


Record Set 5/9/85

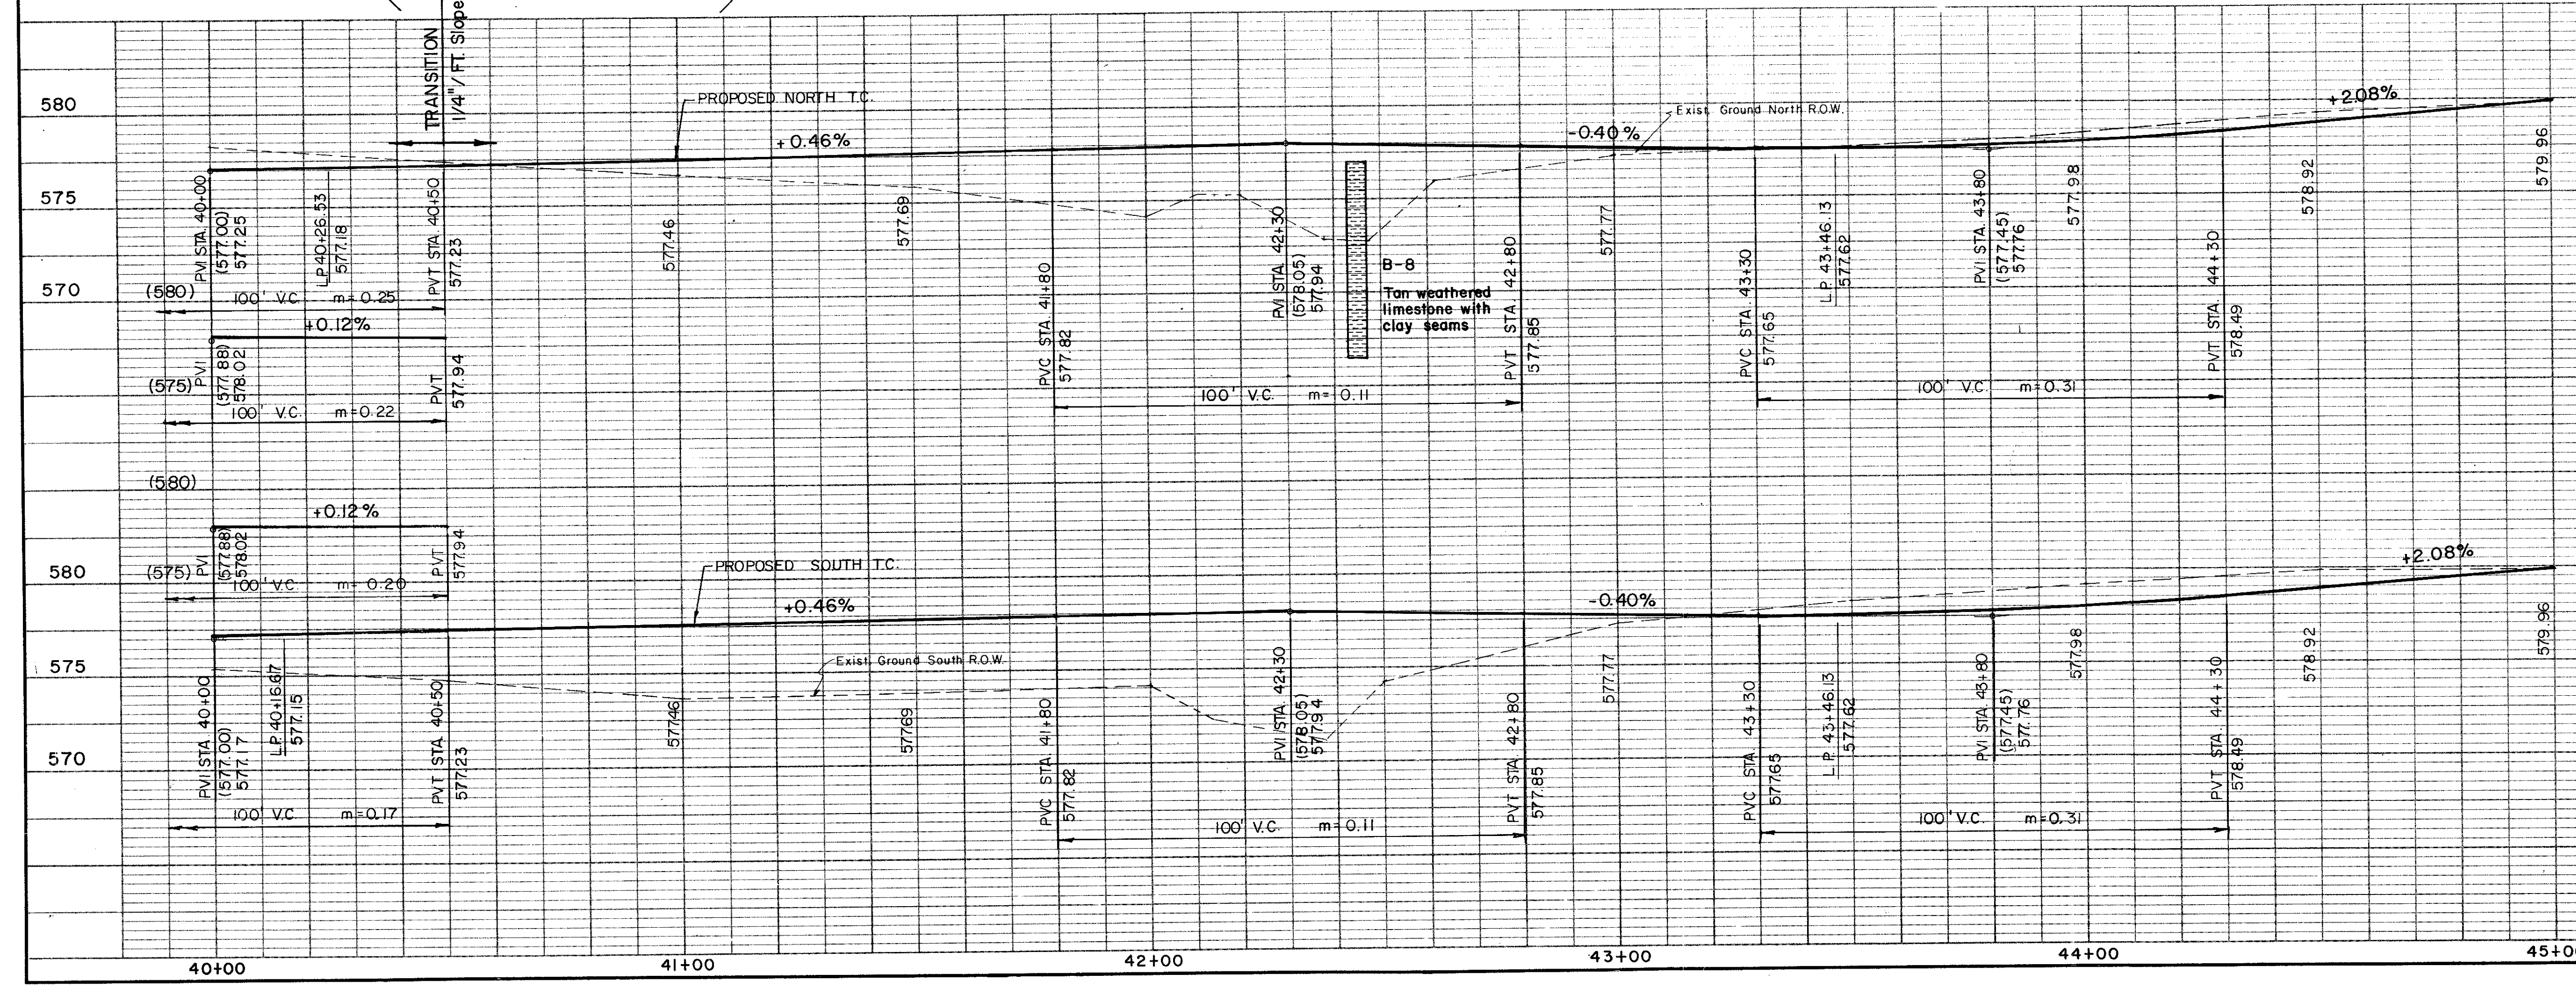

4" Gas Relocated		188	7/9/82
CITY OF ADDISON DALLAS COUNTY, TEXAS SPRING VALLEY ROAD Sta. 40+00 to Sta. 45+00 PAVING GINN, INC. Consulting Engineers - Dallas, Texas			
DESIGNED - G.F. HJ	DRAWN - S.M. G.F.	DATE -	FILE J-178
APPROVED - H.W.G.	CHECKED - HBJ	SCALE - H=1"=20'/V=1"=5'	SHEET 12 OF