


Greenhouse Village Properties, Ltd.

Elvin Levenson

Record Drawing 4/10/85

FOR SECTION D-D, SEE SHT. 4

NOTE: ALL RADII ARE 10'R. UNLESS OTHERWISE NOTED

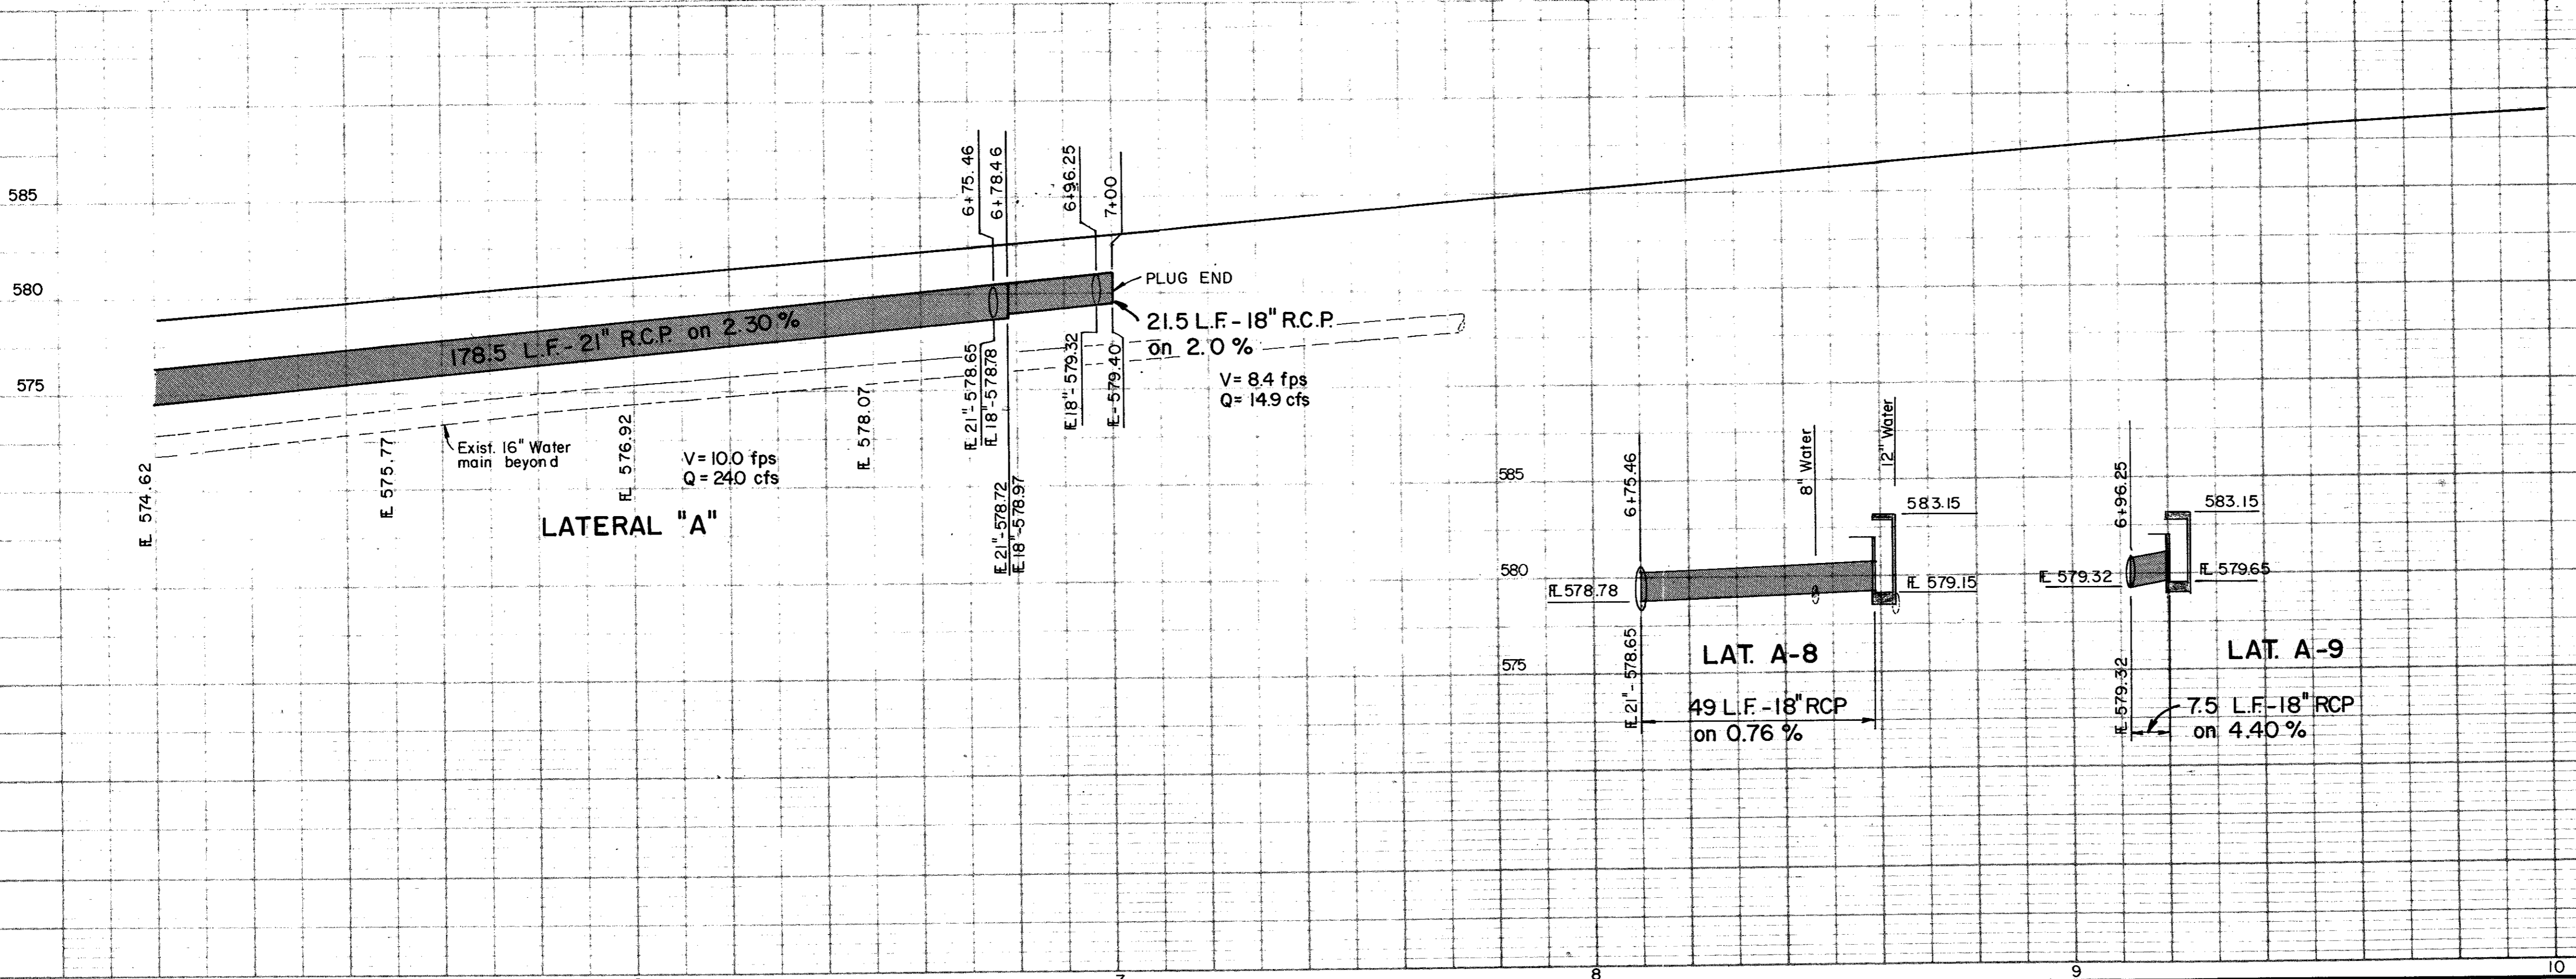

No.	Revision	By	Date
CITY OF ADDISON DALLAS COUNTY, TEXAS SPRING VALLEY ROAD			
DRAINAGE - STA. 5+00 to STA. 10+00			
GINN, INC. Consulting Engineers Dallas, Texas			
Designed - GF	Drawn - GF	Date -	Job No. - J-178
Approved - HWG	Checked - HBJ	Scale - 1" = 20' H., 1" = 5' V.	Sheet 19 of