
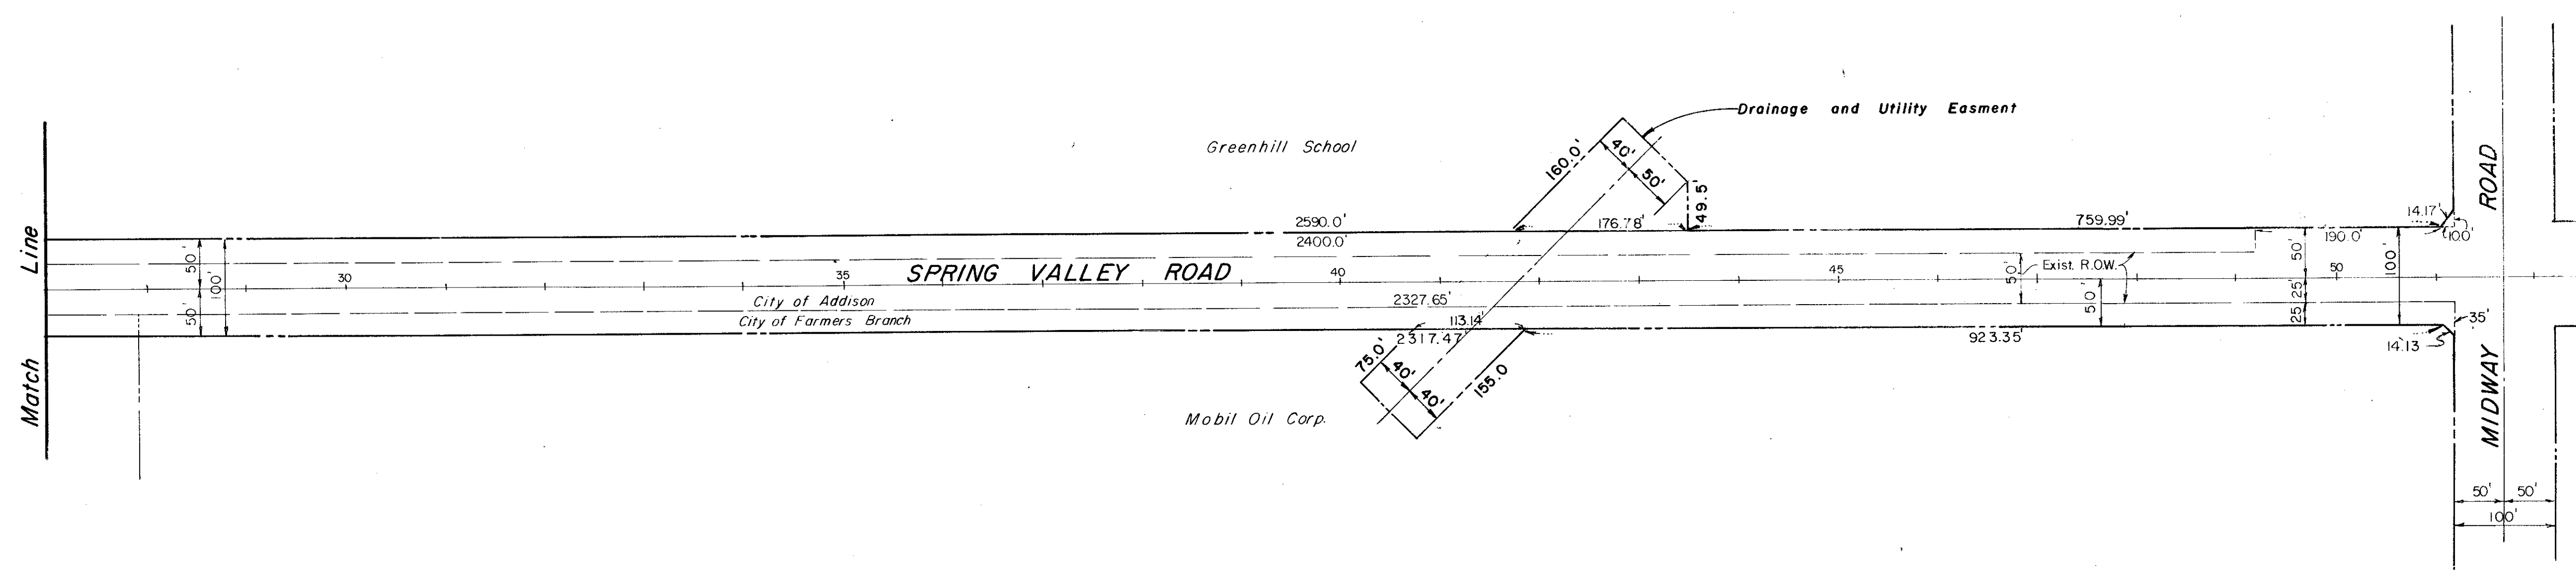


Thomas L. Chenoweth Survey

NOELL ACRES UNRECORDED

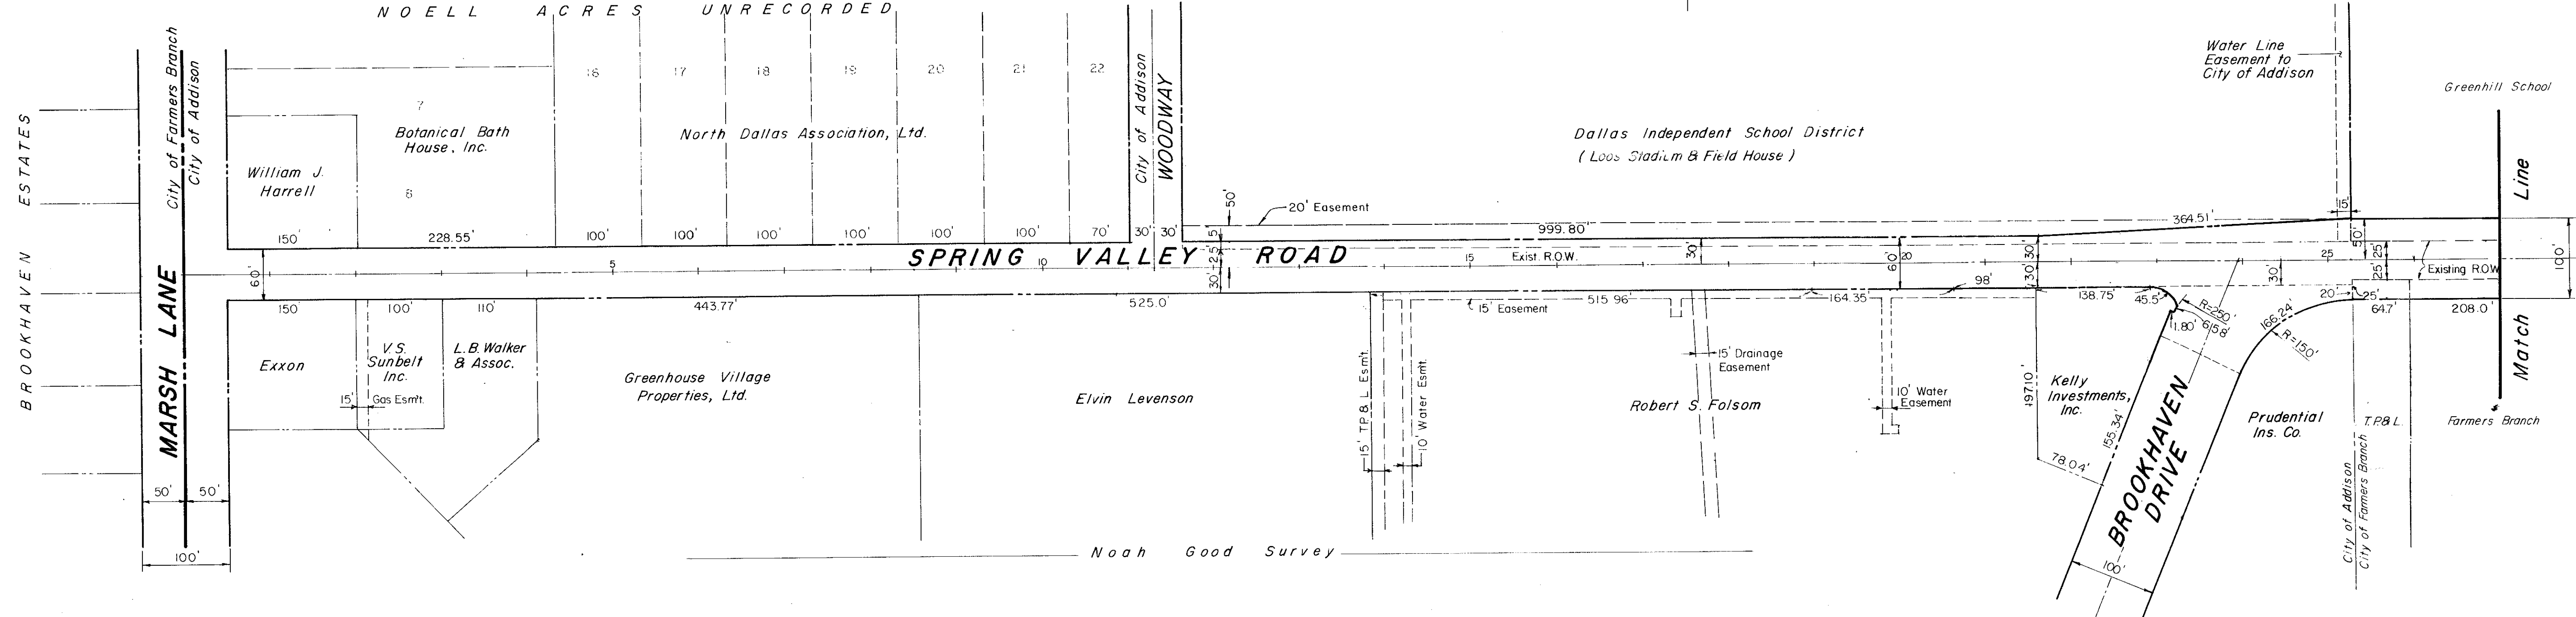

Record Set 5/9/85			
CITY OF ADDISON DALLAS COUNTY, TEXAS SPRING VALLEY ROAD			
RIGHT-OF-WAY MAP			
GINN, INC. Consulting Engineers - Dallas, Texas			
Designed-	Drawn - F	Date-	Job No. J-178
Approved-	Checked-	Scale - 1" = 100'	Sheet 2 of