


Record Set 5/9/85

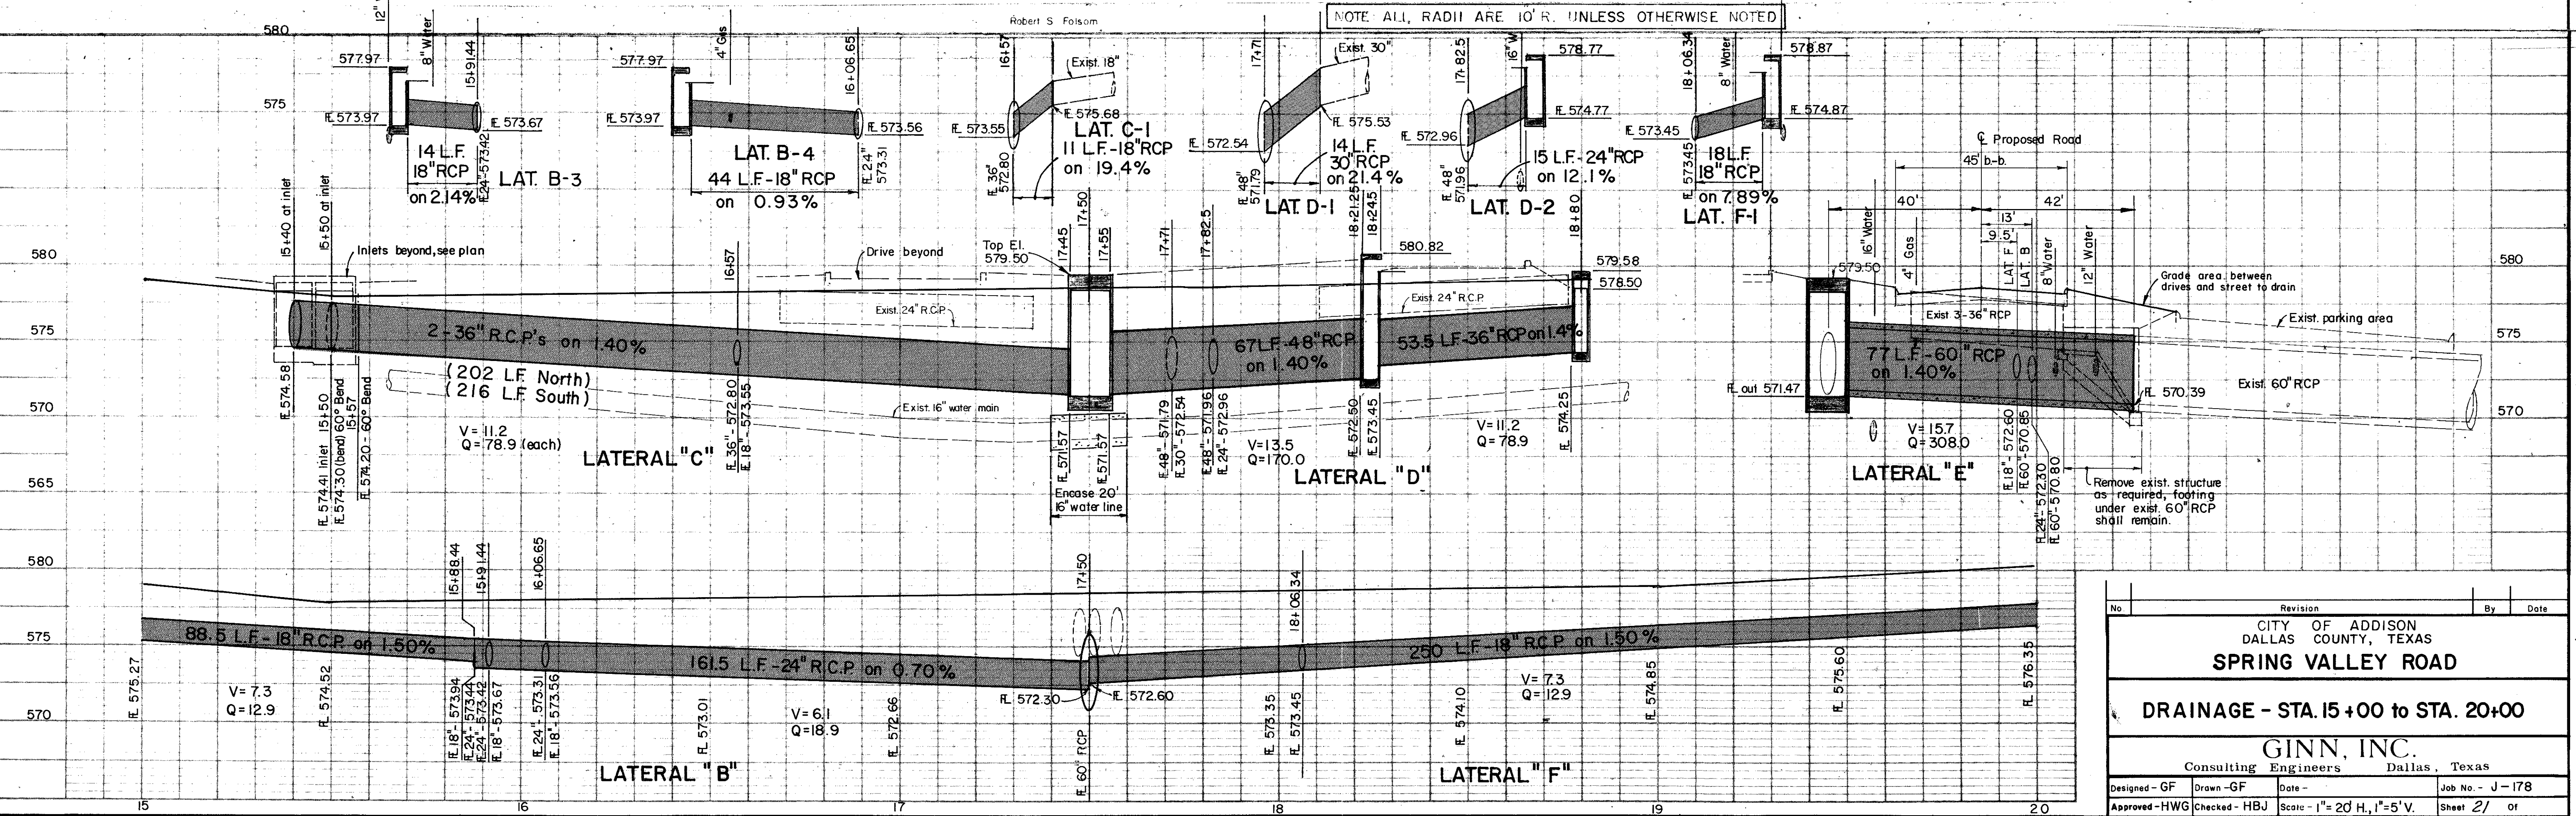

No.	Revision	By	Date
CITY OF ADDISON DALLAS COUNTY, TEXAS <b>SPRING VALLEY ROAD</b>			
<b>DRAINAGE - STA. 15+00 to STA. 20+00</b>			
<b>GINN, INC.</b> Consulting Engineers Dallas, Texas			
Designed - GF	Drawn - GF	Date -	Job No. - J-178
Approved - HWG	Checked - HBJ	Scale - 1" = 20' H, 1" = 5' V.	Sheet 21 of