


NOTE: FOR DIMENSIONS AND DETAILS THIS AREA SEE SHEET 8B

Robert S. Folsom

Kel, Investments, Inc.

Record Drawing 4/10/85

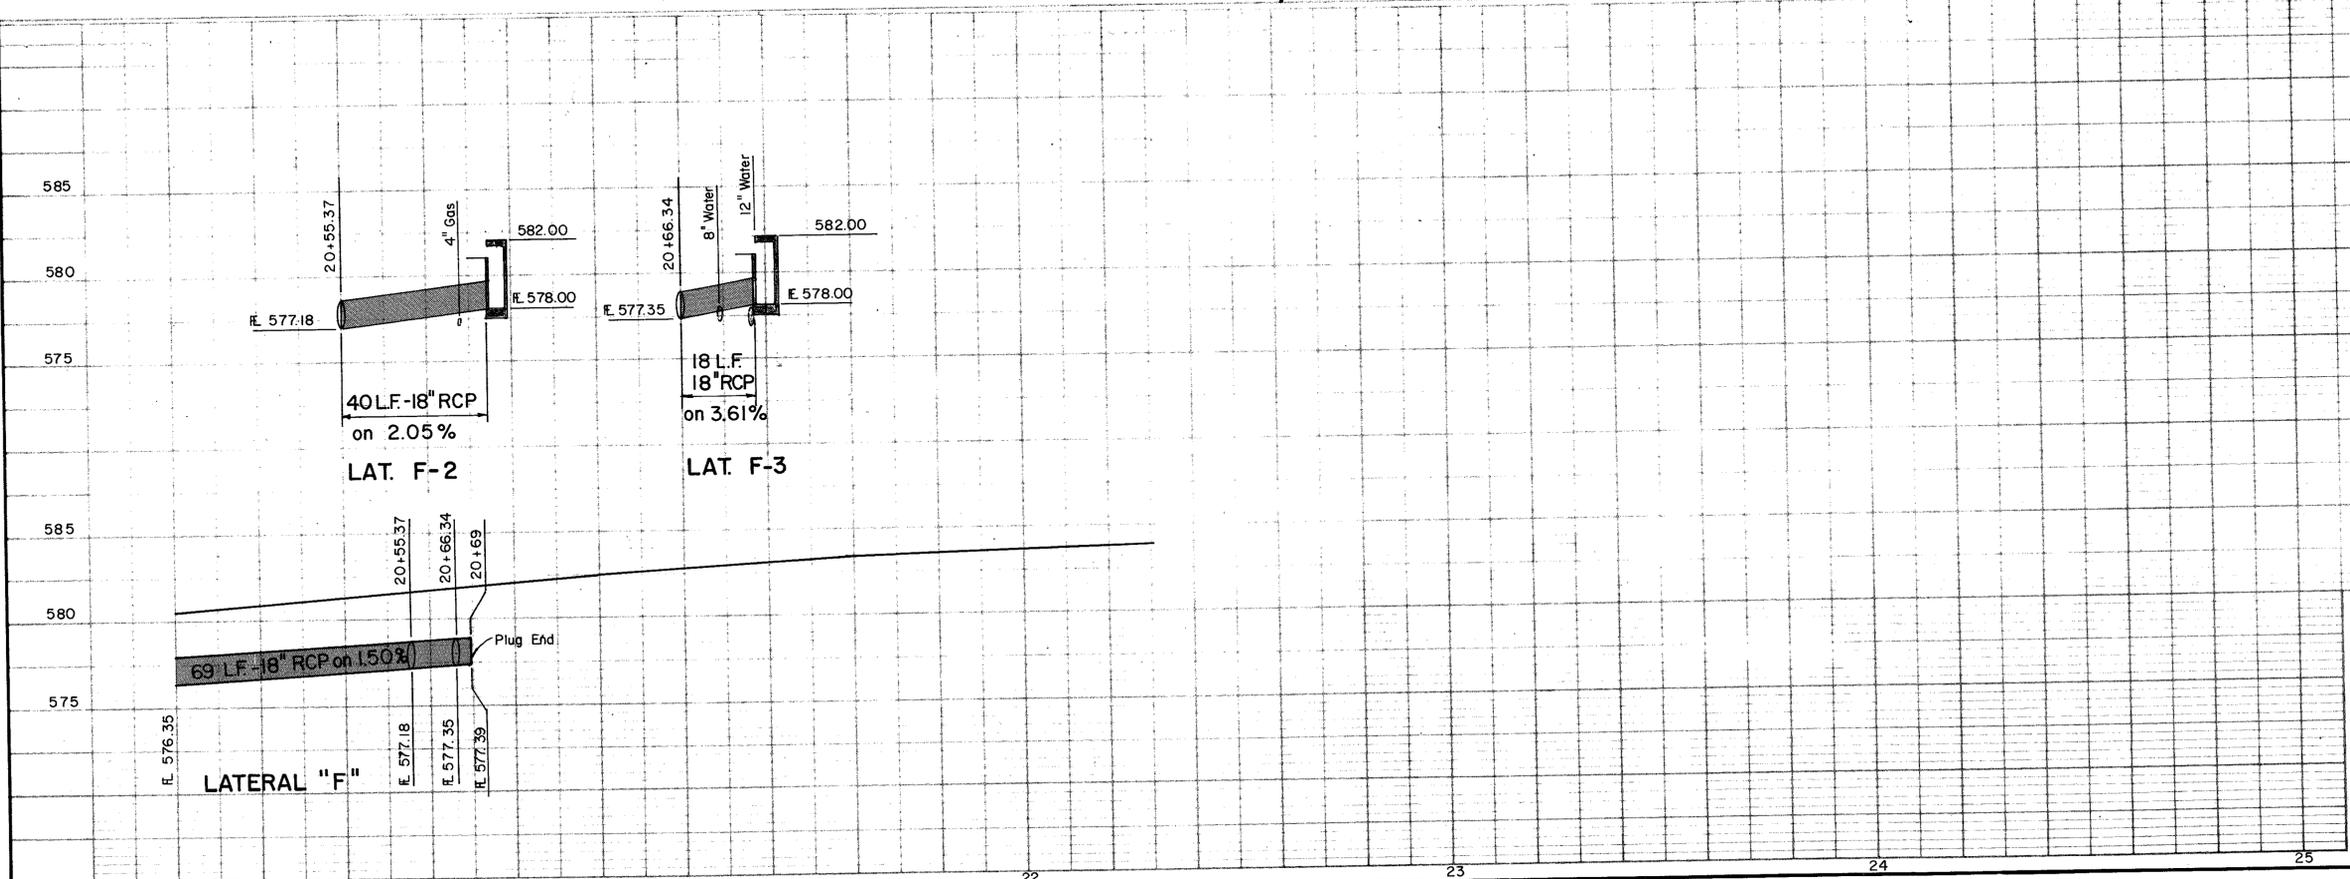

No.	Revision	By	Date
CITY OF ADDISON DALLAS COUNTY, TEXAS SPRING VALLEY ROAD			
DRAINAGE - STA. 20+00 to STA. 25+00			
GINN, INC. Consulting Engineers Dallas, Texas			
Designed - GF	Drawn - GF	Date -	Job No. - J-178
Approved - HWG	Checked - HBJ	Scale - 1"=20'H, 1"=5'V.	Sheet 22 of