


Record Set 5/9/85

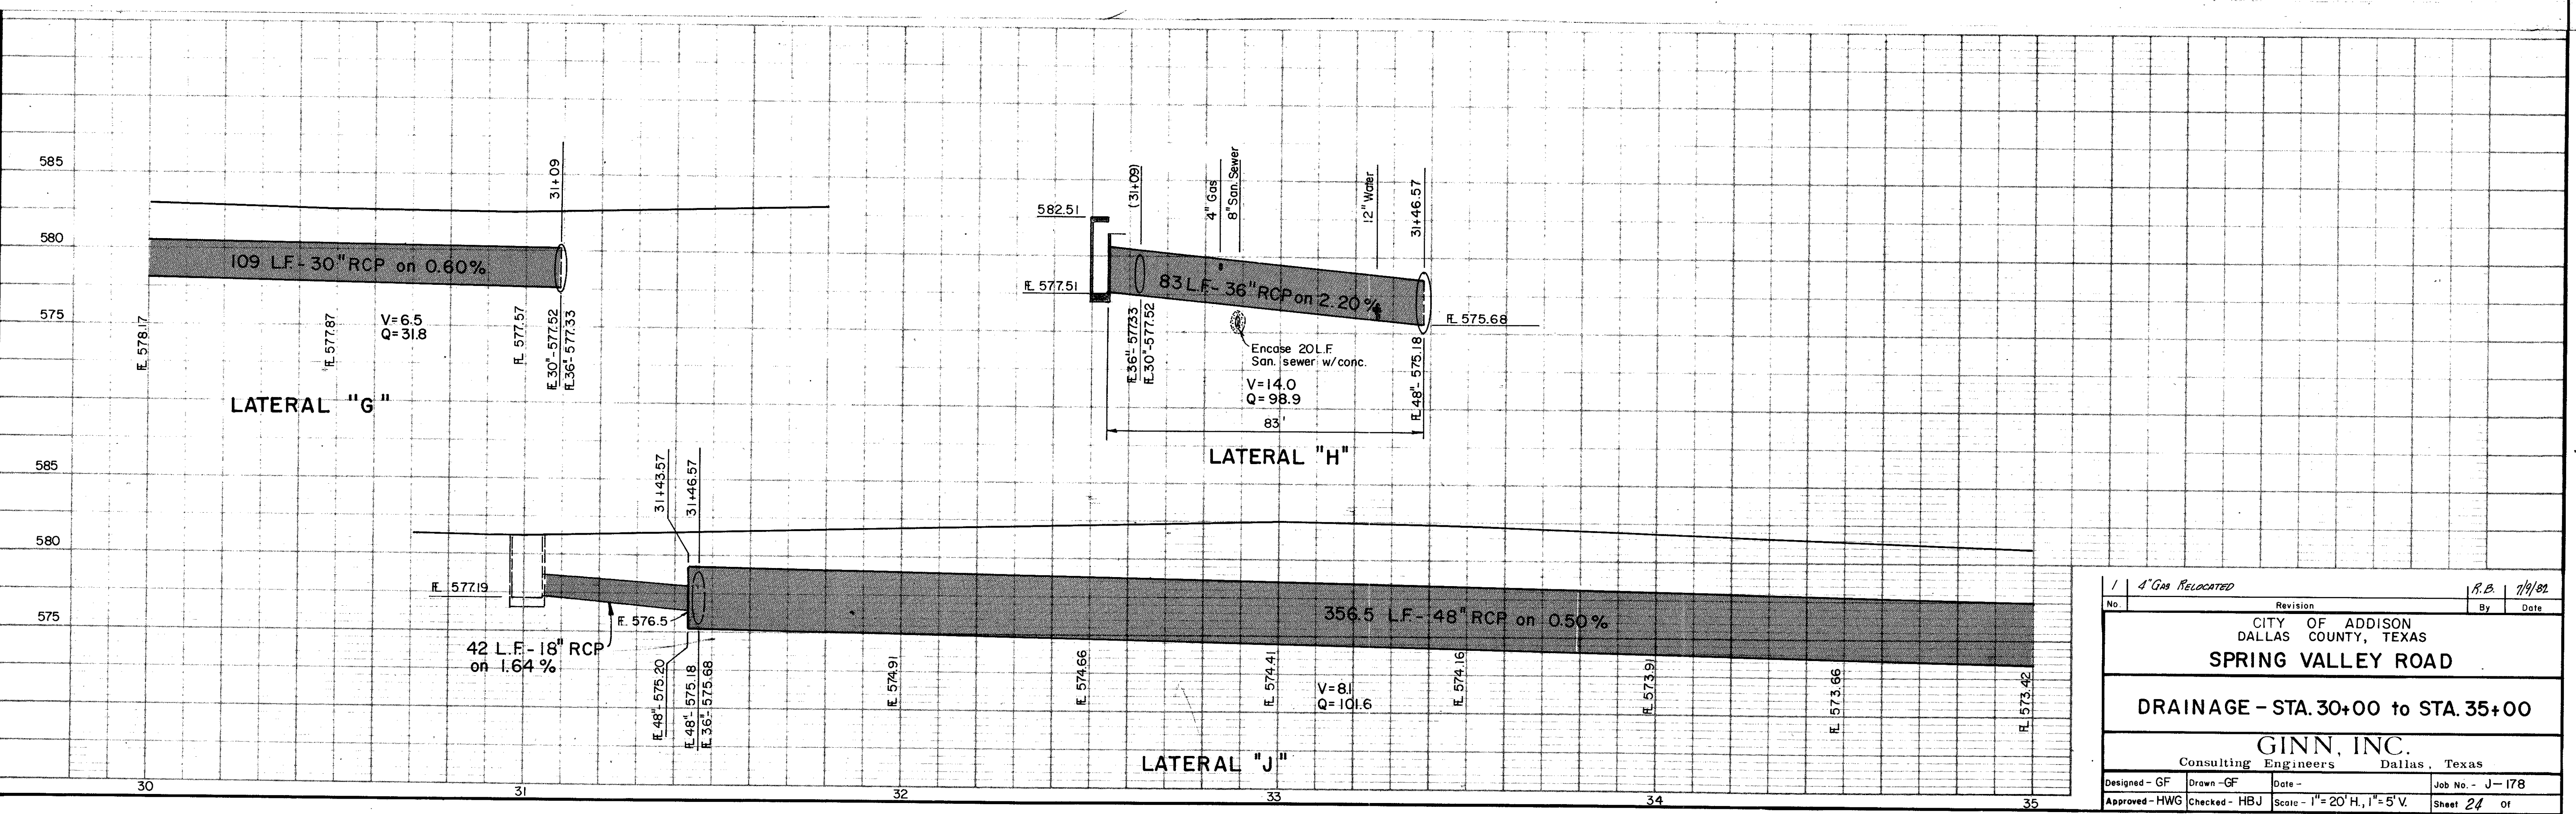

1		4" Gas Relocated	R.B.		1/9/82
No.	Revision			By	Date
CITY OF ADDISON DALLAS COUNTY, TEXAS SPRING VALLEY ROAD					
DRAINAGE - STA. 30+00 to STA. 35+00					
GINN, INC. Consulting Engineers Dallas, Texas					
Designed - GF	Drawn - GF	Date -	Job No. - J-178		
Approved - HWG	Checked - HBJ	Scale - 1"=20' H, 1"=5' V.	Sheet 24 of		