


JUNCTION BOX  
 29.5' Rt. C Sta. 35+91.57  
 Top El. 579.01  
 El. West = 572.99  
 El. NW = 573.18  
 El. East = 572.95  
 For Details, See Sht. 29

Record Set 5/9/85  
 B.M. #3 R.R. Spike On P.P., North Spring Valley Rd.  
 Sta. 35+83.65 Lt. C.  
 Elev. 583.50

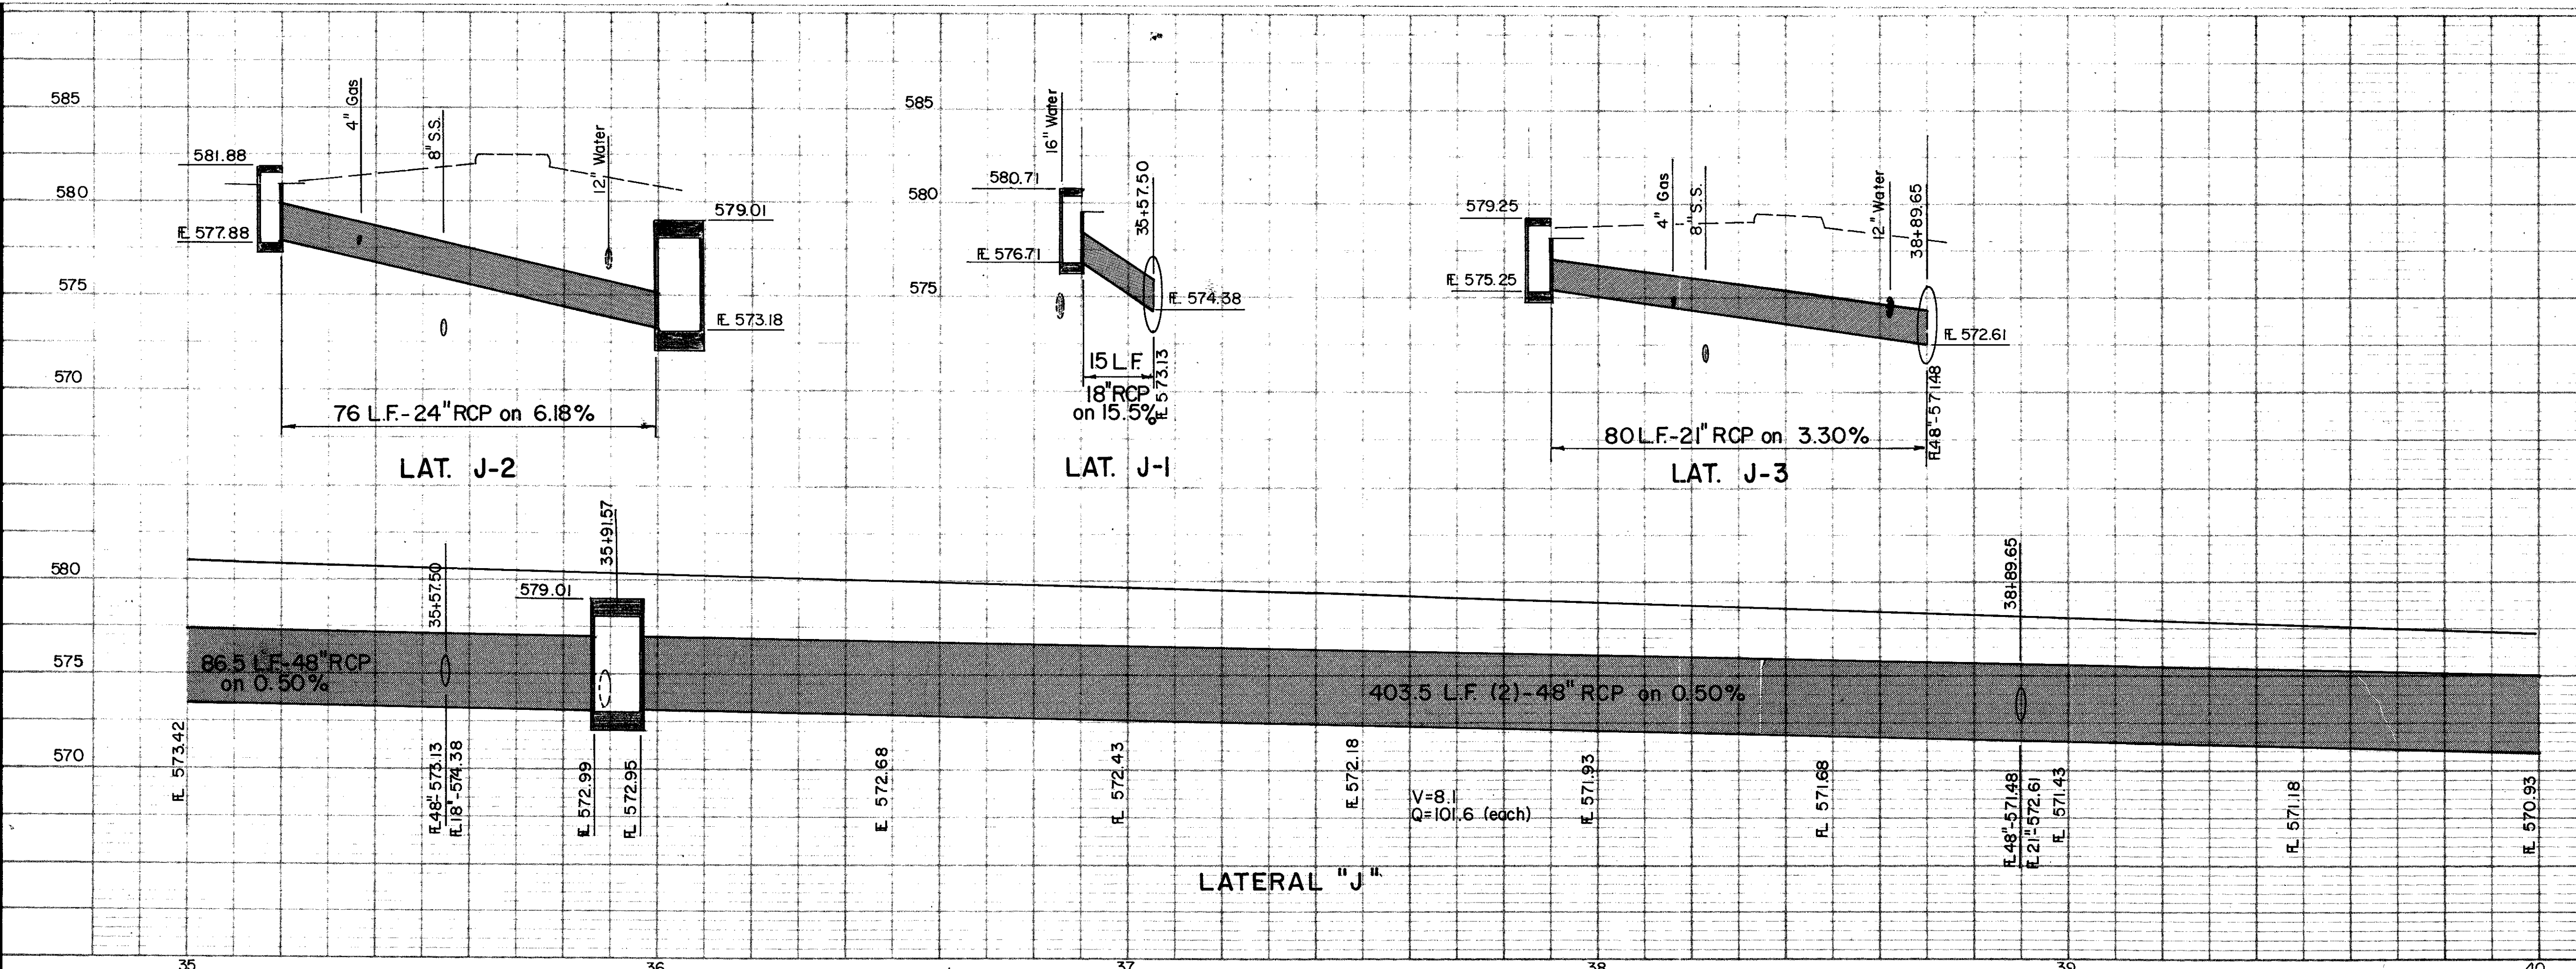

1		4" Gas Relocated		By		Date	
No.		Revision		By		Date	
CITY OF ADDISON DALLAS COUNTY, TEXAS <b>SPRING VALLEY ROAD</b>							
<b>DRAINAGE - STA. 35+00 to STA. 40+00</b>							
<b>GINN, INC.</b> Consulting Engineers Dallas, Texas							
Designed - GF	Drawn - GF	Date -			Job No. - J-178		
Approved - HWG	Checked - HBJ	Scale - 1" = 20' H., 1" = 5' V.			Sheet 25 of		