


NOTE:
 ABANDONMENT OF EXIST. M.H., SEWER LINES,
 AND METER STATIONS TO BE, AFTER 'M.S.' IS COMP.
 CONSTRUCTION OF PROPOSED M.H.'S, SEWER
 LINES AND METER STATION BY THIS CONTRACT.
 THIS CONTRACT RESPONSIBLE FOR ADJUSTMENT
 OF M.H.'S IF REQ'D.

Record Set 5/9/85

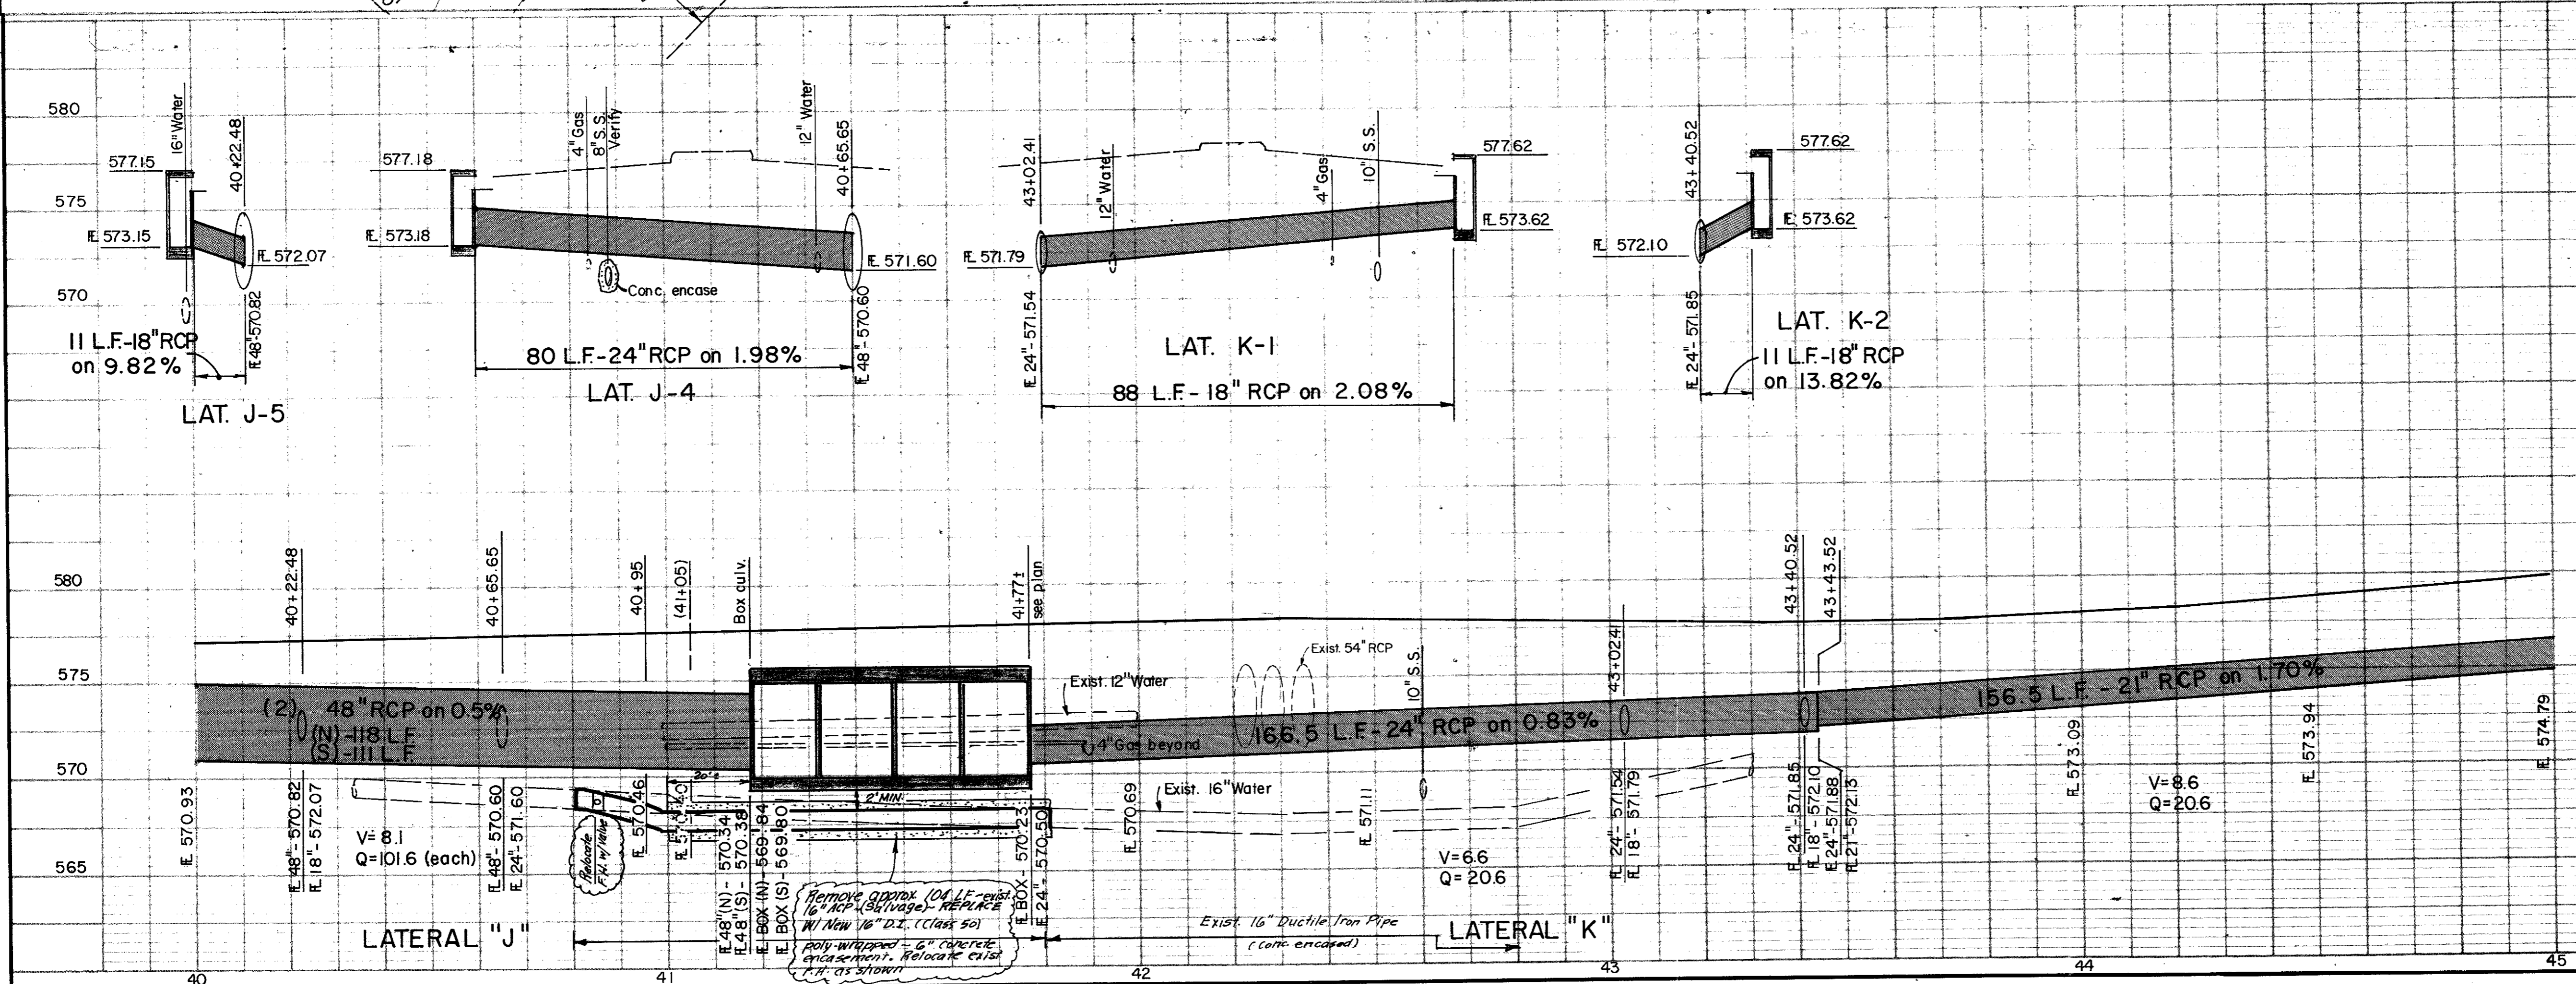

1 4" Gas Relocated		By	Date
Revision		RB	7/9/82
CITY OF ADDISON DALLAS COUNTY, TEXAS			
SPRING VALLEY ROAD			
DRAINAGE - STA.40+00 to STA.45+00			
GINN, INC.			
Consulting Engineers Dallas, Texas			
Designed - GF	Drawn - GF	Date -	Job No. - J-178
Approved - HWG	Checked - HBJ	Scale - 1" = 20' H., 1" = 5' V.	Sheet 26 of