


B.M. #4 R.R. Spike on 14" Elm North Spring Valley Rd.  
 Sta 45+50, 83' Lt.  $\zeta$   
 Elev 582.38

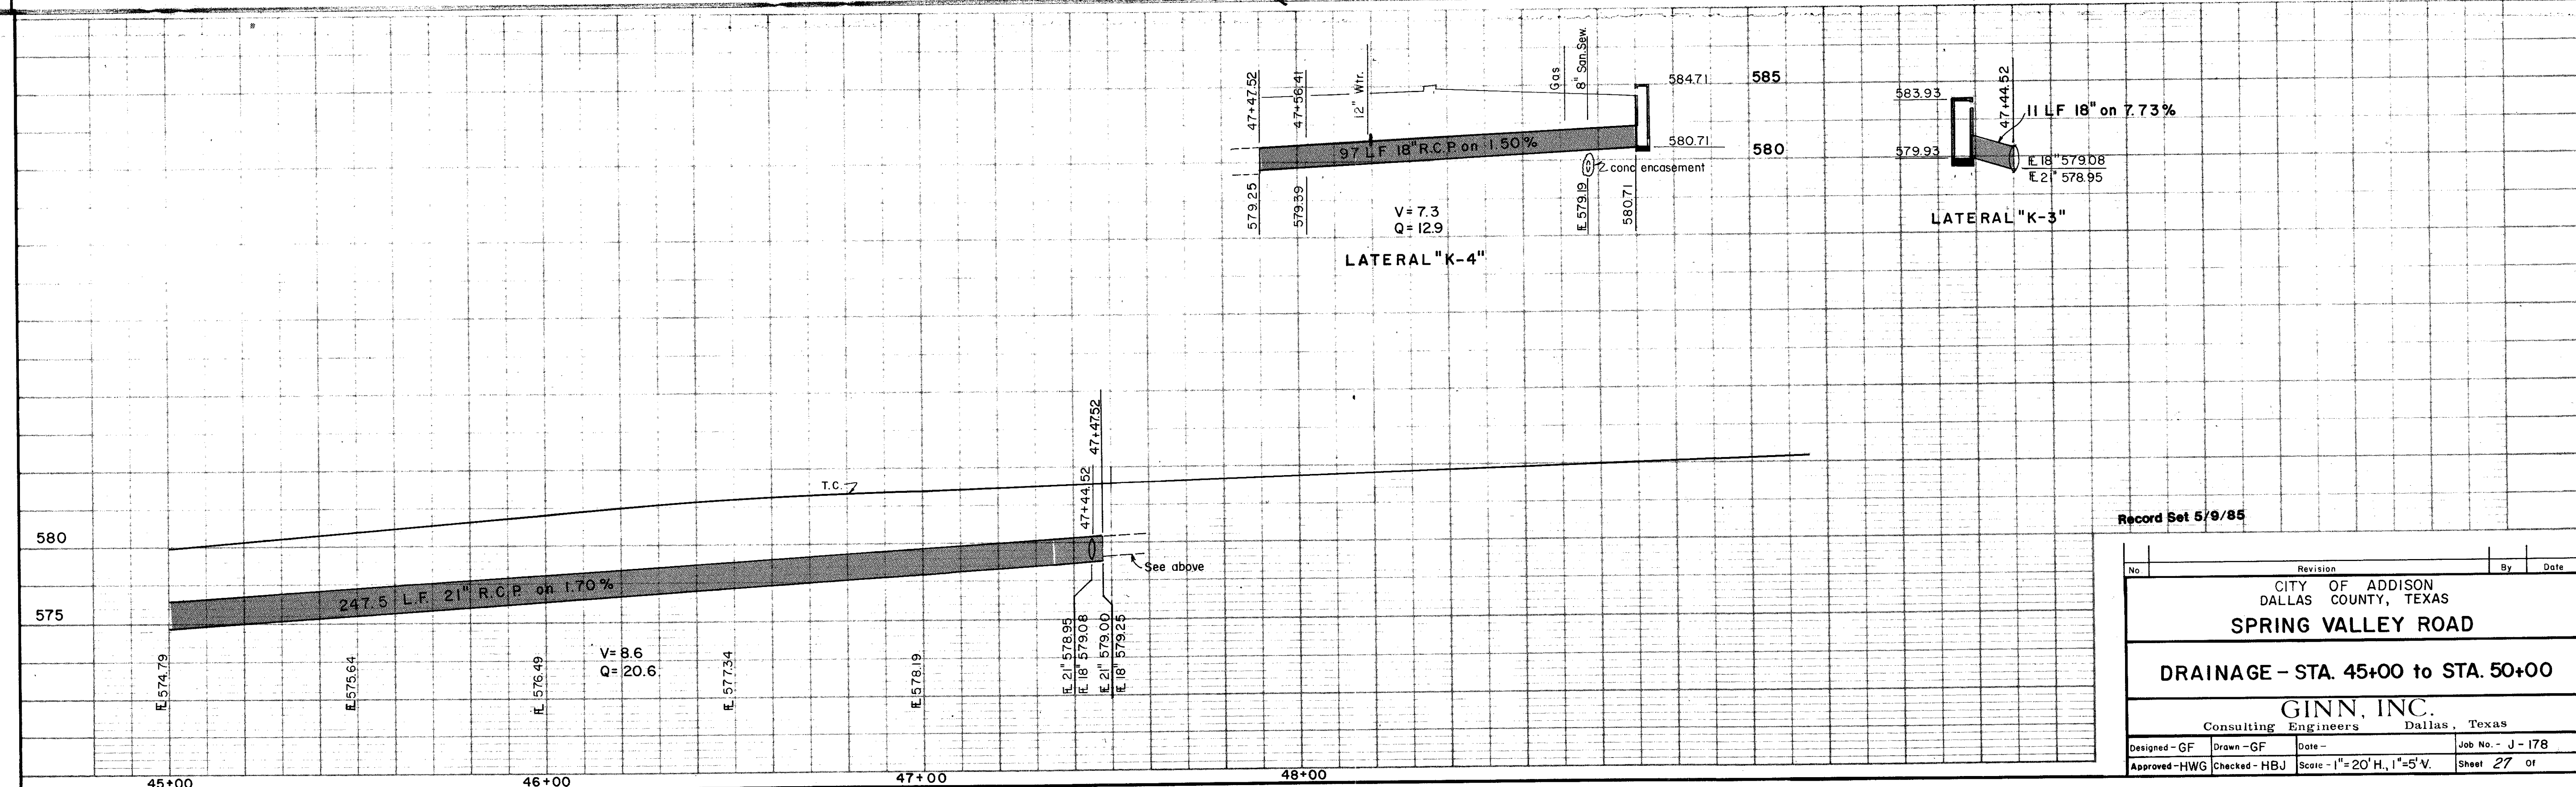

Record Set 5/9/85

No.	Revision	By	Date
CITY OF ADDISON DALLAS COUNTY, TEXAS <b>SPRING VALLEY ROAD</b> <b>DRAINAGE - STA. 45+00 to STA. 50+00</b> <b>GINN, INC.</b> Consulting Engineers Dallas, Texas			
Designed - GF	Drawn - GF	Date -	Job No. - J-178
Approved - HWG	Checked - HBJ	Scale - 1" = 20' H., 1" = 5' V.	Sheet 27 of