


B.M. #3 R.R. Spike On P.P., North Spring Valley Rd.
 Sta. 35+83.65' Lt. E.
 Elev. 583.50

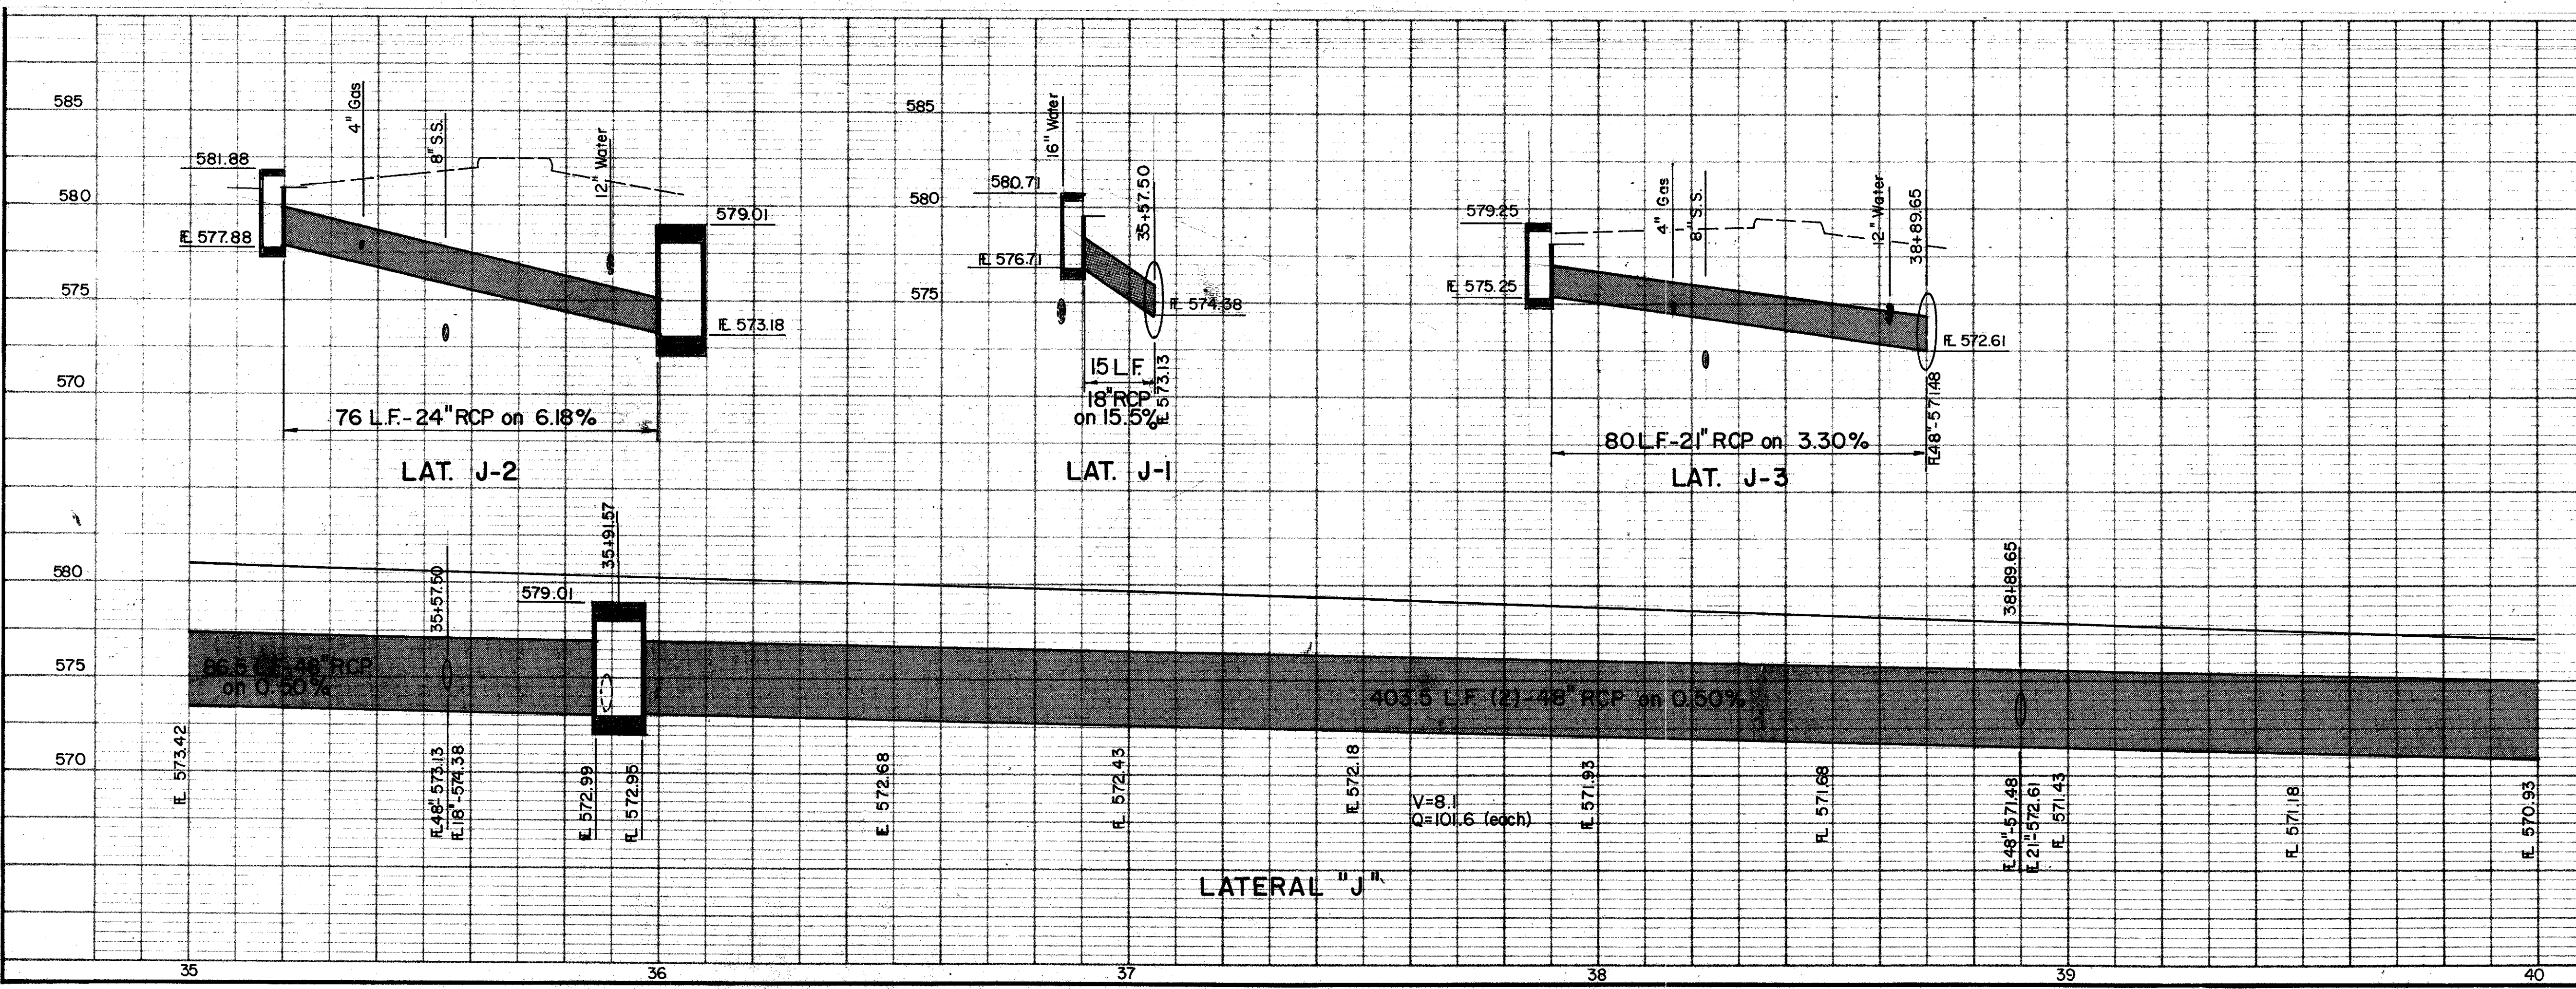

1		4" Gas Relocated		RB	1/9/82
No.	Revision			By	Date
CITY OF ADDISON DALLAS COUNTY, TEXAS SPRING VALLEY ROAD					
DRAINAGE - STA. 35+00 to STA. 40+00					
GINN, INC. Consulting Engineers Dallas, Texas					
Designed - GF	Drawn - GF	Date -	Job No. - J-178		
Approved - HWG	Checked - HBJ	Scale - 1" = 20' H., 1" = 5' V.	Sheet 25	of	