


NOTE:
 ABANDONMENT OF EXIST. M.H., SEWER LINES,
 AND METER STATIONS TO BE, AFTER 'M.S.' IS COMP.
 CONSTRUCTION OF PROPOSED M.H.'S, SEWER
 LINES AND METER STATION BY THIS CONTRACT.
 THIS CONTRACT RESPONSIBLE FOR ADJUSTMENT
 OF M.H.'S IF REQ'D.

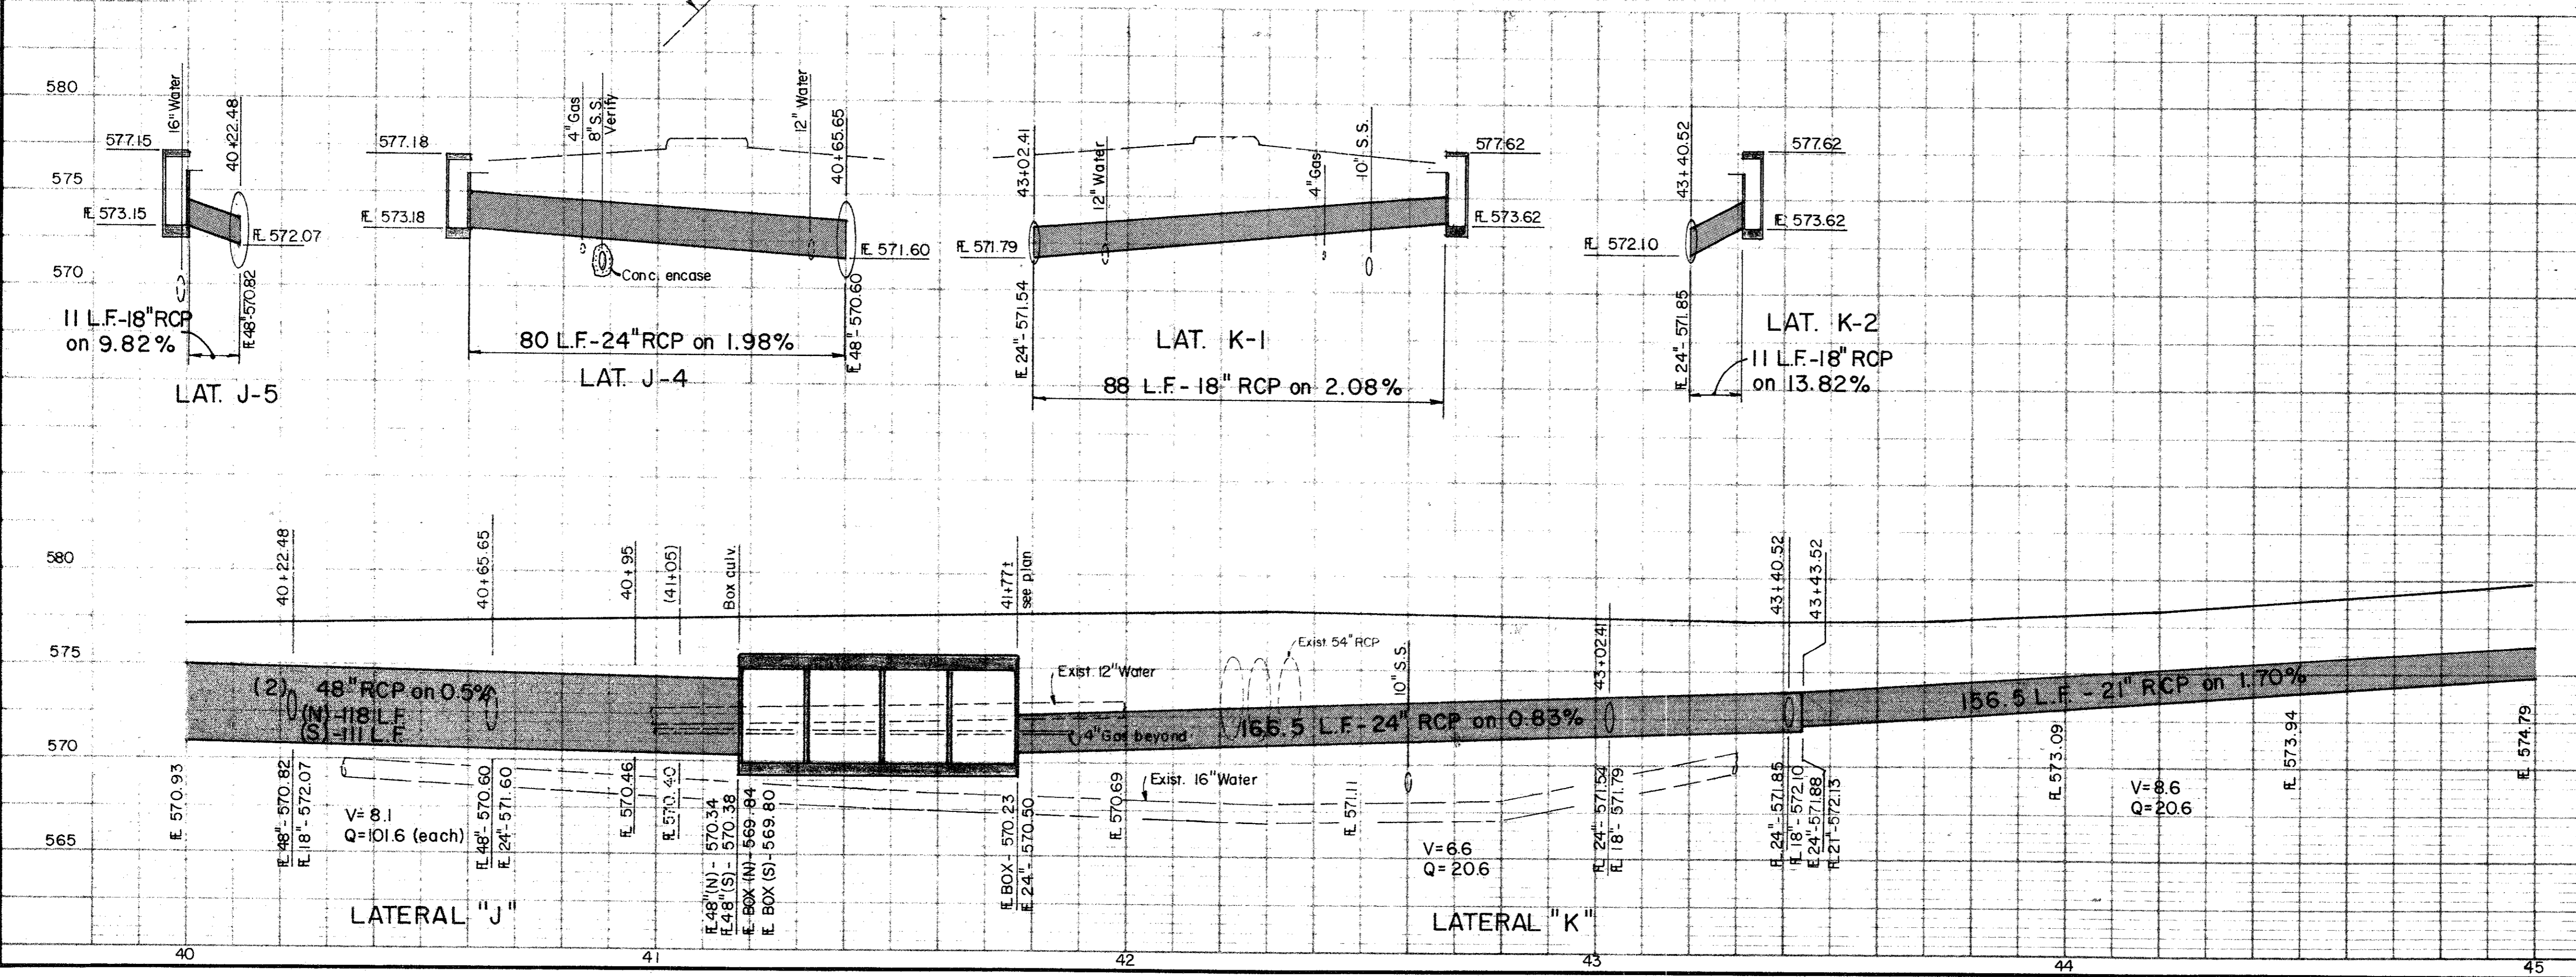

1 4" Gas Relocated		85	7/9/82
No.	Revision	By	Date
CITY OF ADDISON DALLAS COUNTY, TEXAS SPRING VALLEY ROAD			
DRAINAGE - STA. 40+00 to STA. 45+00			
GINN, INC. Consulting Engineers Dallas, Texas			
Designed - GF	Drawn - GF	Date -	Job No. - J-178
Approved - HWG	Checked - HBJ	Scale - 1" = 20' H., 1" = 5' V.	Sheet 26 of