
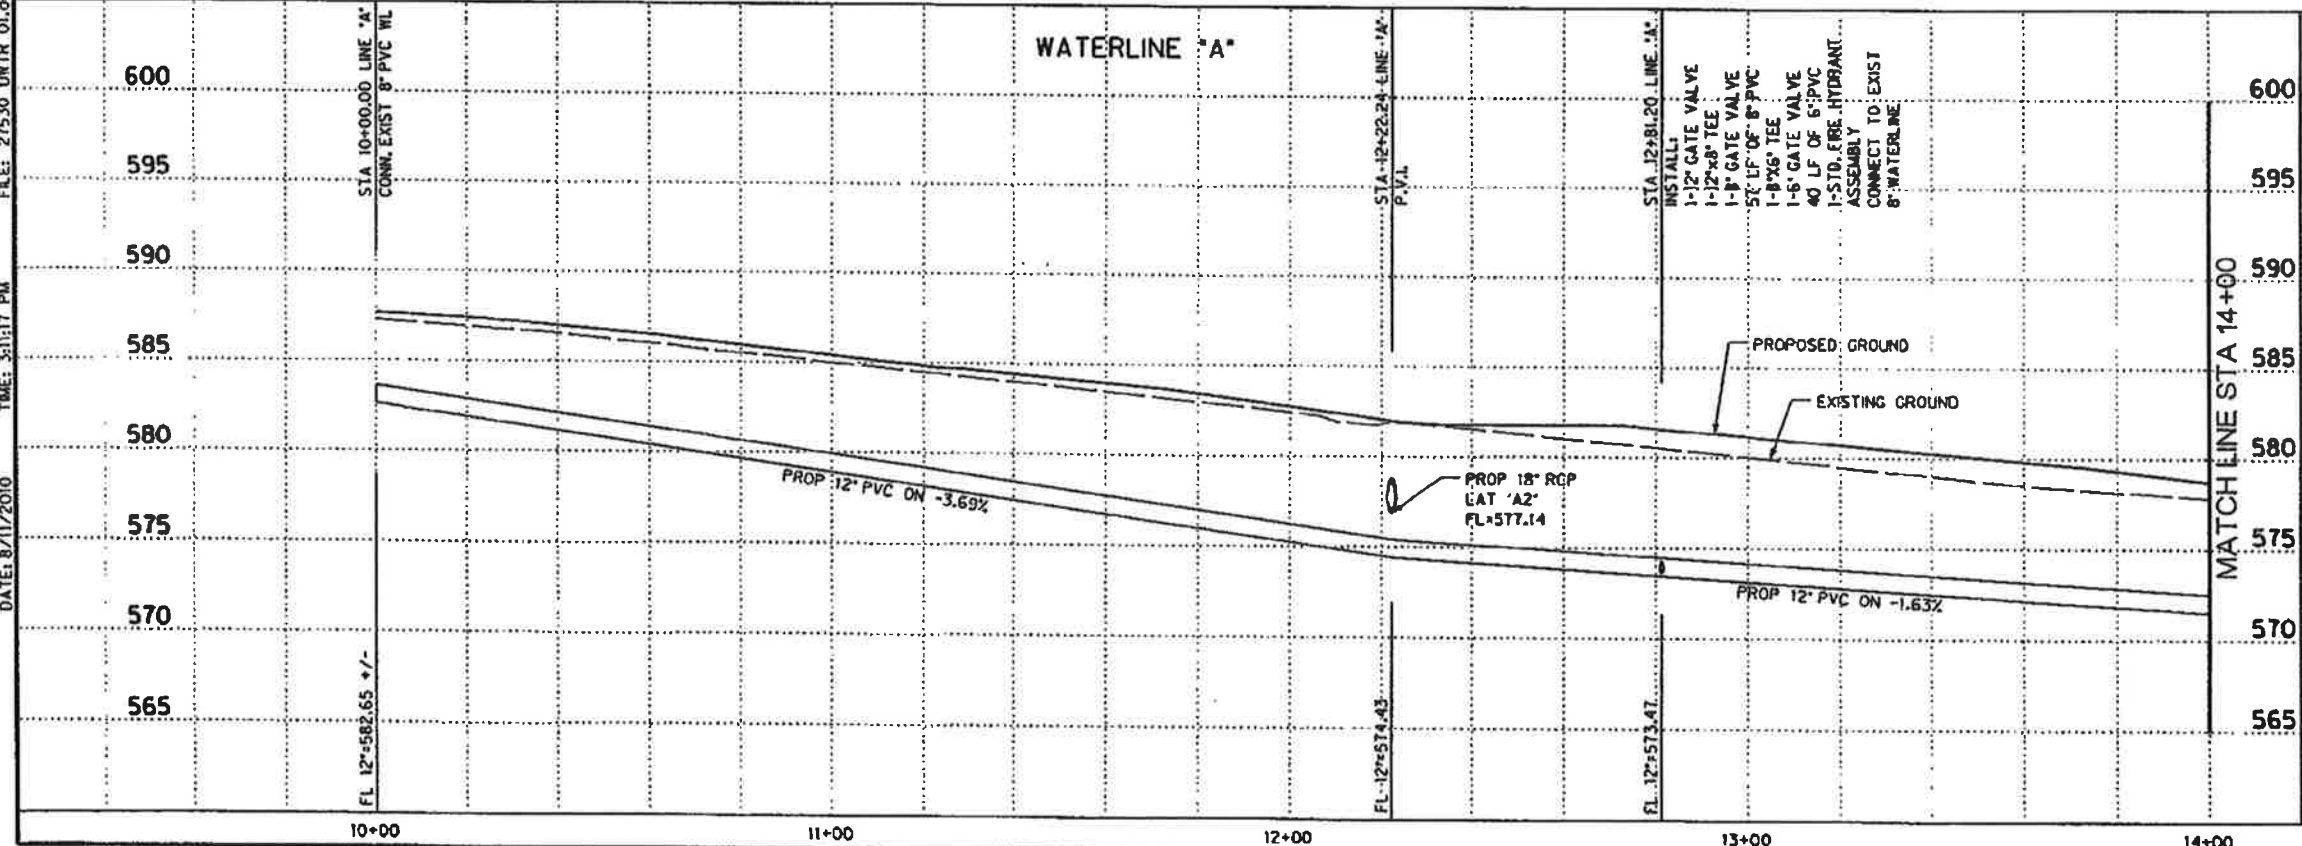
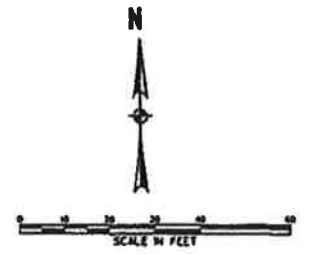


DATE: 8/11/2010 TIME: 3:11:17 PM FILE: 27530 LWTR 01.dwg PROJECT # 27530 OFFICE: RCH USER: chl299

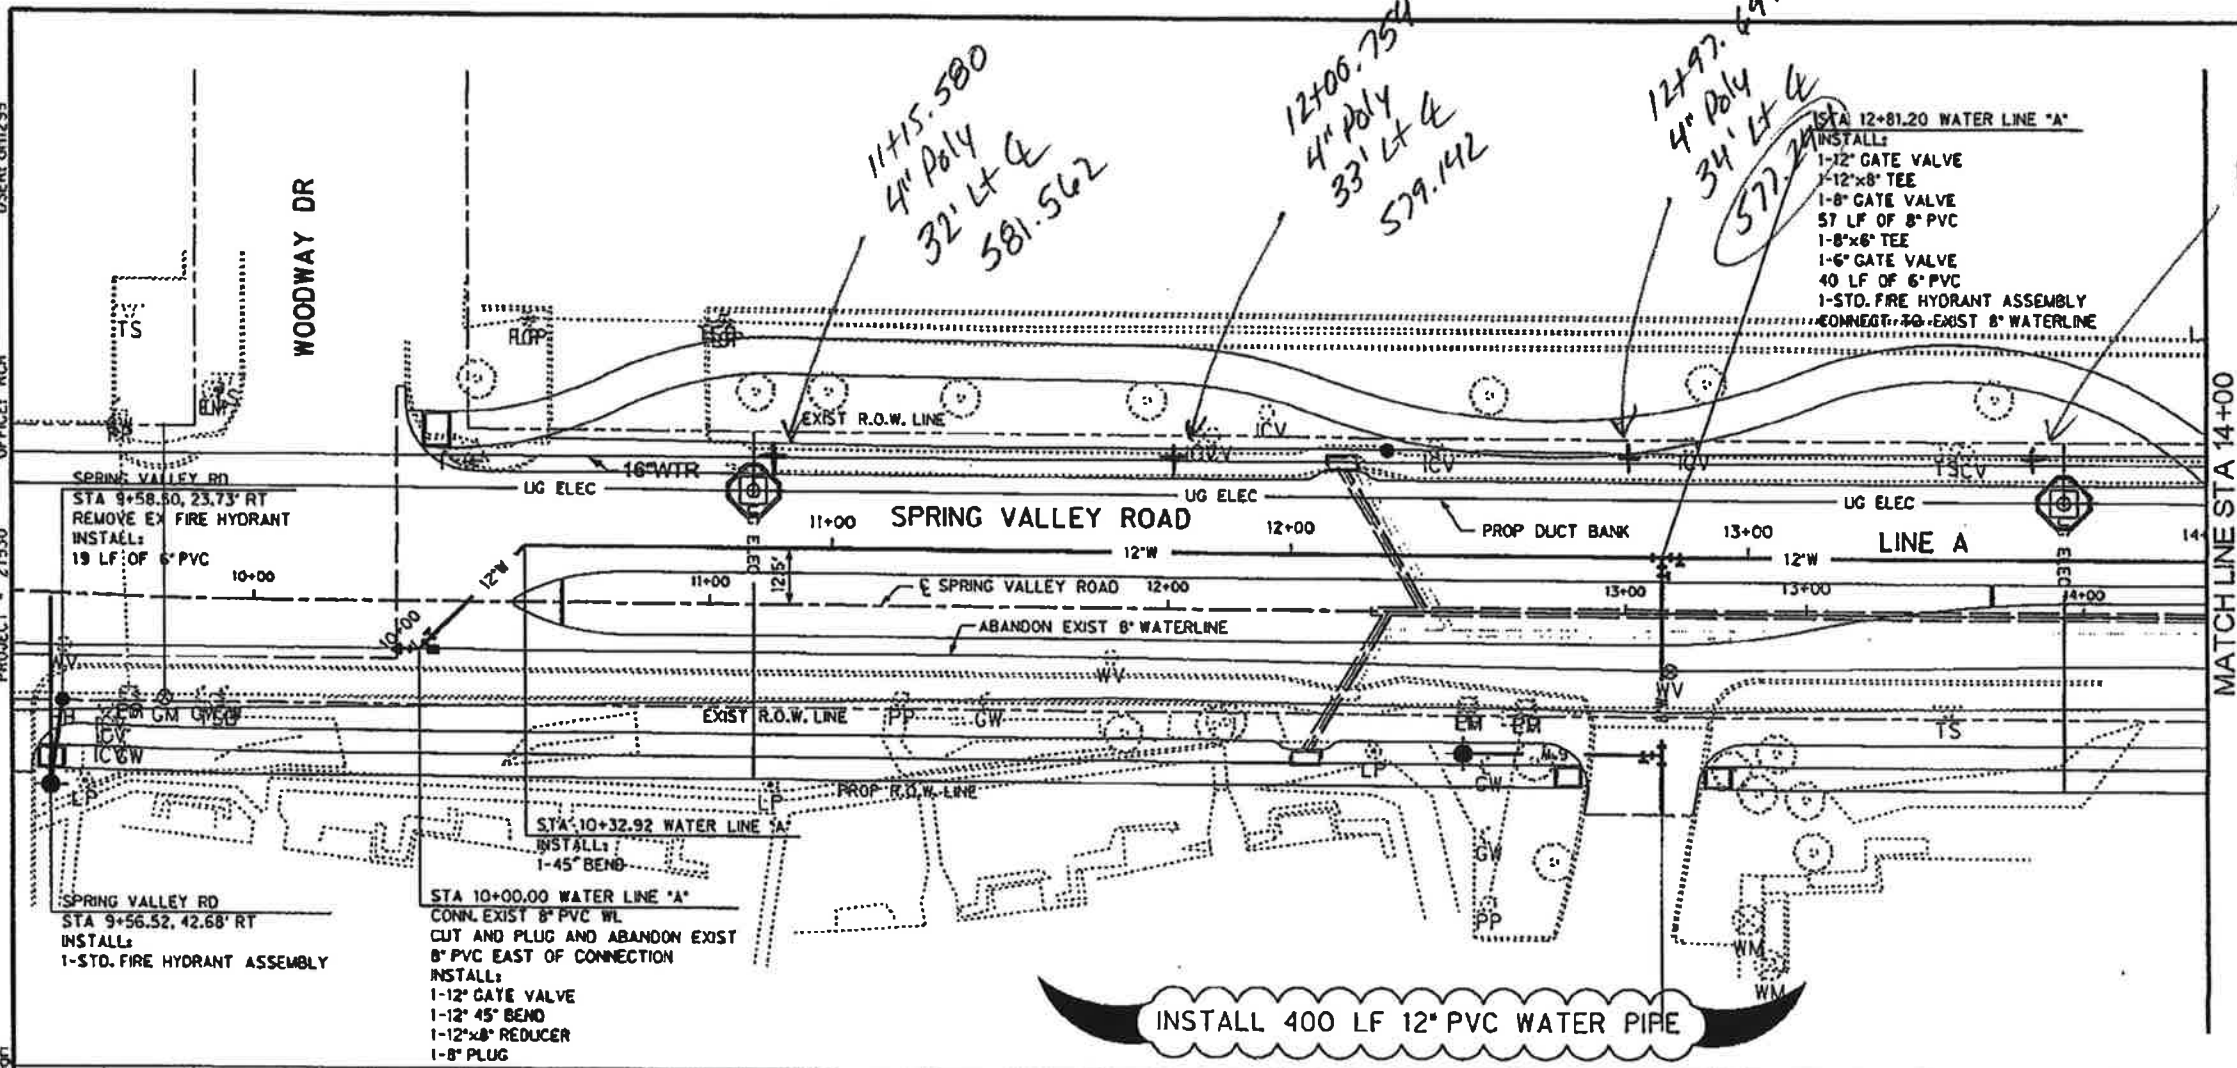

HALFF ASSOCIATES, INC.  
ENGINEERS - SURVEYORS - SCIENTISTS  
PRELIMINARY - FOR INTERIM REVIEW ONLY  
These documents are for Interim Review and not intended for Construction, Bidding, or Permit Purposes. They were prepared by, or under the supervision of:  
M.E. ROMANOWSKI P.E. AUGUST 2010

TOWN OF ADDISON DALLAS COUNTY, TEXAS					
SPRING VALLEY ROAD					
WATER PLAN AND PROFILE STA 10+00 TO 14+00					
1305 NORTH BOWSER ROAD, RICHARDSON, TEXAS 75081-0278 TEL: (972) 348-4200 FAX: (972) 348-4202					
PROJECT	DESIGN	DRAWN	DATE	FILE	SHEET
27530	XXX	XXX	AUGUST 2010	27530 LWTR 01	WTR-1