

USER: dhl299


OFFICE: RCH

PROJECT: 27530


FILE: 27530 UWTR 03.dwg

TIME: 3:11:40 PM

DATE: 8/11/2010

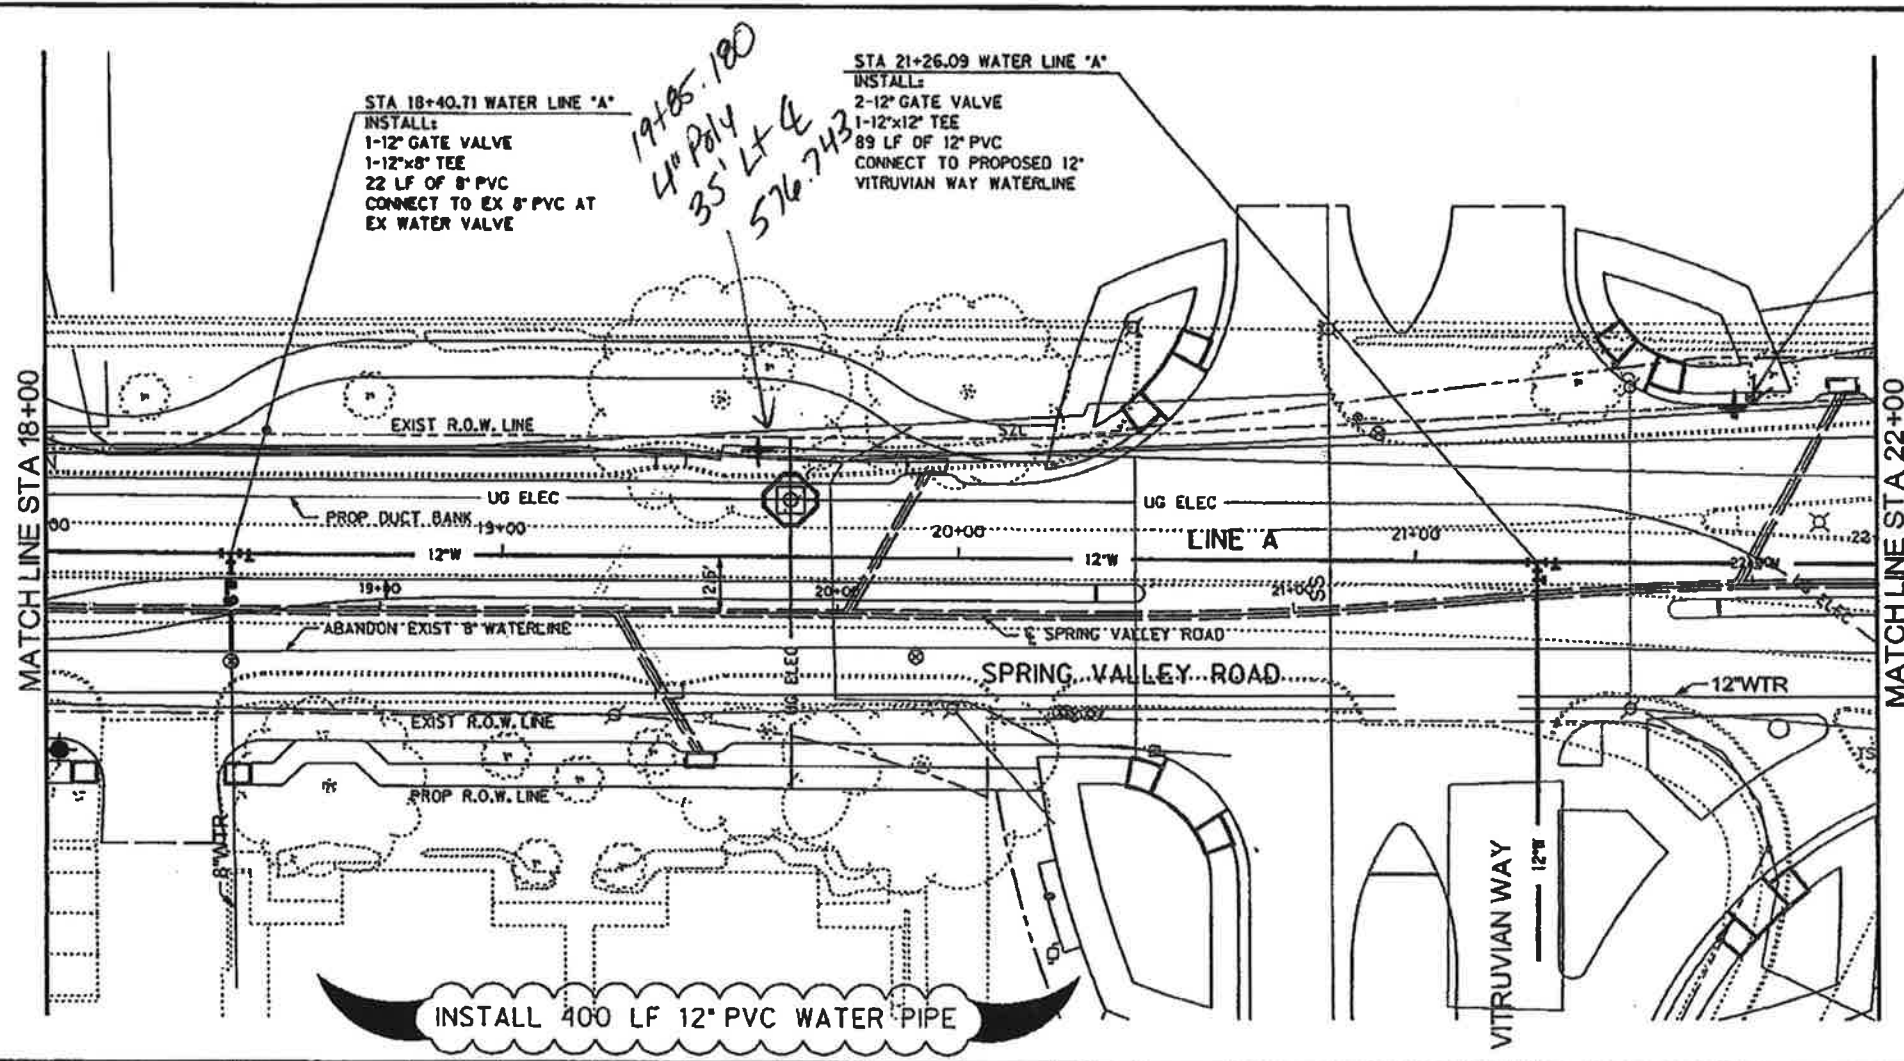

INSTALL 400 LF 12" PVC WATER PIPE

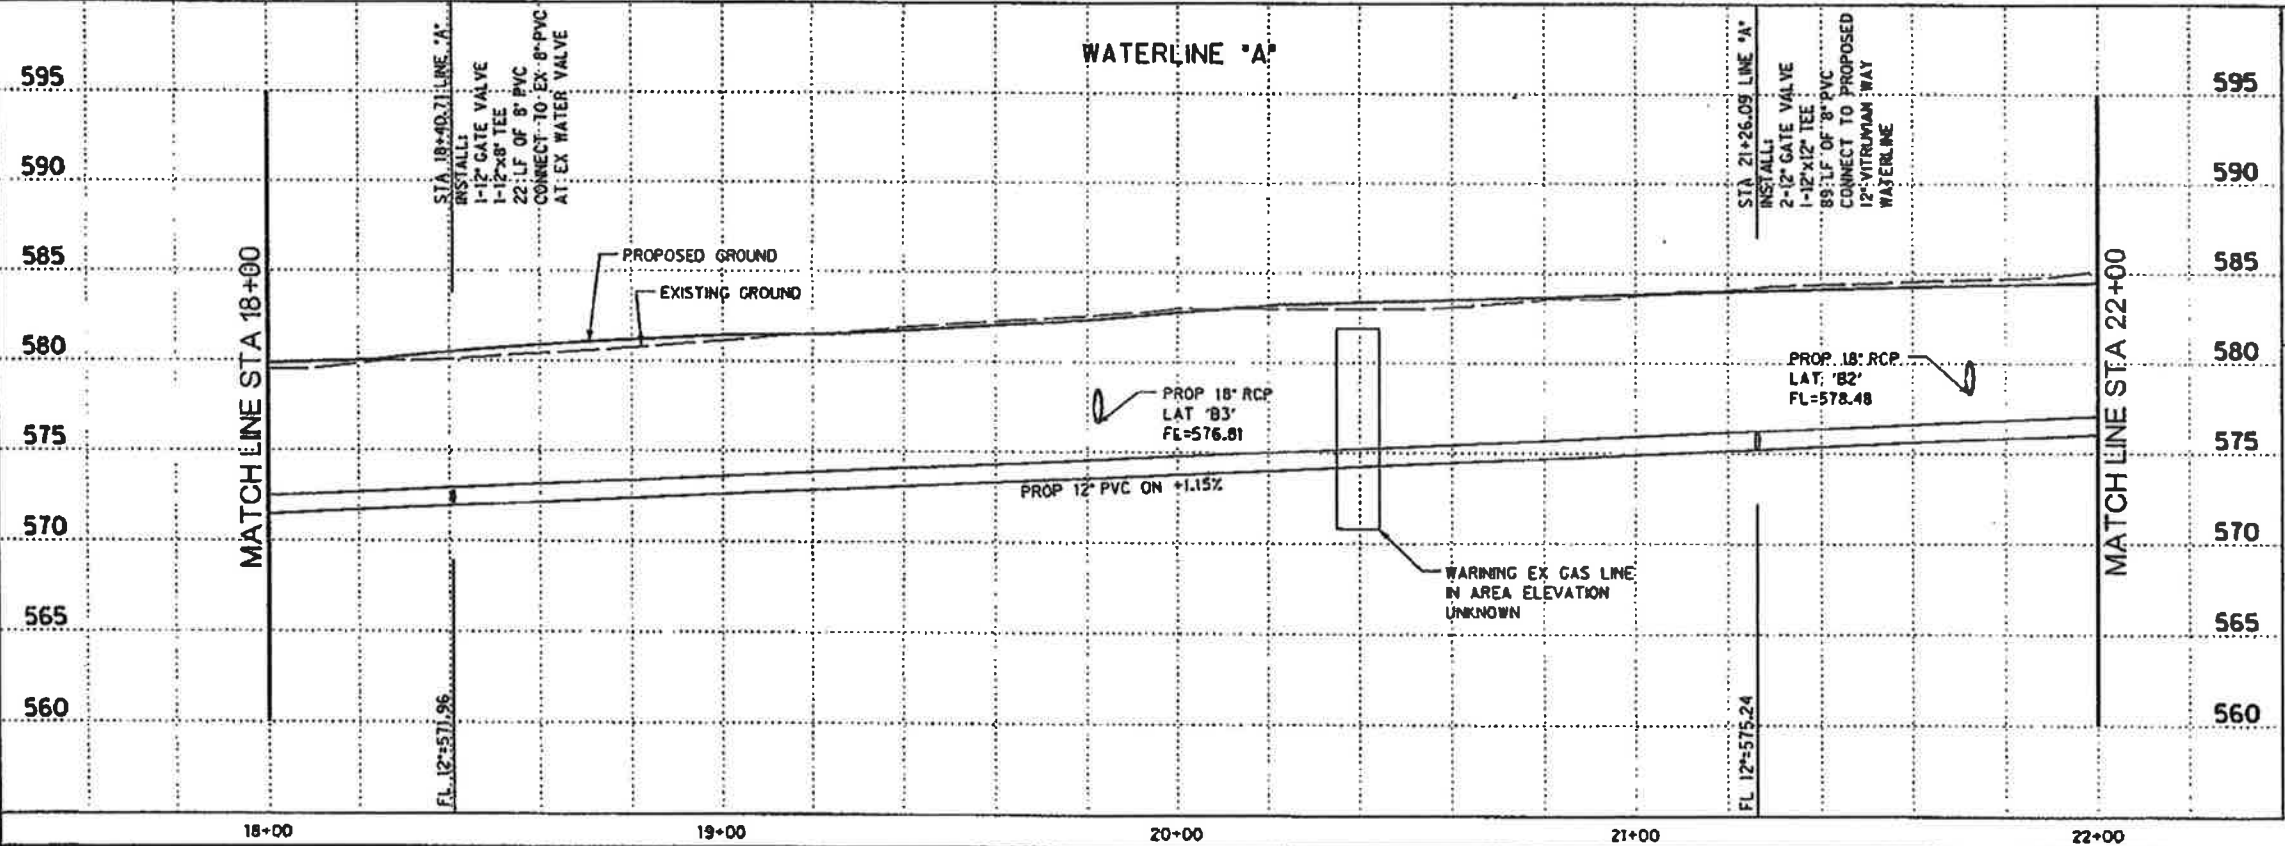

HALFF ASSOCIATES, INC.
 ENGINEERS - SURVEYORS - SCIENTISTS
 PRELIMINARY - FOR INTERIM REVIEW ONLY

These documents are for Interim Review and not intended for Construction, Bidding, or Permit Purposes. They were prepared by, or under the supervision of:

M.E. ROMANOWSKI
 56306
 PER
 AUGUST 2010
 DATE

NO.	REVISION	BY	DATE
TOWN OF ADDISON DALLAS COUNTY, TEXAS SPRING VALLEY ROAD WATER PLAN AND PROFILE STA 18+00 TO 22+00			
1301 NORTH BOWSER ROAD, RICHARDSON, TEXAS 75081-2276 TEL (972) 544-6200 FAX (972) 789-0086			
PROJECT	DESIGN	DRAWN	DATE
27530	XXX	XXX	AUGUST 2010
FILE	SHEET		
27530 UWTR 03	WTR-3		

