

USER: oh1299




OFFICE: RCH

PROJECT: 27530

FILE: 27530 UELE 01.dgn

TIME: 3:12:40 PM

DATE: 8/11/2010

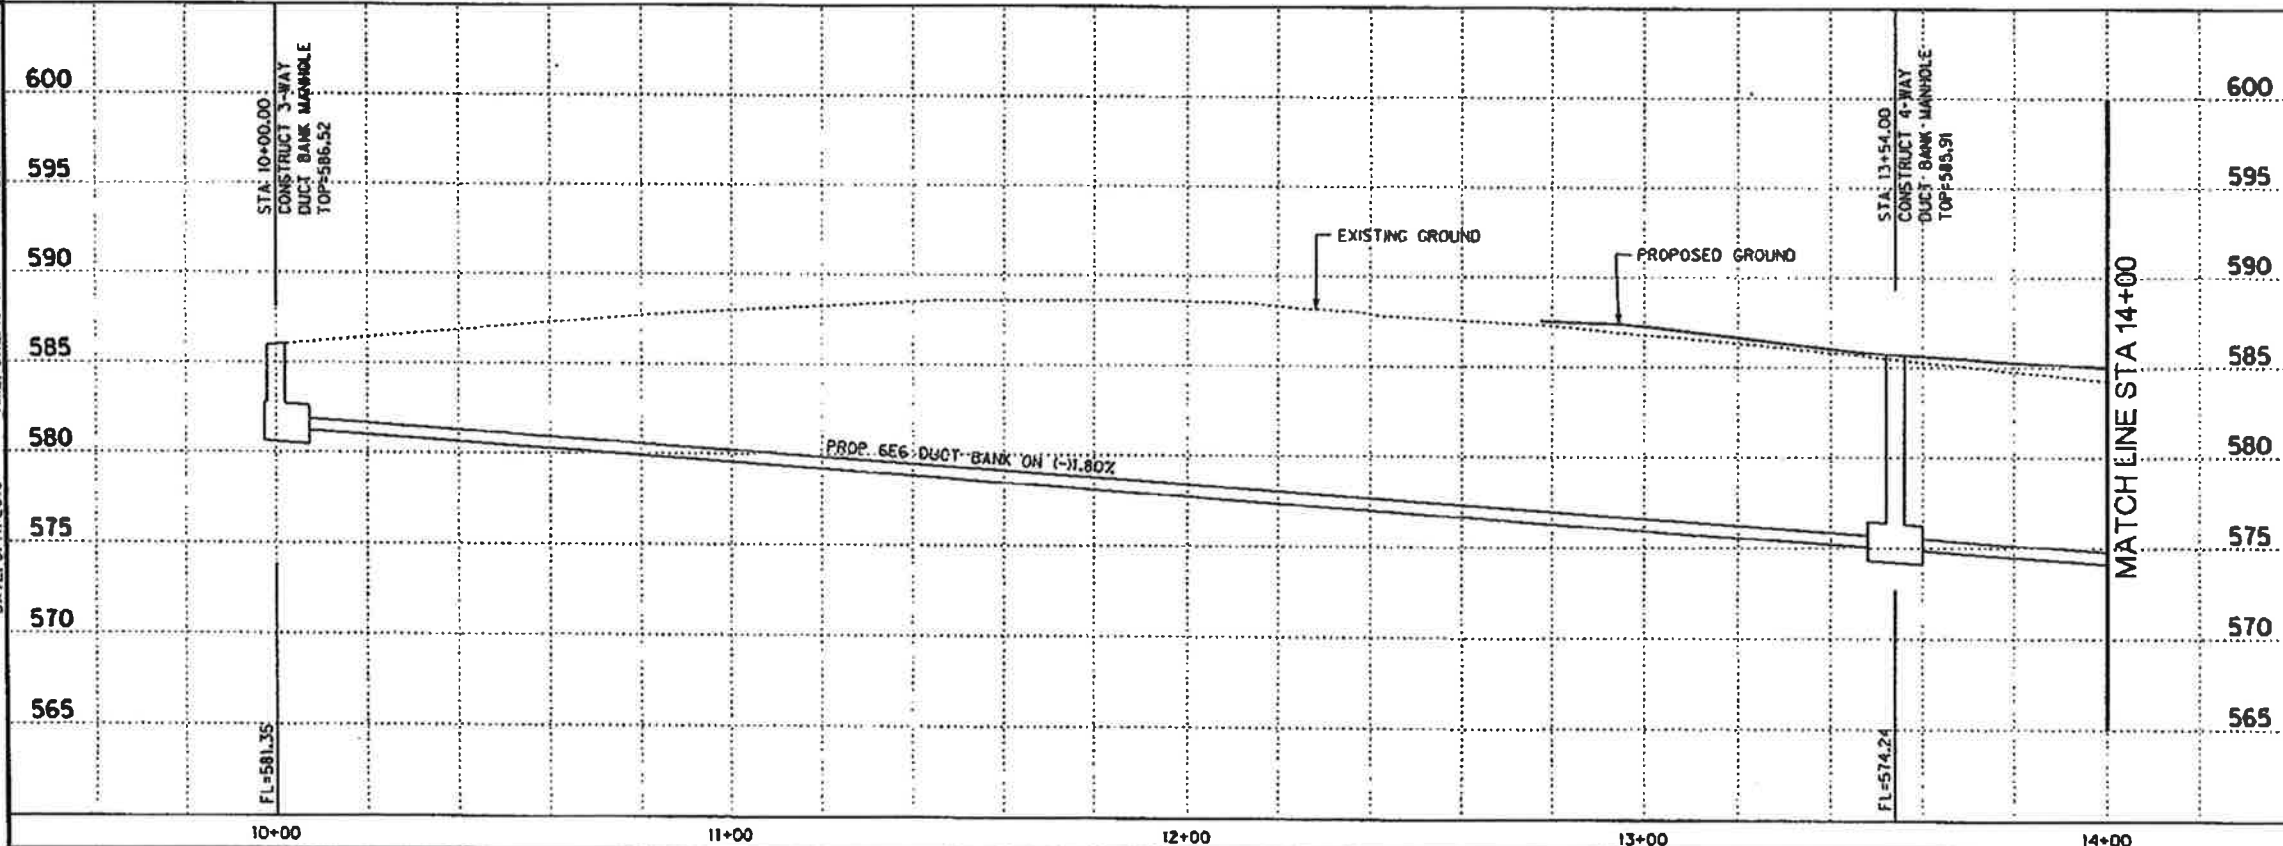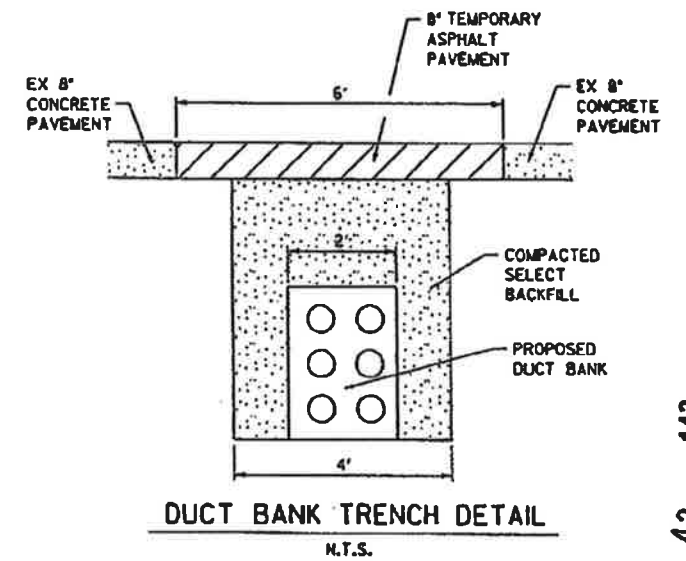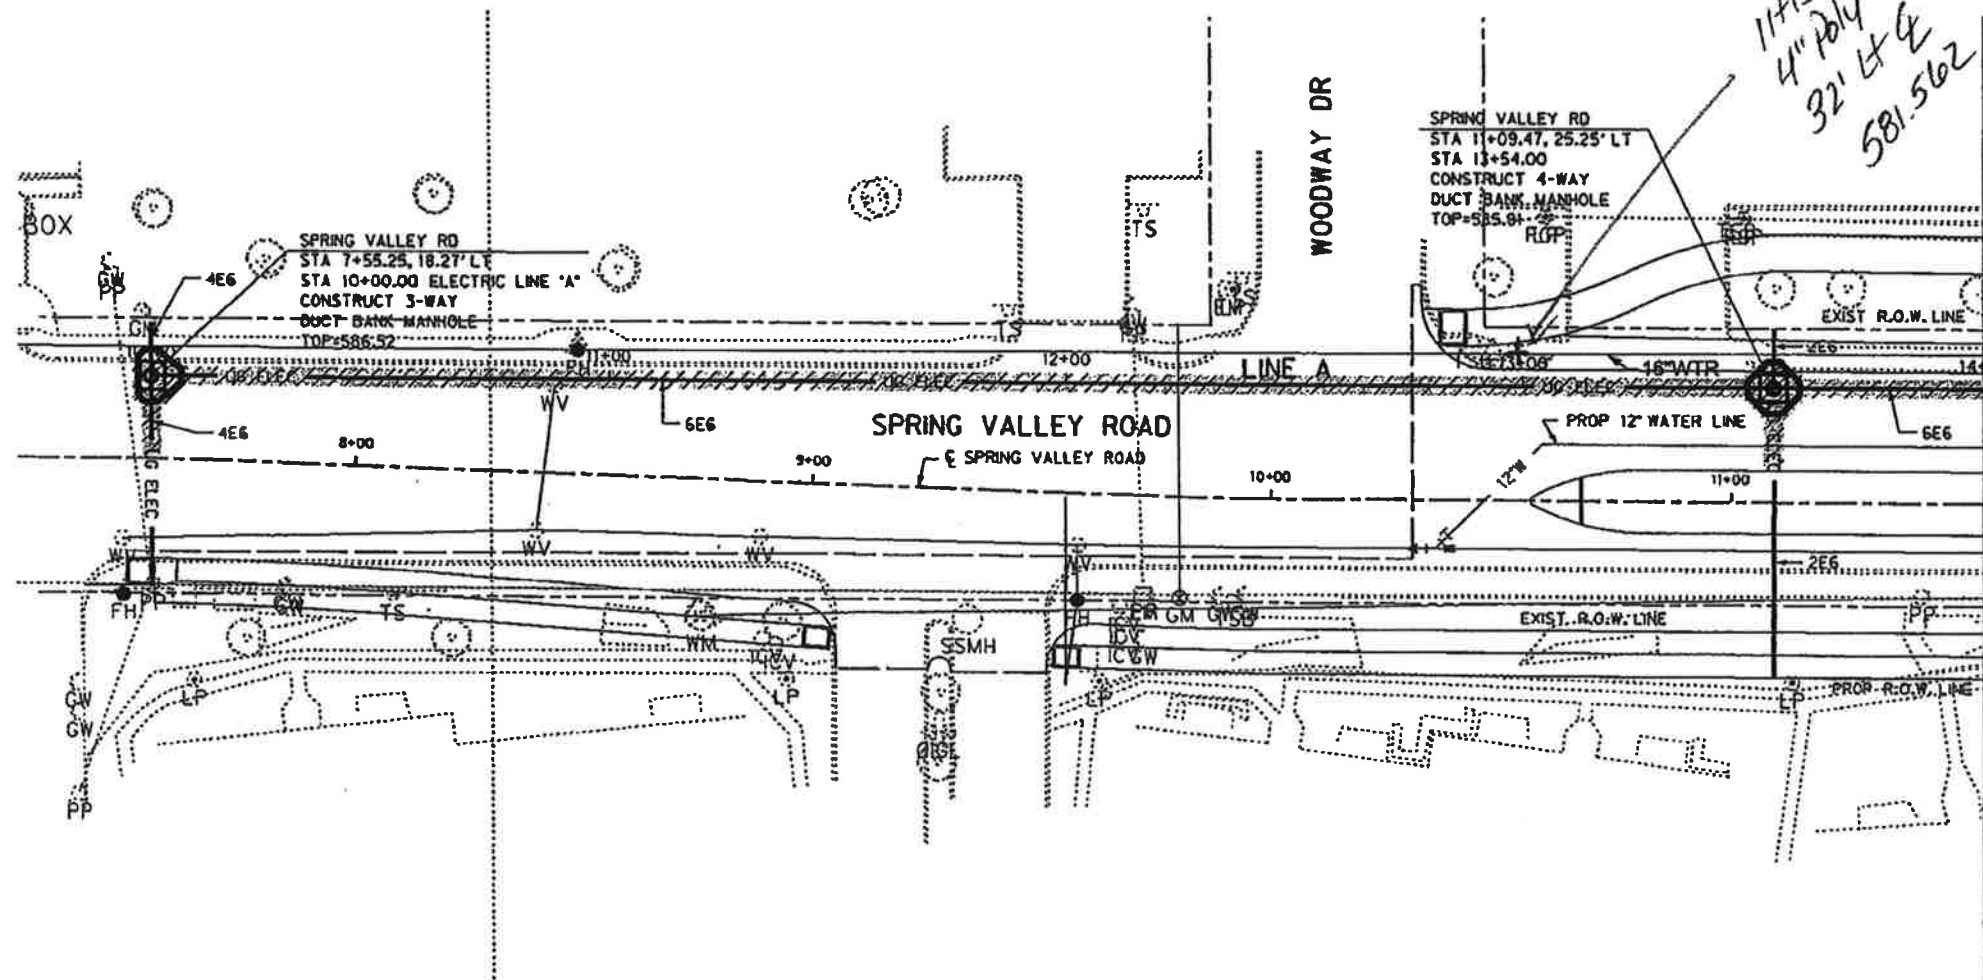

HALFF ASSOCIATES, INC.
ENGINEERS - SURVEYORS - SCIENTISTS
PRELIMINARY - FOR INTERM REVIEW ONLY

These documents are for Interim Review and not intended for Construction, Bidding, or Permit Purposes. They were prepared by, or under the supervision of:

M.E. ROMANOWSKI 56308 AUGUST 2010
PEF URS

NO.	REVISION	BY	DATE		
 TOWN OF ADDISON DALLAS COUNTY, TEXAS SPRING VALLEY ROAD DUCT BANK PLAN AND PROFILE STA 10+00 TO 14+00					
HALFF <small>1801 NORTH BOWSER ROAD, RICHARDSON, TEXAS 75081-3275 TEL (972) 948-8800 FAX (972) 726-0288</small>					
PROJECT	DESIGN	DRAWN	DATE	FILE	SHEET
27530	XXX	XXX	AUGUST 2010	27530 UELE 01	ELE-1