

USER: on1299

OFFICE: RCH

PROJECT #: 27530




FILE: 27530 UELE 02.dgn

TIME: 3:12:51 PM

DATE: 8/11/2010

MATCH LINE STA 14+00

MATCH LINE STA 18+00

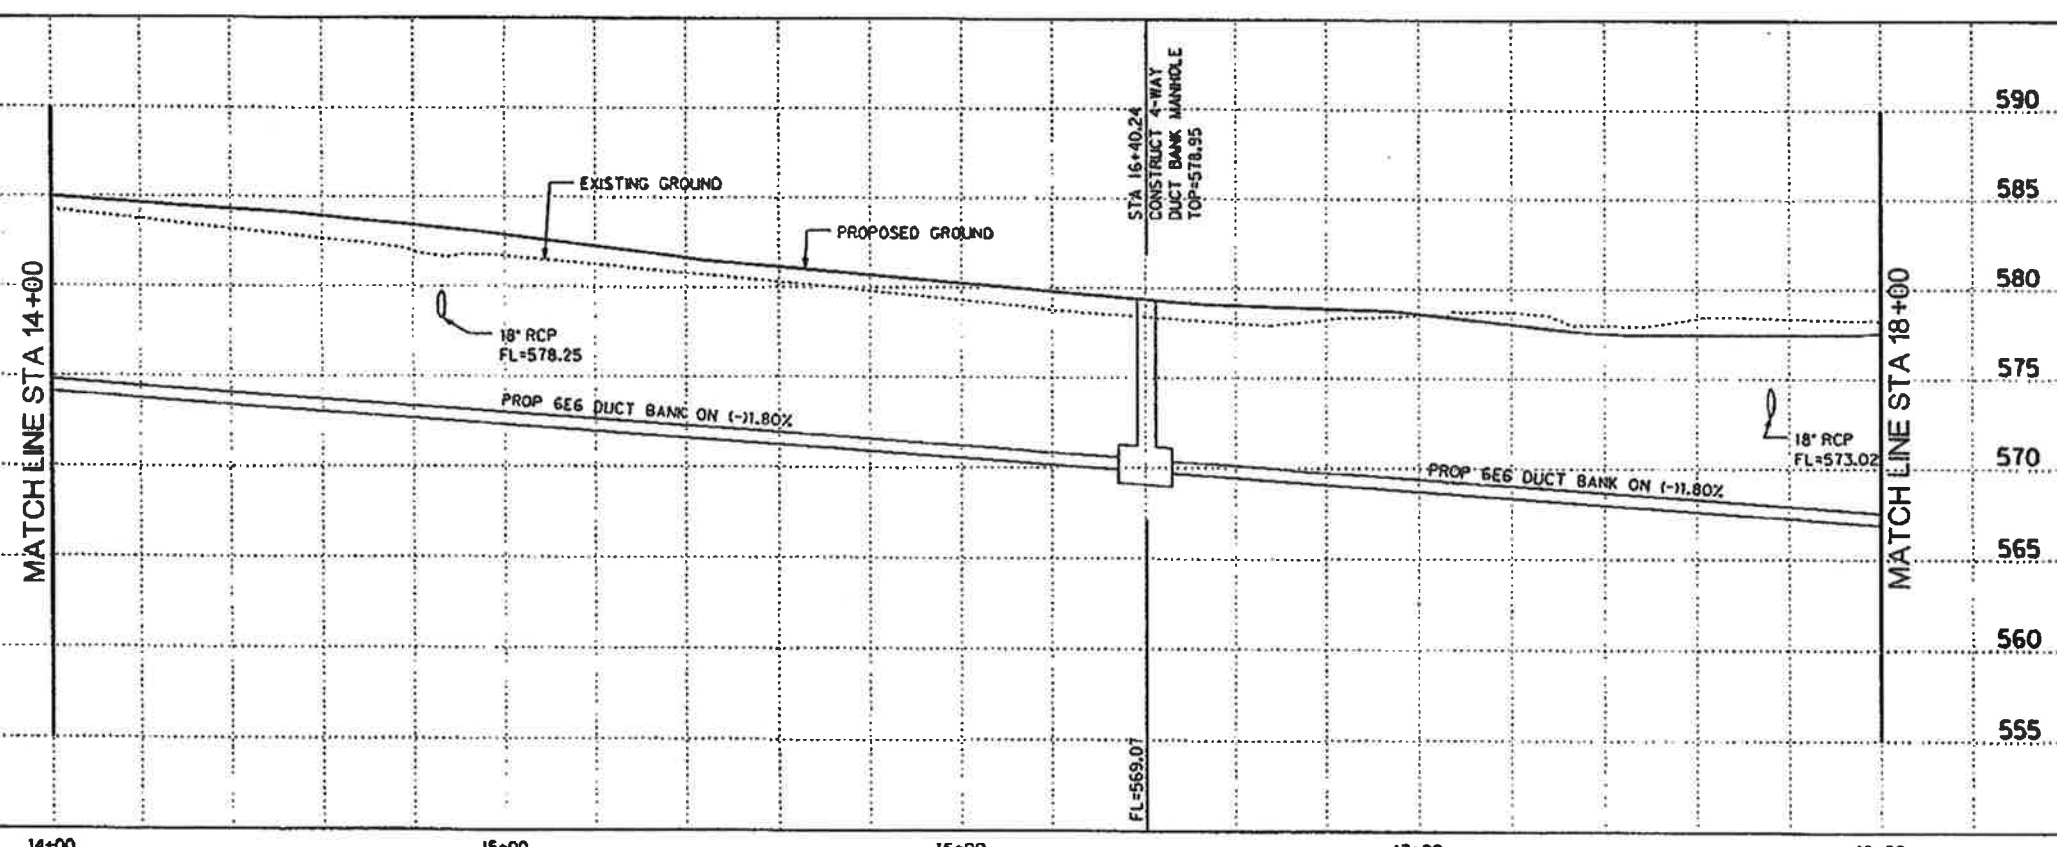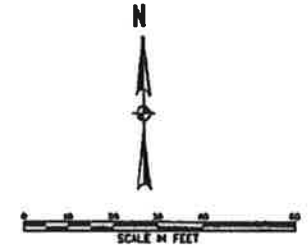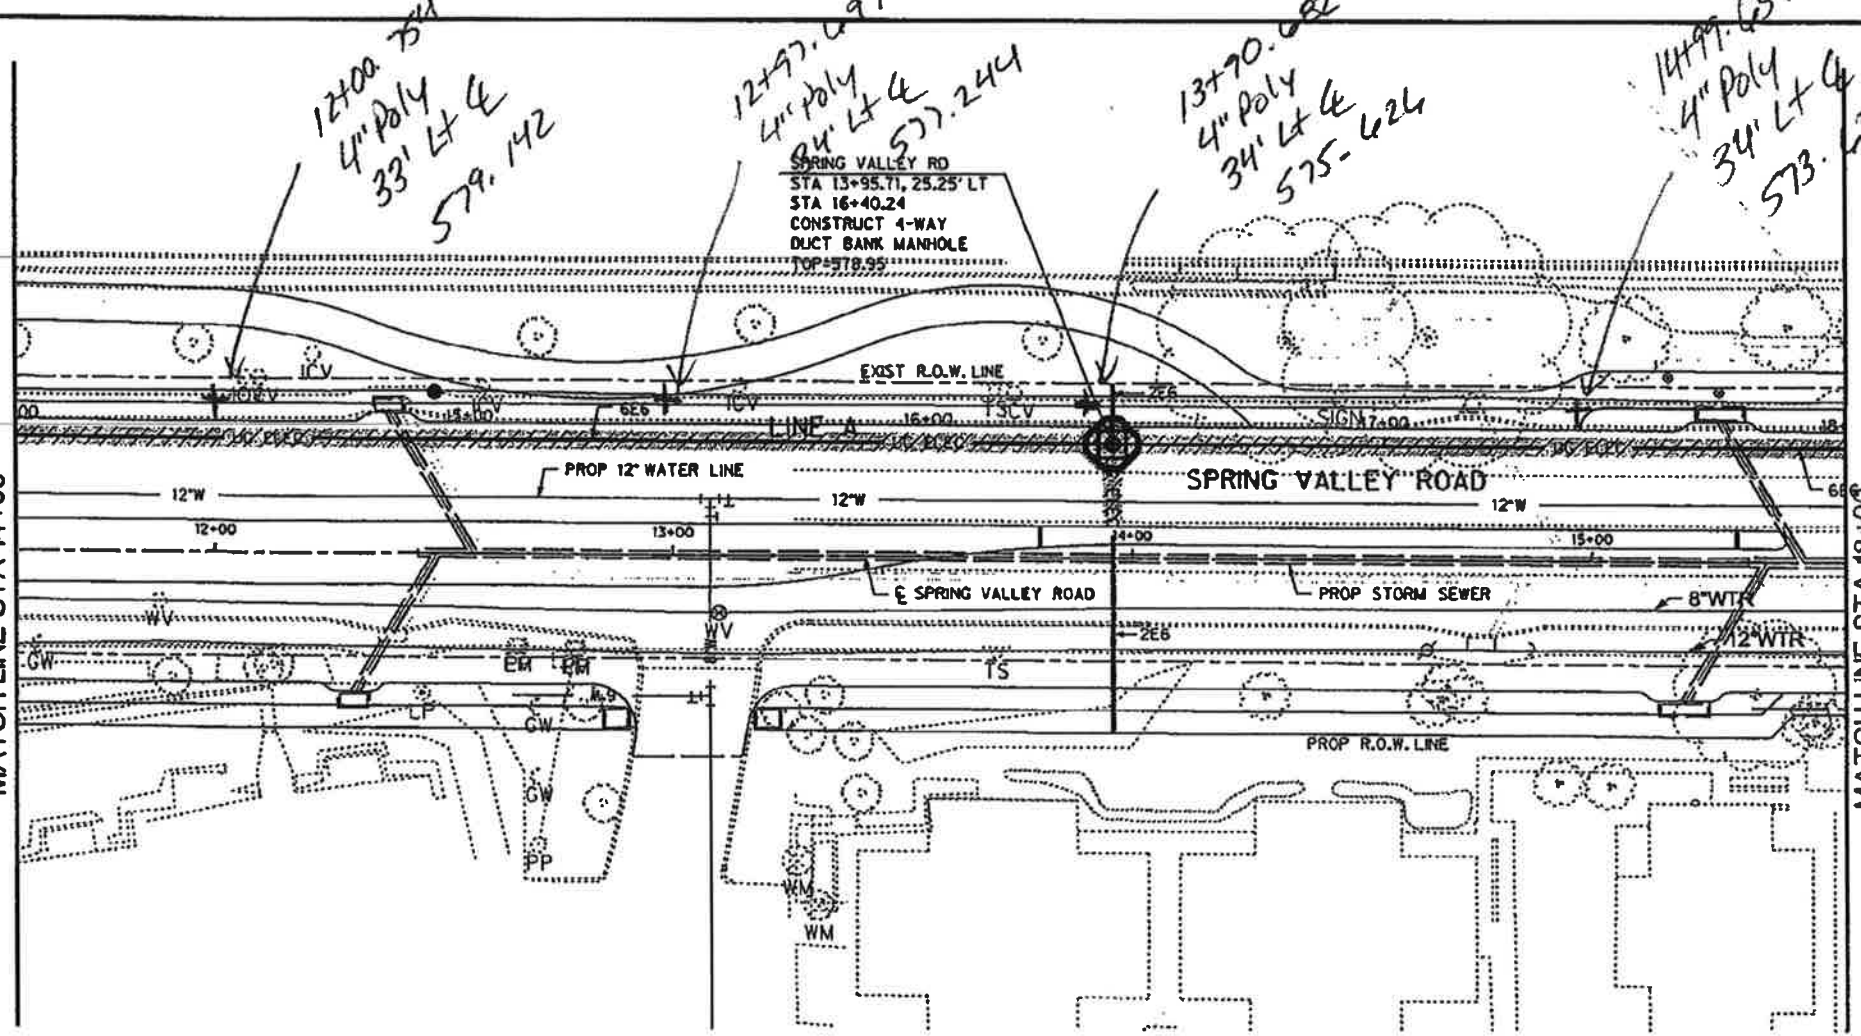

HALFF ASSOCIATES, INC.
ENGINEERS - SURVEYORS - SCIENTISTS
PRELIMINARY - FOR INTERIM REVIEW ONLY

These documents are for Interim Review and not intended for Construction, Bidding, or Permit Purposes. They were prepared by, or under the supervision of:

M.E. ROMANOWSKI
56306 AUGUST 2010
PEM DBA

NO.	REVISION	BY	DATE
TOWN OF ADDISON DALLAS COUNTY, TEXAS SPRING VALLEY ROAD			
DUCT BANK PLAN AND PROFILE STA 14+00 TO 18+00			
HALFF <small>1301 NORTH BOWSER ROAD, RICHARDSON, TEXAS 75081-2072 TEL: (972) 944-8800 FAX: (972) 728-0808</small>			
PROJECT	DESIGN	DRAWN	DATE
27530	XXX	XXX	AUGUST 2010
FILE	SHEET		
27530 UELE 02	ELE-2		