

USER: oh1299


OFFICE: RCH

PROJECT: 27530

FILE: 27530 UELE 03.dgn



TIME: 3:13:02 PM

DATE: 8/11/2010

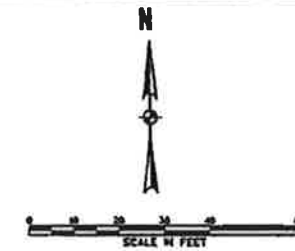

MATCH LINE STA 18+00

MATCH LINE STA 22+00

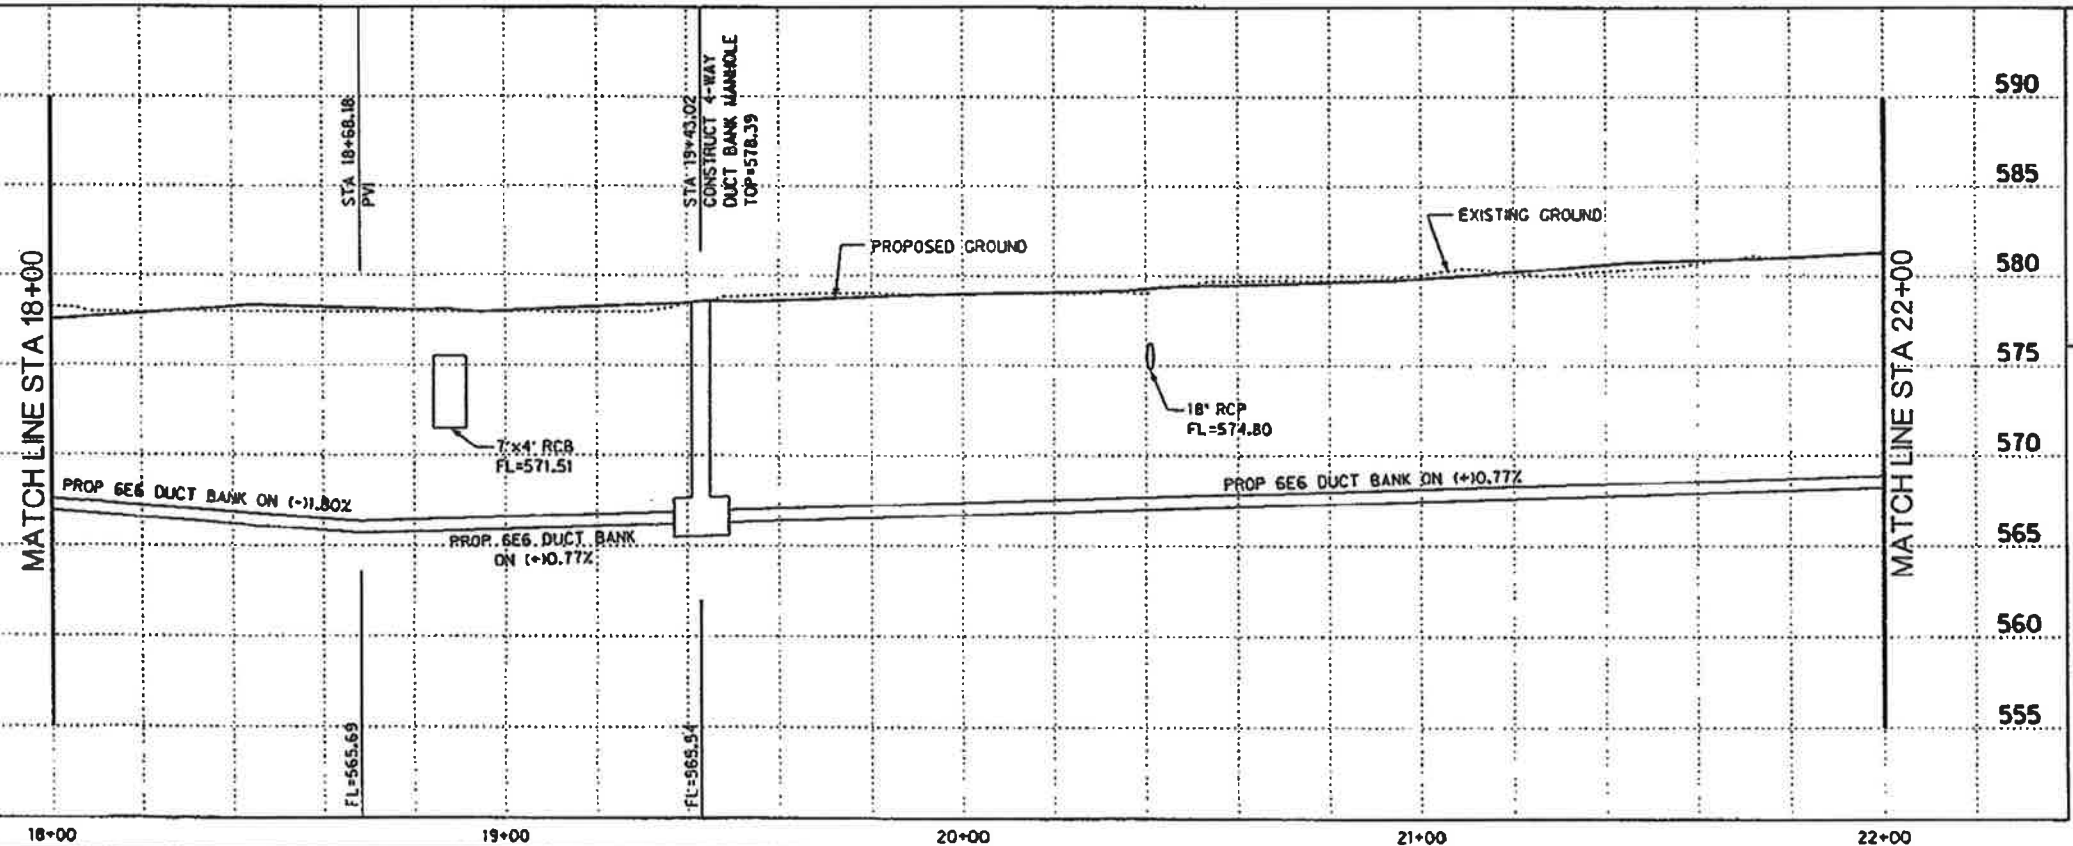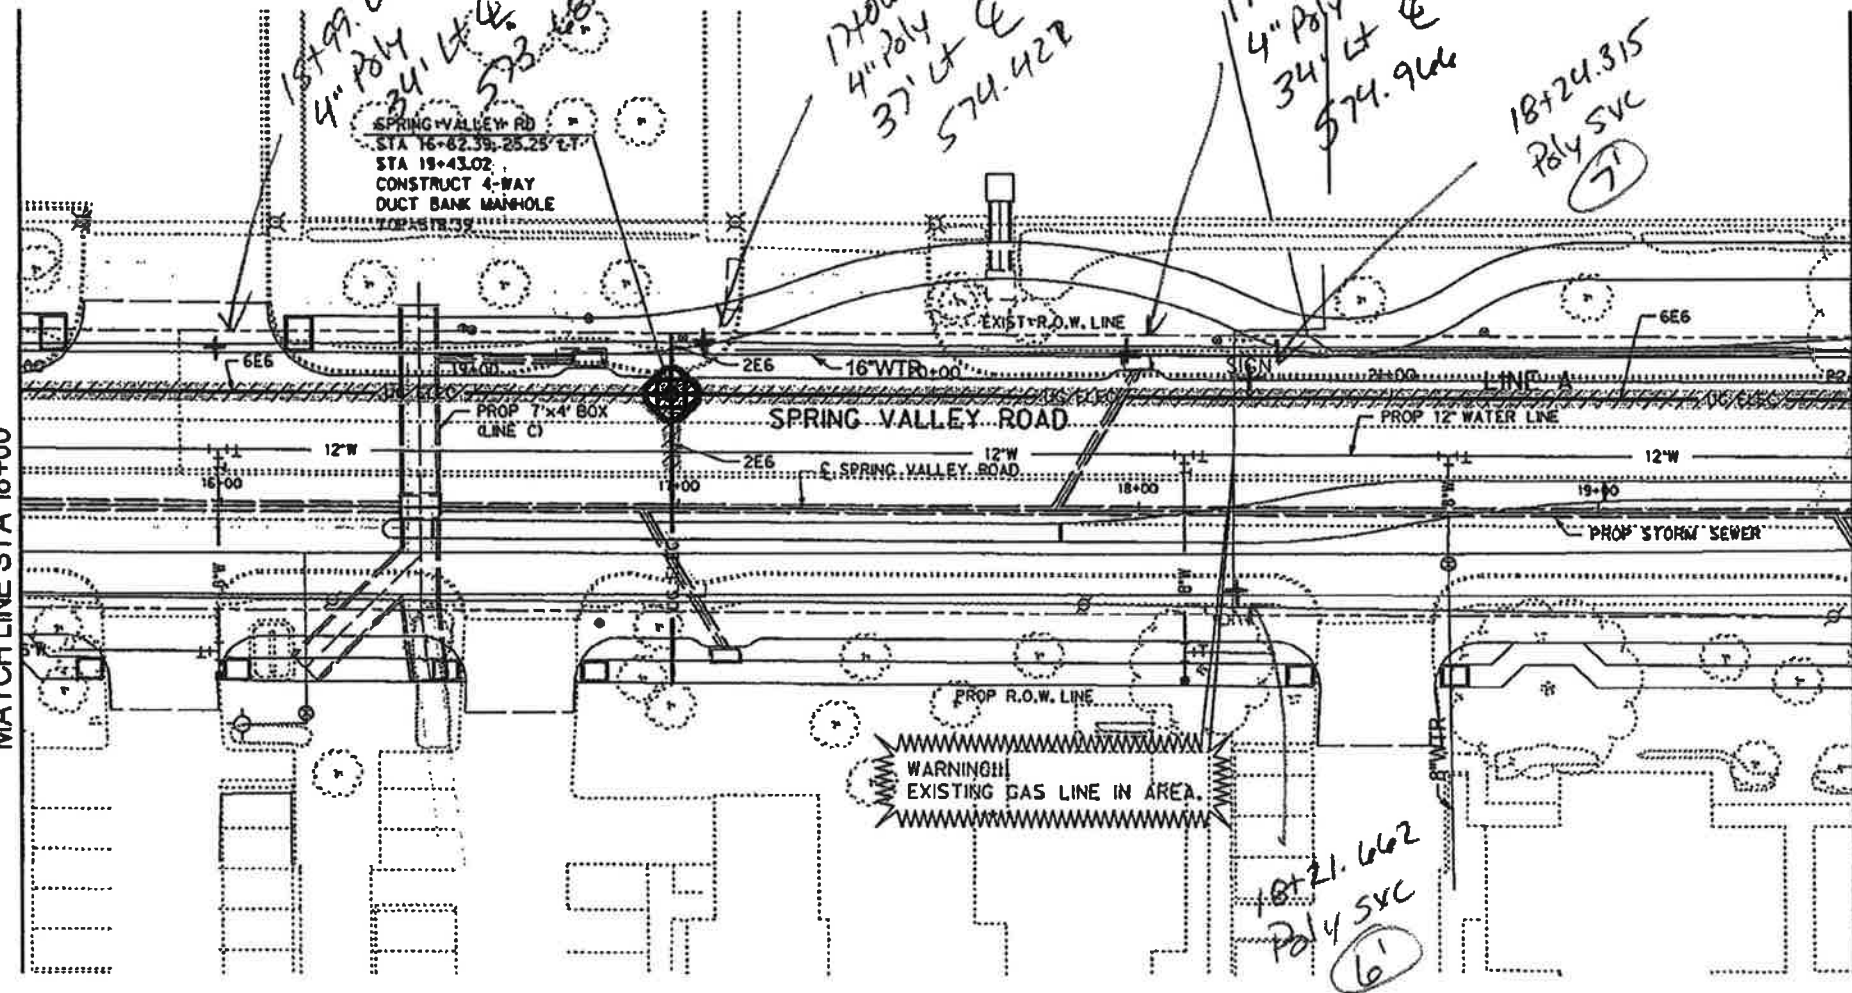

HALFF ASSOCIATES, INC.
 ENGINEERS - SURVEYORS - SCIENTISTS
 PRELIMINARY - FOR INTERM REVIEW ONLY

These documents are for Interim Review and not intended for Construction, Bidding, or Permit Purposes. They were prepared by, or under the supervision of:

M.E. ROMANOWSKI 56306 AUGUST 2010
 PEW DGB

NO.	REVISION	BY	DATE
 TOWN OF ADDISON DALLAS COUNTY, TEXAS SPRING VALLEY ROAD			
DUCT BANK PLAN AND PROFILE STA 18+00 TO 22+00			
PROJECT	DESIGN	DRAWN	DATE
27530	XXX	XXX	AUGUST 2010
FILE	SHEET		
27530 UELE 03	ELE-3		