

USER: oht299



OFFICE: RCH

PROJECT: 27530

FILE: 27530 STM 02.dgn

TIME: 3:10:15 PM

DATE: 8/11/2010

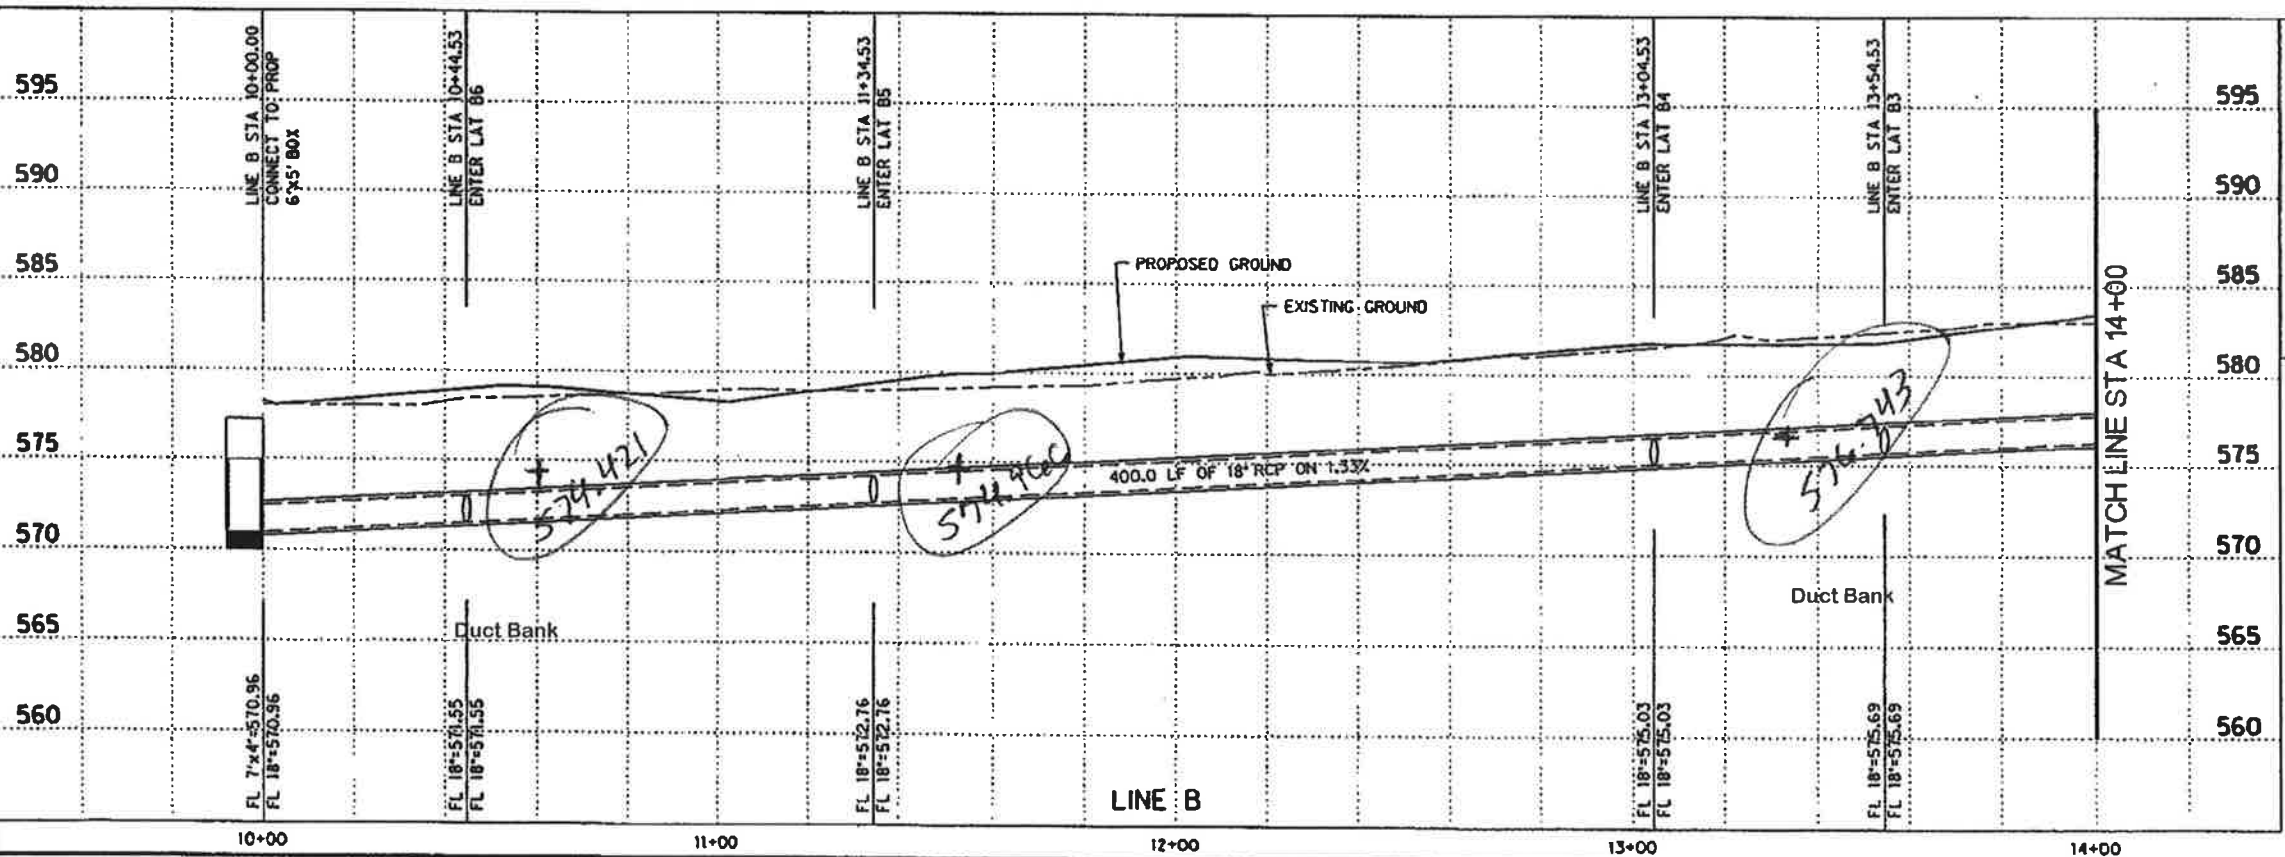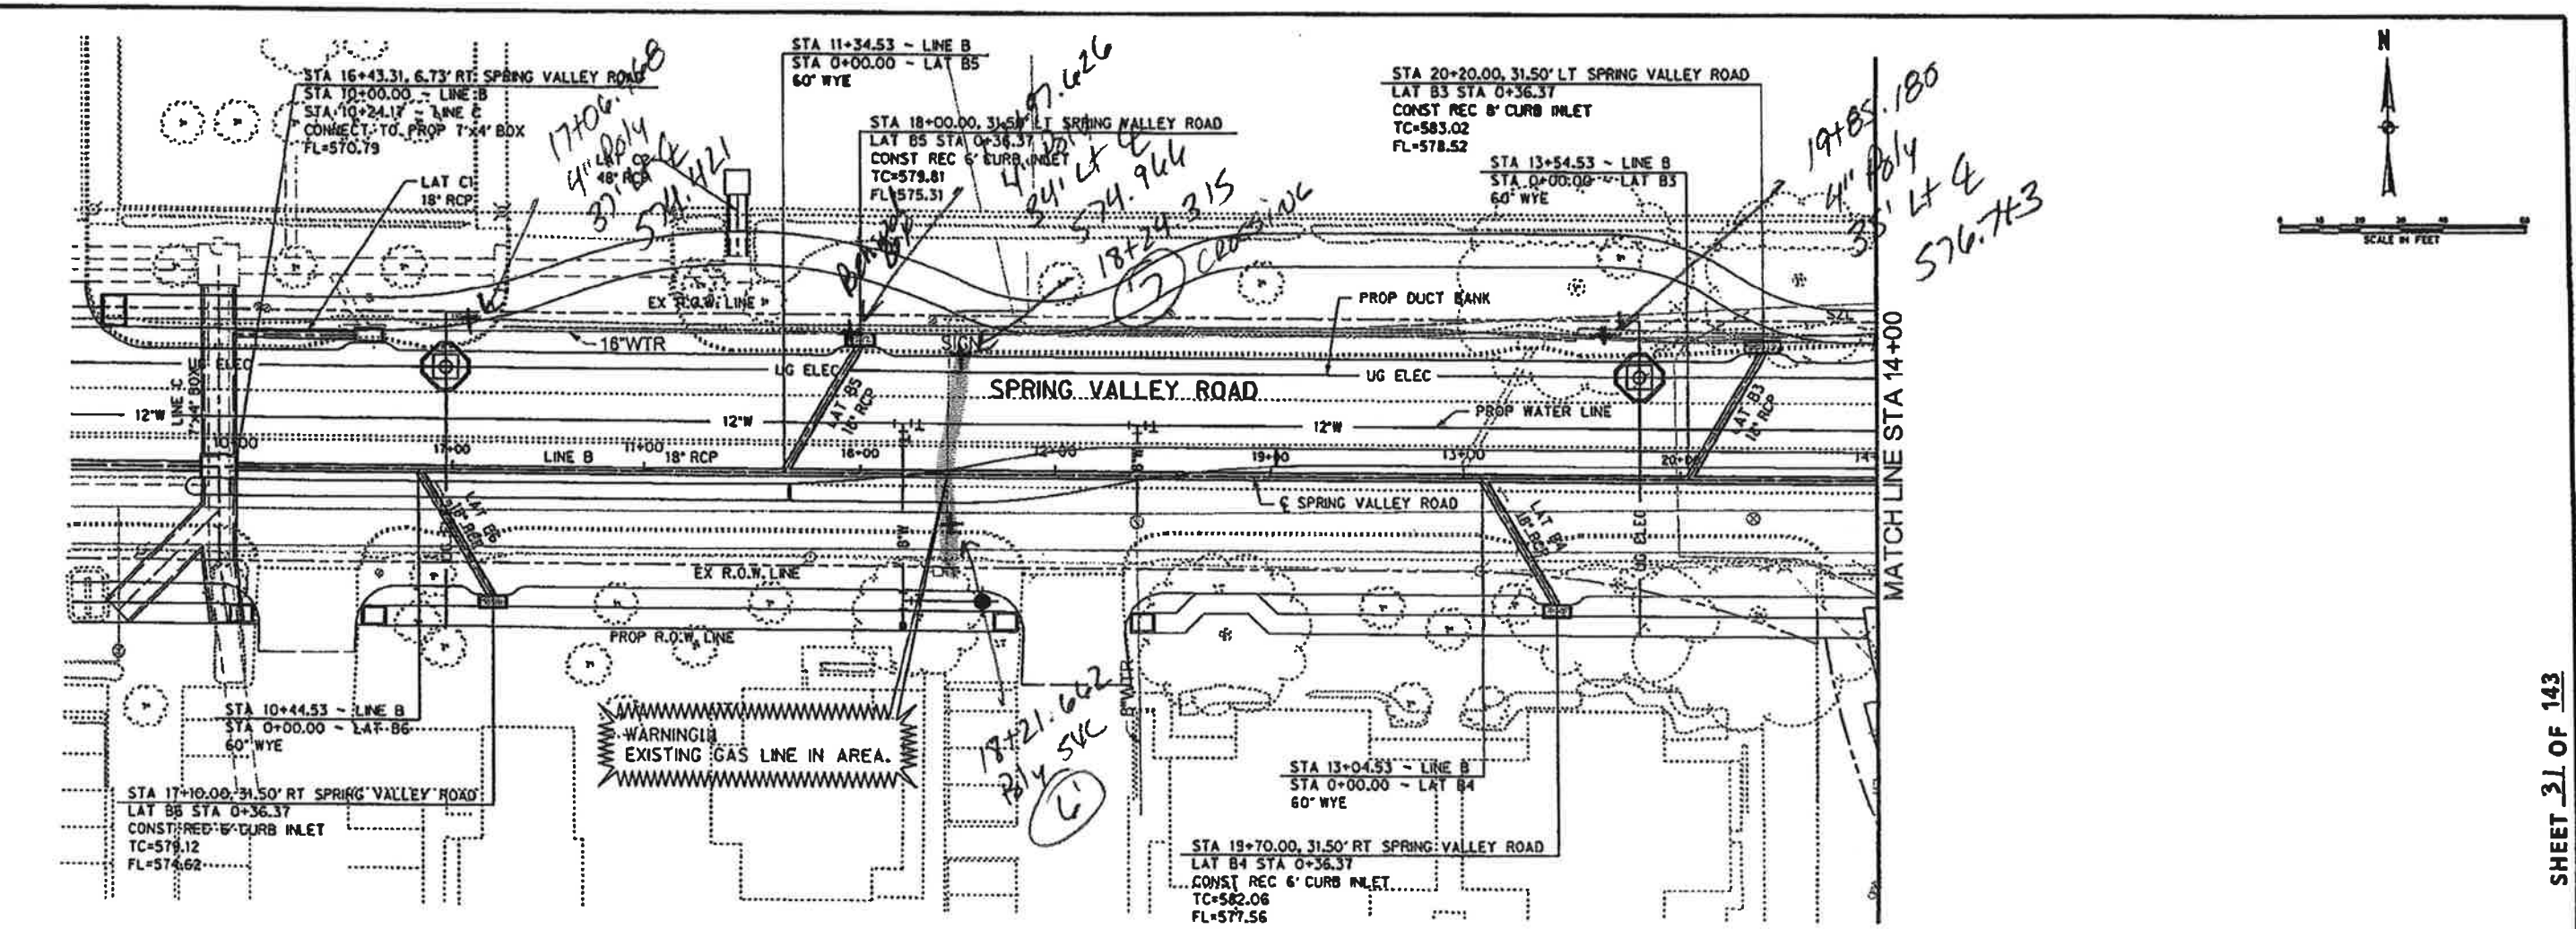

HALFF ASSOCIATES, INC.
ENGINEERS - SURVEYORS - SCIENTISTS
PRELIMINARY - FOR INTERIM REVIEW ONLY

These documents are for Interim Review and not intended for Construction, Bidding, or Permit Purposes. They were prepared by, or under the supervision of:

M.E. ROMANOWSKI 66306 AUGUST 2010
PE# Data

NO.	REVISION	BY	DATE
TOWN OF ADDISON DALLAS COUNTY, TEXAS SPRING VALLEY ROAD STORM DRAIN PLAN & PROFILE LINE B STA 10+00 TO 14+00			
1301 NORTH BOWSER ROAD, RICHARDSON, TEXAS 75081-2278 TEL: (972) 344-8888 FAX: (972) 738-8888			
PROJECT	DESIGN	DRAWN	DATE
27530	XXX	XXX	AUGUST 2010
FILE	SHEET		
27530 STM 02	STM-2		