

**PLANS FOR THE CONSTRUCTION OF
 SPRING VALLEY ROAD WIDENING
 FROM WOODWAY TO VITRUVIAN WAY
 INCLUDING PLANS FOR VITRUVIAN PARK PUBLIC
 INFRASTRUCTURE PHASE 1E**

**PUBLIC WORKS # 2010-05
 AND
 PUBLIC WORKS # 2010-02
 OCTOBER 2010**



JOE CHOW
MAYOR


ROGER MELLOW
NEIL RESNIK
BLAKE CLEMENS
DON DASEKE
KIMBERLY LAY
BIANCA NOBLE
 COUNCIL MEMBERS

RON WHITEHEAD
CITY MANAGER

NANCY CLINE, P.E.
DIRECTOR OF PUBLIC WORKS

CLAY BARNETT, P.E.
TOWN ENGINEER

LEA DUNN
DEPUTY CITY MANAGER

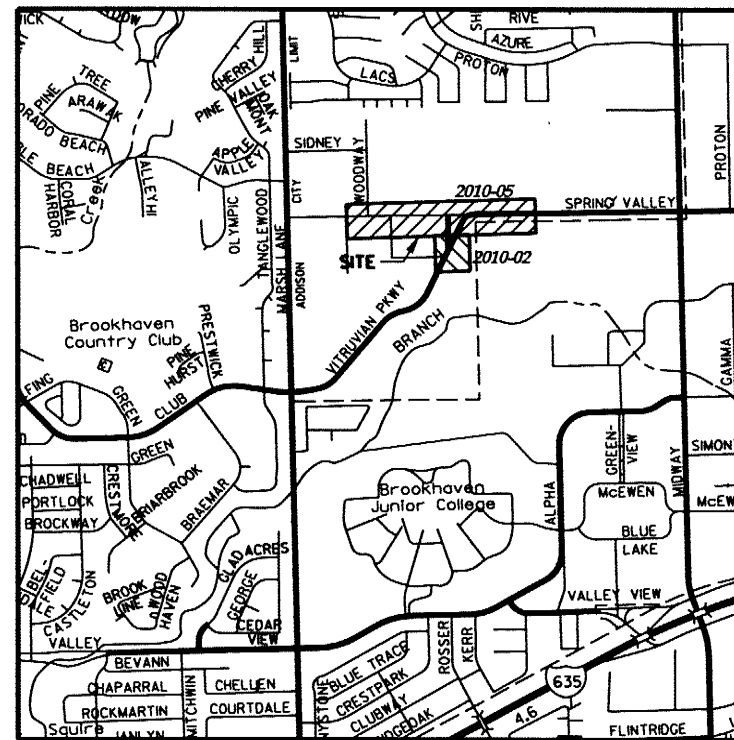

VICINITY MAP
NOT TO SCALE



1201 NORTH BOWSER ROAD
 RICHARDSON, TEXAS 75081-2275
 TEL (214) 346-6200
 FAX (214) 739-0095

USER: dh1299
OFFICE: RCH
PROJECT #: 27530
FILE: 27530 INDX 01.dgn
TIME: 10:04:09 AM
DATE: 12/7/2011

SPRING VALLEY ROAD

SEQ.	NO.	NAME
1	-	Cover Sheet - Spring Valley Road
2	INDEX	Index of Sheets
3	GN-1	General Notes
4	TS-1	Typical Sections
5	SC-1	Survey Control
6	RM-1	Removal Plan (Sheet 1 of 2)
7	RM-2	Removal Plan (Sheet 2 of 2)
8	DT-RD	Removal Details
9-12	HC-1 - HC-4	Horizontal Control Sheet
13	P1	Paving Plan and Profile (Sheet 1 of 5)
14	P2	Paving Plan and Profile (Sheet 2 of 5)
15	P3	Paving Plan and Profile (Sheet 3 of 5)
16	P4	Paving Plan and Profile (Sheet 4 of 5)
17	P5	Paving Plan and Profile (Sheet 5 of 5)
18	DP-1	Driveway Plan and Profile (Sheet 1 of 4)
19	DP-2	Driveway Plan and Profile (Sheet 2 of 4)
20	DP-3	Driveway Plan and Profile (Sheet 3 of 4)
21	DP-4	Driveway Plan and Profile (Sheet 4 of 4)
22	DT-P1	Pavement Details
23	DT-P2	Pavement Details
24	GP1	Grading Plan at Vitruvian Way
25	PM1	Striping & Signage Layout (Sheet 1 of 5)
26	PM2	Striping & Signage Layout (Sheet 2 of 5)
27	PM3	Striping & Signage Layout (Sheet 3 of 5)
28	PM4	Striping & Signage Layout (Sheet 4 of 5)
29	PM5	Striping & Signage Layout (Sheet 5 of 5)
30	DT-PM	Pavement Marking Details
31	DAM-1	Overall Drainage Area Map
32	DAM-2	Drainage Area Map
33	DAC-1	Hydraulic Computations (Sheet 1 of 4)
34	DAC-2	Hydraulic Computations (Sheet 2 of 4)
35	DAC-3	Hydraulic Computations (Sheet 3 of 4)
36	DAC-4	Hydraulic Computations (Sheet 4 of 4)
37	STM-1	Storm Drain Line "A" Plan and Profile
38	STM-2	Storm Drain Line "B" Plan and Profile (Sheet 1 of 2)
39	STM-3	Storm Drain Line "B" Plan and Profile (Sheet 2 of 2)
40	STM-4	Storm Drain Line "C" Plan and Profile
41	STM-5	Storm Drain Laterals
42	WTR-1	Water Line "A" Plan and Profile (Sheet 1 of 4)
43	WTR-2	Water Line "A" Plan and Profile (Sheet 2 of 4)
44	WTR-3	Water Line "A" Plan and Profile (Sheet 3 of 4)
45	WTR-4	Water Line "A" Plan and Profile (Sheet 4 of 4)
46	DT-W	Water Details
47	IP-1	Light Fixture Layout (Sheet 1 of 2)
48	IP-2	Light Fixture Layout (Sheet 3 of 2)
49	IP-3	Illumination Plan
50	ELE-1	ONCOR Duct Bank Plan and Profile (Sheet 1 of 4)
51	ELE-2	ONCOR Duct Bank Plan and Profile (Sheet 2 of 4)
52	ELE-3	ONCOR Duct Bank Plan and Profile (Sheet 3 of 4)
53	ELE-4	ONCOR Duct Bank Plan and Profile (Sheet 4 of 4)
54	ELE-5	Duct Bank Laterals
55	TS-1	Traffic Signal General Notes
56	TS-2	Traffic Signal Plan (Sheet 1 of 2)
57	TS-3	Traffic Signal Plan (Sheet 2 of 2)
58	TCP-00	Traffic Control Narrative

INDEX OF SHEETS

SPRING VALLEY ROAD

SEQ.	NO.	NAME
59	TCP-01	Traffic Control Plan - Phase 1A
60	TCP-02	Traffic Control Plan - Phase 1B (Sheet 1 of 6)
61	TCP-03	Traffic Control Plan - Phase 1B (Sheet 2 of 6)
62	TCP-04	Traffic Control Plan - Phase 1B (Sheet 3 of 6)
63	TCP-05	Traffic Control Plan - Phase 1B (Sheet 4 of 6)
64	TCP-06	Traffic Control Plan - Phase 1B (Sheet 5 of 6)
65	TCP-07	Traffic Control Plan - Phase 1B (Sheet 6 of 6)
66	TCP-08	Traffic Control Plan - Phase 2 (Sheet 1 of 6)
67	TCP-09	Traffic Control Plan - Phase 2 (Sheet 2 of 6)
68	TCP-10	Traffic Control Plan - Phase 2 (Sheet 3 of 6)
69	TCP-11	Traffic Control Plan - Phase 2 (Sheet 4 of 6)
70	TCP-12	Traffic Control Plan - Phase 2 (Sheet 5 of 6)
71	TCP-13	Traffic Control Plan - Phase 2 (Sheet 6 of 6)
72	TCP-14	Traffic Control Plan - Phase 3A (Sheet 1 of 2)
73	TCP-15	Traffic Control Plan - Phase 3A (Sheet 2 of 2)
74	TCP-16	Traffic Control Plan - Phase 3B (Sheet 1 of 6)
75	TCP-17	Traffic Control Plan - Phase 3B (Sheet 2 of 6)
76	TCP-18	Traffic Control Plan - Phase 3B (Sheet 3 of 6)
77	TCP-19	Traffic Control Plan - Phase 3B (Sheet 4 of 6)
78	TCP-20	Traffic Control Plan - Phase 3B (Sheet 5 of 6)
79	TCP-21	Traffic Control Plan - Phase 3B (Sheet 6 of 6)
80	EC-1	Erosion Control Plan (Sheet 1 of 2)
81	EC-2	Erosion Control Plan (Sheet 2 of 2)
82	DT-EC	Erosion Control Details
83	XS-1	Cross Sections (Sheet 1 of 10)
84	XS-2	Cross Sections (Sheet 2 of 10)
85	XS-3	Cross Sections (Sheet 3 of 10)
86	XS-4	Cross Sections (Sheet 4 of 10)
87	XS-5	Cross Sections (Sheet 5 of 10)
88	XS-6	Cross Sections (Sheet 6 of 10)
89	XS-7	Cross Sections (Sheet 7 of 10)
90	XS-8	Cross Sections (Sheet 8 of 10)
91	XS-9	Cross Sections (Sheet 9 of 10)
92	XS-10	Cross Sections (Sheet 10 of 10)

LANDSCAPE & IRRIGATION

93	LP 1.1	Landscape Plan (Sheet 1 of 2)
94	LP 1.2	Landscape Plan (Sheet 2 of 2)
95	LP 2.1	Landscape Details (Sheet 1 of 2)
96	LP 2.2	Landscape Details (Sheet 2 of 2)
97	LI 1.1	Irrigation Plan (Sheet 1 of 2)
98	LI 1.2	Irrigation Plan (Sheet 2 of 2)
99	LI 1.3	Irrigation Details
100	LI 1.4	Irrigation Specifications

VITRUVIAN WAY

SEQ.	NO.	NAME
101	CS	Cover Sheet - Vitruvian Way
102	1	Overall Plan & Project Control
103	2	General Construction Notes, Legend & Abbreviations
104	3	Demolition Plan
105	4	Overall Paving Plan & Notes
106	5	Paving Plan Profile
107	6	Pavement Sections
108	7	Paving Details (Sheet 1 of 2) *
109	8	Paving Details (Sheet 2 of 2) *
110	9	Drainage Area Map & Calculations
111	10	Storm Drain Plan & Profile

VITRUVIAN WAY

SEQ.	NO.	NAME
112	11	Storm Drain Details *
113	12	Storm Drain Details & General Notes *
114	13	Pavement Marking & Signage Plan
115	14	Pavement Marking & Signage Details *
116	15	Street Light & Conduit Plan
117	16	Street Light Details *
118	17	Electrical Details - Conduit (TxDOT) *
119	18	Electrical Details - Conductors (TxDOT) *
120	19	Electrical Details - Ground Boxes (TxDOT) *
121	20	Overall Water & Sewer Layout General Notes
122	21	Water Line Plan & Profile
123	22	Water Line Crossing Profiles
124	23	Water Details (Sheet 1 of 2) *
125	24	Water Details (Sheet 2 of 2) *
126	25	Sanitary Sewer Plan & Profile
127	26	Sanitary Sewer Details
128	27	Overall Duct Bank Layout & Notes
129	28	Duct Bank Plan & Profile
130	29	Duct Bank Crossing Profiles
131	30	Electrical Duct Bank Details *
132	31	Erosion & Sediment Control Plan
133	32	Erosion & Sediment Control Details
134	5.01	Planting Layout Plan
135	5.02	Planting Details & Notes
136	6.01	Irrigation Layout Plan
137	6.02	Irrigation Tree Layout Plan
138	6.03	Irrigation Details & Notes

STANDARDS (Apply to Both)

139	SCP-7	Single Box Culverts Precast, 7'-0" Span (TxDOT)
140	MH-M(MOD)	Manhole Type M (MOD) (TxDOT)
141	ED(4)-03	Electrical Details - Overhead (TxDOT)
142	ED(5)-03	Electrical Details - Service Enclosure & Notes (TxDOT)
143	ED(8)-03	Electrical Details - Pedestal Service Type PS (TxDOT)
144	RID(LUM1)-09	Roadway Illumination Details (Sheet 1 of 2)
145	RID(LUM2)-09	Roadway Illumination Details (Sheet 2 of 2)
146	TS-FD-99	Traffic Signal Pole Foundation (TxDOT)
147	SMA-80(1)-92	Single Mast Arm Assembly (DAL) (Sheet 1 of 2)
148	SMA-80(2)-92	Single Mast Arm Assembly (DAL) (Sheet 2 of 2)
149	MA-C-09	Mast Arm Connections (TxDOT)
150	MA-C(KSN)-96	Mast Arm Connections (TxDOT)
151	MA-D-07	Mast Arm Pole Details (DAL)
152	TS-CF-04	Traffic Signal Controller Cabinet Base and Pad
153	ED(7)-03	Electrical Details - Typ Traffic Signal System (TxDOT)
154		Traffic Signal and Pedestrian Head ID
155	VDZ-04	Video Detection Zone Placement (DAL)
156	WZ(BTS-1)-03	Traffic Signal Installation (TxDOT) (Sheet 1 of 2)
157	WZ(BTS-2)-03	Traffic Signal Installation (TxDOT) (Sheet 2 of 2)
158-159	BC(4-5)-07	Temporary Sign Details
160-163	BC(9-12)-07	Traffic Control Details

**VITRUVIAN WAY
SHEETS PROVIDED
SEPARATELY BY
ICOW ENGINEERING**

* Standard details apply to both projects

RECORD DOCUMENTS
December, 2011
These Record Documents have been prepared based upon information provided by North Texas Contracting, Inc. The Design Professional has not verified the accuracy and / or completeness of this information and shall not be responsible for any errors or omissions which may be incorporated herein as a result.

Design Consultant: Half Associates, Inc.
RECORD DRAWING SUBMITTAL



M.E. Romanowski
Signature of Registrant Date 12/8/2011

NO.	REVISION	BY	DATE
TOWN OF ADDISON DALLAS COUNTY, TEXAS SPRING VALLEY ROAD INDEX OF SHEETS			
HALFF 1201 NORTH BOWSER ROAD, RICHARDSON, TEXAS 75081-2275 TEL (214) 348-8200 FAX (214) 738-0095			
PROJECT	DESIGN	DRAWN	DATE
27530	MPB	TMM	OCTOBER 2010
FILE	SHEET		
27530 INDX 01	INDEX		

SHEET 2 OF 163
RECORD DRAWINGS

GENERAL NOTES



1. All work shall conform to the requirements of the Town of Addison and shall be in accordance with the Town of Addison standard details and specifications for construction. All work not covered in the contract documents and the Town of Addison standard details and specifications for construction shall be governed by the North Central Texas Council of Governments Standard Specifications for Public Works Construction, Fourth Edition, dated 2004, including all amendments.
2. Existing utility locations shown are generally schematic in nature and may not accurately reflect the size and location of each particular utility. Existing utilities shown have been based on available record drawings and surface appurtenance field ties only. Some utility lines and surface locations may not be shown. The contractor shall assume responsibility for actual field location and protection of existing utilities whether shown or not. The Contractor shall also assume responsibility for repairs to existing utilities whether shown or not, damaged by the Contractor's activities. Differences in horizontal or vertical location of existing utilities shall not be basis for additional compensation to the Contractor.
3. The Contractor shall protect existing property monumentation and primary control. Any such points which the Contractor believes will be destroyed shall have offset points established by the Contractor prior to construction. Any monumentation destroyed by the Contractor shall be reestablished at Contractor's expense by a registered professional surveyor.
4. Topographic survey information shown on the plans is provided for informational purposes. The Contractor shall be responsible for verifying that the information shown is correct, and shall notify the engineer immediately of any errors, discrepancies or omissions to the survey information provided. Any costs incurred as the result of not confirming the actual survey shall be borne by the Contractor.
5. It shall be the responsibility of the Contractor to: A.) Prevent any damage to private property and property owner's poles, fences, shrubs, etc. B.) Protect all underground utilities. C.) Notify all utility companies at least 48 hours prior to excavation in accordance with Texas Law D.) Field verify horizontal and vertical location of all utilities in the vicinity of construction activities prior to start of construction. The Contractor shall notify Engineer of any unidentified potential conflicts that may exist between the existing utilities and construction plans.
6. Any damage that may occur to real property or existing improvements, including existing private and public landscape irrigation systems, shall be restored by the Contractor to at least the same condition that the real property or existing improvements were in prior to the damages. This restoration shall be subject to the Owner's approval; moreover, this restoration shall not be a basis for additional compensation to the Contractor. The Contractor must furnish a letter to the town, signed by the property owner that states repairs are satisfactory.
7. The Contractor shall maintain drainage at all times during construction. Ponding of water in streets, drives, trenches, etc. will not be allowed. The Contractor shall maintain residential driveway access at all times.
8. The Contractor shall maintain existing sanitary sewer and water service at all times during construction unless approved by Town of Addison in advance.
9. The Contractor is responsible for coordination with utility companies and adjustment of existing sanitary sewer manholes, cleanouts, water meters, water valves, fire hydrants and other utility appurtenances to finished grade as required at no additional cost to the Town of Addison.
10. The Contractor shall excavate and field locate the horizontal and vertical location of existing water lines and sanitary sewer lines at all proposed storm drain line crossing locations utilizing provided project control. In addition, the horizontal and vertical location and size of existing storm drain lines shall be verified at the point of proposed connection with new storm drain facilities. Field verification shall be performed by the Contractor prior to beginning construction of the proposed storm drain improvements. The Contractor shall immediately notify the Engineer of any discrepancies identified between the Contractor's field verified existing utility location and the existing utility location represented on the drawings. The Contractor shall give all franchise utilities 48 hours advanced notice before construction in areas where utilities are present.
11. Areas of the site that will underlie fill shall be scarified to a depth of 6 inches and recompacted in accordance with embankment specifications.
12. Pedestrian and vehicular traffic flow, safety and access shall be maintained during all phases of construction. Barricading and traffic control during construction shall be the responsibility of the contractor and shall conform to the Texas Manual on Uniform Traffic Control Devices, Part VI in particular. Traffic flow and access shall be maintained during all phases of construction unless otherwise noted on the traffic control plan. The Contractor is responsible for providing traffic safety measures for work on the project. The Contractor shall assume full responsibility for public safety in the construction area during the duration of construction activities.
13. The Contractor shall abide by all applicable federal, state, and local laws governing excavation. The Contractor shall provide detailed plans and specifications for trench safety systems that comply with applicable laws governing excavation. These plans shall be sealed by an Engineer experienced in the design of trench safety systems licensed in the State of Texas. The Contractor shall submit completed trench safety plan to the Engineer prior to commencing work. The Contractor shall be solely responsible for all aspects of work related excavation.
14. The Contractor shall remove from the project area all surplus material. This work shall be incidental and not a separate pay item. Surplus materials from excavation include dirt, trash, rock measuring greater than 9" in the largest dimension, etc. shall be properly disposed of at a site acceptable to the Town of Addison if within the Town limits. If the location is not within the Town limits, the Contractor shall provide a letter stating so. No excess excavated material shall be deposited in low areas or along natural drainage ways without written permission from the affected property owner and the Town of Addison. If the Contractor places excess material in these areas without written permission, he will be responsible for all damages resulting from such fill and he shall remove the material at his own cost.
15. Bidders shall make any investigation of existing subsurface conditions as deemed necessary at no expense to the Town of Addison. Neither the Town of Addison nor the Engineer will be responsible in any way for additional compensation for excavation work performed under this contract due to the Contractor's assumptions.
16. Basic horizontal and vertical control points will be established or designated by Halff Associates, Inc. These points shall be used as a datum for the work. All additional survey work shall be performed by a competent surveyor employed by the contractor. As part of the work, the Town of Addison will provide inspection of the proposed construction.
17. The Contractor will furnish to the Town of Addison the name of an OSHA certified competent person to be on the project at all times.
18. Trees shall only be removed if designated on the plans. The Contractor shall stake limits of proposed grading prior to clearing operations and identify (by flagging) adjacent trees that are to remain outside of these limits for Town review and approval. The Contractor shall provide the Town 72 hours advanced notice of when trees will be flagged and ready for review. All cleared material shall be promptly removed from the site and properly disposed. Stockpiling of cleared material will not be allowed. Burning of cleared material is prohibited. The Contractor is directed to NCTCOG specification item 3.2 for additional requirements. The clearing and removal of trees and other objectionable material shall not be paid for directly but shall be considered subsidiary to pay item DRIGHT-of-Way Preparation. If in the opinion of the Engineer, a tree that is to remain requires protecting from construction, it shall be protected in accordance with note 19.
19. Where trees, plants, shrubbery, etc. are adjacent to the line of work and are not to be removed or removed and replaced, the Contractor shall protect such trees, plants, shrubbery, etc. If such trees, plants, shrubbery, etc. could be damaged by machinery, etc., orange safety fencing with steel T-posts having a minimum height of 3' and as approved by the Town shall be utilized for protection. Hand excavation may also be required in vicinity of trees, plants, shrubbery, etc. that are to remain. The Contractor shall not permit machinery or employees to scrape, tear the limbs from, damage or attach guy cables to existing trees that are to remain in place. The Contractor shall be responsible for all damages to adjacent trees, plants, shrubbery, etc. that are to remain and any such damage shall be remedied to the satisfaction of the Town.
20. The Contractor shall coordinate the protection of existing franchise utilities and appurtenances including existing utility poles in the vicinity of construction operations whether utilities are shown in the Contract Documents or not. Any damage incurred to existing franchise utilities, appurtenances, power poles etc. by construction related activities shall be the sole responsibility of the Contractor.
21. Only Town staff will be allowed to operate existing water line valves. Contractor shall coordinate with Town staff for water valve closures and openings.
22. Contractor is responsible for condition of removed signs. Removed signs to be reinstated must be in same conditions or better condition when reinstated.
23. The Contractor must cease all construction operations immediately if a suspected archeological object/artifact is uncovered during construction. The Contractor must immediately contact THC and the Town. Project work will not commence until proper permits are in place and provided to the Town.
24. The Contractor must comply with the Migratory Bird Treaty Act.
25. The Town had informed all franchise utilities of this project and had provided them with plans. The Town has also worked with the franchise utilities in planning the relocation of their conflicting lines and facilities. The Contractor is responsible to continue coordination directly with the franchise utilities to ensure that any utilities in conflict are adjusted or relocated in accordance with contractor's construction schedule. No additional contract days or additional mobilization expenses will be provided or paid for by the Town to the Contractor for time incurred w/ franchise utility adjustment.
26. Inspection of the proposed construction will be provided and paid for by the Town of Addison. The Contractor shall provide assistance by providing excavation, trench safety, or other work necessary to facilitate inspection activities, and shall give sufficient notice well in advance of pending construction activities to the Town of Addison for scheduling of inspection services.
27. All dimensions are to the face of curb unless otherwise noted.



UTILITY CONTACTS

- | | |
|-------------|---|
| ATMOS | - GARY WOOLSEY - gary.woolsey@atmosenergy.com |
| AT&T | - JOHN HOLLINGSWORTH - jh5568@att.com |
| ONCOR | - LARRY BALDWIN - larry.baldwin@oncor.com |
| TIME WARNER | - WARREN FYFFE - warren.fyffe@twcable.com |

RECORD DOCUMENTS
December, 2011
These Record Documents have been prepared based upon information provided by North Texas Contracting, Inc. The Design Professional has not verified the accuracy and / or completeness of this information and shall not be responsible for any errors or omissions which may be incorporated herein as a result

Design Consultant: Halff Associates, Inc.
RECORD DRAWING SUBMITTAL



 Signature of Registrant _____ Date 12/6/2011 P.E.


 TOWN OF ADDISON DALLAS COUNTY, TEXAS					
SPRING VALLEY ROAD					
GENERAL NOTES					
 1201 NORTH BOWSER ROAD, RICHARDSON, TEXAS 75081-2275 TEL. (214) 348-6200 FAX (214) 738-0065					
PROJECT	DESIGN	DRAWN	DATE	FILE	SHEET
27530	MPB	TMM	OCTOBER 2010	27530 GNTS 01	GN-1

USER: gh1299
 OFFICE: RCH
 PROJECT: 27530
 FILE: 27530 GNTS 01.dgn
 TIME: 10:04:29 AM
 DATE: 12/7/2011

SHEET 3 OF 163

RECORD DRAWINGS

DATE: 12/7/2011 TIME: 10:04:46 AM FILE: 27530 TYPP 01.dgn PROJECT: 27530 OFFICE: RCH USER: gh1299

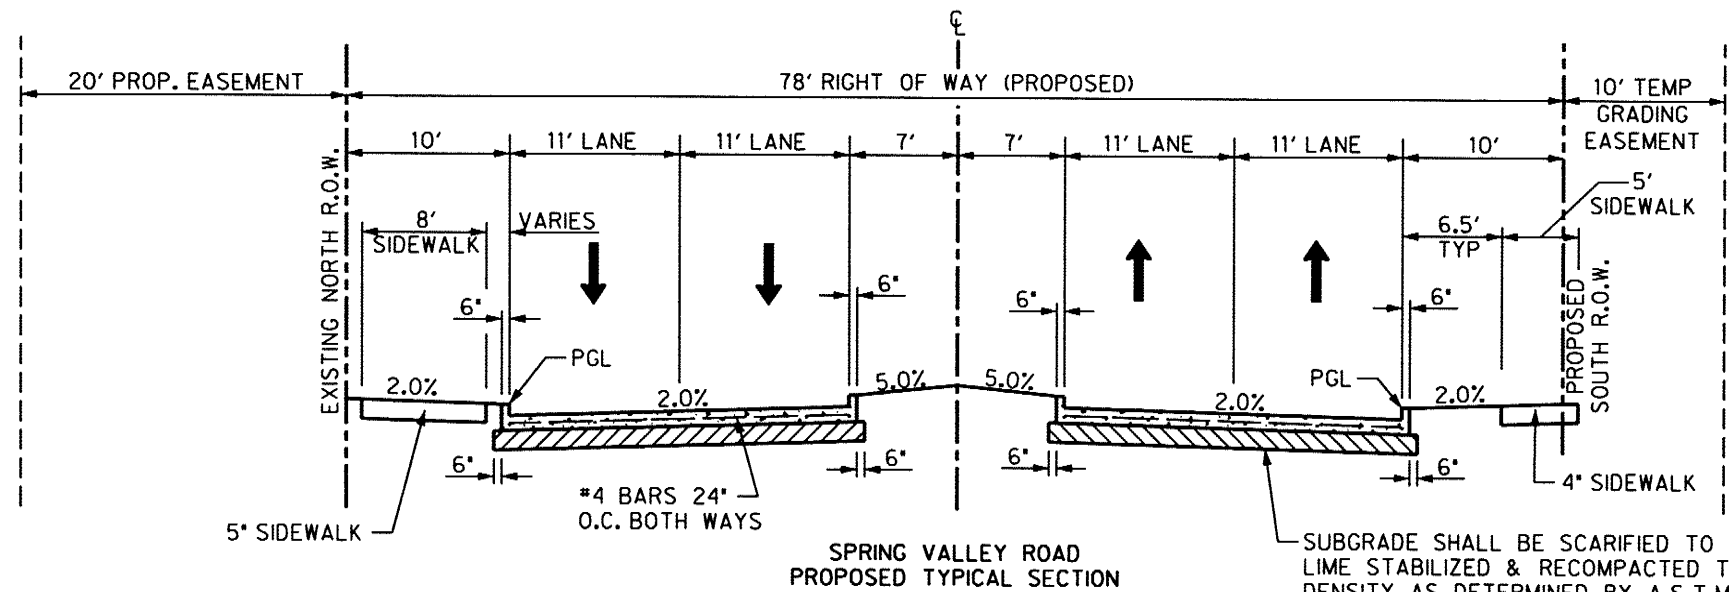


SPRING VALLEY ROAD
PROPOSED TYPICAL SECTION

SUBGRADE SHALL BE SCARIFIED TO A DEPTH OF 6",
LIME STABILIZED & RECOMPACTED TO 95% OF MAX.
DENSITY AS DETERMINED BY A.S.T.M. D-698.
SUBGRADE SHALL BE STABILIZED W/ 6%
APPROXIMATELY, BY WEIGHT OF HYDRATED LIME.


LEGEND

- 10" CRCP (4200 PSI)
- 6" LIME STABILIZED BASE

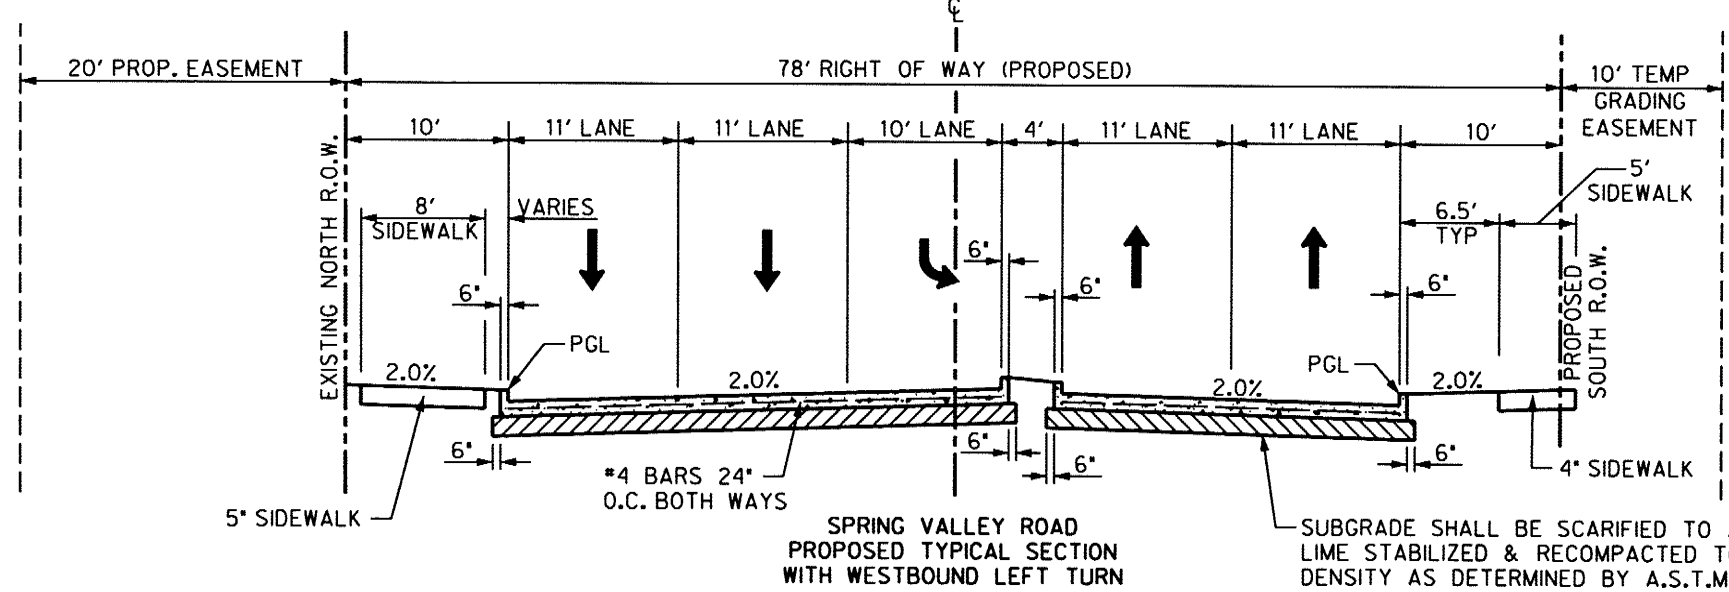

SPRING VALLEY ROAD
PROPOSED TYPICAL SECTION
WITH WESTBOUND LEFT TURN

SUBGRADE SHALL BE SCARIFIED TO A DEPTH OF 6",
LIME STABILIZED & RECOMPACTED TO 95% OF MAX.
DENSITY AS DETERMINED BY A.S.T.M. D-698.
SUBGRADE SHALL BE STABILIZED W/ 6%
APPROXIMATELY, BY WEIGHT OF HYDRATED LIME.

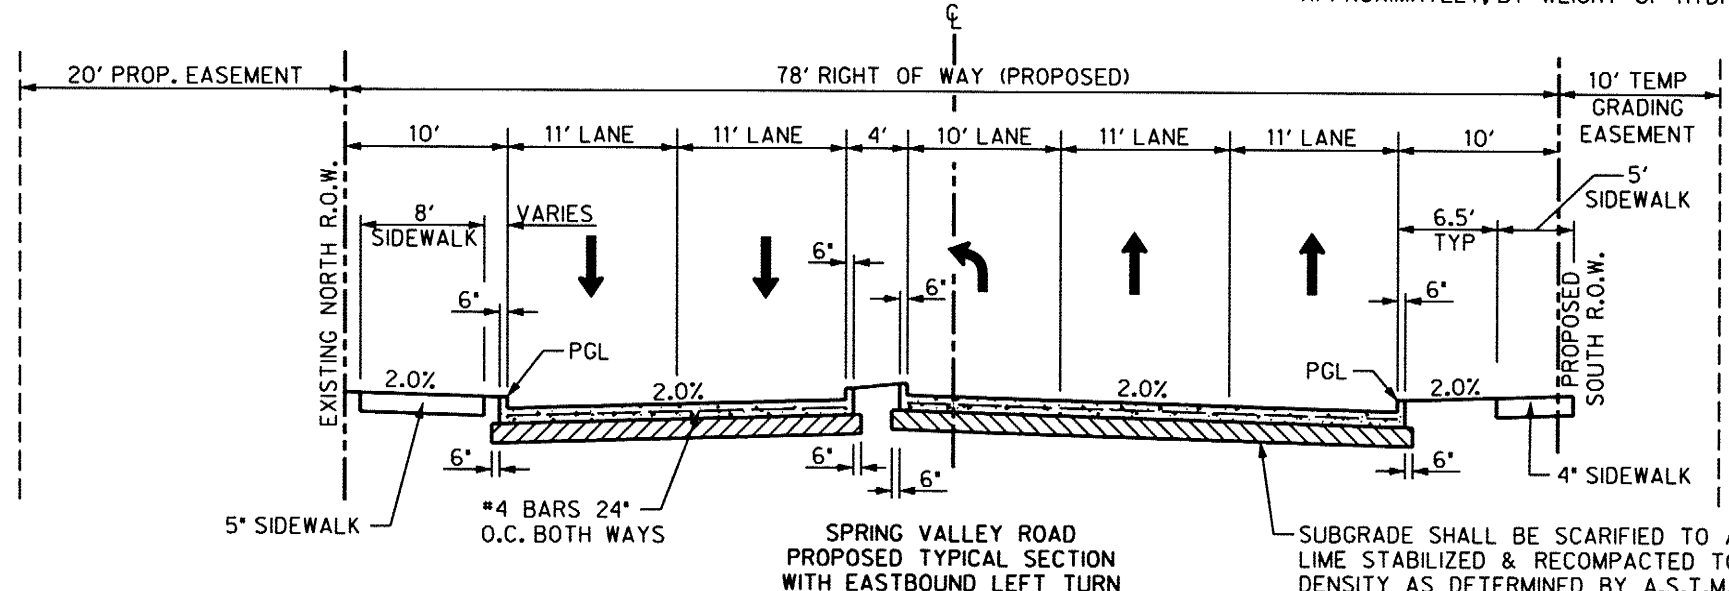

SPRING VALLEY ROAD
PROPOSED TYPICAL SECTION
WITH EASTBOUND LEFT TURN

SUBGRADE SHALL BE SCARIFIED TO A DEPTH OF 6",
LIME STABILIZED & RECOMPACTED TO 95% OF MAX.
DENSITY AS DETERMINED BY A.S.T.M. D-698.
SUBGRADE SHALL BE STABILIZED W/ 6%
APPROXIMATELY, BY WEIGHT OF HYDRATED LIME.

RECORD DOCUMENTS
December, 2011
These Record Documents have been prepared based upon information provided by North Texas Contracting, Inc. The Design Professional has not verified the accuracy and / or completeness of this information and shall not be responsible for any errors or omissions which may be incorporated herein as a result
Design Consultant: Half Associates, Inc.
RECORD DRAWING SUBMITTAL



M. Romanowski
Signature of Registrant Date 12/8/2011

SHEET 4 OF 163 RECORD DRAWINGS

NO.	REVISION	BY	DATE
ADDISON TOWN OF ADDISON DALLAS COUNTY, TEXAS SPRING VALLEY ROAD TYPICAL SECTION			
HALFF 1201 NORTH BOWSER ROAD, RICHARDSON, TEXAS 75081-3275 TEL. (214) 348-6200 FAX (214) 739-0085			
PROJECT	DESIGN	DRAWN	DATE
27530	MPB	TMM	OCTOBER 2010
FILE	SHEET		
27530 TYPP 01	TS-1		


SURVEY CONTROL POINTS

NUMBER	NORTHING	EASTING	ELEVATION	DESCRIPTION
301	9994.2658	11014.7967	587.45	FXTP
302	9996.3462	11213.6958	582.45	SXTP
303	9440.2542	11995.6202	583.07	FXTP
201	9933.8451	12137.7362	584.18	FXTP
202	9906.1846	12168.8438	583.76	FXTP

FXTP - FOUND MONUMENTATION
 SXTP - SET MONUMENTATION

TOWN OF ADDISON MONUMENT

MONUMENT (NOT SHOWN)
 DESCRIPTION:
 DISK SET IN CONCRETE ON THE NORTH SIDE OF
 SPRING VALLEY ROAD, APPROXIMATELY 147 FEET
 EAST OF THE CENTERLINE OF MARSH LANE.
 DATUM:
 NORTHING 9999.9760 FT
 EASTING 10000.2140 FT
 ELEVATION 573.00 FT

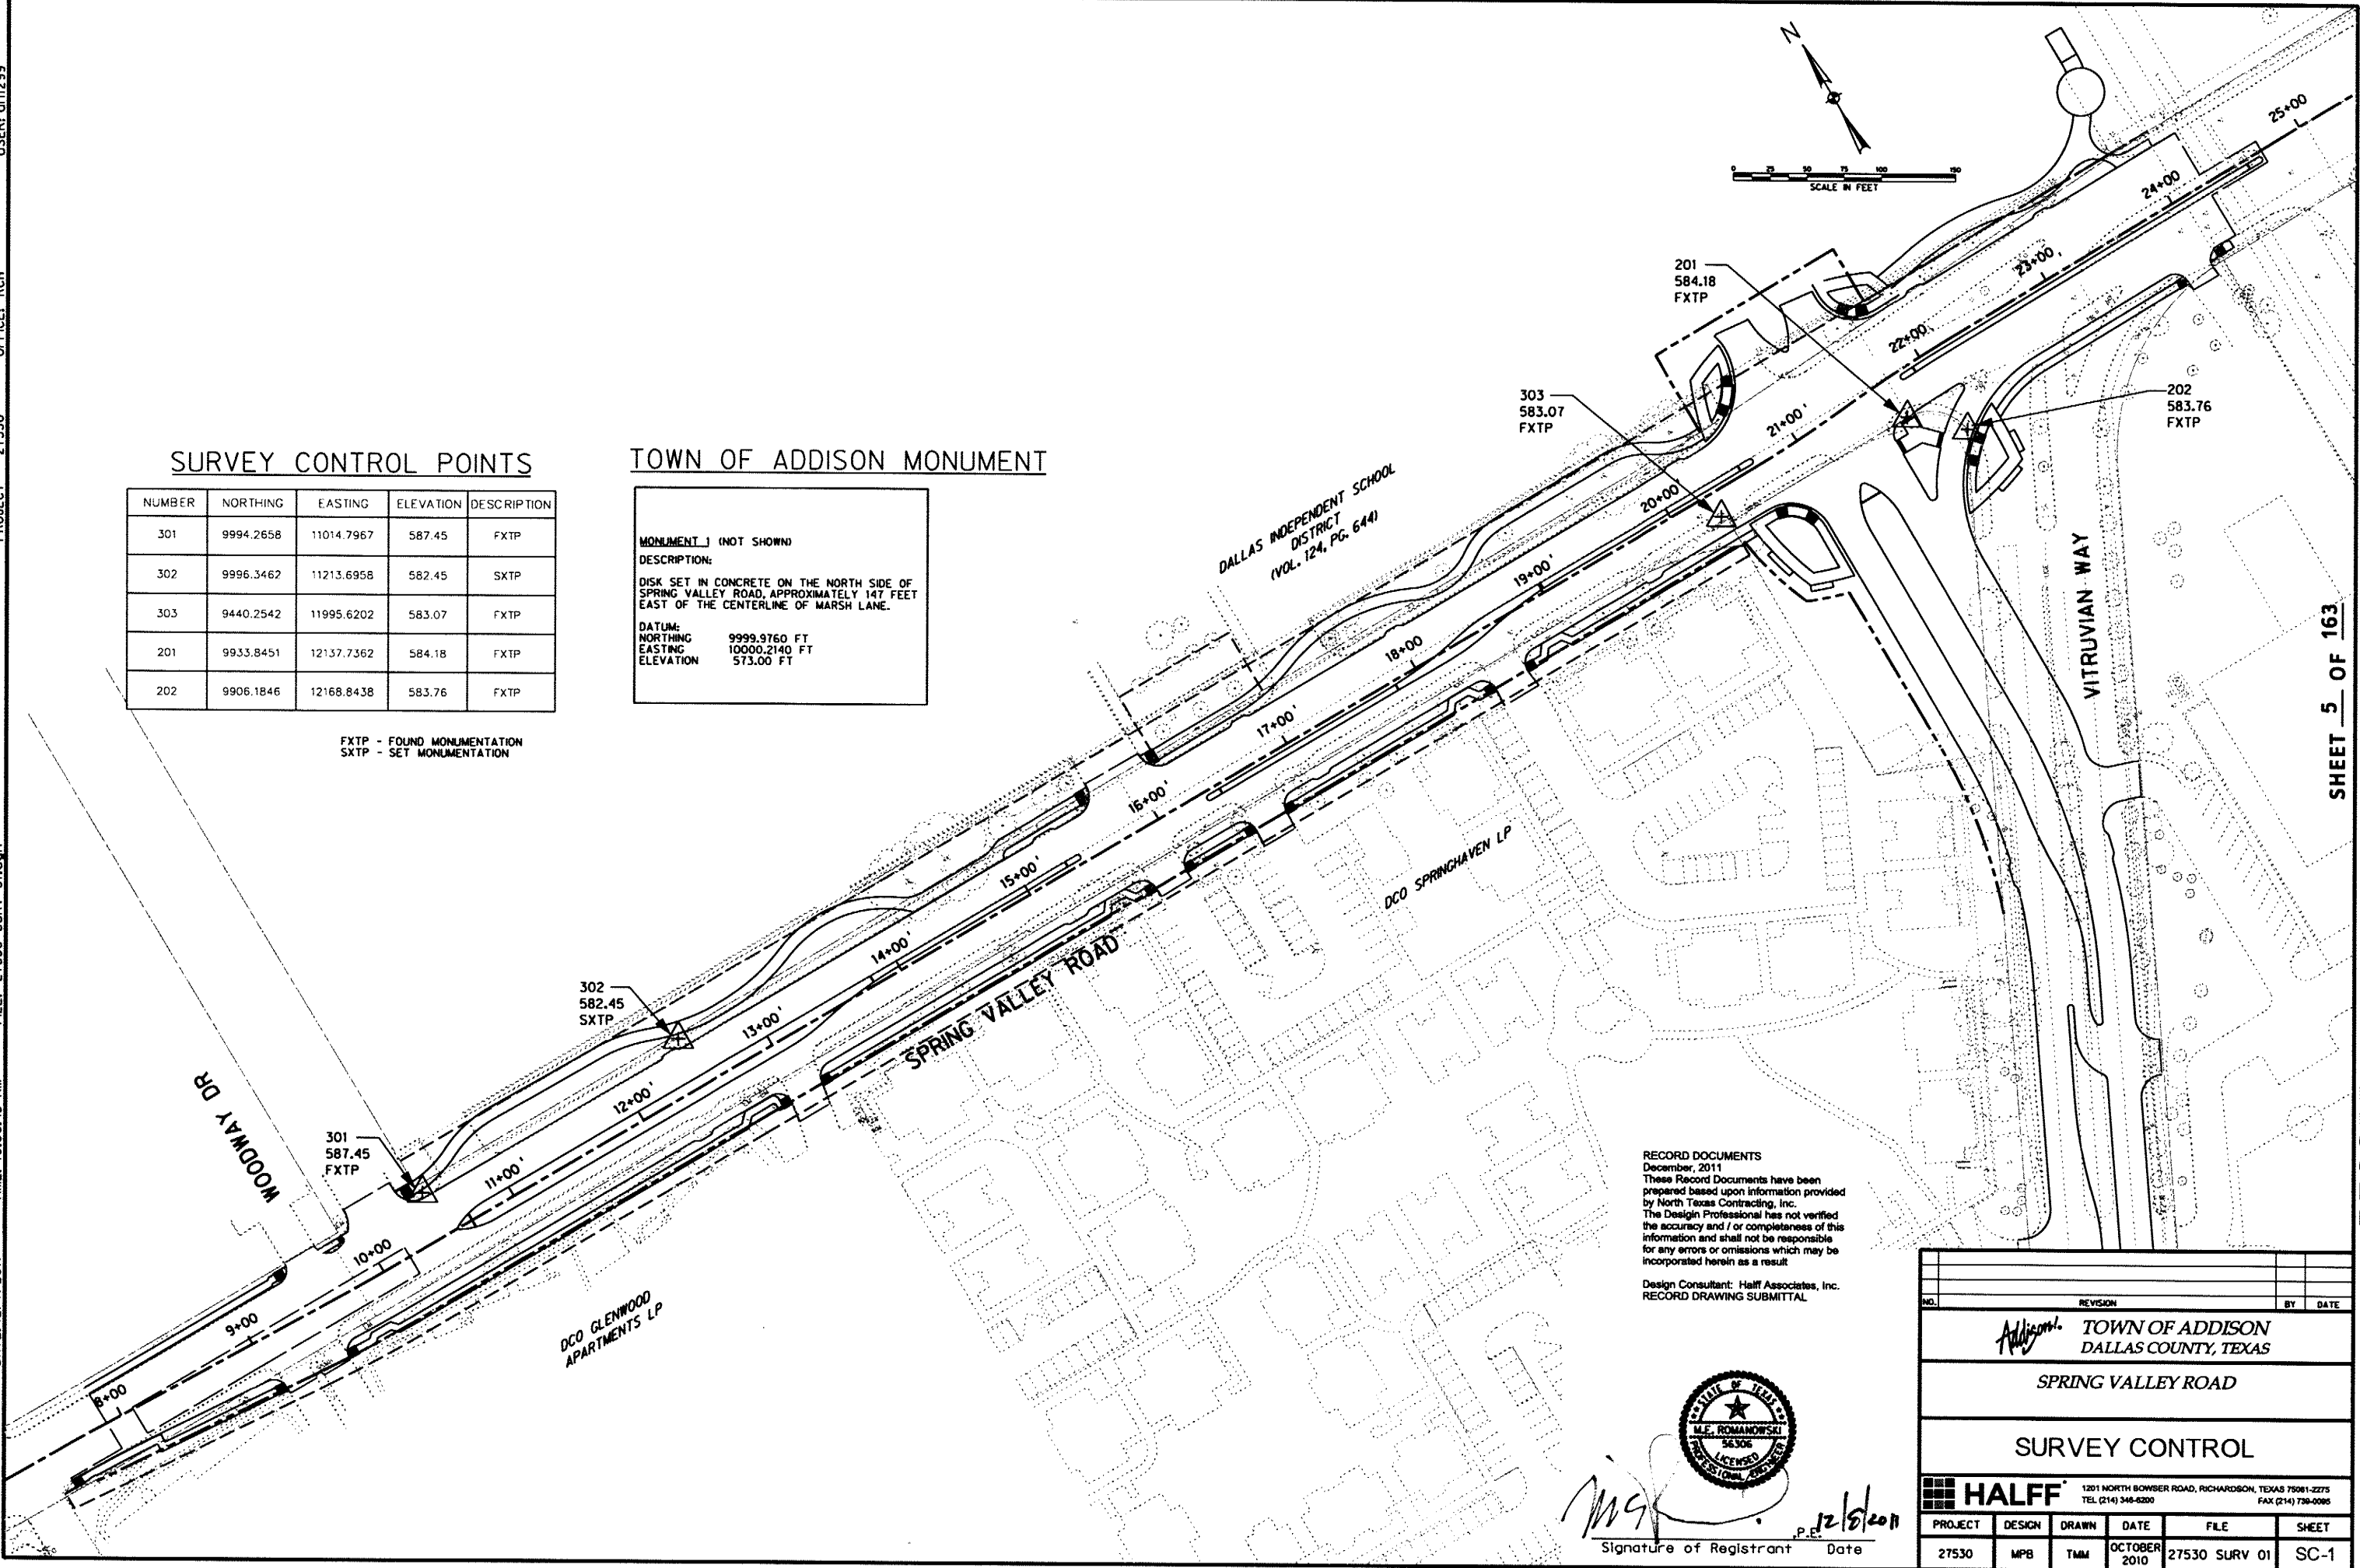


RECORD DOCUMENTS
 December, 2011
 These Record Documents have been prepared based upon information provided by North Texas Contracting, Inc. The Design Professional has not verified the accuracy and / or completeness of this information and shall not be responsible for any errors or omissions which may be incorporated herein as a result.
 Design Consultant: Half Associates, Inc.
 RECORD DRAWING SUBMITTAL



M.E. Romanowski
 Signature of Registrant Date 12/5/2011

NO.	REVISION	BY	DATE		
TOWN OF ADDISON DALLAS COUNTY, TEXAS SPRING VALLEY ROAD SURVEY CONTROL					
HALFF <small>1201 NORTH BOWSER ROAD, RICHARDSON, TEXAS 75081-2275 TEL (214) 348-8200 FAX (214) 799-0095</small>					
PROJECT	DESIGN	DRAWN	DATE	FILE	SHEET
27530	MPB	TMM	OCTOBER 2010	27530 SURV 01	SC-1

USER: oh1299
 OFFICE: RCH
 PROJECT: 27530
 FILE: 27530 REMV 01.dgn
 DATE: 12/7/2011
 TIME: 10:05:13 AM

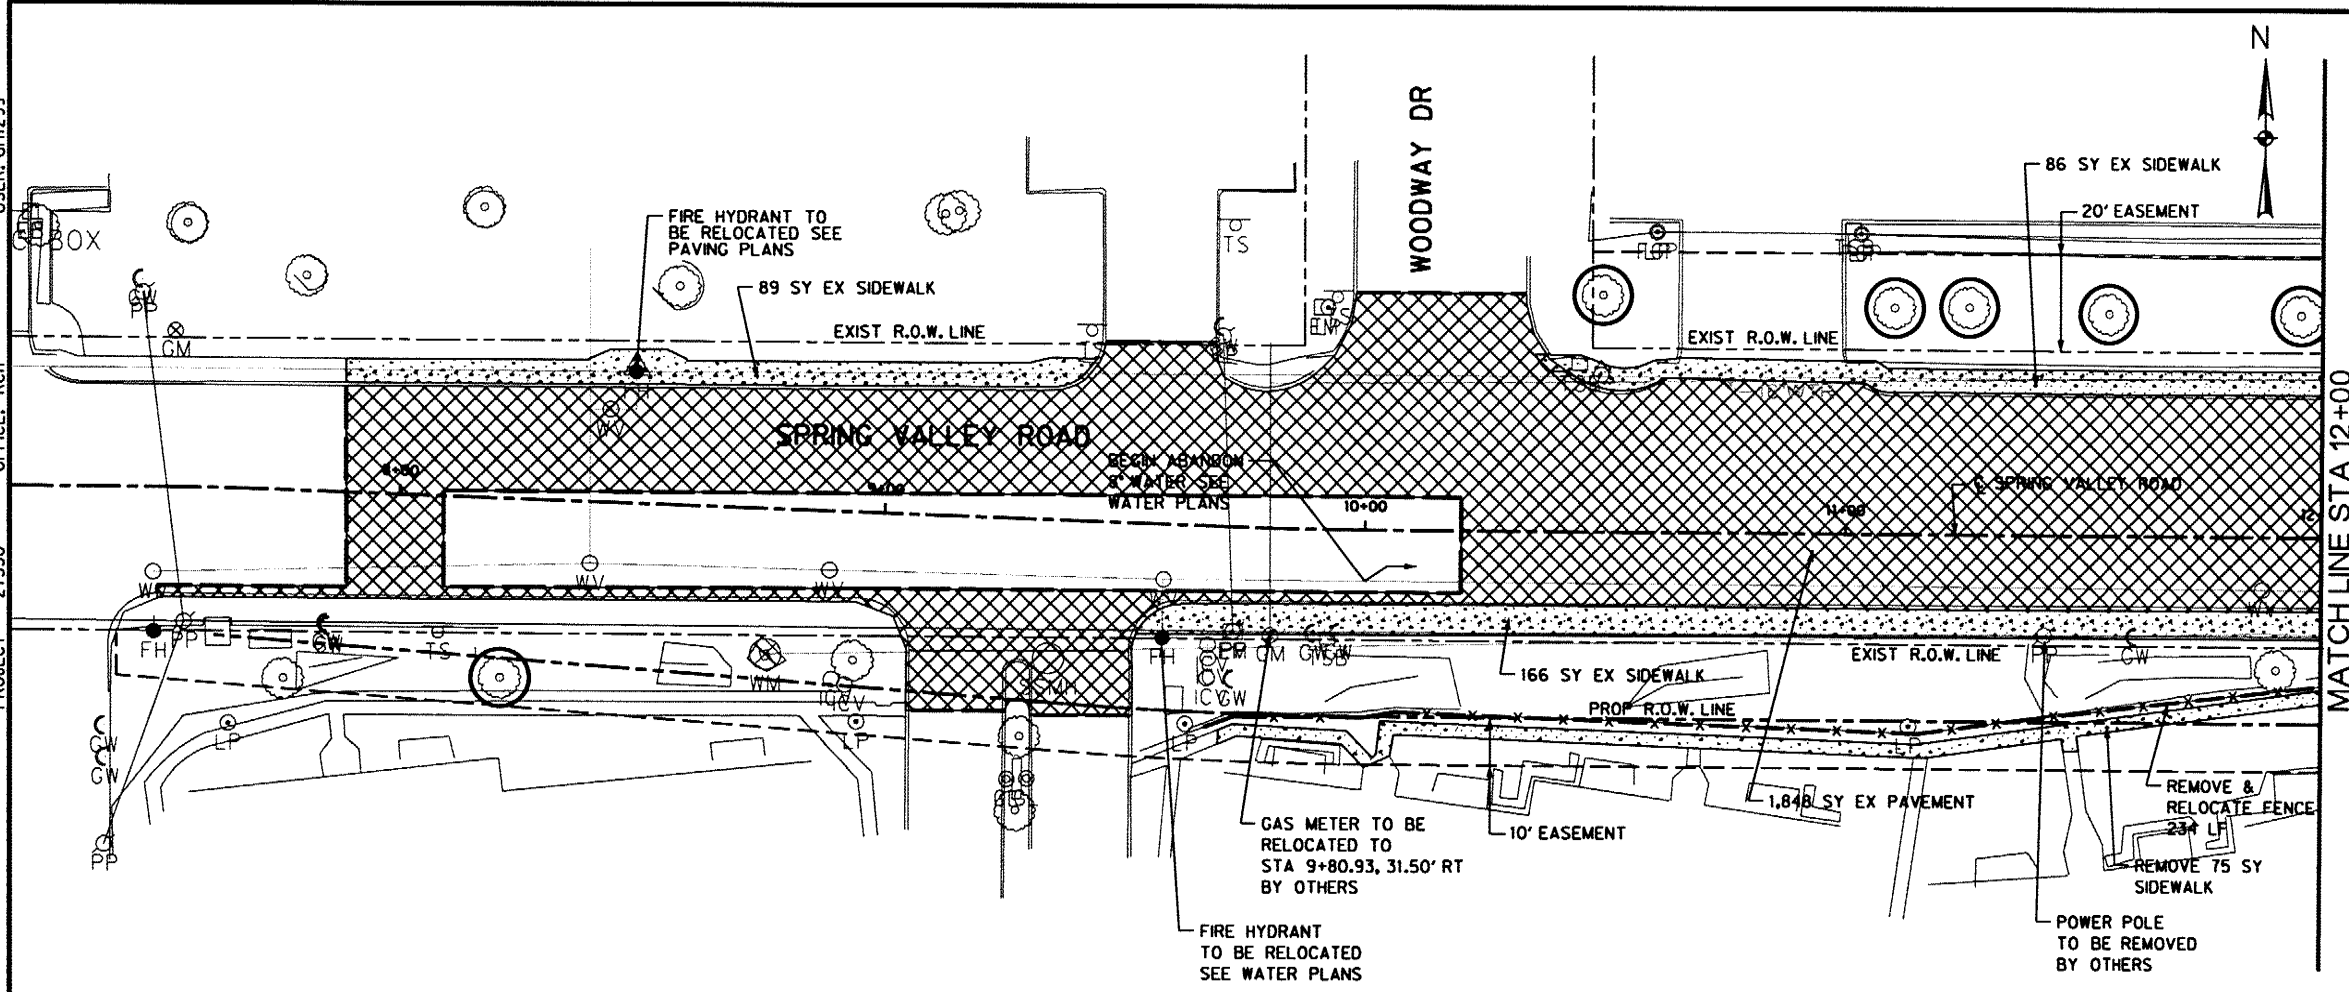


- LEGEND**
- CONCRETE PAVEMENT TO BE SAWCUT AND REMOVED
 - CONCRETE SIDEWALK TO BE REMOVED
 - SAWCUT LINE
 - TREE PROTECTION SEE REMOVAL DETAIL SHEET

NOTE:
 SEE LANDSCAPE PLANS FOR TREES
 TO BE REMOVED & TREES TO REMAIN.

RECORD DOCUMENTS
 December, 2011
 These Record Documents have been prepared based upon information provided by North Texas Contracting, Inc. The Design Professional has not verified the accuracy and / or completeness of this information and shall not be responsible for any errors or omissions which may be incorporated herein as a result.
 Design Consultant: Half Associates, Inc.
 RECORD DRAWING SUBMITTAL



M.E. Romanowski P.E. 12/8/2011
 Signature of Registrant Date

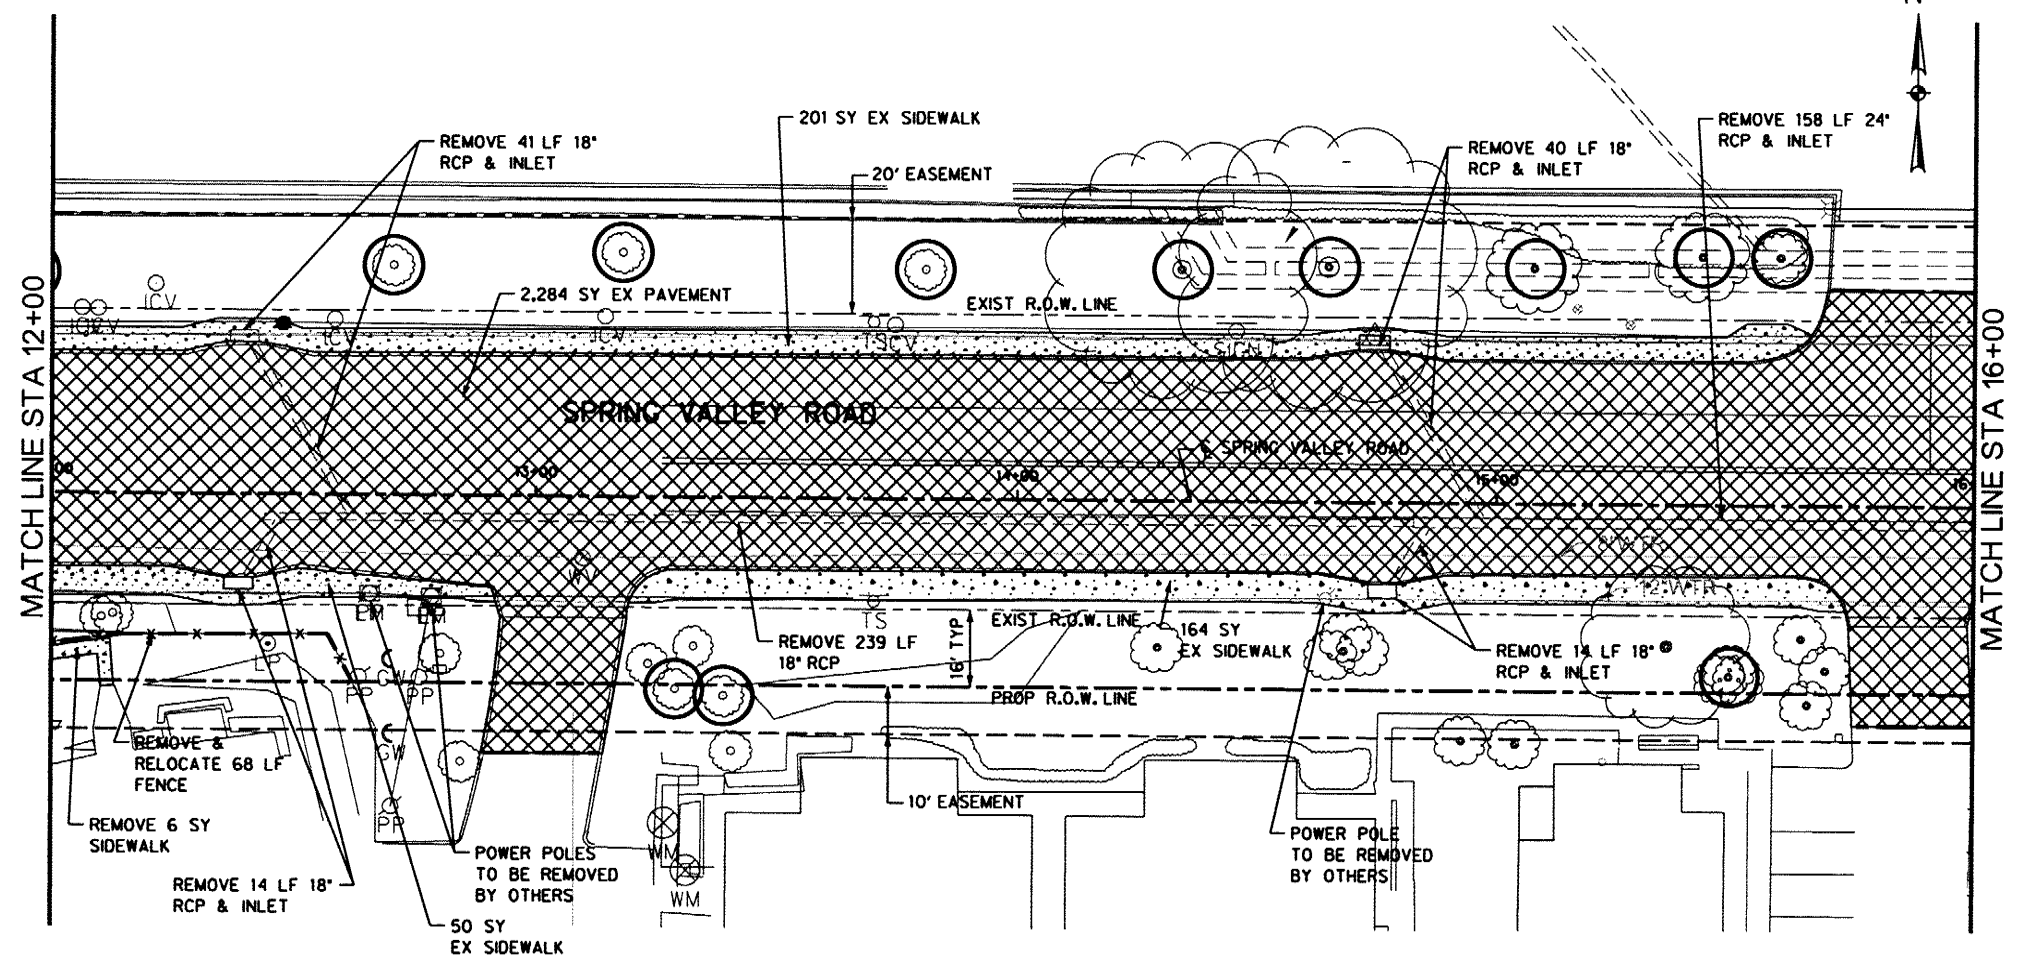

NO.	REVISION	BY	DATE
TOWN OF ADDISON DALLAS COUNTY, TEXAS SPRING VALLEY ROAD REMOVAL PLAN STA 7+49.89 TO STA 16+00			
1201 NORTH BOWSER ROAD, RICHARDSON, TEXAS 75081-2275 TEL (214) 346-8200 FAX (214) 736-0095			
PROJECT	DESIGN	DRAWN	DATE
27530	MPB	TMM	OCTOBER 2010
FILE	SHEET		
27530 REMV 01	RM-1		

SHEET 6 OF 163
 RECORD DRAWINGS

USER: oh1299


OFFICE: RCH

PROJECT: 27530

FILE: 27530 REMV 02.dwg

TIME: 10:05:29 AM

DATE: 12/7/2011

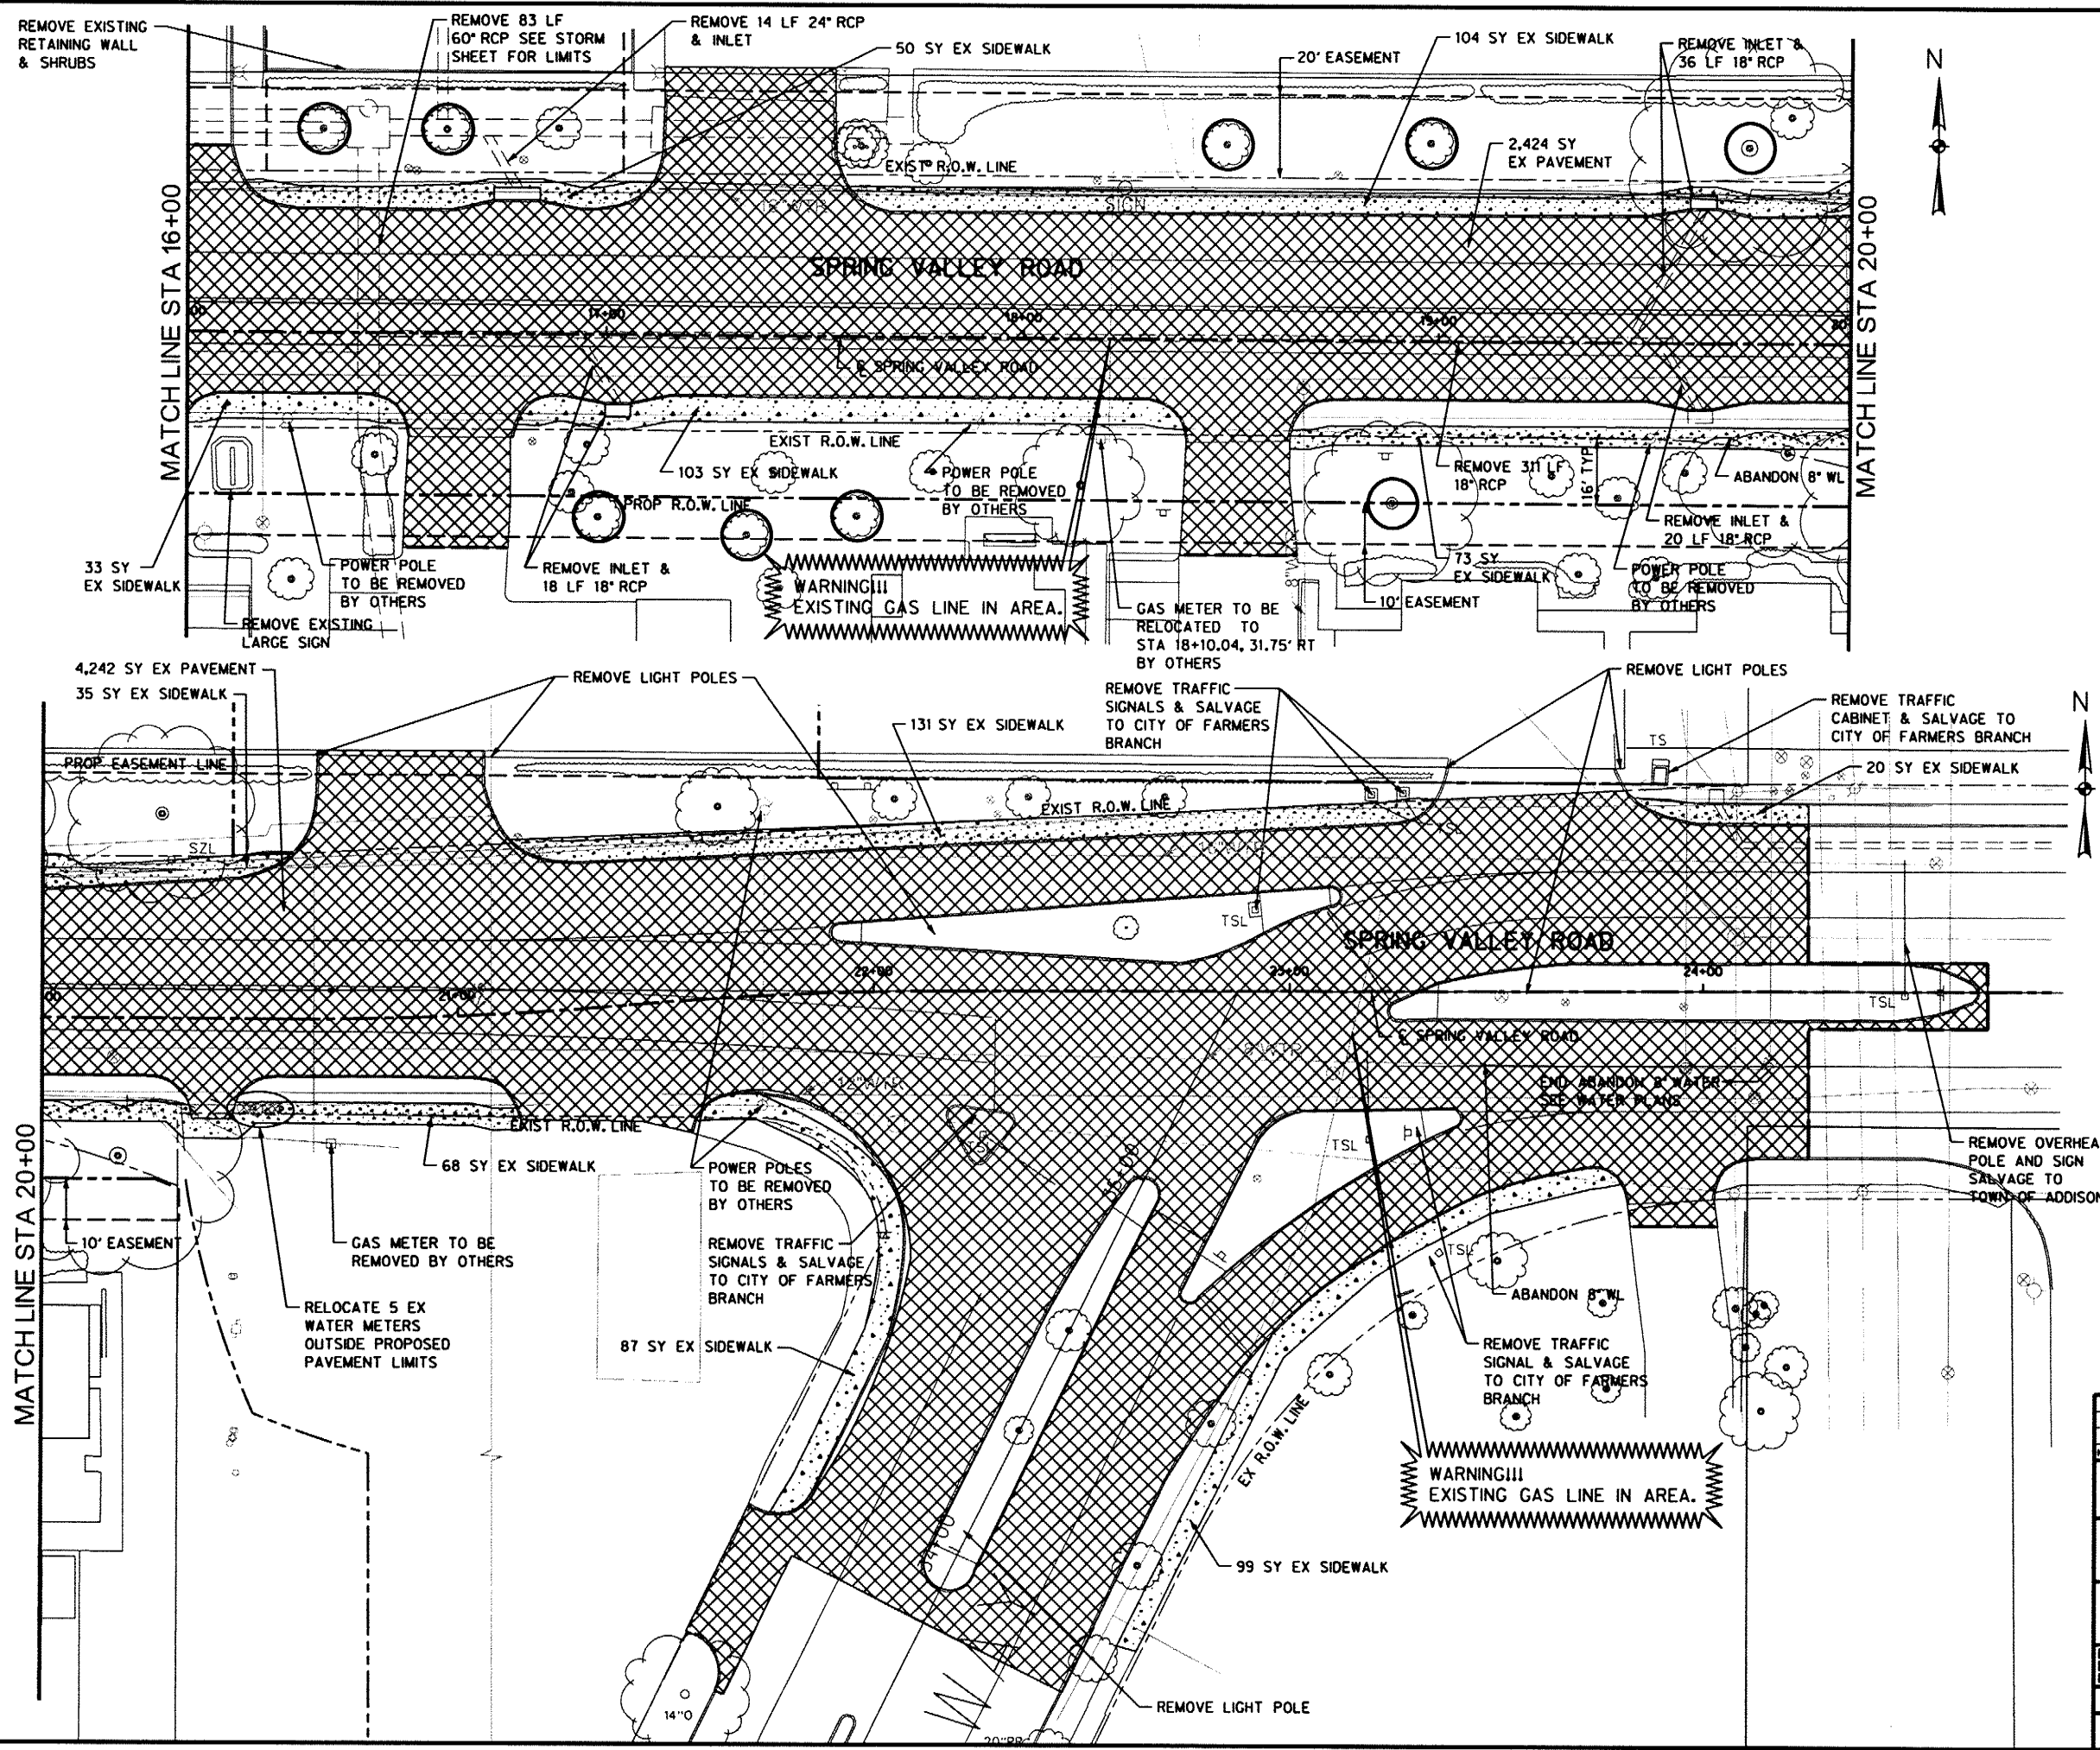

LEGEND

- CONCRETE PAVEMENT TO BE SAWCUT AND REMOVED
- CONCRETE SIDEWALK TO BE REMOVED
- SAWCUT LINE
- TREE PROTECTION SEE REMOVAL DETAIL SHEET

NOTE: SEE LANDSCAPE PLANS FOR TREES TO BE REMOVED & TREES TO REMAIN.

RECORD DOCUMENTS
 December, 2011
 These Record Documents have been prepared based upon information provided by North Texas Contracting, Inc. The Design Professional has not verified the accuracy and / or completeness of this information and shall not be responsible for any errors or omissions which may be incorporated herein as a result.


Design Consultant: Half Associates, Inc.
 RECORD DRAWING SUBMITTAL



[Signature] P.E. 12/6/2011
 Signature of Registrant Date

NO.	REVISION	BY	DATE
TOWN OF ADDISON DALLAS COUNTY, TEXAS SPRING VALLEY ROAD REMOVAL PLAN STA 16+00 TO STA 26+11.52			
HALFF 1201 NORTH BOWSER ROAD, RICHARDSON, TEXAS 75081-2275 TEL (214) 348-6200 FAX (214) 730-0285			
PROJECT	DESIGN	DRAWN	DATE
27530	MPB	TMM	OCTOBER 2010
FILE	SHEET		
27530 REMV 02	RM-2		

RECORD DRAWINGS SHEET 7 OF 163

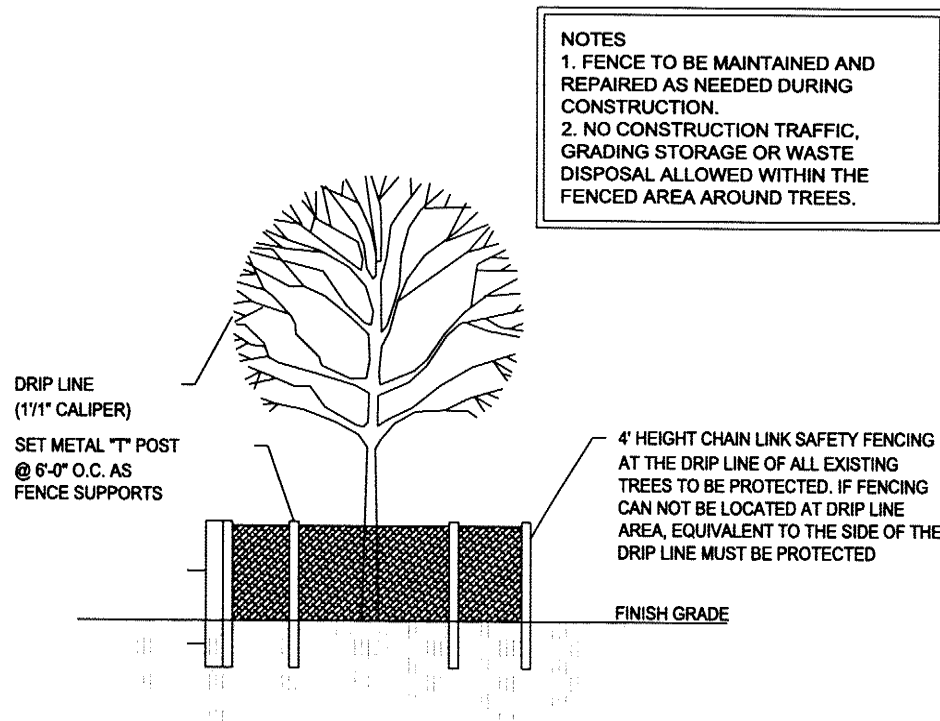




NOTES
 1. FENCE TO BE MAINTAINED AND REPAIRED AS NEEDED DURING CONSTRUCTION.
 2. NO CONSTRUCTION TRAFFIC, GRADING STORAGE OR WASTE DISPOSAL ALLOWED WITHIN THE FENCED AREA AROUND TREES.

TREE PROTECTION NOTES

- EXISTING TREES SHOWN TO REMAIN ARE TO PROTECTED DURING CONSTRUCTION. CHAINLINK FENCING (MIN. 4'-0" HEIGHT) SHALL BE INSTALLED AT THE DRIP LINE OF ALL TREES OR TREE GROUPS TO REMAIN. PARKING OF VEHICLES OR PERFORMING WORK WITHIN THESE AREAS OTHER THAN SHOWN ON THE PLAN, WILL NOT BE ALLOWED. THE TREE PROTECTION SHALL REMAIN DURING CONSTRUCTION. OTHER TREE PROTECTION MEASURES SHALL BE IN ACCORDANCE WITH THE CITY'S STANDARDS AND ORDINANCES.
- DISPOSAL OF ANY WASTE MATERIAL SUCH AS, BUT NOT LIMITED TO, PAINT, ASPHALT, OIL SOLVENTS, CONCRETE, MORTAR, ETC. WITHIN THE CANOPY AREA OF THE EXISTING TREES SHALL NOT BE ALLOWED.
- NO ATTACHMENTS OR WIRES OF ANY KIND, OTHER THAN THOSE OF A PROTECTIVE NATURE, SHALL BE ATTACHED TO TREE.
- NO FILL OR EXCAVATION OF ANY NATURE SHALL OCCUR WITHIN THE DRIP LINE OF A TREE TO BE PRESERVED, UNLESS THERE IS A SPECIFIED WELL OR RETAINING WALL SHOWN ON THE GRADING PLAN.
- NO MATERIALS SHALL BE STORED WITHIN THE DRIPLINE AREA OF A TREE TO BE PRESERVED.

RECORD DOCUMENTS
 December, 2011
 These Record Documents have been prepared based upon information provided by North Texas Contracting, Inc. The Design Professional has not verified the accuracy and / or completeness of this information and shall not be responsible for any errors or omissions which may be incorporated herein as a result
 Design Consultant: Halff Associates, Inc.
 RECORD DRAWING SUBMITTAL



 Signature of Registrant Date 12/6/2011

NO.	REVISION	BY	DATE		
<i>Addison</i> TOWN OF ADDISON DALLAS COUNTY, TEXAS					
SPRING VALLEY ROAD					
REMOVAL DETAILS					
 HALFF		1201 NORTH BOWSER ROAD, RICHARDSON, TEXAS 75081-2275 TEL (214) 348-8200 FAX (214) 738-0095			
PROJECT	DESIGN	DRAWN	DATE	FILE	SHEET
27530	MPB	TMM	OCTOBER 2010	27530 DTL5 01	DT-RD

USER: oh1299
OFFICE: RCH
PROJECT: 27530
FILE: 27530 ALGN 01.dgn
TIME: 10:07:28 AM
DATE: 12/7/2011

DESCRIPTION OF SPRING VALLEY CENTERLINE

Point 1 N 9,970.2712 E 10,615.7988 Sta 6+49.89

Course from 1 to PC CURSV-3 S 89° 45' 14.20" E Dist 100.0000

Curve Data

Curve CURSV-3
P.I. Station 7+63.21 N 9,969.7845 E 10,729.1133
Delta = 1° 47' 41.87" (RT)
Degree = 6° 44' 26.45"
Tangent = 13.3155
Length = 26.6288
Radius = 850.0000
External = 0.1043
Long Chord = 26.6277
Mid. Ord. = 0.1043
P.C. Station 7+49.89 N 9,969.8417 E 10,715.7979
P.T. Station 7+76.52 N 9,969.3103 E 10,742.4203
C.C. N 9,119.8495 E 10,712.1476
Back = S 89° 45' 14.20" E
Ahead = S 87° 57' 32.33" E
Chord Bear = S 88° 51' 23.26" E

Course from PT CURSV-3 to PC CURSV-4 S 87° 57' 32.33" E Dist 196.8477

Curve Data

Curve CURSV-4
P.I. Station 9+86.68 N 9,961.8253 E 10,952.4502
Delta = 1° 47' 41.87" (LT)
Degree = 6° 44' 26.45"
Tangent = 13.3155
Length = 26.6288
Radius = 850.0000
External = 0.1043
Long Chord = 26.6277
Mid. Ord. = 0.1043
P.C. Station 9+73.37 N 9,962.2996 E 10,939.1431
P.T. Station 10+00.00 N 9,961.7682 E 10,965.7655
C.C. N 10,811.7603 E 10,969.4159
Back = S 87° 57' 32.33" E
Ahead = S 89° 45' 14.20" E
Chord Bear = S 88° 51' 23.26" E

Course from PT CURSV-4 to PC CURSV-1 S 89° 45' 14.20" E Dist 1,058.1379

Curve Data

Curve CURSV-1
P.I. Station 20+99.61 N 9,957.0459 E 12,065.3717
Delta = 5° 35' 14.71" (LT)
Degree = 6° 44' 26.45"
Tangent = 41.4784
Length = 82.8910
Radius = 850.0000
External = 1.0114
Long Chord = 82.8582
Mid. Ord. = 1.0102
P.C. Station 20+58.13 N 9,957.2240 E 12,023.8937
P.T. Station 21+41.02 N 9,960.9071 E 12,106.6700
C.C. N 10,807.2162 E 12,027.5440
Back = S 89° 45' 14.20" E
Ahead = N 84° 39' 31.09" E
Chord Bear = N 87° 27' 08.45" E

Curve Data

Curve CURSV-2
P.I. Station 21+79.47 N 9,964.4856 E 12,144.9452
Delta = 5° 10' 44.39" (RT)
Degree = 6° 44' 26.45"
Tangent = 38.4422
Length = 76.8320
Radius = 850.0000
External = 0.8689
Long Chord = 76.8058
Mid. Ord. = 0.8680
P.C. Station 21+41.02 N 9,960.9071 E 12,106.6700
P.T. Station 22+17.86 N 9,964.5946 E 12,183.3873
C.C. N 9,114.5980 E 12,185.7960
Back = N 84° 39' 31.09" E
Ahead = N 89° 50' 15.49" E
Chord Bear = N 87° 14' 53.29" E

Course from PT CURSV-2 to 6 N 89° 50' 15.52" E Dist 1,730.4681

Point 6 N 9,969.4981 E 13,913.8484 Sta 39+48.32

DESCRIPTION OF DRIVEWAY S1W CENTERLINE

Point 20 N 9,947.0937 E 10,880.5898 Sta 10+00.00

Course from 20 to 21 S 0° 03' 56.26" W Dist 50.0000

Point 21 N 9,897.0938 E 10,880.5325 Sta 10+50.00

DESCRIPTION OF DRIVEWAY S1E CENTERLINE

Point 22 N 9,946.9913 E 10,906.7023 Sta 10+00.00

Course from 22 to 23 S 0° 19' 27.94" W Dist 49.9280

Point 23 N 9,897.0641 E 10,906.4196 Sta 10+49.93

DESCRIPTION OF DRIVEWAY S2 CENTERLINE

Point 24 N 9,931.4556 E 11,271.3311 Sta 10+00.00

Course from 24 to 25 S 10° 04' 25.10" W Dist 38.3685

Point 25 N 9,893.6787 E 11,264.6199 Sta 10+38.37

DESCRIPTION OF DRIVEWAY S3 CENTERLINE

Point 26 N 9,930.2500 E 11,552.0618 Sta 10+00.00

Course from 26 to 27 S 2° 22' 26.21" E Dist 23.5101

Point 27 N 9,906.7601 E 11,553.0357 Sta 10+23.51

DESCRIPTION OF DRIVEWAY S4 CENTERLINE

Point 28 N 9,929.9108 E 11,631.0465 Sta 10+00.00

Course from 28 to 29 S 2° 47' 50.09" W Dist 25.3716

Point 29 N 9,904.5695 E 11,629.8083 Sta 10+25.37

DESCRIPTION OF DRIVEWAY S4 CENTERLINE

Point 30 N 9,929.1094 E 11,817.6563 Sta 10+00.00

Course from 30 to 31 S 0° 50' 23.66" E Dist 23.8966

Point 31 N 9,905.2154 E 11,818.0065 Sta 10+23.90

DESCRIPTION OF DRIVEWAY S6 CENTERLINE

Point 32 N 9,925.2084 E 12,356.8162 Sta 10+00.00

Course from 32 to 33 S 5° 58' 39.21" E Dist 24.6201

Point 33 N 9,900.7222 E 12,359.3801 Sta 10+24.62

DESCRIPTION OF DRIVEWAY N1 CENTERLINE

Point 34 N 9,988.2338 E 11,555.9756 Sta 10+00.00

Course from 34 to 35 N 0° 44' 30.25" E Dist 30.9357

Point 35 N 10,019.1668 E 11,556.3761 Sta 10+30.94

DESCRIPTION OF NORTH SIDEWALK CENTERLINE

Curve Data

Curve SWN-1
P.I. Station 10+18.69 N 9,999.5824 E 11,027.8243
Delta = 26° 37' 12.34" (LT)
Degree = 72° 31' 30.81"
Tangent = 18.6897
Length = 36.7046
Radius = 79.0012
External = 2.1807
Long Chord = 36.3754
Mid. Ord. = 2.1221
P.C. Station 10+00.00 N 9,999.5823 E 11,009.1346
P.T. Station 10+36.70 N 10,007.9568 E 11,044.5328
C.C. N 10,078.5835 E 11,009.1341
Back = N 89° 59' 58.83" E
Ahead = N 63° 22' 46.49" E
Chord Bear = N 76° 41' 22.66" E

Curve Data

Curve SWN-2
P.I. Station 10+56.05 N 10,016.6266 E 11,061.8305
Delta = 27° 31' 27.23" (RT)
Degree = 72° 31' 36.65"
Tangent = 19.3487
Length = 37.9504
Radius = 78.9994
External = 2.3350
Long Chord = 37.5865
Mid. Ord. = 2.2679
P.C. Station 10+36.70 N 10,007.9568 E 11,044.5328
P.T. Station 10+74.66 N 10,016.3214 E 11,081.1768
C.C. N 9,937.3318 E 11,079.9307
Back = N 63° 22' 46.49" E
Ahead = S 89° 05' 46.27" E
Chord Bear = N 77° 08' 30.11" E

Course from PT SWN-2 to PC SWN-3 S 89° 05' 46.27" E Dist 80.3858

RECORD DOCUMENTS
December, 2011
These Record Documents have been prepared based upon information provided by North Texas Contracting, Inc. The Design Professional has not verified the accuracy and / or completeness of this information and shall not be responsible for any errors or omissions which may be incorporated herein as a result
Design Consultant: Half Associates, Inc.
RECORD DRAWING SUBMITTAL



M. E. Romanowski P.E. 12/6/2011
Signature of Registrant Date

NO.	REVISION	BY	DATE
TOWN OF ADDISON DALLAS COUNTY, TEXAS SPRING VALLEY ROAD HORIZONTAL CONTROL SHEET			
1201 NORTH BOWSER ROAD, RICHARDSON, TEXAS 75081-2275 TEL (214) 346-4200 FAX (214) 736-0965			
PROJECT	DESIGN	DRAWN	DATE
27530	MPB	TMM	OCTOBER 2010
FILE	SHEET		
27530 ALGN 01	HC-1		

RECORD DRAWINGS SHEET 9 OF 163

DESCRIPTION OF NORTH SIDEWALK CENTERLINE

Curve Data
 Curve SWN-3
 P.I. Station 11+73.96 N 10,015.0421 E 11,180.4747
 Delta = 20° 37' 24.93" (RT)
 Degree = 55° 05' 31.54"
 Tangent = 18.9221
 Length = 37.4348
 Radius = 104.0000
 External = 1.7074
 Long Chord = 37.2330
 Mid. Ord. = 1.6798
 P.C. Station 11+55.04 N 10,015.0534 E 11,161.5526
 P.T. Station 11+92.48 N 10,008.3667 E 11,198.1802
 C.C. N 9,911.0534 E 11,161.4906
 Back = S 89° 57' 57.13" E
 Ahead = S 69° 20' 32.20" E
 Chord Bear = S 79° 39' 14.66" E

Curve Data
 Curve SWN-4
 P.I. Station 12+49.82 N 9,988.1377 E 11,251.8344
 Delta = 42° 53' 04.07" (LT)
 Degree = 39° 14' 37.26"
 Tangent = 57.3410
 Length = 109.2774
 Radius = 146.0000
 External = 10.8566
 Long Chord = 106.7444
 Mid. Ord. = 10.1052
 P.C. Station 11+92.48 N 10,008.3667 E 11,198.1802
 P.T. Station 13+01.75 N 10,009.8282 E 11,304.9146
 C.C. N 10,144.9796 E 11,249.6867
 Back = S 69° 20' 32.20" E
 Ahead = N 67° 46' 23.73" E
 Chord Bear = N 89° 12' 55.77" E

Curve Data
 Curve SWN-5
 P.I. Station 13+49.44 N 10,027.8675 E 11,349.0597
 Delta = 59° 10' 08.61" (RT)
 Degree = 68° 12' 33.34"
 Tangent = 47.6886
 Length = 86.7464
 Radius = 84.0000
 External = 12.5930
 Long Chord = 82.9428
 Mid. Ord. = 10.9512
 P.C. Station 13+01.75 N 10,009.8282 E 11,304.9146
 P.T. Station 13+88.50 N 9,999.2061 E 11,387.1744
 C.C. N 9,932.0699 E 11,336.6895
 Back = N 67° 46' 23.73" E
 Ahead = S 53° 03' 27.65" E
 Chord Bear = S 82° 38' 31.96" E

Curve Data
 Curve SWN-6
 P.I. Station 13+98.12 N 9,993.4257 E 11,394.8614
 Delta = 36° 41' 46.54" (LT)
 Degree = 197° 34' 17.95"
 Tangent = 9.6179
 Length = 18.5736
 Radius = 29.0000
 External = 1.5533
 Long Chord = 18.2578
 Mid. Ord. = 1.4743
 P.C. Station 13+88.50 N 9,999.2061 E 11,387.1744
 P.T. Station 14+07.07 N 9,993.3844 E 11,404.4792
 C.C. N 10,022.3841 E 11,404.6037
 Back = S 53° 03' 27.65" E
 Ahead = S 89° 45' 14.20" E
 Chord Bear = S 71° 24' 20.92" E

Course from PT SWN-6 to PC SWN-7 S 89° 45' 14.20" E Dist 45.9500

DESCRIPTION OF NORTH SIDEWALK CENTERLINE

Curve Data
 Curve SWN-7
 P.I. Station 14+60.30 N 9,993.1558 E 11,457.7040
 Delta = 28° 09' 59.68" (LT)
 Degree = 197° 34' 17.95"
 Tangent = 7.2753
 Length = 14.2564
 Radius = 29.0000
 External = 0.8987
 Long Chord = 14.1133
 Mid. Ord. = 0.8717
 P.C. Station 14+53.02 N 9,993.1871 E 11,450.4287
 P.T. Station 14+67.28 N 9,996.5625 E 11,464.1324
 C.C. N 10,022.1868 E 11,450.5533
 Back = S 89° 45' 14.20" E
 Ahead = N 62° 04' 46.12" E
 Chord Bear = N 76° 09' 45.96" E

Curve Data
 Curve SWN-8
 P.I. Station 14+69.54 N 9,997.6197 E 11,466.1274
 Delta = 28° 09' 59.68" (RT)
 Degree = 636° 37' 11.18"
 Tangent = 2.2579
 Length = 4.4244
 Radius = 9.0000
 External = 0.2789
 Long Chord = 4.3800
 Mid. Ord. = 0.2705
 P.C. Station 14+67.28 N 9,996.5625 E 11,464.1324
 P.T. Station 14+71.70 N 9,997.6100 E 11,468.3853
 C.C. N 9,988.6101 E 11,468.3466
 Back = N 62° 04' 46.12" E
 Ahead = S 89° 45' 14.20" E
 Chord Bear = N 76° 09' 45.96" E

Course from PT SWN-8 to 401 S 89° 45' 14.20" E Dist 57.4936
 Point 401 N 9,997.3631 E 11,525.8783 Sta 15+29.20
 Course from 401 to 402 S 89° 45' 14.20" E Dist 60.2069
 Point 402 N 9,997.1045 E 11,586.0847 Sta 15+89.40
 Course from 402 to PC SWN-9 S 89° 45' 14.20" E Dist 62.7906

Curve Data
 Curve SWN-9
 P.I. Station 16+74.40 N 9,996.7395 E 11,671.0802
 Delta = 21° 40' 26.04" (LT)
 Degree = 49° 23' 34.49"
 Tangent = 22.2057
 Length = 43.8806
 Radius = 116.0000
 External = 2.1063
 Long Chord = 43.6194
 Mid. Ord. = 2.0687
 P.C. Station 16+52.19 N 9,996.8349 E 11,648.8747
 P.T. Station 16+96.08 N 10,004.8519 E 11,691.7510
 C.C. N 10,112.8338 E 11,649.3729
 Back = S 89° 45' 14.20" E
 Ahead = N 68° 34' 19.76" E
 Chord Bear = N 79° 24' 32.78" E

Curve Data
 Curve SWN-10
 P.I. Station 17+49.95 N 10,024.5349 E 11,741.9045
 Delta = 46° 58' 10.26" (RT)
 Degree = 46° 12' 22.59"
 Tangent = 53.8775
 Length = 101.6518
 Radius = 124.0000
 External = 11.1991
 Long Chord = 98.8293
 Mid. Ord. = 10.2714
 P.C. Station 16+96.08 N 10,004.8519 E 11,691.7510
 P.T. Station 17+97.73 N 10,001.3047 E 11,790.5166
 C.C. N 9,889.4230 E 11,737.0519
 Back = N 68° 34' 19.76" E
 Ahead = S 64° 27' 29.98" E
 Chord Bear = S 87° 56' 35.11" E


DESCRIPTION OF NORTH SIDEWALK CENTERLINE



Curve Data
 Curve SWN-11
 P.I. Station 18+24.29 N 9,989.8505 E 11,814.4860
 Delta = 60° 00' 49.87" (LT)
 Degree = 124° 33' 21.75"
 Tangent = 26.5655
 Length = 48.1822
 Radius = 46.0000
 External = 7.1199
 Long Chord = 46.0096
 Mid. Ord. = 6.1656
 P.C. Station 17+97.73 N 10,001.3047 E 11,790.5166
 P.T. Station 18+45.91 N 10,004.8868 E 11,836.3866
 C.C. N 10,042.8092 E 11,810.3503
 Back = S 64° 27' 29.98" E
 Ahead = N 55° 31' 40.15" E
 Chord Bear = N 85° 32' 05.09" E

Curve Data
 Curve SWN-12
 P.I. Station 18+62.18 N 10,014.0956 E 11,849.7995
 Delta = 36° 44' 10.63" (RT)
 Degree = 116° 55' 48.58"
 Tangent = 16.2699
 Length = 31.4173
 Radius = 49.0000
 External = 2.6305
 Long Chord = 30.8819
 Mid. Ord. = 2.4965
 P.C. Station 18+45.91 N 10,004.8868 E 11,836.3866
 P.T. Station 18+77.33 N 10,013.4529 E 11,866.0567
 C.C. N 9,964.4911 E 11,864.1209
 Back = N 55° 31' 40.15" E
 Ahead = S 87° 44' 09.22" E
 Chord Bear = N 73° 53' 45.47" E

Course from PT SWN-12 to PC SWN-13 S 89° 59' 52.20" E Dist 82.5311

RECORD DOCUMENTS
 December, 2011
 These Record Documents have been prepared based upon information provided by North Texas Contracting, Inc. The Design Professional has not verified the accuracy and / or completeness of this information and shall not be responsible for any errors or omissions which may be incorporated herein as a result.
 Design Consultant: Half Associates, Inc.
 RECORD DRAWING SUBMITTAL


 Signature of Registrant: *M.E. Romanowski* Date: 12/8/2011

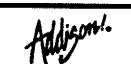NO.	REVISION	BY	DATE
 TOWN OF ADDISON DALLAS COUNTY, TEXAS SPRING VALLEY ROAD HORIZONTAL CONTROL SHEET			
 1201 NORTH BOWSER ROAD, RICHARDSON, TEXAS 75081-2275 TEL (214) 348-8200 FAX (214) 730-0095			
PROJECT	DESIGN	DRAWN	DATE
27530	MPB	TMM	OCTOBER 2010
FILE	SHEET		
27530 ALGN 02	HC-2		

USER: ohi299
 OFFICE: RCH
 PROJECT: 27530
 FILE: 27530 ALGN 02.dgn
 TIME: 10:07:48 AM
 DATE: 12/7/2011

SHEET 10 OF 163 RECORD DRAWINGS

DESCRIPTION OF NORTH SIDEWALK CENTERLINE

Curve Data

Curve SWN-13
 P.I. Station 19+74.62 N 10,013.4497 E 11,963.3499
 Delta = 32° 53' 51.75" (RT)
 Degree = 114° 35' 29.61"
 Tangent = 14.7621
 Length = 28.7087
 Radius = 50.0000
 External = 2.1337
 Long Chord = 28.3159
 Mid. Ord. = 2.0464
 P.C. Station 19+59.86 N 10,013.4497 E 11,948.5878
 P.T. Station 19+88.57 N 10,005.4318 E 11,975.7448
 C.C. N 9,963.4497 E 11,948.5878
 Back = Due East
 Ahead = S 57° 06' 08.25" E
 Chord Bear = S 73° 33' 04.13" E

Course from PT SWN-13 to PC SWN-14 S 57° 06' 08.25" E Dist 3.8903

Curve Data


Curve SWN-14
 P.I. Station 20+07.10 N 9,995.3643 E 11,991.3082
 Delta = 32° 39' 05.95" (LT)
 Degree = 114° 35' 29.61"
 Tangent = 14.6455
 Length = 28.4939
 Radius = 50.0000
 External = 2.1008
 Long Chord = 28.1099
 Mid. Ord. = 2.0161
 P.C. Station 19+92.46 N 10,003.3189 E 11,979.0112
 P.T. Station 20+20.95 N 9,995.3014 E 12,005.9536
 C.C. N 10,045.3009 E 12,006.1683
 Back = S 57° 06' 08.25" E
 Ahead = S 89° 45' 14.20" E
 Chord Bear = S 73° 25' 41.22" E


Course from PT SWN-14 to 403 S 89° 45' 14.20" E Dist 7.3150

Point 403 N 9,995.2700 E 12,013.2685 Sta 20+28.27

RECORD DOCUMENTS
 December, 2011
 These Record Documents have been prepared based upon information provided by North Texas Contracting, Inc. The Design Professional has not verified the accuracy and / or completeness of this information and shall not be responsible for any errors or omissions which may be incorporated herein as a result


Design Consultant: Half Associates, Inc.
 RECORD DRAWING SUBMITTAL


M.E. Romanowski 12/6/2011
 Signature of Registrant Date

NO.	REVISION	BY	DATE
<i>Addison!</i> TOWN OF ADDISON DALLAS COUNTY, TEXAS			
SPRING VALLEY ROAD			
HORIZONTAL CONTROL SHEET			
 HALFF		1201 NORTH BOWSER ROAD, RICHARDSON, TEXAS 75081-2275 TEL (214) 348-8200 FAX (214) 738-0095	
PROJECT	DESIGN	DRAWN	DATE
27530	MPB	TMM	OCTOBER 2010
FILE	SHEET		
27530 ALGN 03	HC-3		

DATE: 12/7/2011 TIME: 10:08:03 AM FILE: 27530 ALGN 03.dgn PROJECT * 27530 OFFICE: RCH USER: gh1299

DATE: 12/7/2011 TIME: 10:08:20 AM FILE: 27530 ALGN 04.dgn PROJECT: 27530 OFFICE: RCH USER: ch1299

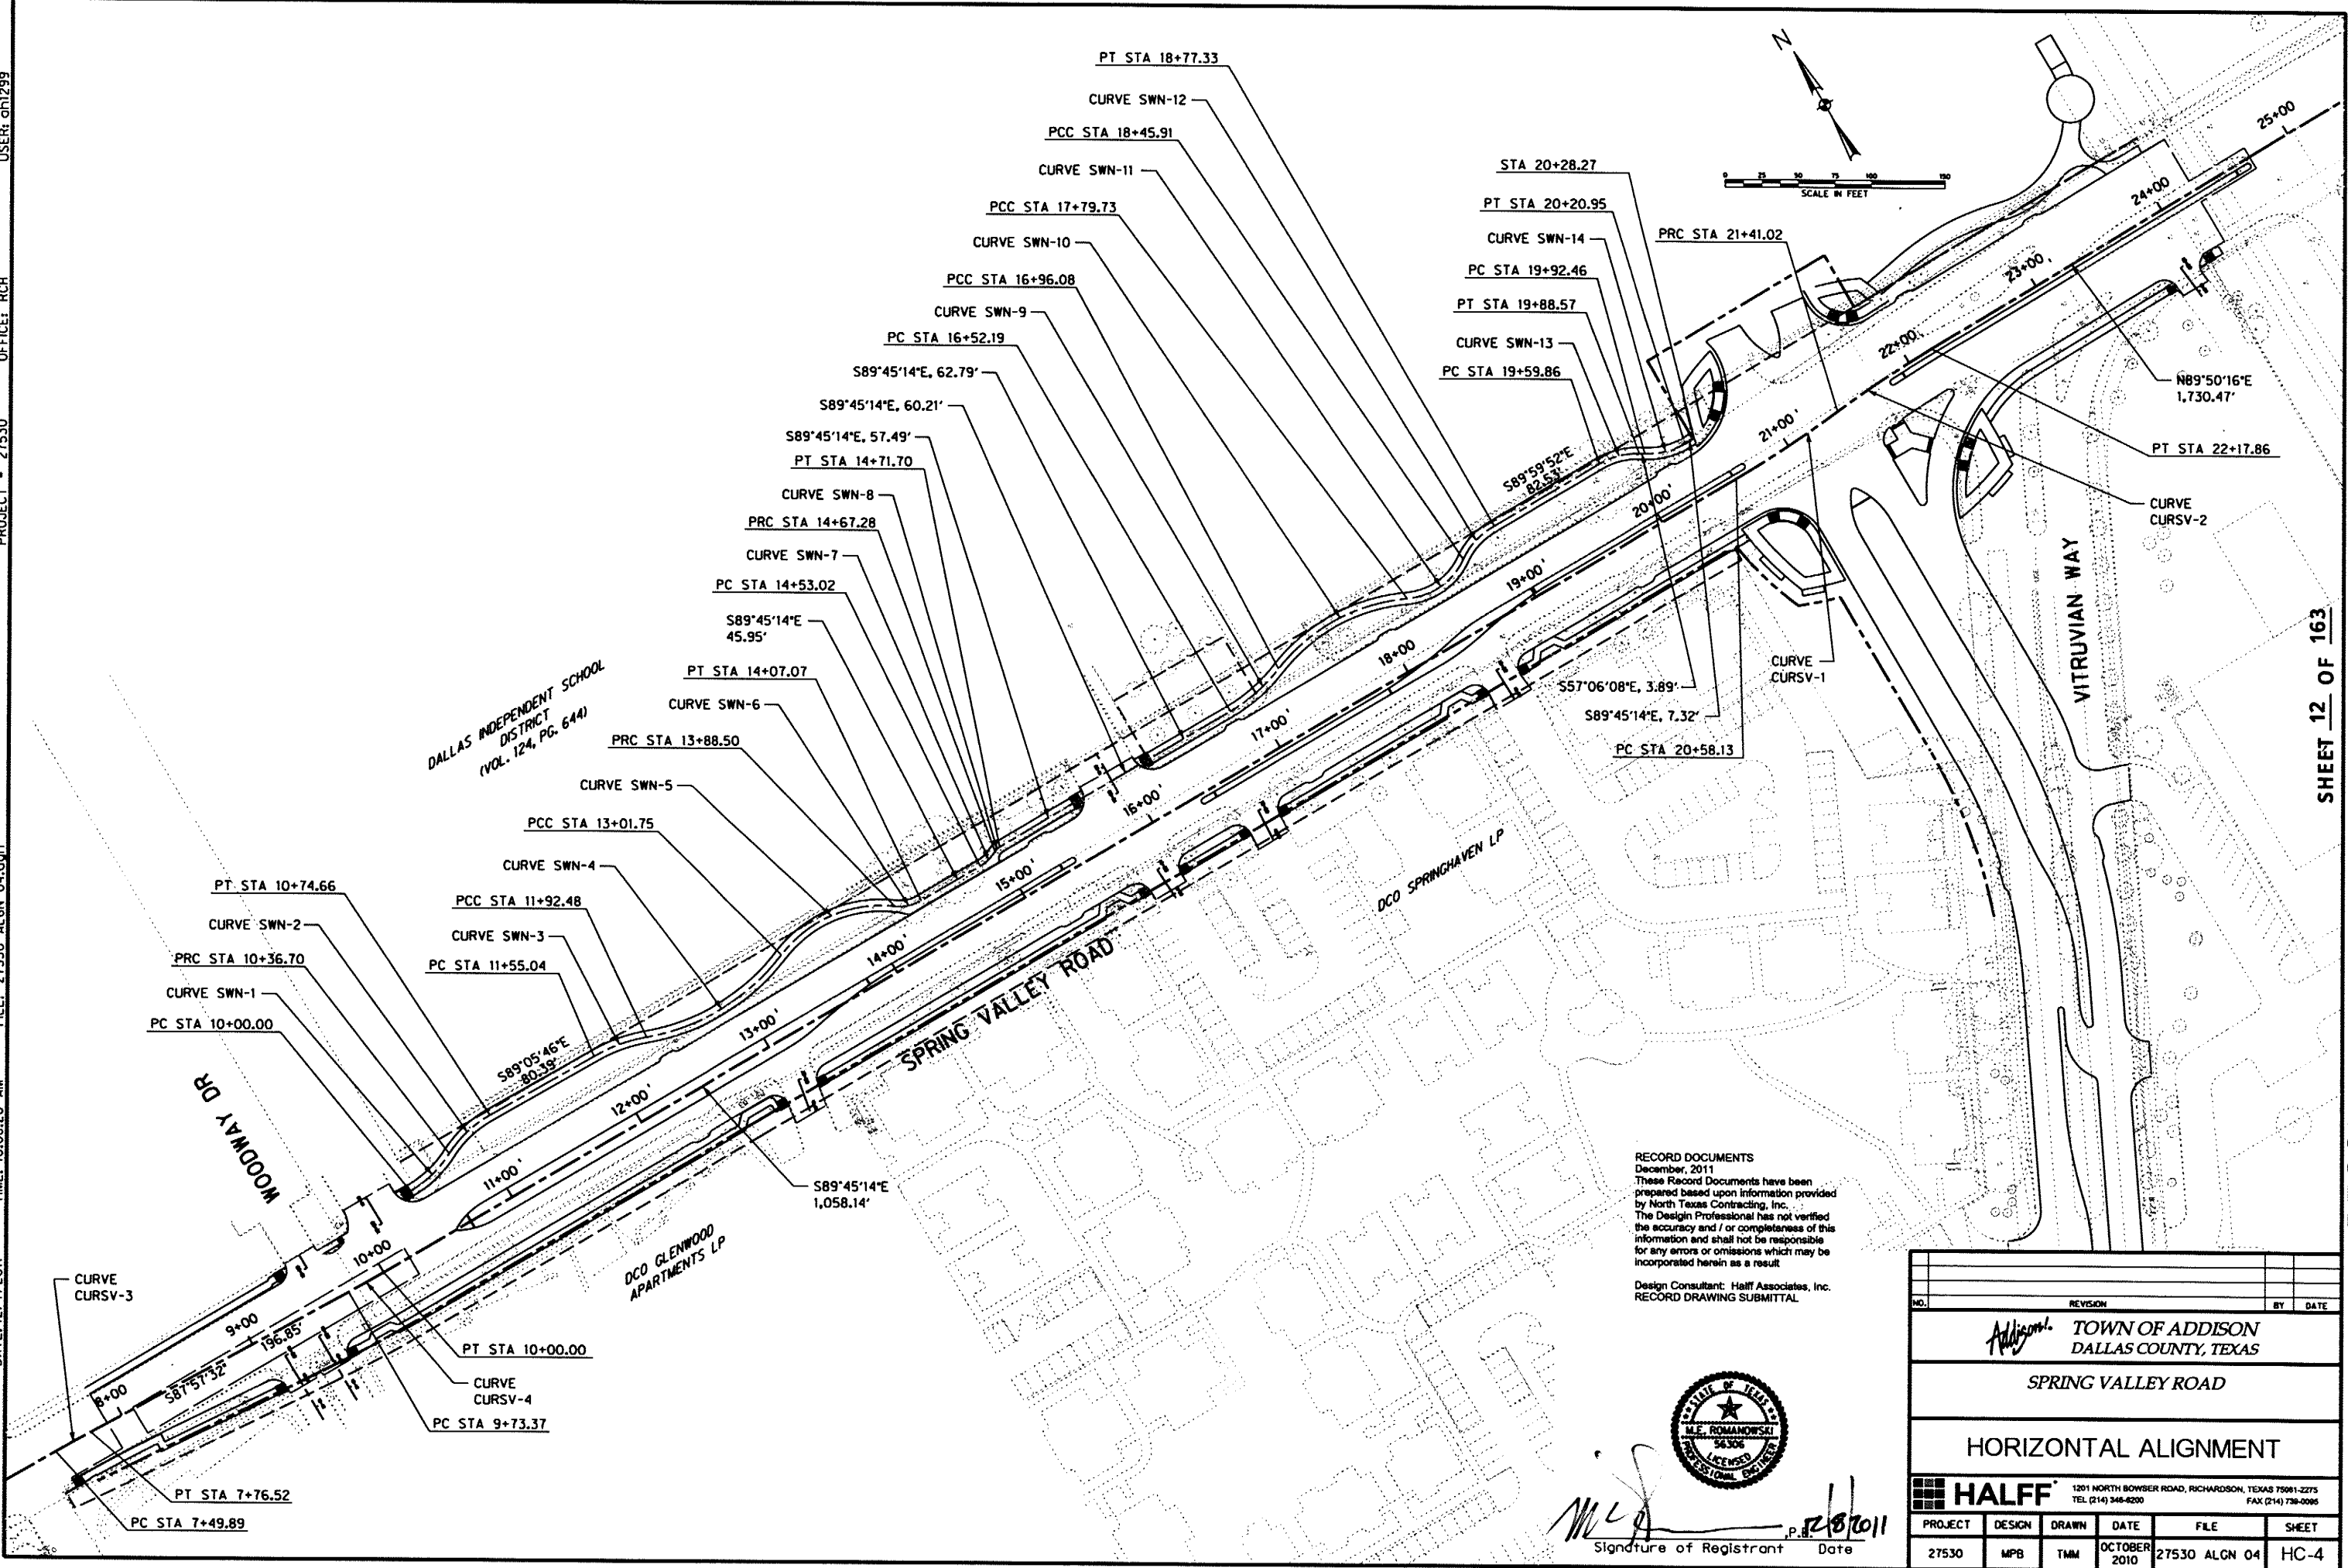

RECORD DOCUMENTS
 December, 2011
 These Record Documents have been prepared based upon information provided by North Texas Contracting, Inc. The Design Professional has not verified the accuracy and / or completeness of this information and shall not be responsible for any errors or omissions which may be incorporated herein as a result.

Design Consultant: Halff Associates, Inc.
 RECORD DRAWING SUBMITTAL



M.E. Romanowski
 Signature of Registrant Date 12/8/2011

NO.	REVISION	BY	DATE
TOWN OF ADDISON DALLAS COUNTY, TEXAS SPRING VALLEY ROAD HORIZONTAL ALIGNMENT			
HALFF 1201 NORTH BOWSER ROAD, RICHARDSON, TEXAS 75081-2275 TEL (214) 346-8200 FAX (214) 739-0095			
PROJECT	DESIGN	DRAWN	DATE
27530	MPB	TMM	OCTOBER 2010
FILE	SHEET		
27530 ALGN 04	HC-4		

USER: oh1299
 OFFICE: RCH
 PROJECT: 27530
 FILE: 27530 PAVM 01 (REV 2) 1.dgn
 DATE: 12/7/2011
 TIME: 10:08:56 AM




LEGEND

- PERMANENT REINFORCED CONCRETE PAVEMENT CONSTRUCTION
- CONC MEDIAN NOSE PAVER
- CONC PAVER

RECORD DOCUMENTS
 December, 2011
 These Record Documents have been prepared based upon information provided by North Texas Contracting, Inc. The Design Professional has not verified the accuracy and / or completeness of this information and shall not be responsible for any errors or omissions which may be incorporated herein as a result.
 Design Consultant: Half Associates, Inc.
 RECORD DRAWING SUBMITTAL


BACK OF CURB PC/PT/PRC/PCC
 SPRING VALLEY ROAD

NO	DESC	STATION	OFFSET
1	PC	10+81.35	7.00' LT
2	PT	10+57.80	1.11' LT
3	PC	10+57.80	1.10' RT
4	PT	10+81.37	7.00' RT
5	PC	7+49.89	22.21' RT
6	PT	8+11.46	22.94' RT
7	PT	9+99.87	29.00' LT
8	PI	10+20.00	13.02' RT
9	PI	7+89.71	19.67' RT
10	PI	7+88.18	22.11' LT
11	PI	8+09.70	18.96' RT
12	PI	8+08.97	1.08' LT
13	PI	10+20.00	6.96' LT
14	PC	10+48.36	29.00' LT

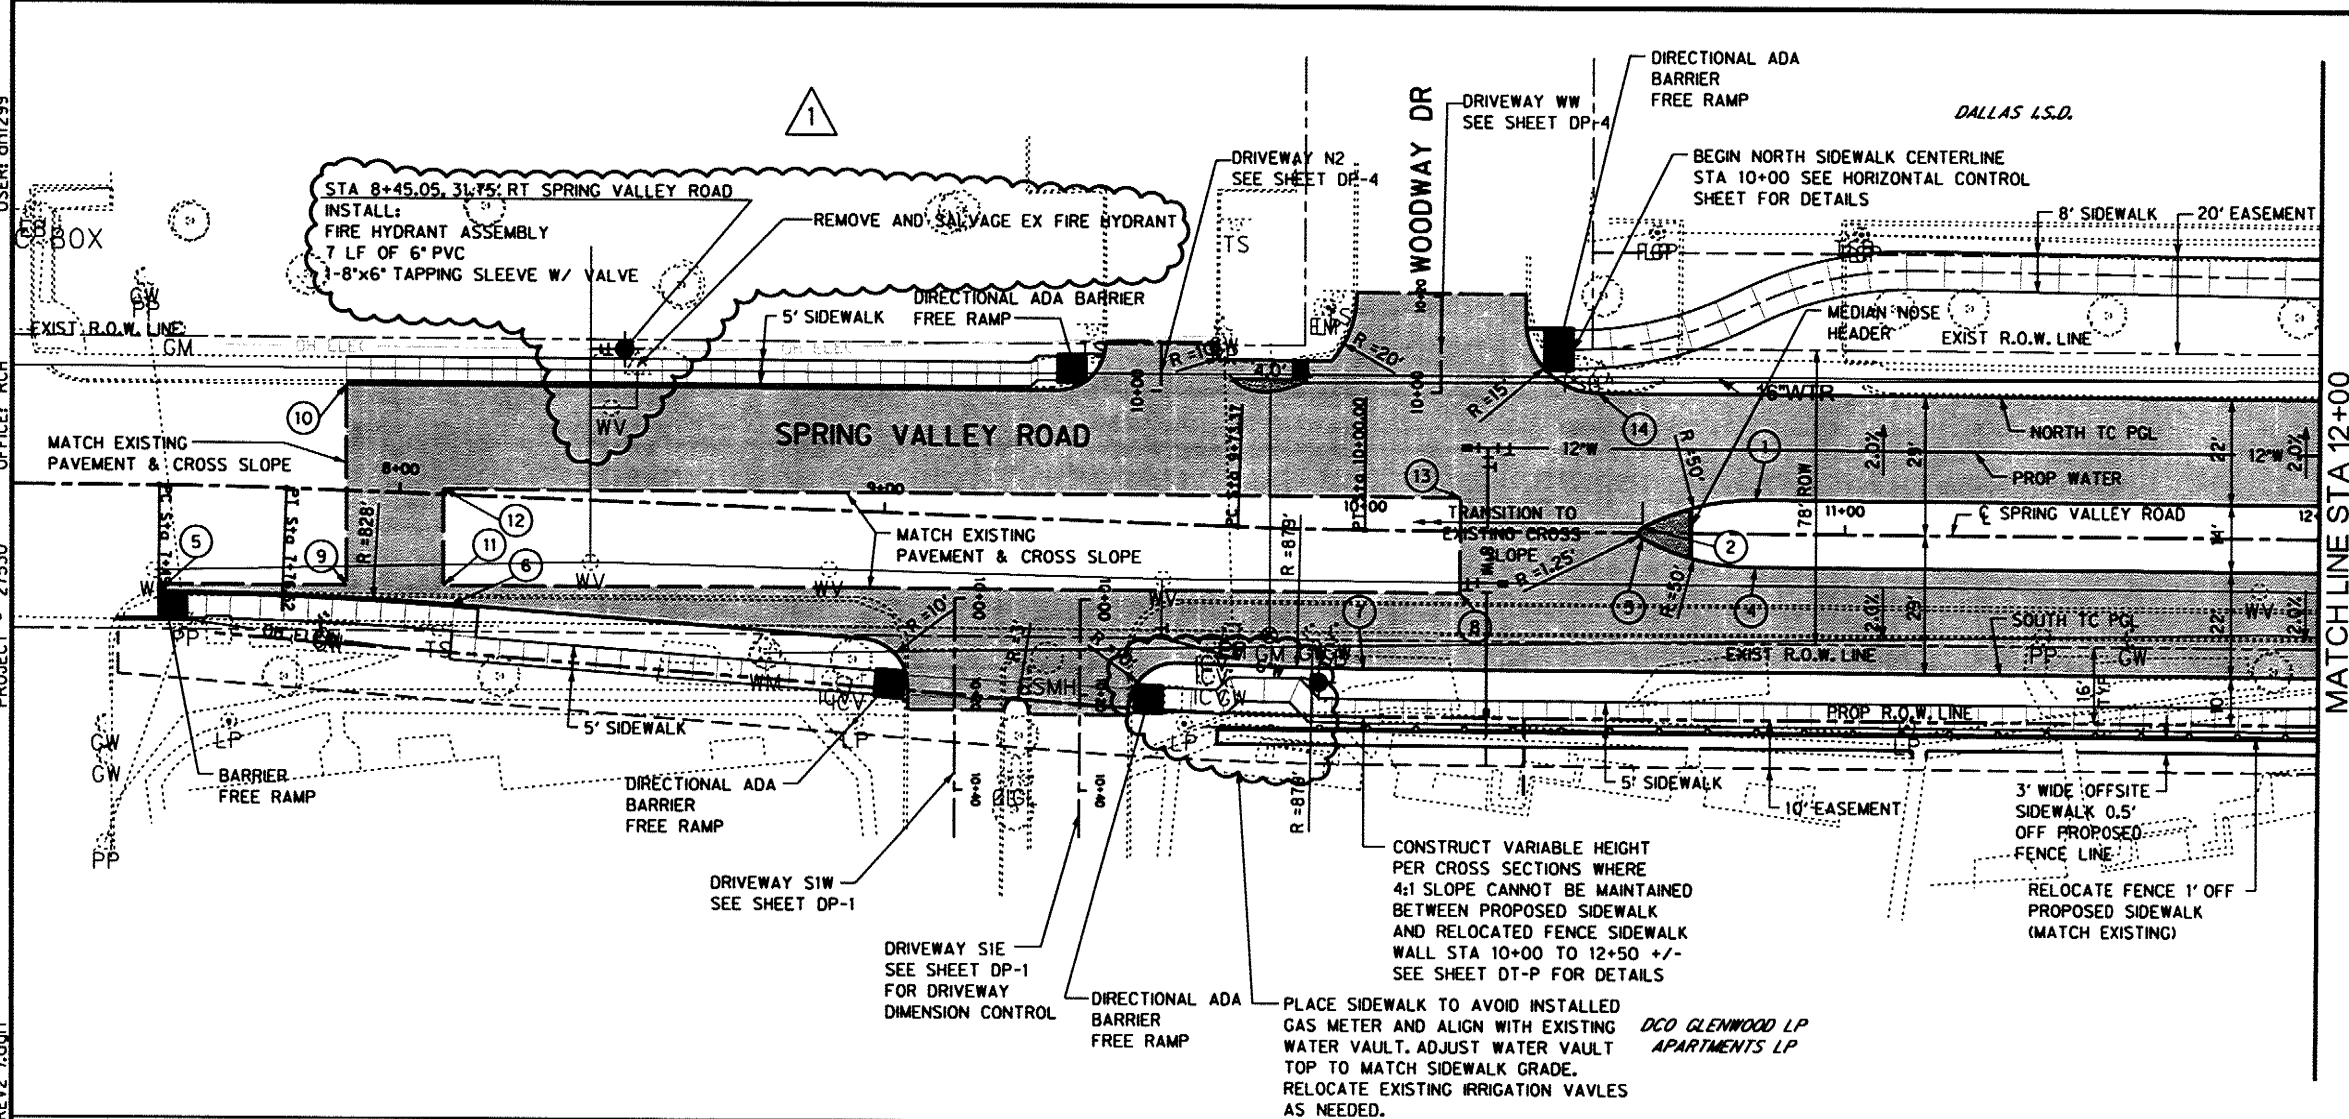

CONSTRUCT VARIABLE HEIGHT PER CROSS SECTIONS WHERE 4:1 SLOPE CANNOT BE MAINTAINED BETWEEN PROPOSED SIDEWALK AND RELOCATED FENCE SIDEWALK WALL STA 10+00 TO 12+50 +/- SEE SHEET DT-P FOR DETAILS

PLACE SIDEWALK TO AVOID INSTALLED GAS METER AND ALIGN WITH EXISTING WATER VAULT. ADJUST WATER VAULT TOP TO MATCH SIDEWALK GRADE. RELOCATE EXISTING IRRIGATION VAVLES AS NEEDED.



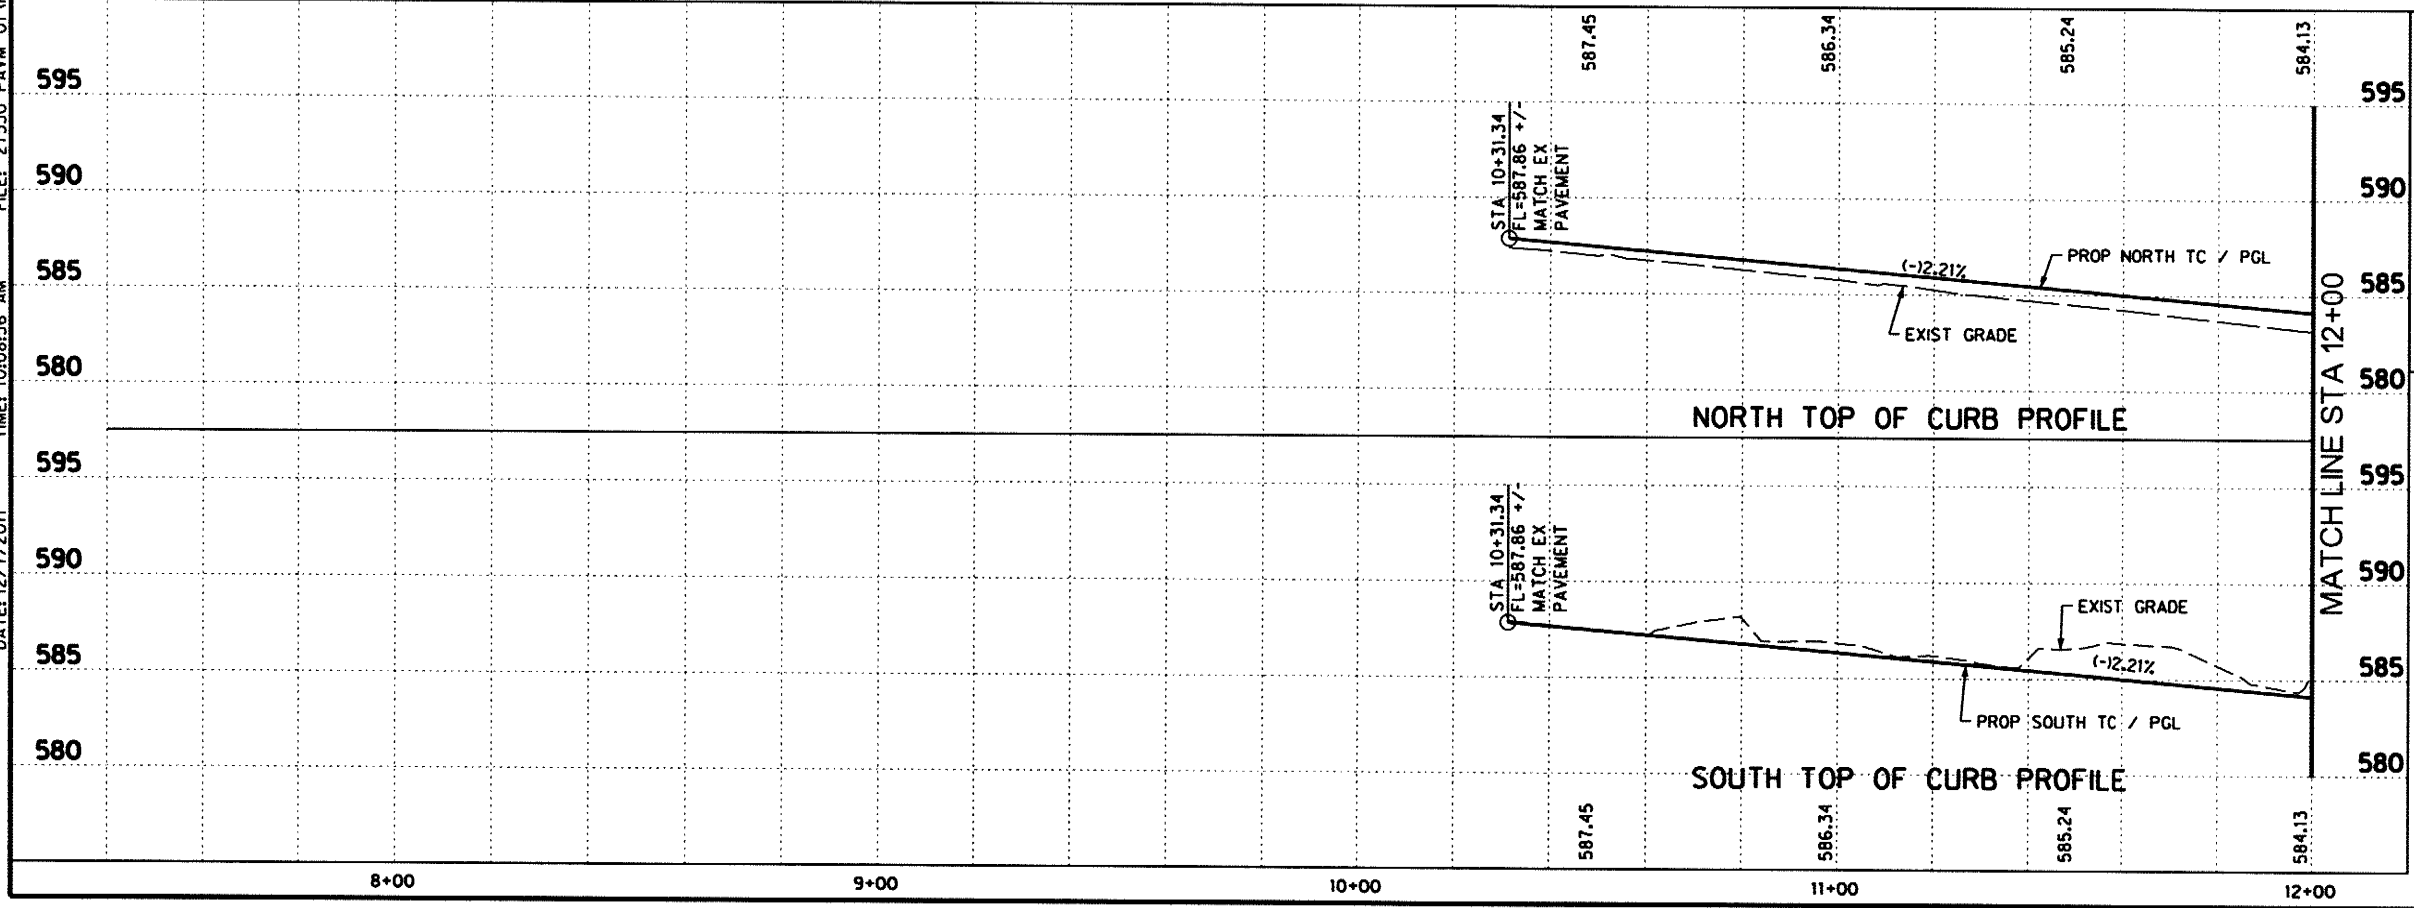


Signature of Registrant: *M.E. Romanowski*
 Date: 12/8/2011

1	WATER LINE AND SIDEWALK REVISION	MER	2/09/11
2	PAVING AND SIDEWALK REVISION	MER	3/17/11
NO.	REVISION	BY	DATE
TOWN OF ADDISON DALLAS COUNTY, TEXAS SPRING VALLEY ROAD PAVING PLAN AND PROFILE STA 7+49.89 TO 12+00 HALFF 1201 NORTH BOWSER ROAD, RICHARDSON, TEXAS 75081-2275 TEL (214) 348-4200 FAX (214) 730-0085			
PROJECT	DESIGN	DRAWN	DATE
27530	MPB	TMM	OCTOBER 2010
FILE	SHEET		
27530 PAVM 01	P1		

SHEET 13 OF 163
 RECORD DRAWINGS

DATE: 12/7/2011 TIME: 10:09:33 AM FILE: 27530 PAVM_02 (REV 1).dgn PROJECT: 27530 OFFICE: RCH USER: oh1299

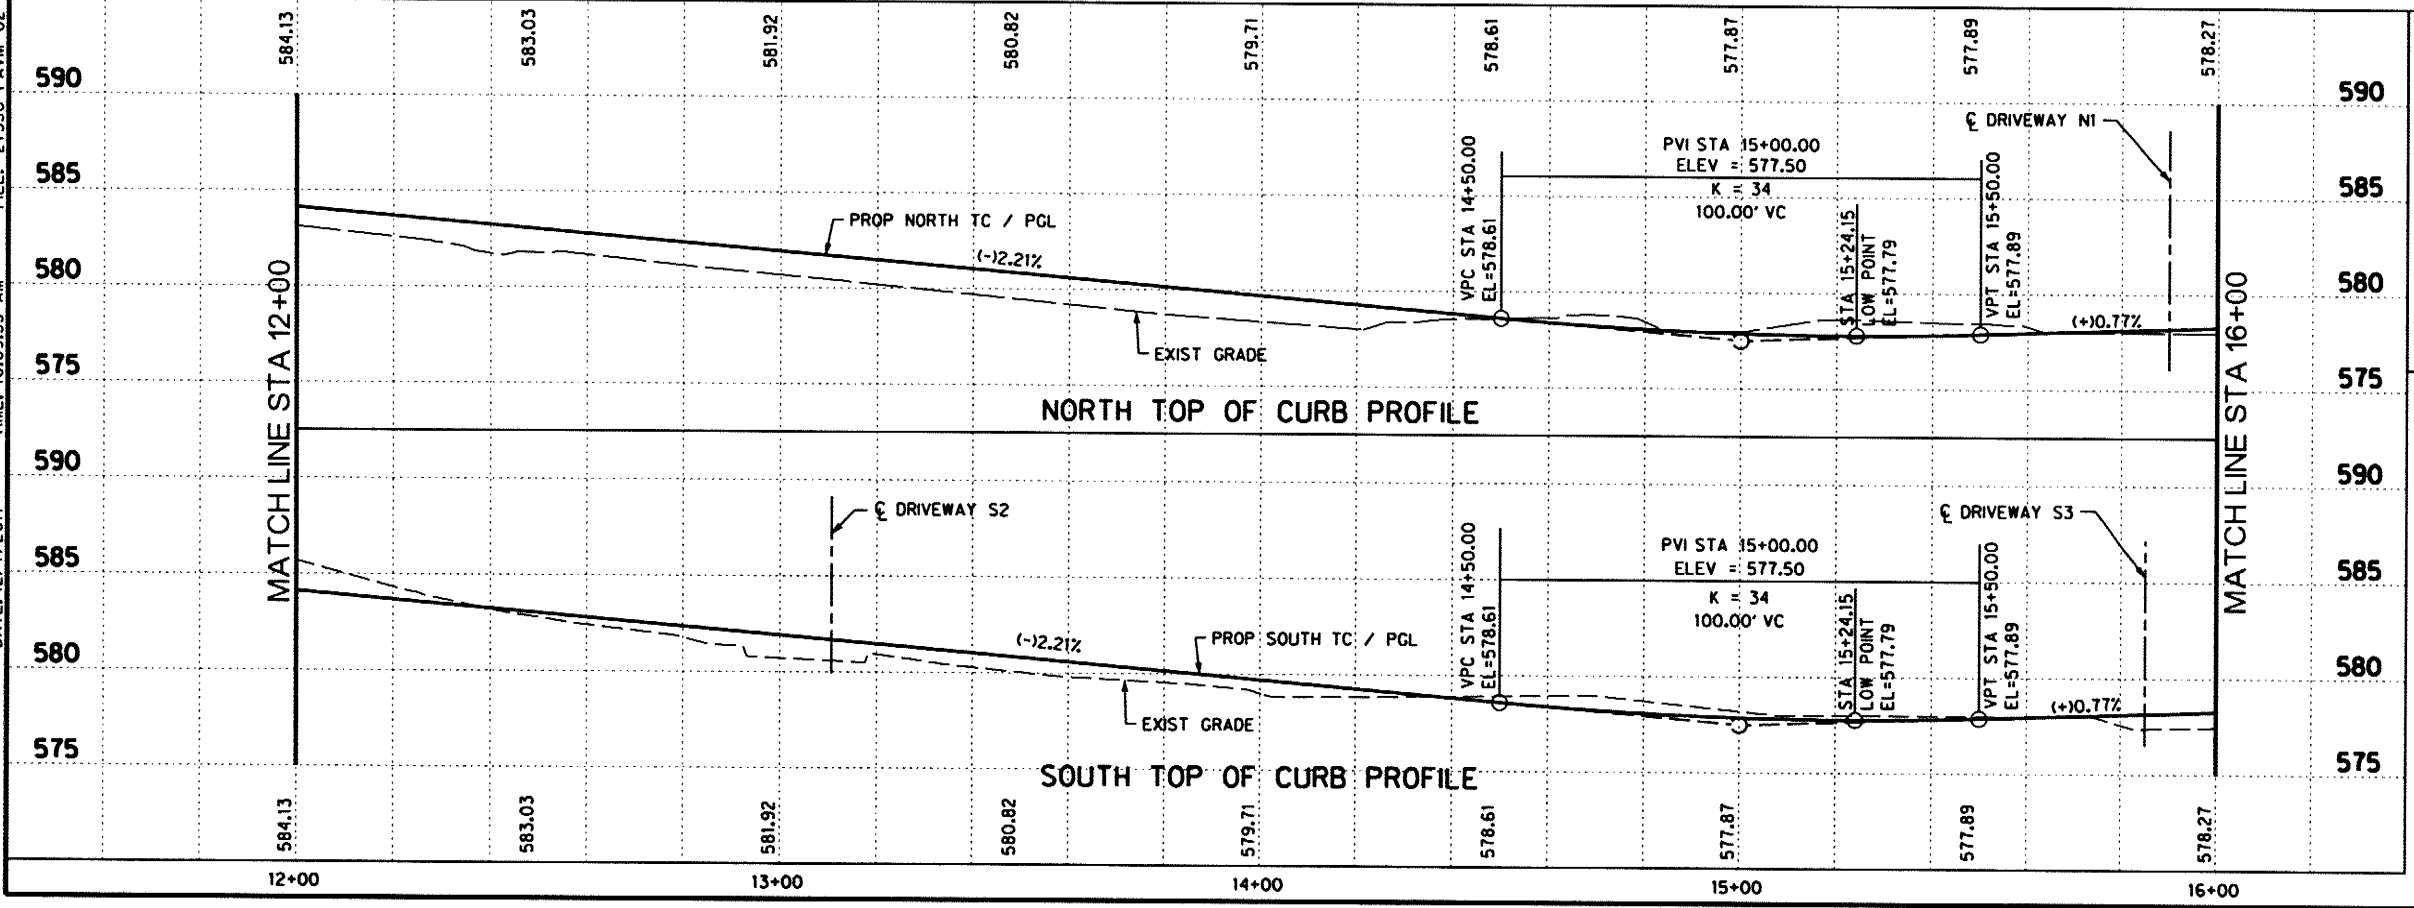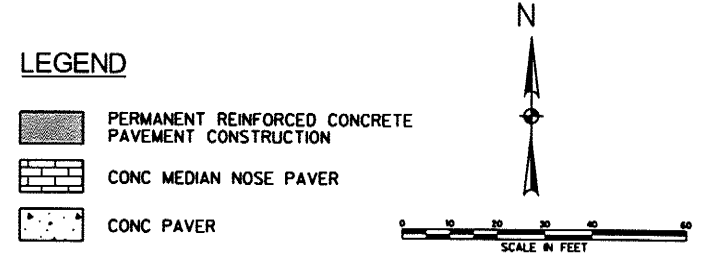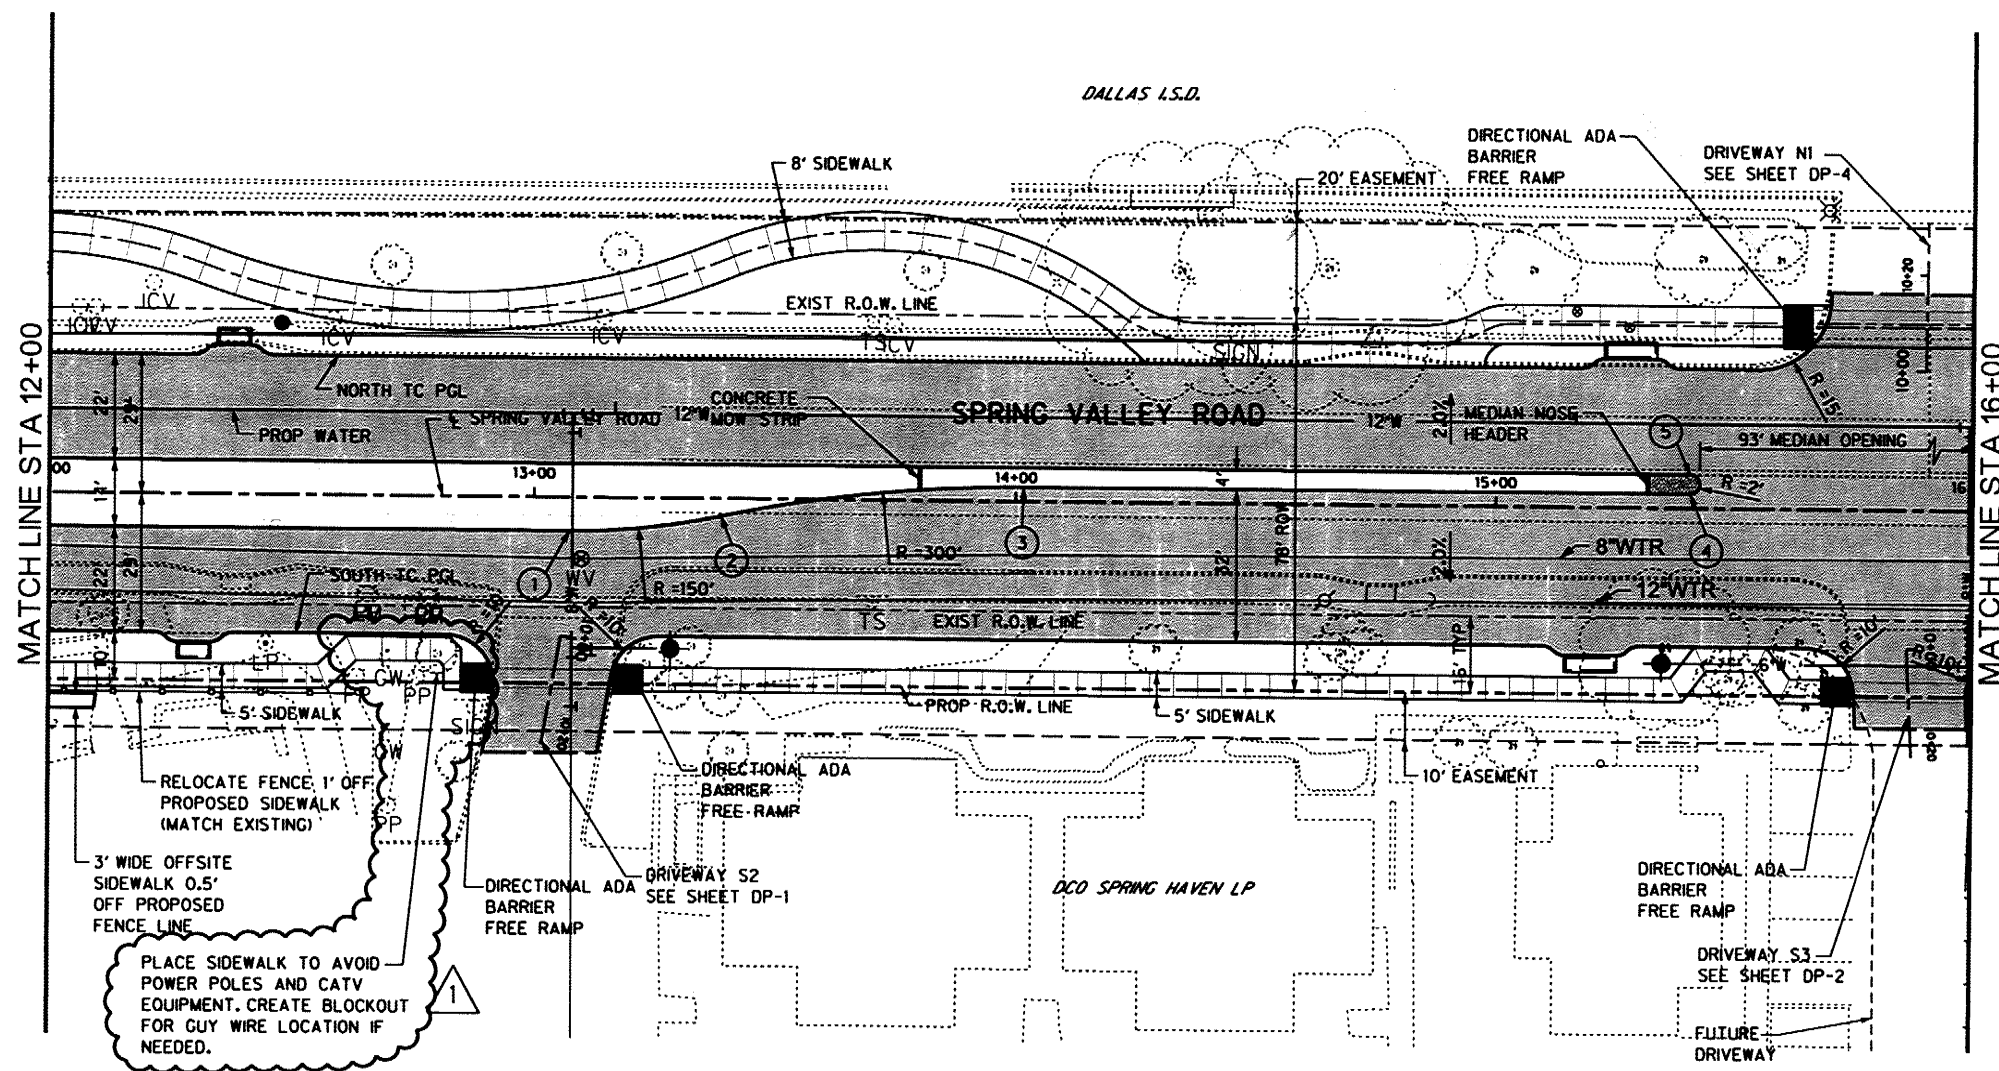


Signature of Registrant: *M.E. Romanowski*
 Date: 12/8/2011

1	SIDEWALK RE-ALIGNMENT	MER	1/27/11
NO.	REVISION	BY	DATE
TOWN OF ADDISON DALLAS COUNTY, TEXAS SPRING VALLEY ROAD PAVING PLAN AND PROFILE STA 12+00 TO 16+00			
HALFF 1201 NORTH BOWSER ROAD, RICHARDSON, TEXAS 75081-2275 TEL (214) 346-8200 FAX (214) 739-0095			
PROJECT	DESIGN	DRAWN	DATE
27530	MPB	TMM	OCTOBER 2010
FILE	SHEET		
27530 PAVM02	P2		


RECORD DRAWINGS SHEET 14 OF 163

USER: gh1299
 OFFICE: RCH
 PROJECT: 27530
 FILE: 27530 PAVM 03.dgn
 TIME: 10:09:51 AM
 DATE: 12/7/2011

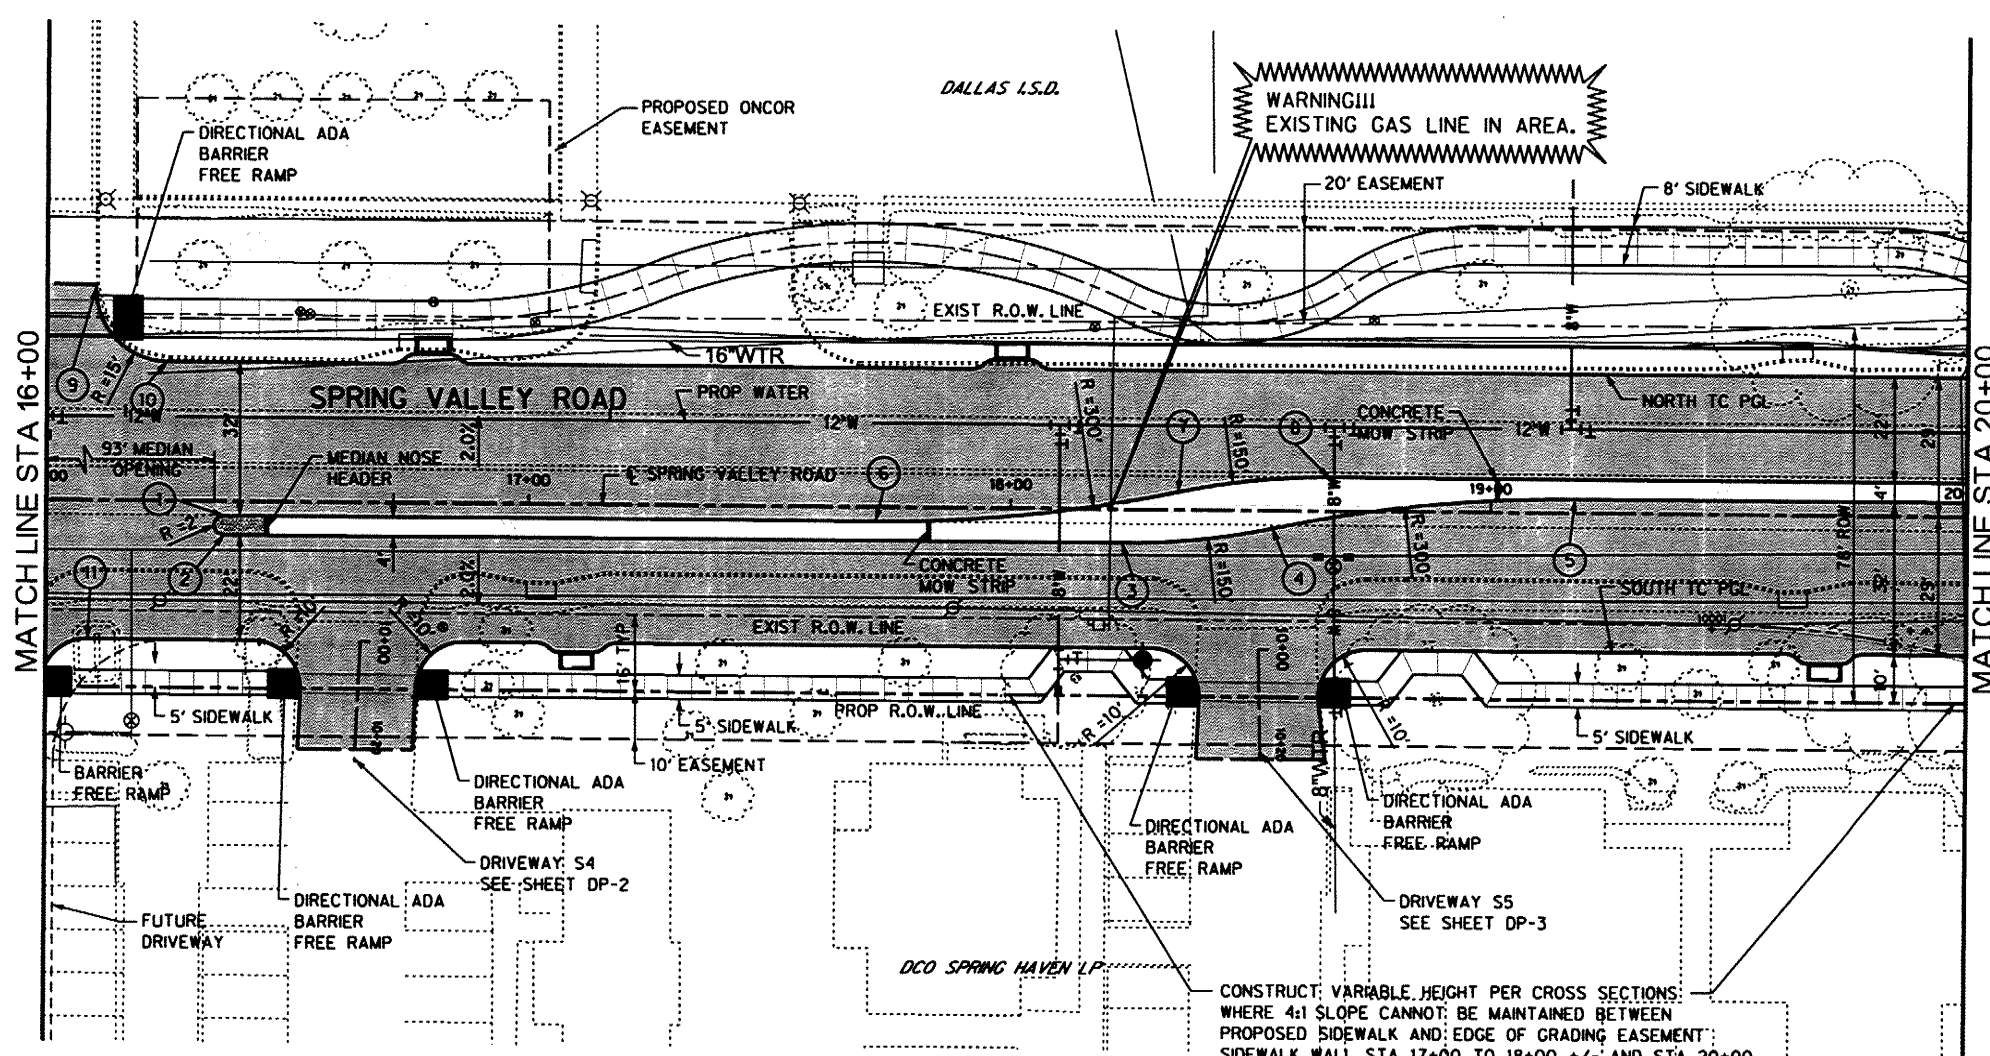

LEGEND

- PERMANENT REINFORCED CONCRETE PAVEMENT CONSTRUCTION
- CONC MEDIAN NOSE PAVER
- CONC PAVER

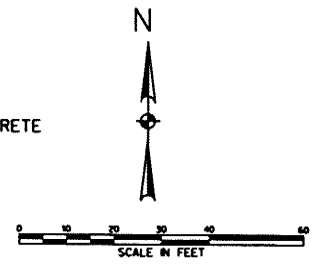


BACK OF CURB PC/PT/PRC/PCC
 SPRING VALLEY ROAD

NO	DESC	STATION	OFFSET
1	PC	16+37.20	3.00' RT
2	PT	16+37.20	7.00' RT
3	PC	18+23.31	7.00' RT
4	PRC	18+54.76	3.67' RT
5	PT	19+17.65	3.00' LT
6	PC	17+72.08	3.00' RT
7	PRC	18+34.97	3.67' LT
8	PT	18+66.42	7.00' LT
9	PC	16+10.34	44.13' LT
10	PT	16+25.34	29.00' LT
11	PT	16+08.89	29.00' RT

RECORD DOCUMENTS
 December, 2011
 These Record Documents have been prepared based upon information provided by North Texas Contracting, Inc. The Design Professional has not verified the accuracy and / or completeness of this information and shall not be responsible for any errors or omissions which may be incorporated herein as a result.

Design Consultant: Helff Associates, Inc.
 RECORD DRAWING SUBMITTAL

CONSTRUCT VARIABLE HEIGHT PER CROSS SECTIONS WHERE 4:1 SLOPE CANNOT BE MAINTAINED BETWEEN PROPOSED SIDEWALK AND EDGE OF GRADING EASEMENT; SIDEWALK WALL STA 17+00 TO 18+00 +/- AND STA 20+00 SEE SHEET DT-P FOR DETAILS

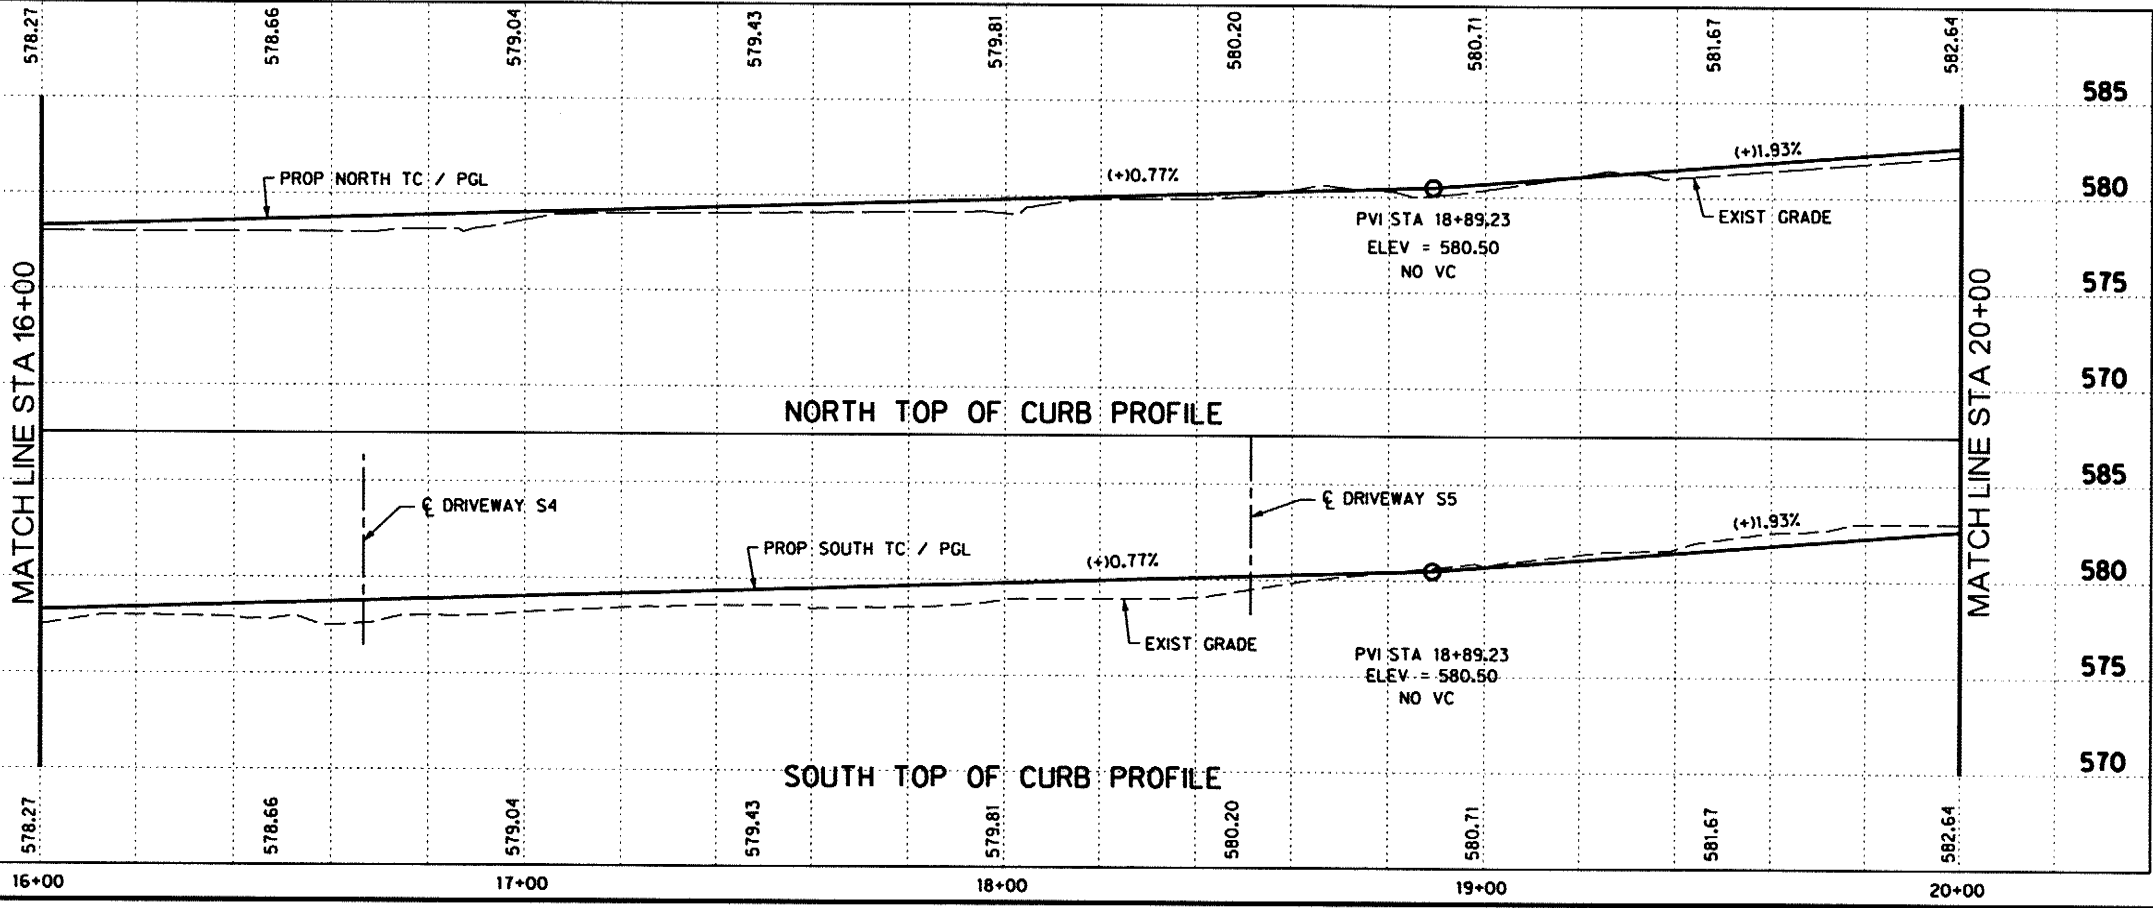

M.E. Romowski
 Signature of Registrant
 Date: 12/6/2011

NO.	REVISION	BY	DATE

TOWN OF ADDISON
 DALLAS COUNTY, TEXAS

SPRING VALLEY ROAD

PAVING PLAN AND PROFILE
 STA 16+00 TO 20+00

HALFF 1201 NORTH BOWSER ROAD, RICHARDSON, TEXAS 75081-2275
 TEL (214) 348-8200 FAX (214) 738-0085

PROJECT	DESIGN	DRAWN	DATE	FILE	SHEET
27530	MPB	TMM	OCTOBER 2010	27530 PAVM03	P3

SHEET 15 OF 163
 RECORD DRAWINGS

USER: oh299


OFFICE: RCH

PROJECT: 27530

FILE: 27530 PAVM 04.dgn

TIME: 10:10:07 AM

DATE: 12/7/2011

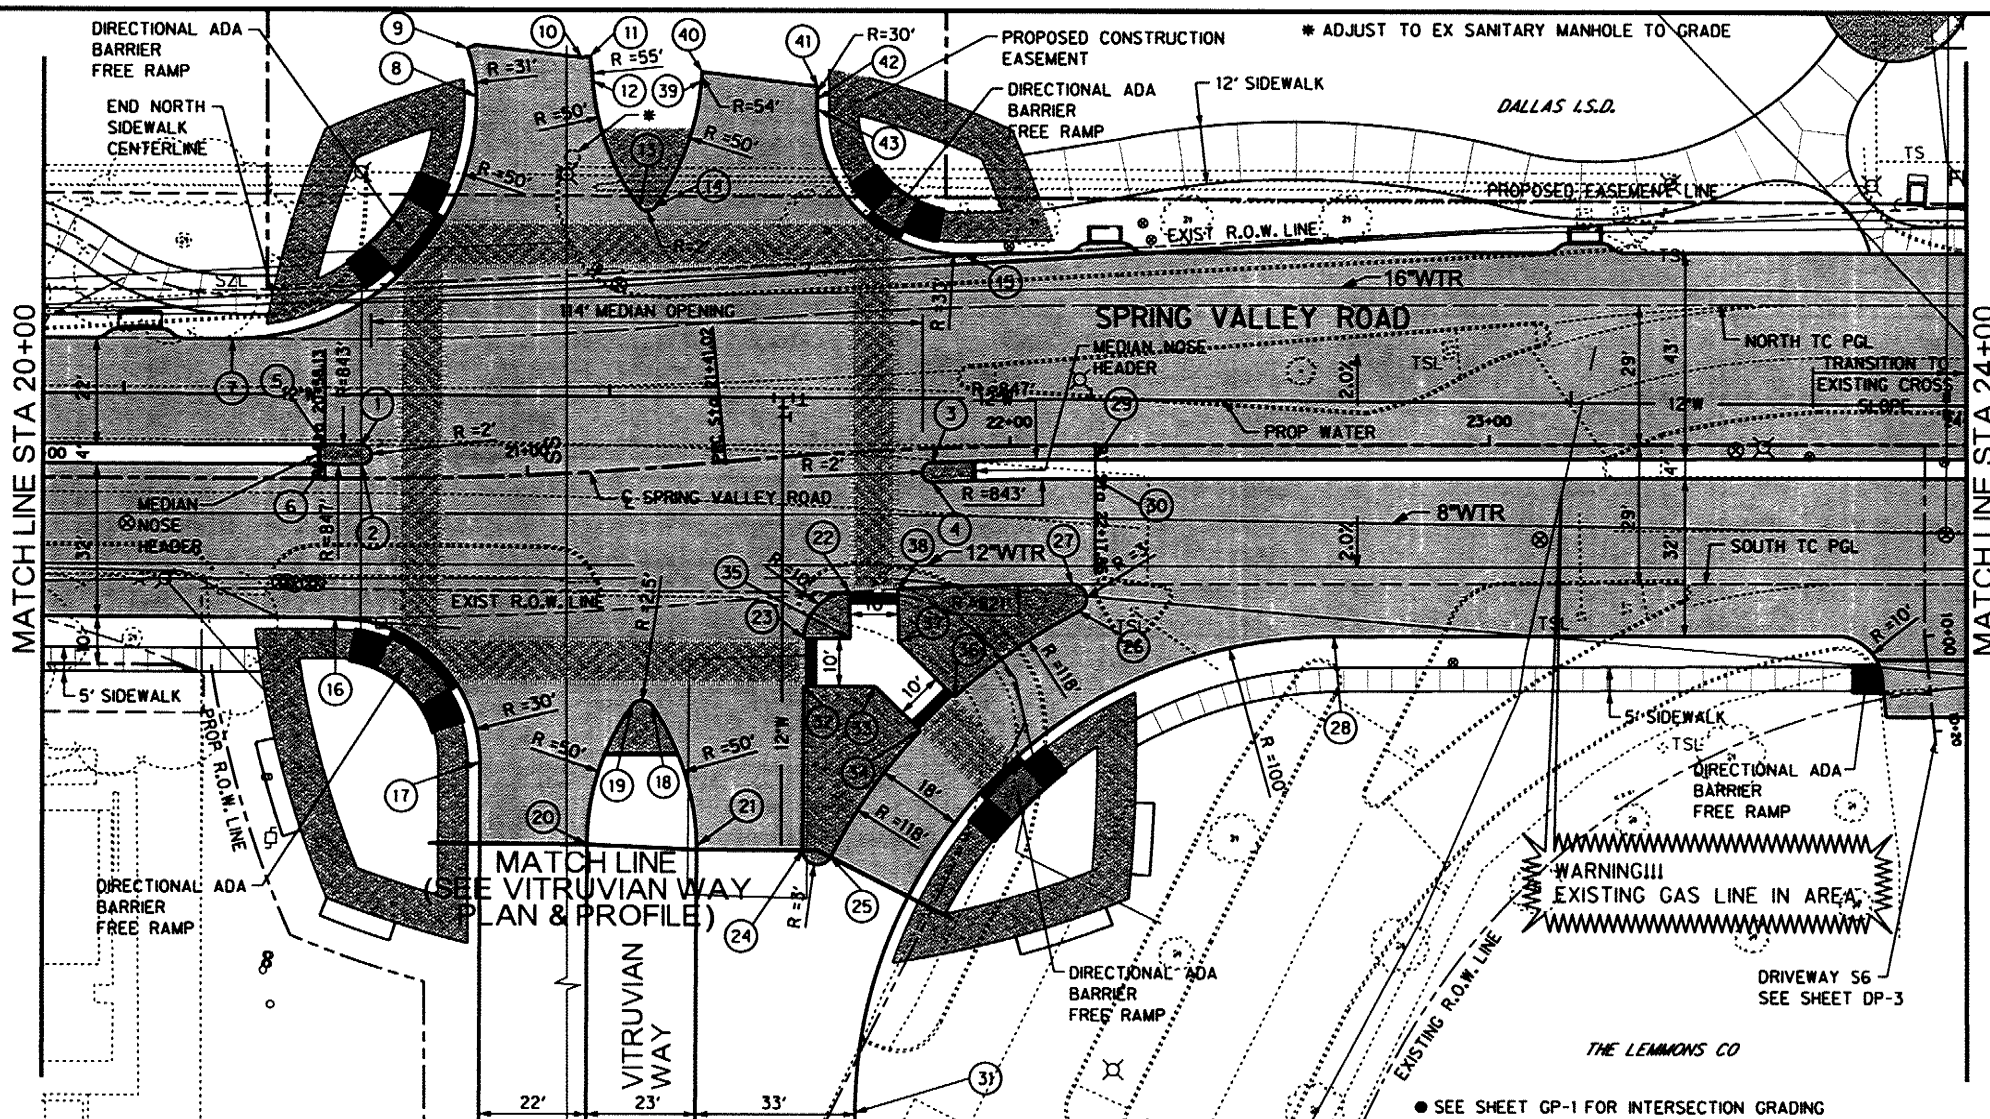


LEGEND

- PERMANENT REINFORCED CONCRETE PAVEMENT CONSTRUCTION
- CONC MEDIAN NOSE PAVER
- CONC PAVER

BACK OF CURB PC/PT/PRC/PCC
SPRING VALLEY ROAD

NO	DESC	STATION	OFFSET	NO	DESC	STATION	OFFSET
1	PC	20+65.69	7.00' LT	22	PC	21+64.97	29.00' RT
2	PT	20+65.69	3.00' LT	23	PT	21+54.42	38.03' RT
3	PC	21+83.65	3.00' RT	24	PC	21+50.40	82.20' RT
4	PT	21+83.65	7.00' RT	25	PT	21+56.54	84.02' RT
5	PCC	20+58.14	7.00' LT	26	PC	22+14.20	34.68' RT
6	PCC	20+58.14	3.00' LT	27	PT	22+12.80	29.00' RT
7	PC	20+39.17	29.00' LT	28	PC	22+67.48	40.00' RT
8	PCC	20+92.35	79.05' LT	29	PCC	22+17.86	3.00' RT
9	PT	20+90.74	89.18' LT	30	PCC	22+17.86	7.00' RT
10	PI	21+16.60	86.18' LT	31	PT	21+57.83	137.48' RT
11	PC	21+18.60	86.33' LT	32	PI	21+53.55	48.00' RT
12	PCC	21+18.87	81.20' LT	33	PI	21+69.24	49.09' RT
13	PCC	21+27.23	54.31' LT	34	PI	21+78.48	58.75' RT
14	PCC	21+30.65	54.04' LT	35	PI	21+64.34	38.75' RT
15	PT	21+92.34	40.00' LT	36	PI	21+86.40	52.03' RT
16	PC	20+60.26	29.00' RT	37	PI	21+74.77	39.95' RT
17	PT	20+88.23	59.58' RT	38	PI	21+75.34	29.00' RT
18	PT	21+22.03	49.47' RT	39	PCC	21+43.35	79.37' LT
19	PT	21+18.21	49.20' RT	40	PI	21+43.65	81.16' LT
20	PC	21+07.82	77.58' RT	41	PC	21+65.17	76.34' LT
21	PC	21+29.19	79.14' RT	42	PT	21+64.89	73.67' LT
				43	PC	21+64.76	71.61' LT

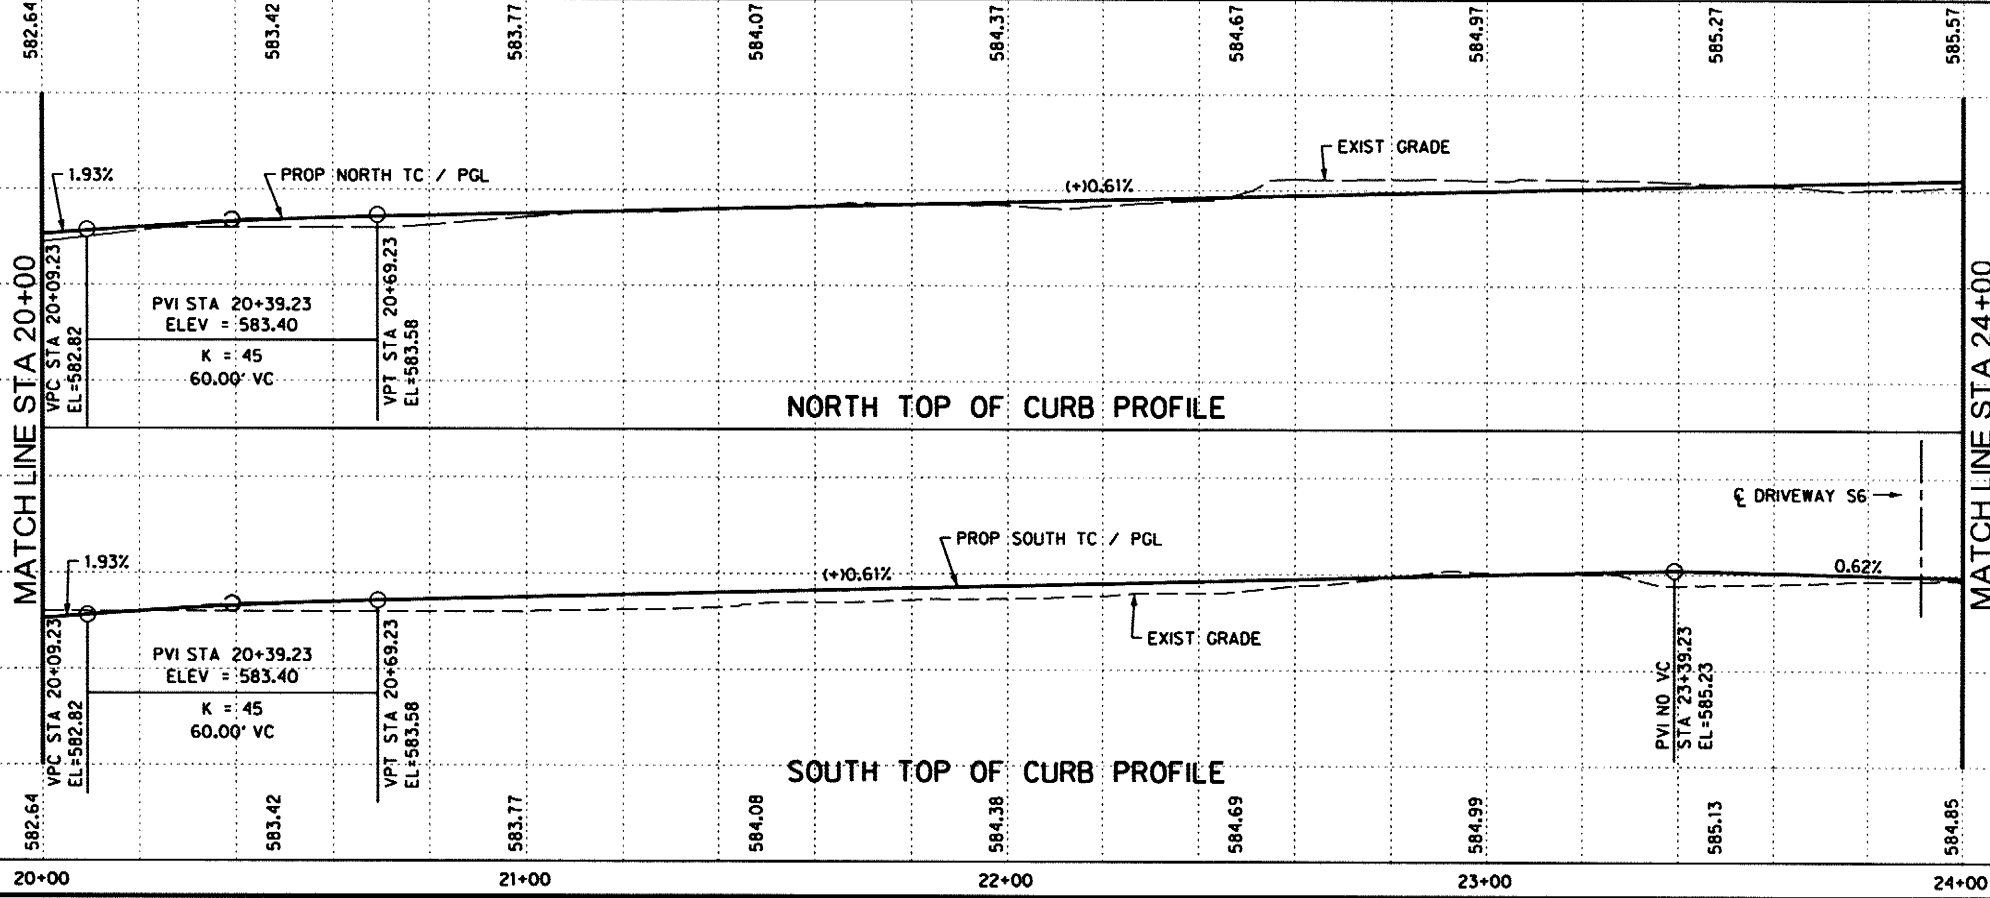

RECORD DOCUMENTS
December, 2011
These Record Documents have been prepared based upon information provided by North Texas Contracting, Inc. The Design Professional has not verified the accuracy and / or completeness of this information and shall not be responsible for any errors or omissions which may be incorporated herein as a result.

Design Consultant: Half Associates, Inc.
RECORD DRAWING SUBMITTAL

M.E. ROMANOWSKI
Professional Engineer

[Signature] P.E. 12/8/2011
Signature of Registrant Date

NO.	REVISION	BY	DATE
TOWN OF ADDISON DALLAS COUNTY, TEXAS SPRING VALLEY ROAD PAVING PLAN AND PROFILE STA 20+00 TO 24+00 HALFF 1201 NORTH BOWSER ROAD, RICHARDSON, TEXAS 75081-2275 TEL (214) 348-8200 FAX (214) 738-0095			
PROJECT	DESIGN	DRAWN	DATE
27530	MPB	TMM	OCTOBER 2010
FILE	SHEET		
27530 PAVM04	P4		

RECORD DRAWINGS SHEET 16 OF 163

USER: dh1299


OFFICE: RCH

PROJECT: 27530

FILE: 27530 PAVM 05.dgn


TIME: 10:10:27 AM

DATE: 12/7/2011

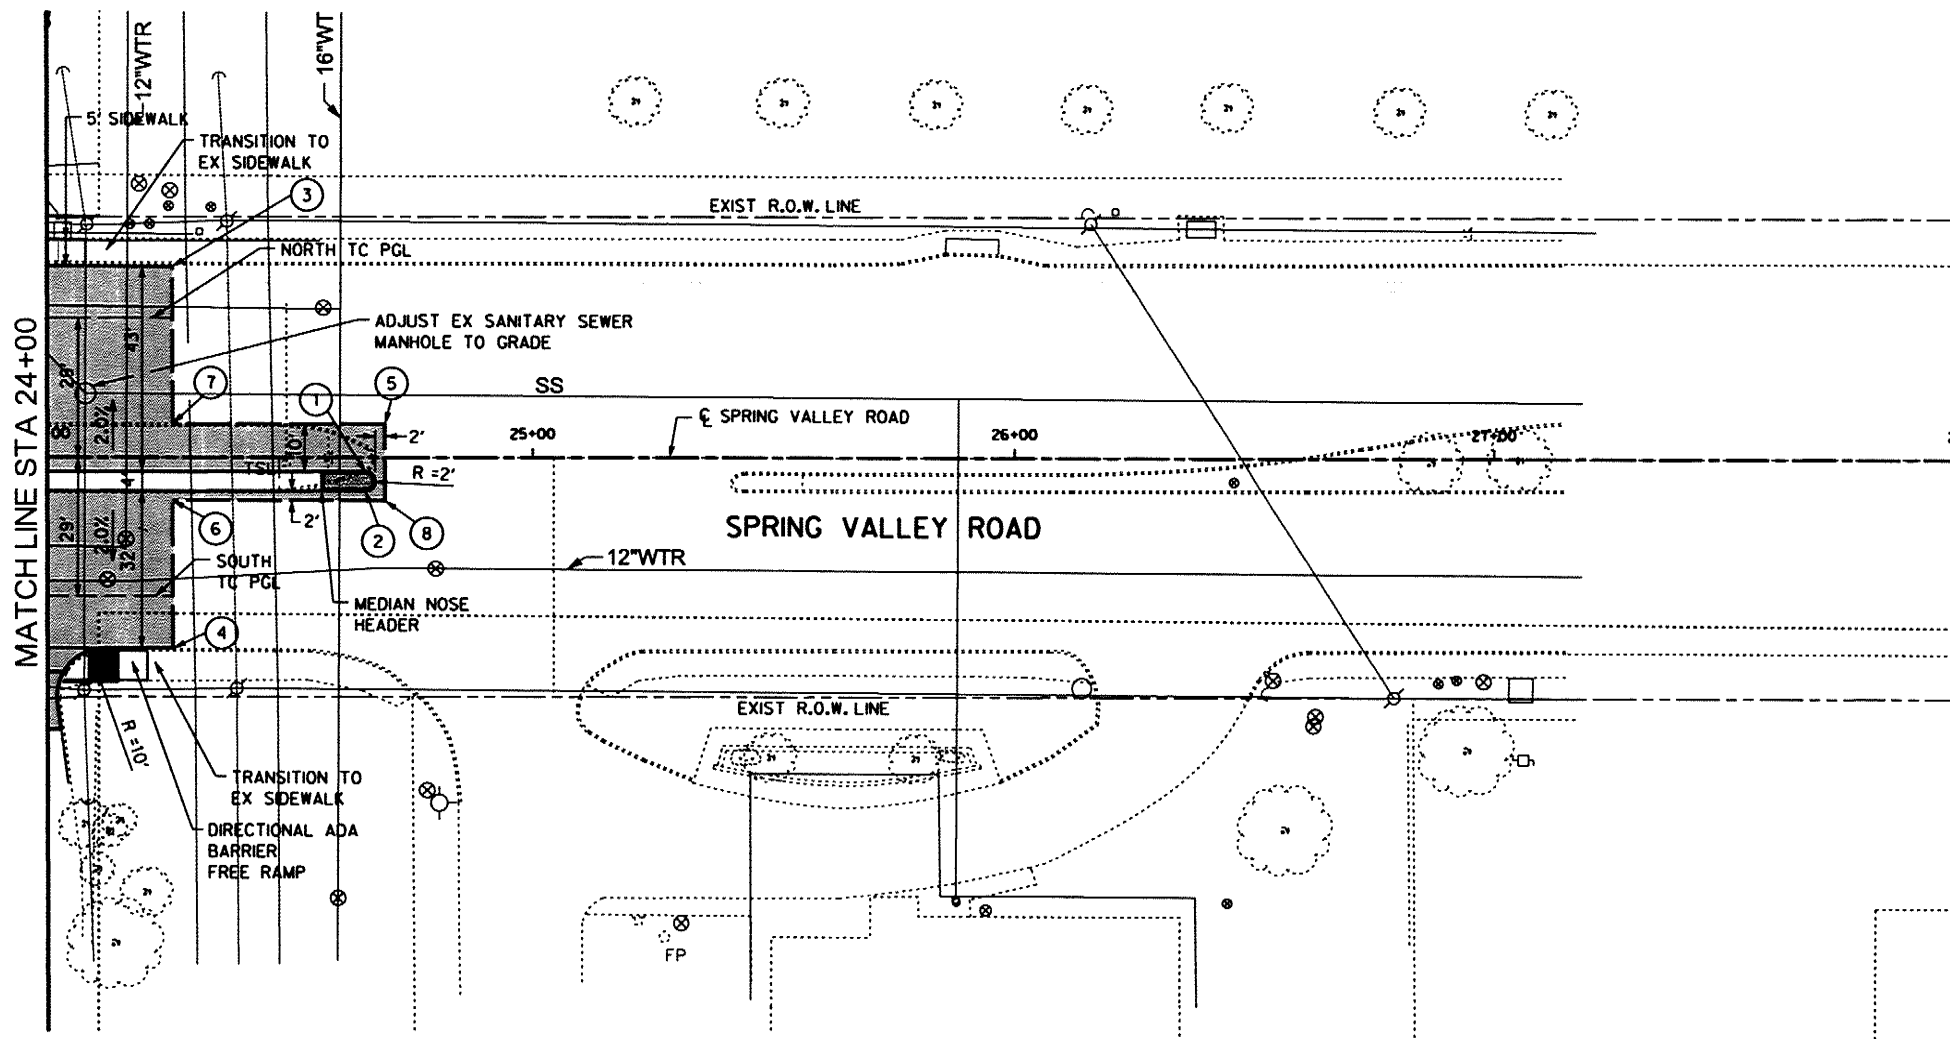

LEGEND

- PERMANENT REINFORCED PAVEMENT CONSTRUCTION
- CONC MEDIAN NOSE PAVER
- CONC PAVER

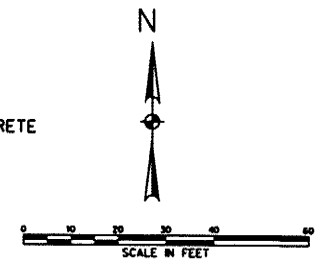


BACK OF CURB PC/PT/PRC/PCC
SPRING VALLEY ROAD

NO	DESC	STATION	OFFSET
1	PC	24+65.59	3.00' RT
2	PT	24+65.59	7.00' RT
3	PI	24+25.83	39.68' LT
4	PI	24+26.02	39.84' RT
5	PI	24+69.57	7.00' LT
6	PI	24+25.83	9.00' RT
7	PI	24+25.83	7.00' LT
8	PI	24+69.59	9.00' RT

RECORD DOCUMENTS
December, 2011
These Record Documents have been prepared based upon information provided by North Texas Contracting, Inc. The Design Professional has not verified the accuracy and / or completeness of this information and shall not be responsible for any errors or omissions which may be incorporated herein as a result.



Design Consultant: Halff Associates, Inc.
RECORD DRAWING SUBMITTAL

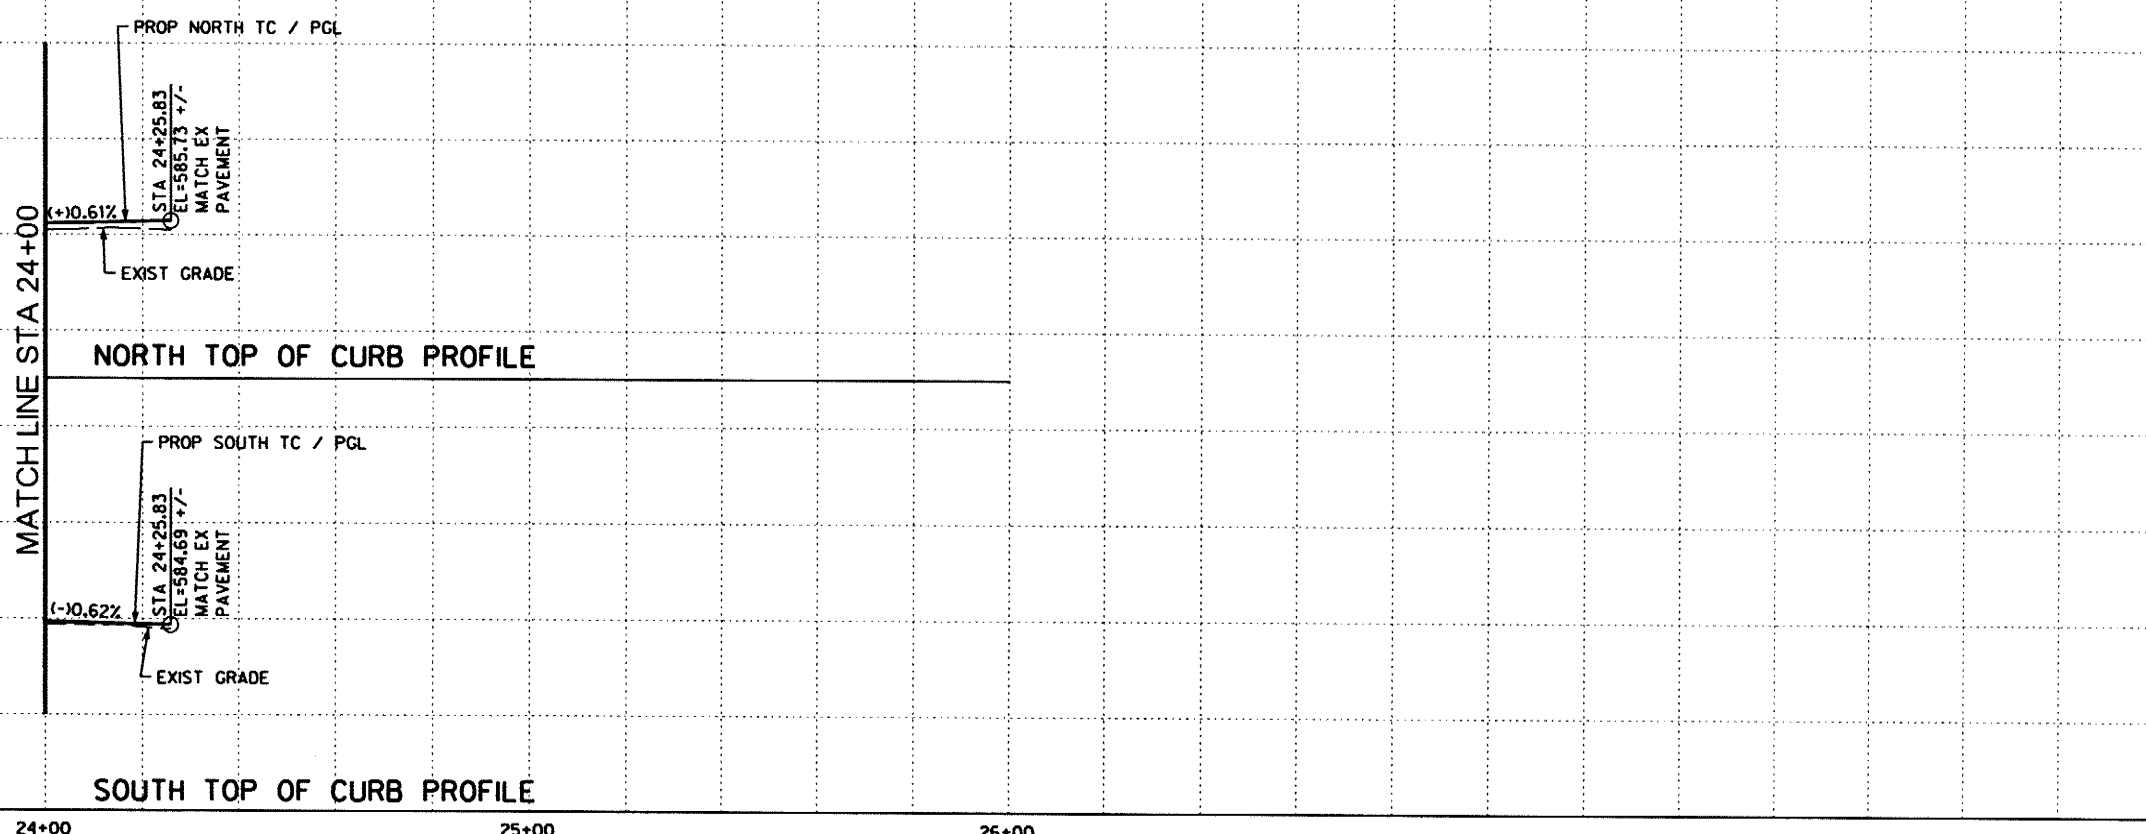



M.E. Romanowski P.E. *12/8/2011*
Signature of Registrant Date

NO.	REVISION	BY	DATE
TOWN OF ADDISON DALLAS COUNTY, TEXAS SPRING VALLEY ROAD PAVING PLAN AND PROFILE STA 24+00 TO 26+11.52 1201 NORTH BOWSER ROAD, RICHARDSON, TEXAS 75081-2275 TEL (214) 348-8200 FAX (214) 739-0095			
PROJECT	DESIGN	DRAWN	DATE
27530	MPB	TMM	OCTOBER 2010
FILE	SHEET		
27530 PAVM05	P5		

DATE: 12/7/2011 TIME: 10:11:02 AM FILE: 27530_PAVD 01.dgn PROJECT # 27530 OFFICE: RCH USER: oh1299

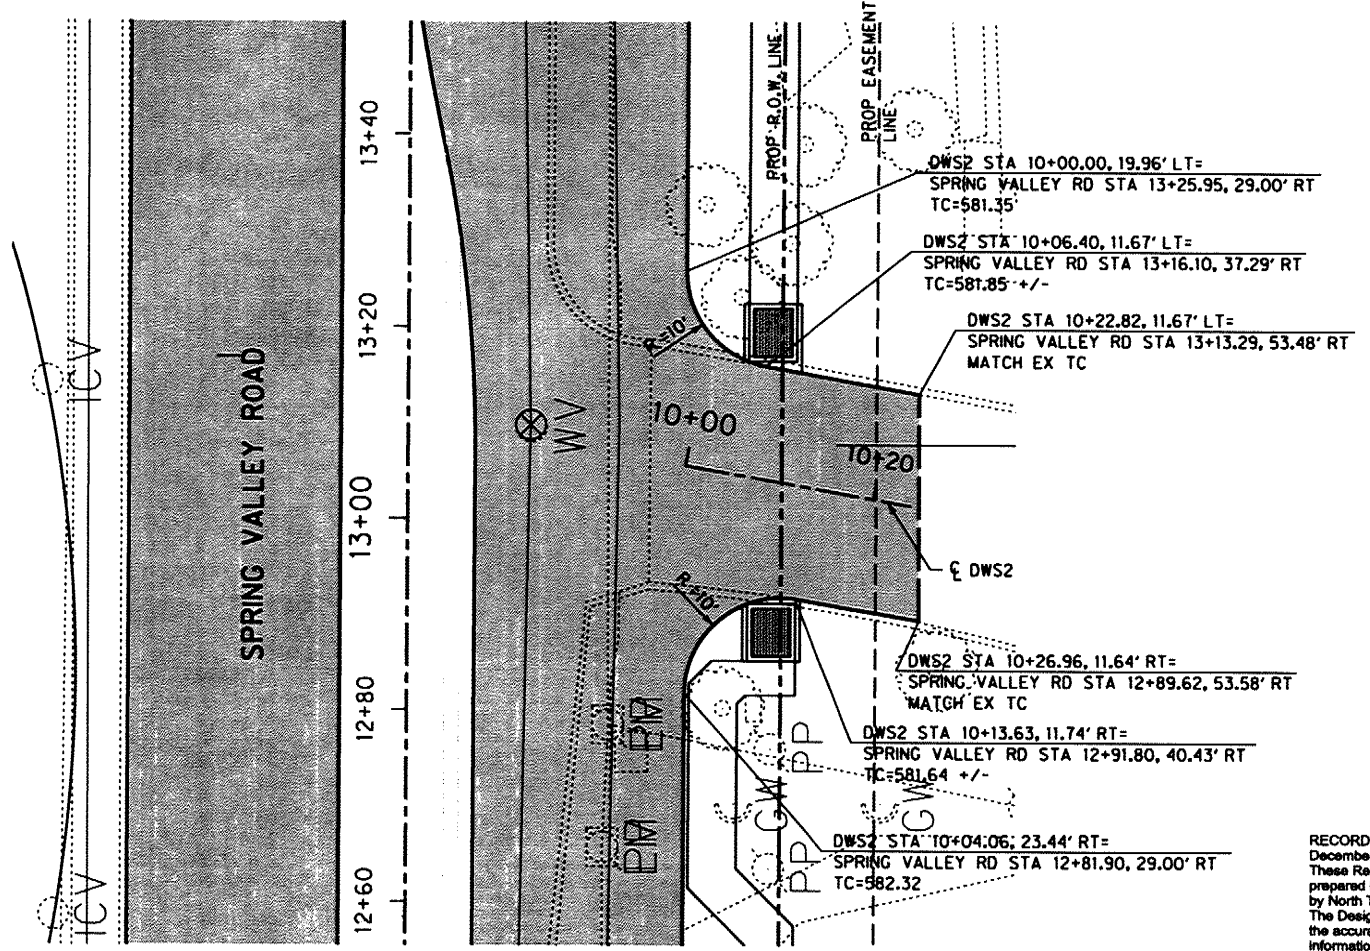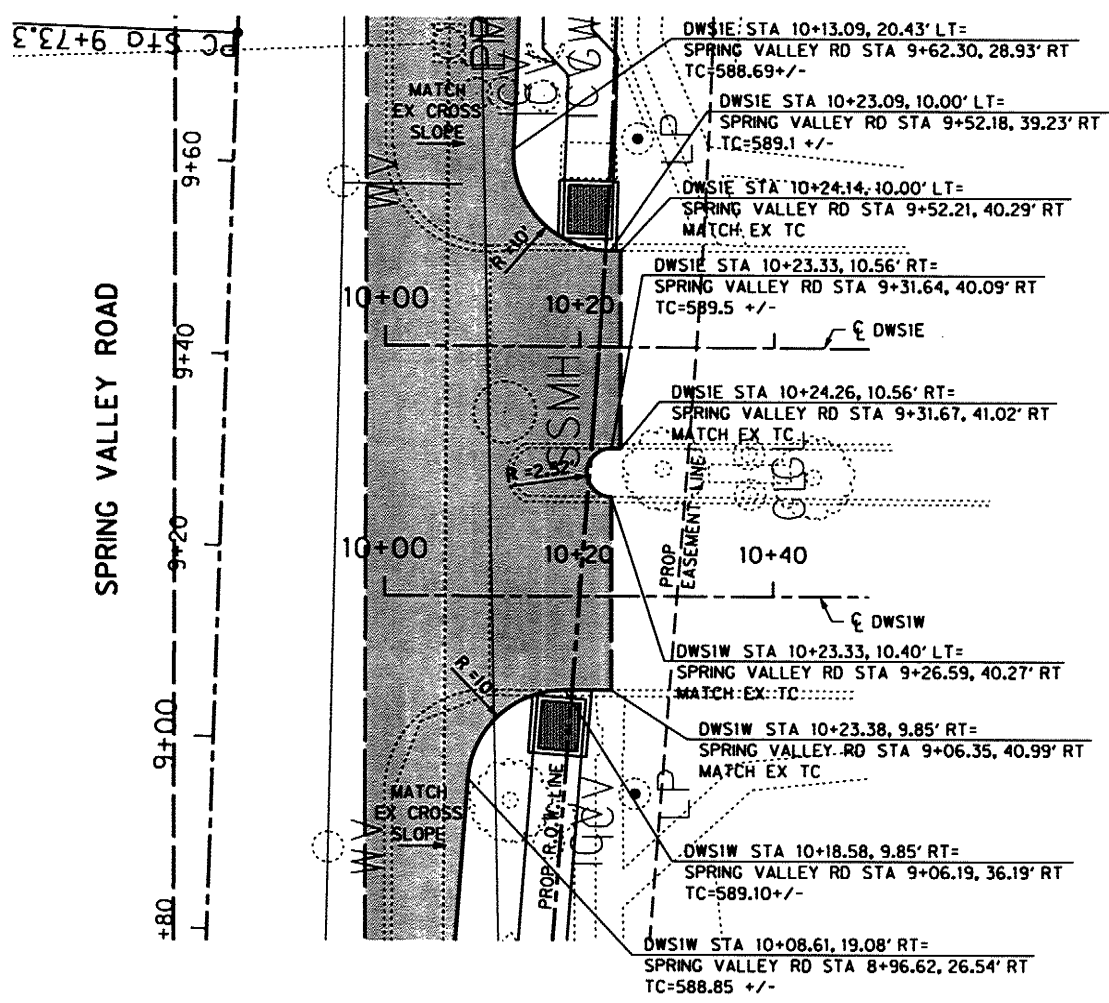

RECORD DOCUMENTS
 December, 2011
 These Record Documents have been prepared based upon information provided by North Texas Contracting, Inc. The Design Professional has not verified the accuracy and / or completeness of this information and shall not be responsible for any errors or omissions which may be incorporated herein as a result.
 Design Consultant: Half Associates, Inc.
 RECORD DRAWING SUBMITTAL

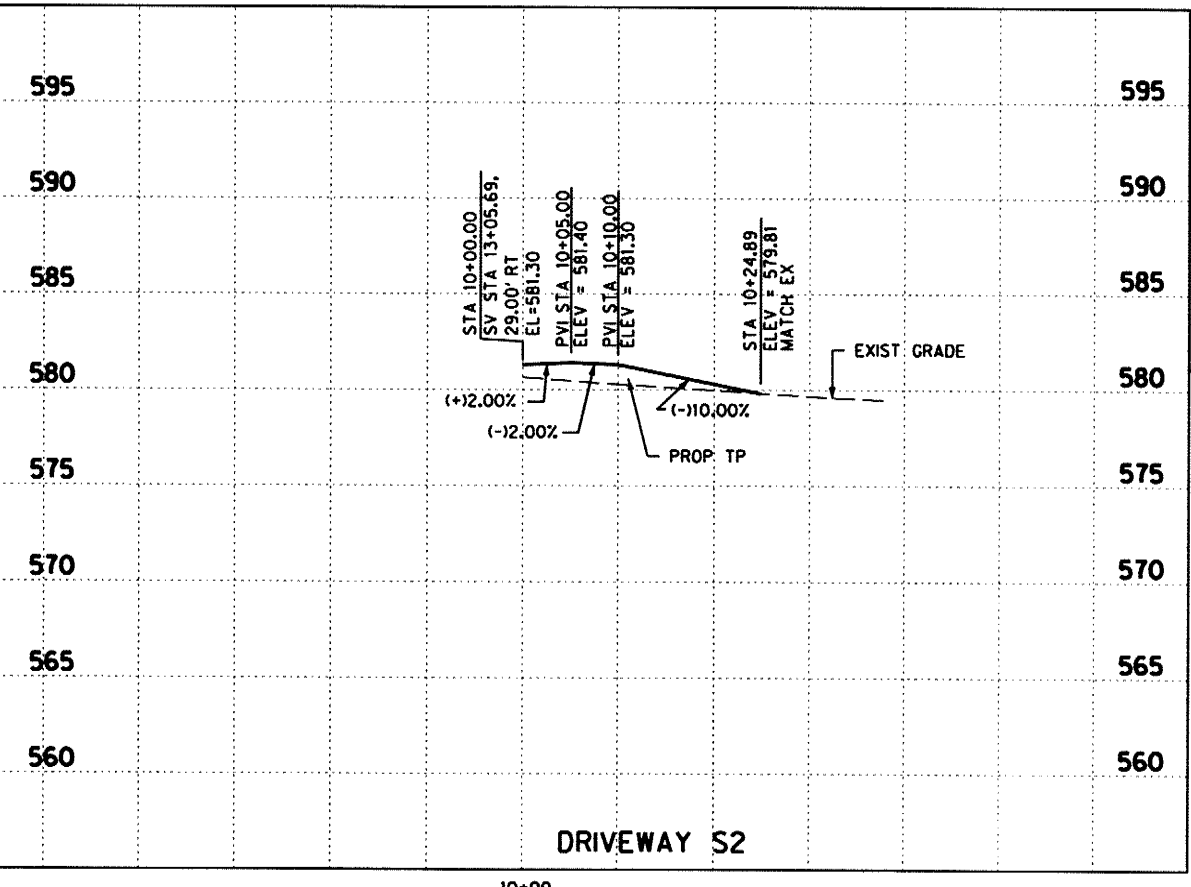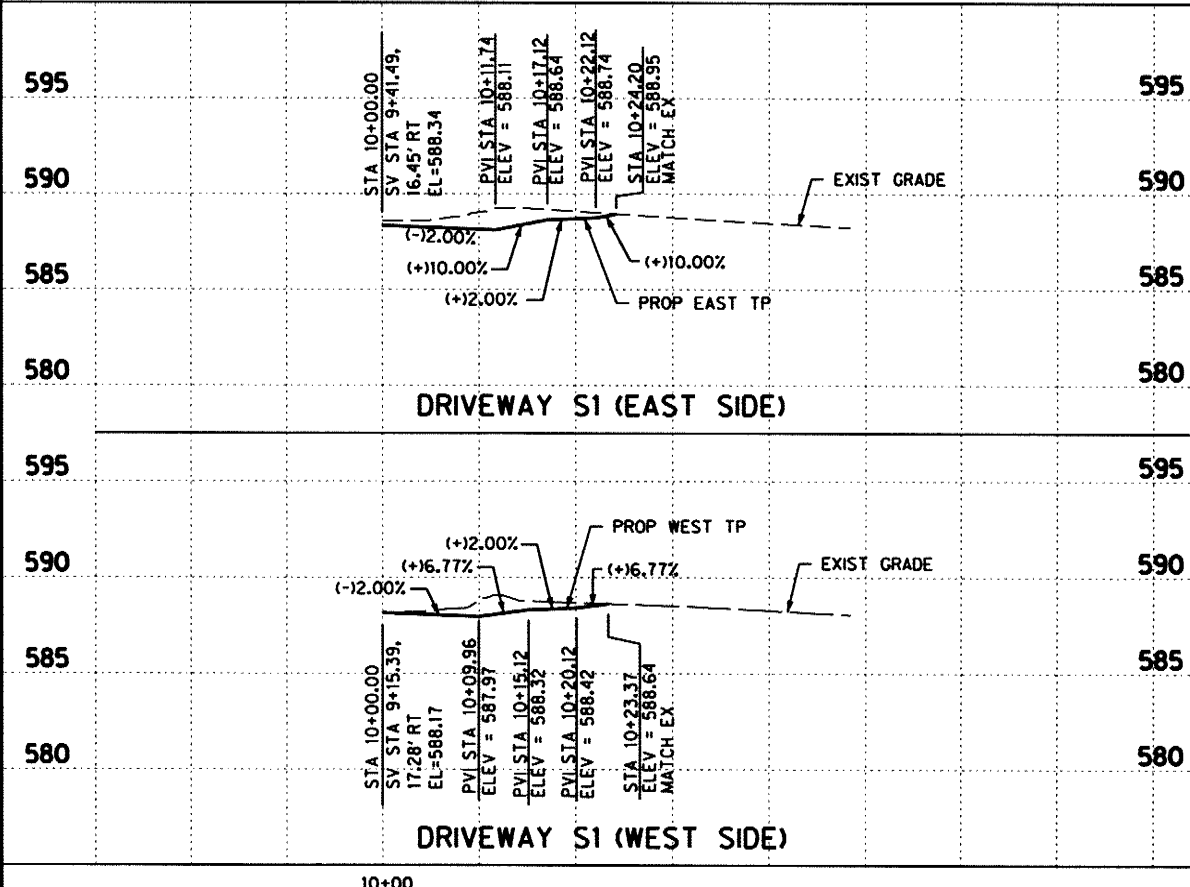

Signature of Registrant: *[Signature]* Date: 12/6/2011
 P.E.

NO.	REVISION	BY	DATE

TOWN OF ADDISON
 DALLAS COUNTY, TEXAS

SPRING VALLEY ROAD



DRIVEWAY PLAN AND PROFILE S1 & S2

HALFF 1201 NORTH BOWSER ROAD, RICHARDSON, TEXAS 75081-2275
 TEL (214) 348-8200 FAX (214) 739-0085

PROJECT	DESIGN	DRAWN	DATE	FILE	SHEET
27530	MPB	TMM	OCTOBER 2010	27530_PAVD 01	DP-1


RECORD DRAWINGS SHEET 18 OF 163

PROJECT • 27530 OFFICE: RCH USER: dh1299
 FILE: 27530 PAVD 02.dgn TIME: 10:11:21 AM DATE: 12/7/2011

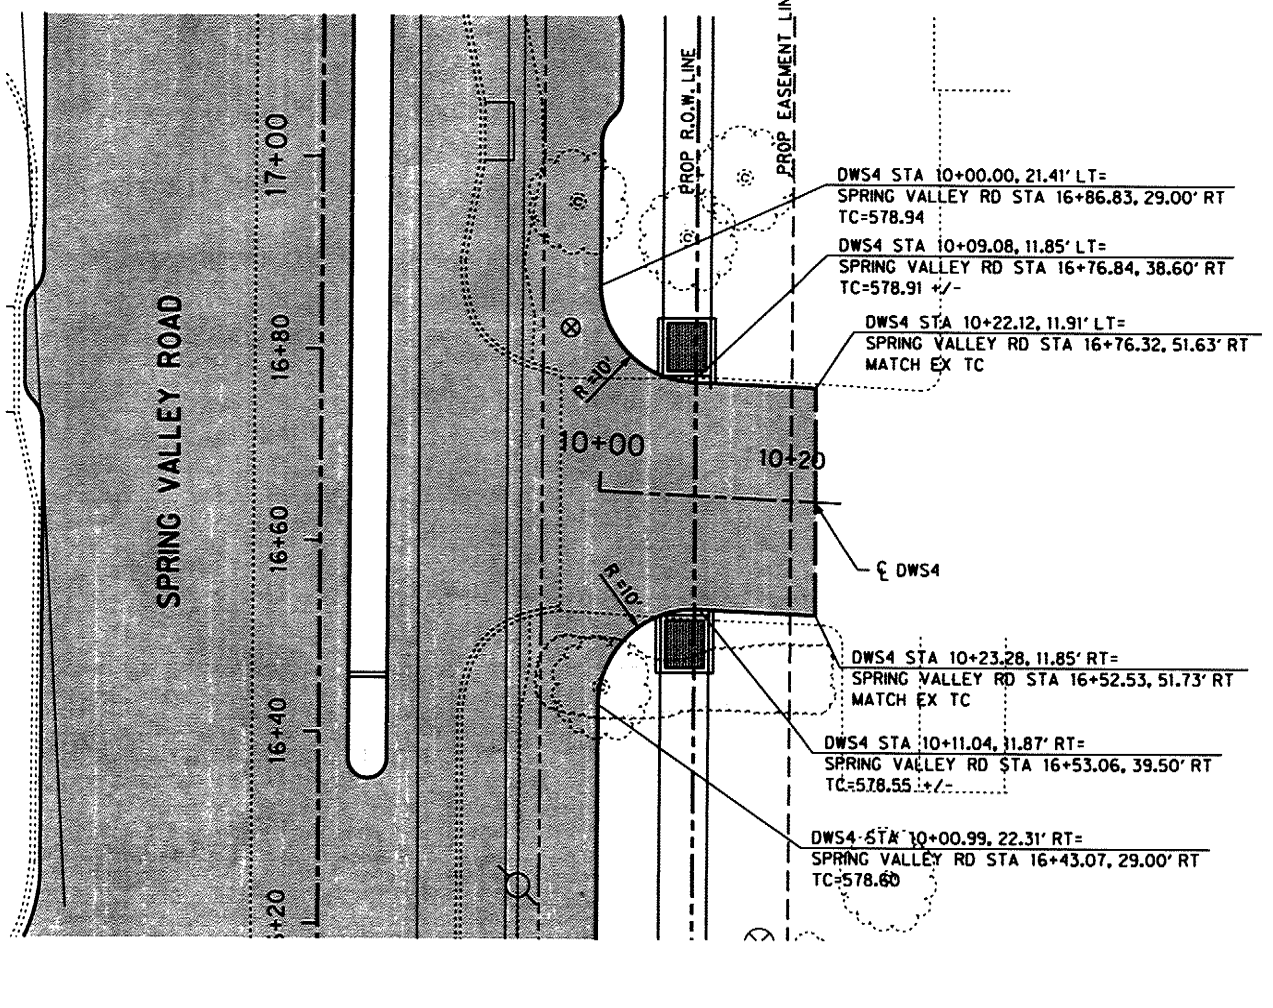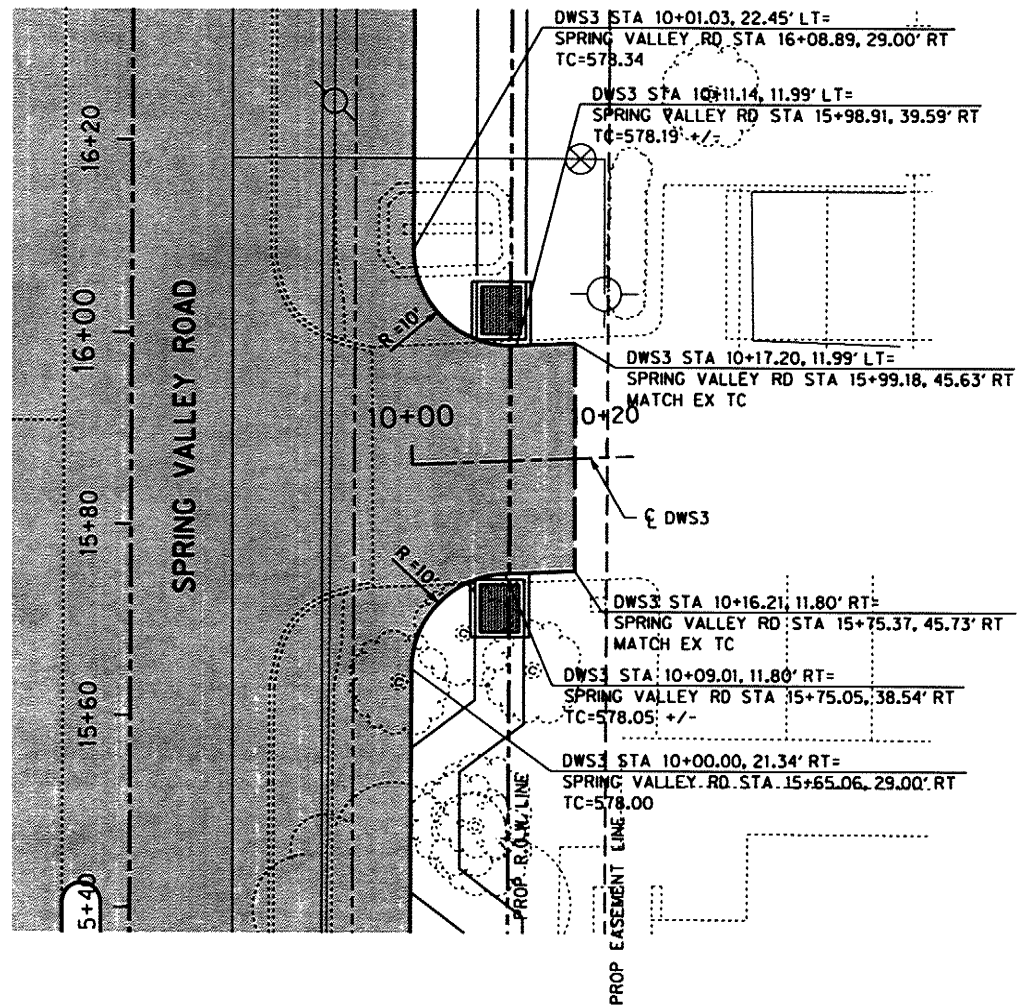


RECORD DOCUMENTS
 December, 2011
 These Record Documents have been prepared based upon information provided by North Texas Contracting, Inc. The Design Professional has not verified the accuracy and / or completeness of this information and shall not be responsible for any errors or omissions which may be incorporated herein as a result
 Design Consultant: Halff Associates, Inc.
 RECORD DRAWING SUBMITTAL

SHEET 19 OF 163

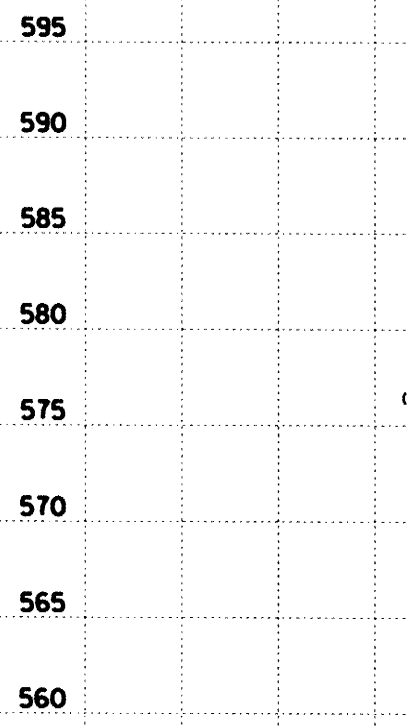

DRIVEWAY S3
 10+00

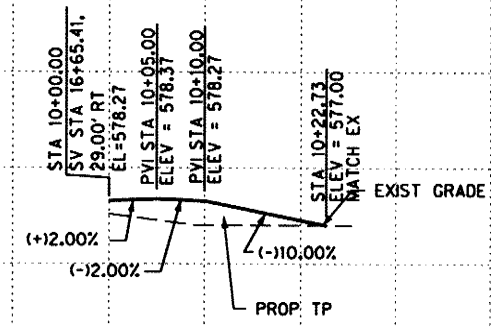



DRIVEWAY S4
 10+00

Signature of Registrant: *M.E. Romanowski* Date: *12/8/11*
 P.E.

NO.	REVISION	BY	DATE
 TOWN OF ADDISON DALLAS COUNTY, TEXAS SPRING VALLEY ROAD DRIVEWAY PLAN AND PROFILE S3 & S4			
 1201 NORTH BOWSER ROAD, RICHARDSON, TEXAS 75081-2275 TEL (214) 348-8200 FAX (214) 738-0085			
PROJECT	DESIGN	DRAWN	DATE
27530	MPB	TMM	OCTOBER 2010
FILE	SHEET		
27530 PAVD 02	DP-2		


RECORD DRAWINGS

DATE: 12/7/2011 TIME: 10:11:39 AM FILE: 27530 PAVD 03.dgn PROJECT: 27530 OFFICE: RCH USER: oh1299

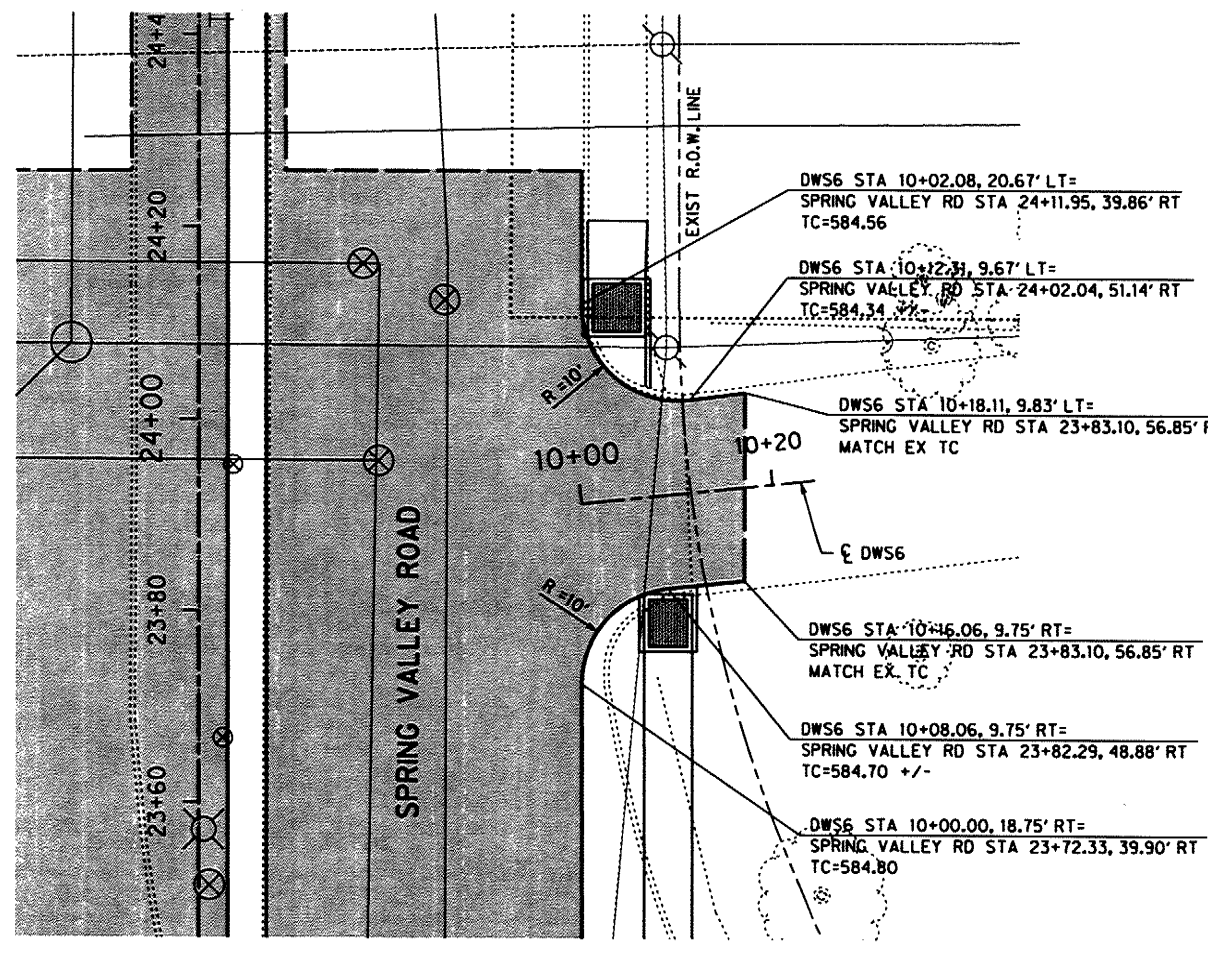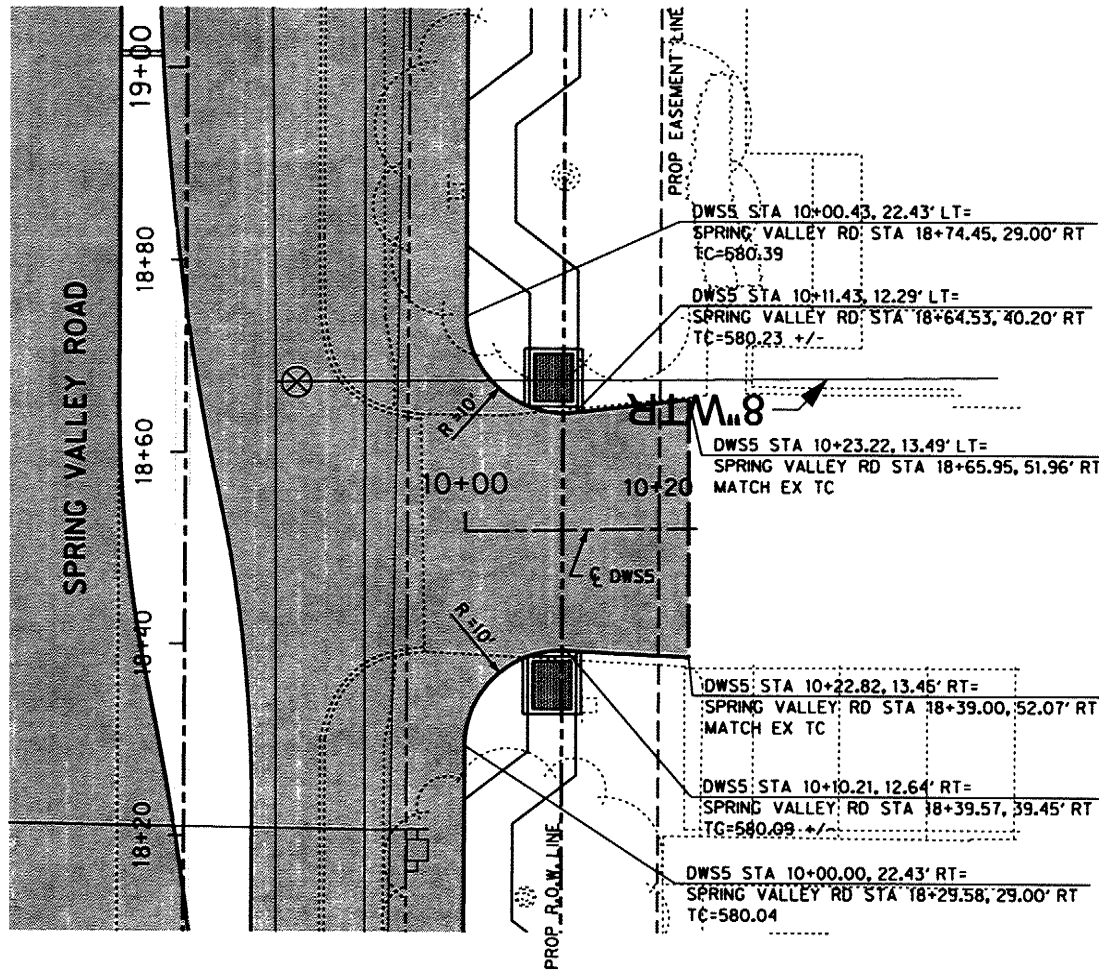

RECORD DOCUMENTS
December, 2011
These Record Documents have been prepared based upon information provided by North Texas Contracting, Inc. The Design Professional has not verified the accuracy and / or completeness of this information and shall not be responsible for any errors or omissions which may be incorporated herein as a result

Design Consultant: Half Associates, Inc.
RECORD DRAWING SUBMITTAL




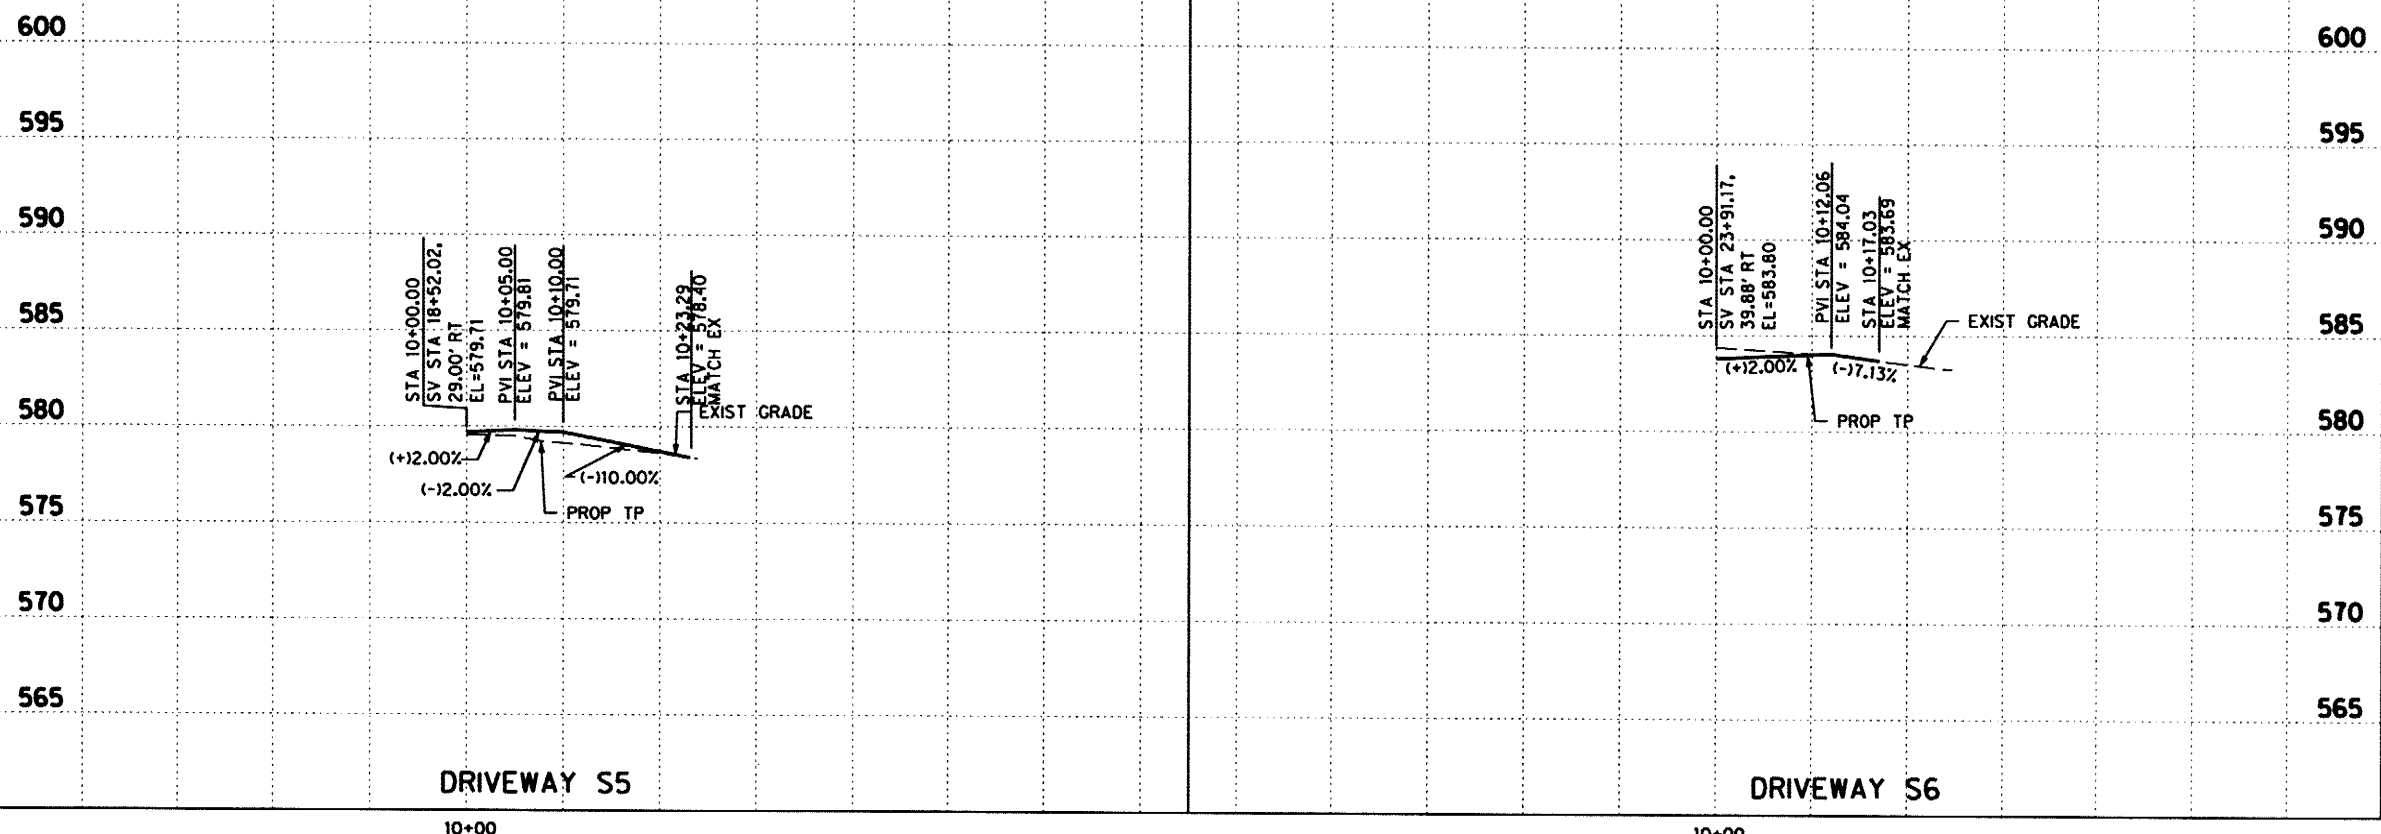


Signature of Registrant: *M.L.E. Romanowski* Date: 12/6/2011

NO.	REVISION	BY	DATE
TOWN OF ADDISON DALLAS COUNTY, TEXAS SPRING VALLEY ROAD			
DRIVEWAY PLAN AND PROFILE S5 & S6			
1201 NORTH BOWSER ROAD, RICHARDSON, TEXAS 75081-2275 TEL (214) 346-6200 FAX (214) 736-0065			
PROJECT	DESIGN	DRAWN	DATE
27530	MPB	TMM	OCTOBER 2010
FILE	SHEET		
27530 PAVD 03	DP-3		

RECORD DRAWINGS SHEET 20 OF 163

DATE: 12/7/2011 TIME: 10:12:06 AM FILE: 27530_PAVD_04 (REV).dgn PROJECT: 27530 OFFICE: RCH USER: rhl299

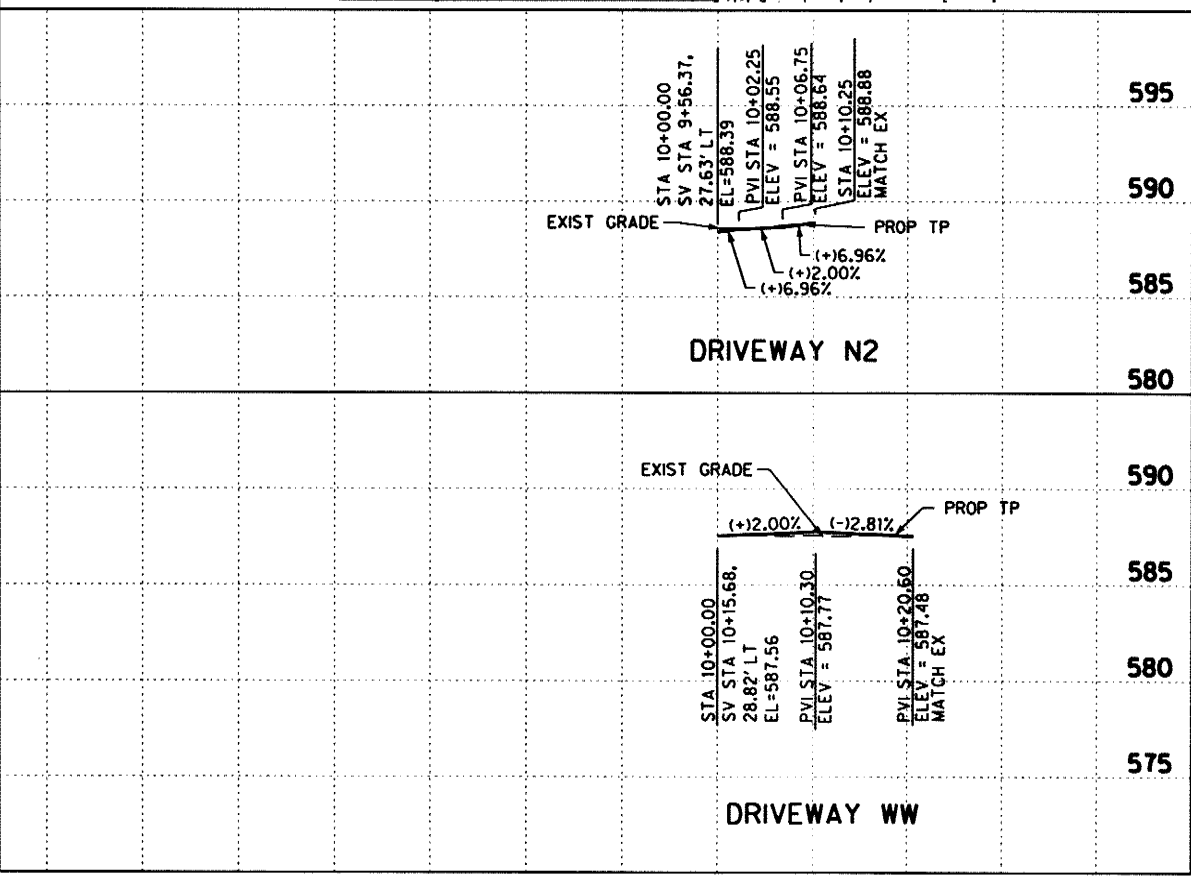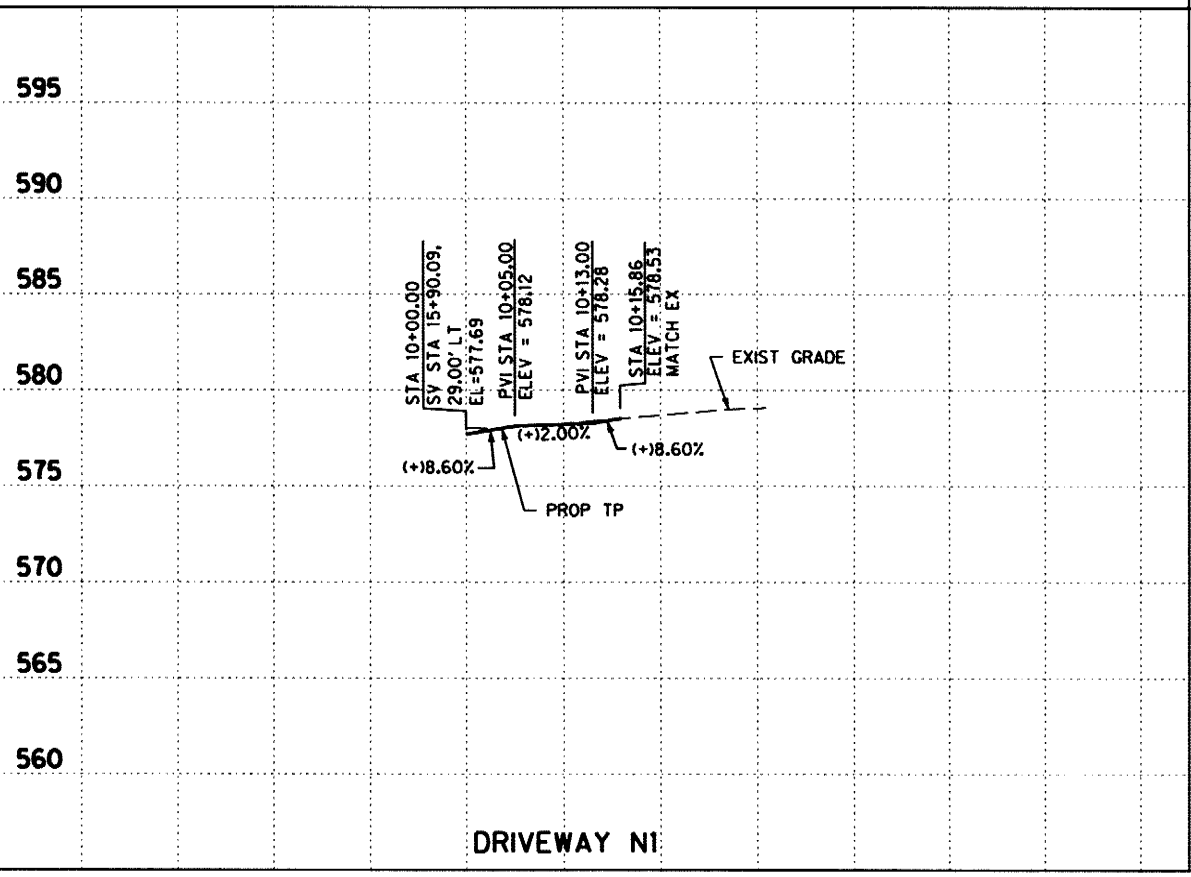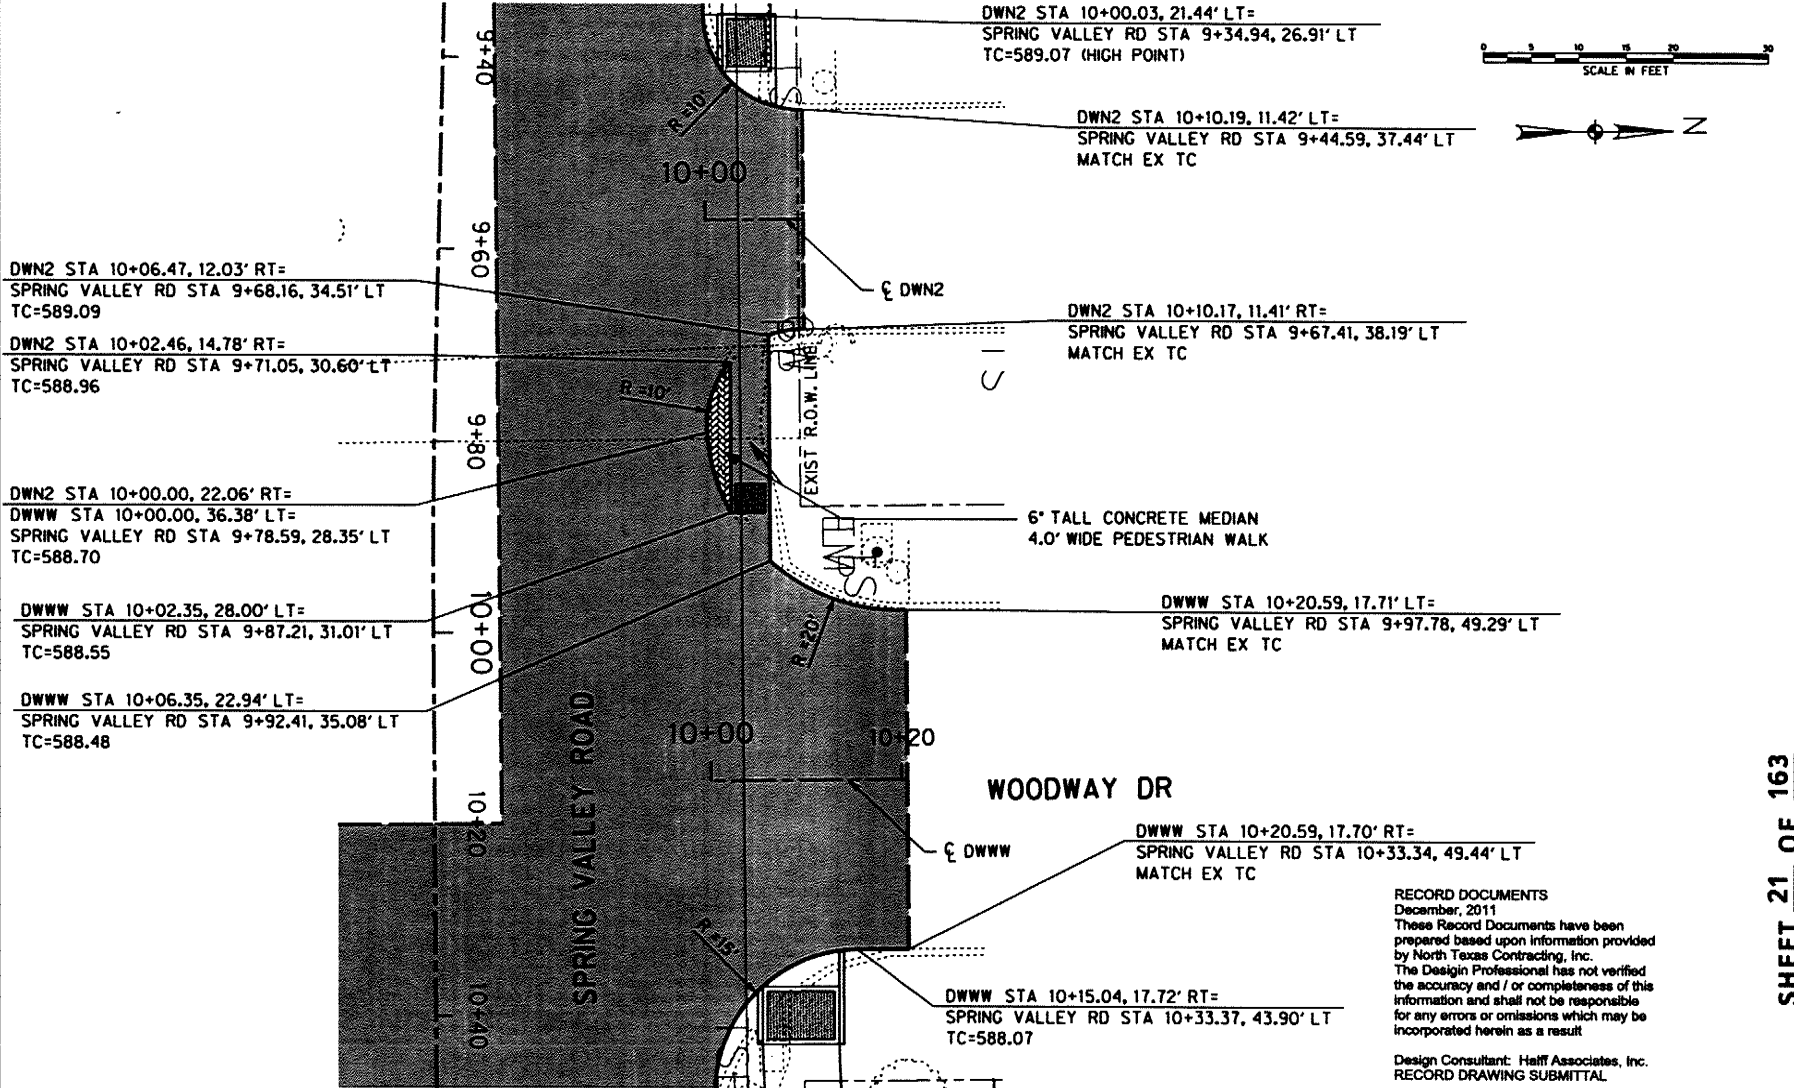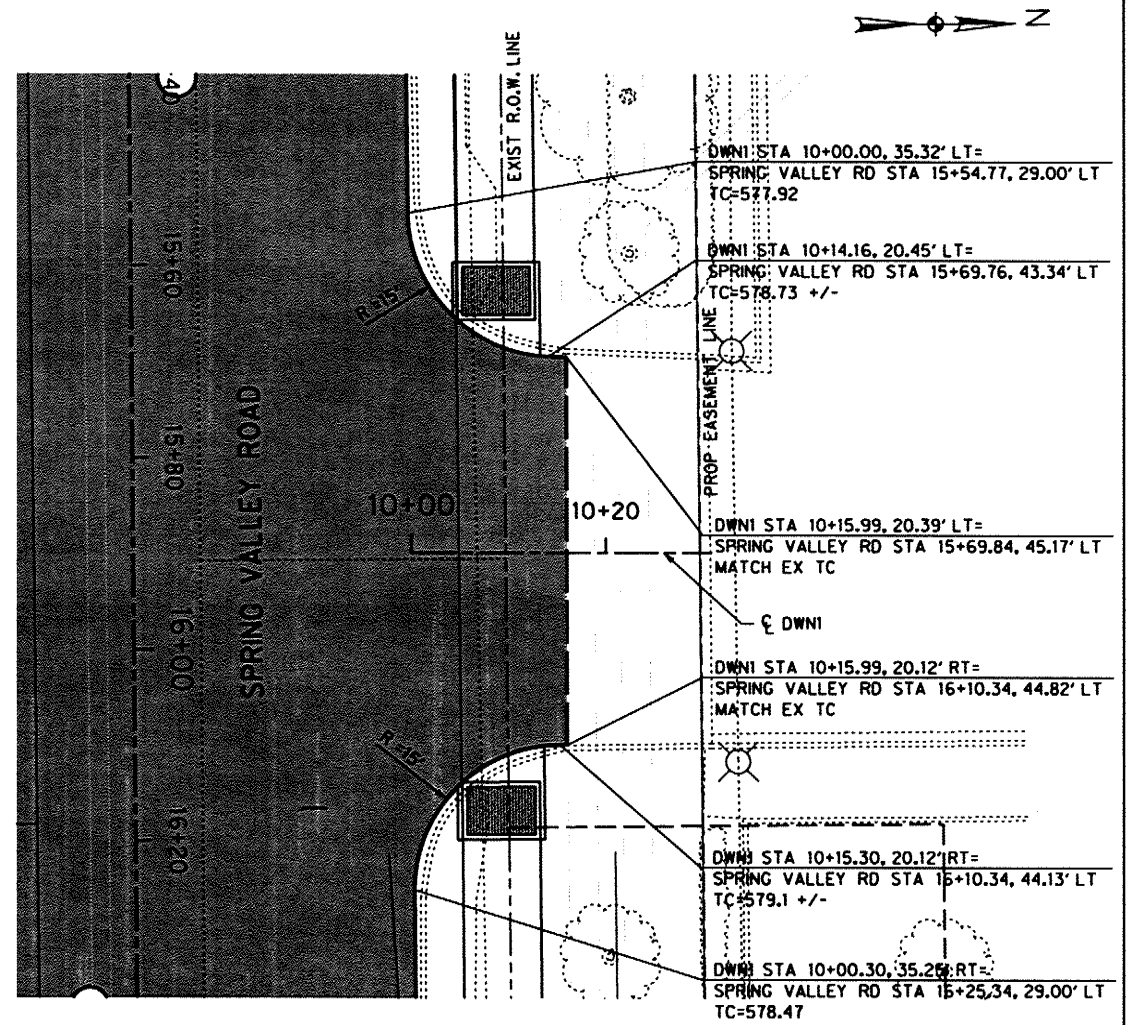


RECORD DOCUMENTS
 December, 2011
 These Record Documents have been prepared based upon information provided by North Texas Contracting, Inc. The Design Professional has not verified the accuracy and / or completeness of this information and shall not be responsible for any errors or omissions which may be incorporated herein as a result
 Design Consultant: Half Associates, Inc.
 RECORD DRAWING SUBMITTAL

[Signature]
 Signature of Registrant
 M.E. ROMANOWSKI
 56306
 LICENSED PROFESSIONAL ENGINEER
 12/8/2011
 Date

NO.	REVISION	BY	DATE
1	ADD DRIVEWAY N2 AND WW	MER	5/17/11
TOWN OF ADDISON DALLAS COUNTY, TEXAS SPRING VALLEY ROAD DRIVEWAY PLAN AND PROFILE N1, N2, WW			
HALFF 1201 NORTH BOWSER ROAD, RICHARDSON, TEXAS 75081-2275 TEL (214) 348-6200 FAX (214) 730-0065			
PROJECT	DESIGN	DRAWN	DATE
27530	MPB	TMM	OCTOBER 2010
FILE	SHEET		
27530 PAVD 04	DP-4		

RECORD DRAWINGS SHEET 21 OF 163



USER: gh1299
 OFFICE: RCH
 PROJECT: 27530
 FILE: 27530 DTPV 01.dgn
 DATE: 12/7/2011
 TIME: 10:12:27 AM

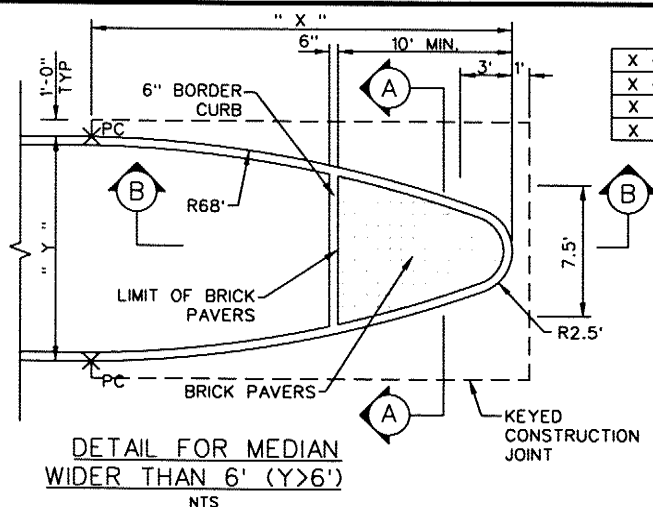






DIMENSIONS OF MEDIAN NOSE

X - 13.90'	Y - 7.0'	X - 26.36'	Y - 14.0'
X - 16.44'	Y - 8.0'	X - 29.89'	Y - 17.0'
X - 18.08'	Y - 9.0'	X - 32.93'	Y - 20.0'
X - 20.42'	Y - 10.0'	X - 36.47'	Y - 24.0'

- VEHICULAR BRICK PAVER
- BITUMINOUS EXPANSION JOINT MATERIAL SHALL BE SUFFICIENT TO PREVENT CONTACT BETWEEN WALK & CURB. STOP EXPANSION JOINT AT 1/4" BELOW TOP OF CURB AND FILL WITH CONC. GRAY SEALANT.
- JOINT SAND COMPRISED OF CRUSHED GRANITE SAND CONFORMING TO ASTM C144 AND A DRY MIX POLYMER BASED JOINT SAND STABILIZER. JOINT SAND STABILIZER SHALL BE APPROVED BY THE PUBLIC WORKS DEPARTMENT PRIOR TO INSTALLATION.
- BEDDING SAND COMPRISED OF 90% NATURAL OR CRUSHED GRANITE SAND CONFORMING TO ASTM C33 AND 10% PORTLAND CEMENT.

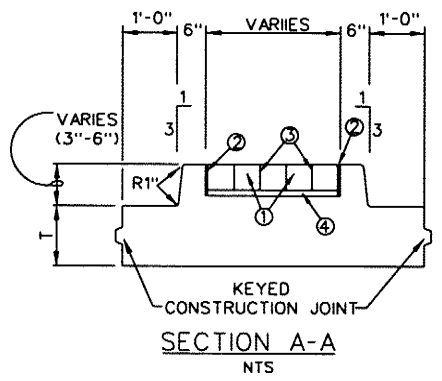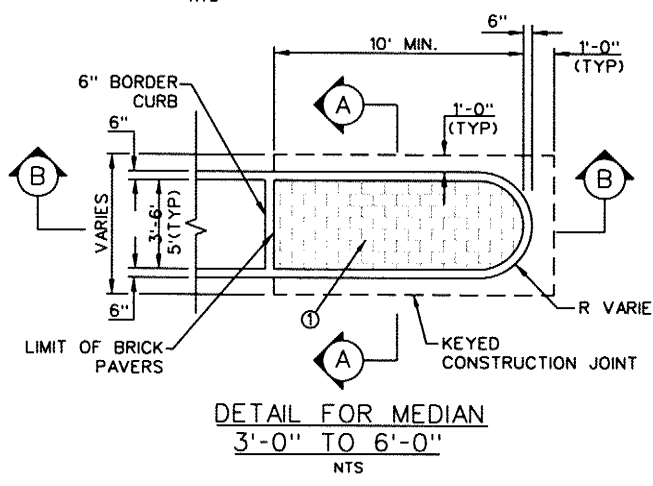

- NOTES:**
- BRICK PAVERS SHALL BE VEHICULAR PAVERS CONFORMING TO ASTM C1272, TYPE R APPLICATION AND SHALL BE APPROVED BY PUBLIC WORKS DEPT.
 - BRICK PAVERS SHALL BE WITHOUT FROGS OR CORES IN SURFACE EXPOSED TO VIEW IN THE COMPLETED WORK.
 - MEDIAN PAVERS SHALL EXTEND TO A POINT WHERE MEDIAN IS AT LEAST 6' WIDE. IF MEDIAN IS 6' WIDE, PAVERS SHALL EXTEND 10' FROM THE NOSE.
 - ALL DISTANCES ARE MINIMUM.

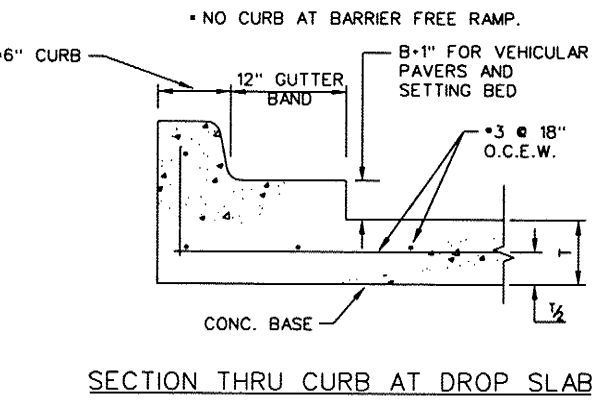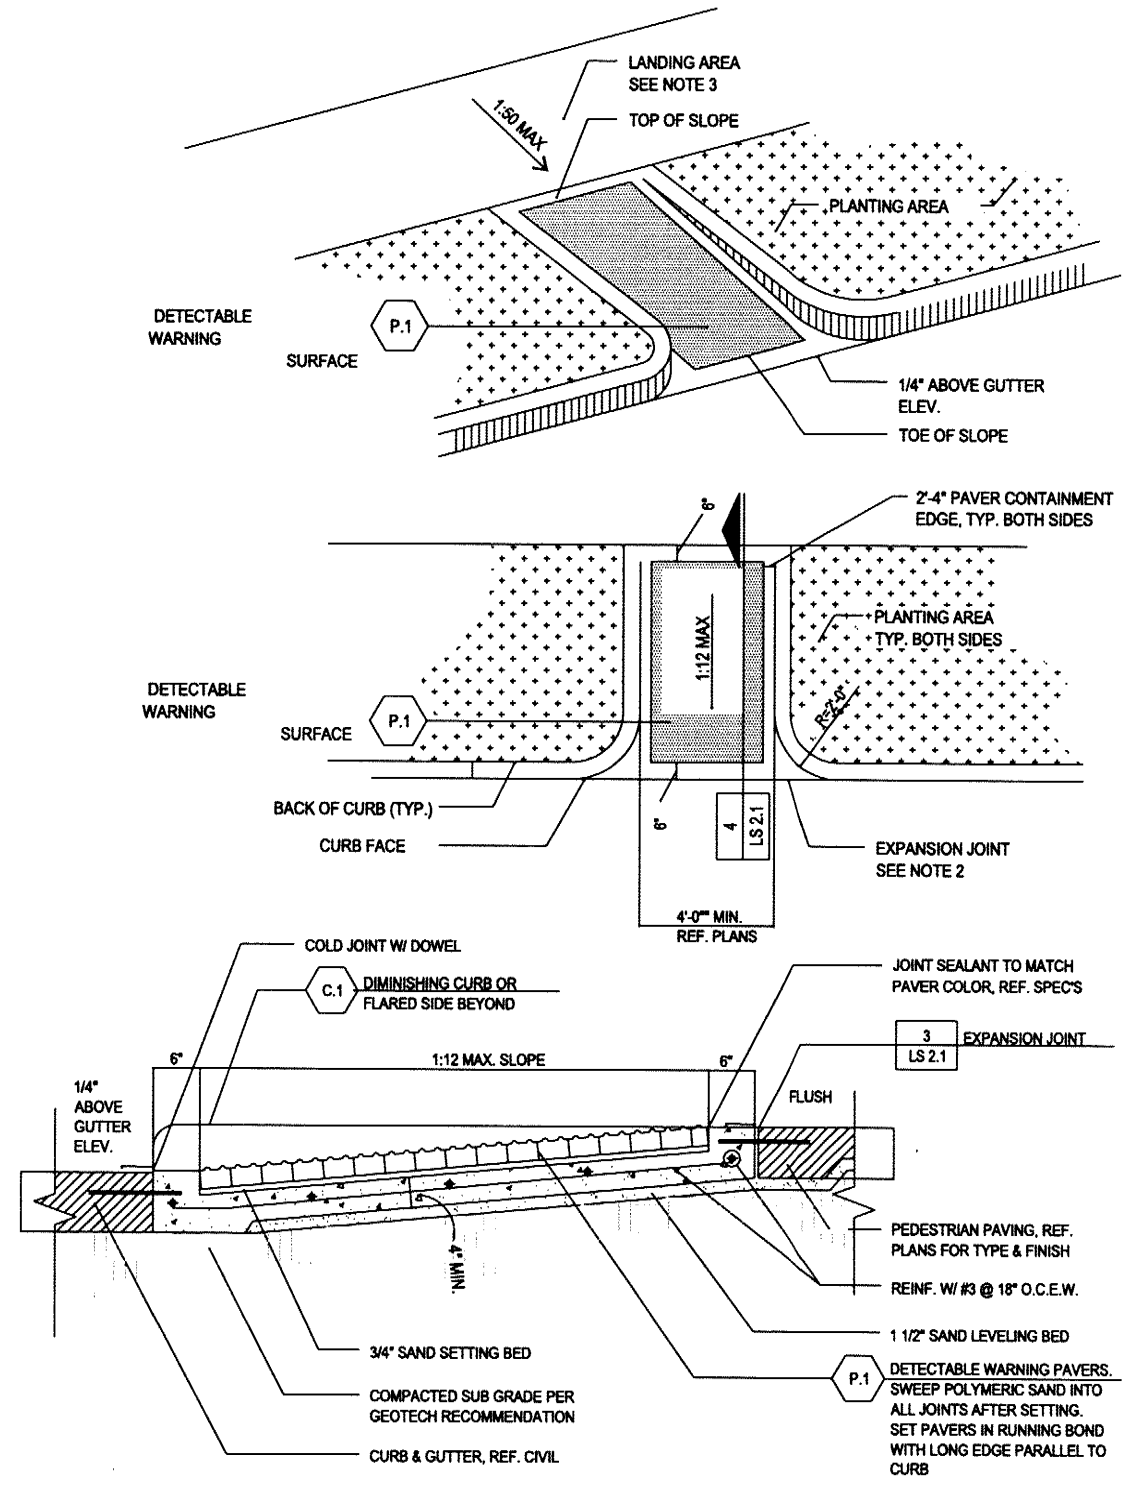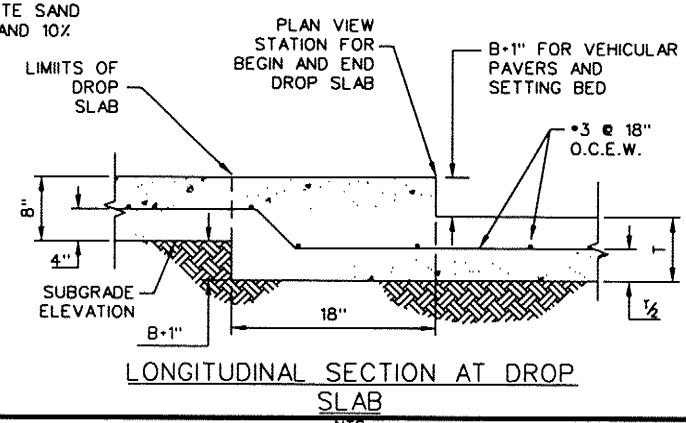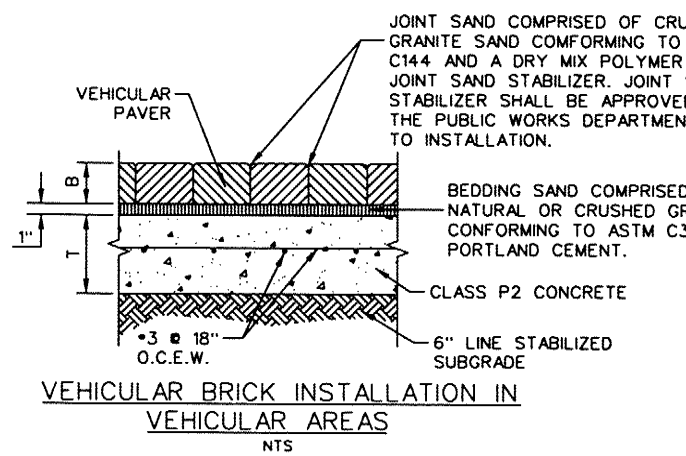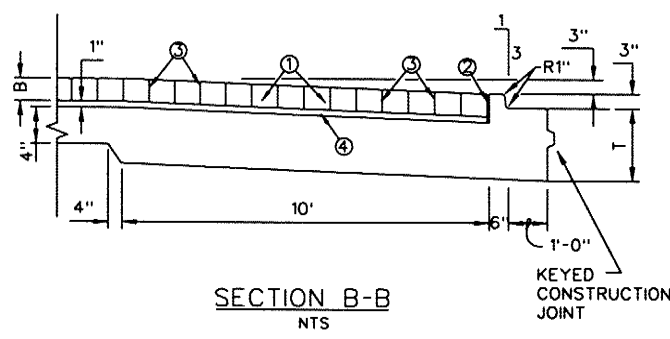

- NOTES:**
- VEHICULAR PAVERS SHALL BE HEAVY PAVING BRICK MEETING ASTM C1272, TYPE R, APPLICATION AND BE APPROVED BY THE PUBLIC WORKS DEPT.
 - PROVIDE BRICK WITHOUT FROGS OR CORES, IN SURFACES EXPOSED TO VIEW IN COMPLETED WORK.
- T-PAVEMENT THICKNESS
 B-BRICK PAVER THICKNESS

- REFER TO SECTION 4.7 OF THE ADA ACCESSIBILITY GUIDELINES FOR BUILDINGS AND FACILITIES FOR ADDITIONAL INFORMATION. VERIFY THAT ANY STATE OR LOCAL STANDARDS DO NOT AMMEND FEDERAL GUIDELINES.
- CURB RAMPS SHALL BE ISOLATED FROM ALL OTHER CONCRETE BY EXPANSION JOINTS.
- A MIN. 4'-0" X 5'-0" LANDING SHALL BE PROVIDED AT THE TOP OF RAMP. REFERENCE PLANS FOR ACTUAL LAYOUT. LANDING SHALL NOT EXCEED 2% CROSS SLOPE OR 5% LONGITUDINAL SLOPE.
- THE SIDEWALK THICKENED EDGE SHALL BE CONTINUED THROUGH FLARED SIDES.
- THE FLARED SIDES SHALL HAVE A MEDIUM BROOM FINISH PARALLEL TO THE CURB.
- MINIMUM LATERAL CLEARANCE FROM INLETS, POLES, HYDRANTS AND OTHER ABOVE GROUND OBSTACLES SHALL BE 1'-0" FROM THE SCORED OR DETECTABLE WARNING PORTION OF THE CURB RAMP.
- INLETS SHALL BE SO LOCATED THAT GUTTER FLOW DOES NOT FLOW PAST THE CURB RAMP.
- REFER TO THE MATERIALS SCHEDULE FOR TYPE AND COLOR OF DETECTABLE WARNING SURFACE.

RECORD DOCUMENTS
 December, 2011
 These Record Documents have been prepared based upon information provided by North Texas Contracting, Inc. The Design Professional has not verified the accuracy and / or completeness of this information and shall not be responsible for any errors or omissions which may be incorporated herein as a result.

Design Consultant: Half Associates, Inc.
 RECORD DRAWING SUBMITTAL

[Signature]
 Signature of Registrant
 12/5/2011
 Date

NO.	REVISION	BY	DATE

TOWN OF ADDISON
 DALLAS COUNTY, TEXAS





SPRING VALLEY ROAD

PAVEMENT DETAILS


HALFF
 1201 NORTH BOWSER ROAD, RICHARDSON, TEXAS 75081-2275
 TEL. (214) 348-8200 FAX (214) 739-0095

PROJECT	DESIGN	DRAWN	DATE	FILE	SHEET
27530	MPB	TMM	OCTOBER 2010	27530 DTPV01	DT-P1

RECORD DRAWINGS SHEET 22 OF 163

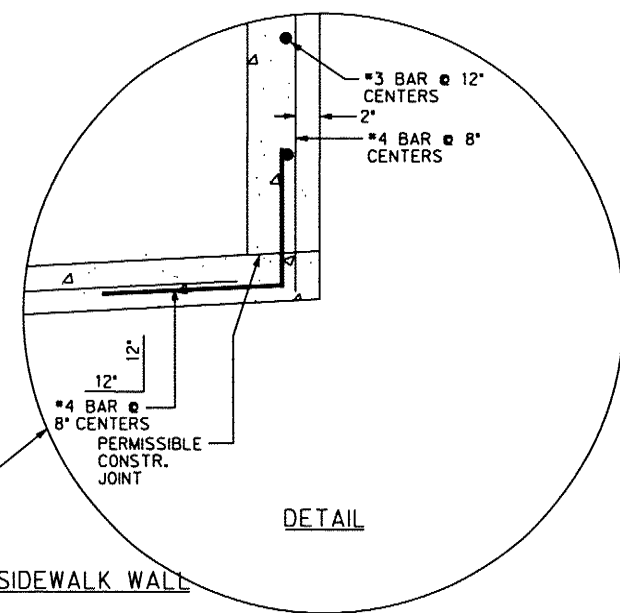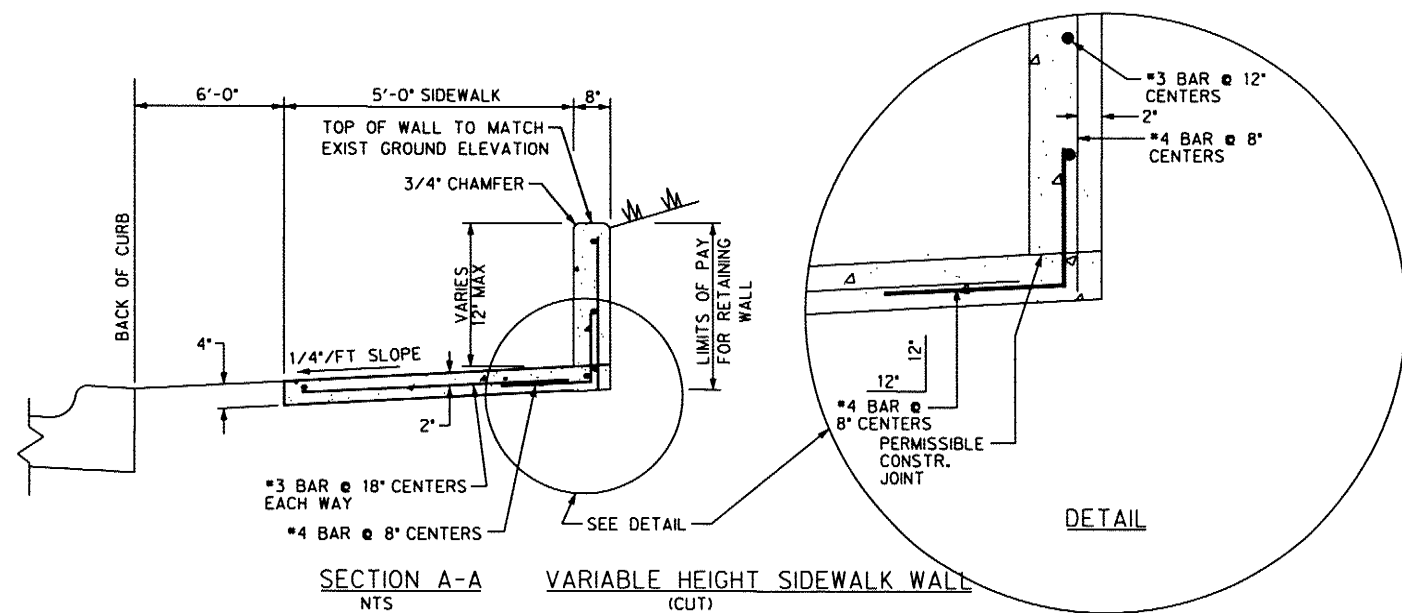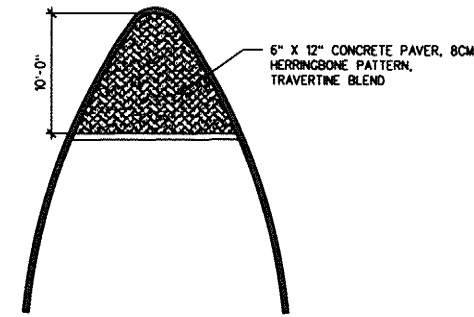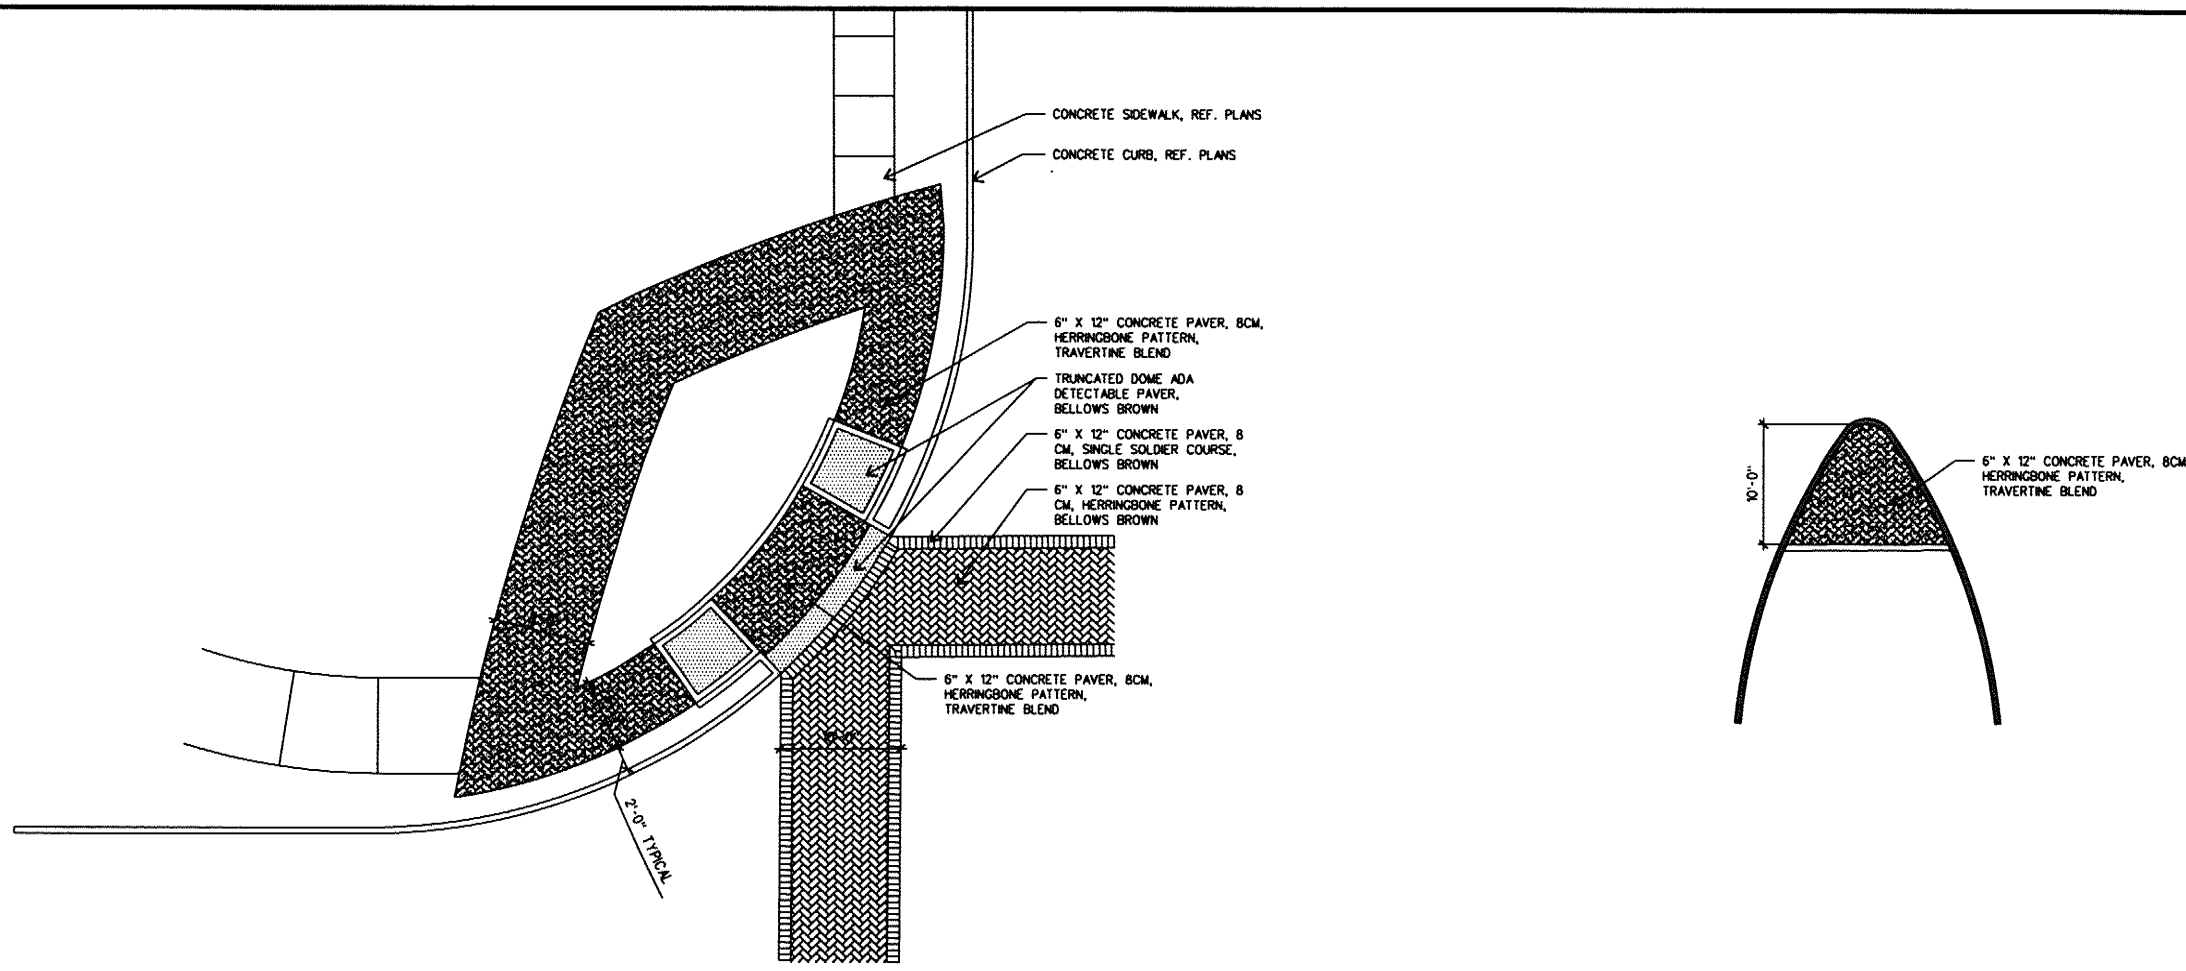

- NOTES:
1. STEEL REINFORCING IN WALL SHALL BE #3 BARS @ 12" CENTERS HORIZONTALLY AND #4 BARS @ 8" CENTERS VERTICALLY.
 2. EXPANSION JOINTS IN WALL SHALL MATCH EXPANSION JOINTS IN THE SIDEWALK.
 3. ENDS OF WALL SHALL ALSO BE CHAMFERED.
 4. CONCRETE TO HAVE COMPRESSIVE STRENGTH OF 3000 psi at 28 DAYS.


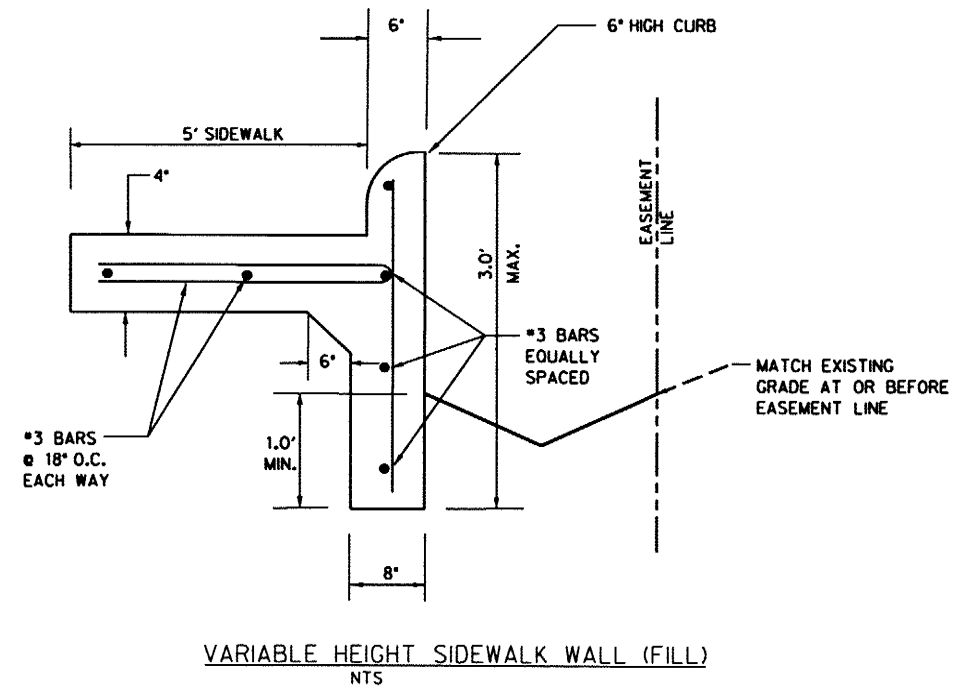


RECORD DOCUMENTS
 December, 2011
 These Record Documents have been prepared based upon information provided by North Texas Contracting, Inc. The Design Professional has not verified the accuracy and / or completeness of this information and shall not be responsible for any errors or omissions which may be incorporated herein as a result
 Design Consultant: Half Associates, Inc.
 RECORD DRAWING SUBMITTAL

Signature of Registrant: *M.E. Romanowski* Date: *12/8/2011*

NO.	REVISION	BY	DATE		
TOWN OF ADDISON DALLAS COUNTY, TEXAS SPRING VALLEY ROAD PAVEMENT DETAILS					
HALFF 1201 NORTH BOWSER ROAD, RICHARDSON, TEXAS 75081-2275 TEL (214) 346-4200 FAX (214) 739-0086					
PROJECT	DESIGN	DRAWN	DATE	FILE	SHEET
27530	MPB	TMM	OCTOBER 2010	27530 DTPV02	DT-P2

USER: ah1299
 PROJECT • 27530 OFFICE: RCH
 FILE: 27530 GRAD 01.dgn
 DATE: 12/7/2011 TIME: 10:13:05 AM

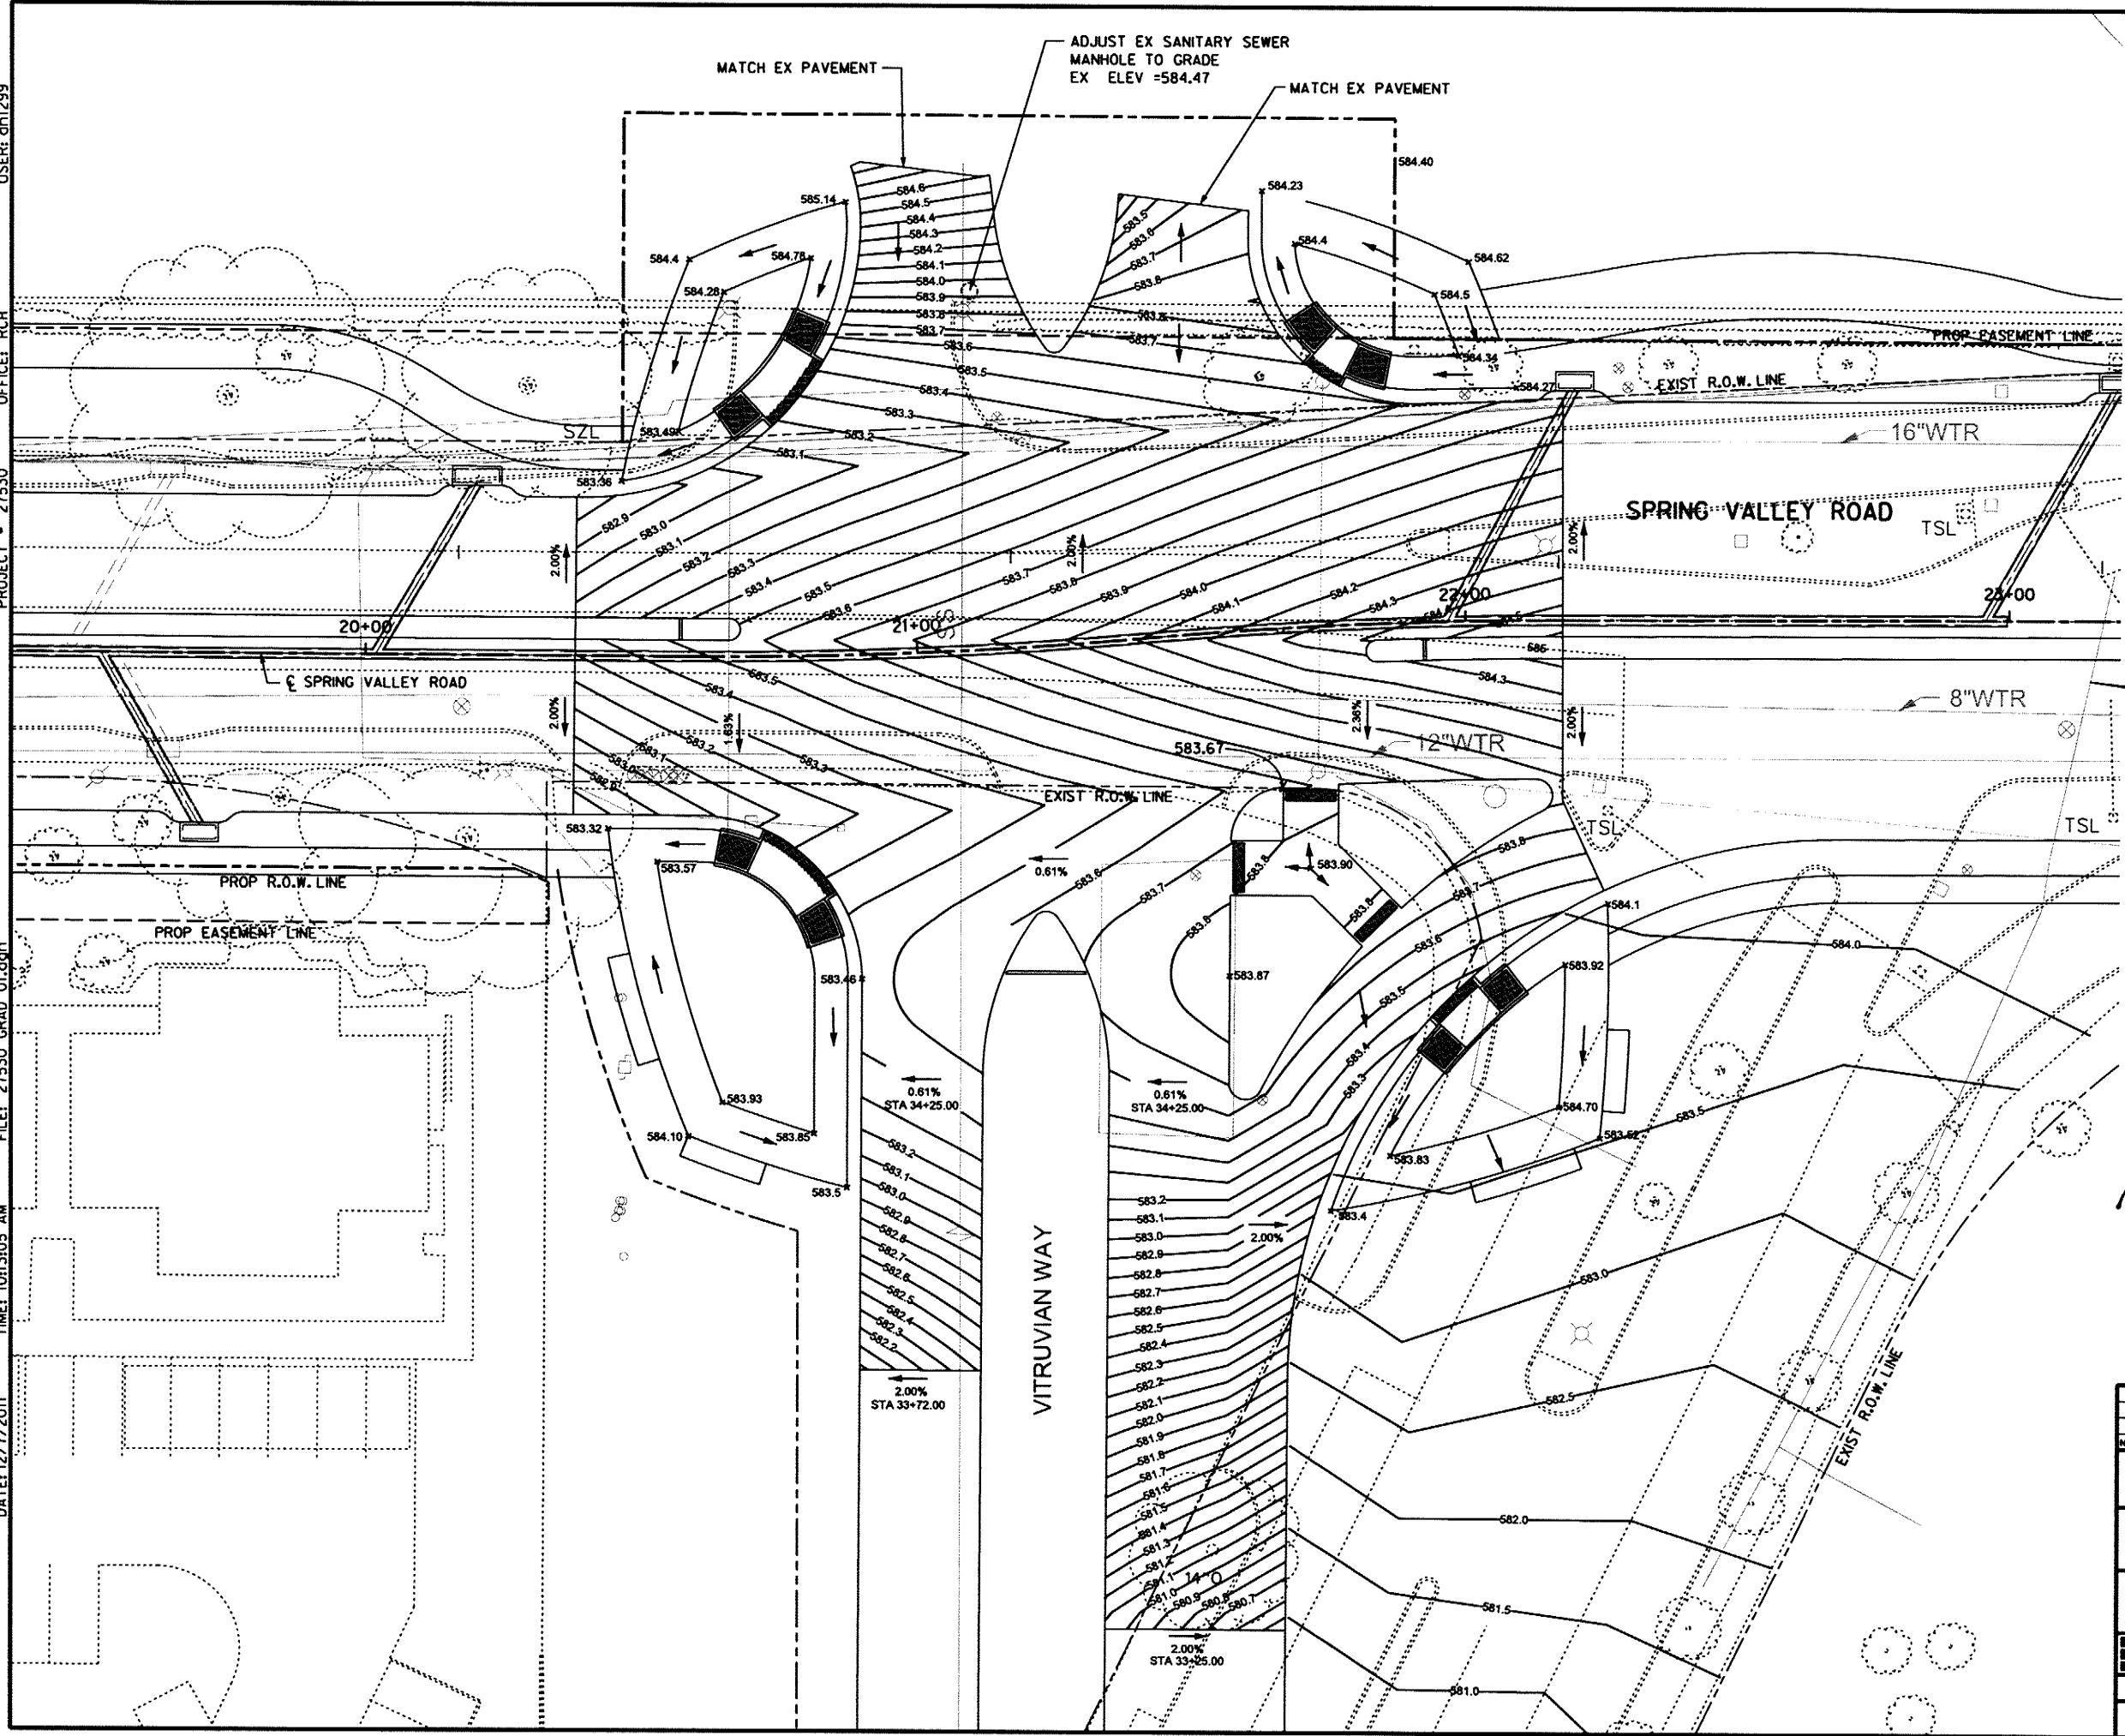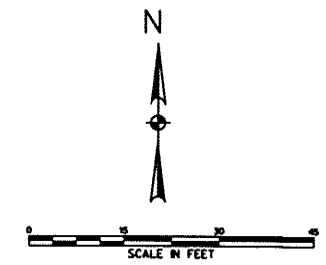

WARNING!!!
 EXISTING GAS LINE IN AREA.

RECORD DOCUMENTS
 December, 2011
 These Record Documents have been prepared based upon information provided by North Texas Contracting, Inc. The Design Professional has not verified the accuracy and / or completeness of this information and shall not be responsible for any errors or omissions which may be incorporated herein as a result.

Design Consultant: Half Associates, Inc.
 RECORD DRAWING SUBMITTAL





M.E. Romowski P.E. 12/8/2011
 Signature of Registrant Date

NO.	REVISION	BY	DATE		
TOWN OF ADDISON DALLAS COUNTY, TEXAS SPRING VALLEY ROAD GRADING PLAN AT VITRUVIAN WAY					
HALFF 1201 NORTH BOWSER ROAD, RICHARDSON, TEXAS 75081-2275 TEL (214) 346-4200 FAX (214) 738-0985					
PROJECT	DESIGN	DRAWN	DATE	FILE	SHEET
27530	MPB	TMM	OCTOBER 2010	27530 GRAD 01	GP1

SHEET 24 OF 163

RECORD DRAWINGS


DATE: 12/7/2011 TIME: 10:13:46 AM FILE: 27530 PMKS 01.dgn PROJECT: 27530 OFFICE: RCH USER: oh1299

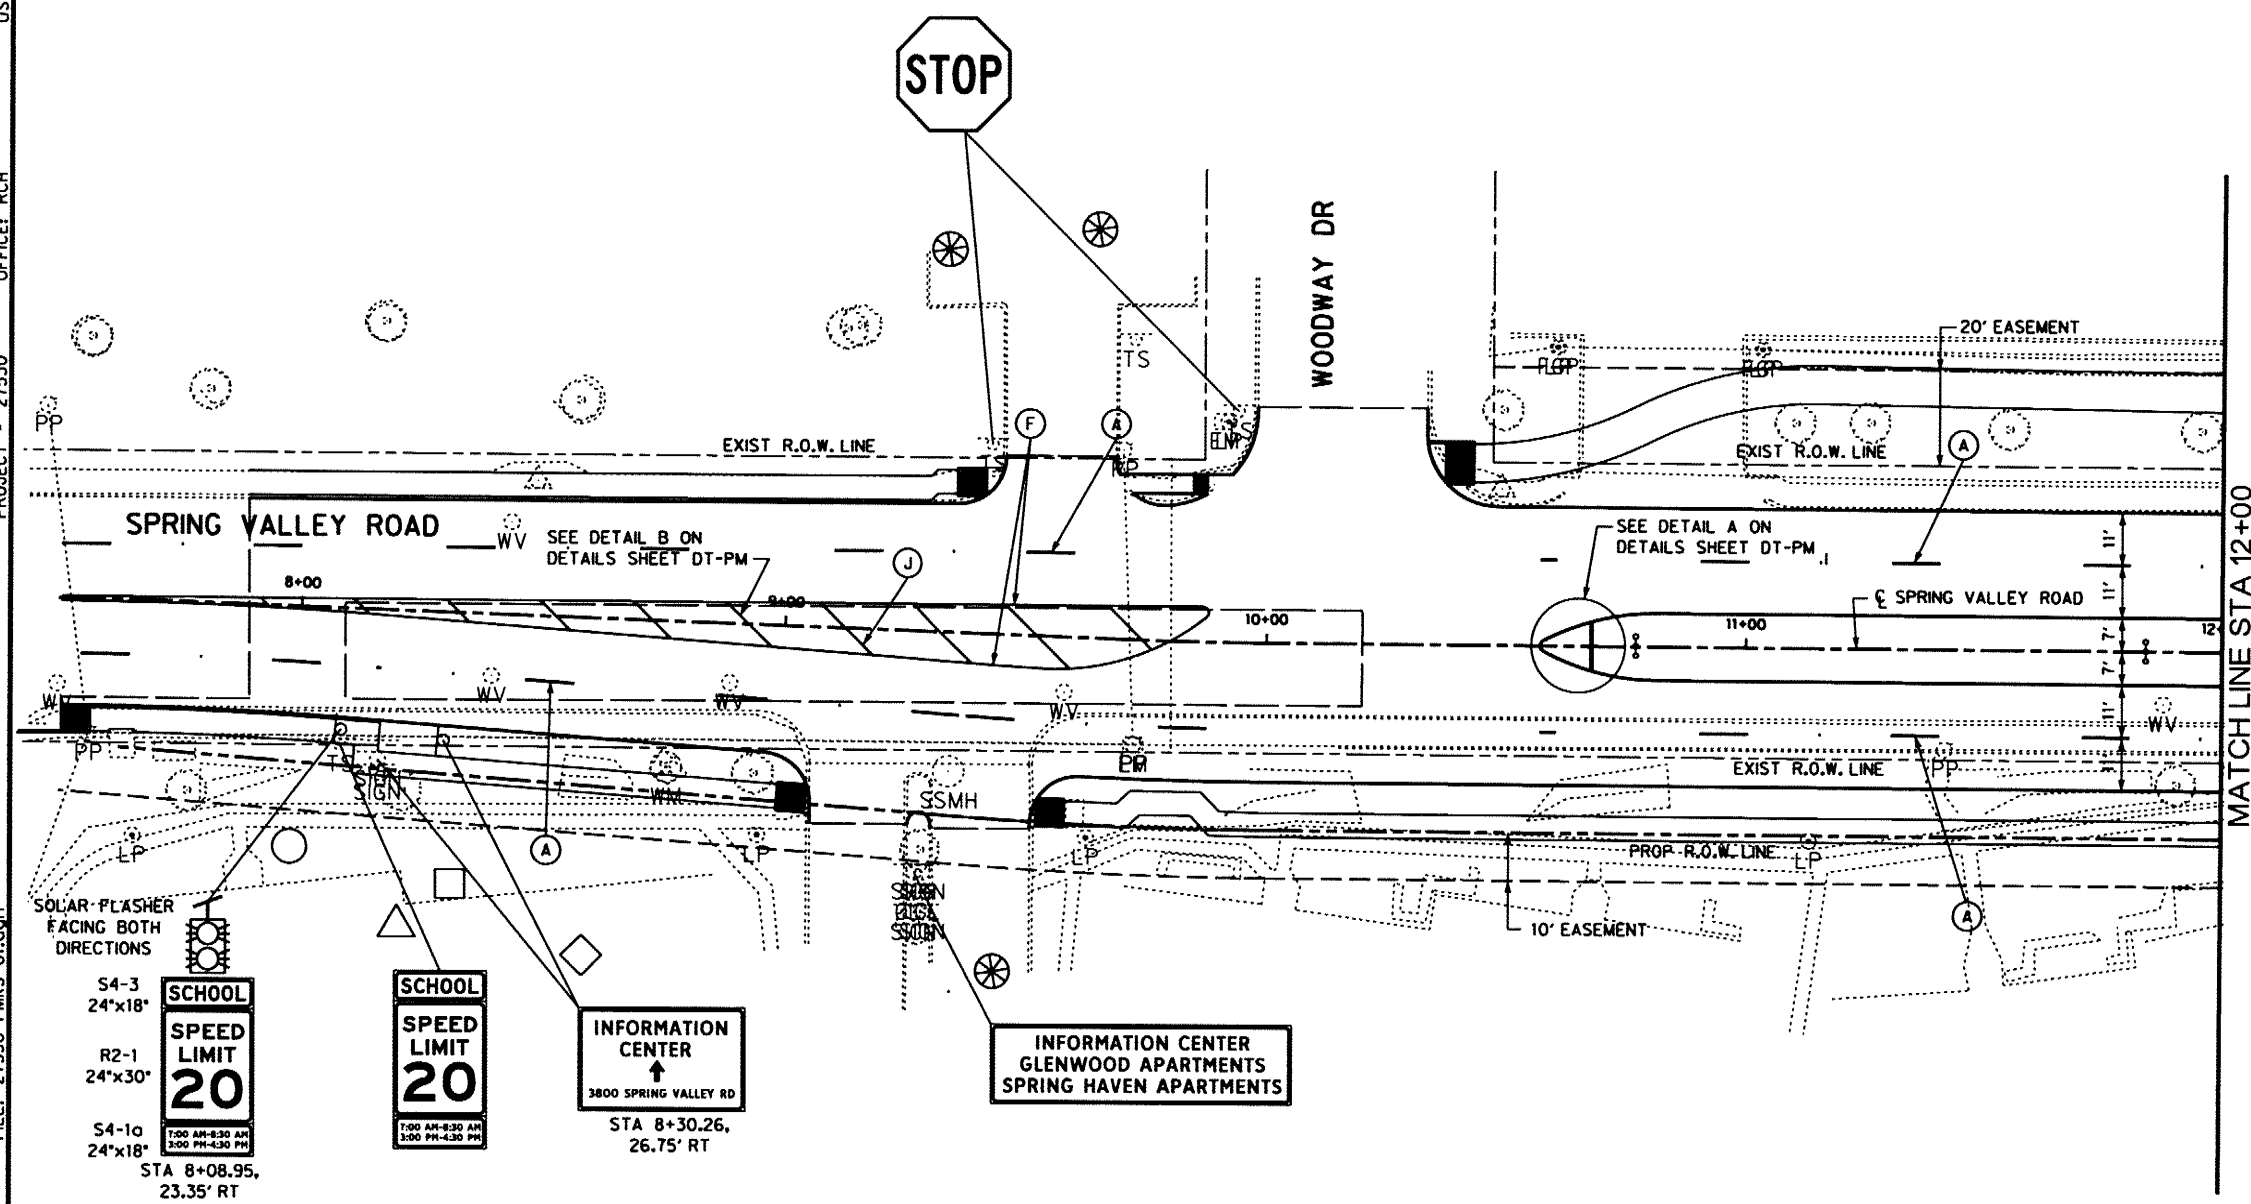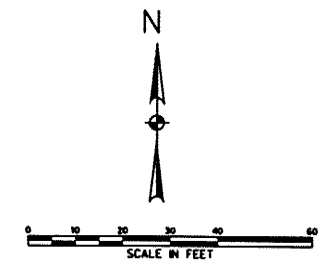

LEGEND

- (A) 4" WHITE BROKEN STRIPE 15' IN LENGTH WITH 30' GAPS SUPPLEMENTED BY TY-II-CR4 BUTTONS CENTERED ON GAP. CLEAR SIDE OF BUTTON SHALL FACE TRAFFIC FLOW
- (B) 4" WHITE SOLID REFLECTORIZED PAVEMENT MARKING
- (C) 12" WHITE SOLID REFLECTORIZED PAVEMENT MARKING
- (D) 24" WHITE SOLID REFLECTORIZED PAVEMENT MARKING
- (E) 4" WHITE DOT REFLECTORIZED PAVEMENT MARKING
- (F) 4" YELLOW SOLID REFLECTORIZED PAVEMENT MARKING
- (H) 8" WHITE SOLID REFLECTORIZED PAVEMENT MARKING
- (J) 12" YELLOW SOLID REFLECTORIZED PAVEMENT MARKING
- (K) WHITE REFLECTORIZED PAVEMENT MARKING WORD
- (L) WHITE REFLECTORIZED PAVEMENT MARKING ARROW



NOTE:
ALL SIGNING AND STRIPING SHALL COMPLY WITH THE LATEST VERSION OF TMTUCD.


 Signature of Registrant: *M.E. Romanowski* Date: 12/5/2011



RECORD DOCUMENTS
 December, 2011
 These Record Documents have been prepared based upon information provided by North Texas Contracting, Inc. The Design Professional has not verified the accuracy and / or completeness of this information and shall not be responsible for any errors or omissions which may be incorporated herein as a result.
 Design Consultant: Half Associates, Inc.
 RECORD DRAWING SUBMITTAL

LEGEND

- PROPOSED SIGN TO BE INSTALLED
- ⊗ EXISTING SIGN TO REMAIN IN PLACE
- △ EXISTING SIGN TO BE REMOVED
- EXISTING SIGN TO BE RELOCATED
- ◇ EXISTING SIGN RELOCATED

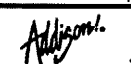NO.	REVISION	BY	DATE
 TOWN OF ADDISON DALLAS COUNTY, TEXAS			
SPRING VALLEY ROAD			
STRIPING & SIGNAGE LAYOUT STA 8+87.26 TO 12+00			
		1201 NORTH BOWBER ROAD, RICHARDSON, TEXAS 75081-2275 TEL (214) 348-8200 FAX (214) 738-0085	
PROJECT	DESIGN	DRAWN	DATE
27530	MPB	TMM	OCTOBER 2010
FILE	SHEET		
27530 PMKS 01	PM1		

RECORD DRAWINGS SHEET 25 OF 163

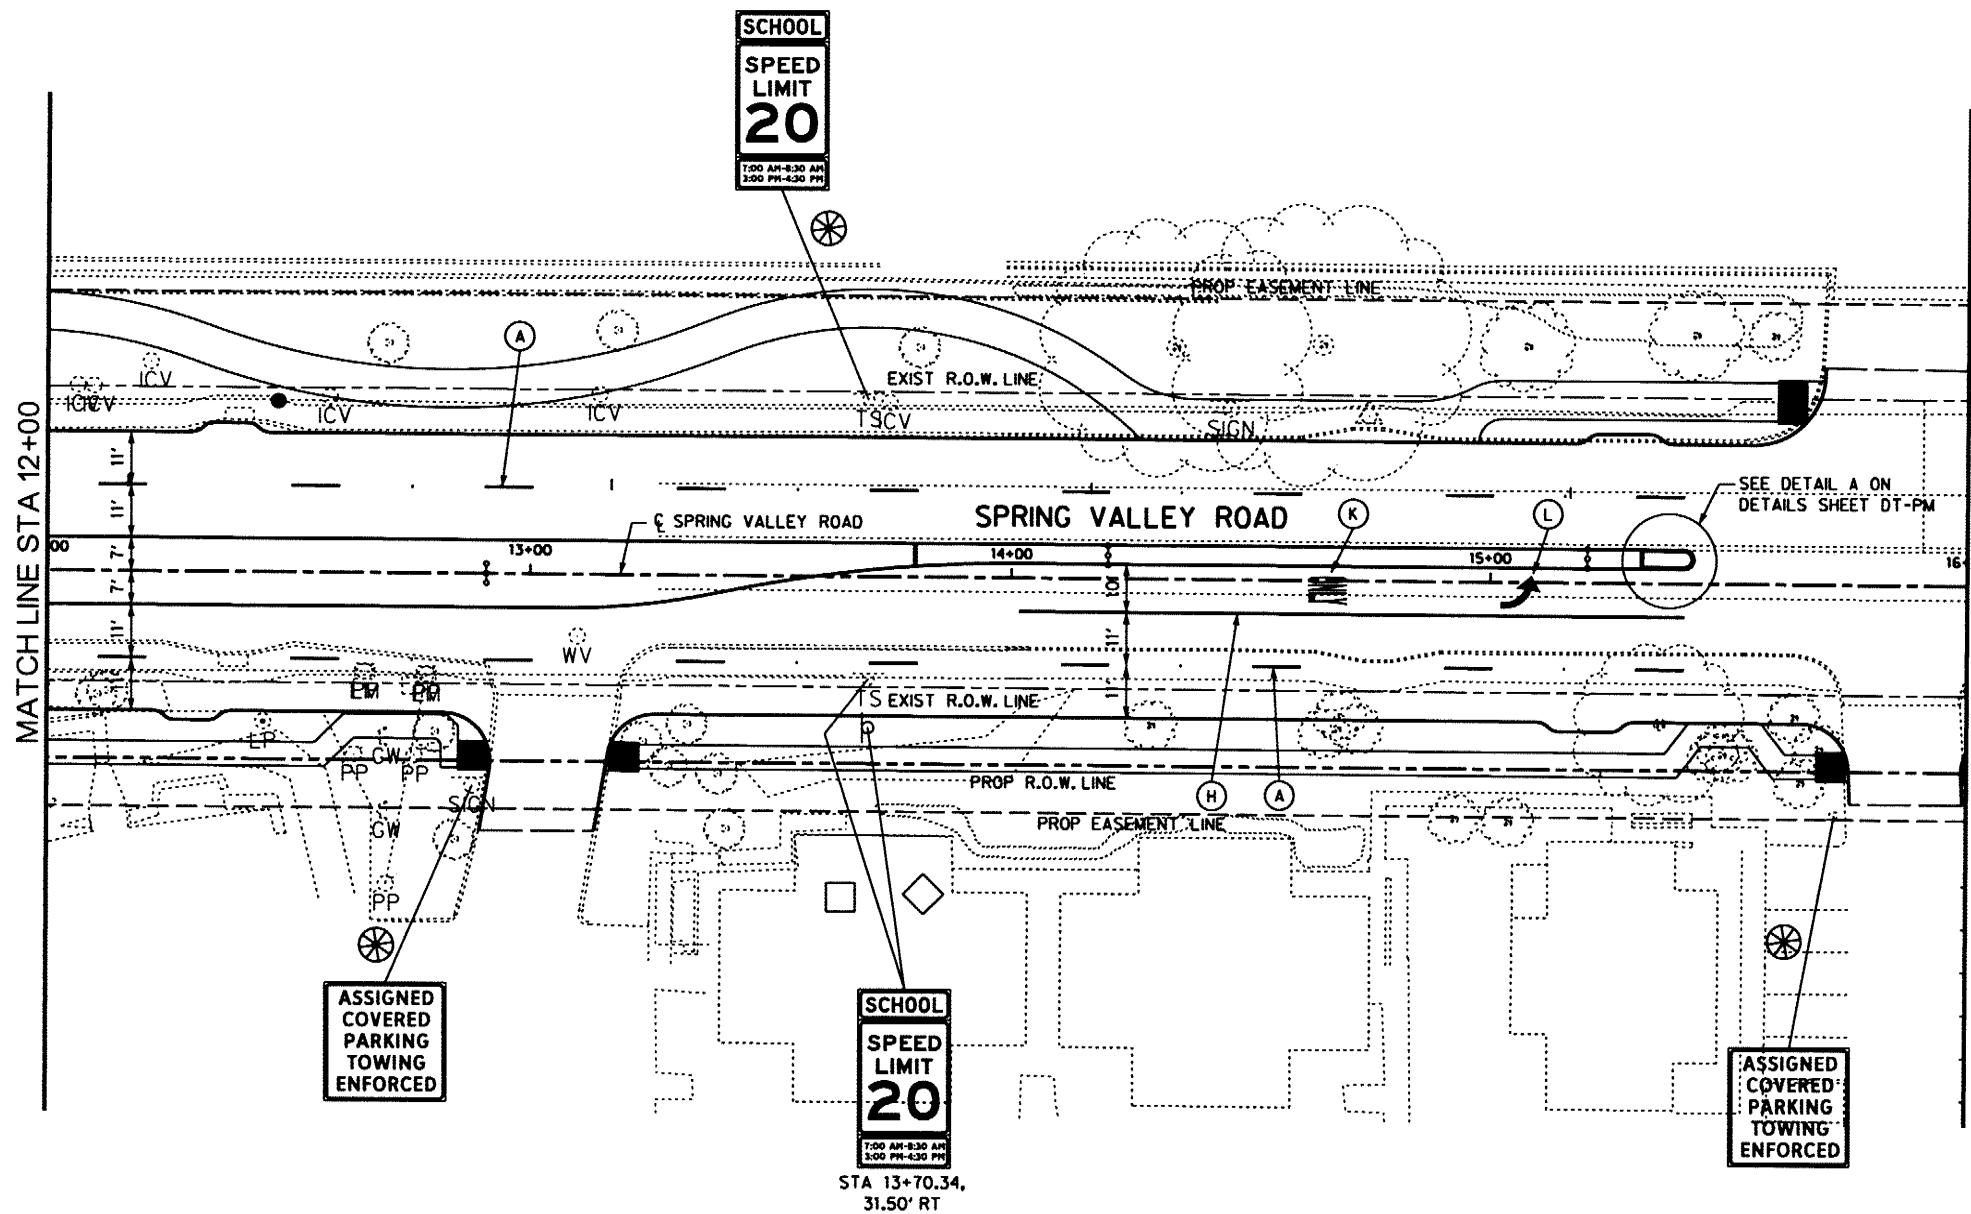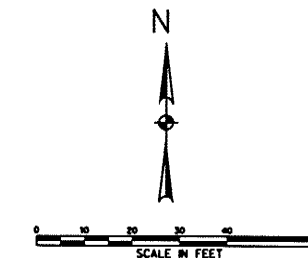

LEGEND

- (A) 4" WHITE BROKEN STRIPE 15' IN LENGTH WITH 30' GAPS SUPPLEMENTED BY TY-II-CR4 BUTTONS CENTERED ON GAP. CLEAR SIDE OF BUTTON SHALL FACE TRAFFIC FLOW
- (B) 4" WHITE SOLID REFLECTORIZED PAVEMENT MARKING
- (C) 12" WHITE SOLID REFLECTORIZED PAVEMENT MARKING
- (D) 24" WHITE SOLID REFLECTORIZED PAVEMENT MARKING
- (E) 4" WHITE DOT REFLECTORIZED PAVEMENT MARKING
- (F) 4" YELLOW SOLID REFLECTORIZED PAVEMENT MARKING
- (H) 8" WHITE SOLID REFLECTORIZED PAVEMENT MARKING
- (J) 12" YELLOW SOLID REFLECTORIZED PAVEMENT MARKING
- (K) WHITE REFLECTORIZED PAVEMENT MARKING WORD
- (L) WHITE REFLECTORIZED PAVEMENT MARKING ARROW

NOTE:
ALL SIGNING AND STRIPING SHALL COMPLY WITH THE LATEST VERSION OF T MUTCD.

RECORD DOCUMENTS
December, 2011
These Record Documents have been prepared based upon information provided by North Texas Contracting, Inc. The Design Professional has not verified the accuracy and / or completeness of this information and shall not be responsible for any errors or omissions which may be incorporated herein as a result.

Design Consultant: Halff Associates, Inc.
RECORD DRAWING SUBMITTAL





MFR
Signature of Registrant P.E. *12/20/11*
Date

LEGEND

- PROPOSED SIGN TO BE INSTALLED
- ⊗ EXISTING SIGN TO REMAIN IN PLACE
- △ EXISTING SIGN TO BE REMOVED
- EXISTING SIGN TO BE RELOCATED
- ◇ EXISTING SIGN RELOCATED

NO.	REVISION	BY	DATE
TOWN OF ADDISON DALLAS COUNTY, TEXAS SPRING VALLEY ROAD STRIPING & SIGNAGE LAYOUT STA 12+00 TO 16+00			
HALFF 1201 NORTH BOWSER ROAD, RICHARDSON, TEXAS 75081-2275 TEL (214) 348-4200 FAX (214) 738-0085			
PROJECT	DESIGN	DRAWN	DATE
27530	MPB	TMM	OCTOBER 2010
FILE	SHEET		
27530 PMKS 02	PM2		

DATE: 12/17/2011 TIME: 10:14:15 AM FILE: 27530 PMKS 03.dgn PROJECT: 27530 OFFICE: RCH USER: rch1299

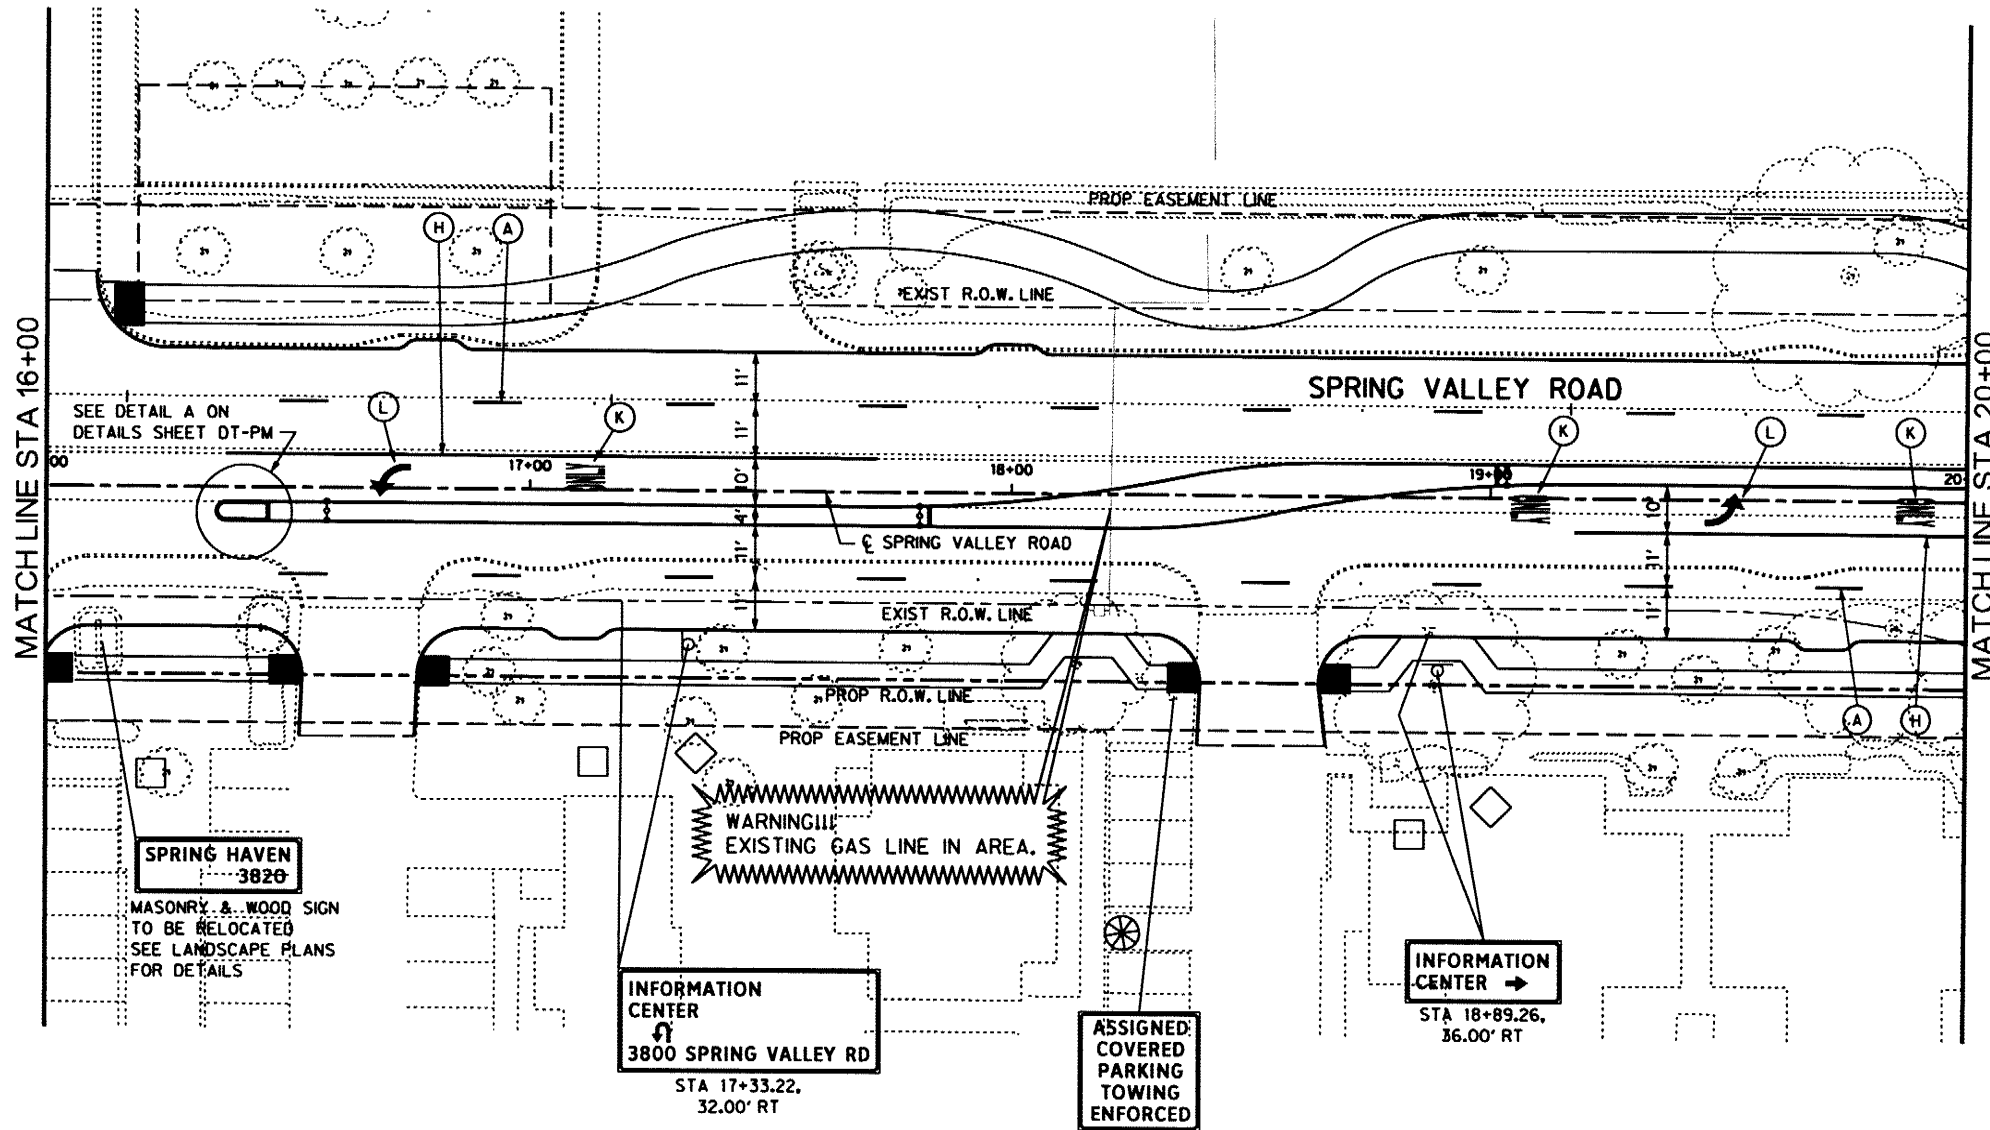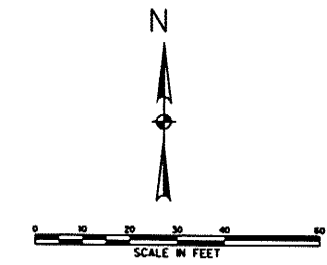


- (A) 4" WHITE BROKEN STRIPE 15' IN LENGTH WITH 30' GAPS SUPPLEMENTED BY TY-II-CR4 BUTTONS CENTERED ON GAP. CLEAR SIDE OF BUTTON SHALL FACE TRAFFIC FLOW
- (B) 4" WHITE SOLID REFLECTORIZED PAVEMENT MARKING
- (C) 12" WHITE SOLID REFLECTORIZED PAVEMENT MARKING
- (D) 24" WHITE SOLID REFLECTORIZED PAVEMENT MARKING
- (E) 4" WHITE DOT REFLECTORIZED PAVEMENT MARKING
- (F) 4" YELLOW SOLID REFLECTORIZED PAVEMENT MARKING
- (H) 8" WHITE SOLID REFLECTORIZED PAVEMENT MARKING
- (J) 12" YELLOW SOLID REFLECTORIZED PAVEMENT MARKING
- (K) WHITE REFLECTORIZED PAVEMENT MARKING WORD
- (L) WHITE REFLECTORIZED PAVEMENT MARKING ARROW

NOTE:
ALL SIGNING AND STRIPING SHALL COMPLY WITH THE LATEST VERSION OF T MUTCD.



RECORD DOCUMENTS
December, 2011
These Record Documents have been prepared based upon information provided by North Texas Contracting, Inc. The Design Professional has not verified the accuracy and / or completeness of this information and shall not be responsible for any errors or omissions which may be incorporated herein as a result.

Design Consultant: Half Associates, Inc.
RECORD DRAWING SUBMITTAL


Signature of Registrant: *M.E. Romanowski* P.E. Date: 12/8/2011



LEGEND

- PROPOSED SIGN TO BE INSTALLED
- ⊗ EXISTING SIGN TO REMAIN IN PLACE
- △ EXISTING SIGN TO BE REMOVED
- EXISTING SIGN TO BE RELOCATED
- ◇ EXISTING SIGN RELOCATED

NO.	REVISION	BY	DATE
 TOWN OF ADDISON DALLAS COUNTY, TEXAS SPRING VALLEY ROAD STRIPING & SIGNAGE LAYOUT STA 16+00 TO 20+00  1201 NORTH BOWSER ROAD, RICHARDSON, TEXAS 75081-2275 TEL (214) 344-8200 FAX (214) 738-0095			
PROJECT	DESIGN	DRAWN	DATE
27530	MPB	TMM	OCTOBER 2010
FILE	SHEET		
27530 PMKS 03	PM3		

RECORD DRAWINGS SHEET 27 OF 163

DATE: 12/7/2011 TIME: 10:14:33 AM FILE: 27530 PMKS 04.dgn PROJECT: 27530 OFFICE: RCH USER: chl299

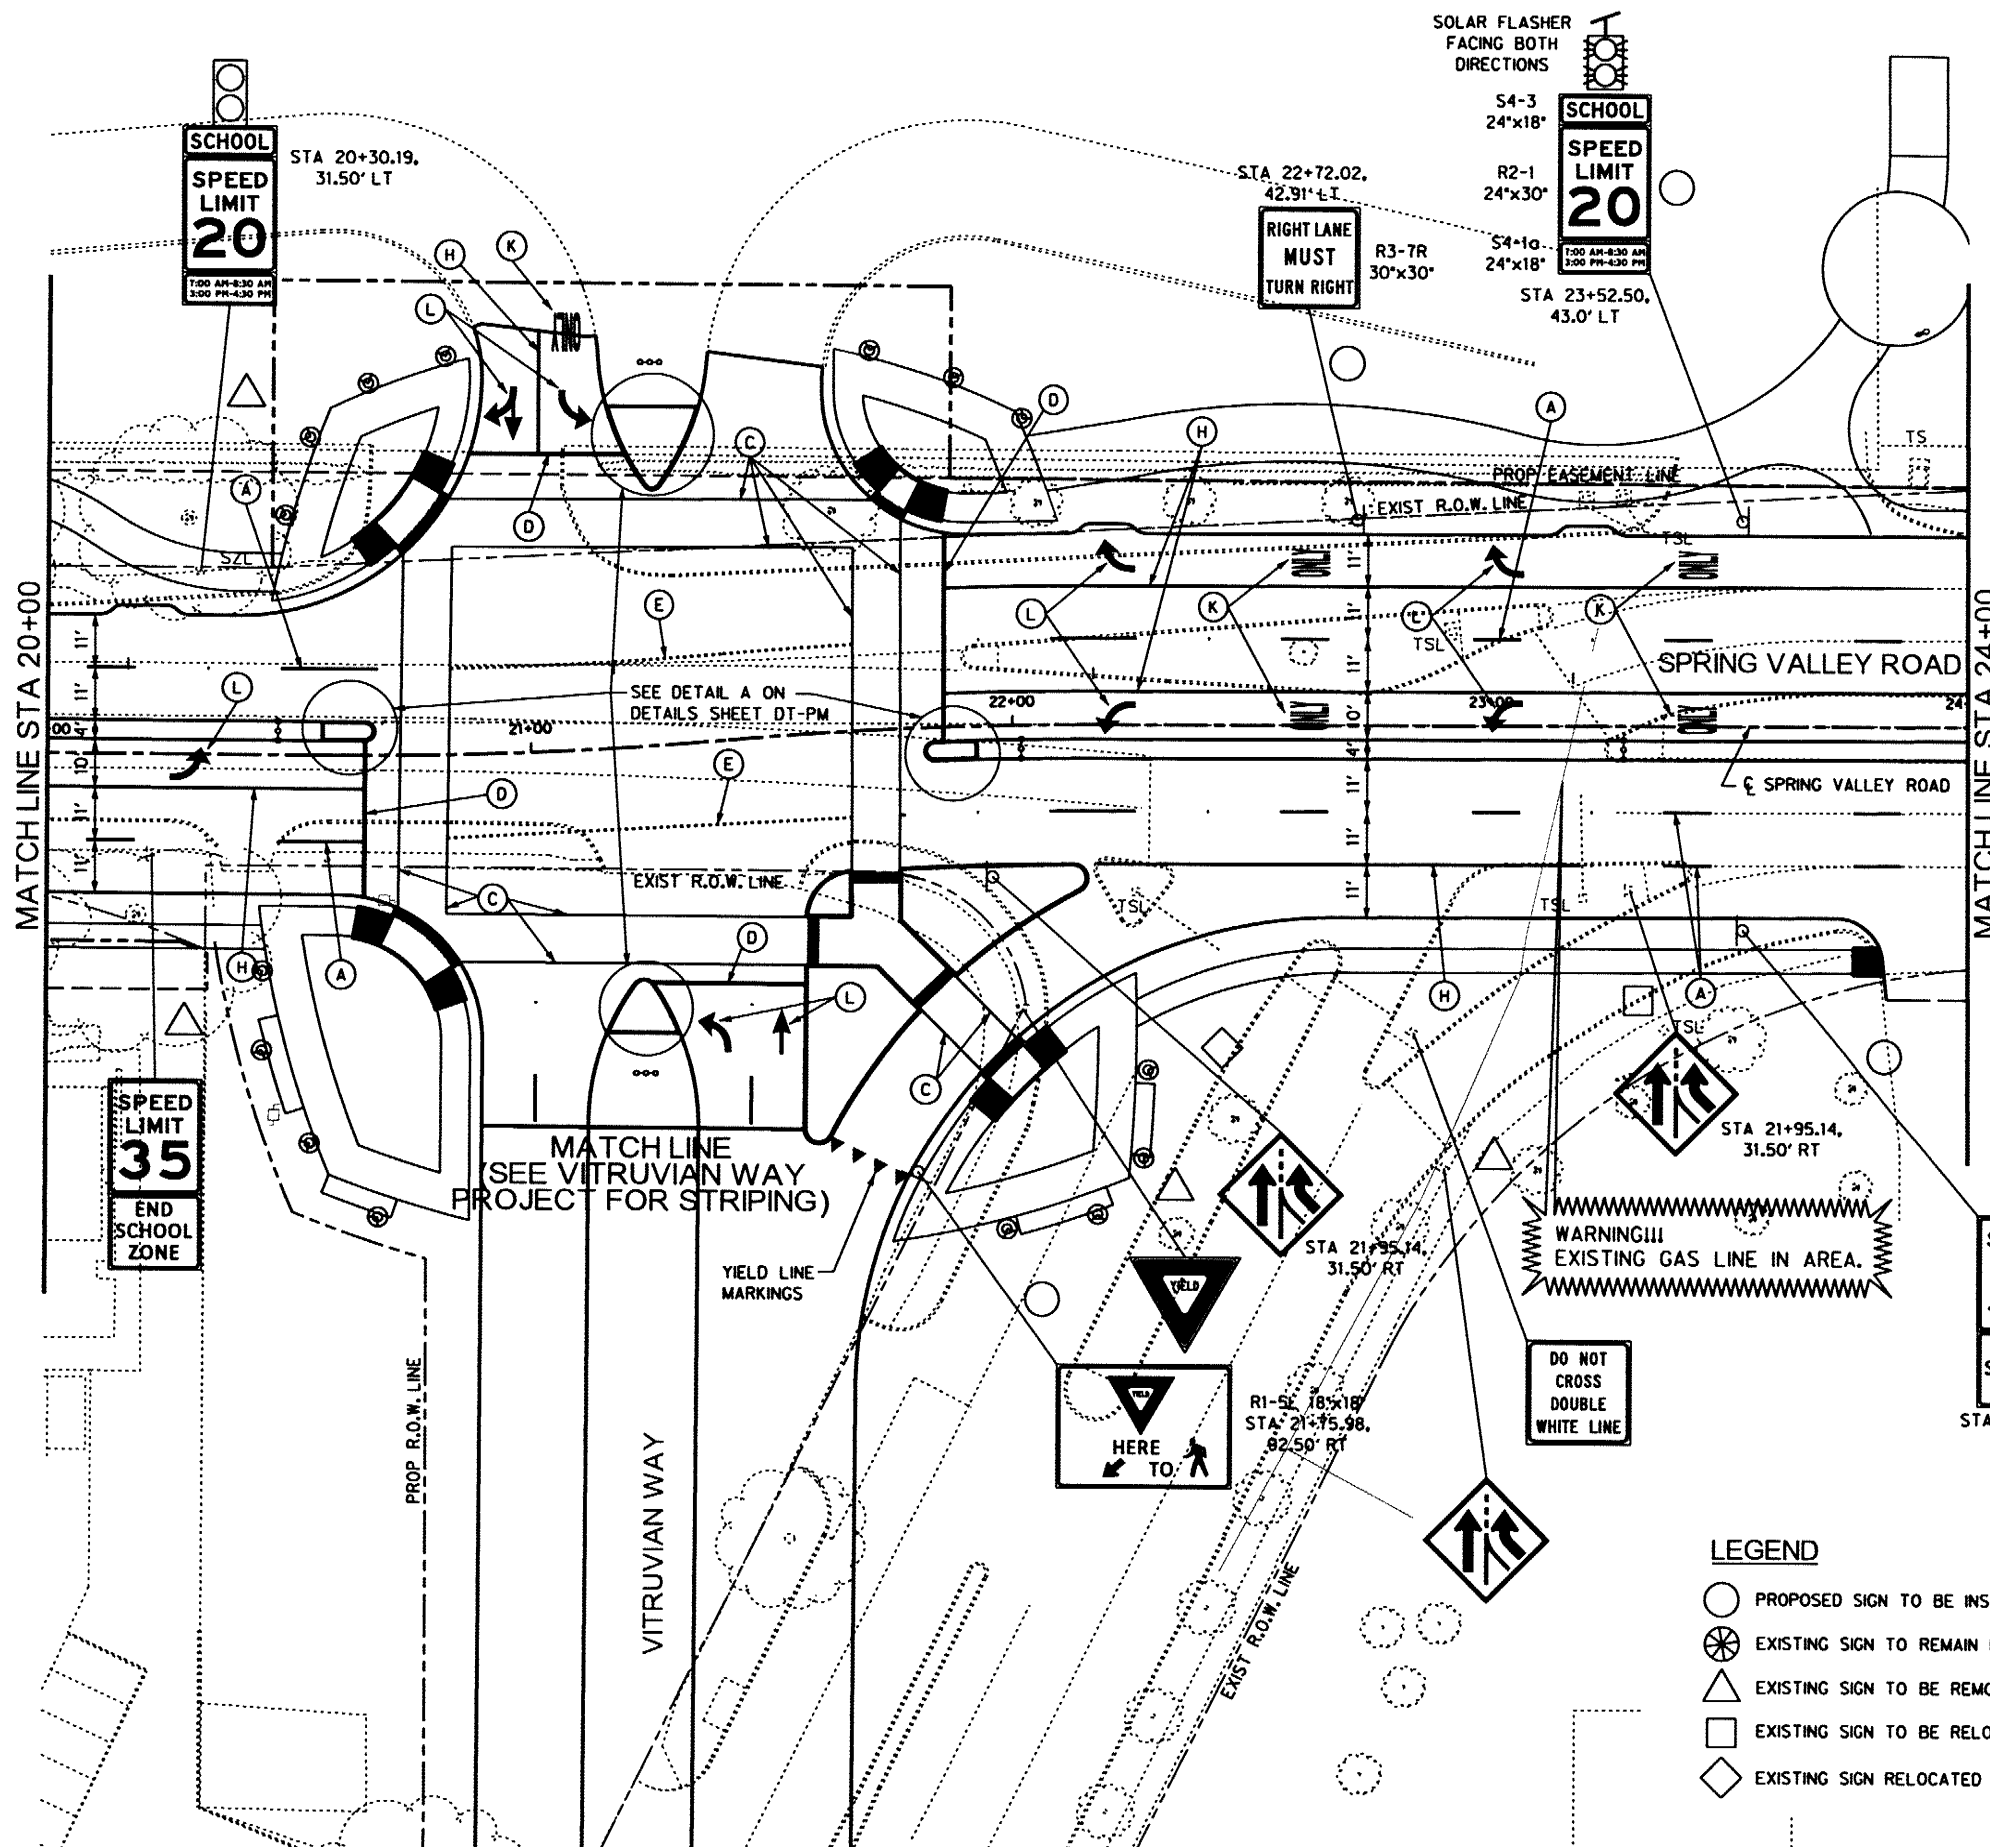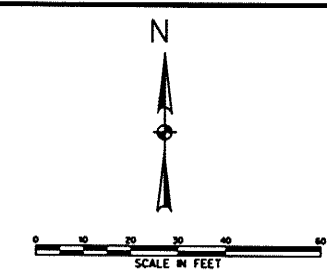

LEGEND

- (A) 4" WHITE BROKEN STRIPE 15' IN LENGTH WITH 30' GAPS SUPPLEMENTED BY TY-II-CR4 BUTTONS CENTERED ON GAP. CLEAR SIDE OF BUTTON SHALL FACE TRAFFIC FLOW
- (B) 4" WHITE SOLID REFLECTORIZED PAVEMENT MARKING
- (C) 12" WHITE SOLID REFLECTORIZED PAVEMENT MARKING
- (D) 24" WHITE SOLID REFLECTORIZED PAVEMENT MARKING
- (E) 4" WHITE DOT REFLECTORIZED PAVEMENT MARKING
- (F) 4" YELLOW SOLID REFLECTORIZED PAVEMENT MARKING
- (H) 8" WHITE SOLID REFLECTORIZED PAVEMENT MARKING
- (J) 12" YELLOW SOLID REFLECTORIZED PAVEMENT MARKING
- (K) WHITE REFLECTORIZED PAVEMENT MARKING WORD
- (L) WHITE REFLECTORIZED PAVEMENT MARKING ARROW

NOTE:
ALL SIGNING AND STRIPING SHALL COMPLY WITH THE LATEST VERSION OF T MUTCD.

RECORD DOCUMENTS
December, 2011
These Record Documents have been prepared based upon information provided by North Texas Contracting, Inc. The Design Professional has not verified the accuracy and / or completeness of this information and shall not be responsible for any errors or omissions which may be incorporated herein as a result.
Design Consultant: Half Associates, Inc.
RECORD DRAWING SUBMITTAL



[Signature]
Signature of Registrant Date 12/8/2011

SPEED LIMIT 35
END SCHOOL ZONE
R2-1 24"x30"
S5-2 24"x30"
STA 23+52.50, 42.5' RT



LEGEND

- PROPOSED SIGN TO BE INSTALLED
- ⊗ EXISTING SIGN TO REMAIN IN PLACE
- △ EXISTING SIGN TO BE REMOVED
- EXISTING SIGN TO BE RELOCATED
- ◇ EXISTING SIGN RELOCATED

NO.	REVISION	BY	DATE
ADDISON TOWN OF ADDISON DALLAS COUNTY, TEXAS SPRING VALLEY ROAD STRIPING & SIGNAGE LAYOUT STA 20+00 TO 24+00			
HALFF 1201 NORTH BOWSER ROAD, RICHARDSON, TEXAS 75061-2275 TEL (214) 348-6200 FAX (214) 738-0085			
PROJECT	DESIGN	DRAWN	DATE
27530	MPB	TMM	OCTOBER 2010
FILE	SHEET		
27530 PMKS 04	PM4		

SHEET 28 OF 163 RECORD DRAWINGS

DATE: 12/7/2011 TIME: 10:14:46 AM FILE: 27530 PMKS 05.dgn PROJECT: 27530 OFFICE: RCH USER: chl299

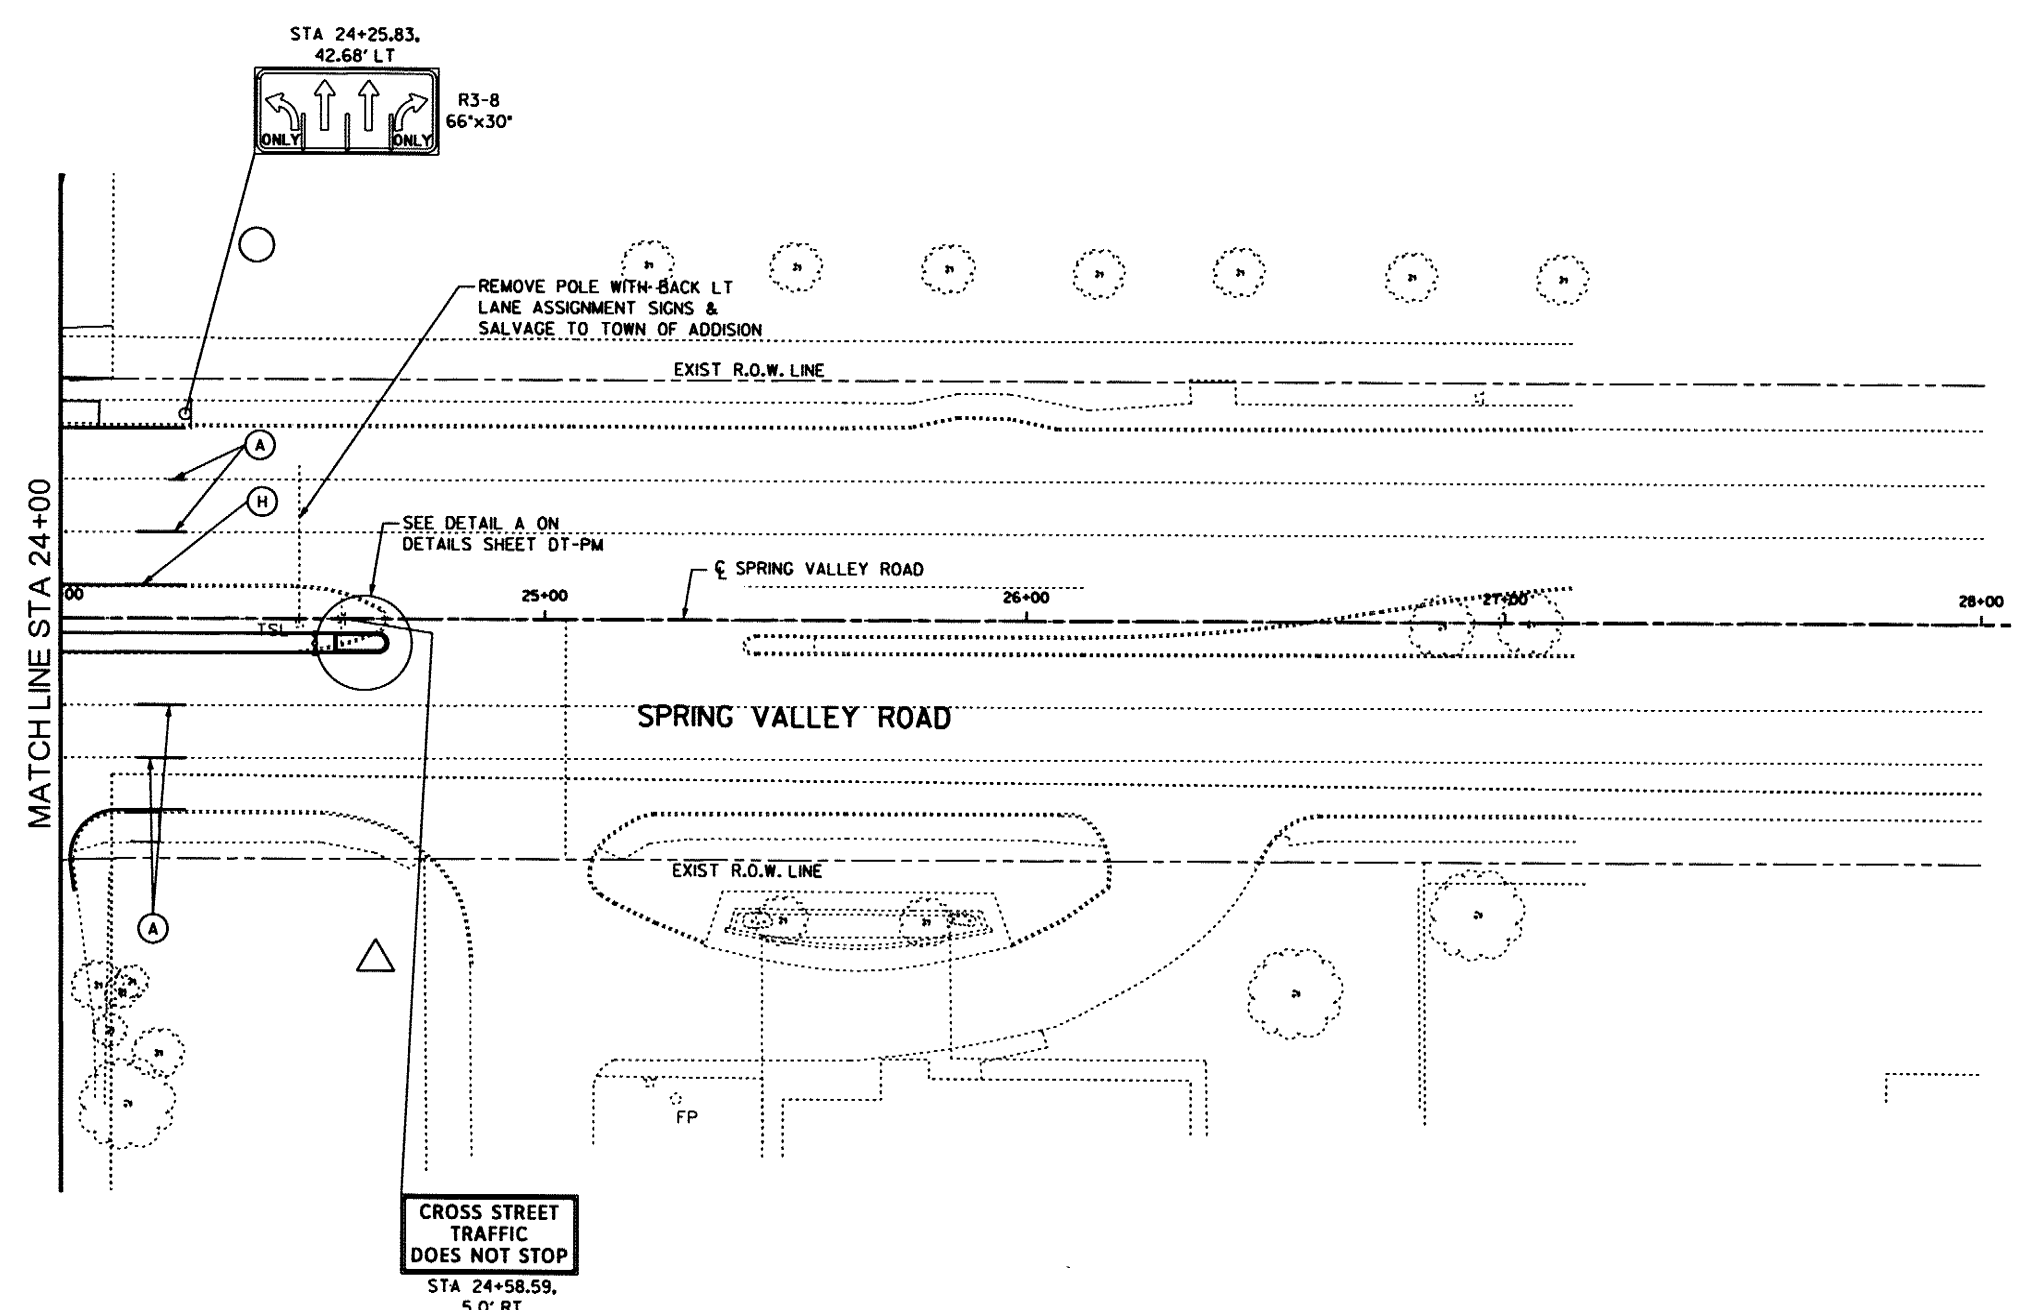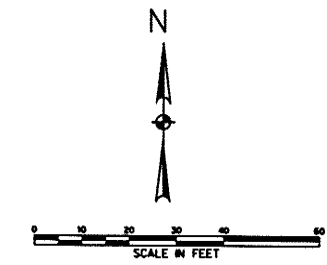

LEGEND

- (A) 4" WHITE BROKEN STRIPE 15' IN LENGTH WITH 30' GAPS SUPPLEMENTED BY TY-II-CR4 BUTTONS CENTERED ON GAP. CLEAR SIDE OF BUTTON SHALL FACE TRAFFIC FLOW
- (B) 4" WHITE SOLID REFLECTORIZED PAVEMENT MARKING
- (C) 12" WHITE SOLID REFLECTORIZED PAVEMENT MARKING
- (D) 24" WHITE SOLID REFLECTORIZED PAVEMENT MARKING
- (E) 4" WHITE DOT REFLECTORIZED PAVEMENT MARKING
- (F) 4" YELLOW SOLID REFLECTORIZED PAVEMENT MARKING
- (H) 8" WHITE SOLID REFLECTORIZED PAVEMENT MARKING
- (J) 12" YELLOW SOLID REFLECTORIZED PAVEMENT MARKING
- (K) WHITE REFLECTORIZED PAVEMENT MARKING WORD
- (L) WHITE REFLECTORIZED PAVEMENT MARKING ARROW

NOTE:
ALL SIGNING AND STRIPING SHALL COMPLY WITH THE LATEST VERSION OF T MUTCD.

RECORD DOCUMENTS
December, 2011
These Record Documents have been prepared based upon information provided by North Texas Contracting, Inc. The Design Professional has not verified the accuracy and / or completeness of this information and shall not be responsible for any errors or omissions which may be incorporated herein as a result.



Design Consultant: Half Associates, Inc.
RECORD DRAWING SUBMITTAL
Signature of Registrant: *M.E. Romanowski* Date: 12/8/2011


LEGEND

- PROPOSED SIGN TO BE INSTALLED
- ⊗ EXISTING SIGN TO REMAIN IN PLACE
- △ EXISTING SIGN TO BE REMOVED
- EXISTING SIGN TO BE RELOCATED
- ◇ EXISTING SIGN RELOCATED


NO.		REVISION		BY	DATE
TOWN OF ADDISON DALLAS COUNTY, TEXAS SPRING VALLEY ROAD STRIPING & SIGNAGE LAYOUT STA 24+00 TO 26+11.52					
		1201 NORTH BOWSER ROAD, RICHARDSON, TEXAS 75081-2275 TEL (214) 348-8200 FAX (214) 728-0085			
PROJECT	DESIGN	DRAWN	DATE	FILE	SHEET
27530	MPB	TMM	OCTOBER 2010	27530 PMKS 05	PM5

RECORD DRAWINGS SHEET 29 OF 163


DATE: 12/7/2011 TIME: 10:15:03 AM FILE: 27530 DTSN 01.dgn PROJECT: 27530 OFFICE: RCH USER: oh1299

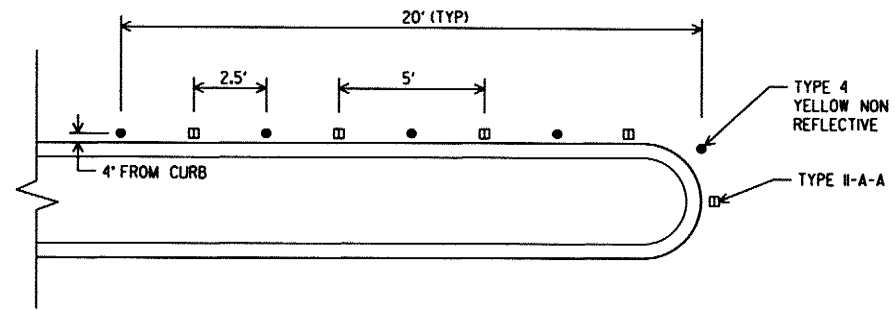


DETAIL "A"
N.T.S.

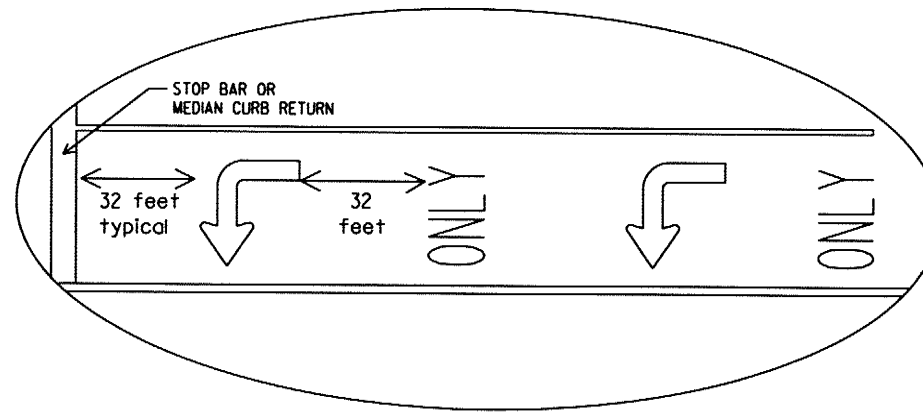

DETAIL "C"
TYPICAL FOR ALL PROPOSED
TURN LANES
N.T.S.

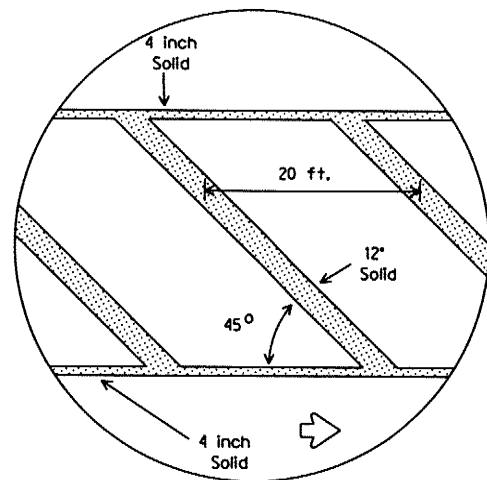

DETAIL "B"
TYPICAL FOR ALL PROPOSED
LANE BLOCK STRIPING
N.T.S.

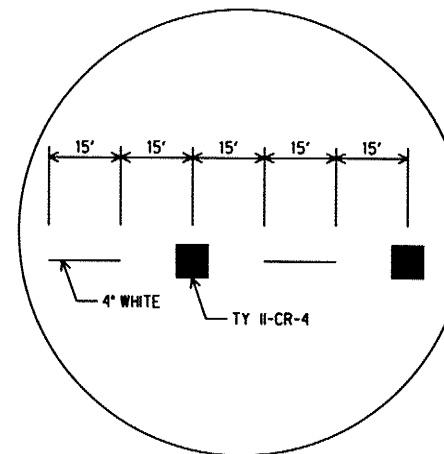


DETAIL "D"
N.T.S.

RECORD DOCUMENTS
December, 2011
These Record Documents have been prepared based upon information provided by North Texas Contracting, Inc. The Design Professional has not verified the accuracy and / or completeness of this information and shall not be responsible for any errors or omissions which may be incorporated herein as a result.
Design Consultant: Half Associates, Inc.
RECORD DRAWING SUBMITTAL

Signature of Registrant Date 12/8/2011

NO.	REVISION	BY	DATE		
TOWN OF ADDISON DALLAS COUNTY, TEXAS SPRING VALLEY ROAD PAVEMENT MARKING DETAILS					
1201 NORTH BOWSER ROAD, RICHARDSON, TEXAS 75081-2275 TEL (214) 348-6200 FAX (214) 739-0085					
PROJECT	DESIGN	DRAWN	DATE	FILE	SHEET
27530	MPB	TMM	OCTOBER 2010	27530 DTSN 01	DT-PM

DATE: 12/7/2011 TIME: 10:15:27 AM FILE: 27530 DAM 01.dgn PROJECT: 27530 OFFICE: RCH USER: rch1299

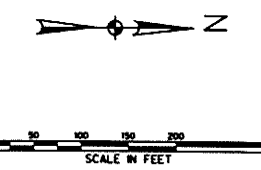


WOODWAY DR

SPRING VALLEY ROAD

TRUVIAN WAY

LEGEND

- DRAINAGE DIVIDE LINE
- - - RIGHT-OF-WAY LINE
- ← DIRECTION OF FLOW

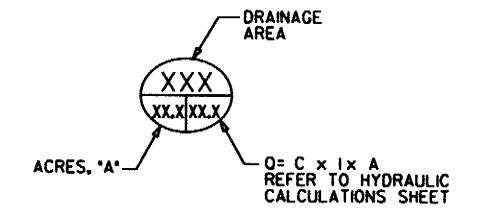

* C3 IS THE TOTAL DRAINAGE AREA ROUTED TO THE EXISTING JUNCTION BOX AT STA 16+43.16, 49.43' LT

C3*
37.95262.0

DRAINAGE BOUNDARY FROM GEORGE HW BUSH ELEMENTARY SCHOOL PLANS DATED 4/8/10

RECORD DOCUMENTS
December, 2011
These Record Documents have been prepared based upon information provided by North Texas Contracting, Inc. The Design Professional has not verified the accuracy and / or completeness of this information and shall not be responsible for any errors or omissions which may be incorporated herein as a result.




Design Consultant: Half Associates, Inc.
RECORD DRAWING SUBMITTAL
[Signature] P.E.
Signature of Registrant Date 12/7/2011

NO.	REVISION	BY	DATE
TOWN OF ADDISON DALLAS COUNTY, TEXAS SPRING VALLEY ROAD DRAINAGE AREA MAP OVERALL			
1201 NORTH BOWSER ROAD, RICHARDSON, TEXAS 75081-2275 TEL (214) 348-8200 FAX (214) 738-0085			
PROJECT	DESIGN	DRAWN	DATE
27530	MPB	TMM	OCTOBER 2010
FILE	SHEET		
27530 DAM 01	DAM-1		

SHEET 31 OF 163 RECORD DRAWINGS


USER: gh1299
 OFFICE: RCH
 PROJECT: 27530
 DATE: 12/7/2011
 TIME: 10:15:45 AM
 FILE: 27530 DAM 02.dgn

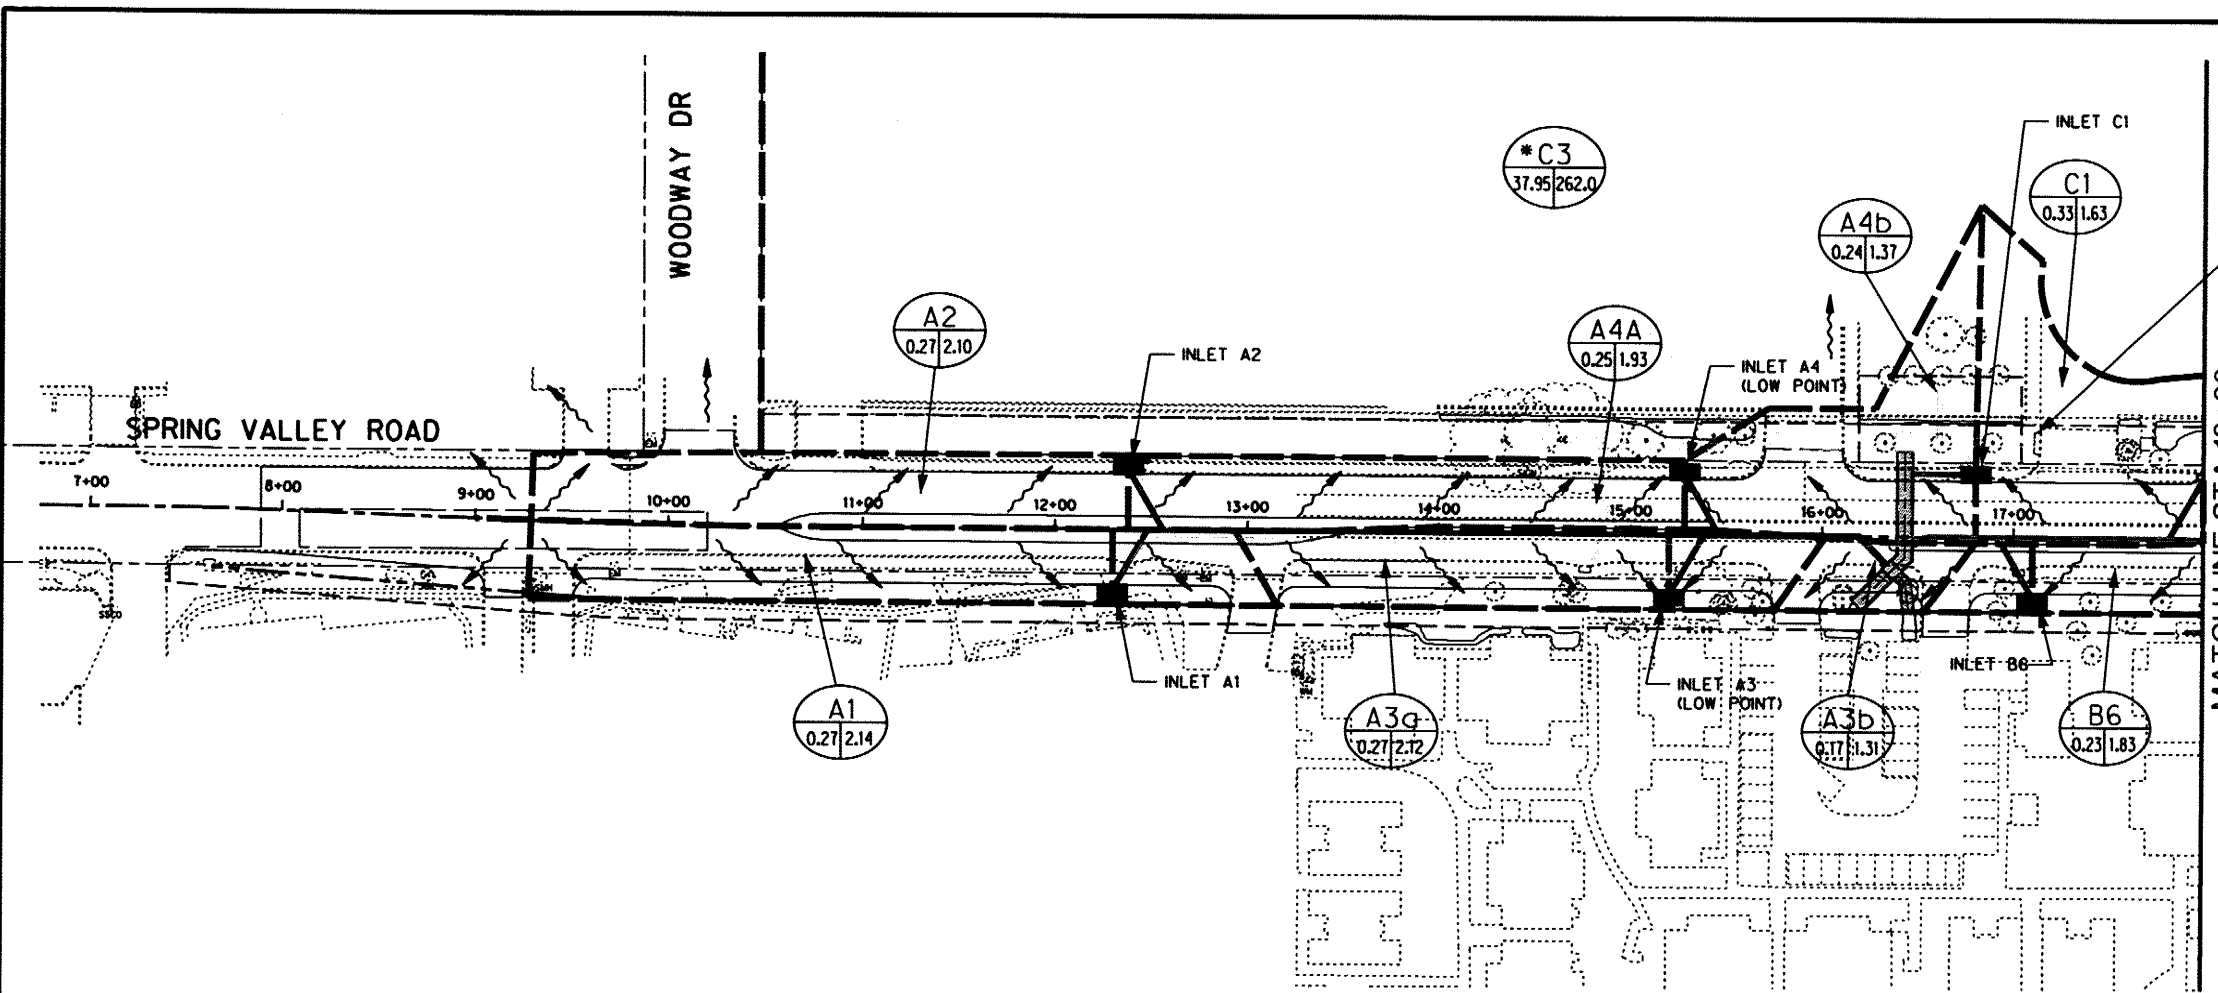

LEGEND

- EXISTING INLET
- PROPOSED INLET
- DRAINAGE DIVIDE LINE
- RIGHT-OF-WAY LINE
- DIRECTION OF FLOW

DRAINAGE AREA
 ACRES, "A"
 $Q = C \times I \times A$
 REFER TO HYDRAULIC CALCULATIONS SHEET

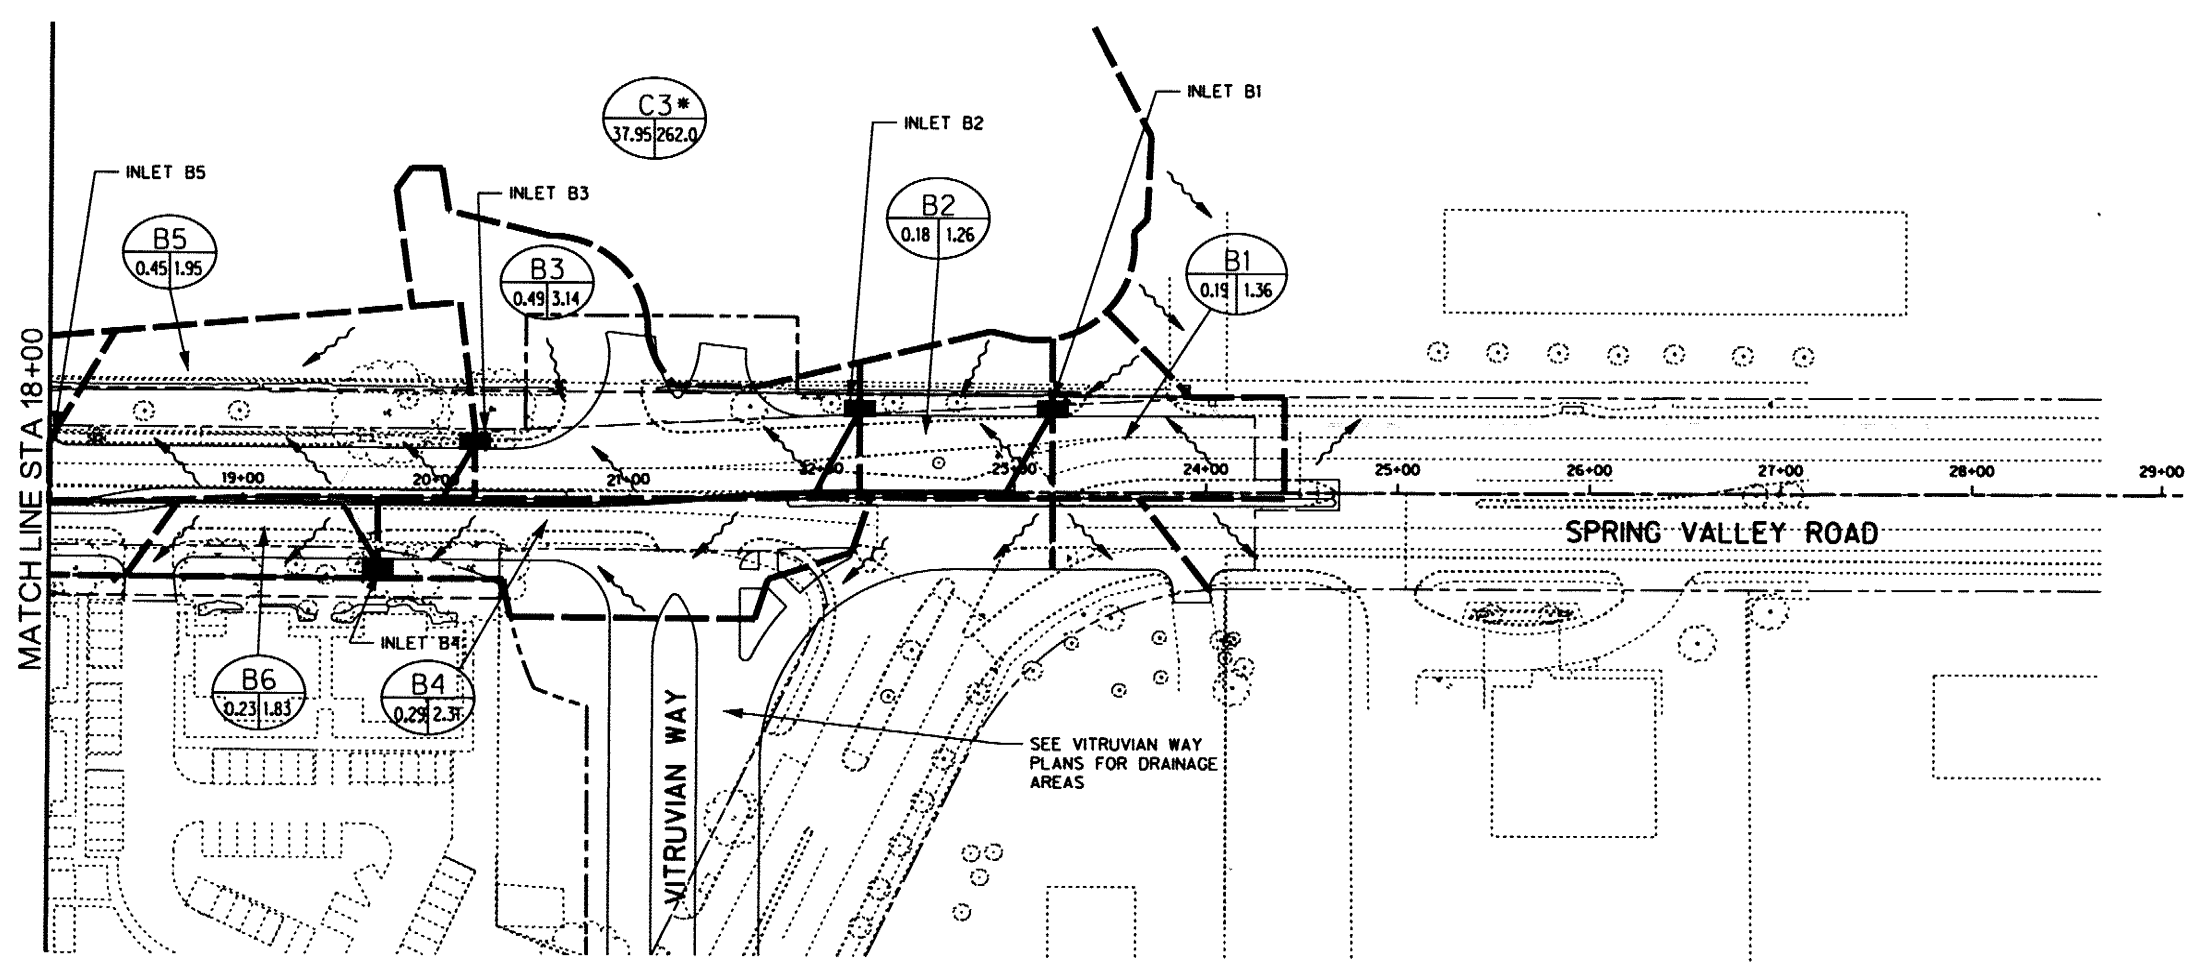

* SEE SHEET DAM-1

RECORD DOCUMENTS
 December, 2011
 These Record Documents have been prepared based upon information provided by North Texas Contracting, Inc. The Design Professional has not verified the accuracy and / or completeness of this information and shall not be responsible for any errors or omissions which may be incorporated herein as a result.
 Design Consultant: Half Associates, Inc.
 RECORD DRAWING SUBMITTAL

Signature of Registrant Date 12/6/2011

NO.	REVISION	BY	DATE		
ADDISON TOWN OF ADDISON DALLAS COUNTY, TEXAS SPRING VALLEY ROAD DRAINAGE AREA MAP					
HALFF 1201 NORTH BOWSER ROAD, RICHARDSON, TEXAS 75081-2275 TEL (214) 346-6200 FAX (214) 738-0095					
PROJECT	DESIGN	DRAWN	DATE	FILE	SHEET
27530	MPB	TMM	OCTOBER 2010	27530 DAM 02	DAM-2

SHEET 32 OF 163
 RECORD DRAWINGS

DATE: 12/7/2011 TIME: 10:15:57 AM FILE: 27530.DAC.01.dgn PROJECT: 27530 OFFICE: RCH USER: gh1299


RUNOFF CALCULATIONS



DRAINAGE AREAS		LANDUSE			C x A	Tc	I ₁₀₀	Q ₁₀₀
ID	AREA (AC)	PAV (AC)	COMM. (AC)	GRASS (AC)				
A1	0.27	0.27	0.00	0.00	0.25	10	8.74	2.14
A2	0.27	0.27	0.00	0.00	0.24	10	8.74	2.10
A3a	0.27	0.27	0.00	0.00	0.24	10	8.74	2.12
A3b	0.17	0.17	0.00	0.00	0.15	10	8.74	1.31
A4a	0.25	0.25	0.00	0.00	0.22	10	8.74	1.93
A4b	0.24	0.14	0.00	0.10	0.16	10	8.74	1.37
B1	0.19	0.16	0.00	0.03	0.16	10	8.74	1.36
B2	0.18	0.15	0.00	0.04	0.14	10	8.74	1.26
B3	0.49	0.36	0.00	0.13	0.36	10	8.74	3.14
B4	0.29	0.29	0.00	0.00	0.26	10	8.74	2.31
B5	0.45	0.19	0.00	0.18	0.22	10	8.74	1.95
B6	0.23	0.23	0.00	0.00	0.21	10	8.74	1.83
C1	0.33	0.15	0.00	0.18	0.19	10	8.74	1.63
C3	37.95	30.99	0.00	6.96	29.98	10	8.74	262.02

INLET CALCULATIONS

INLET NUMBER	A	C	Tc (min)	I ₁₀₀ (in/hr)	SUB-AREA Q100	CARRYOVER FLOW FROM UPSTREAM INLET q	TOTAL FLOW	INLET TYPE	SPRING VALLEY ROAD CENTERLINE STATION AT INLET	STRAIGHT CROWN TYPE CROSS SLOPE	RECIPROCAL OF CROWN SLOPE	Z/n	GUTTER SLOPE AT INLET	FLOW DEPTH %	SPREAD Sp	CAPACITY PER FOOT OF INLET Q/Lo	LENGTH OF INLET REQ'D Lo	INLET LENGTH L	L/Lo	a	a/%	O/O	FLOW INTERCEPTED	CARRYOVER FLOW TO DOWNSTREAM INLET	COMMENTS
	(ACRES)		(MIN)	(IN/HR)	(CFS)	(CFS)	(CFS)		(STA)	(%)	Z		(%)	(FT)	(FT)	(CFS/FT)	(FT)	(FT)		(INCH)		(CFS)	(CFS)		
A1	0.27	0.90	10	8.74	2.14	0.00	2.14	6' Recessed Curb Inlet on Grade	12+30.00	2.00%	50	3/25	2.21%	0.17	8.25	0.47	4.55	6	1.32	4	2.02	100%	2.14	0.00	
A2	0.27	0.90	10	8.74	2.10	0.00	2.10	6' Recessed Curb Inlet on Grade	12+38.00	2.00%	50	3/25	2.47%	0.16	8.02	0.47	4.50	6	1.33	4	2.08	100%	2.10	0.00	
A3	0.44	0.90	10	8.74	3.43	0.00	3.43	10' Recessed Curb Inlet on Sag	15+20.00	2.00%	50	3/25	1.49%	0.21	10.60	0.51	6.69	10	1.49	4	1.57	100%	3.43	0.00	Low Point
A4	0.49	0.78	10	8.74	3.31	0.00	3.31	10' Recessed Curb Inlet on Sag	15+28.00	2.00%	50	3/25	1.49%	0.21	10.45	0.87	3.81	10	2.62	4	1.59	100%	3.31	0.00	Low Point
B1	0.19	0.81	10	8.74	1.36	0.00	1.36	6' Recessed Curb Inlet on Grade	23+20.00	2.00%	50	3/25	0.60%	0.18	8.87	0.48	2.82	6	2.13	3	1.41	100%	1.36	0.00	
B2	0.18	0.78	10	8.74	1.26	0.00	1.26	6' Recessed Curb Inlet on Grade	22+20.00	2.00%	50	3/25	0.60%	0.17	8.63	0.48	2.64	6	2.27	4	1.93	100%	1.26	0.00	
B3	0.49	0.74	10	8.74	3.14	0.00	3.14	8' Recessed Curb Inlet on Grade	20+20.00	2.00%	50	3/25	1.69%	0.20	10.00	0.50	6.24	8	1.28	4	1.67	100%	3.14	0.00	
B4	0.29	0.90	10	8.74	2.31	0.00	2.31	6' Recessed Curb Inlet on Grade	19+70.00	2.00%	50	3/25	1.93%	0.17	8.70	0.82	2.83	6	2.12	4	1.91	100%	2.31	0.00	
B5	0.45	0.50	10	8.74	1.95	0.00	1.95	6' Recessed Curb Inlet on Grade	18+00.00	2.00%	50	3/25	0.77%	0.19	9.71	0.85	2.31	6	2.60	5	2.15	100%	1.95	0.00	
B6	0.23	0.90	10	8.74	1.83	0.00	1.83	6' Recessed Curb Inlet on Grade	17+10.00	2.00%	50	3/25	0.77%	0.19	9.46	0.84	2.18	6	2.76	6	2.64	100%	1.83	0.00	
C1	0.33	0.57	10	8.74	1.63	0.00	1.63	6' Recessed Curb Inlet on Grade	16+80.00	2.00%	50	3/25	0.77%	0.18	9.08	0.49	3.36	6	1.79	4	1.84	100%	1.63	0.00	

RECORD DOCUMENTS
 December, 2011
 These Record Documents have been prepared based upon information provided by North Texas Contracting, Inc. The Design Professional has not verified the accuracy and / or completeness of this information and shall not be responsible for any errors or omissions which may be incorporated herein as a result.
 Design Consultant: Half Associates, Inc.
 RECORD DRAWING SUBMITTAL


 Signature of Registrant: *M.E. Romanowski* P.E. Date: 12/8/2011

NO.	REVISION	BY	DATE
 TOWN OF ADDISON DALLAS COUNTY, TEXAS SPRING VALLEY ROAD HYDRAULIC COMPUTATIONS			
 1201 NORTH BOWSER ROAD, RICHARDSON, TEXAS 75081-2275 TEL (214) 346-8200 FAX (214) 738-0095			
PROJECT	DESIGN	DRAWN	DATE
27530	MPB	TMM	OCTOBER 2010
FILE	SHEET		
27530 DAC 01	DAC-1		

USER: gh1299
 OFFICE: RCH
 PROJECT: 27530
 FILE: 27530_DAC_02.dgn
 TIME: 10:16:11 AM
 DATE: 12/7/2011

LINE A

INLET OR NODE		DISTANCE			US DRAINAGE AREA			RUNOFF COEFF	INCR	TOTAL	US TIME OF CONCENTR.			DESIGN FREQ.	INTENS.	DISCH.	SIZE OF PIPE	PIPE FLOWLINE		PIPE SOFFT		PIPE SLOPE	AREA FULL	VEL. FULL	TIME IN PIPE	FULL PIPE HYD. RADI US	MANN. COEFF.	FULL PIPE FRICT. GRAD. SLOPE	FLOW IN PIPE	HYDRAULIC GRADIENT ELEVATION		FULL PIPE VELOC. HEAD	DS NODE STRUCTURAL LOSS			
					INCR. AREA	AREA	TOT.				"C"	"CA"	"CA"					INLET	PIPE	TOTAL	US									DS	US		DS	S _{PIPE}	A _{PIPE}	V _{PIPE}
US	DS	FEET	STA	STA	ID#	AC.	AC.				MIN	MIN	MIN	YEARS	IN/HR	CFS	IN.	US	DS	US	DS	FT./FT.	SF	FPS	MIN	FT	FT/FT		US	DS	FT.	CON.	FT.			
	1			13+91.10																																
1	2	8.00	13+91.10	13+83.10	A1	0.28	0.28	0.90	0.25	0.25	10	0.00	10.00	100	8.74	2.20	18	576.38	576.05	577.68	577.55	0.0162	1.767	1.25	0.11	0.375	0.013	0.00044	PARTIAL	577.49	577.48	0.02	0.35	0.08		
2	3	282.00	13+83.10	11+01.10	A2	0.27	0.55	0.90	0.24	0.50		0.11	10.11	100	8.72	4.32	18	576.05	571.76	577.55	573.26	0.0152	1.767	2.45	1.92	0.375	0.013	0.00189	FULL	577.40	576.92	0.09	0.35	0.06		
3	4	8.00	11+01.10	10+93.10	A3	0.43	0.98	0.90	0.39	0.88		1.92	12.03	100	8.72	7.69	24	571.76	571.70	573.76	573.70	0.0075	3.142	2.45	0.05	0.500	0.013	0.00188	FULL	576.86	576.85	0.09	0.35	0.06		
4	5	93.10	10+93.10	10+00.00	A4	0.49	1.47	0.90	0.44	1.32		0.05	12.08	100	8.72	11.54	24	571.70	570.96	573.70	572.96	0.0079	3.142	3.68	0.42	0.500	0.013	0.0026	FULL	576.67	576.43	0.21				

LAT A1

INLET OR NODE		DISTANCE			US DRAINAGE AREA			RUNOFF COEFF	INCR	TOTAL	US TIME OF CONCENTR.			DESIGN FREQ.	INTENS.	DISCH.	SIZE OF PIPE	PIPE FLOWLINE		PIPE SOFFT		PIPE SLOPE	AREA FULL	VEL. FULL	TIME IN PIPE	FULL PIPE HYD. RADI US	MANN. COEFF.	FULL PIPE FRICT. GRAD. SLOPE	FLOW IN PIPE	HYDRAULIC GRADIENT ELEVATION		FULL PIPE VELOC. HEAD	DS NODE STRUCTURAL LOSS			
					INCR. AREA	AREA	TOT.				"C"	"CA"	"CA"					INLET	PIPE	TOTAL	US									DS	US		DS	S _{PIPE}	A _{PIPE}	V _{PIPE}
US	DS	FEET	STA	STA	ID#	AC.	AC.				MIN	MIN	MIN	YEARS	IN/HR	CFS	IN.	US	DS	US	DS	FT./FT.	SF	FPS	MIN	FT	FT/FT		US	DS	FT.	CON.	FT.			
	1			0+36.37																																
1	2	36.37	0+36.37	0+00.00	A1	0.27	0.27	0.90	0.25	0.25	10	0.00	10.00	100	8.74	2.14	18	578.97	576.98	580.47	577.68	0.0767	1.767	1.22	0.50	0.375	0.013	0.00042	PARTIAL	577.25	577.23	0.02				

LAT A2

INLET OR NODE		DISTANCE			US DRAINAGE AREA			RUNOFF COEFF	INCR	TOTAL	US TIME OF CONCENTR.			DESIGN FREQ.	INTENS.	DISCH.	SIZE OF PIPE	PIPE FLOWLINE		PIPE SOFFT		PIPE SLOPE	AREA FULL	VEL. FULL	TIME IN PIPE	FULL PIPE HYD. RADI US	MANN. COEFF.	FULL PIPE FRICT. GRAD. SLOPE	FLOW IN PIPE	HYDRAULIC GRADIENT ELEVATION		FULL PIPE VELOC. HEAD	DS NODE STRUCTURAL LOSS			
					INCR. AREA	AREA	TOT.				"C"	"CA"	"CA"					INLET	PIPE	TOTAL	US									DS	US		DS	S _{PIPE}	A _{PIPE}	V _{PIPE}
US	DS	FEET	STA	STA	ID#	AC.	AC.				MIN	MIN	MIN	YEARS	IN/HR	CFS	IN.	US	DS	US	DS	FT./FT.	SF	FPS	MIN	FT	FT/FT		US	DS	FT.	CON.	FT.			
	1			0+36.37																																
1	2	36.37	0+36.37	0+00.00	A2	0.27	0.27	0.90	0.24	0.24	10	0.00	10.00	100	8.74	2.10	18	578.79	576.05	580.29	577.55	0.0753	1.767	1.19	0.51	0.375	0.013	0.00040	PARTIAL	577.16	577.15	0.02				



LAT A3

INLET OR NODE		DISTANCE			US DRAINAGE AREA			RUNOFF COEFF	INCR	TOTAL	US TIME OF CONCENTR.			DESIGN FREQ.	INTENS.	DISCH.	SIZE OF PIPE	PIPE FLOWLINE		PIPE SOFFT		PIPE SLOPE	AREA FULL	VEL. FULL	TIME IN PIPE	FULL PIPE HYD. RADI US	MANN. COEFF.	FULL PIPE FRICT. GRAD. SLOPE	FLOW IN PIPE	HYDRAULIC GRADIENT ELEVATION		FULL PIPE VELOC. HEAD	DS NODE STRUCTURAL LOSS			
					INCR. AREA	AREA	TOT.				"C"	"CA"	"CA"					INLET	PIPE	TOTAL	US									DS	US		DS	S _{PIPE}	A _{PIPE}	V _{PIPE}
US	DS	FEET	STA	STA	ID#	AC.	AC.				MIN	MIN	MIN	YEARS	IN/HR	CFS	IN.	US	DS	US	DS	FT./FT.	SF	FPS	MIN	FT	FT/FT		US	DS	FT.	CON.	FT.			
	1			0+36.37																																
1	2	36.37	0+36.37	0+00.00	A3	0.44	0.44	0.90	0.39	0.39	10	0.00	10.00	100	8.74	3.43	18	573.29	572.01	574.79	573.51	0.0352	1.767	1.95	0.31	0.375	0.013	0.00107	FULL	576.65	576.61	0.06				



LAT A4

INLET OR NODE		DISTANCE			US DRAINAGE AREA			RUNOFF COEFF	INCR	TOTAL	US TIME OF CONCENTR.			DESIGN FREQ.	INTENS.	DISCH.	SIZE OF PIPE	PIPE FLOWLINE		PIPE SOFFT		PIPE SLOPE	AREA FULL	VEL. FULL	TIME IN PIPE	FULL PIPE HYD. RADI US	MANN. COEFF.	FULL PIPE FRICT. GRAD. SLOPE	FLOW IN PIPE	HYDRAULIC GRADIENT ELEVATION		FULL PIPE VELOC. HEAD	DS NODE STRUCTURAL LOSS			
					INCR. AREA	AREA	TOT.				"C"	"CA"	"CA"					INLET	PIPE	TOTAL	US									DS	US		DS	S _{PIPE}	A _{PIPE}	V _{PIPE}
US	DS	FEET	STA	STA	ID#	AC.	AC.				MIN	MIN	MIN	YEARS	IN/HR	CFS	IN.	US	DS	US	DS	FT./FT.	SF	FPS	MIN	FT	FT/FT		US	DS	FT.	CON.	FT.			
	1			0+36.37																																
1	2	36.37	0+36.37	0+00.00	A4	0.49	0.49	0.78	0.38	0.38	10		10.00	100	8.74	3.31	18	573.29	571.95	574.79	573.45	0.0368	1.767	1.88	0.32	0.375	0.013	0.00099	FULL	576.57	576.54	0.05				

RECORD DOCUMENTS
 December, 2011
 These Record Documents have been prepared based upon information provided by North Texas Contracting, Inc. The Design Professional has not verified the accuracy and / or completeness of this information and shall not be responsible for any errors or omissions which may be incorporated herein as a result.
 Design Consultant: Helff Associates, Inc.
 RECORD DRAWING SUBMITTAL



 Signature of Registrant Date

SHEET 34 OF 163 RECORD DRAWINGS

NO.	REVISION	BY	DATE
 TOWN OF ADDISON DALLAS COUNTY, TEXAS SPRING VALLEY ROAD HYDRAULIC COMPUTATIONS			
 HALFF 1201 NORTH BOWSER ROAD, RICHARDSON, TEXAS 75081-2275 TEL (214) 346-8200 FAX (214) 738-0095			
PROJECT	DESIGN	DRAWN	DATE
27530	MPB	TMM	OCTOBER 2010
FILE	SHEET		
27530 DAC 02	DAC-2		

LINE B

Table with columns: INLET OR NODE, DISTANCE, US DRAINAGE AREA, RUNOFF COEFF, INCR, TOTAL, US TIME OF CONCENTR., DESIGN FREQ., INTENS., DISCH., SIZE OF PIPE, PIPE FLOWLINE, PIPE SOFFIT, PIPE SLOPE, AREA FULL, VEL. FULL, TIME IN PIPE, FULL PIPE HYD. RADII, MANN. COEFF., FULL PIPE FRICT. GRAD. SLOPE, FLOW IN PIPE, HYDRAULIC GRADIENT ELEVATION, FULL PIPE VELOC. HEAD, DS NODE STRUCTURAL LOSS.

LAT B1

Table with columns: INLET OR NODE, DISTANCE, US DRAINAGE AREA, RUNOFF COEFF, INCR, TOTAL, US TIME OF CONCENTR., DESIGN FREQ., INTENS., DISCH., SIZE OF PIPE, PIPE FLOWLINE, PIPE SOFFIT, PIPE SLOPE, AREA FULL, VEL. FULL, TIME IN PIPE, FULL PIPE HYD. RADII, MANN. COEFF., FULL PIPE FRICT. GRAD. SLOPE, FLOW IN PIPE, HYDRAULIC GRADIENT ELEVATION, FULL PIPE VELOC. HEAD, DS NODE STRUCTURAL LOSS.

LAT B2

Table with columns: INLET OR NODE, DISTANCE, US DRAINAGE AREA, RUNOFF COEFF, INCR, TOTAL, US TIME OF CONCENTR., DESIGN FREQ., INTENS., DISCH., SIZE OF PIPE, PIPE FLOWLINE, PIPE SOFFIT, PIPE SLOPE, AREA FULL, VEL. FULL, TIME IN PIPE, FULL PIPE HYD. RADII, MANN. COEFF., FULL PIPE FRICT. GRAD. SLOPE, FLOW IN PIPE, HYDRAULIC GRADIENT ELEVATION, FULL PIPE VELOC. HEAD, DS NODE STRUCTURAL LOSS.

LAT B3

Table with columns: INLET OR NODE, DISTANCE, US DRAINAGE AREA, RUNOFF COEFF, INCR, TOTAL, US TIME OF CONCENTR., DESIGN FREQ., INTENS., DISCH., SIZE OF PIPE, PIPE FLOWLINE, PIPE SOFFIT, PIPE SLOPE, AREA FULL, VEL. FULL, TIME IN PIPE, FULL PIPE HYD. RADII, MANN. COEFF., FULL PIPE FRICT. GRAD. SLOPE, FLOW IN PIPE, HYDRAULIC GRADIENT ELEVATION, FULL PIPE VELOC. HEAD, DS NODE STRUCTURAL LOSS.

LAT B4

Table with columns: INLET OR NODE, DISTANCE, US DRAINAGE AREA, RUNOFF COEFF, INCR, TOTAL, US TIME OF CONCENTR., DESIGN FREQ., INTENS., DISCH., SIZE OF PIPE, PIPE FLOWLINE, PIPE SOFFIT, PIPE SLOPE, AREA FULL, VEL. FULL, TIME IN PIPE, FULL PIPE HYD. RADII, MANN. COEFF., FULL PIPE FRICT. GRAD. SLOPE, FLOW IN PIPE, HYDRAULIC GRADIENT ELEVATION, FULL PIPE VELOC. HEAD, DS NODE STRUCTURAL LOSS.

RECORD DOCUMENTS
December, 2011
These Record Documents have been prepared based upon information provided by North Texas Contracting, Inc.

Design Consultant: Half Associates, Inc.
RECORD DRAWING SUBMITTAL

Signature of Registrant
Date 12/8/11
Professional Engineer Seal

Revision table and project information: TOWN OF ADDISON, DALLAS COUNTY, TEXAS, SPRING VALLEY ROAD, HYDRAULIC COMPUTATIONS, HALFF, 1201 NORTH BOWBER ROAD, RICHARDSON, TEXAS 75081-2275.

USER: gh1299
 OFFICE: RCH
 PROJECT: 27530
 FILE: 27530 DAC 04.dgn
 DATE: 12/7/2011
 TIME: 10:16:40 AM

LAT B5

INLET OR NODE	DISTANCE			US DRAINAGE AREA			RUNOFF COEFF	INCR	TOTAL	US TIME OF CONCENTR.			DESIGN FREQ.	INTENS.	DISCH.	SIZE OF PIPE		PIPE FLOWLINE		PIPE SOFFIT		PIPE SLOPE	AREA FULL		VEL. FULL	TIME IN PIPE	FULL PIPE HYD. RAD. US	MANN. COEFF.	FULL PIPE FRICT. GRAD. SLOPE	FLOW IN PIPE	HYDRAULIC GRADIENT ELEVATION		FULL PIPE VELOC. HEAD	DS NODE STRUCTURAL LOSS	
	L	US	DS	DA	AREA	AREA				"C"	"CA"	"CA"				INLET	PIPE	TOTAL	"100"	"Q100"	US		DS	US							DS	S _{PIPE}		A _{FULL}	V _{FULL}
1	2	36.37	0+36.37	0+00.00	B5	0.45	0.45	0.50	0.22	0.22	10	0.00	10.00	100	8.74	1.95	18	575.31	572.76	576.81	574.26	0.0703	1.767	1.11	0.55	0.375	0.013	0.00035	FULL	577.35	577.34	0.02			

LAT B6

INLET OR NODE	DISTANCE			US DRAINAGE AREA			RUNOFF COEFF	INCR	TOTAL	US TIME OF CONCENTR.			DESIGN FREQ.	INTENS.	DISCH.	SIZE OF PIPE		PIPE FLOWLINE		PIPE SOFFIT		PIPE SLOPE	AREA FULL		VEL. FULL	TIME IN PIPE	FULL PIPE HYD. RAD. US	MANN. COEFF.	FULL PIPE FRICT. GRAD. SLOPE	FLOW IN PIPE	HYDRAULIC GRADIENT ELEVATION		FULL PIPE VELOC. HEAD	DS NODE STRUCTURAL LOSS	
	L	US	DS	DA	AREA	AREA				"C"	"CA"	"CA"				INLET	PIPE	TOTAL	"100"	"Q100"	US		DS	US							DS	S _{PIPE}		A _{FULL}	V _{FULL}
1	2	36.37	0+36.37	0+00.00	B6	0.23	0.23	0.90	0.21	0.21	10	0.00	10.00	100	8.74	1.83	18	574.82	571.55	576.12	573.05	0.0842	1.767	1.04	0.59	0.375	0.013	0.00030	FULL	576.85	576.84	0.02			

LINE C


INLET OR NODE	DISTANCE			US DRAINAGE AREA			RUNOFF COEFF	INCR	TOTAL	US TIME OF CONCENTR.			DESIGN FREQ.	INTENS.	DISCH.	SIZE OF PIPE/BOX		PIPE FLOWLINE		PIPE SOFFIT		PIPE SLOPE	AREA FULL		VEL. FULL	TIME IN PIPE	FULL PIPE HYD. RAD. US	MANN. COEFF.	FULL PIPE FRICT. GRAD. SLOPE	FLOW IN PIPE	HYDRAULIC GRADIENT ELEVATION		FULL PIPE VELOC. HEAD	DS NODE STRUCTURAL LOSS	
	L	US	DS	DA	AREA	AREA				"C"	"CA"	"CA"				INLET	PIPE	TOTAL	"100"	"Q100"	SPAN		HEIGHT	US							DS	US		DS	S _{PIPE}
1	2	44.44	10+83.05	10+38.61	C1, C2 & C3	38.28	38.28	0.79	30.17	30.17	10	0.00	10.00	100	8.74	283.67	84	48	571.87	570.96	575.87	574.96	0.0205	28.000	9.44	0.08	1.273	0.013	0.00492	FULL	577.35	577.13	1.38	0.35	0.70
2	3	22.84	10+38.61	10+15.77	A & B	3.30	41.58	0.81	2.88	32.84	5.77	0.08	15.85	100	7.42	243.71	84	48	570.96	570.49	574.96	574.49	0.0208	28.000	8.73	0.04	1.273	0.013	0.00420	FULL	576.43	576.33	1.18	0.10	1.10
3	4	15.77	10+15.77	10+00.00		41.58				32.84	0.04	15.89	100	7.52	248.99	84	48	570.49	570.17	574.49	574.17	0.0203	28.000	8.84	0.03	1.273	0.013	0.00432	FULL	575.24	575.17	1.21			



LAT C1

INLET OR NODE	DISTANCE			US DRAINAGE AREA			RUNOFF COEFF	INCR	TOTAL	US TIME OF CONCENTR.			DESIGN FREQ.	INTENS.	DISCH.	SIZE OF PIPE		PIPE FLOWLINE		PIPE SOFFIT		PIPE SLOPE	AREA FULL		VEL. FULL	TIME IN PIPE	FULL PIPE HYD. RAD. US	MANN. COEFF.	FULL PIPE FRICT. GRAD. SLOPE	FLOW IN PIPE	HYDRAULIC GRADIENT ELEVATION		FULL PIPE VELOC. HEAD	DS NODE STRUCTURAL LOSS	
	L	US	DS	DA	AREA	AREA				"C"	"CA"	"CA"				INLET	PIPE	TOTAL	"100"	"Q100"	US		DS	US							DS	S _{PIPE}		A _{FULL}	V _{FULL}
1	2	30.30	0+30.30	0+00.00	C1	0.33	0.33	0.57	0.19	0.19	10	0.00	10.00	100	8.74	1.83	18	574.39	572.92	575.89	574.42	0.0484	1.767	0.93	0.54	0.375	0.013	0.00024	FULL	577.35	577.35	0.01			



RECORD DOCUMENTS
 December, 2011
 These Record Documents have been prepared based upon information provided by North Texas Contracting, Inc. The Design Professional has not verified the accuracy and / or completeness of this information and shall not be responsible for any errors or omissions which may be incorporated herein as a result

Design Consultant: Half Associates, Inc.
 RECORD DRAWING SUBMITTAL


 Signature of Registrant: *M.E. Romanowski* Date: 12/5/2011


NO.	REVISION	BY	DATE
 TOWN OF ADDISON DALLAS COUNTY, TEXAS SPRING VALLEY ROAD HYDRAULIC COMPUTATIONS			
 1201 NORTH BOWSER ROAD, RICHARDSON, TEXAS 75081-2275 TEL (214) 348-4200 FAX (214) 730-0095			
PROJECT	DESIGN	DRAWN	DATE
27530	MPB	TMM	OCTOBER 2010
FILE	SHEET		
27530 DAC 04	DAC-4		

USER: oh1293
 OFFICE: RCH
 PROJECT: 27530
 FILE: 27530 STM 01.dgn
 TIME: 10:17:04 AM
 DATE: 12/7/2011

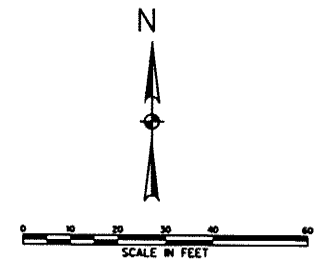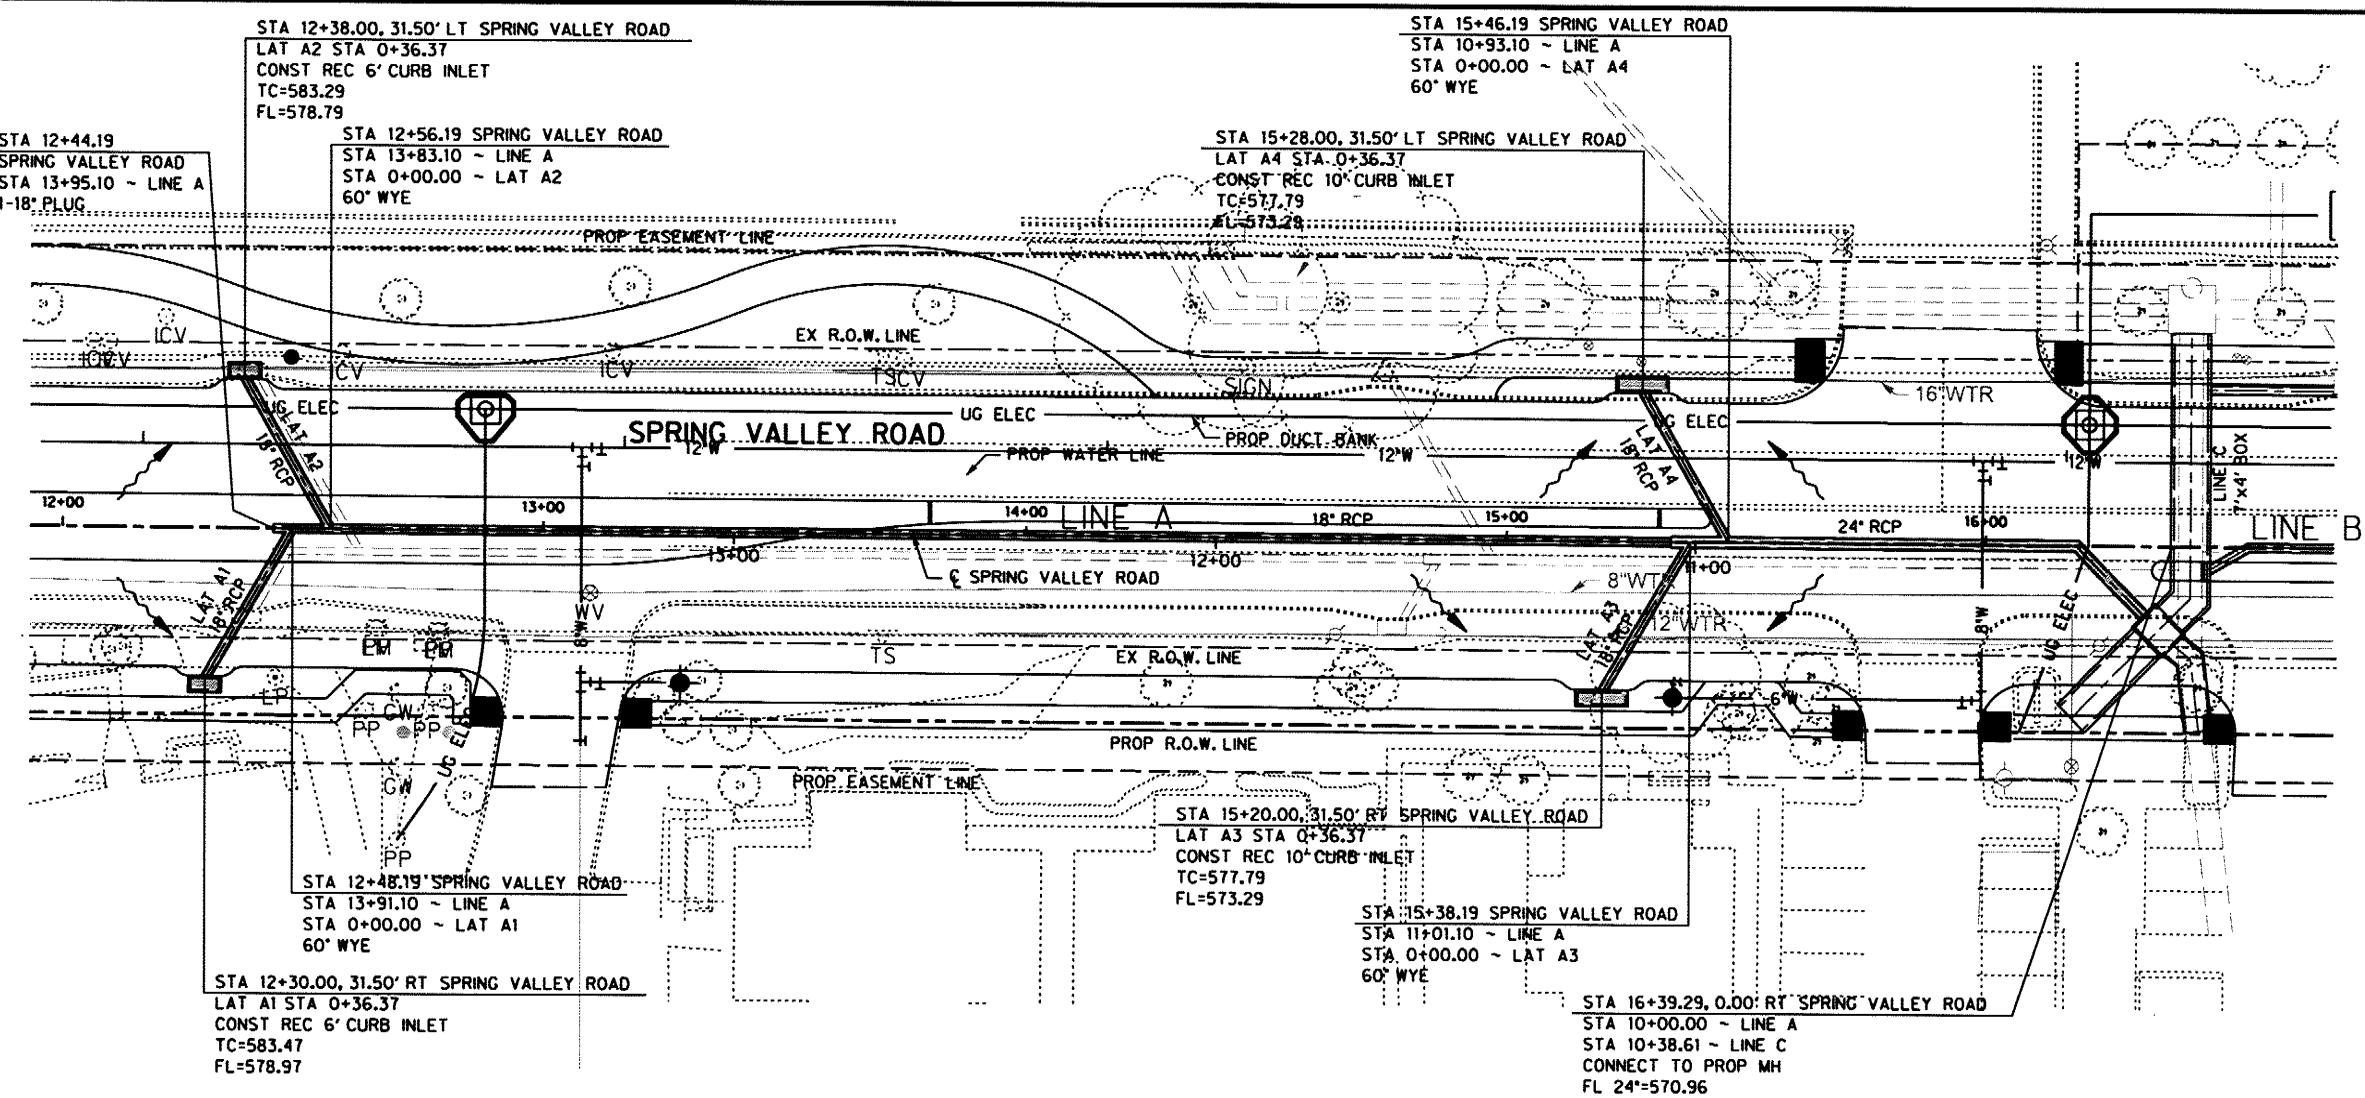

RECORD DOCUMENTS
 December, 2011
 These Record Documents have been prepared based upon information provided by North Texas Contracting, Inc. The Design Professional has not verified the accuracy and / or completeness of this information and shall not be responsible for any errors or omissions which may be incorporated herein as a result.
 Design Consultant: Half Associates, Inc.
 RECORD DRAWING SUBMITTAL

SHEET 37 OF 163


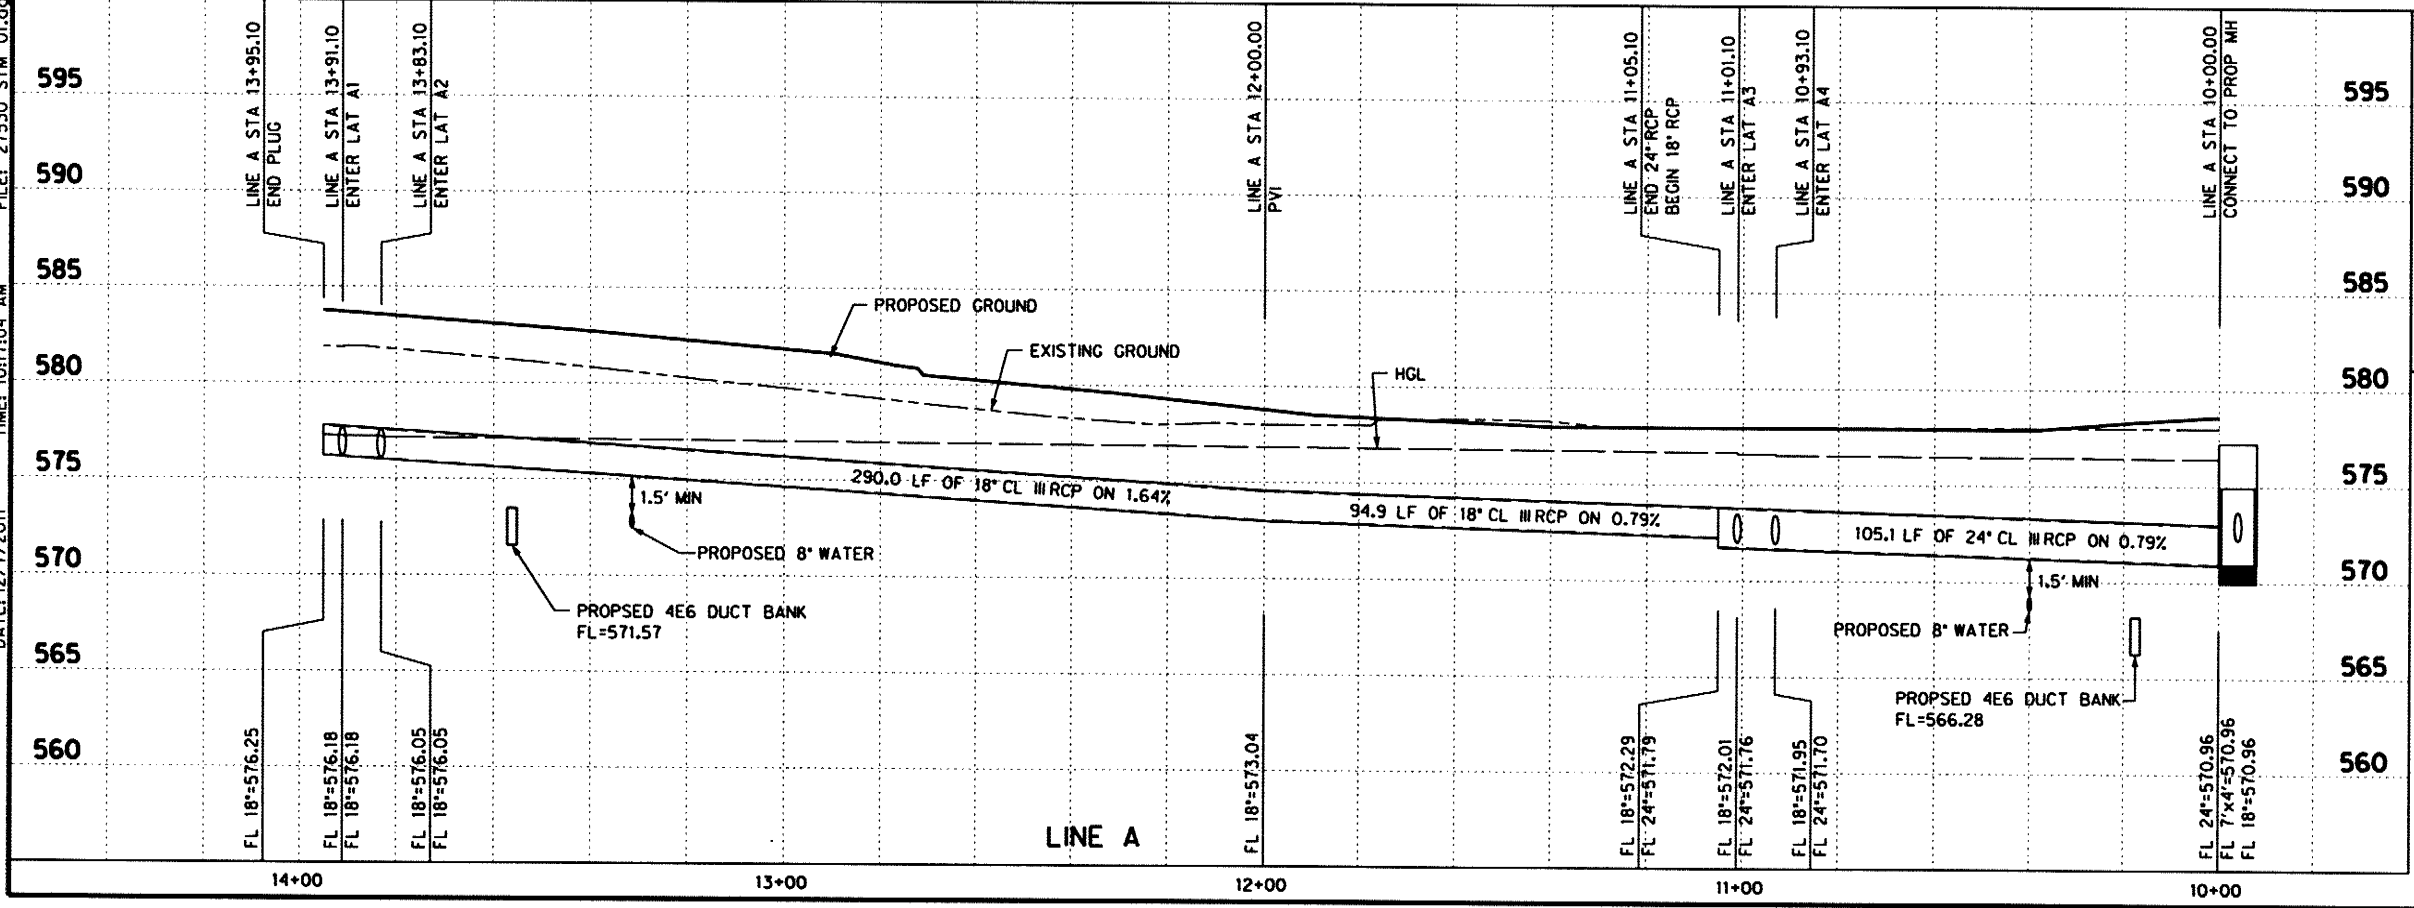


[Signature]
 Signature of Registrant
 12/8/2011
 Date
 P.E.

NO.	REVISION	BY	DATE
TOWN OF ADDISON DALLAS COUNTY, TEXAS SPRING VALLEY ROAD			
STORM DRAIN PLAN & PROFILE LINE A STA 10+00 TO 13+90.00			
HALFF <small>1201 NORTH BOWSER ROAD, RICHARDSON, TEXAS 75081-2275 TEL (214) 346-4200 FAX (214) 738-0095</small>			
PROJECT	DESIGN	DRAWN	DATE
27530	MPB	TMM	OCTOBER 2010
FILE	SHEET		
27530 STM 01	STM-1		


RECORD DRAWINGS

DATE: 12/7/2011 TIME: 10:17:24 AM FILE: 27530 STM 02.dgn PROJECT: 27530 OFFICE: RCH USER: gh1299

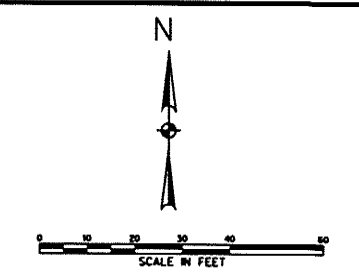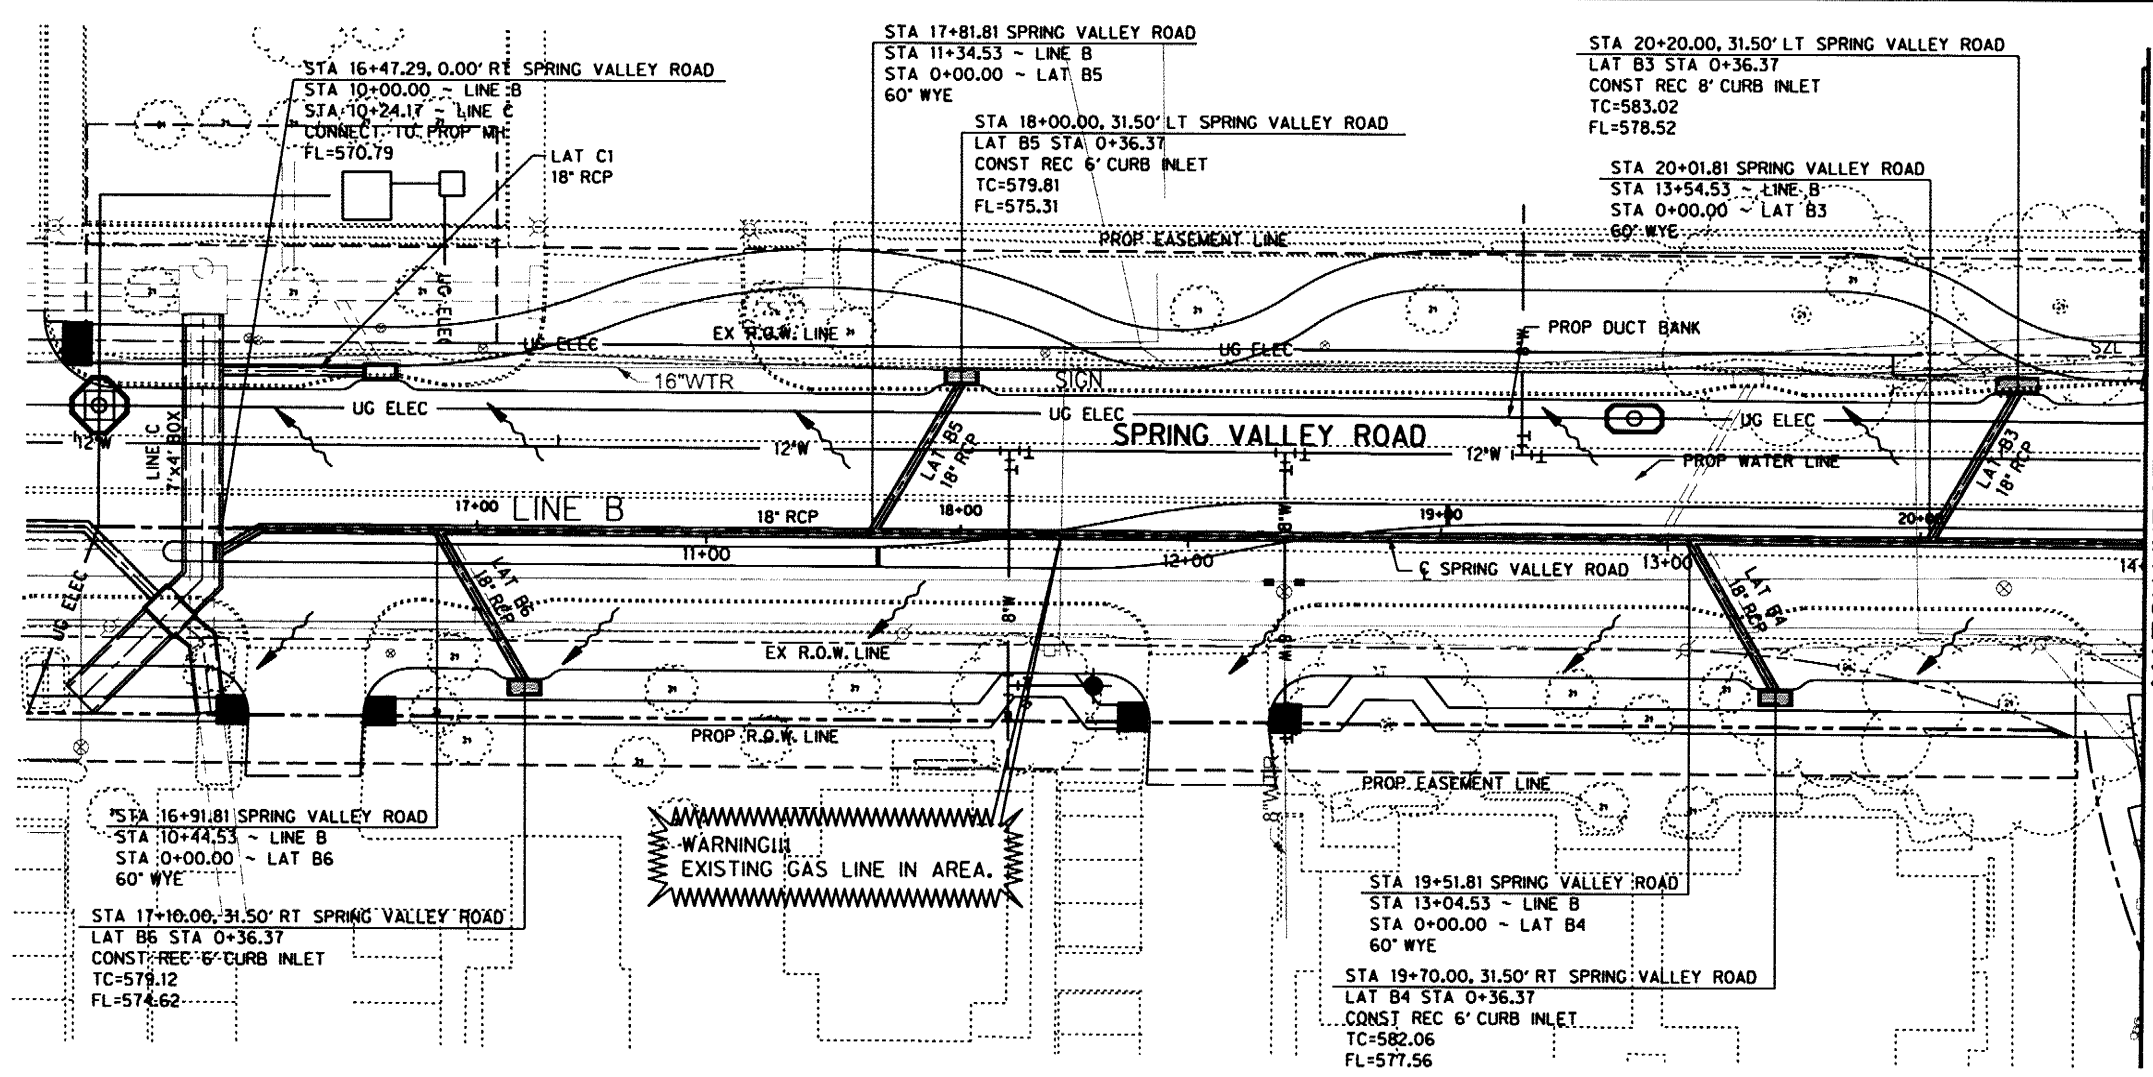

* CONTRACTOR TO FIELD VERIFY GAS LINE LOCATION AND COORDINATE WITH ATMOS TO RESOLVE CONFLICTS.

RECORD DOCUMENTS
 December, 2011
 These Record Documents have been prepared based upon information provided by North Texas Contracting, Inc. The Design Professional has not verified the accuracy and / or completeness of this information and shall not be responsible for any errors or omissions which may be incorporated herein as a result.
 Design Consultant: Half Associates, Inc.
 RECORD DRAWING SUBMITTAL

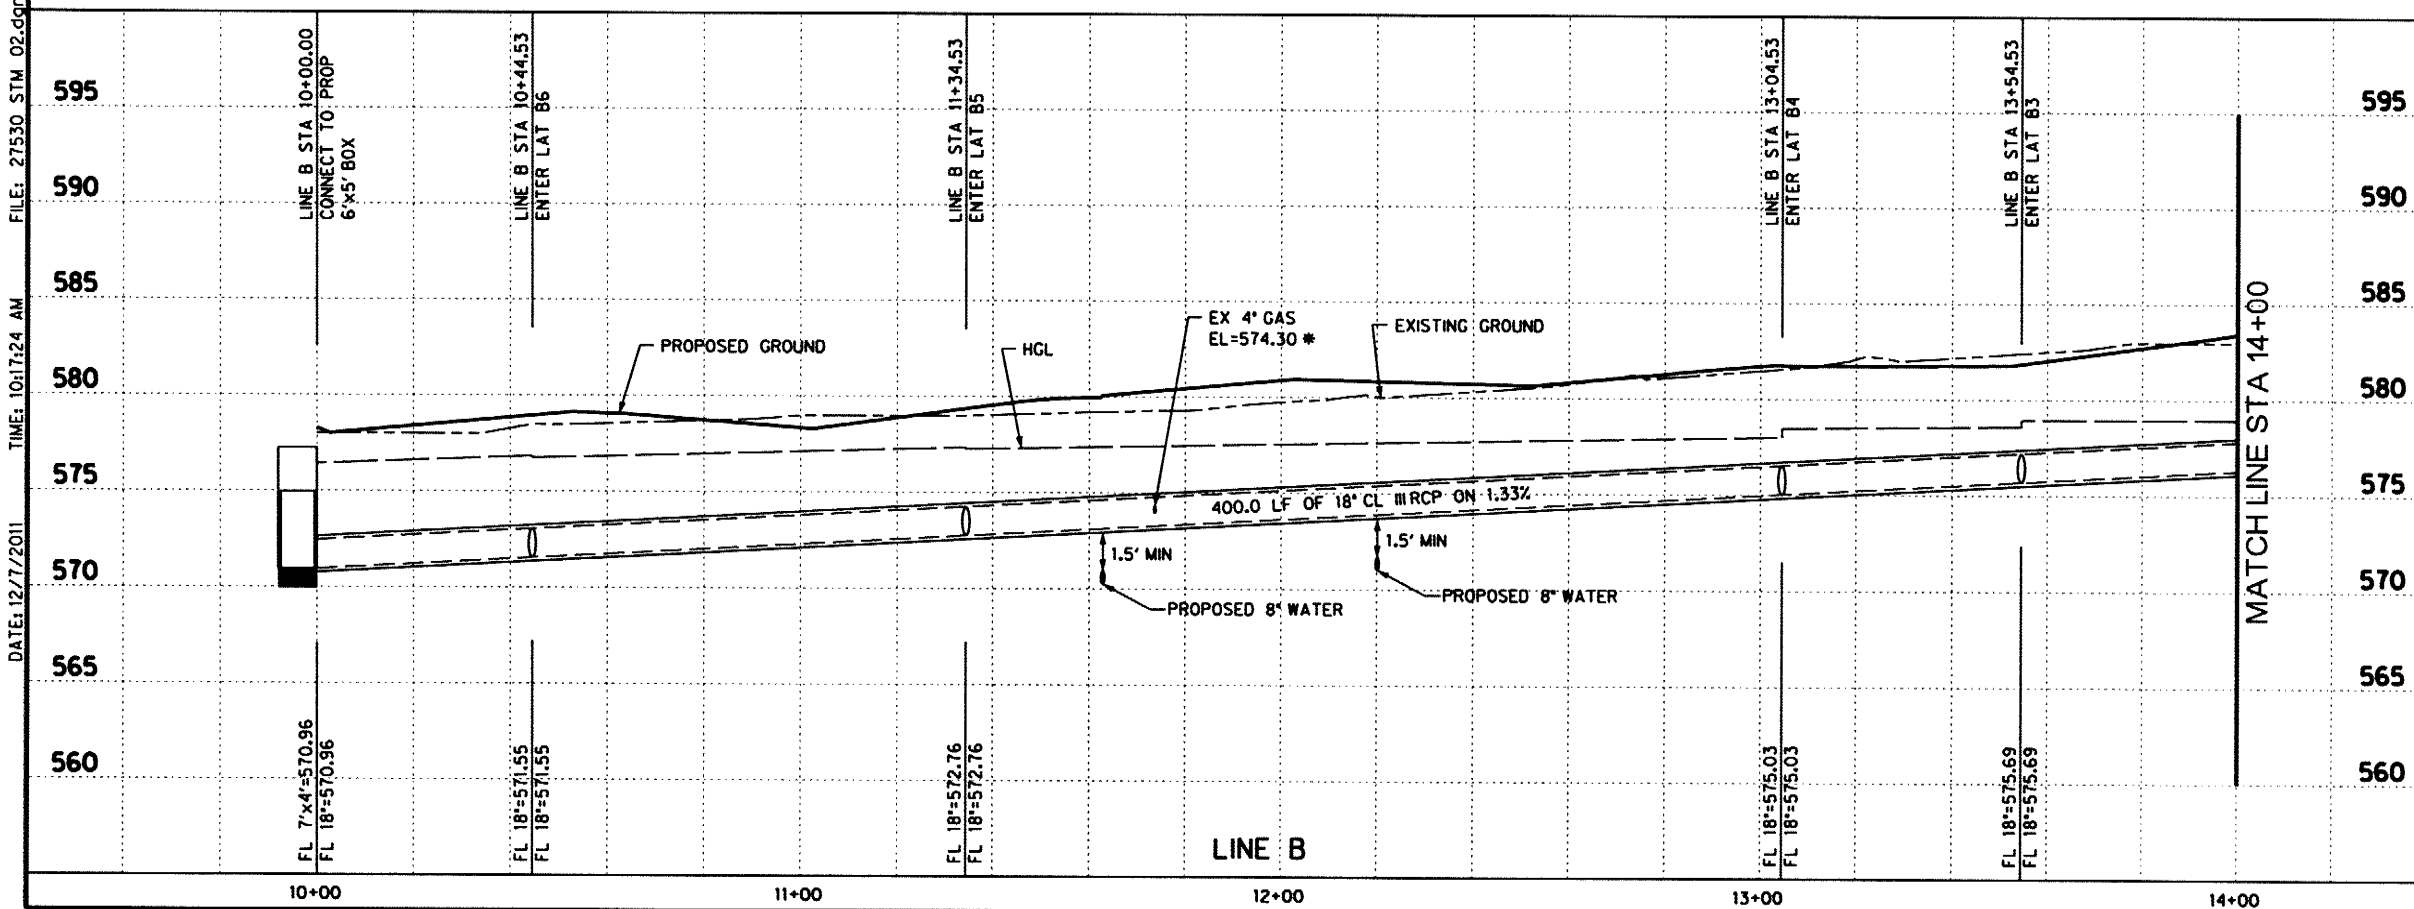

Signature of Registrant: *[Signature]* Date: 12/8/2011
 P.E.

NO.	REVISION	BY	DATE

Addison TOWN OF ADDISON
 DALLAS COUNTY, TEXAS

SPRING VALLEY ROAD


STORM DRAIN PLAN & PROFILE
 LINE B STA 10+00 TO 14+00

HALFF 1201 NORTH BOWSER ROAD, RICHARDSON, TEXAS 75081-2275
 TEL (214) 348-8200 FAX (214) 730-0095


PROJECT	DESIGN	DRAWN	DATE	FILE	SHEET
27530	MPB	TMM	OCTOBER 2010	27530 STM 02	STM-2

SHEET 38 OF 163 RECORD DRAWINGS

DATE: 12/7/2011 TIME: 10:17:45 AM FILE: 27530_STM_03.dgn PROJECT: 27530 OFFICE: RCH USER: oh1299

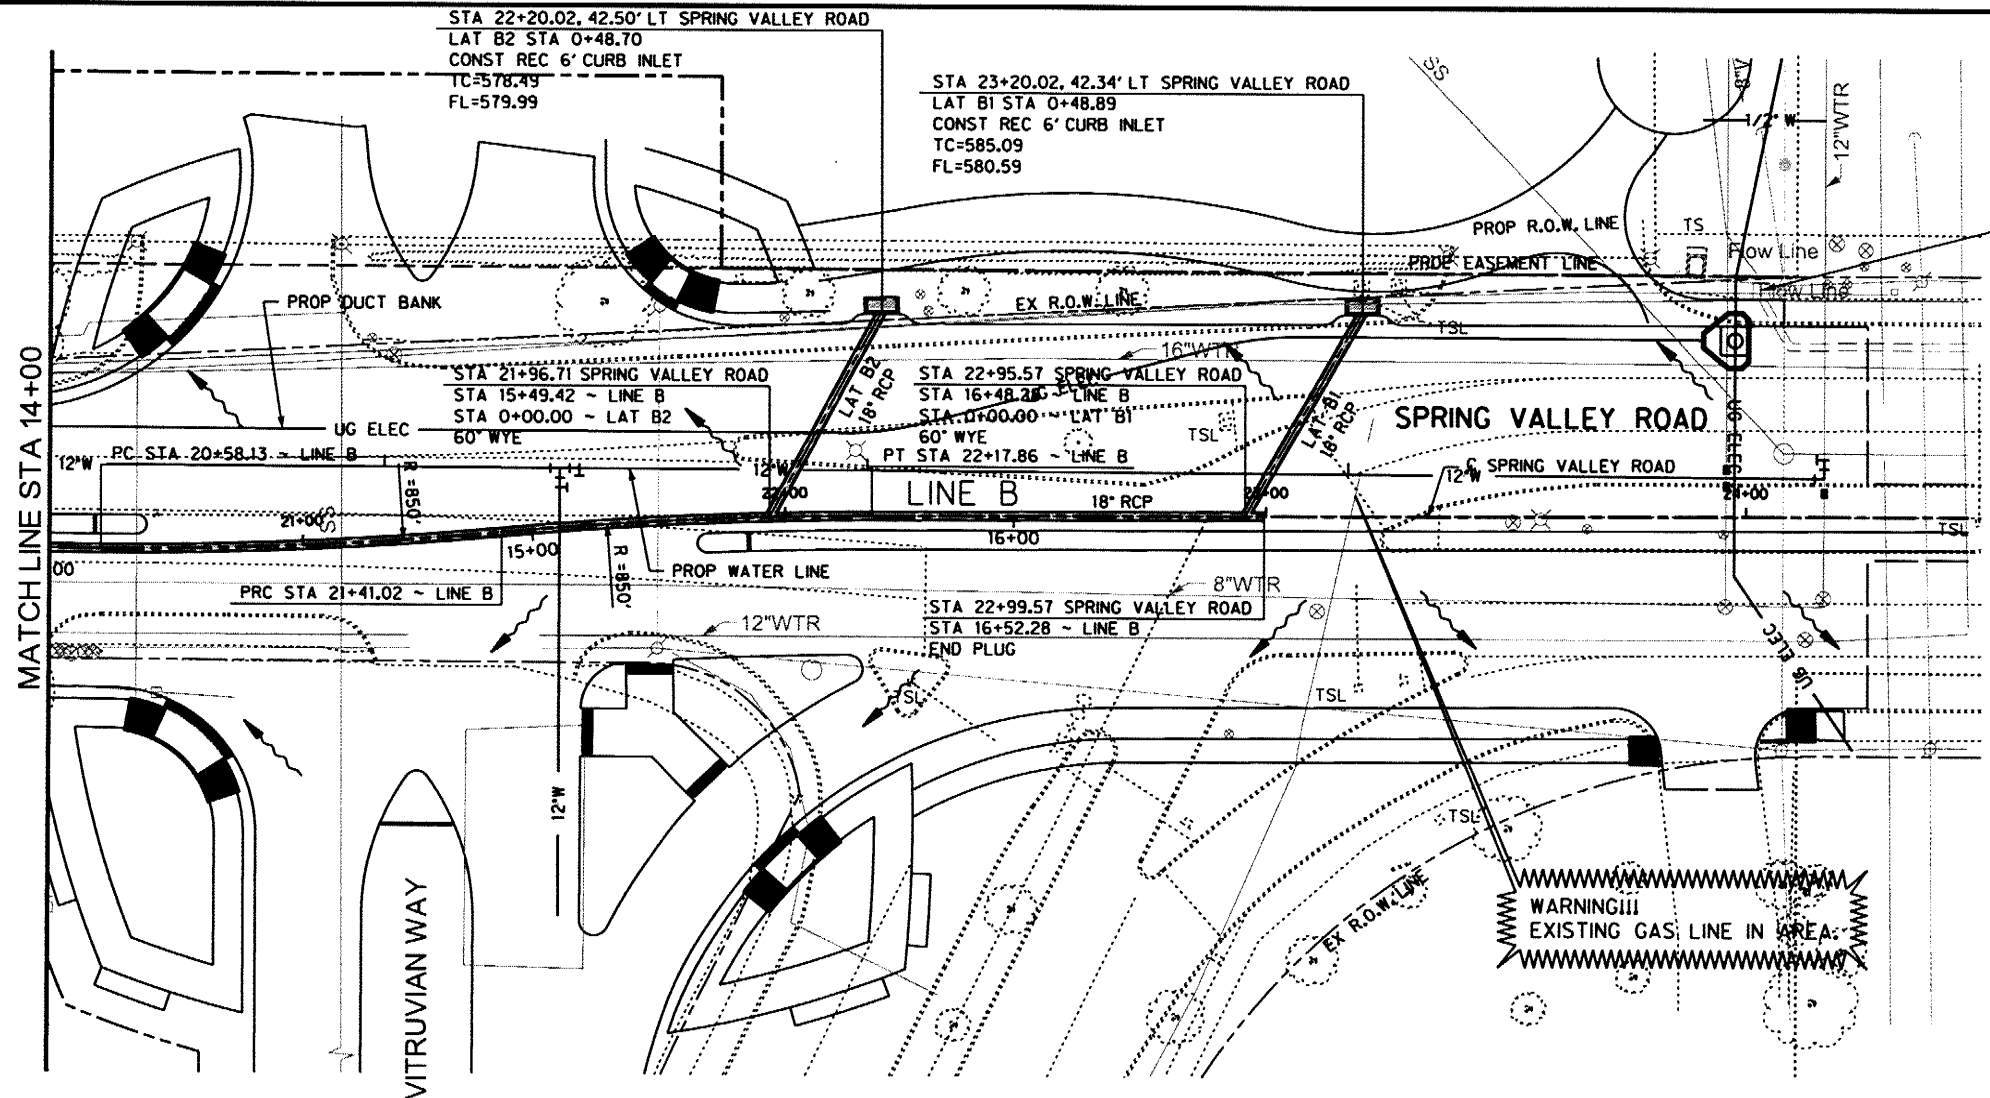

MODIFY EX INLET TOP TO ACCEPT DRAINAGE ONLY FROM NORTH SIDE. GRADE AREA TO DRAIN

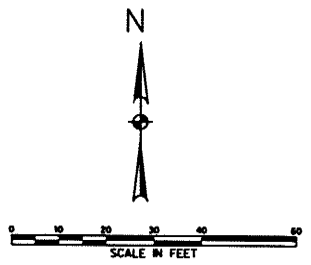


WARNING!!!
EXISTING GAS LINE IN AREA

RECORD DOCUMENTS
December, 2011
These Record Documents have been prepared based upon information provided by North Texas Contracting, Inc. The Design Professional has not verified the accuracy and / or completeness of this information and shall not be responsible for any errors or omissions which may be incorporated herein as a result.

Design Consultant: Half Associates, Inc.
RECORD DRAWING SUBMITTAL

SHEET 39 OF 163



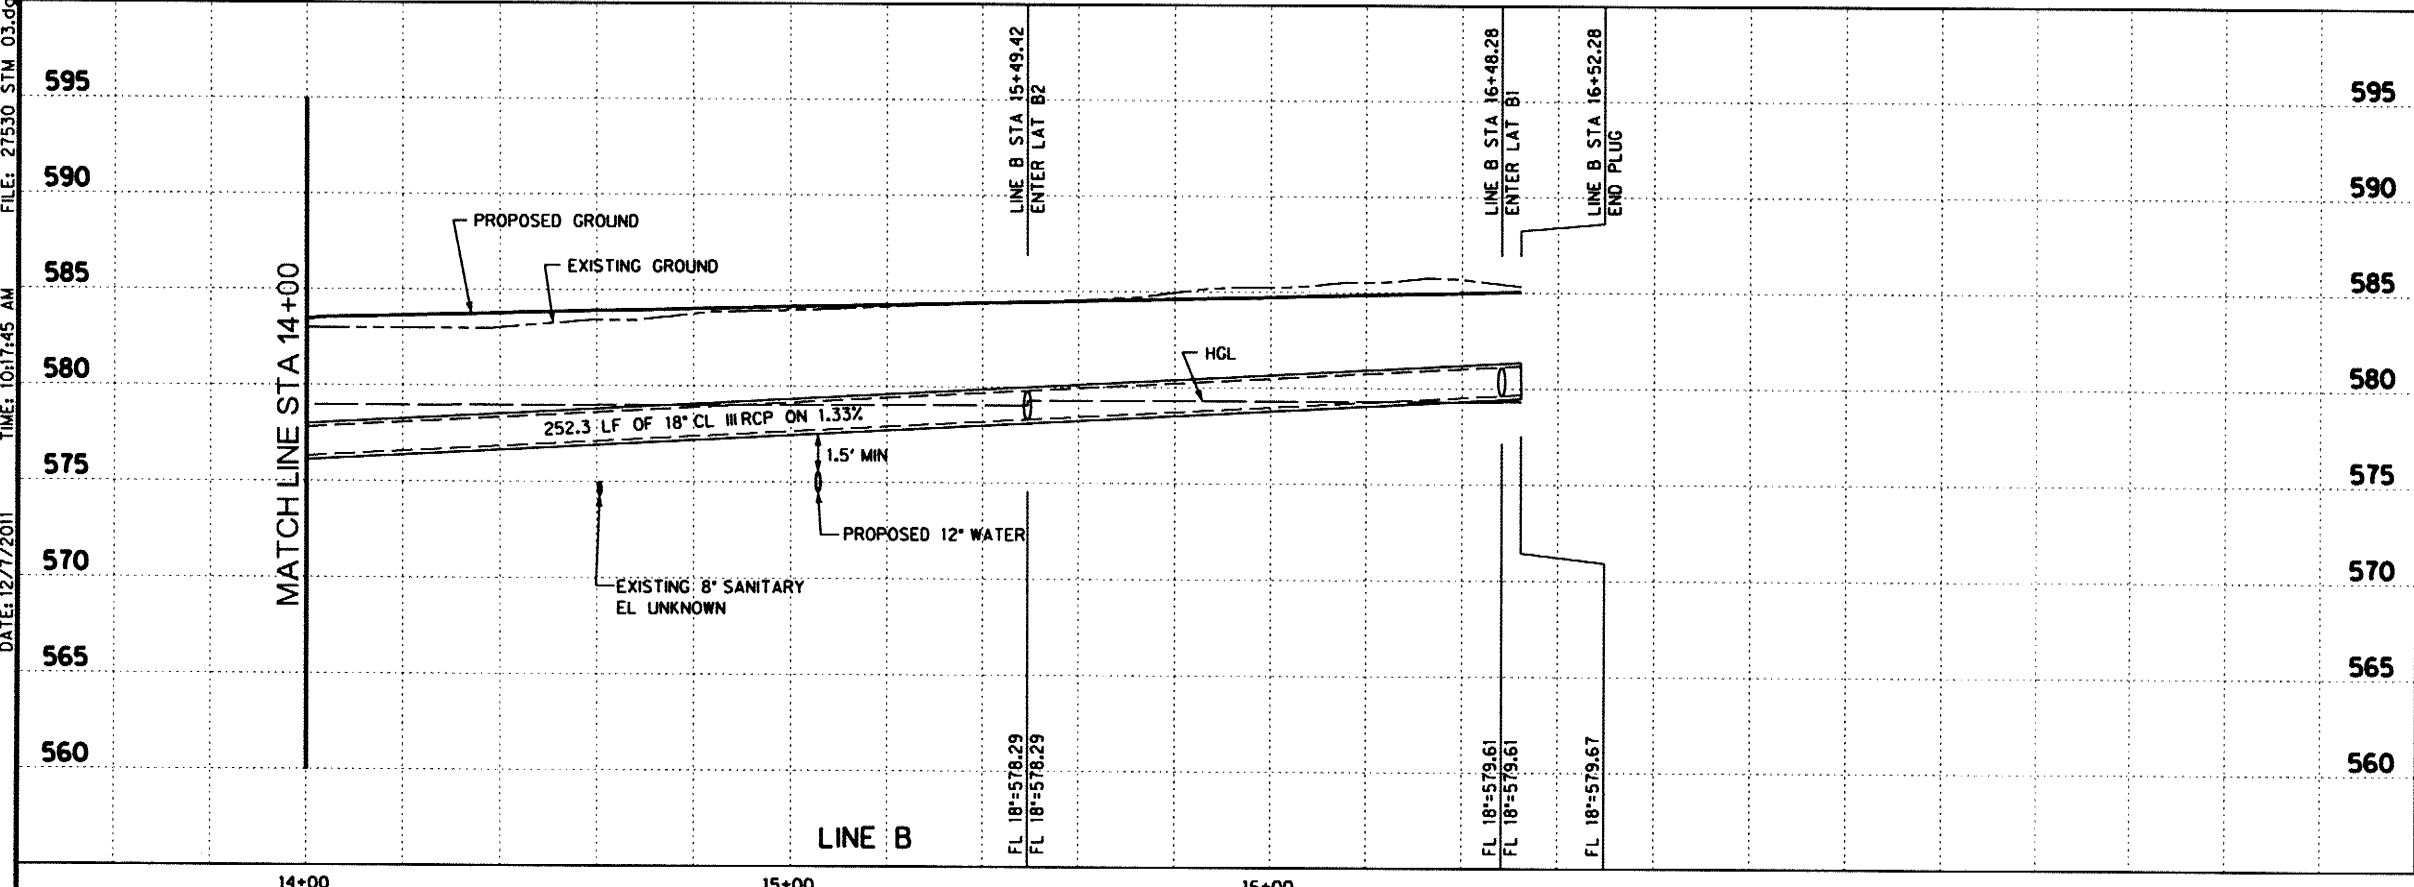


Signature of Registrant: *M.F. Romanowski*
Date: 12/8/2011

NO.	REVISION	BY	DATE
<p><i>Addison!</i> TOWN OF ADDISON DALLAS COUNTY, TEXAS</p> <p>SPRING VALLEY ROAD</p> <p>STORM DRAIN PLAN & PROFILE LINE B STA 14+00 TO 16+52.28</p> <p>HALFF 1201 NORTH BOWSER ROAD, RICHARDSON, TEXAS 75081-2275 TEL (214) 348-8200 FAX (214) 738-0095</p>			
PROJECT	DESIGN	DRAWN	DATE
27530	MPB	TMM	OCTOBER 2010
FILE	SHEET		
27530 STM 03	STM-3		

RECORD DRAWINGS

USER: qh1299
 OFFICE: RCH
 PROJECT: 27530
 FILE: 27530_STM_04_Rev1.dgn
 TIME: 10:43:25 AM
 DATE: 12/7/2011

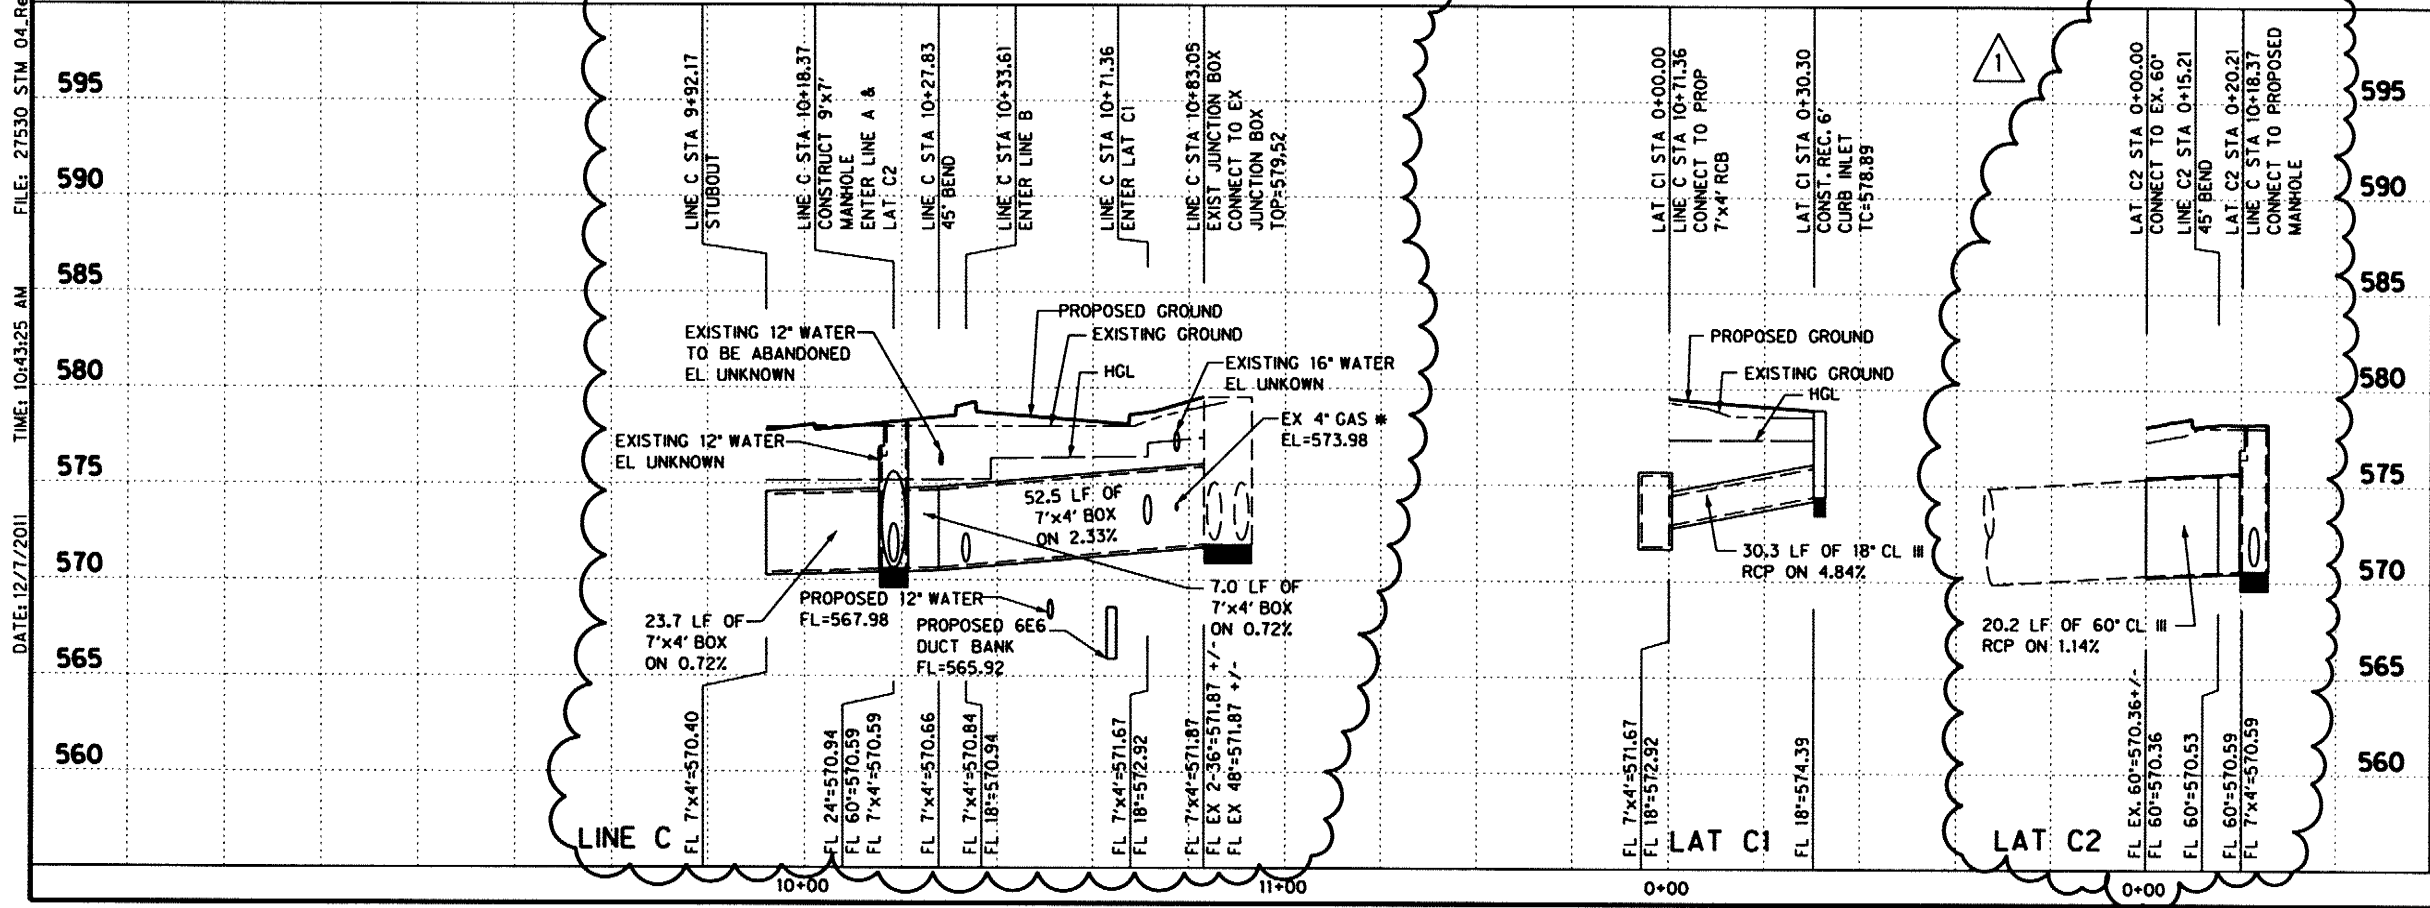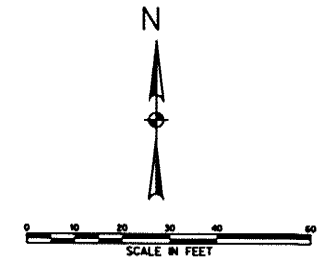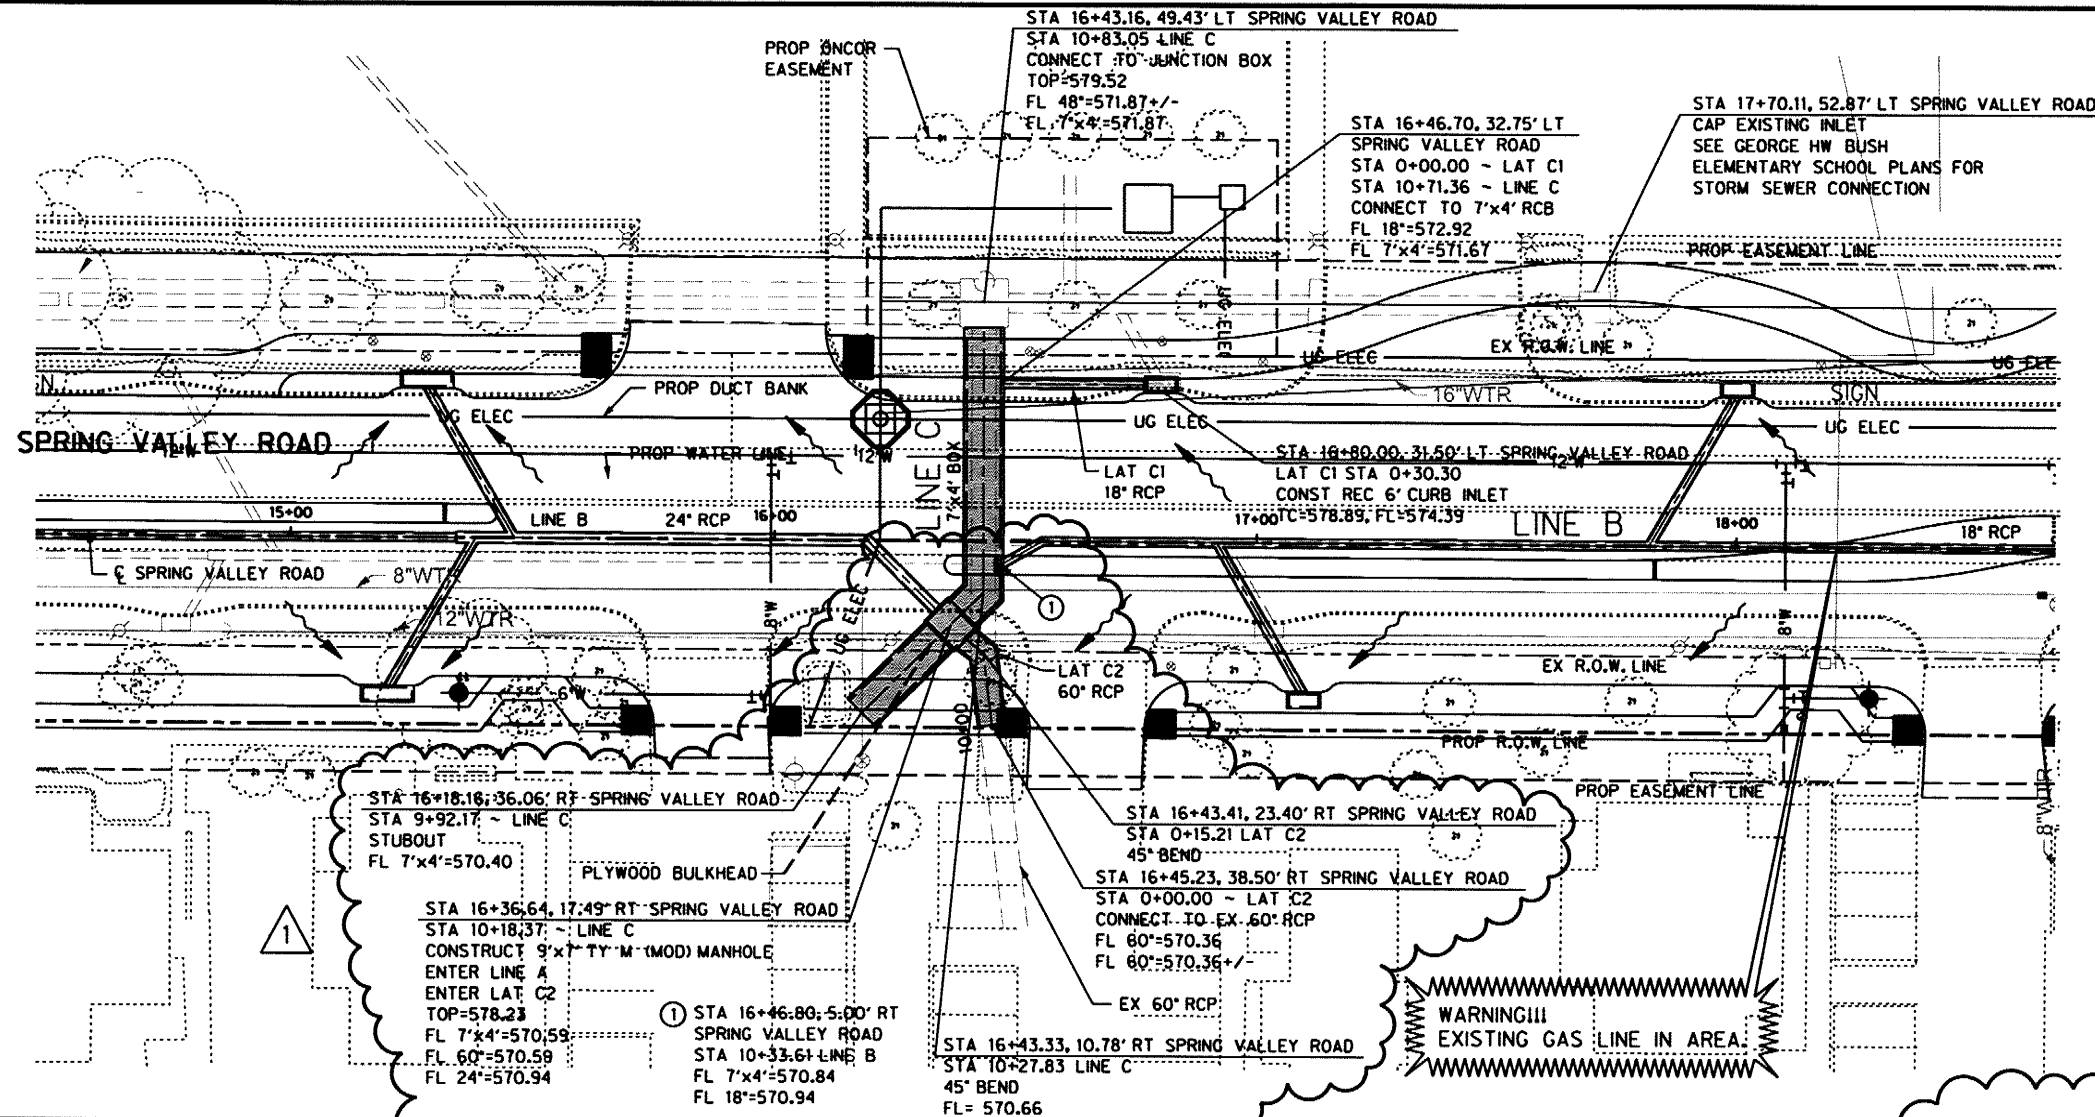

* CONTRACTOR TO FIELD VERIFY GAS LINE LOCATION AND COORDINATE WITH ATMOS TO RESOLVE CONFLICTS.

WARNING!!!
 EXISTING GAS LINE IN AREA.

Signature of Registrant: *[Signature]* P.E. M/S/2011
 Date: 12/8/2011

NO.	REVISION	BY	DATE
1	STORM LINE REVISION	MER	12/14/10
	REVISION		


Addisom TOWN OF ADDISON
 DALLAS COUNTY, TEXAS
 SPRING VALLEY ROAD
 STORM DRAIN PLAN & PROFILE
 LINE C STA 10+00 TO 12+08.48

PROJECT	DESIGN	DRAWN	DATE	FILE	SHEET
27530	MPB	TMM	OCTOBER 2010	27530 STM 04	STM-4

HALFF 1201 NORTH BOWSER ROAD, RICHARDSON, TEXAS 75081-2275
 TEL (214) 346-6200 FAX (214) 730-0065


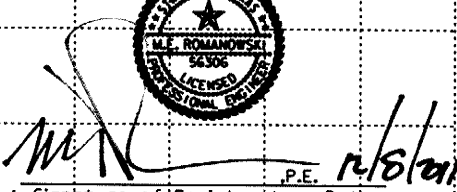
SHEET 40 OF 163


USER: ghl299
 OFFICE: RCH
 PROJECT: 27530
 TIME: 10:19:25 AM
 FILE: 27530 STM 05.dgn
 DATE: 12/7/2011

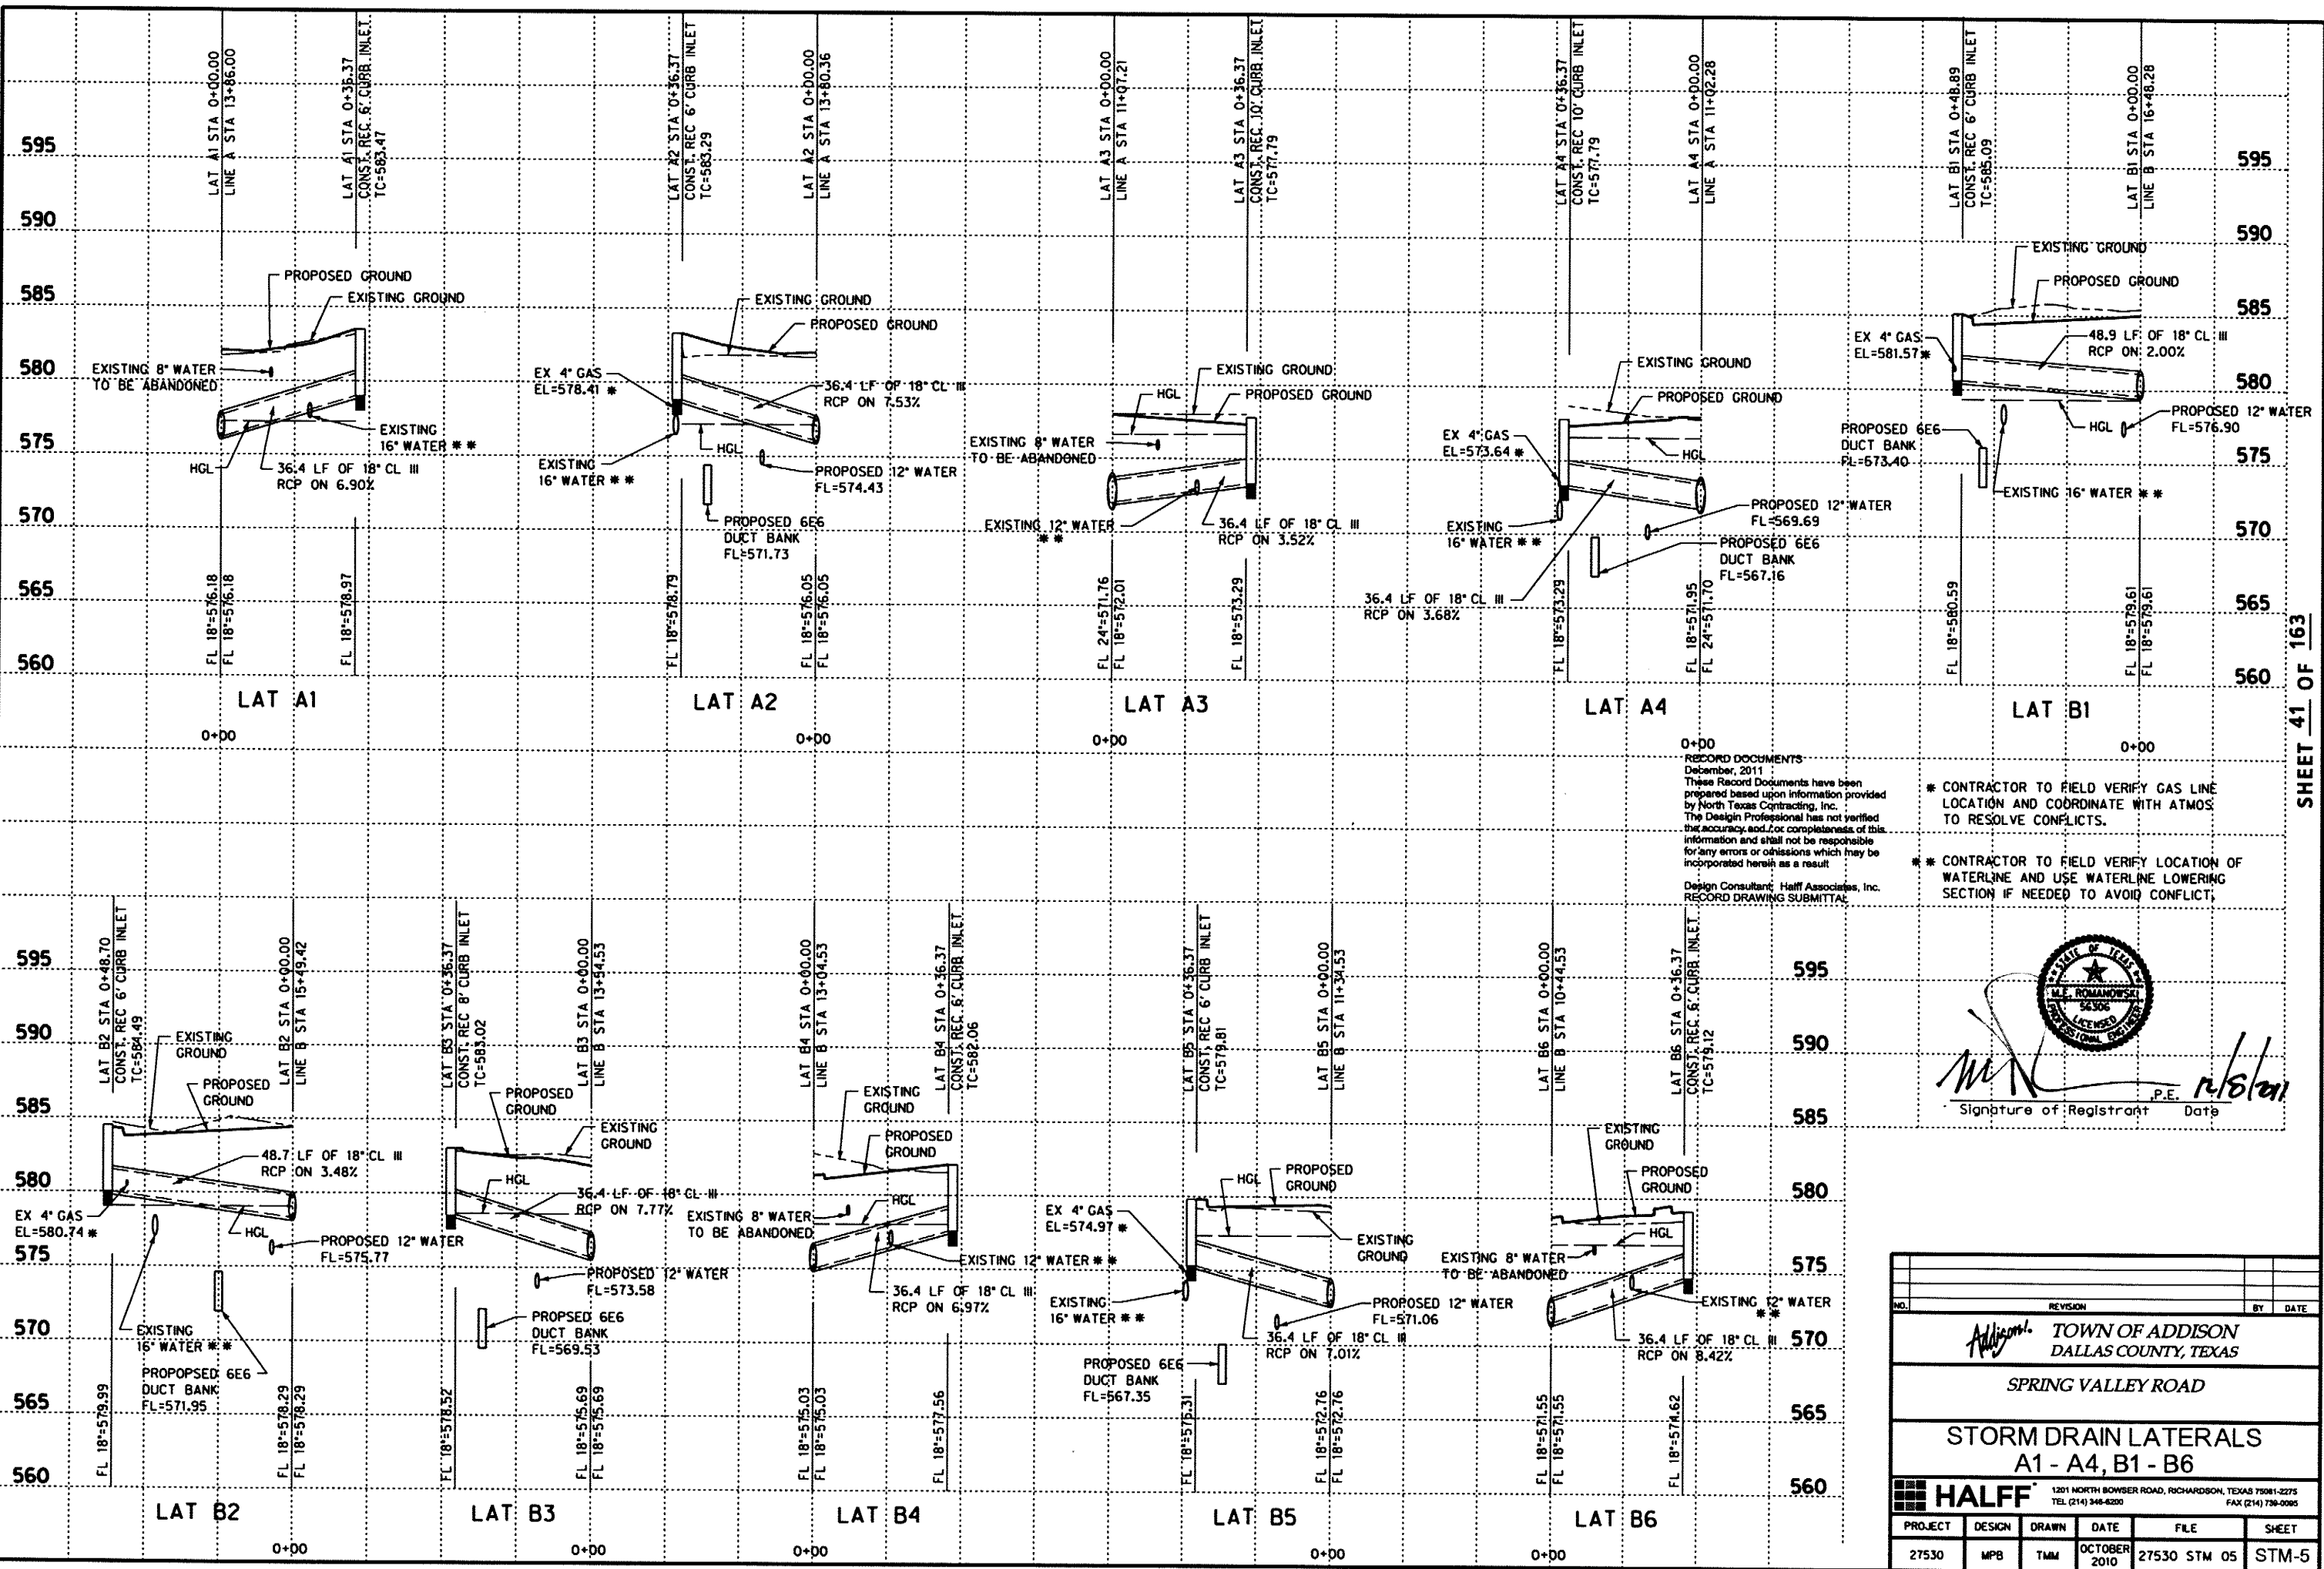

RECORD DOCUMENTS
 December, 2011
 These Record Documents have been prepared based upon information provided by North Texas Contracting, Inc. The Design Professional has not verified the accuracy and/or completeness of this information and shall not be responsible for any errors or omissions which may be incorporated herein as a result.
 Design Consultant: Half Associates, Inc.
 RECORD DRAWING SUBMITTAL


- * CONTRACTOR TO FIELD VERIFY GAS LINE LOCATION AND COORDINATE WITH ATMOS TO RESOLVE CONFLICTS.
- ** CONTRACTOR TO FIELD VERIFY LOCATION OF WATERLINE AND USE WATERLINE LOWERING SECTION IF NEEDED TO AVOID CONFLICT.



 Signature of Registrant Date: 12/6/11

NO.	REVISION	BY	DATE
TOWN OF ADDISON DALLAS COUNTY, TEXAS <hr/> SPRING VALLEY ROAD <hr/> STORM DRAIN LATERALS A1 - A4, B1 - B6			
 1201 NORTH BOWSER ROAD, RICHARDSON, TEXAS 75081-2275 TEL (214) 348-8200 FAX (214) 730-0095			
PROJECT	DESIGN	DRAWN	DATE
27530	MPB	TMM	OCTOBER 2010
FILE	SHEET		
27530 STM 05	STM-5		

SHEET 41 OF 163

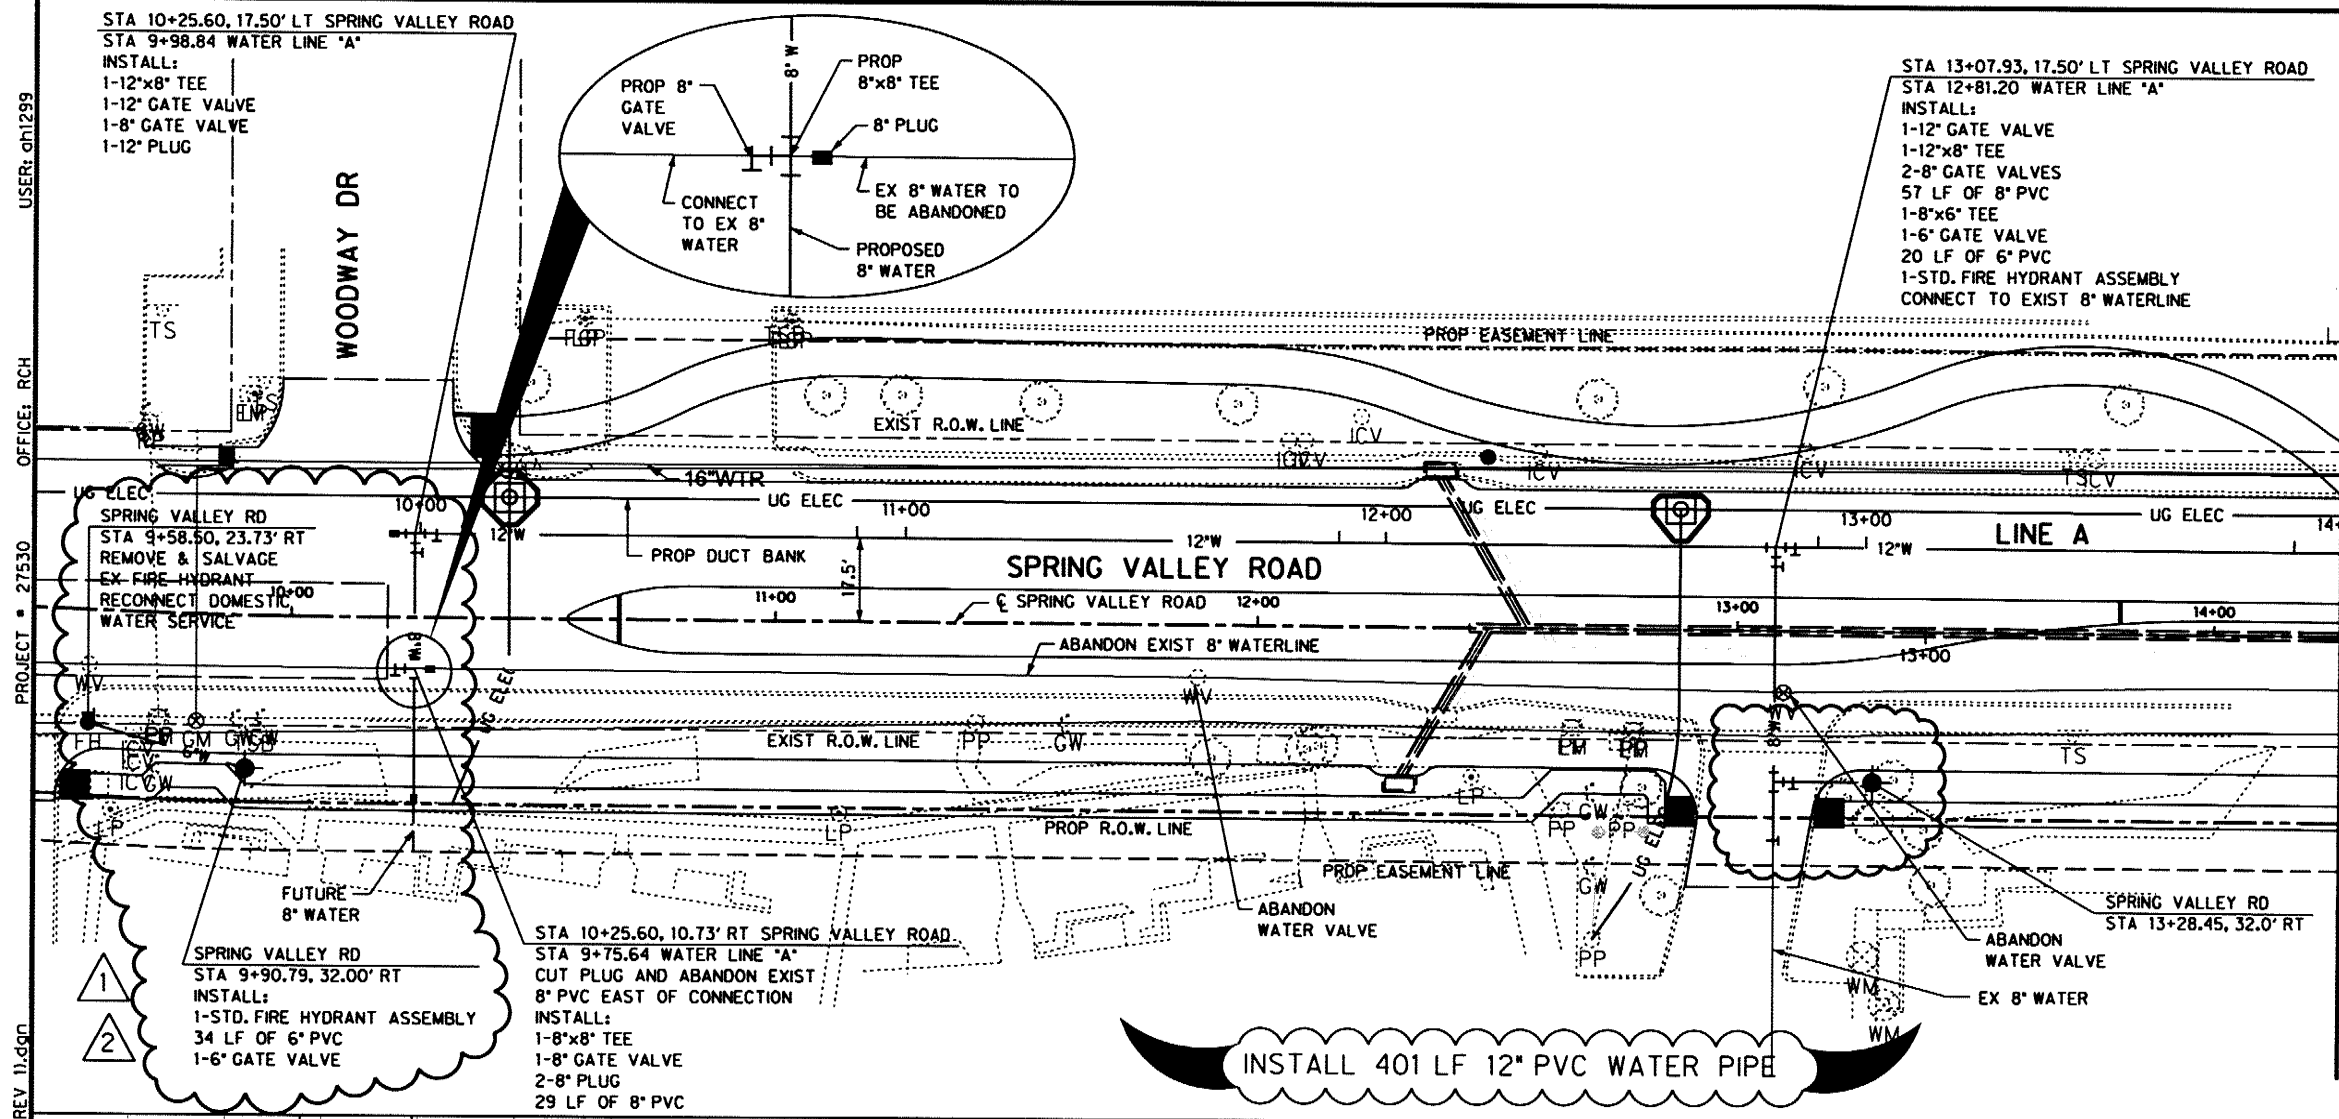RECORD DRAWINGS




N
SCALE IN FEET

NOTE:
ALL WATERLINE CROSSING WITH OTHER UNDER GROUND UTILITIES MUST COMPLY WITH APPLICABLE TCEO REGULATIONS.

RECORD DOCUMENTS
December, 2011
These Record Documents have been prepared based upon information provided by North Texas Contracting, Inc. The Design Professional has not verified the accuracy and / or completeness of this information and shall not be responsible for any errors or omissions which may be incorporated herein as a result

Design Consultant: Half Associates, Inc.
RECORD DRAWING SUBMITTAL

SHEET 42 OF 163

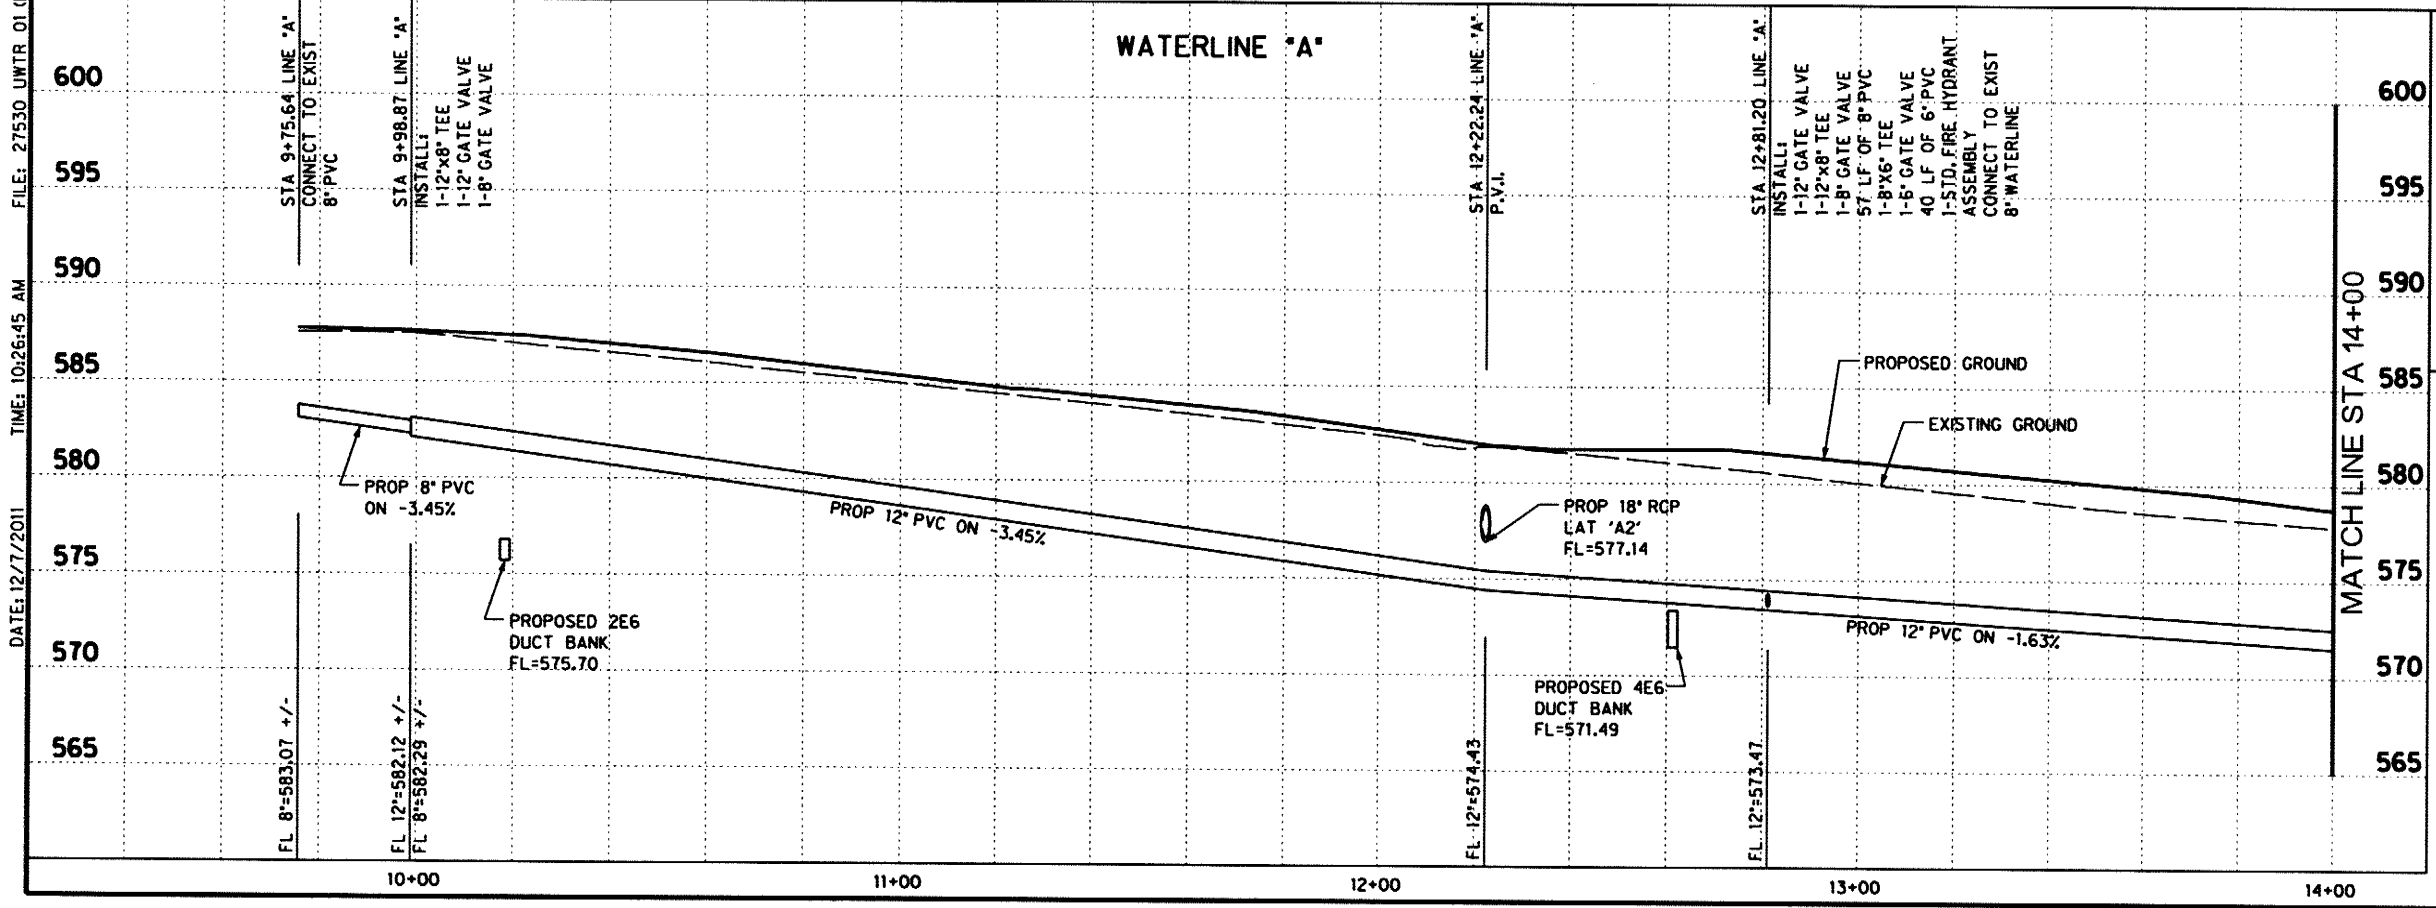

Signature of Registrant: *A.E. Romanowski* Date: 12/01/11

NO.	REVISION	MER	DATE
1	WATER LINE REVISION		2/09/11
2	ADD 6\"/>		

TOWN OF ADDISON
DALLAS COUNTY, TEXAS



SPRING VALLEY ROAD

WATER PLAN AND PROFILE
STA 10+00 TO 14+00

PROJECT	DESIGN	DRAWN	DATE	FILE	SHEET
27530	MPB	TMM	OCTOBER 2010	27530 UWTR 01	WTR-1

USER: qh1299
 OFFICE: RCH
 PROJECT: 27530
 DATE: 12/7/2011
 TIME: 10:26:45 AM
 FILE: 27530 UWTR 01 (REV 1).dgn


DATE: 12/7/2011 TIME: 10:27:03 AM FILE: 27530 UWTR 02.dgn PROJECT: 27530 OFFICE: RCH USER: gh1299

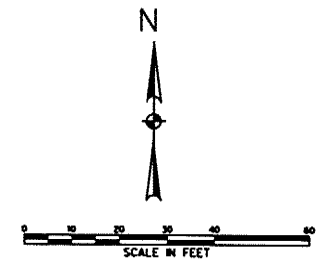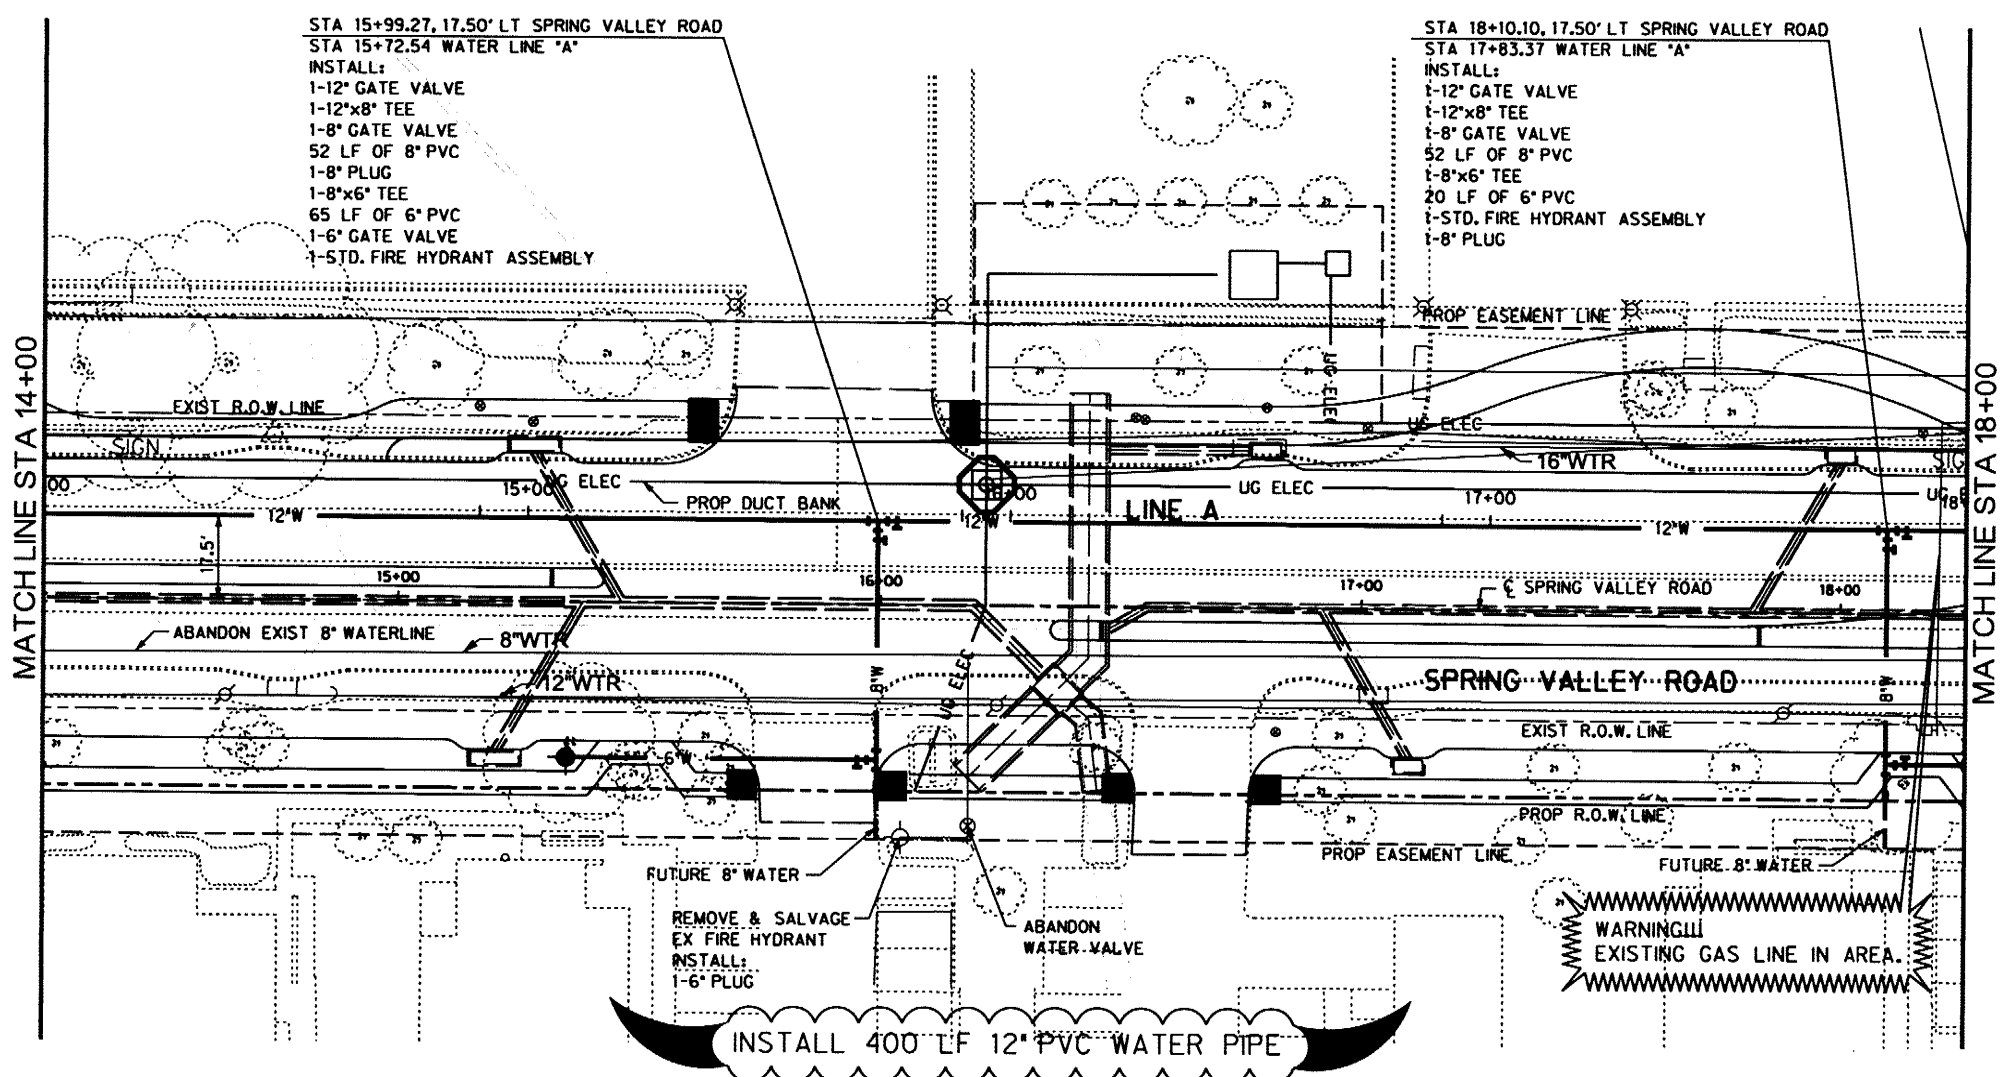



RECORD DOCUMENTS
 December, 2011
 These Record Documents have been prepared based upon information provided by North Texas Contracting, Inc. The Design Professional has not verified the accuracy and / or completeness of this information and shall not be responsible for any errors or omissions which may be incorporated herein as a result.

Design Consultant: Helff Associates, Inc.
 RECORD DRAWING SUBMITTAL

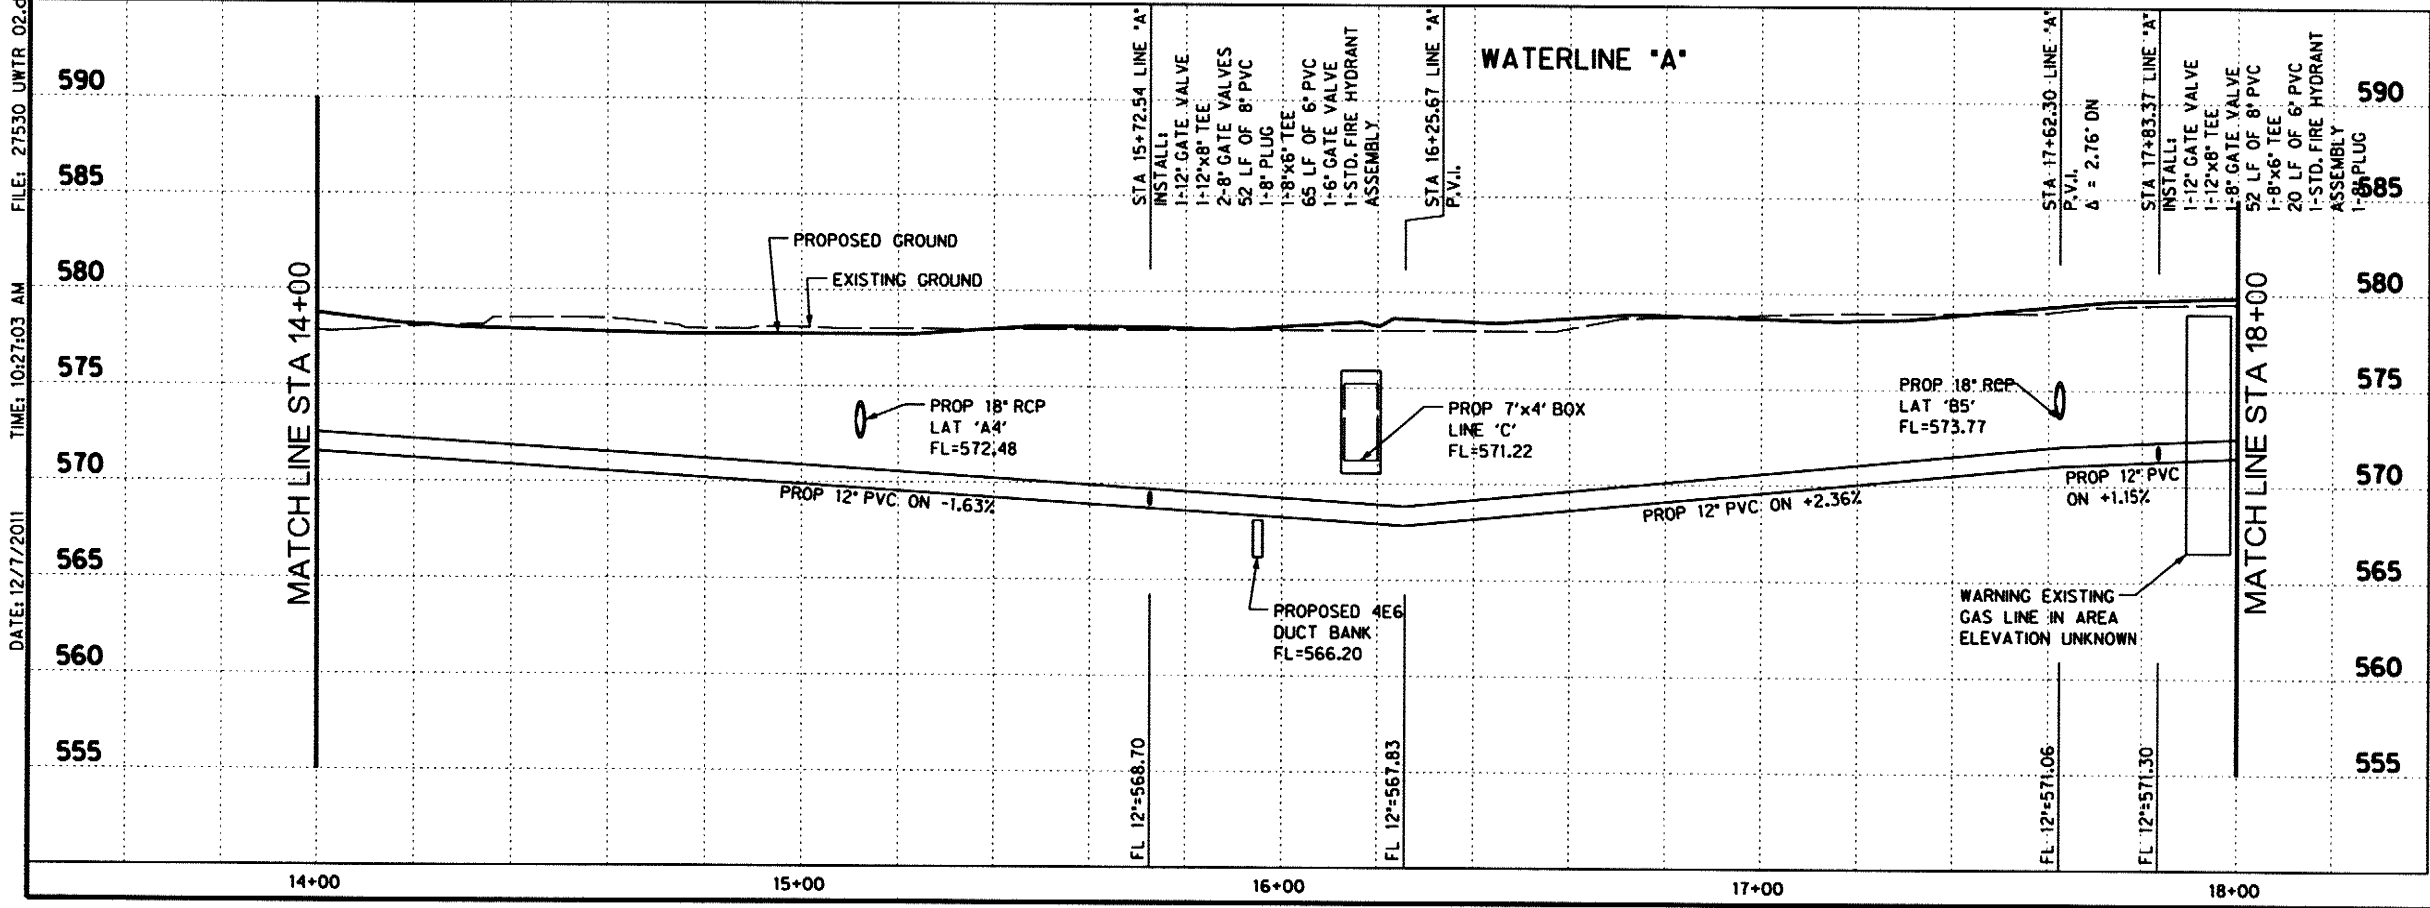INSTALL 400' LF 12" PVC WATER PIPE






 Signature of Registrant: *M.E. Romanowski*
 Date: 12/8/2011


NO.	REVISION	BY	DATE		
 TOWN OF ADDISON DALLAS COUNTY, TEXAS SPRING VALLEY ROAD WATER PLAN AND PROFILE STA 14+00 TO 18+00 HALFF 1201 NORTH BOYSER ROAD, RICHARDSON, TEXAS 75081-2275 TEL (214) 344-8200 FAX (214) 730-0095					
PROJECT	DESIGN	DRAWN	DATE	FILE	SHEET
27530	MPB	TMM	OCTOBER 2010	27530 UWTR 02	WTR-2

RECORD DRAWINGS SHEET 43 OF 163

DATE: 12/7/2011 TIME: 10:27:20 AM FILE: 27530 UWTR 03.dwg PROJECT: 27530 OFFICE: RCH USER: rhl299

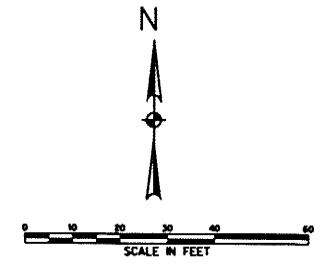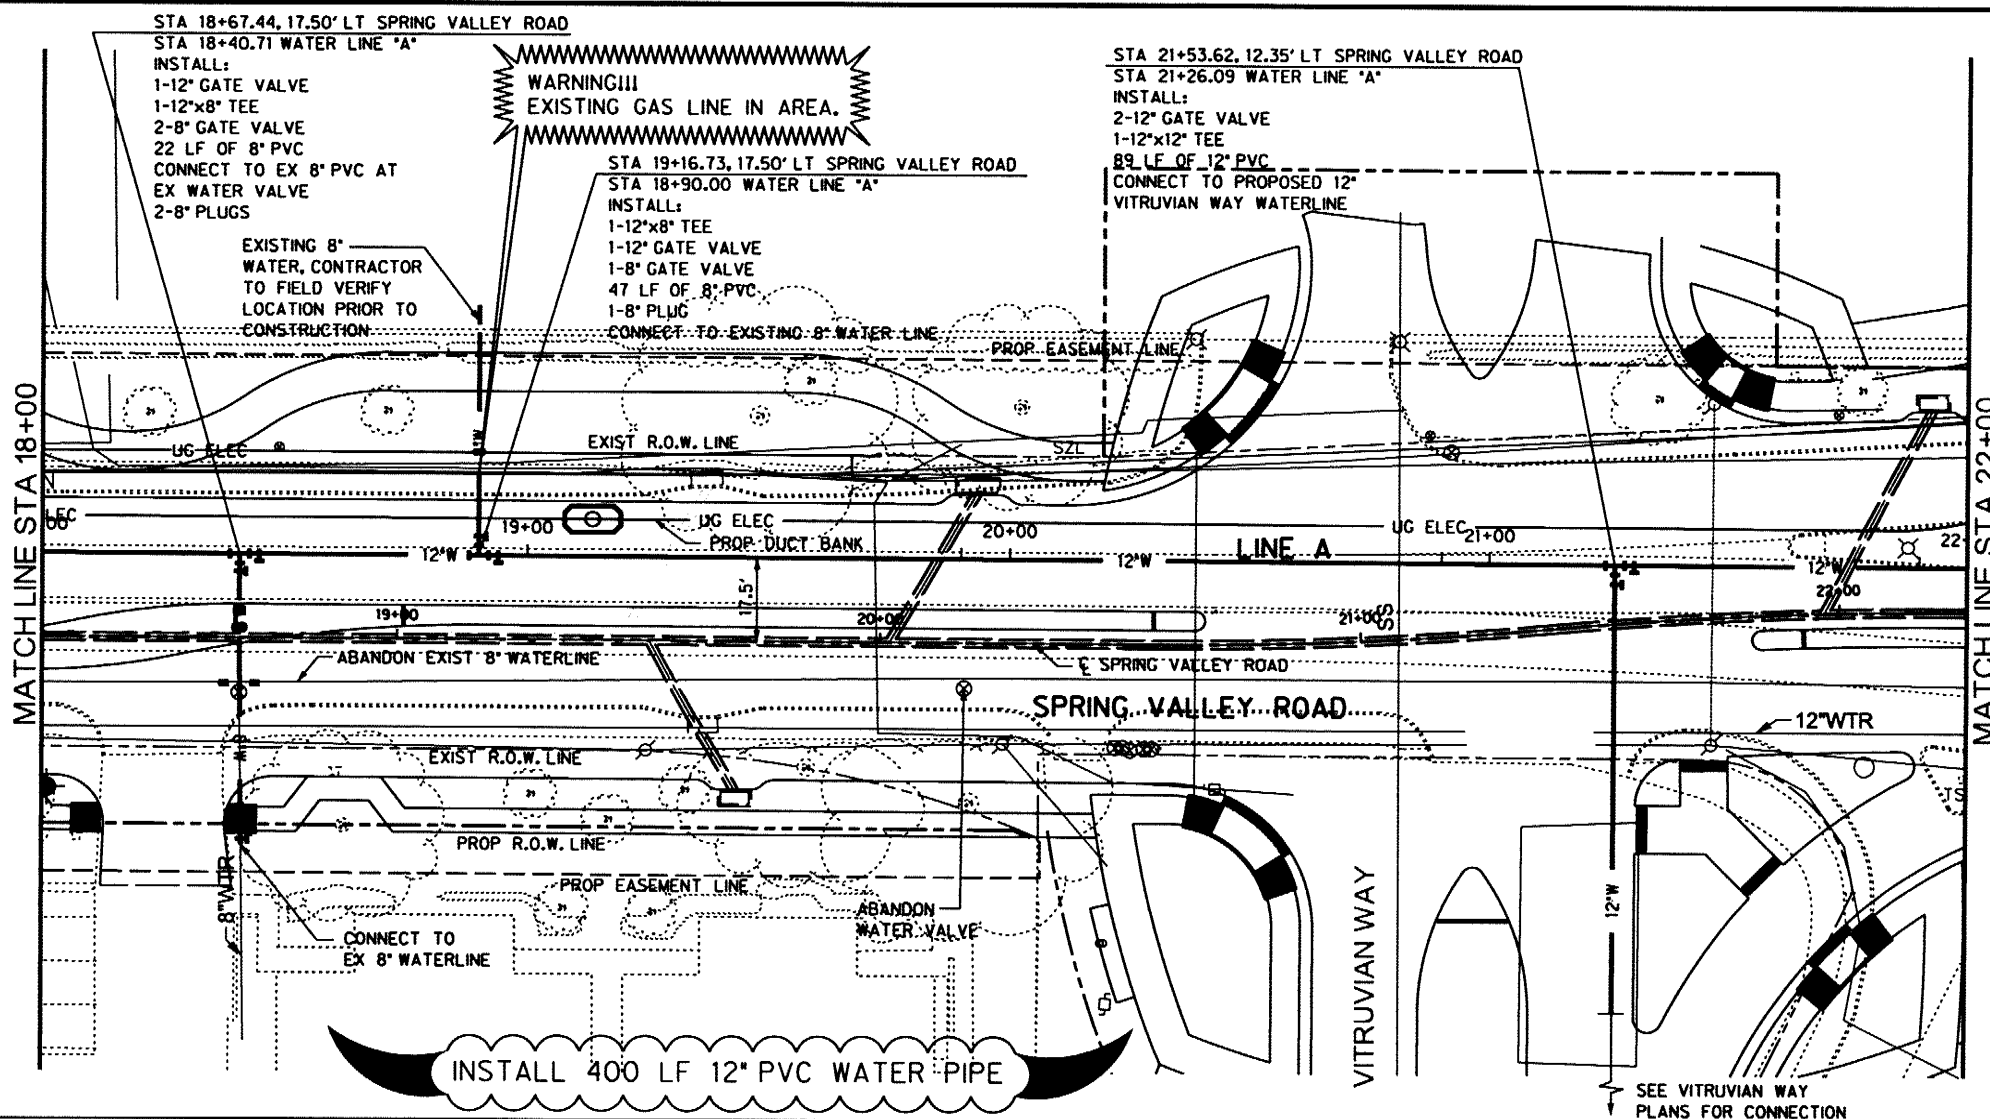

RECORD DOCUMENTS
 December, 2011
 These Record Documents have been prepared based upon information provided by North Texas Contracting, Inc. The Design Professional has not verified the accuracy and / or completeness of this information and shall not be responsible for any errors or omissions which may be incorporated herein as a result.
 Design Consultant: Half Associates, Inc.
 RECORD DRAWING SUBMITTAL

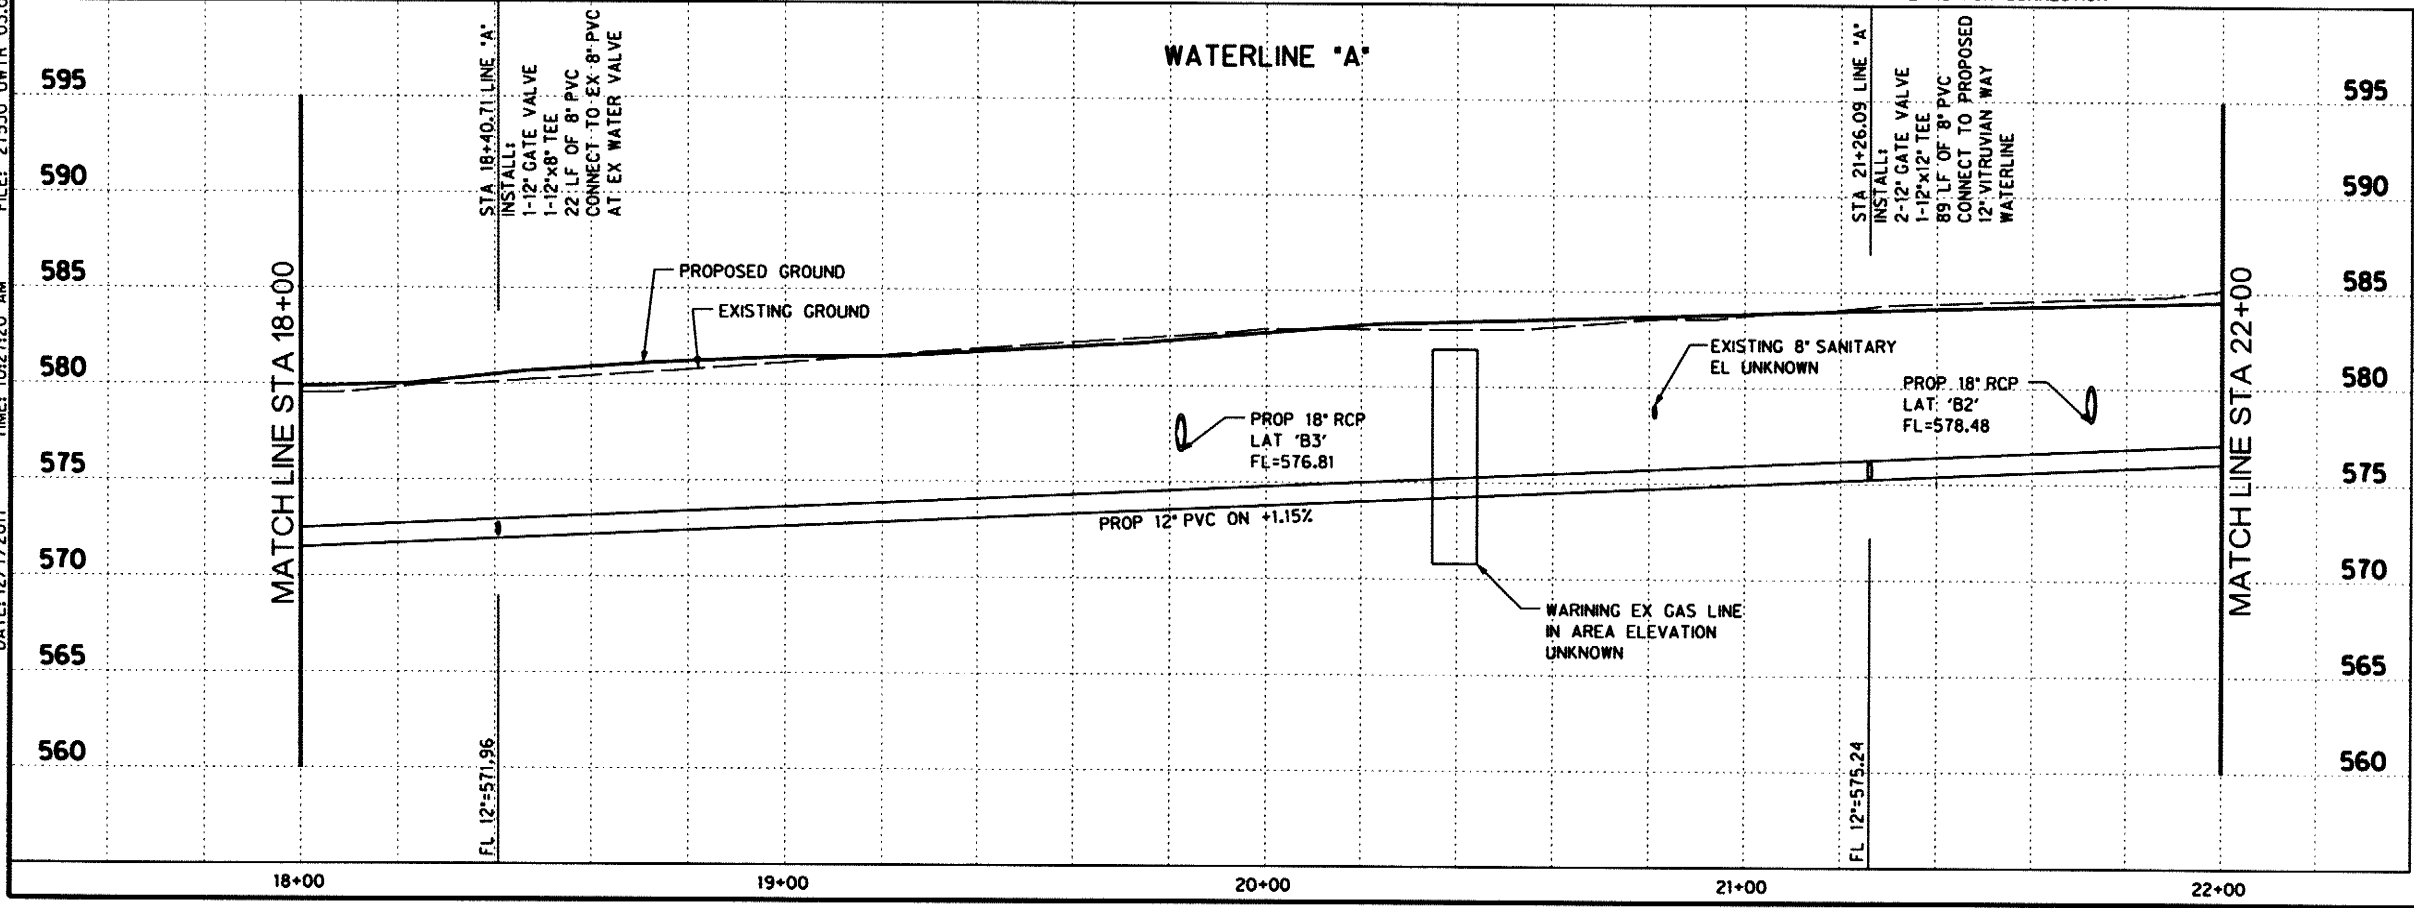

Signature of Registrant: *U.S. Romanowski* Date: 12/8/2011

NO.	REVISION	BY	DATE		
TOWN OF ADDISON DALLAS COUNTY, TEXAS SPRING VALLEY ROAD WATER PLAN AND PROFILE STA 18+00 TO 22+00 HALFF 1201 NORTH BOWSER ROAD, RICHARDSON, TEXAS 75061-2275 TEL (214) 348-6200 FAX (214) 730-0095					
PROJECT	DESIGN	DRAWN	DATE	FILE	SHEET
27530	MPB	TMM	OCTOBER 2010	27530 UWTR 03	WTR-3

RECORD DRAWINGS SHEET 44 OF 163

USER: qh1299



OFFICE: RCH

PROJECT: 27530

FILE: 27530 UWTR 04.dgn

TIME: 10:27:35 AM


DATE: 12/7/2011

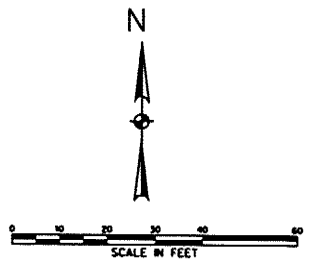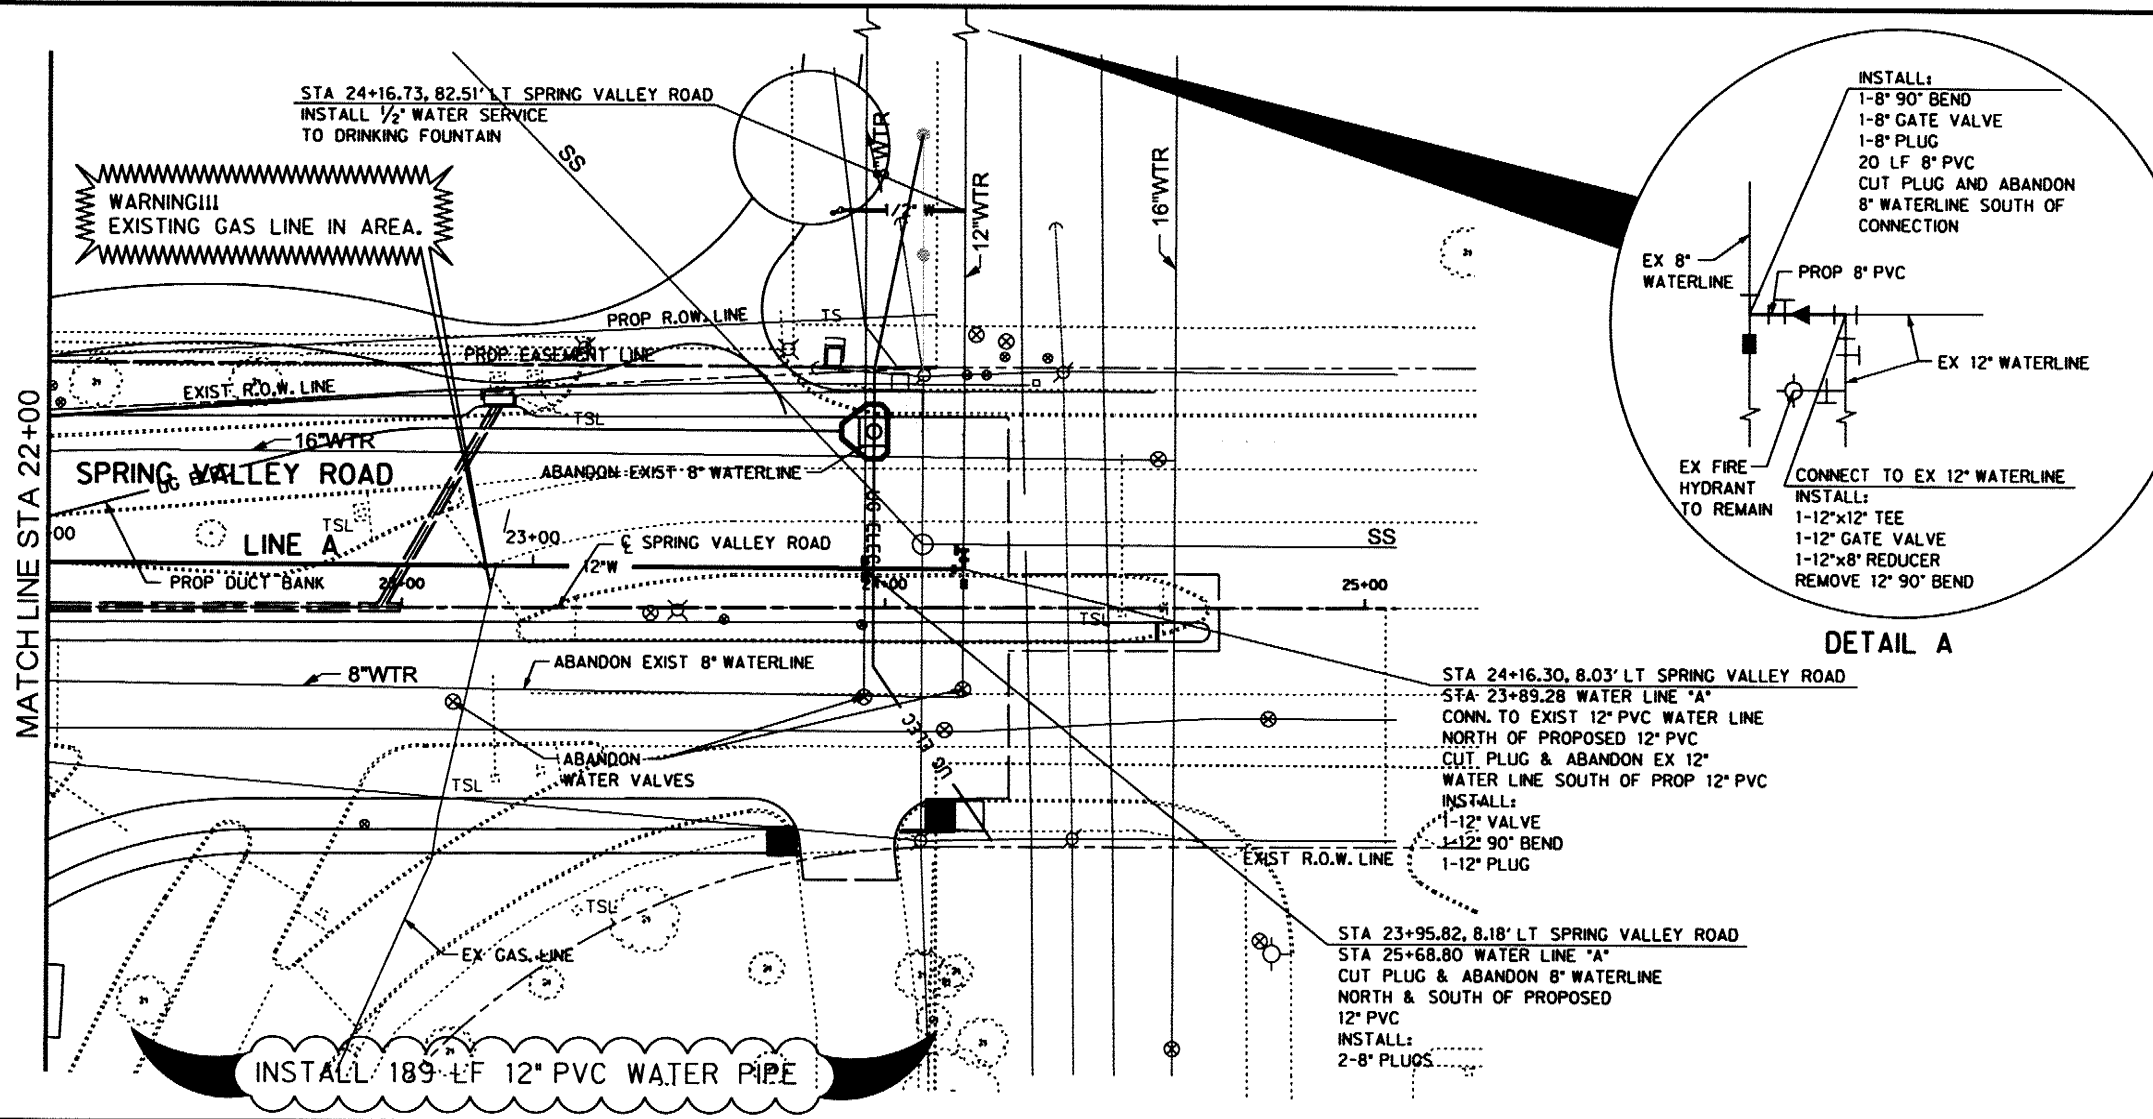

RECORD DOCUMENTS
 December, 2011
 These Record Documents have been prepared based upon information provided by North Texas Contracting, Inc. The Design Professional has not verified the accuracy and / or completeness of this information and shall not be responsible for any errors or omissions which may be incorporated herein as a result

Design Consultant: Halff Associates, Inc.
 RECORD DRAWING SUBMITTAL

SHEET 45 OF 163

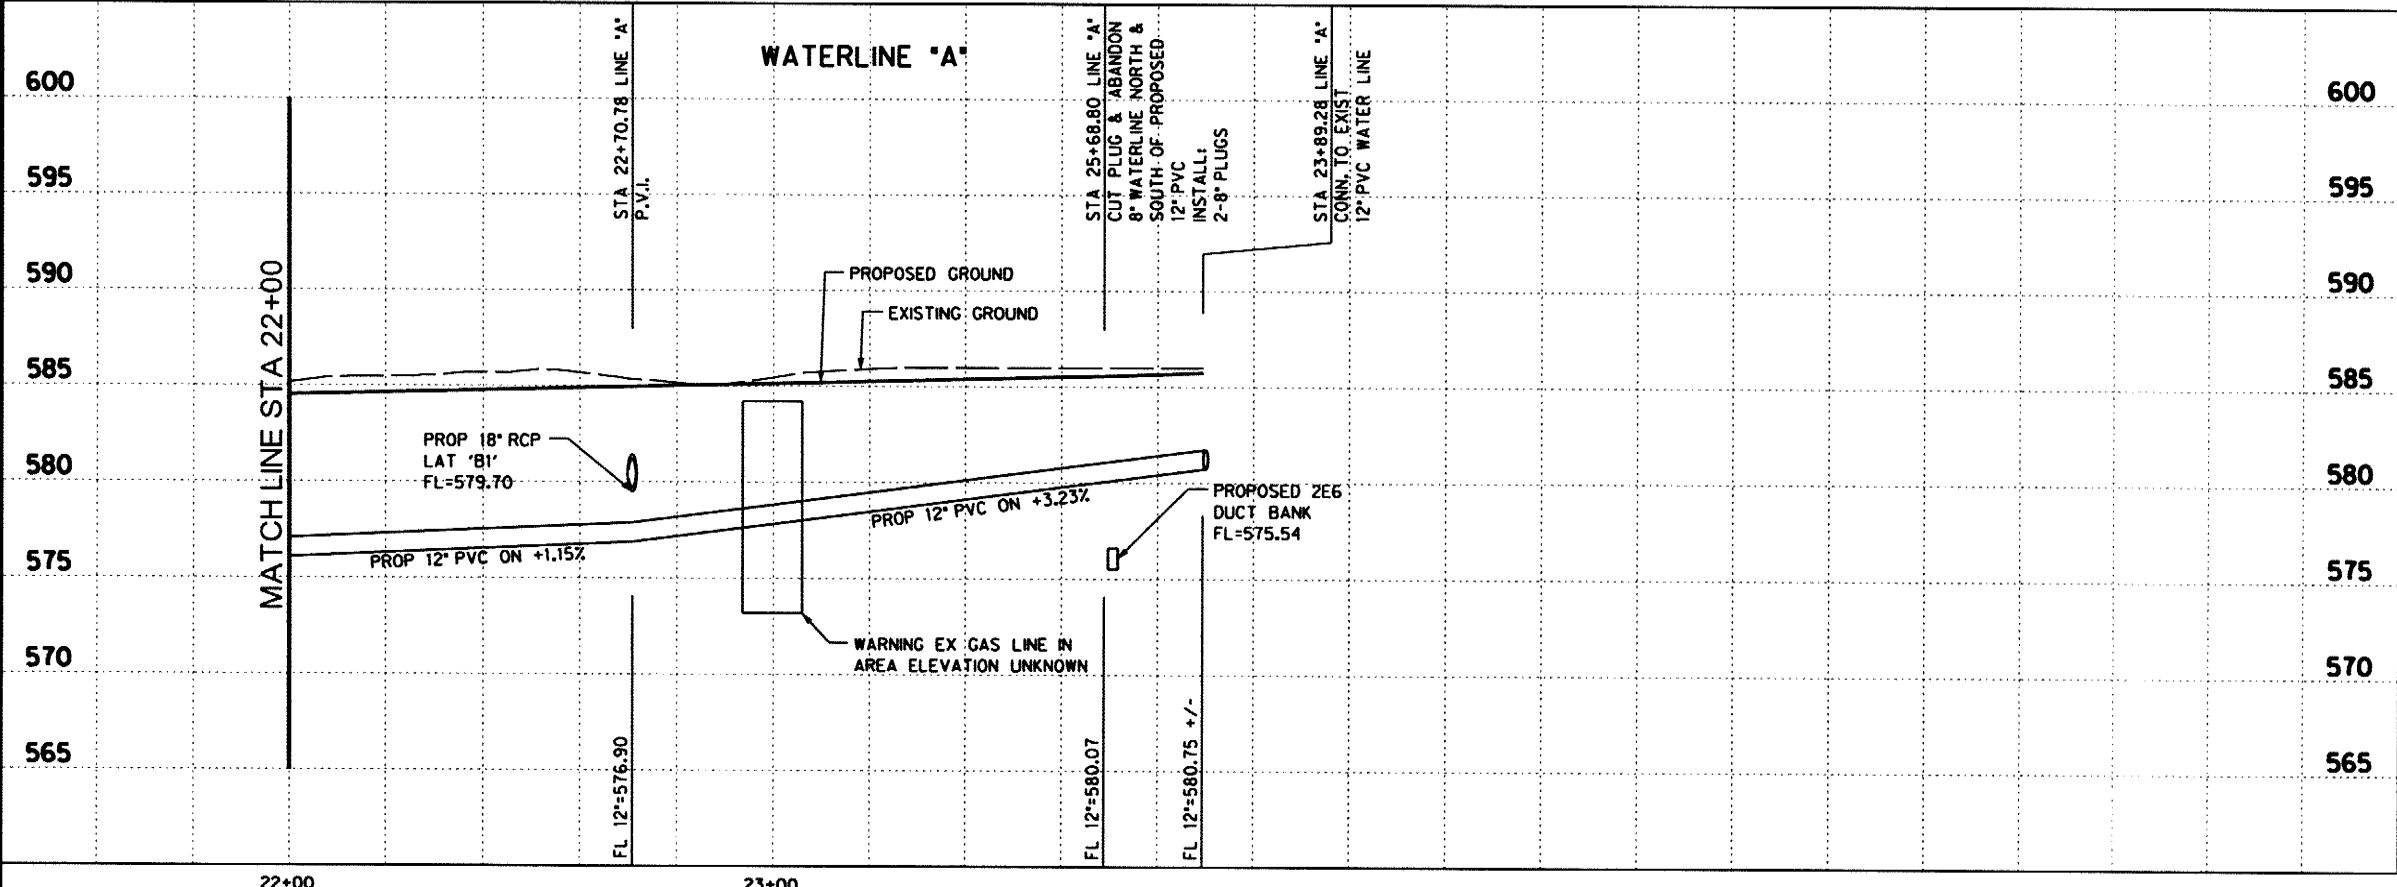


Signature of Registrant: *[Signature]* Date: 12/6/2011

Professional Engineer Seal: M.F. ROMANOWSKI, License No. 56306, State of Texas.

NO.	REVISION	BY	DATE		
ADDISON TOWN OF ADDISON DALLAS COUNTY, TEXAS SPRING VALLEY ROAD					
WATER PLAN AND PROFILE STA 22+00 TO 23+89.28					
HALFF 1201 NORTH BOWSER ROAD, RICHARDSON, TEXAS 75081-2275 TEL (214) 346-6200 FAX (214) 736-0095					
PROJECT	DESIGN	DRAWN	DATE	FILE	SHEET
27530	MPB	TMM	OCTOBER 2010	27530 UWTR 04	WTR-4

RECORD DRAWINGS

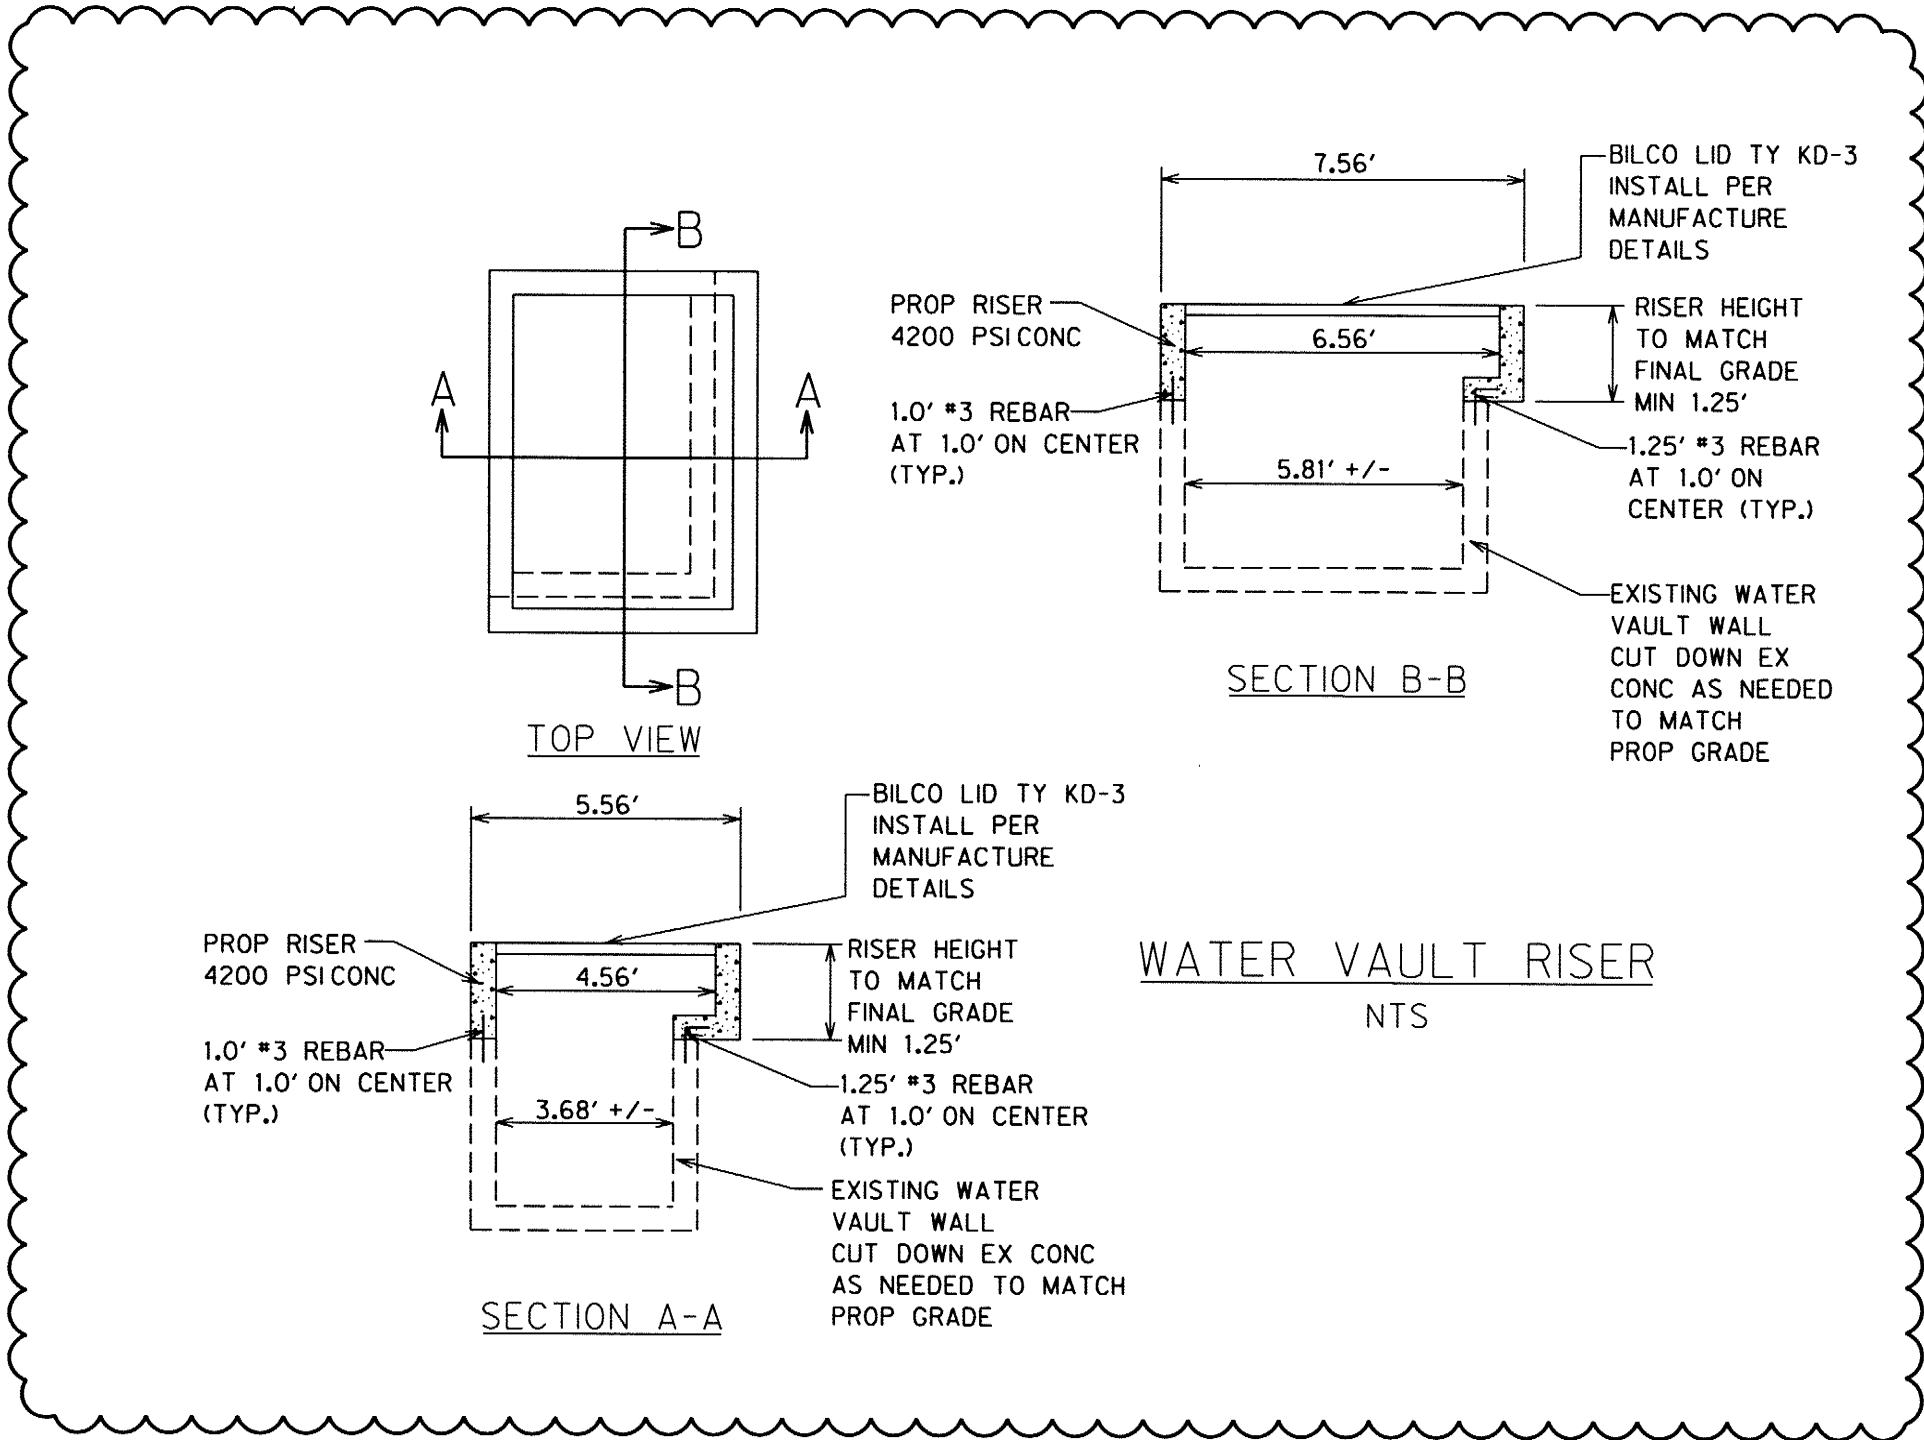

1

RECORD DOCUMENTS
 December, 2011
 These Record Documents have been prepared based upon information provided by North Texas Contracting, Inc. The Design Professional has not verified the accuracy and / or completeness of this information and shall not be responsible for any errors or omissions which may be incorporated herein as a result.



Design Consultant: Halff Associates, Inc.
 RECORD DRAWING SUBMITTAL

[Signature] *[Signature]*
 Signature of Registrant Date

STATE OF TEXAS
M.E. ROMANOWSKI
54306
REGISTERED PROFESSIONAL ENGINEER

1	ADDED WATER VAULT RISER DETAIL	MR	6/9/2011
NO.	REVISION	BY	DATE
<i>Addison</i> TOWN OF ADDISON DALLAS COUNTY, TEXAS			
SPRING VALLEY ROAD			
WATER DETAILS			
HALFF		1201 NORTH BOWSER ROAD, RICHARDSON, TEXAS 75081-2275 TEL (214) 348-4200 FAX (214) 739-0085	
PROJECT	DESIGN	DRAWN	DATE
27530	MPB	TMM	OCTOBER 2010
FILE	SHEET		
27530 DTW 01	DT-W		

DATE: 9/29/2010 TIME: 10:46:38 AM FILE: 21530_LUM_01.dwg PROJECT: 21530 OFFICE: RCH USER: 002104

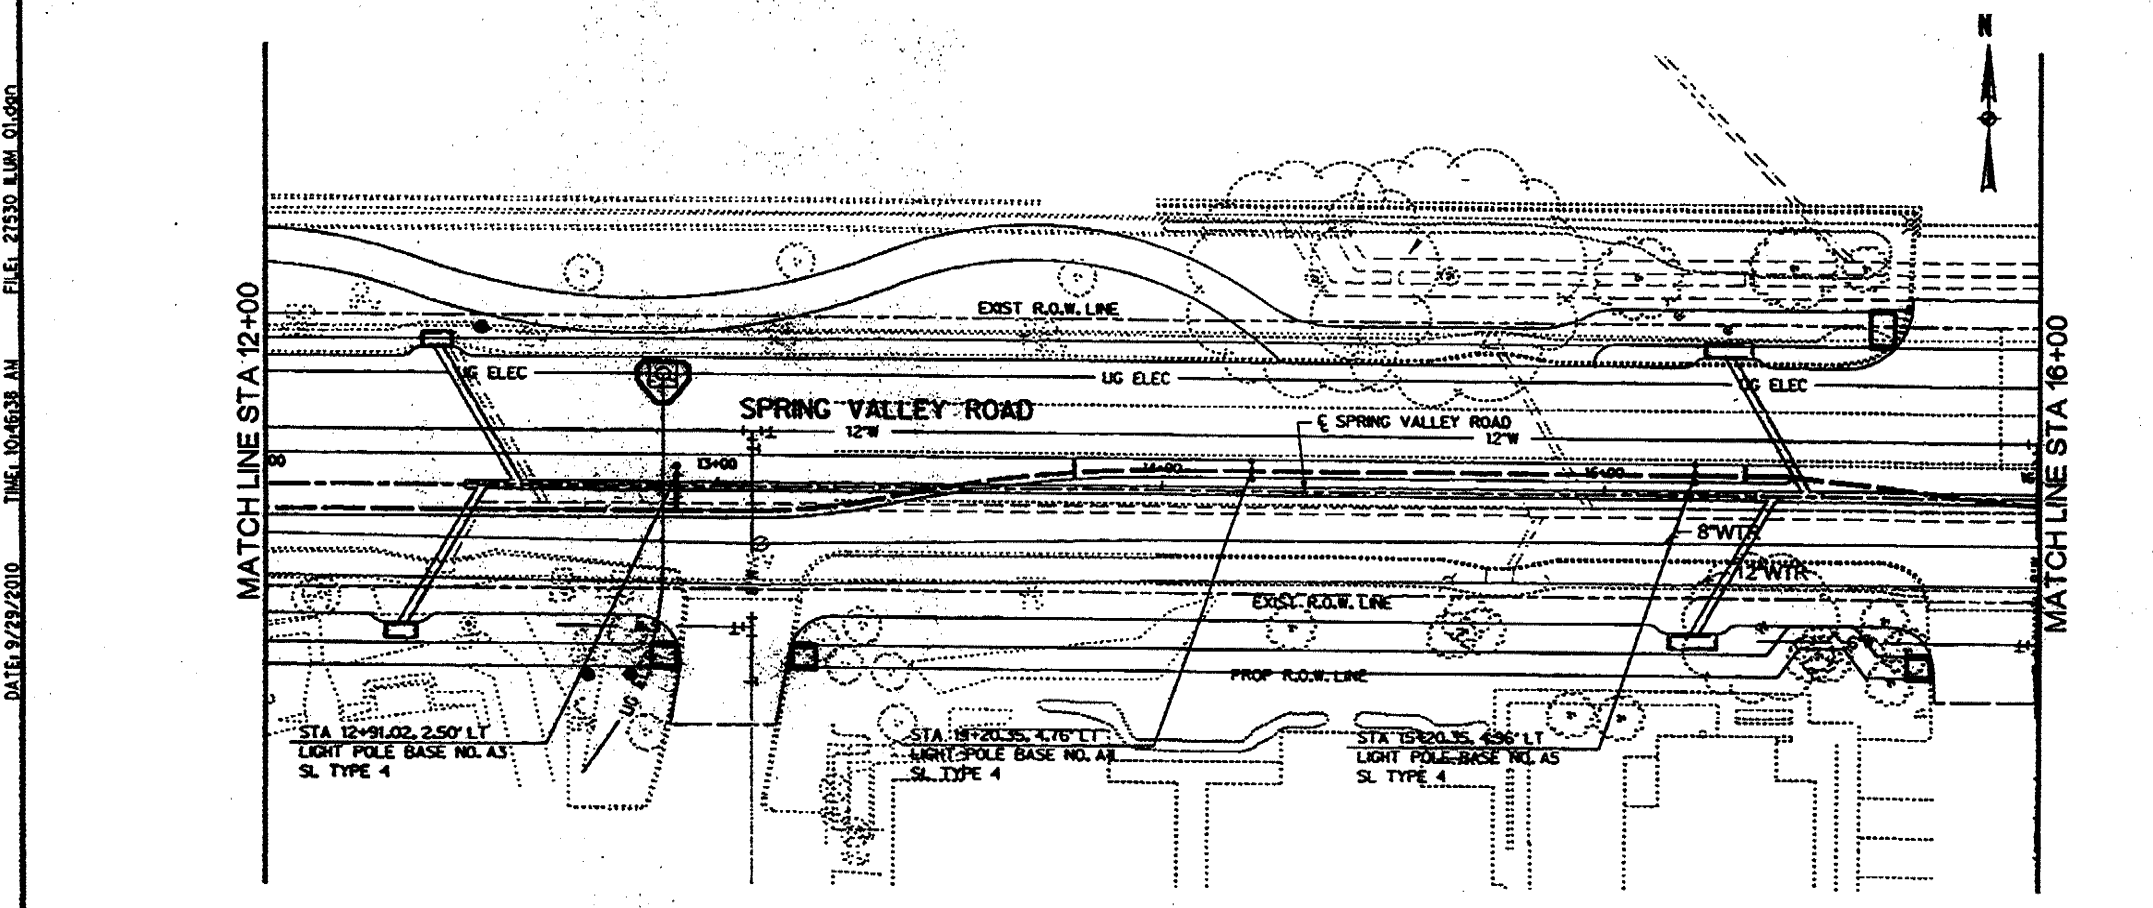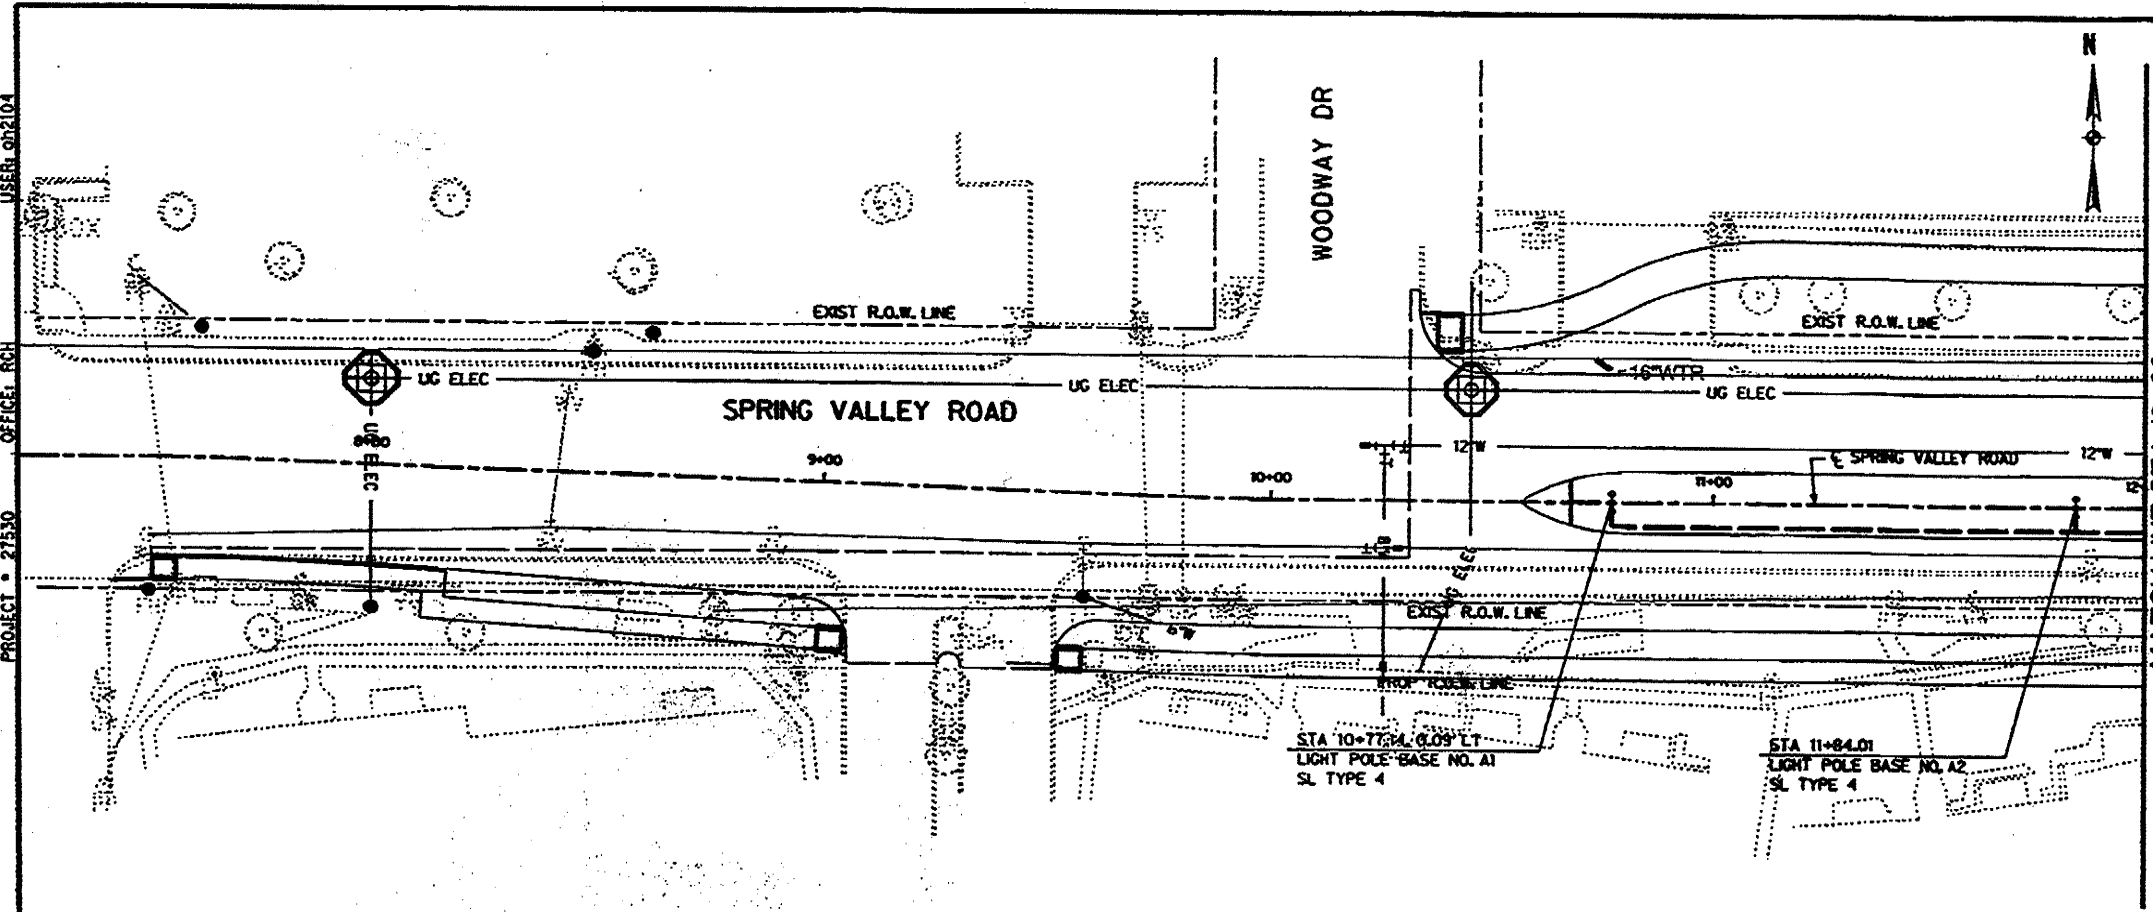

STREET LIGHTING & CONDUIT NOTES

1. REFER TO "GENERAL NOTES" FOR THE GENERAL CONSTRUCTION NOTES FOR THE PROJECT
2. REFER TO SHEET XX FOR ELECTRIC DETAILS - CONDUIT RIGID METAL CONDUIT ELBOWS ARE NOT REQUIRED.
3. REFER TO SHEET XX FOR ELECTRIC DETAILS - CONDUCTORS
4. REFER TO SHEET XX FOR ELECTRIC DETAILS - GROUND BOXES, RIGID METAL CONDUIT ELBOS ARE NOT REQUIRED, CONCRETE APRON IS NOT REQUIRED
5. REFER TO SHEET XX FOR ELECTRIC DETAILS - SERVICE ENCLOSURE & NOTES, ELECTRICAL SERVICE TYPE D
6. REFER TO SHEET XX FOR ELECTRIC DETAILS - ELECTRICAL SERVICE SUPPORT PEDestal TYPE PS, PEDestal SERVICE SHALL BE ALUMINUM, COLOR FINE GREEN, RIGID ELBOWS ARE NOT REQUIRED.
7. WATER, SANITARY SEWER, AND STORM DRAIN LINES ARE SHOWN FOR REFERENCE ONLY. CONTRACTOR SHALL LOCATE ALL UTILITY LINES IN THE AREA PRIOR TO DIGGING.
8. INSTALL SCHEDULE 40 PVC UNDERGROUND (24" MIN COVER), ALL STREET AND DRIVEWAY CROSSINGS (30" MIN COVER), ALL BENDS TO LONG RADIUS.
9. ALL CONDUIT POLE BASES TO BE WITHIN THE DRILLED SHAFT FOUNDATION. NO EXPOSED CONDUIT AT POLE BASES WILL BE ALLOWED.
10. SL TYPE 1 - SINGLE 100W 240V MH LUMINAIRE ON 11'-8" POLE, COLOR SILVER - REFERENCE SPECIAL PROVISIONS
- SL TYPE 2 - TWIN 100W 240V MH LUMINAIRE ON 11'-8" POLE, COLOR SILVER - REFERENCE SPECIAL PROVISIONS
- SL TYPE 3 - SINGLE 400W 240V MH LUMINAIRE ON 30' POLE, COLOR SILVER - REFERENCE SPECIAL PROVISIONS
- SL TYPE 4 - TWIN 400W 240V MH LUMINAIRE ON 30' POLE, COLOR SILVER - REFERENCE SPECIAL PROVISIONS
- SL TYPE 5 - BR 12-57 TOW 120V TREE UPLIGHT RECESSED IN GRADE REFERENCE SPECIAL PROVISIONS
11. CONNECTION TO POWER COMPANY CIRCUITS TO BE MADE ONLY BY POWER COMPANY.
12. UNLESS OTHERWISE INDICATED ALL WORK SHALL CONFORM TO THE 2008 NATIONAL ELECTRICAL CODE (NFPA 70) AND THE 2007 NATIONAL ELECTRICAL SAFETY CODE (ANSI Z22).
13. ALL EMPTY CONDUIT INSTALLED FOR FUTURE EXTENSION SHALL BE TURNED UP AND EXTENDED UP TO FINISH GRADE. CAP ENDS OF ALL CONDUITS.



Daniel C. ...
10/1/2010

NO.	REVISIONS	DATE
LIGHT FIXTURE LAYOUT STA 7+49.89 TO STA 16+00		

C&P ENGINEERING, LTD.
1804 Gurney Blvd. 972.444.2800
Suite 101 Fax: 972.444.2817
Richardson, Texas 75080 www.cpeengineering.com
Texas Reg. No. F-3185

C&P	6/10	1'-20'	100SS	10-1
-----	------	--------	-------	------

USER# 092104


OFFICE# RCH

PROJECT # 21930

FILE# 21930 ILM 02.dwg

TIME 10:47:13 AM

DATE 9/29/2010

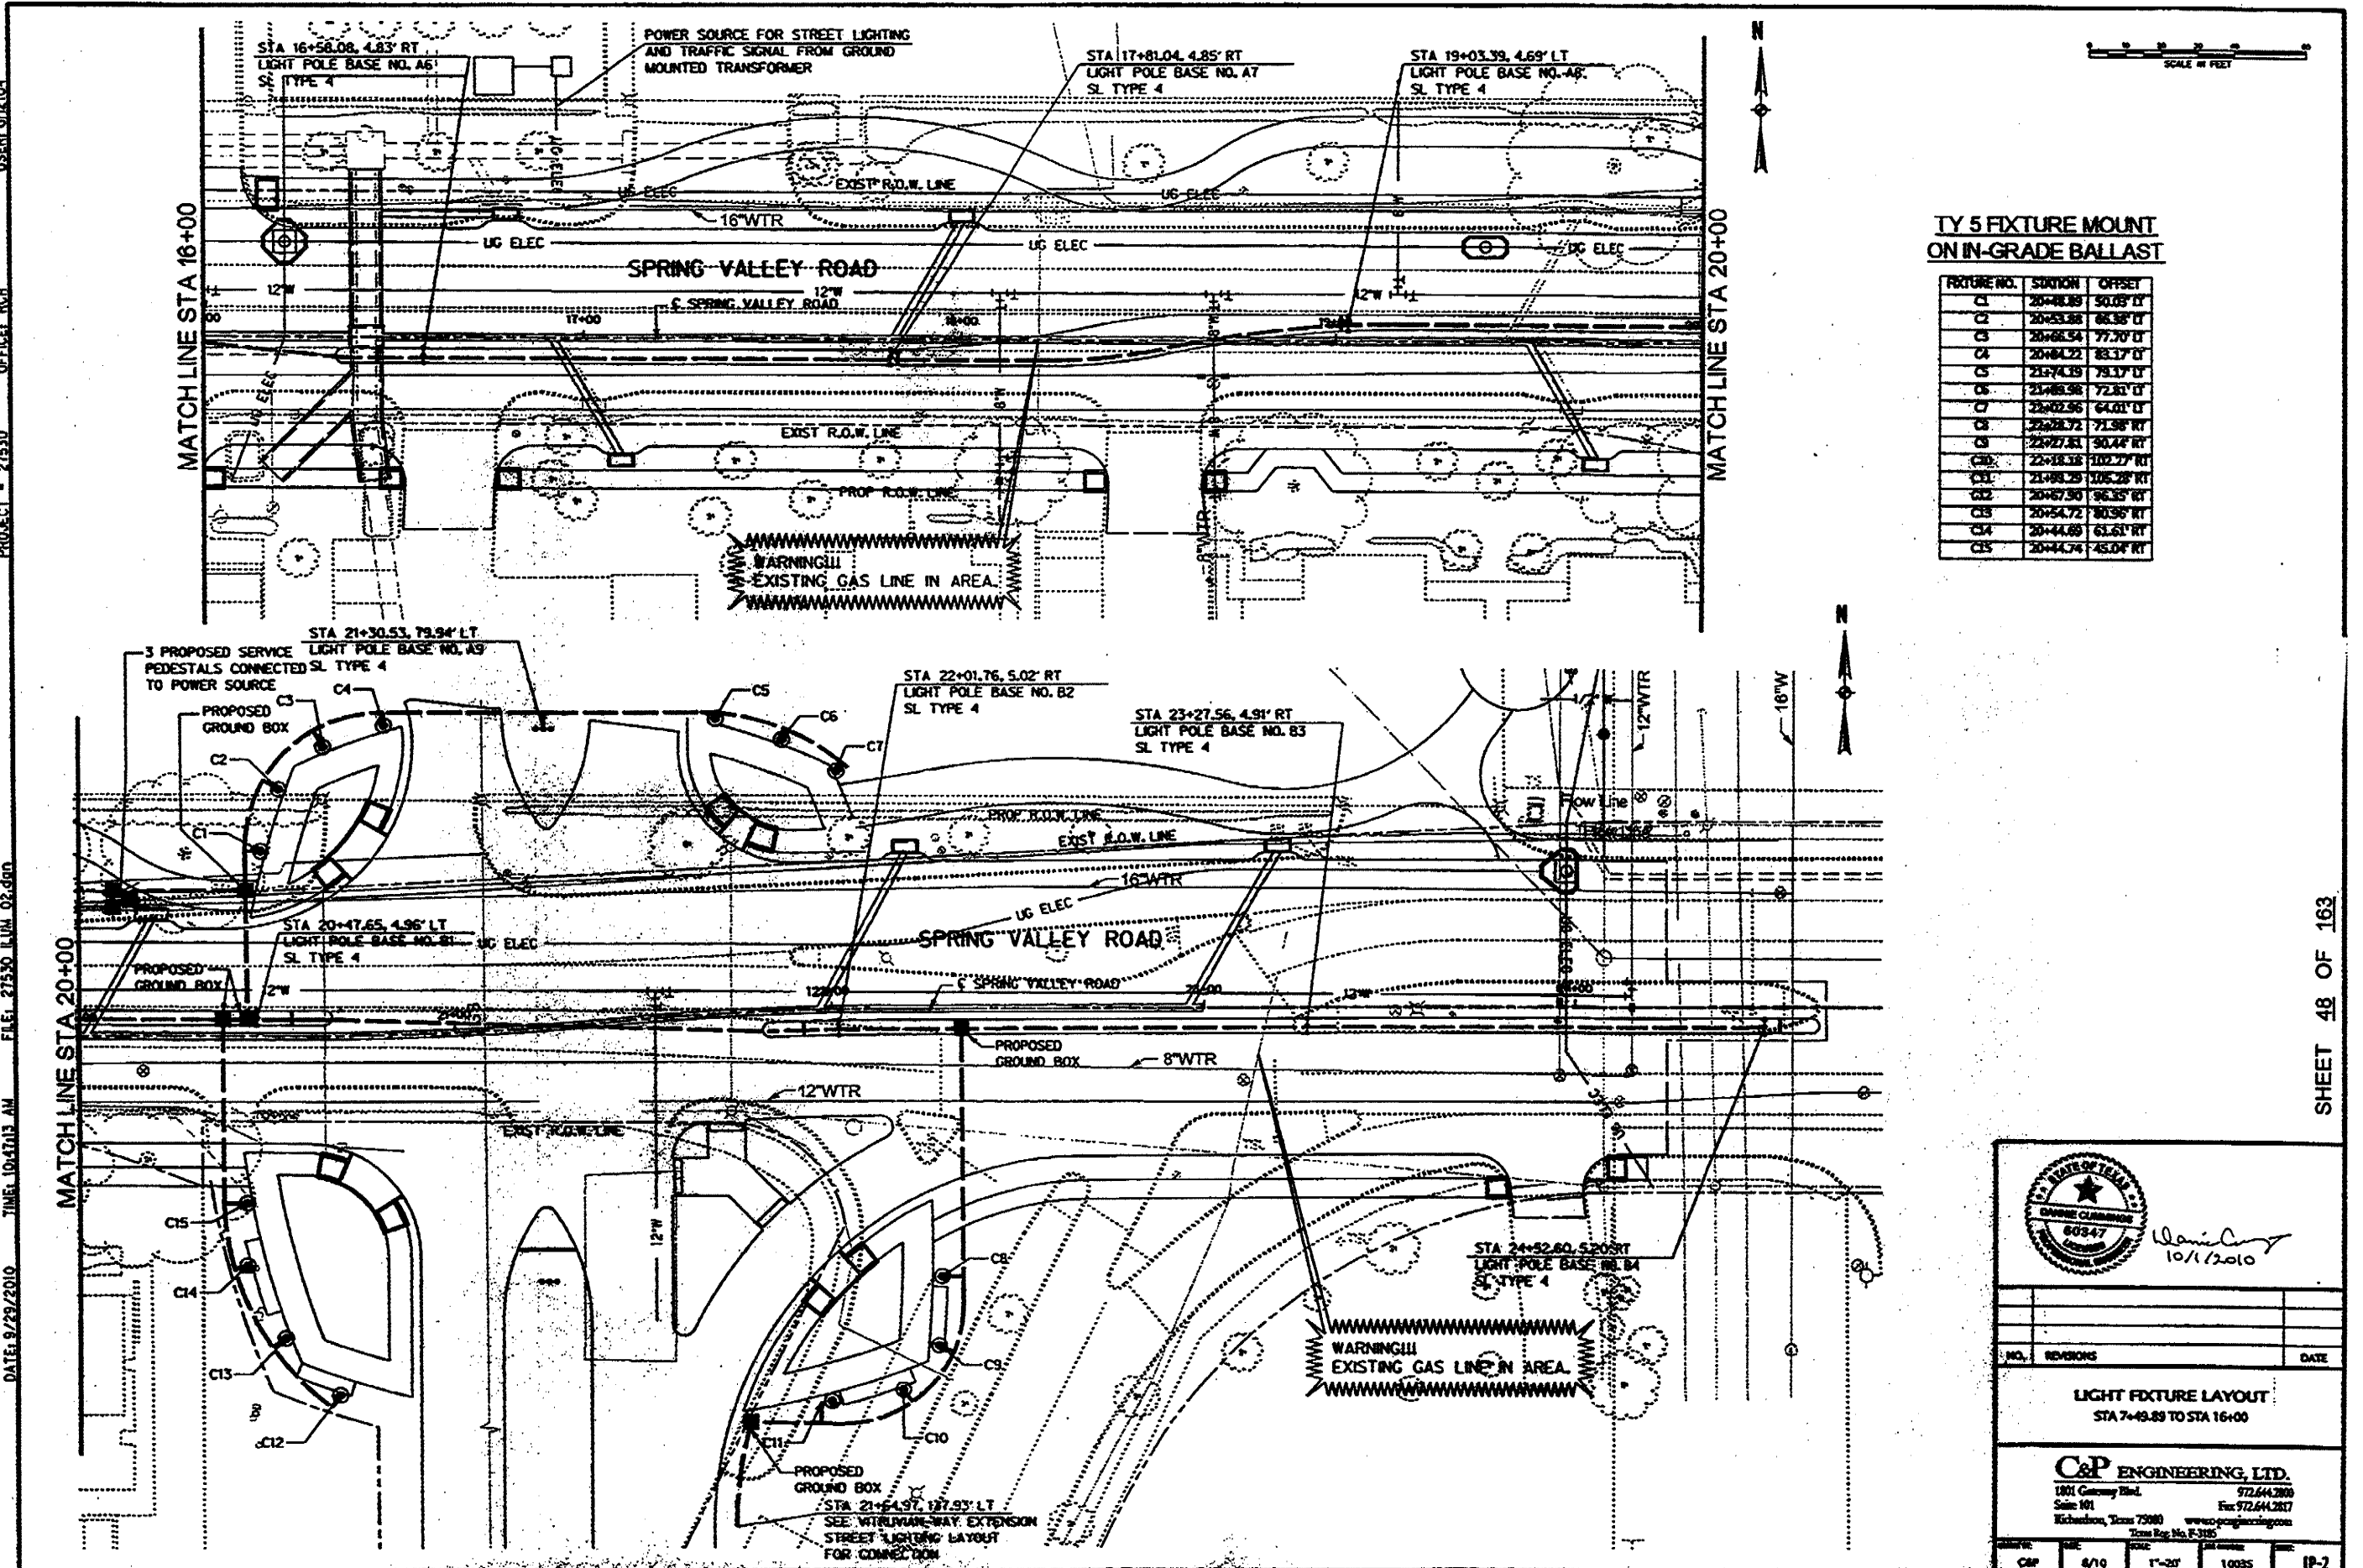

**TY 5 FIXTURE MOUNT
ON IN-GRADE BALLAST**

FIXTURE NO.	SOUTH	OFFSET
C1	20+48.89	50.09' LT
C2	20+53.88	65.38' LT
C3	20+68.94	77.70' LT
C4	20+84.22	83.17' LT
C5	21+74.19	79.17' LT
C6	21+88.98	72.81' LT
C7	22+02.96	64.01' LT
C8	22+28.72	71.98' RT
C9	22+27.81	90.44' RT
C10	22+18.38	102.27' RT
C11	21+98.29	105.28' RT
C12	20+87.90	95.85' RT
C13	20+54.72	80.96' RT
C14	20+44.69	61.61' RT
C15	20+44.74	45.04' RT

W. C. Perry
10/1/2010

NO.	REVISIONS	DATE

LIGHT FIXTURE LAYOUT
STA 7+49.89 TO STA 16+00

C&P ENGINEERING, LTD.
1801 Gateway Blvd. 972.644.2800
Suite 101 Fax 972.644.2817
Richardson, Texas 75080 www.candpengineering.com
Texas Reg. No. F-3185

DATE	FILE	SCALE	PLANT	SHEET
C&P	4/10	1"=20'	10085	1P-2


SHEET 48 OF 163



**STRING 1 WIRING
FIXTURES A1 - A9**
IN CONDUIT RUNS:
2 #6 AWG XHHW
1 #6 AWG NEUTRAL
1 #6 AWG BARE
IN POLES:
2 #12 AWG THHN


**STRING 2 WIRING
FIXTURES B1 - B11**
IN CONDUIT RUNS:
2 #6 AWG XHHW
1 #6 AWG NEUTRAL
1 #6 AWG BARE
IN POLES:
2 #12 AWG THHN

**STRING 3 WIRING
FIXTURES C1 - C15**
IN CONDUIT RUNS:
2 #6 AWG XHHW
1 #6 AWG NEUTRAL
1 #6 AWG BARE
IN POLES:
2 #12 AWG THHN

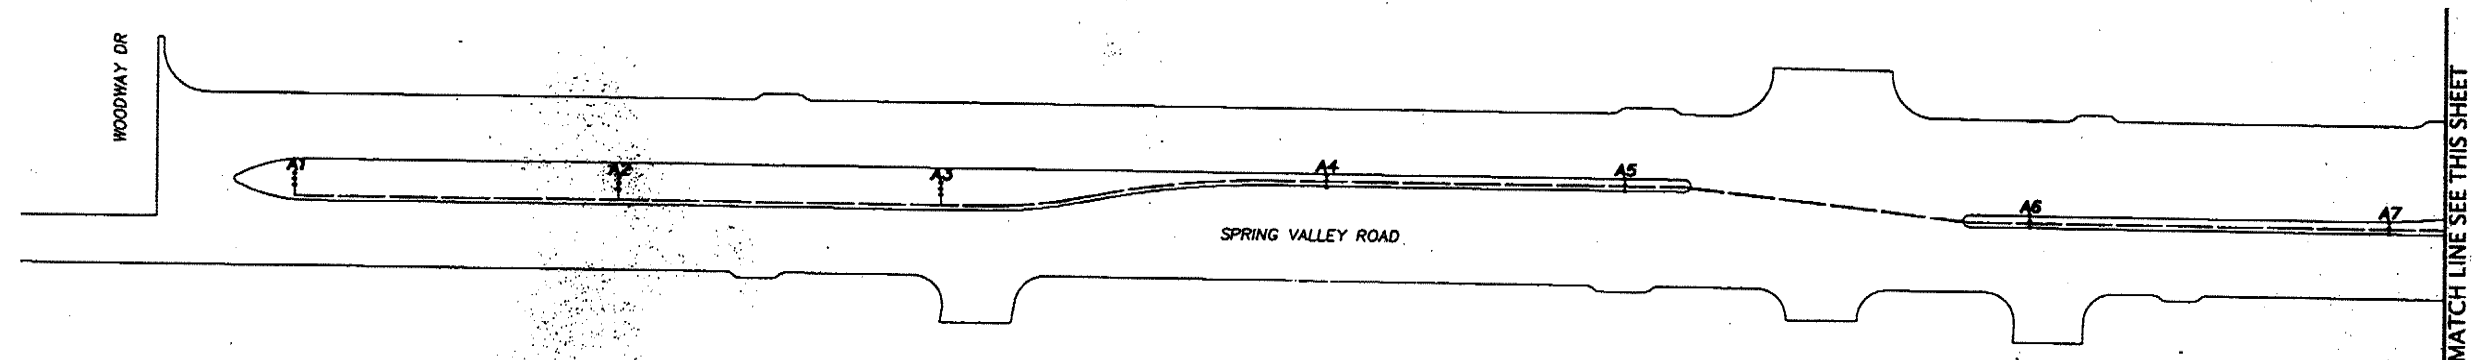

FIXTURES	WATTAGE	VOLTAGE
A1 - A9	400	240
B1 - B4	400	240
B5 - B11	100	240
C1 - C15	70	120

INSTALL THREE SERVICE PEDESTALS IN SW CORNER OF SPRING VALLEY AND VITRUVIAN - ONE SERVICE PEDESTAL FOR EACH OF THE THREE STRINGS. THESE SERVICE PEDESTALS TO SATISFY REQUIREMENTS OF TxDOT TYPE 'D' ELECTRICAL PEDESTAL SERVICE.

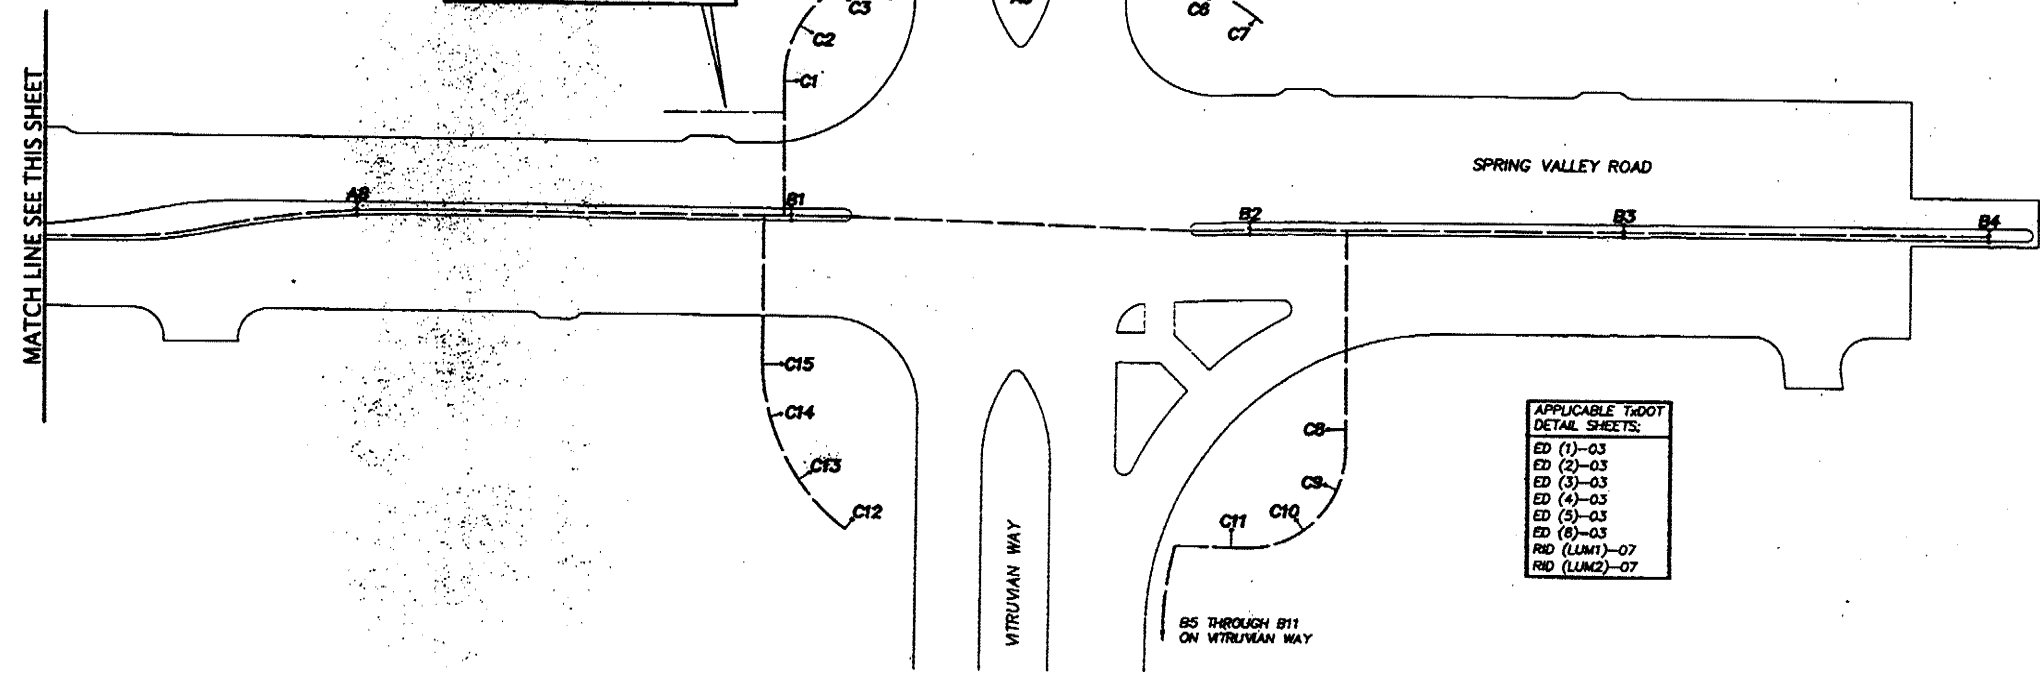

APPLICABLE TxDOT
DETAIL SHEETS:

ED (1)-03
ED (2)-03
ED (3)-03
ED (4)-03
ED (5)-03
ED (6)-03
RFD (LUM1)-07
RFD (LUM2)-07

The seal appearing on this document was authorized by Danne Cummings, P.E. 87930. Alteration of a sealed document without proper notification to the responsible engineer is an offense under the Texas Engineering Practice Act.
Danne Cummings 10/1/2010





NO.	REVISIONS	DATE

ILLUMINATION PLANS
STA 16+00 TO STA 26+11.52
SPRING VALLEY ROAD

C&P ENGINEERING, LTD.
1801 Gateway Blvd. 972.644.2800
Suite 101 Fax 972.644.2817
Richardson, Texas 75080 www.c-p-engineering.com
Texas Reg. No. P-3185

DRAWN BY:	DATE:	SCALE:	JOB NUMBER:	SHEET:
CAP	8/10	1"=30'	10035	IP-3


USER: oh1299
 OFFICE: RCH
 PROJECT: 27530
 FILE: 27530 UELE 01 (REV 1).dgn
 DATE: 12/7/2011
 TIME: 10:28:58 AM

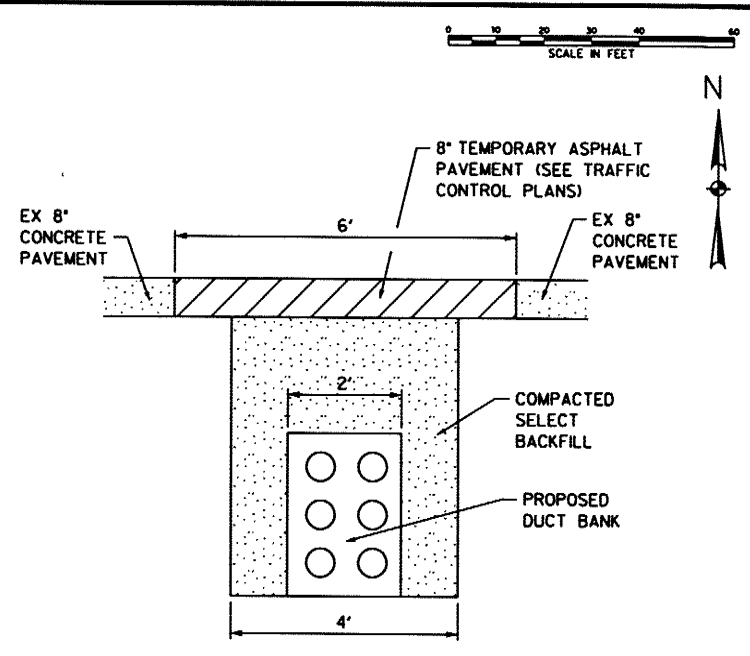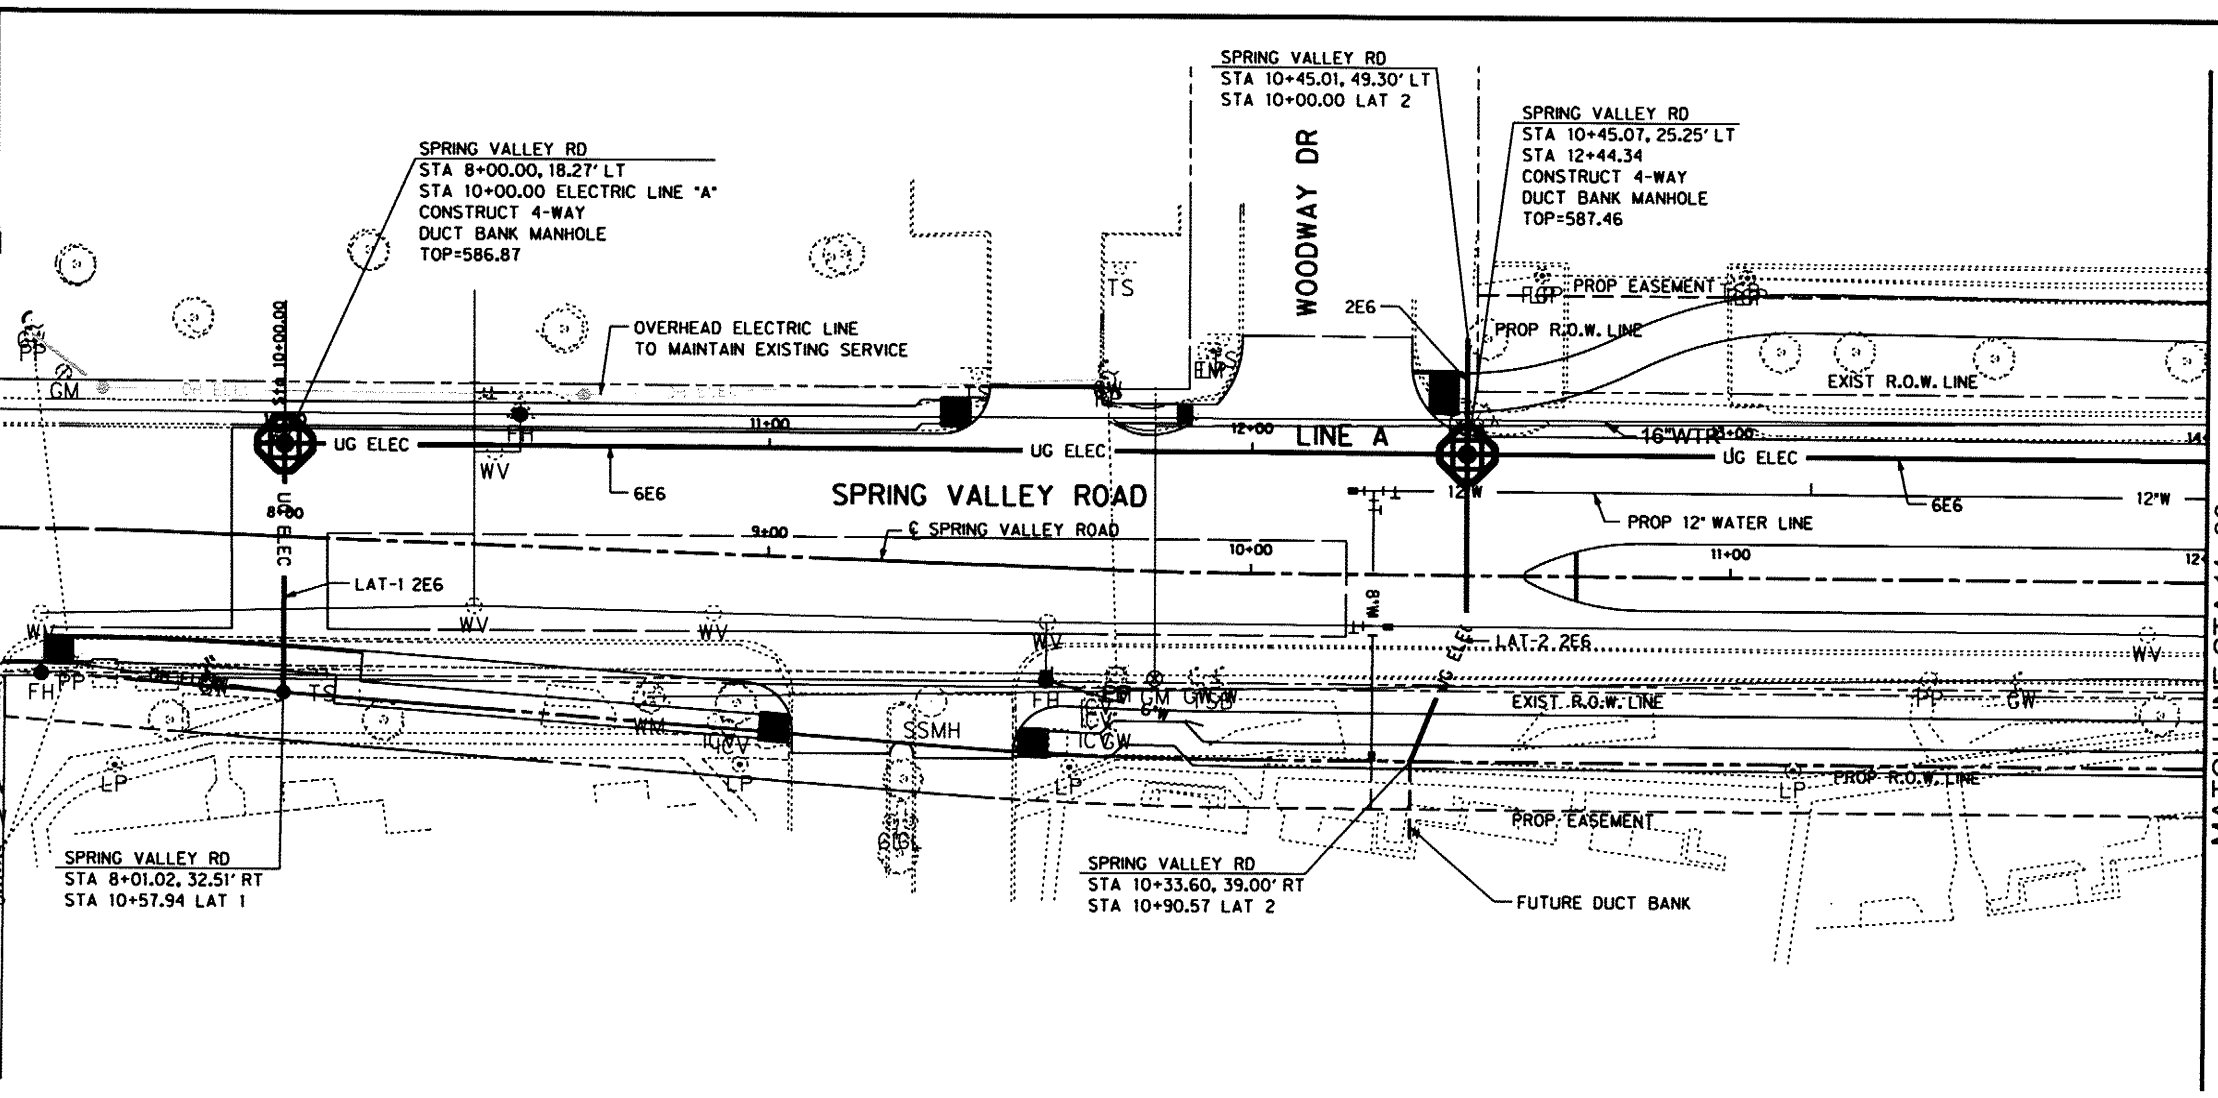

DUCT BANK TRENCH DETAIL
 N.T.S.

* CONTRACTOR TO FIELD VERIFY LOCATION OF GAS LINE COORDINATE WITH ATMOS TO RESOLVE CONFLICTS.

RECORD DOCUMENTS
 December, 2011
 These Record Documents have been prepared based upon information provided by North Texas Contracting, Inc. The Design Professional has not verified the accuracy and / or completeness of this information and shall not be responsible for any errors or omissions which may be incorporated herein as a result
 Design Consultant: Half Associates, Inc.
 RECORD DRAWING SUBMITTAL

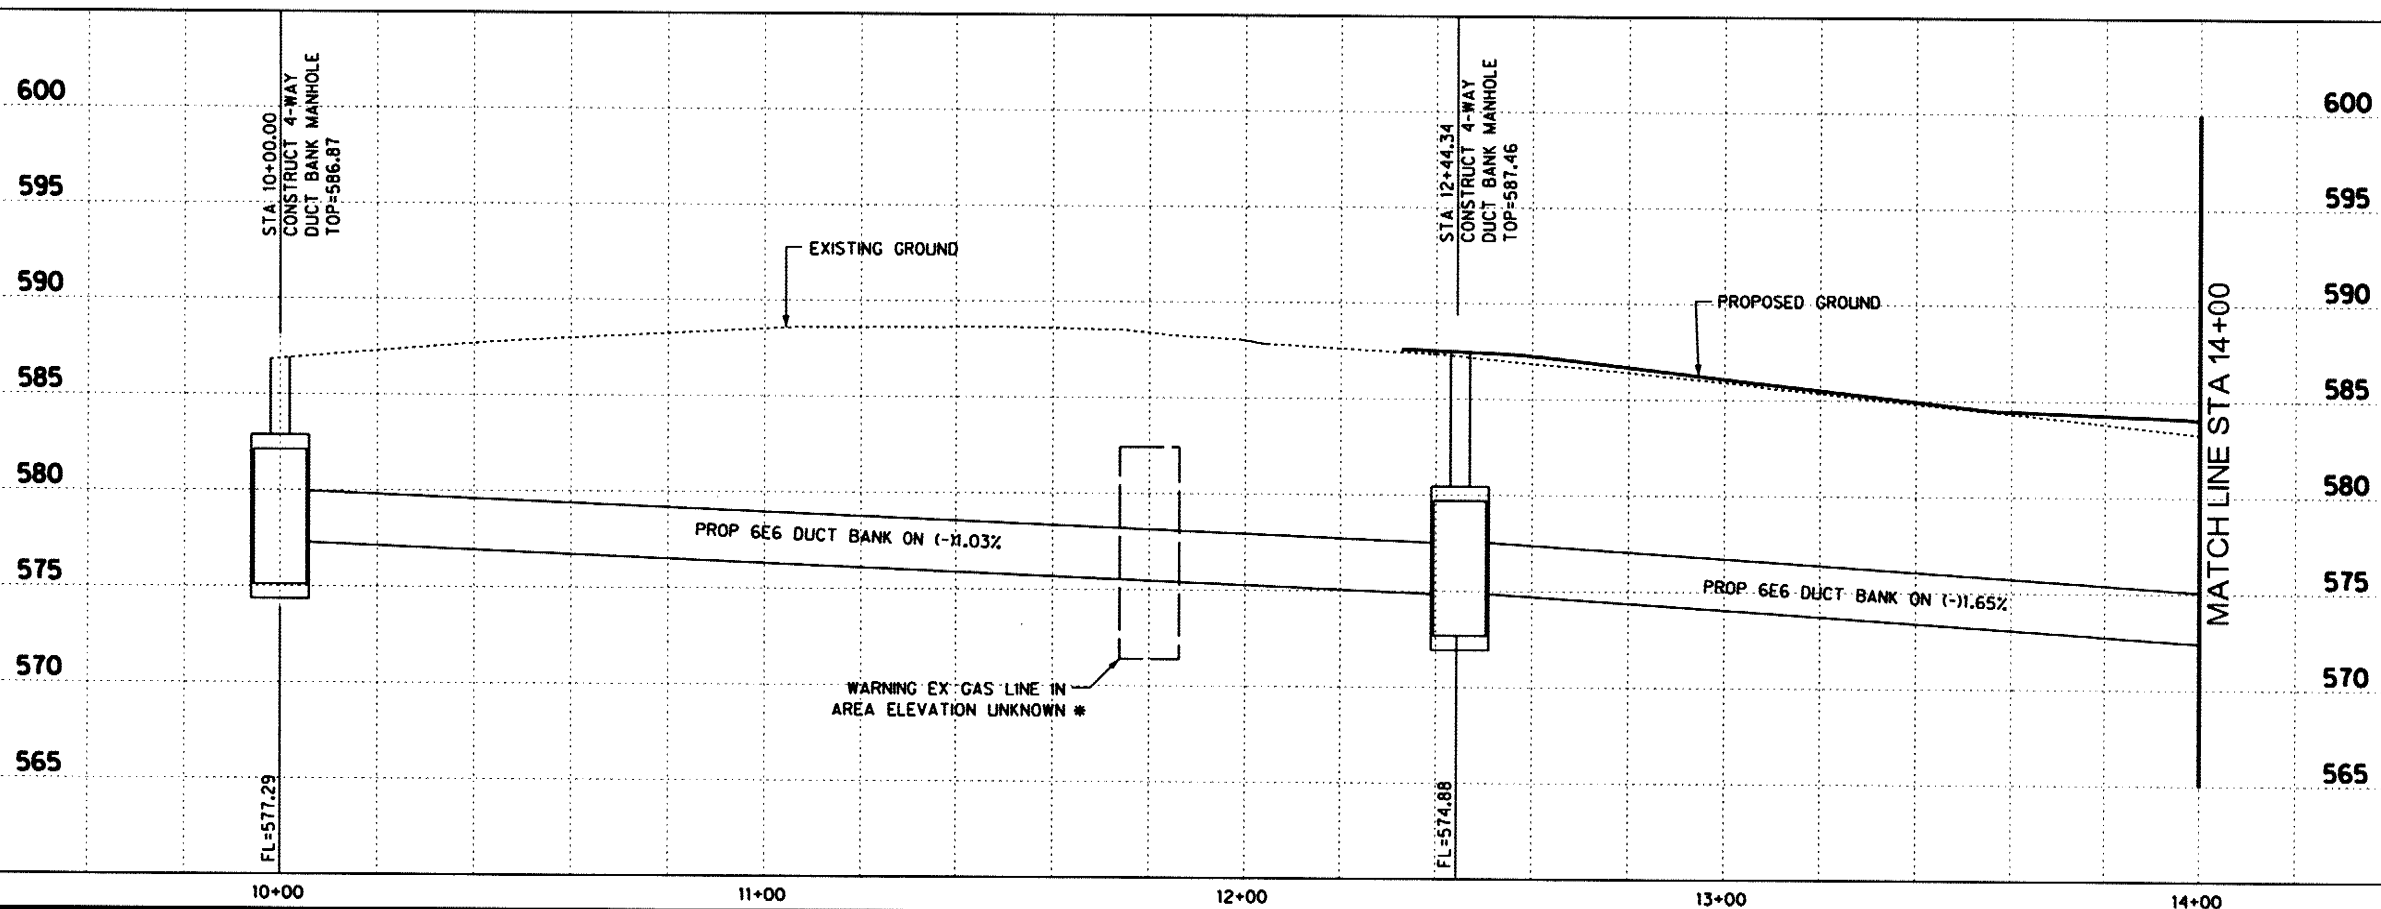

[Signature]
 Signature of Registrant
[Signature]
 Date

NO.	REVISION	BY	DATE
<p><i>[Signature]</i> TOWN OF ADDISON DALLAS COUNTY, TEXAS</p> <p>SPRING VALLEY ROAD</p> <p>DUCT BANK PLAN AND PROFILE STA 10+00 TO 14+00</p> <p>HALFF 1201 NORTH BOWSER ROAD, RICHARDSON, TEXAS 75081-2275 TEL (214) 348-8200 FAX (214) 738-0095</p>			
PROJECT	DESIGN	DRAWN	DATE
27530	MPB	TMM	OCTOBER 2010
FILE	SHEET		
27530 UELE 01	ELE-1		

SHEET 50 OF 163
 RECORD DRAWINGS

USER: dh1299




OFFICE: RCH

PROJECT: 27530

FILE: 27530 UELE 02.dgn

TIME: 10:29:16 AM

DATE: 12/7/2011

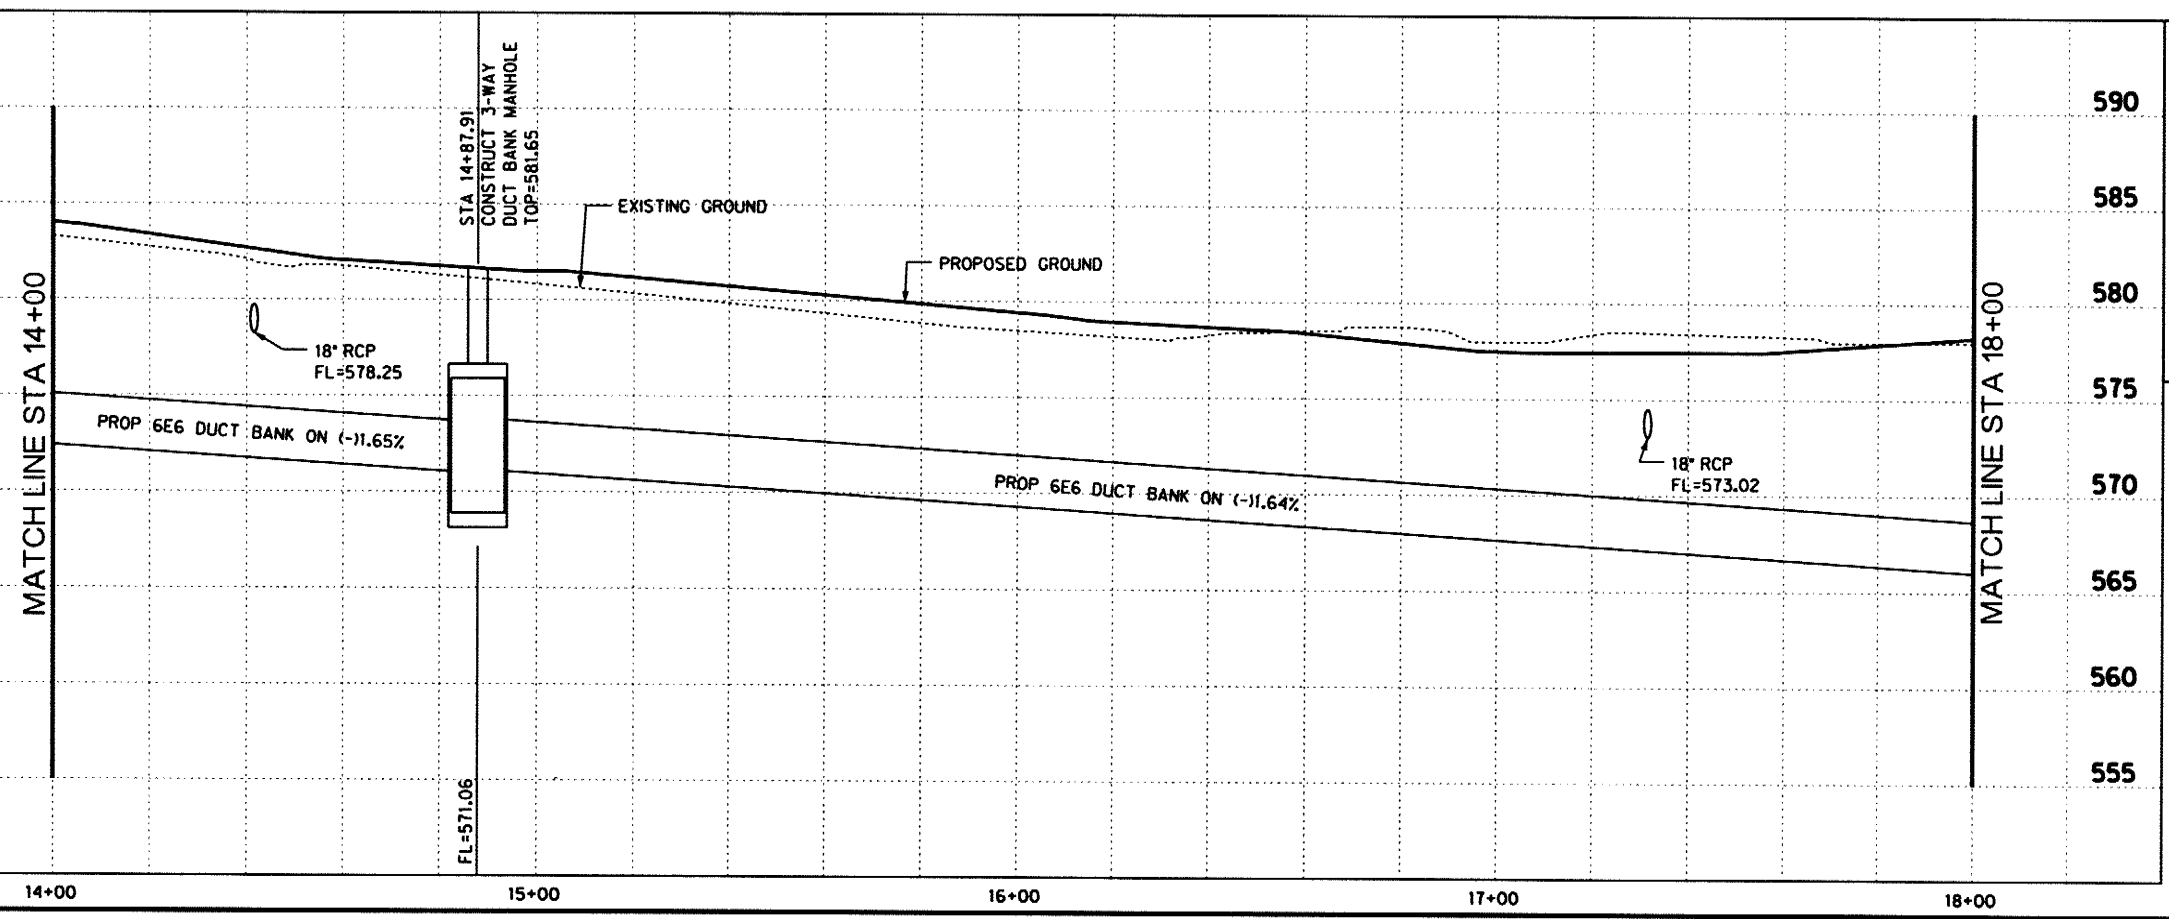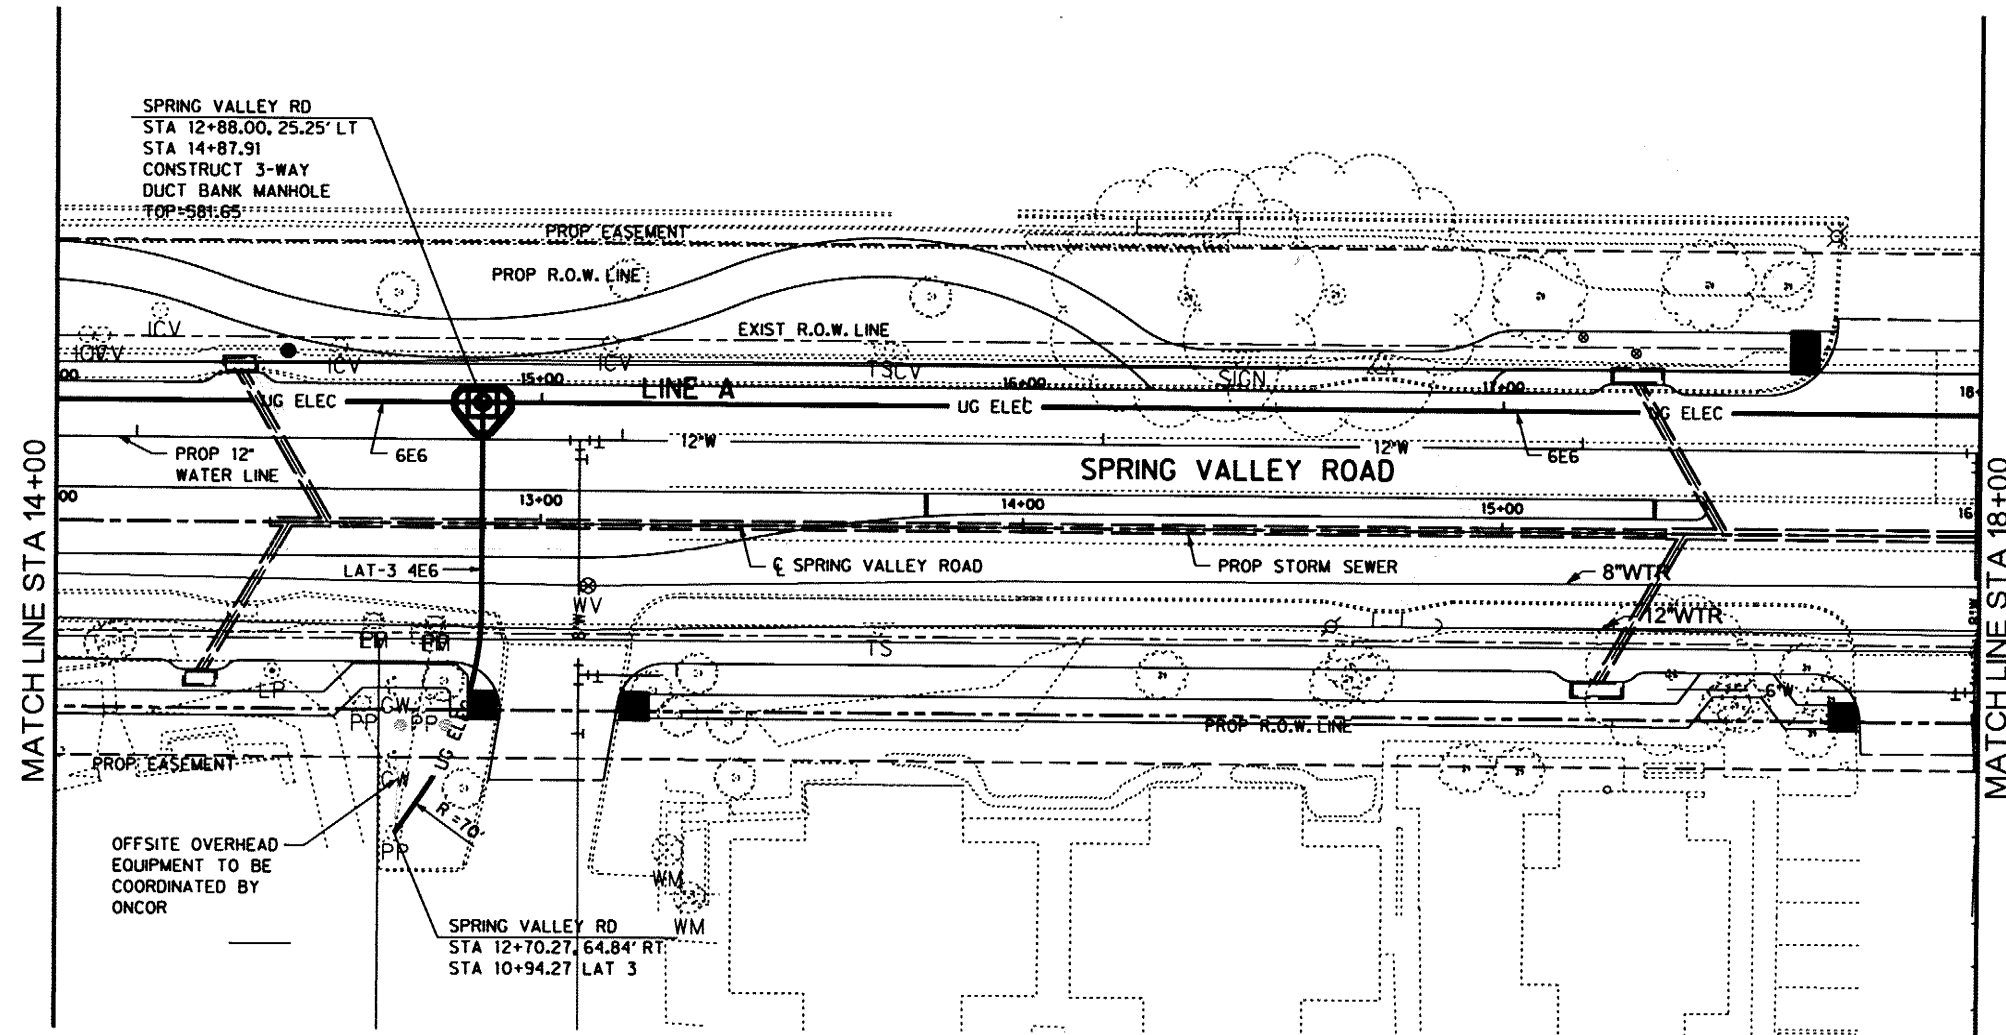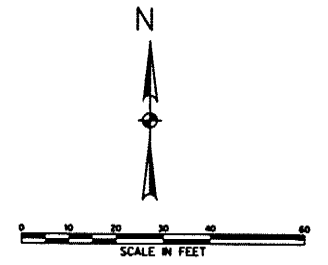

RECORD DOCUMENTS
 December, 2011
 These Record Documents have been prepared based upon information provided by North Texas Contracting, Inc. The Design Professional has not verified the accuracy and / or completeness of this information and shall not be responsible for any errors or omissions which may be incorporated herein as a result.

Design Consultant: Half Associates, Inc.
 RECORD DRAWING SUBMITTAL

Signature of Registrant: *M.E. Romanowski* Date: 12/8/2011

NO.	REVISION	BY	DATE

Addison TOWN OF ADDISON
 DALLAS COUNTY, TEXAS

SPRING VALLEY ROAD

DUCT BANK PLAN AND PROFILE
 STA 14+00 TO 18+00



HALFF 1201 NORTH BOWSER ROAD, RICHARDSON, TEXAS 75081-2275
 TEL (214) 346-4200 FAX (214) 738-0095

PROJECT	DESIGN	DRAWN	DATE	FILE	SHEET
27530	MPB	TMM	OCTOBER 2010	27530 UELE 02	ELE-2

SHEET 51 OF 163

RECORD DRAWINGS


USER: gh1299
 OFFICE: RCH
 PROJECT: 27530
 DATE: 12/7/2011
 TIME: 10:29:37 AM
 FILE: 27530 UELE 03.dgn

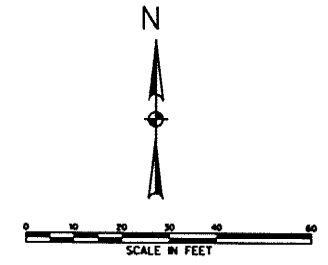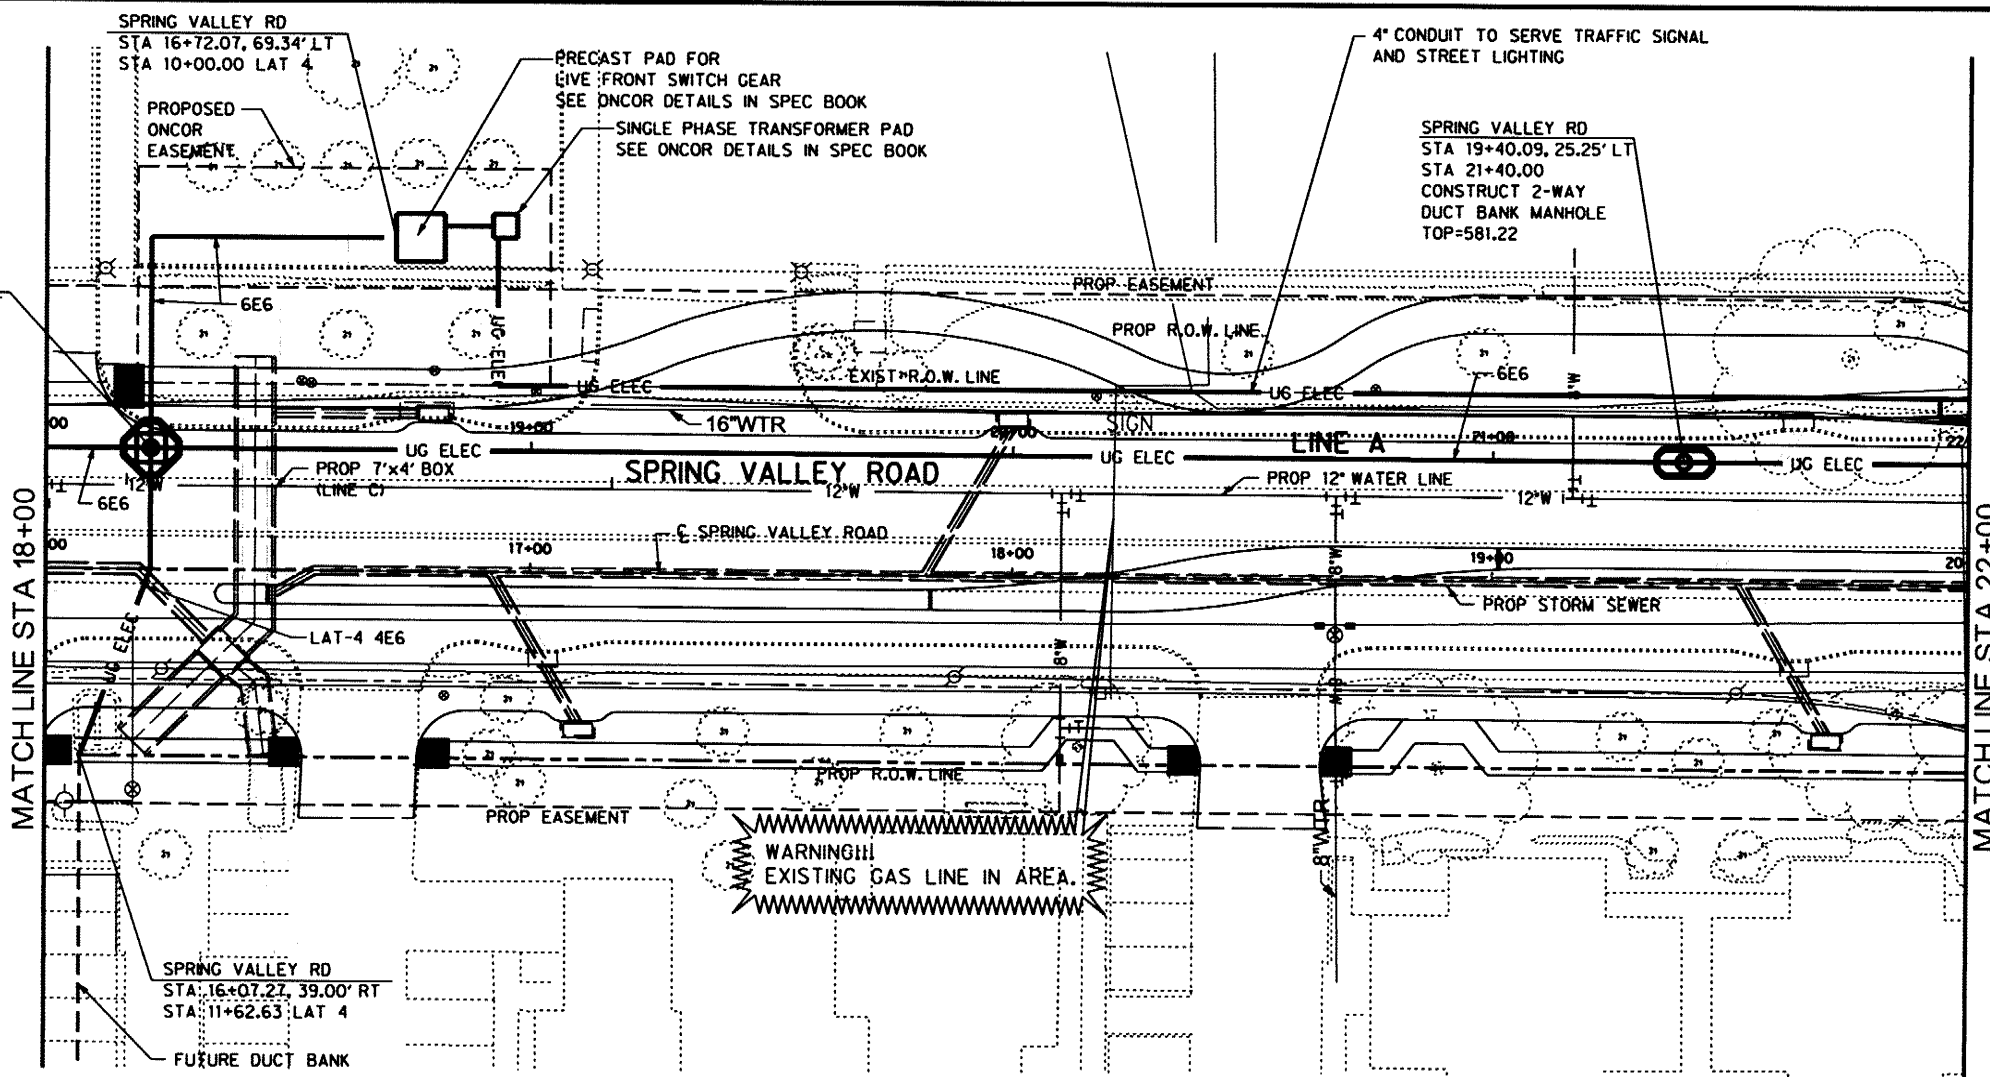

* CONTRACTOR TO FIELD VERIFY LOCATION OF GAS LINE COORDINATE WITH ATMOS TO RESOLVE CONFLICTS.

RECORD DOCUMENTS
 December, 2011
 These Record Documents have been prepared based upon information provided by North Texas Contracting, Inc. The Design Professional has not verified the accuracy and / or completeness of this information and shall not be responsible for any errors or omissions which may be incorporated herein as a result
 Design Consultant: Half Associates, Inc.
 RECORD DRAWING SUBMITTAL

SHEET 52 OF 163

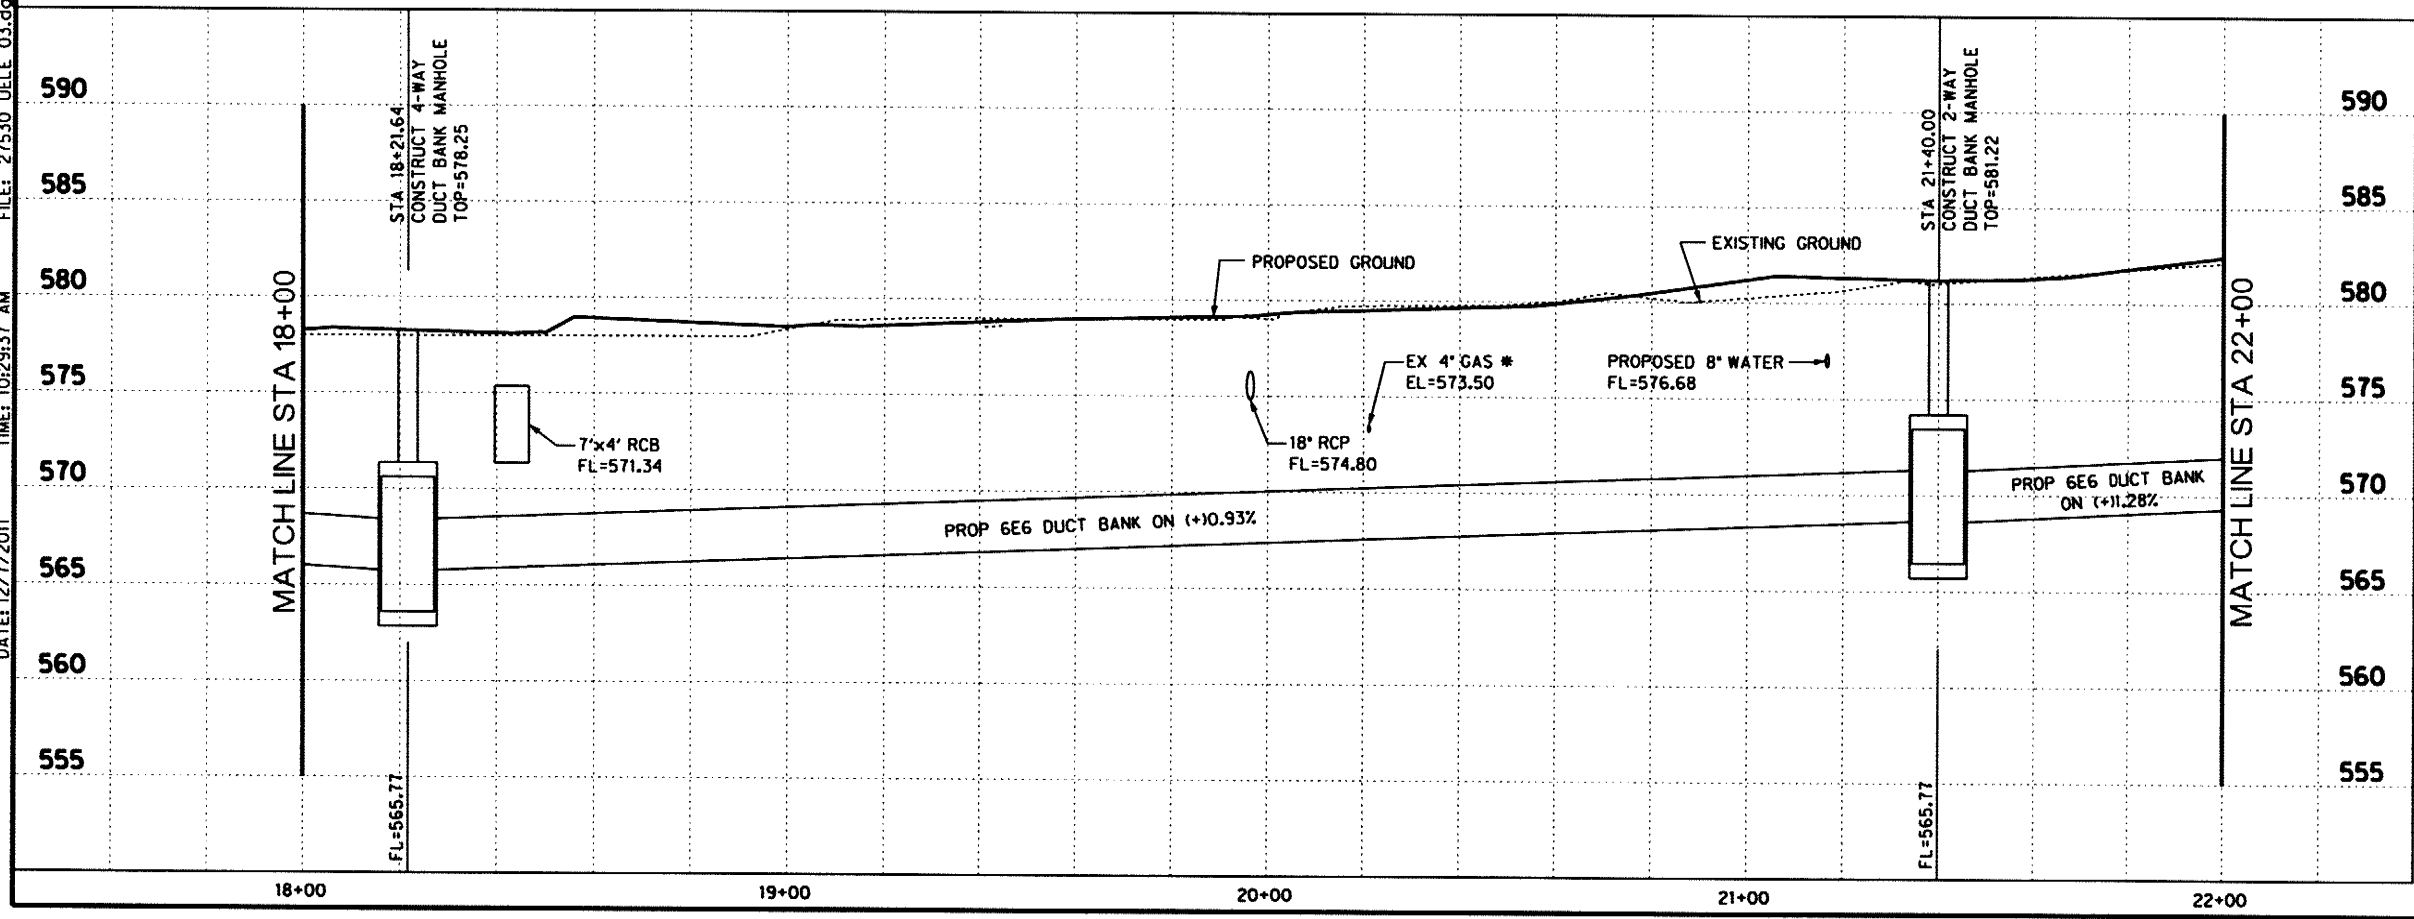


[Signature]
 Signature of Registrant
 M.E. ROMANOWSKI
 P.E.
 12/5/2011
 Date


NO.	REVISION	BY	DATE
<p><i>Addison</i> TOWN OF ADDISON DALLAS COUNTY, TEXAS</p> <p>SPRING VALLEY ROAD</p> <p>DUCT BANK PLAN AND PROFILE STA 18+00 TO 22+00</p> <p>HALFF 1201 NORTH BOWSER ROAD, RICHARDSON, TEXAS 75081-2275 TEL (214) 346-6200 FAX (214) 730-0055</p>			
PROJECT	DESIGN	DRAWN	DATE
27530	MPB	TMM	OCTOBER 2010
FILE	SHEET		
27530 UELE 03	ELE-3		

RECORD DRAWINGS

USER: gh1299
 OFFICE: RCH
 PROJECT: 27530
 FILE: 27530 UELE 04 (REV 1).dgn
 DATE: 12/7/2011
 TIME: 10:29:53 AM

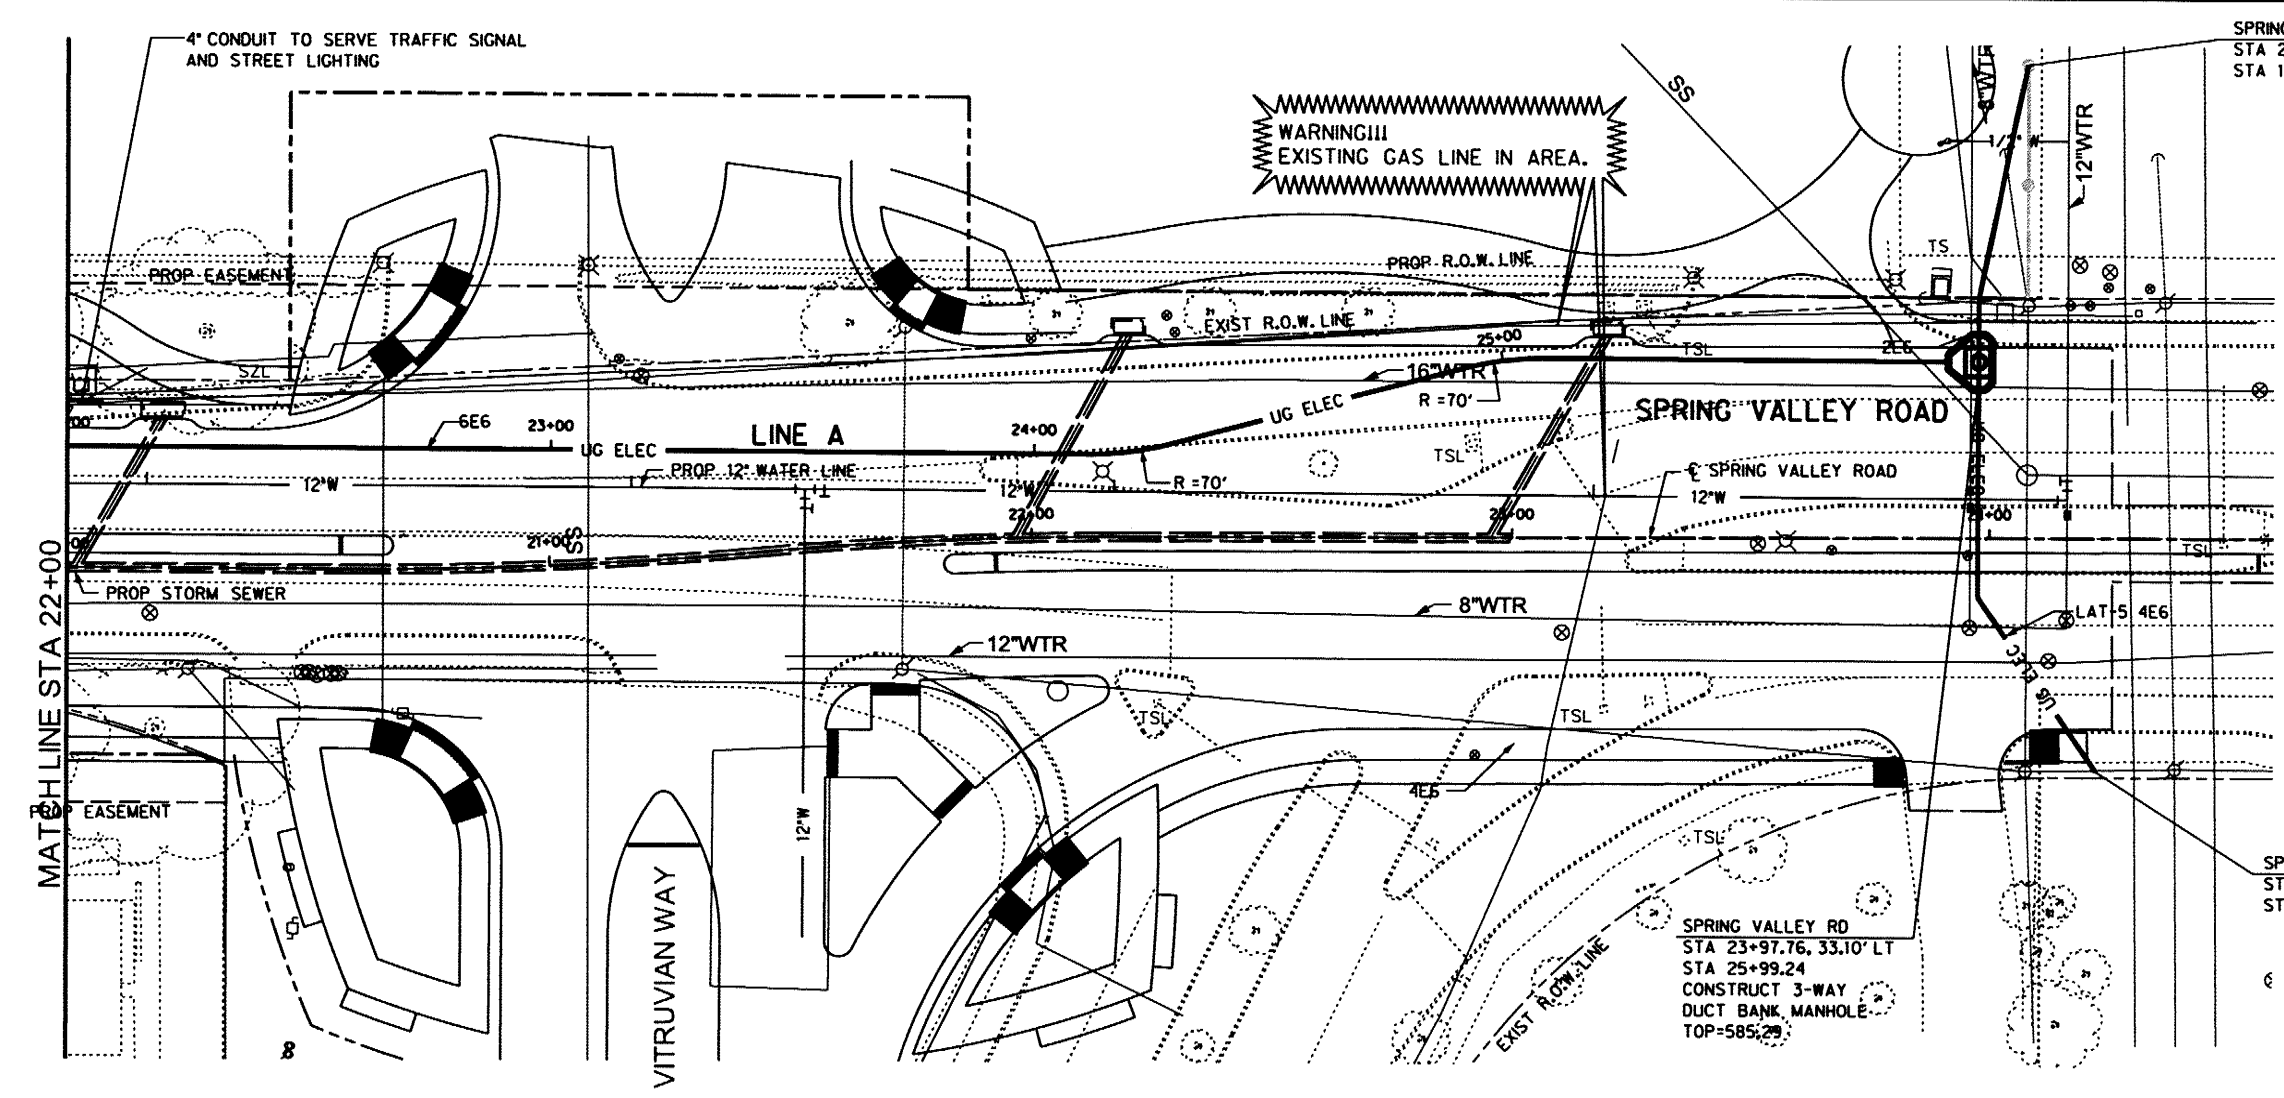

SPRING VALLEY RD
 STA 24+08.17, 98.38' LT
 STA 10+00.00 LAT 5

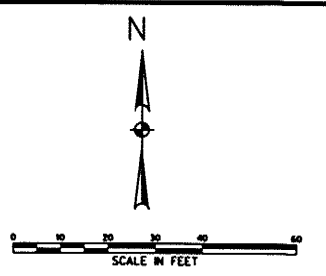


* CONTRACTOR TO FIELD VERIFY LOCATION OF GAS LINE COORDINATE WITH ATMOS TO RESOLVE CONFLICTS.

SPRING VALLEY RD
 STA 24+22.27, 48.72' RT
 STA 11+55.89 LAT 5

SPRING VALLEY RD
 STA 23+97.76, 33.10' LT
 STA 25+99.24
 CONSTRUCT 3-WAY DUCT BANK MANHOLE
 TOP=585.29

RECORD DOCUMENTS
 December, 2011
 These Record Documents have been prepared based upon information provided by North Texas Contracting, Inc. The Design Professional has not verified the accuracy and / or completeness of this information and shall not be responsible for any errors or omissions which may be incorporated herein as a result
 Design Consultant: Half Associates, Inc.
 RECORD DRAWING SUBMITTAL

SHEET 53 OF 163

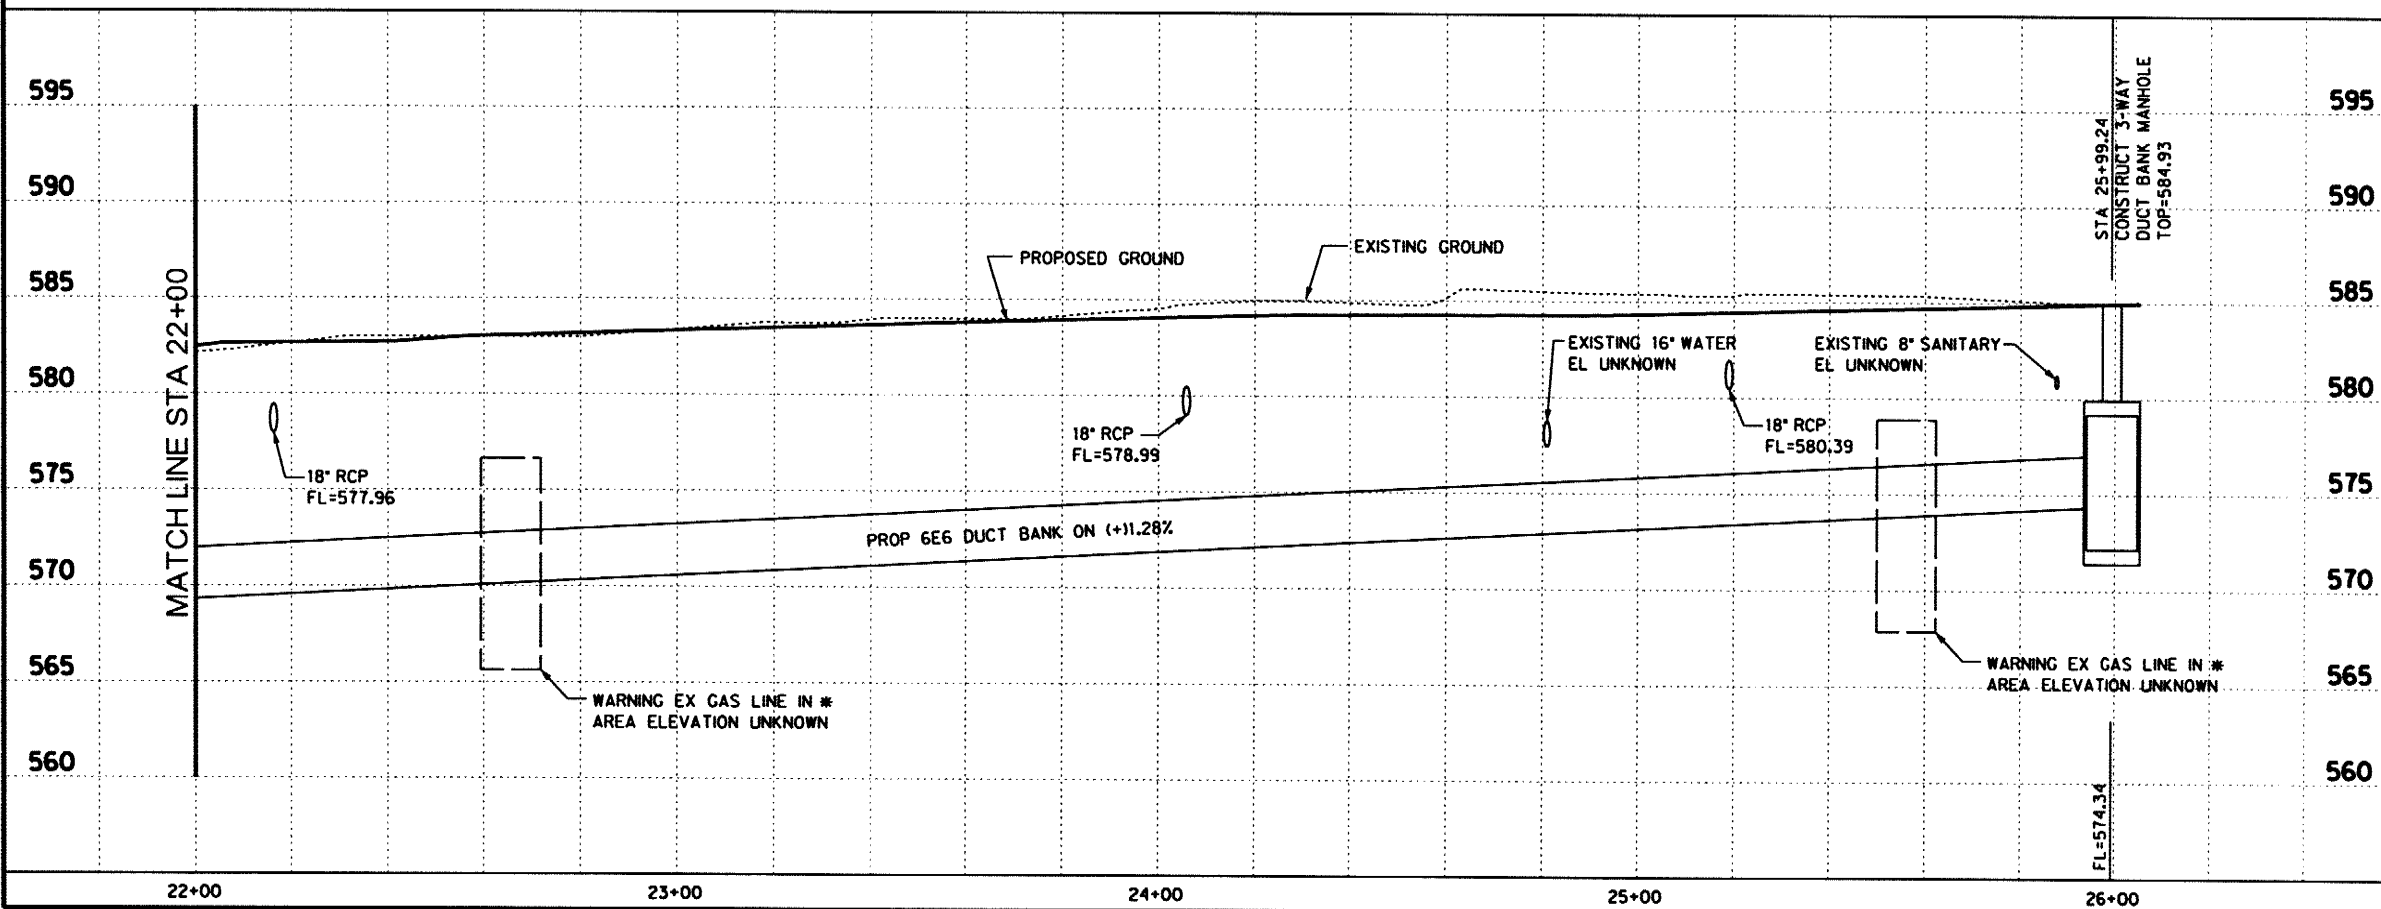


[Signature]
 Signature of Registrant
 P.E. 12/8/2011
 Date

NO.	REVISION	BY	DATE
SPRING VALLEY ROAD			
DUCT BANK PLAN AND PROFILE STA 22+00 TO 25+58.15			
<small>1201 NORTH BOWSER ROAD, RICHARDSON, TEXAS 75081-2275 TEL (214) 346-6200 FAX (214) 736-0065</small>			
PROJECT	DESIGN	DRAWN	DATE
27530	MPB	TMM	OCTOBER 2010
FILE	SHEET		
27530 UELE 04	ELE-4		


RECORD DRAWINGS

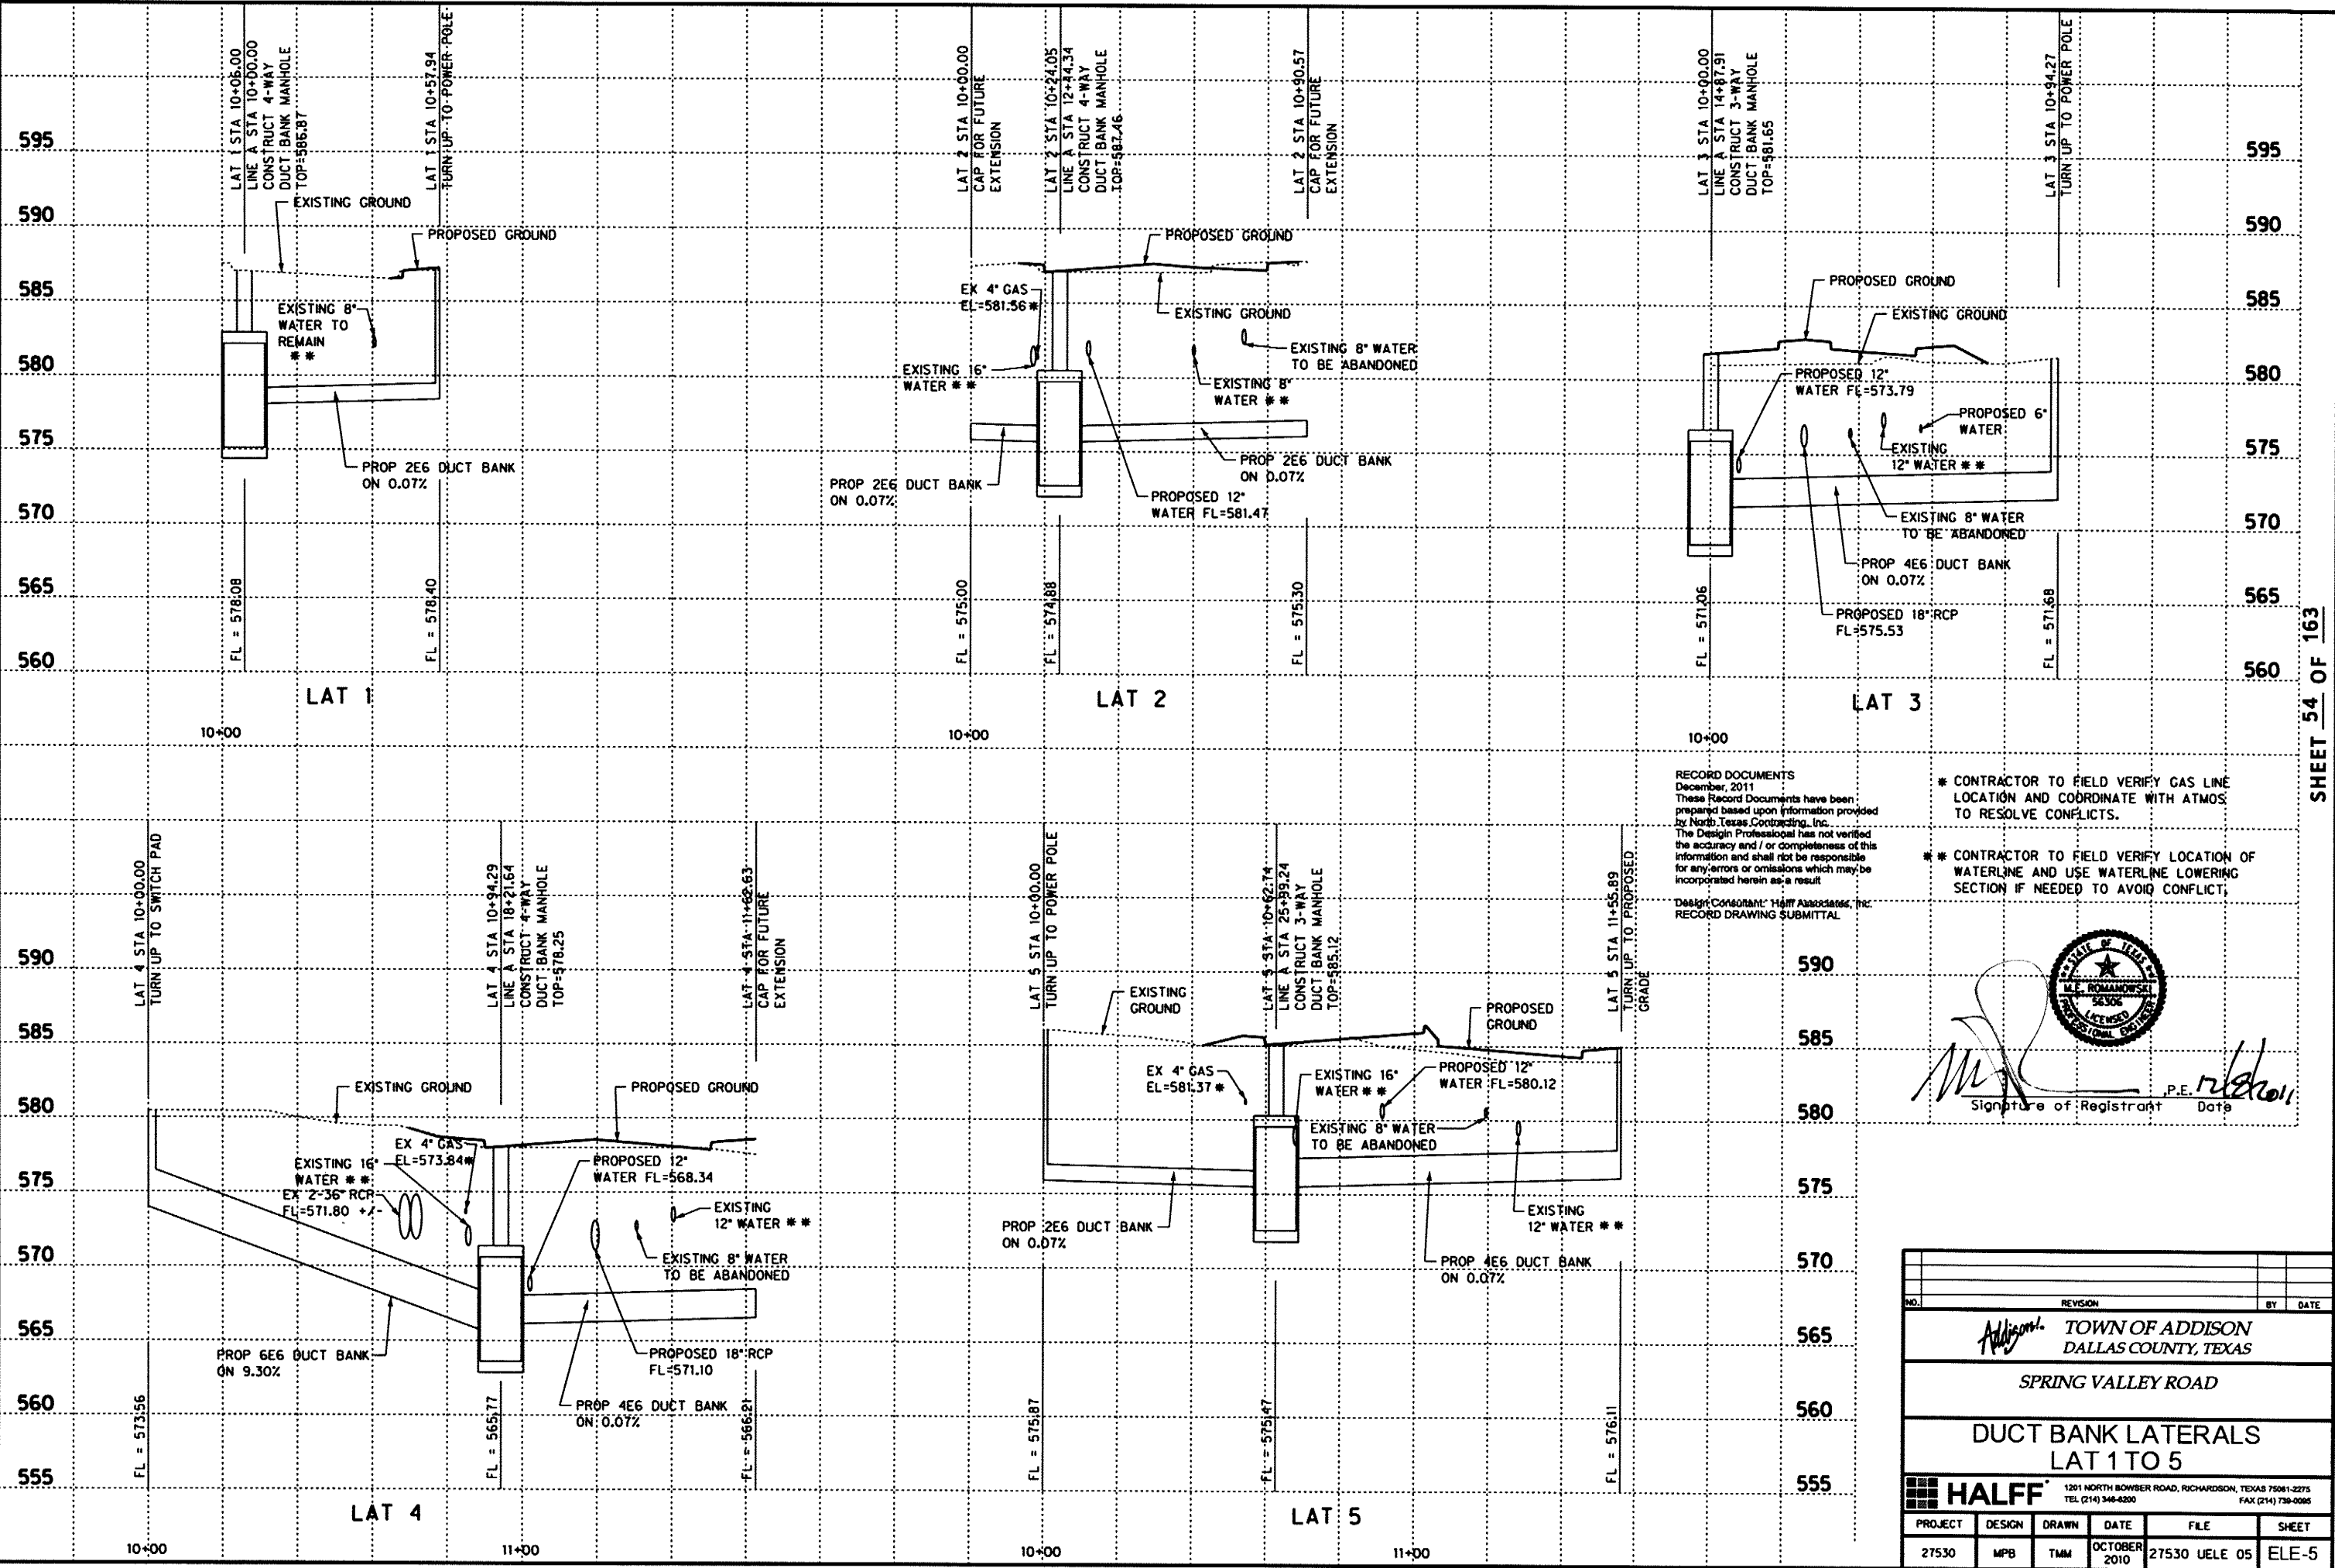

USER: qh1299
 OFFICE: RCH
 PROJECT #: 27530
 DATE: 12/7/2011
 TIME: 10:30:05 AM
 FILE: 27530 UELE 05 (REV. 1).dgn



RECORD DOCUMENTS
 December, 2011
 These Record Documents have been prepared based upon information provided by North Texas Contracting, Inc. The Design Professional has not verified the accuracy and/or completeness of this information and shall not be responsible for any errors or omissions which may be incorporated herein as a result.
 Design Consultant: Half Associates, Inc.
 RECORD DRAWING SUBMITTAL

- * CONTRACTOR TO FIELD VERIFY GAS LINE LOCATION AND COORDINATE WITH ATMOS TO RESOLVE CONFLICTS.
- ** CONTRACTOR TO FIELD VERIFY LOCATION OF WATERLINE AND USE WATERLINE LOWERING SECTION IF NEEDED TO AVOID CONFLICT.


 Signature of Registrant: *M.E. Romanowski*
 Date: *12/20/11*

NO.	REVISION	BY	DATE
 TOWN OF ADDISON DALLAS COUNTY, TEXAS SPRING VALLEY ROAD DUCT BANK LATERALS LAT 1 TO 5			
 1201 NORTH BOWSER ROAD, RICHARDSON, TEXAS 75061-2275 TEL (214) 346-4200 FAX (214) 739-0065			
PROJECT	DESIGN	DRAWN	DATE
27530	MPB	TMM	OCTOBER 2010
FILE	SHEET		
27530 UELE 05	ELE-5		

SHEET 54 OF 163
 RECORD DRAWINGS

USER: ch1299
 OFFICE: RCH
 PROJECT: 27530
 FILE: 27530_SGML_CN.dgn
 TIME: 10:31:05 AM
 DATE: 12/7/2011

The CONTRACTOR shall notify of the Town of Addison at least one week prior to starting work on this project.

The CONTRACTOR will only be allowed to work on this project during daylight hours (8 am to 5 pm Monday - Friday). Lane closures will only be allowed between the hours of 9 am and 3 pm Monday - Friday.

The CONTRACTOR shall clean up and remove from work area all loose material resulting from the contract operations each day before work is suspended. Any obstructions to existing drainage due to the CONTRACTOR's operations will be removed by the CONTRACTOR as required by the Town at the CONTRACTOR's entire expense.

THE TRAFFIC SIGNAL INSTALLATION CONSISTS OF THE FOLLOWING PRINCIPLE ITEMS:

1. Furnish and install controller cabinet assembly according to Town specifications.
2. Remove and salvage existing traffic signal assemblies.
3. Furnishing and installing signal pole/mast arm assemblies, signal heads, and signal cable.
4. Furnishing and installing conduit, ground boxes.
5. Furnishing and installing VIVDS detection system and signal preemption detectors.
6. Furnishing and placing all concrete and reinforcing steel for the signal pole foundations, and controller foundation.
7. The CONTRACTOR shall also furnish and install all other items not listed above which are needed to provide the complete traffic signal installation as called for in the plans and specifications.

SIGNAL TECHNICIAN

A signal technician from the Town of Addison shall be present when the signals are placed in operation. The CONTRACTOR shall notify Ms. Nancy Cline at (972) 450-2871 a minimum of 48 hours in advance of the turn on.

SIGNAL START UP AND TEST PERIOD FOR SIGNALS

Unless directed by the Town, the signal shall be placed in flashing mode on a Tuesday, Wednesday, or Thursday only between 9:00 am and 12:00 pm. Unless directed by the Town, the signal shall be placed in full operation between 9:00 am and 12:00 pm (noon) on a Monday, Tuesday, or Wednesday only. Once the signals have been installed and placed in operation, they shall operate continuously for a minimum of 30 calendar days in a satisfactory manner. Equipment failures during these 30 days will cause the test period to start over.

WIRING AND SIGNAL OPERATIONS

The CONTRACTOR shall be responsible for terminating all field wiring inside the cabinet. Wiring inside the cabinet shall be performed by the CONTRACTOR according to instructions from the Town of Addison and according to the cable termination chart.

EXISTING UTILITIES

The exact location of the underground utilities is not certain. The CONTRACTOR shall contact the Town of Addison and utility companies with utilities in the area for the exact location prior to drilling for foundations and any other work that might interfere with or damage present utilities. Known utilities include town water and sewer lines, TXU electric lines, SBC telecommunication lines, TXU gas lines, and fiber optic lines. Location of some of these utilities can be determined by calling the number 1-800-DIG-TESS. No additional payment will be made for relocation of foundations due to utilities.

Texas state law, article 1436c, makes unlawful the operation of equipment or machines within 10 feet of any overhead electrical line unless danger against contact with high voltage lines has been effectively guarded against pursuant to the provisions in the article. When construction operations requires working near an overhead electrical line, the CONTRACTOR shall contact the owner operator of the overhead electrical line to make adequate arrangements and to take the necessary safety precautions to ensure that all laws, electrical line owner/operator requirements, and standard industry safety practices are met.

ELECTRICAL CONDUCTORS

All electrical conductors for breakaway poles shall be breakaway (Buchanan 65u, Bussman hebw, Littlefuse leb, or equal) in accordance with RID(2). All electrical connections for neutrals shall be breakaway, shall have a white color marking, and shall permanently installed solid neutral (Buchanan 20u, Bussman het, Littlefuse let, or equal). Grounding conductors that share the same conduit, ground box, or structure shall be bonded together at every accessible point in accordance with the NEC.

CONDUIT

Underground conduit for cable shall be schedule 40 PVC. All couplings and connections shall be tight and waterproof. PVC conduit shall be heavy-wall schedule 40, unless otherwise approved by the engineer. All conduit elbows and rigid metal extensions required to be installed on PVC conduit systems will not be paid separately, but will be considered subsidiary to various bid items.

Conduit to be placed under existing pavement shall be placed at a minimum depth of 3 feet below the pavement surface. If it is determined by the engineer that it is impractical to place conduit by jacking or boring, the open trench method may be used, when approved, at no additional expense to the owner. In the event that the open trench method is used, the trench shall be backfilled to a condition acceptable to the Town engineer.

POLE ASSEMBLIES, POLE FOUNDATIONS AND ANCHORS

Critical pole assembly features and dimensions required for this project are shown on the plan detail sheets. Pole shaft/mast arm identification numbers shall be stenciled on pole shafts and mast arms before shipment to insure matching of poles and mast arms during field assembly. Signal pole assemblies shall be powder coated SILVER.

No mast arm poles shall be placed on the foundations prior to seven (7) days following placement of concrete. The dimensions shown on the plans for location of foundations, conduit and other items may be varied to meet local conditions, subject to approval by the Town of Addison.

The CONTRACTOR shall notify Ms. Nancy Cline at (972) 450-2871 at least 48 hours before placing concrete. Cylinders will be made for testing by a laboratory approved by Town personnel.

TRAFFIC SIGNAL CONTROLLER AND CABINET ASSEMBLY

The CONTRACTOR shall furnish and install an Econolite asc3-1000 ts2 traffic signal controller and cabinet assembly. This equipment shall be in accordance with town of Addison Special Specification A9004. CONTRACTOR shall be paid according to installation of highway traffic signals.

SIGNAL HEADS

Unless otherwise shown in the plans, all signals shall be mounted vertically. All signal heads shall be covered with burlap or other approved material from the time of installation until the signal is placed in operation. LED signal lamps shall be used for all signal indications and furnished and installed by the CONTRACTOR. All signal heads shall be polycarbonate with polycarbonate back-plates. Pedestrian signal heads shall be aluminum.

GROUND BOXES

CONTRACTOR shall install a 5/8" x 8' copper clad ground rod in a ground box nearest to each signal pole. A ground wire (#8 bare) shall be installed from this ground rod to the base of the pole. Each ground rod shall be electrically bonded to all other ground rods on this premise. The ground wire (#8 bare) shall bond all ground rods back to the electrical service. The cost of the ground rod shall be considered subsidiary to this item.

SIGNING

All new signs shall be furnished and installed by the CONTRACTOR. All new sign sheeting shall be High Intensity Prismatic (HIP). The CONTRACTOR shall verify the specifications and all information to be placed on the Illuminated Street Name Signs ((ILSNs) with the Town of Addison prior to fabrication. The CONTRACTOR shall contact Ms. Nancy Cline at (972) 450-2871 to obtain this information.

SIGNAL PREEMPTION DETECTORS

The CONTRACTOR shall furnish and install an opticom detector system manufactured by Global Traffic Technologies. The CONTRACTOR shall furnish four (4) Type 721 uni-directional opticom detectors, two (2) Type 752 2-channel phase selectors, and opticom detector cable.

WIRING

Extra cable length shall be included in each run to provide adequate slack, as determined by the Town inspector, at each ground box or foundation. No splicing shall be allowed in signal preemption or VIVDS detector cables. No splicing shall be allowed in the traffic signal cable except at pole base.

PAVEMENT MARKINGS

Pavement markings to be installed by others as part of roadway construction project.

VIDEO IMAGING VEHICLE DETECTION SYSTEM (VIVDS)

All equipment required for installation of a Econolite Solo Terra Pro VIVDS, including VIVDS cable, will be furnished and installed by the CONTRACTOR according to TxDOT Special Specification 6266. The CONTRACTOR shall furnish and install adequate number of VIVDS modular units required for four (4) camera inputs. The CONTRACTOR will not be required to supply a computer for VIVDS set-up. If a computer is required for set-up, the CONTRACTOR shall supply and use his/her own computer.

WIRELESS COMMUNICATION

The CONTRACTOR shall furnish and install a Wireless Ethernet Radio Subscriber Unit and CAT 5E Ethernet Cable. This equipment shall be in accordance with the Town of Addison Special Specification A9007.

The CONTRACTOR shall furnish and install a Hardened Ethernet Switch inside the controller cabinet. This equipment shall be in accordance with the Town of Addison Special Specification A9001.

The CONTRACTOR shall furnish and install a Video Server inside the controller cabinet. This equipment shall be in accordance with the Town of Addison Special Specification A9002.

CONTRACTOR'S RESPONSIBILITY FOR THE WORK

The CONTRACTOR shall be responsible for all installations until accepted by the Town as required by the general provisions and requirements. Should "knock downs" occur, the CONTRACTOR shall responsible for all labor to reinstall said equipment at no additional cost to the Town. If new equipment is required, as determined by the Town, the CONTRACTOR shall provide replacement equipment at no additional cost to the Town.

HANDLING OF TRAFFIC

Roads and streets shall be kept open to traffic at all times. The CONTRACTOR shall, unless otherwise directed by the Town, arrange the work in the roadway so as to close only one lane of the roadway at a time. All construction operations shall be conducted to provide the least possible interference to traffic as provided in the specifications and/or as directed by the Town.

The CONTRACTOR shall arrange the installation of signals, poles, and conduit so as to permit the continuous movement of the traffic in both directions at all times. A pre-construction conference including Town staff shall outline intersection construction phases. A traffic control plan (TCP) for this project shall be as detailed on standard sheets WZ (BTS-1) - 03 and WZ (BTS-2) - 03. All construction signs shall be mounted on fixed supports (4" x 4" wood posts) unless otherwise directed by the Town.

RECORD DOCUMENTS
 December, 2011
 These Record Documents have been prepared based upon information provided by North Texas Contracting, Inc. The Design Professional has not verified the accuracy and / or completeness of this information and shall not be responsible for any errors or omissions which may be incorporated herein as a result

Design Consultant: Half Associates, Inc.
 RECORD DRAWING SUBMITTAL




S.P. Booth P.E. 12/8/2011
 Signature of Registrant Date

NO.	REVISION	BY	DATE
TOWN OF ADDISON DALLAS COUNTY, TEXAS SPRING VALLEY ROAD TRAFFIC SIGNAL GENERAL NOTES SPRING VALLEY RD AT VITRUVIAN PKWY 1201 NORTH BOWSER ROAD, RICHARDSON, TEXAS 75081-2275 TEL (214) 346-6200 FAX (214) 730-0095			
PROJECT	DESIGN	DRAWN	DATE
27530	MPB	TMM	OCTOBER 2010
FILE	SHEET		
	TS-1		

FILE: 27530_SGNL 01-02 (REV 2).dgn
 DATE: 12/7/2011
 TIME: 10:31:30 AM
 PROJECT: 27530 OFFICE: RCH
 USER: qh1299

SPRING VALLEY ROAD

VITRUVIAN PARKWAY

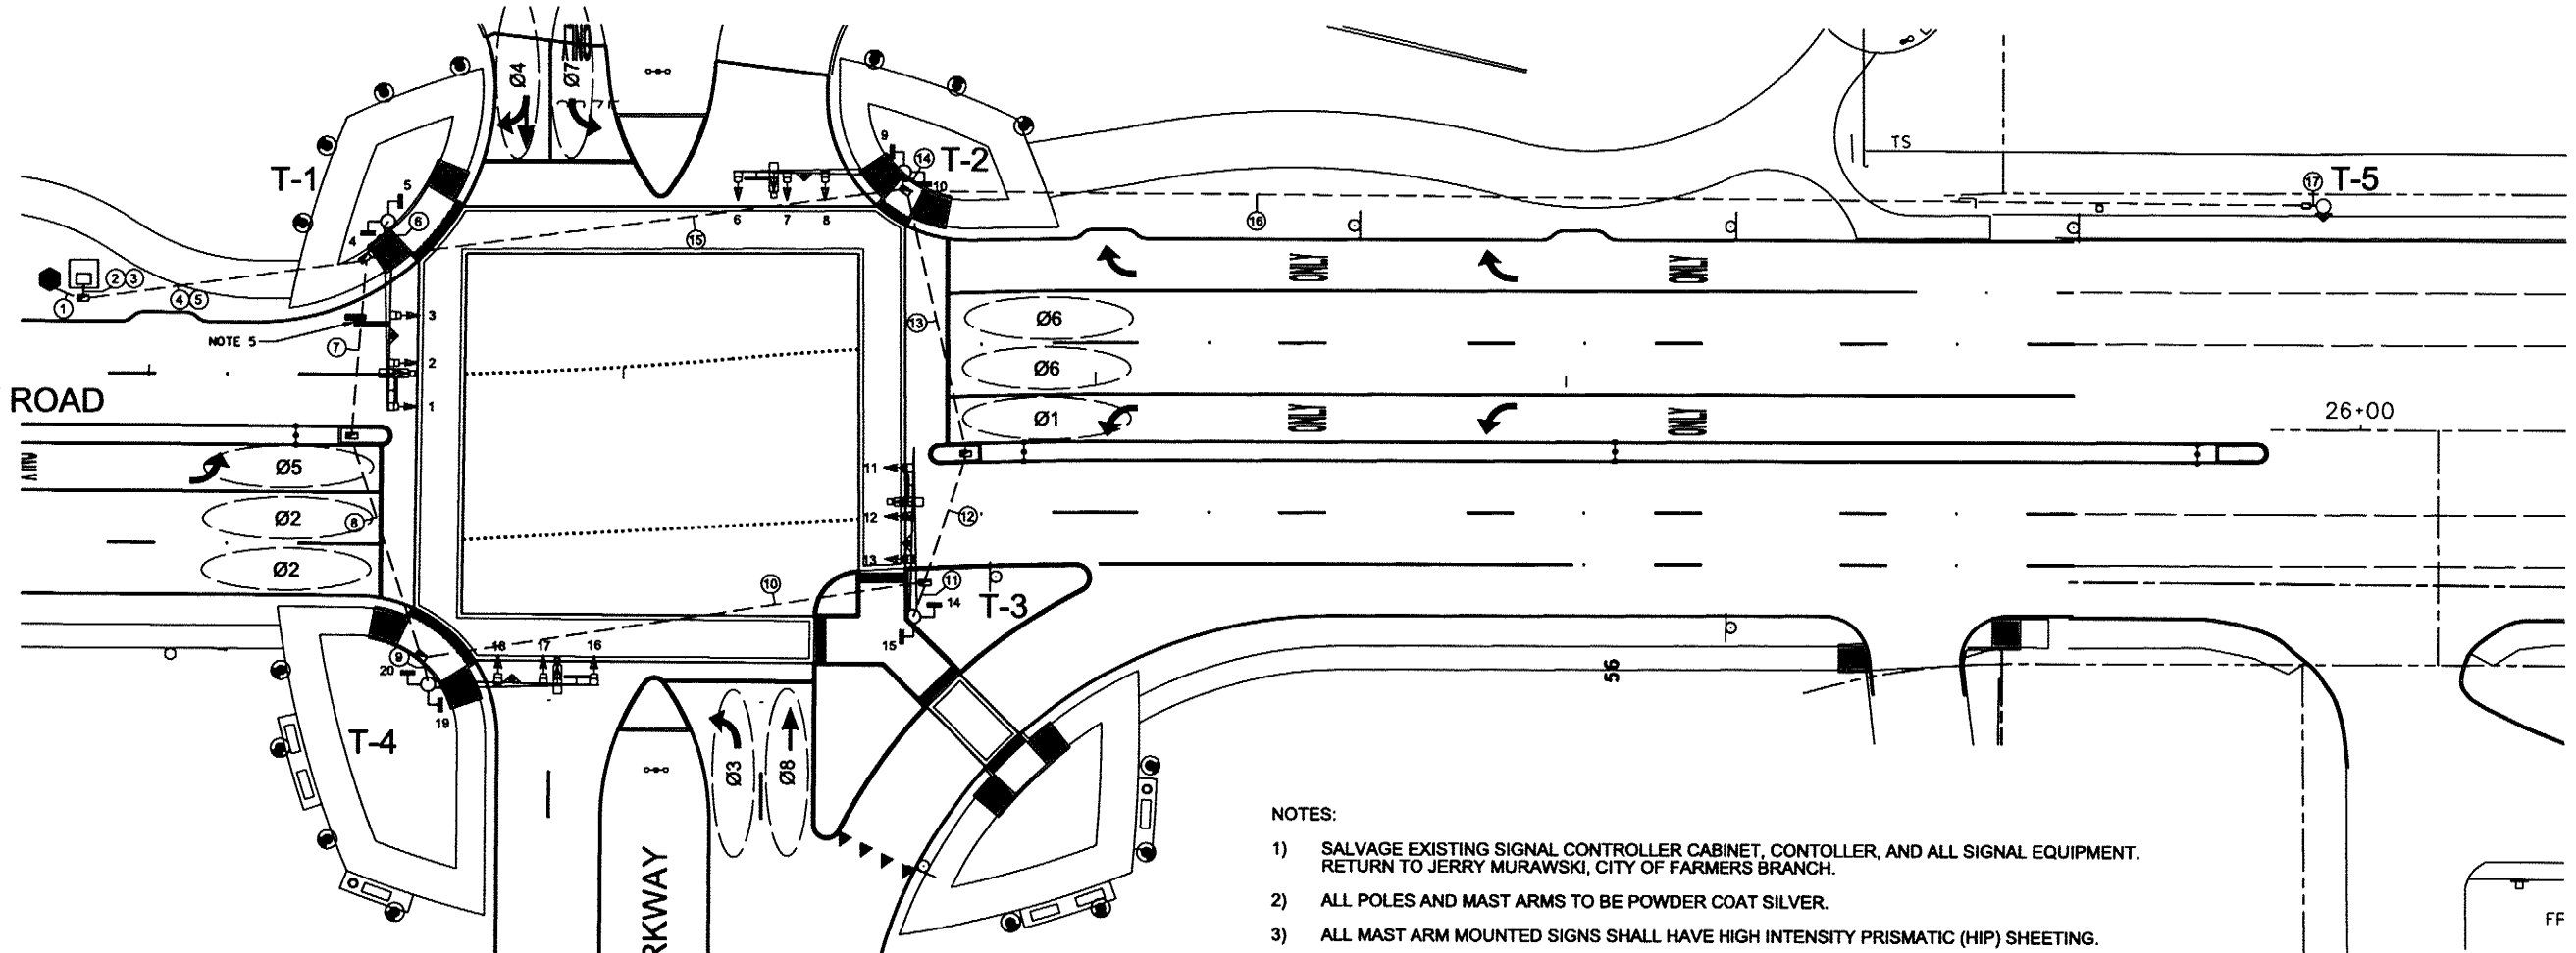

NOTES:

- 1) SALVAGE EXISTING SIGNAL CONTROLLER CABINET, CONTROLLER, AND ALL SIGNAL EQUIPMENT. RETURN TO JERRY MURAWSKI, CITY OF FARMERS BRANCH.
- 2) ALL POLES AND MAST ARMS TO BE POWDER COAT SILVER.
- 3) ALL MAST ARM MOUNTED SIGNS SHALL HAVE HIGH INTENSITY PRISMATIC (HIP) SHEETING.
- 4) ALL STREET NAME SIGNS SHALL BE ILLUMINATED STREET NAME SIGNS MEETING TOWN OF ADDISON REQUIREMENTS. CONTRACTOR SHALL OBTAIN BLOCK NUMBERS FROM THE TOWN OF ADDISON AND RECEIVE APPROVAL OF THE DESIGN OF THE SIGNS PRIOR TO FABRICATION.
- 5) FURNISH AND INSTALL A 10' POLE EXTENSION ON T-1 SIGNAL ARM. CONTRACTOR FURNISH AND INSTALL A WIRELESS ETHERNET SUBSCRIBER ACCORDING TO TOWN OF ADDISON SPECIAL SPECIFICATION A9007 ON THE POLE EXTENSION. CONTRACTOR SHALL AIM THE ETHERNET SUBSCRIBER UNIT AS DIRECTED BY THE TOWN ENGINEER. WIRELESS RADIO TO BE MOUNTED BY OPTICOM HEAD ON T-1.
- 6) CONTRACTOR SHALL FURNISH AND INSTALL THE VIDEO SERVER AND HARDENED ETHERNET SWITCH INSIDE THE TRAFFIC SIGNAL CONTROLLER CABINET.
- 7) THE VIDEO SERVER SHALL BE INSTALLED BETWEEN THE VIVDS PROCESSOR AND HARDENED ETHERNET SWITCH.
- 8) MOUNT OPTICOM DETECTOR ON PED POLE AT T-5. DETECTOR WILL ACTIVATE EB PREEMPTION (POLE T-1).

SCALE 1" = 40'


RECORD DOCUMENTS
 December, 2011
 These Record Documents have been prepared based upon information provided by North Texas Contracting, Inc. The Design Professional has not verified the accuracy and / or completeness of this information and shall not be responsible for any errors or omissions which may be incorporated herein as a result.
 Design Consultant: Half Associates, Inc.
 RECORD DRAWING SUBMITTAL

ELECTRICAL SERVICE DATA								
ELECTRICAL SERVICE DESCRIPTION (SEE ECK4)	SERVICE CONDUIT SIZE (RMC)	SERVICE CONDUCTORS NO. / SIZE	MAIN CIRCUIT BREAKER POLE / AMP	TWO-POLE CONTACTOR AMPS	PANELBO / LOADCENTER AMP RATING (AMB)	CIRCUIT NO.	BRANCH CKT. BRK. POLE / AMPS	KVA LOAD
TY D (120/240) 100 (MS) 88 (E) P8 (U)	1 1/2"	3 / #6	2P / 100	30	100	T.S. LUM 1 LUM 2 LUM 3	1P / 50 2P / 15 2P / 15 2P / 15	< 7.1

LEGEND OF SYMBOLS	
	VIDEO DETECTION ZONES
	SIGNAL POLE/MAST ARM SET UP
	SIGNAL HEAD NUMBERS
	CONTROLLER CABINET
	GROUND BOX TYPE D (LG)
	GROUND BOX TYPE E (SM)
	LUMINAIRE
	PHASE NUMBERS
	POLE NUMBERS
	CONDUIT RUN NUMBERS
	RIGHT OF WAY LINES
	VIVDS CAMERA
	ELECTRICAL SERVICE
	OPTICOM
	MAST ARM MOUNTED SIGN
	WIRELESS ETHERNET SUBSCRIBER

SIGNAL POLE CHART																				
POLE NUMBER	T-1				T-2				T-3				T-4				T-5			
MAST ARM LENGTH	40'				36'				36'				36'				PED			
FOUNDATION TYPE	36-A				36-A				36-A				36-A				24-A			
WITH LUMINAIRES	NO				NO				NO				NO				NO			
MAST ARM SIGNS	R10-12				R10-12				R10-12				R10-12				NONE			
SIZE OF LENS	12"																			
SIGNAL TYPE	B	A	A	C	C	B	A	A	C	C	B	A	A	C	C	B	A	A	C	C
SIGNAL FACE NO.	1	2	3	4	5	6	7	8	9	10	11	12	13	14	15	16	17	18	19	20
LED SIGNAL INDICATIONS	R	R	R	DW	DW	R	R	R	DW	DW	R	R	R	DW	DW	R	R	R	DW	DW
	Y	Y	Y	W	W	Y	Y	Y	W	W	Y	Y	Y	W	W	Y	Y	Y	W	W
	G	G	G			G	G	G			G	G	G			G	G	G		
	—GV					—GV					—GV					—GV				


ALL SIGNAL HEADS SHALL HAVE BLACK ALUMINUM BACK PLATES AS STATED IN THE GENERAL NOTES. LEFT-TURN INDICATIONS WILL CONSIST OF 4 SECTION HEADS WITH BI-MODAL YELLOW AND GREEN ARROWS. ALL MAST ARMS WILL HAVE LED ILLUMINATED STREET NAME SIGNS.

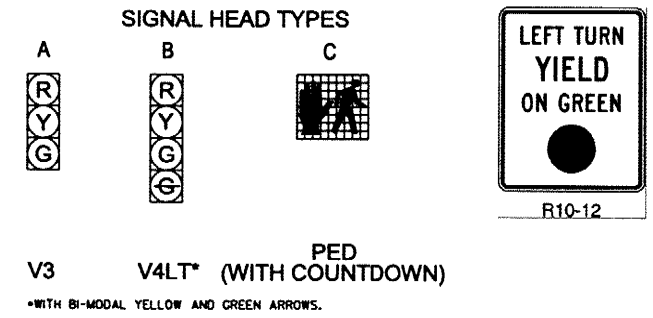

Signature of Registrant: *S.P. Booth* Date: *12/6/10*

TOWN OF ADDISON DALLAS COUNTY, TEXAS				
SPRING VALLEY ROAD				
TRAFFIC SIGNAL LAYOUT SPRING VALLEY AT VITRUVIAN				
PROJECT	DESIGN	DRAWN	DATE	SHEET
27530	MPB	TMM	OCTOBER 2010	TS-2

RECORD DRAWINGS SHEET 56 OF 163

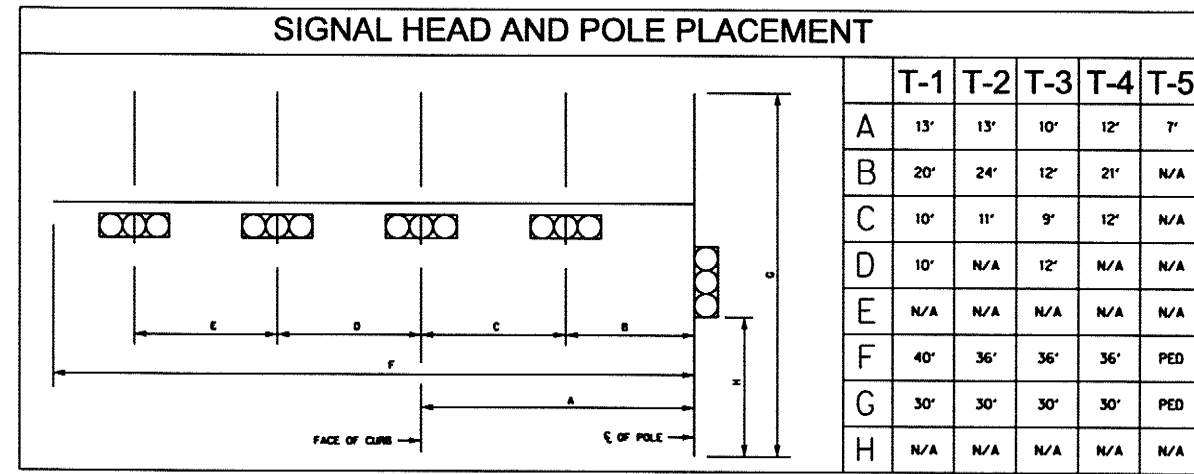

	T-1	T-2	T-3	T-4	T-5
A	13'	13'	10'	12'	7'
B	20'	24'	12'	21'	N/A
C	10'	11'	9'	12'	N/A
D	10'	N/A	12'	N/A	N/A
E	N/A	N/A	N/A	N/A	N/A
F	40'	36'	36'	36'	PED
G	30'	30'	30'	30'	PED
H	N/A	N/A	N/A	N/A	N/A

CABLE TERMINATION CHART

CONDUCTOR NO.	TYPICAL APPLICATION	CONDUCTOR COLOR	CABLE 1	CABLE 2	CABLE 3	CABLE 4	CABLE 5
			20 CNDR	20 CNDR	20 CNDR	20 CNDR	N/A
			FROM CNTRL TO T-1 TERMINAL BLOCK	FROM CNTRL TO T-2 TERMINAL BLOCK	FROM CNTRL TO T-3 TERMINAL BLOCK	FROM CNTRL TO T-4 TERMINAL BLOCK	FROM CNTRL TO T-5 TERMINAL BLOCK
1	RED THRU PHASE	RED	SH 1, 2, 3 Ø6 R	SH 6, 7, 8 Ø8 R	SH 11, 12, 13 Ø2 R	SH 16, 17, 18 Ø4 R	
2	YLW THRU PHASE	ORANGE	SH 1, 2, 3 Ø6 Y	SH 6, 7, 8 Ø8 Y	SH 11, 12, 13 Ø2 Y	SH 16, 17, 18 Ø4 Y	
3	GRN THRU PHASE	GREEN	SH 1, 2, 3 Ø6 G	SH 6, 7, 8 Ø8 G	SH 11, 12, 13 Ø2 G	SH 16, 17, 18 Ø4 G	
4	LT RED BALL OL	RED/BLACK TR	SPARE	SPARE	SPARE	SPARE	
5	LT YLW BALL OL	ORANGE/BLACK TR	SPARE	SPARE	SPARE	SPARE	
6	LT GRN BALL OL	GREEN/BLACK TR	SPARE	SPARE	SPARE	SPARE	
7	SPARE	WHITE/BLACK TR	SPARE	SPARE	SPARE	SPARE	
8	PED CALL	BLUE/BLACK TR	Ø6	Ø6	Ø2	Ø2	
9	WALK	BLUE/WHITE TR	SH 5 Ø6 W	SH 9 Ø6 W	SH 15 Ø2 W	SH 19 Ø2 W	
10	DON'T WALK	BLACK/WHITE TR	SH 5 Ø6 DW	SH 9 Ø6 DW	SH 15 Ø2 DW	SH 19 Ø2 DW	
11	LT YLW ARROW	BLACK	SH 1 Ø1 YLT	SH 6 Ø3 YLT	SH 11 Ø5 YLT	SH 16 Ø7 YLT	
12	WALK	GREEN/WHITE TR	SH 4 Ø4 W	SH 10 Ø8 W	SH 14 Ø8 W	SH 20 Ø4 W	
13	DON'T WALK	RED/WHITE TR	SH 4 Ø4 DW	SH 10 Ø8 DW	SH 14 Ø8 DW	SH 20 Ø4 DW	
14	LT GRN ARROW	BLUE	SH 1 Ø1 GLT	SH 6 Ø3 GLT	SH 11 Ø5 GLT	SH 16 Ø7 GLT	
15	NEUTRAL	WHITE	SIG COMMON	SIG COMMON	SIG COMMON	SIG COMMON	
16	PED CALL	BLACK/RED TR	Ø4	Ø8	Ø8	Ø4	
17		WHITE/RED TR	SPARE	SPARE	SPARE	SPARE	
18		ORANGE/RED TR	SPARE	SPARE	SPARE	SPARE	
19		BLUE/RED TR	SPARE	SPARE	SPARE	SPARE	
20		RED/GREEN TR	SPARE	SPARE	SPARE	SPARE	


OPTICOM ONLY

TABLE ABOVE SHOWS WIRING TO TERMINAL BLOCK AT POLE BASE. WIRING TO SIGNAL HEADS SHALL CONSIST OF SEPARATE RUNS TO EACH SIGNAL HEAD, 5 COND FOR 3 SECTION HEADS, AND 7 COND FOR 4 OR 5 SECTION HEADS. THESE QUANTITIES ARE CONSIDERED SUBSIDIARY TO THE POLE AND MAST ARM ASSEMBLIES.

RUN NO.	CONDUIT SIZE	CONDUIT LENGTH	INSTALL TYPE	CONDUIT RUNS								
				ELECTRICAL CONDUCTORS		SIGNAL CABLES #14 AWG			VIVDS DETECTOR CABLE	ILSN CABLE #5 CNDR #14 AWG	OPTICOM DETECTOR CABLE	CAT 5E ETHERNET CABLE
				XHHW #6	GROUND #6	7 CNDR	16 CNDR	20 CNDR				
1	2"	7'	T	2	1							
2	5'	4"	T	2	1			4		4		
3	5'	4"	T						4		5	1
4	60'	4"	T		1			4		4		
5	60'	4"	T		1				4		5	1
6	10'	3"	T		1			1	1	1	1	1
7	40'	4"	B		1			2	2	2	2	
8	50'	4"	B		1			2	2	2	2	
9	8'	3"	T		1			1	1	1	1	
10	108'	4"	T		1			1	1	1	1	
11	10'	3"	T		1			1	1	1	1	
12	30'	4"	B		1							
13	58'	4"	B		1							
14	7'	3"	T		1			1	1	1	1	
15	115'	4"	B		1			1	1	1	2	
16	300'	2"	T								1	
17	10'	2"	T								1	


T = TRENCH B = BORE

PROPOSED SIGNAL PHASING

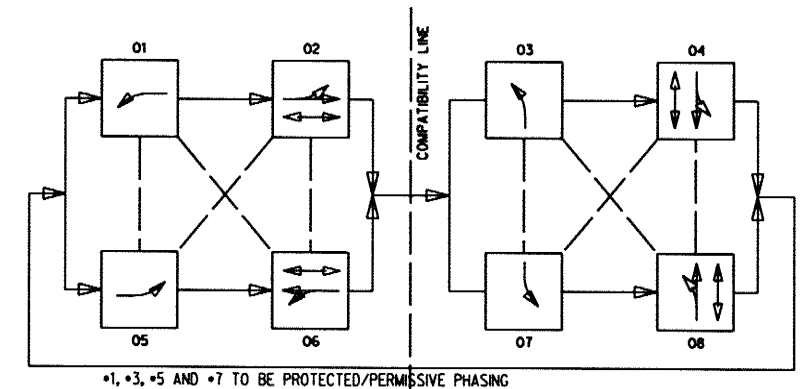

RECORD DOCUMENTS
 December, 2011
 These Record Documents have been prepared based upon information provided by North Texas Contracting, Inc. The Design Professional has not verified the accuracy and / or completeness of this information and shall not be responsible for any errors or omissions which may be incorporated herein as a result.
 Design Consultant: Half Associates, Inc.
 RECORD DRAWING SUBMITTAL

SIGNAL POLE LOCATIONS

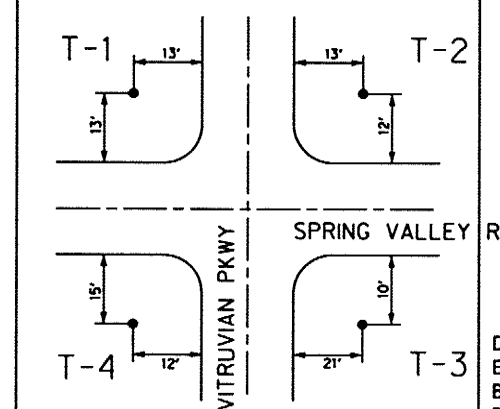

DISTANCE TO CURB MEASURED ALONG PERPENDICULAR TO CL



S.P. Booth P.E. 12/8/2011
 Signature of Registrant Date

DISTANCES ARE FOR GUIDANCE ONLY. EXACT LOCATION OF SIGNAL POLES SHALL BE STAKED BY THE CONTRACTOR AND APPROVED BY THE TOWN ENGINEER PRIOR TO DRILLING

2	ADDITION OF OPTICOM AT T-5	SPB	12/6/2010
1	PHASING AND WIRING CHANGES	SPB	8/26/10
NO.	REVISION	BY	DATE
TOWN OF ADDISON DALLAS COUNTY, TEXAS SPRING VALLEY ROAD			
TRAFFIC SIGNAL DESIGN TABLES SPRING VALLEY RD AT VITRUVIAN PKWY			
1201 NORTH BOWSER ROAD, RICHARDSON, TEXAS 75081-2275 TEL (214) 348-8200 FAX (214) 738-0085			
PROJECT	DESIGN	DRAWN	DATE
27530	MPB	TMM	OCTOBER 2010
FILE	SHEET		
	TS-3		

TRAFFIC CONTROL NARRATIVE

PHASE 1A

- 1.REMOVE EXISTING MEDIANS NEAR THE INTERSECTION OF SPRING VALLEY AND VITRUVIAN WAY.
- 2.REMOVE ANY EXISTING ITEMS WITHIN MEDIAN LIMITS AT VITRUVIAN INTERSECTION.
3. CONSTRUCT TEMPORARY ASPHALT PAVEMENT IN PLACE OF MEDIANS.

PHASE 1B

1. SHIFT TRAFFIC TO ONE LANE EACH DIRECTION CONFIGURATION ON SOUTH SIDE OF EXISTING SPRING VALLEY ROAD.
2. REMOVE ALL EXISTING TRAFFIC SIGNAL EQUIPMENT AND INSTALL STOP SIGNS IN EACH DIRECTION AT VITRUVIAN INTERSECTION.
3. CONSTRUCT PROPOSED ELECTRICAL DUCT BANK ON NORTH SIDE OF SPRING VALLEY ROAD TO MAXIMUM LIMITS WHILE MAINTAINING A MINIMUM OF 1-11' LANE IN EACH DIRECTION.

PHASE 2

1. SHIFT TRAFFIC TO ONE LANE EACH DIRECTION CONFIGURATION ON NORTH SIDE OF EXISTING SPRING VALLEY ROAD. CONSTRUCT REMAINING SECTIONS OF ELECTRICAL DUCT BANK ON SPRING VALLEY ROAD PRIOR TO ANY OTHER CONSTRUCTION IN PHASE 2.
2. AFTER SPRING VALLEY ELECTRICAL DUCT BANK IS IN PLACE, ONCOR WILL REQUIRE 2 MONTHS TO SHIFT SERVICE FROM THE EXISTING OVERHEAD LINE TO THE NEW DUCT BANK. DURING THIS TIME, ALL OTHER PHASE 2 CONSTRUCTION CAN BE COMPLETED.
3. ONCOR MUST HAVE ALL SERVICE LINES RELOCATED TO THE NEW SPRING VALLEY ROAD DUCT BANK AND THE EXISTING UTILITY POLES REMOVED PRIOR TO BEGINNING PHASE 3 CONSTRUCTION.
4. IF EXISTING UTILITY POLES ARE STILL IN PLACE DURING PHASE 2 PAVING ACTIVITIES, THE CONTRACTOR WILL BLOCK OUT PAVEMENT AROUND EXISTING POLES AND COMPLETE PAVING WHEN POLES HAVE BEEN REMOVED.
5. SHIFT VITRUVIAN WAY TRAFFIC TO ONE LANE EACH DIRECTION CONFIGURATION ON THE EXISTING EAST SIDE LANES.
6. CONSTRUCT ALL REMAINING UTILITIES TO MAXIMUM LIMITS WHILE MAINTAINING A MINIMUM OF 1-11' LANE IN ALL DIRECTIONS.
7. CONSTRUCT PROPOSED EAST BOUND LANES OF SPRING VALLEY ROAD, AND ALL VITRUVIAN WAY LANES TO LIMITS SHOWN.

PHASE 3A

1. ALL ONCOR WORK ON SPRING VALLEY MUST BE COMPLETED PRIOR TO BEGINNING PHASE 3 CONSTRUCTION.
2. SHIFT ALL VITRUVIAN WAY TRAFFIC TO NEW WEST SIDE PAVEMENT, ONE LANE EACH DIRECTION.
3. SHIFT SPRING VALLEY/VITRUVIAN INTERSECTION FROM EXISTING LOCATION TO ALIGN WITH PROPOSED LOCATION.
4. CONSTRUCT REMAINING SECTION OF PROPOSED SPRING VALLEY EAST BOUND LANES.
5. CONSTRUCT TEMPORARY ACCESS TO LEMMONS PROPERTY ON VITRUVIAN WAY.
6. CONSTRUCT REMAINING PROPOSED NORTH BOUND LANES OF VITRUVIAN WAY EXCEPT LEMMONS TEMPORARY ACCESS.

PHASE 3B


1. SHIFT SPRING VALLEY ROAD TRAFFIC TO 1 LANE EACH DIRECTION CONFIGURATION ON NEW SOUTH SIDE PAVEMENT.
2. COMPLETE ALL REMAINING UTILITY WORK ON THE PROJECT IN THIS PHASE.
3. CONSTRUCT PROPOSED WEST BOUND LANES ON SPRING VALLEY ROAD.
4. CONSTRUCT REMAINING PORTION OF PROPOSED NORTH BOUND LANES ON VITRUVIAN WAY.
5. SHIFT ALL TRAFFIC TO FINAL CONFIGURATION WHEN COMPLETE.

NOTE: 1. CONTRACTOR SHALL PHASE CONSTRUCTION AROUND EXISTING DRIVEWAYS TO MAINTAIN ACCESS TO ALL ADJACENT PROPERTIES IN EACH PHASE.



2. ALL TRAFFIC CONTROL MEASURES SHALL COMPLY WITH TEXAS MUTCD & TOWN OF ADDISON WORK ZONE SAFETY SPECIFICATIONS.

RECORD DOCUMENTS
December, 2011
These Record Documents have been prepared based upon information provided by North Texas Contracting, Inc. The Design Professional has not verified the accuracy and / or completeness of this information and shall not be responsible for any errors or omissions which may be incorporated herein as a result


Design Consultant: Halff Associates, Inc.
RECORD DRAWING SUBMITTAL



M.E. Romanowski, P.E. 12/8/2011
Signature of Registrant Date

NO.	REVISION	BY	DATE
 TOWN OF ADDISON DALLAS COUNTY, TEXAS SPRING VALLEY ROAD TRAFFIC CONTROL NARRATIVE			
 HALFF			
<small>1201 NORTH BOMBER ROAD, RICHARDSON, TEXAS 75081-2275 TEL (214) 346-6200 FAX (214) 739-0995</small>			
PROJECT	DESIGN	DRAWN	DATE
27530	MPB	TMM	OCTOBER 2010
FILE	SHEET		
27530 TCPN 01	TCP-00		

DATE: 12/7/2011 TIME: 10:32:07 AM FILE: 27530 TCP 01-01-01.dgn PROJECT: 27530 OFFICE: RCH USER: ah1299

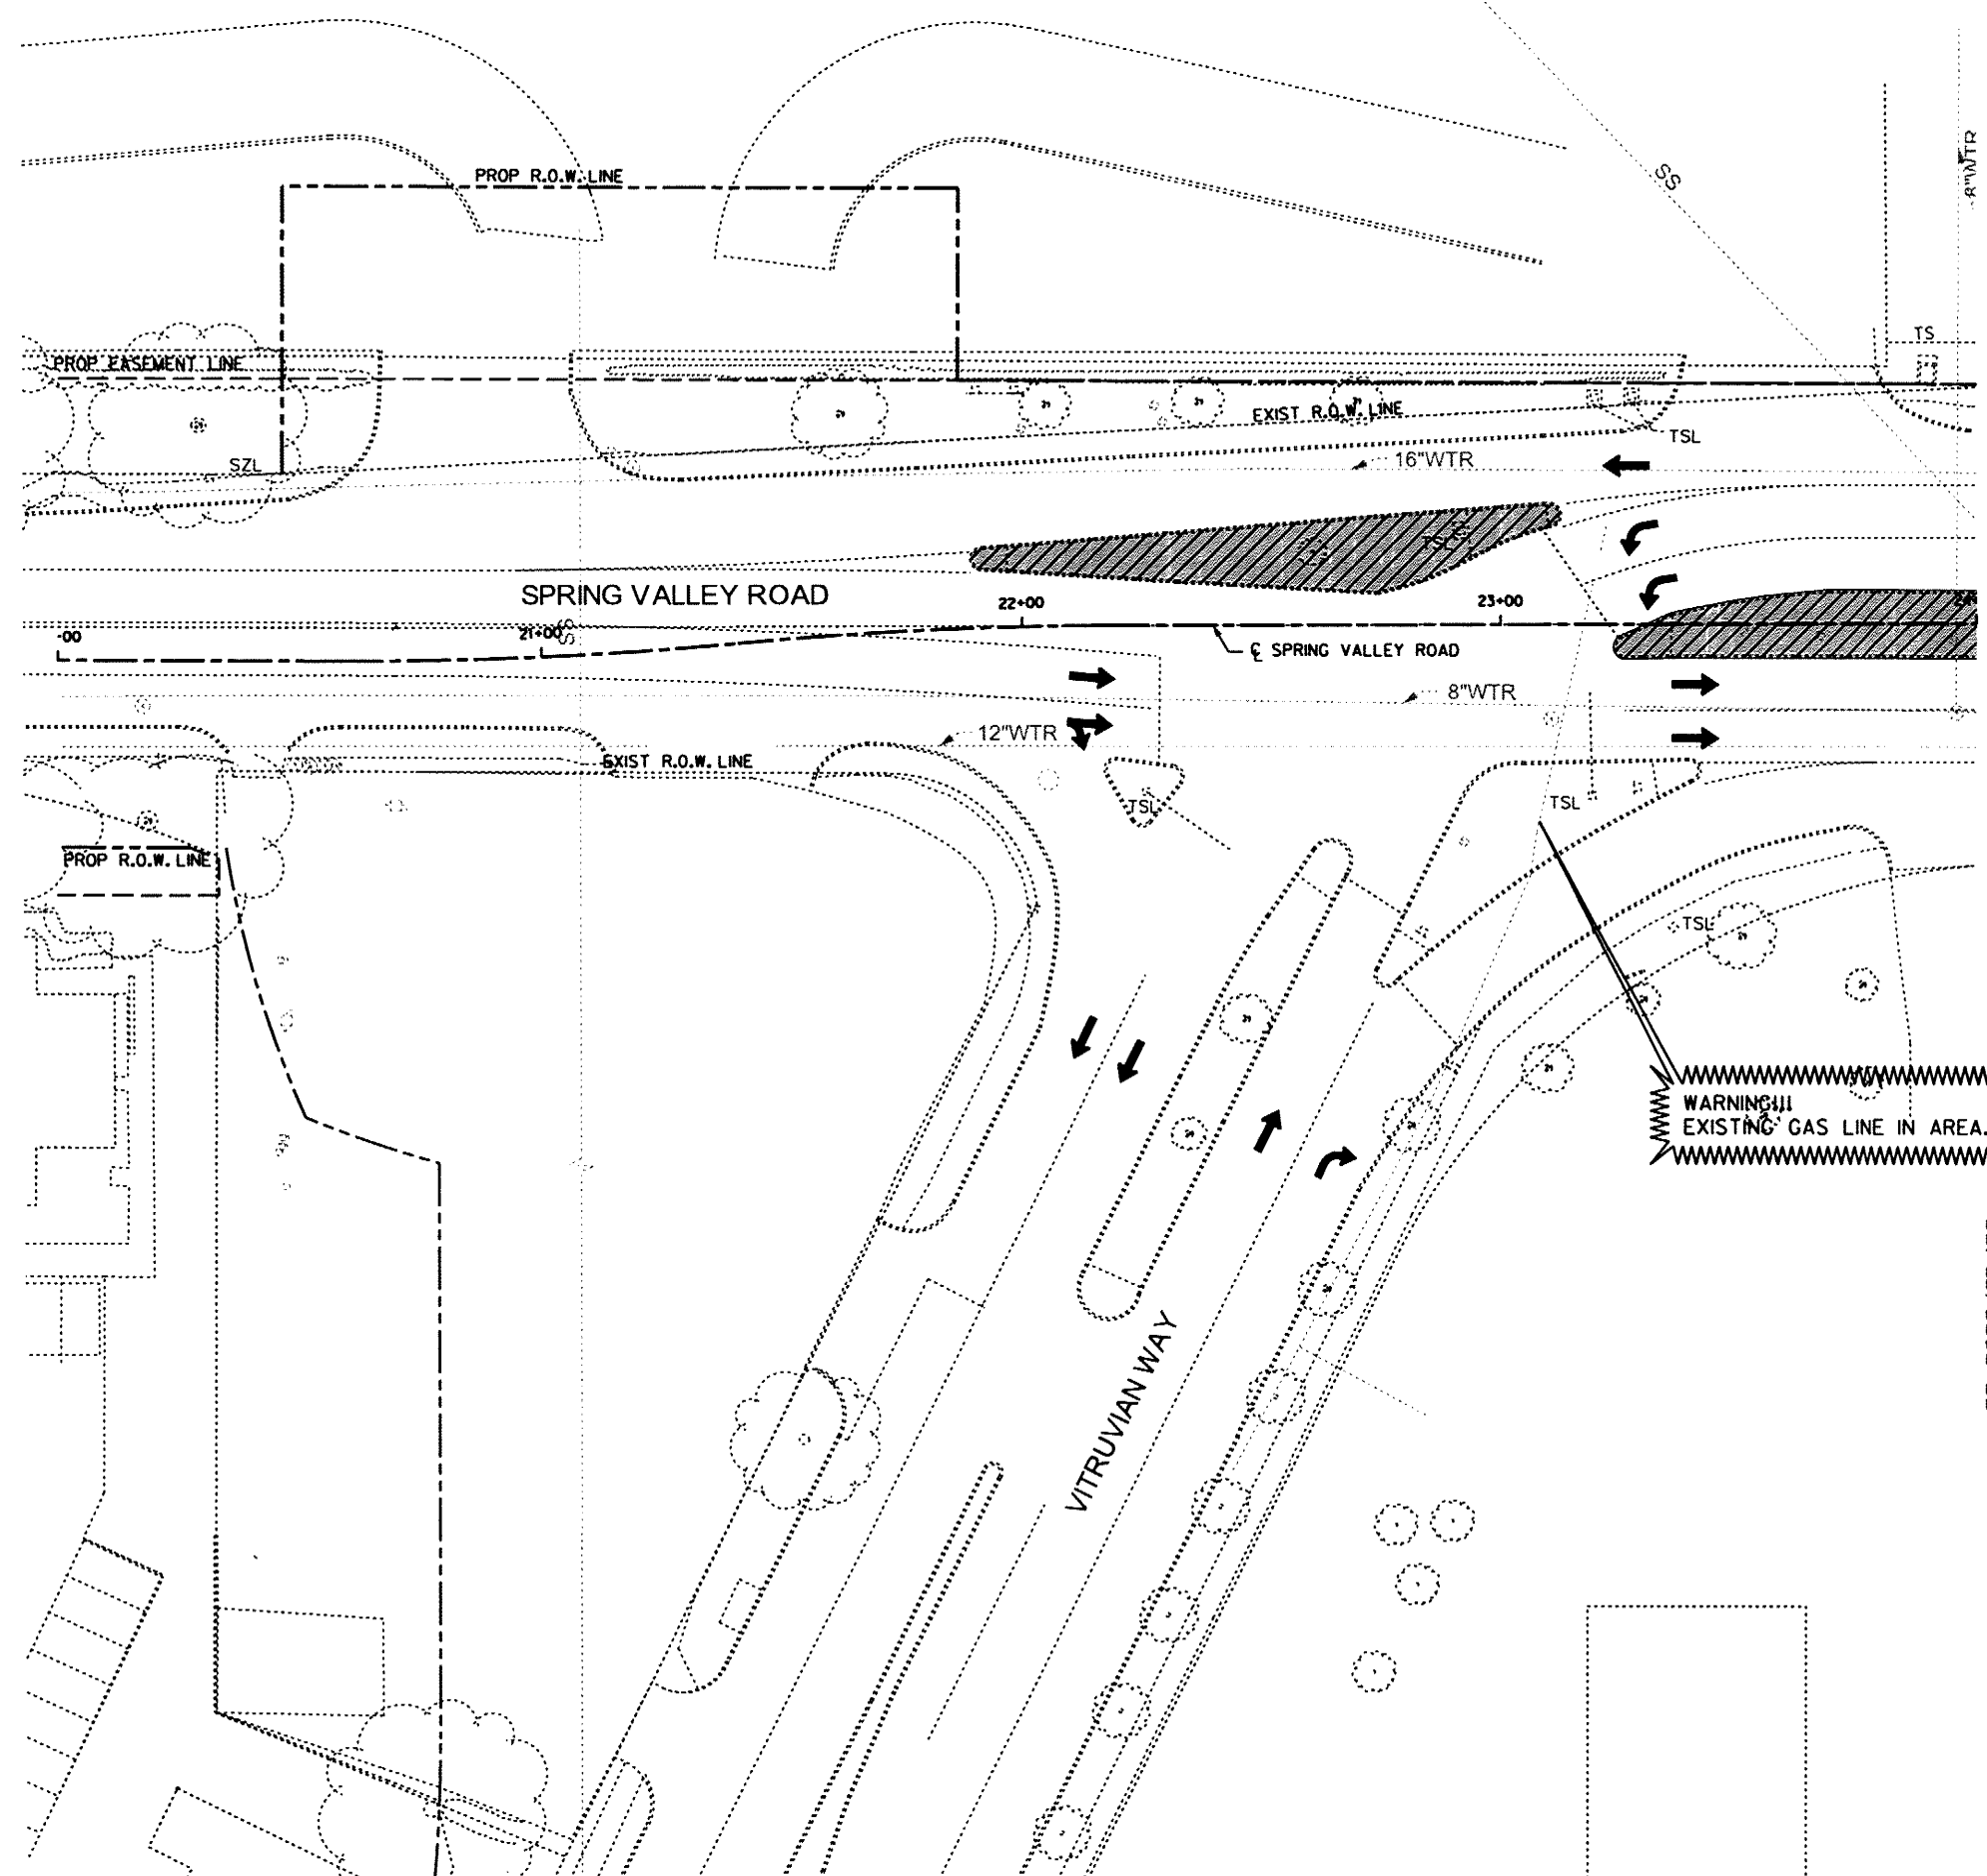

TRAFFIC CONTROL LEGEND:

- TEMPORARY 8" HMAC PAVEMENT
- PAVEMENT CONSTRUCTED IN THIS PHASE
- PAVEMENT CONSTRUCTED IN PREVIOUS PHASE
- TEMPORARY PAVEMENT HMAC WIDENING PREVIOUS PHASE
- TRAFFIC FLOW DIRECTION
- CONSTRUCTION SIGN
- PLASTIC DRUM CHANNELIZING DEVICE
- VERTICAL PANEL WITH TWO WAY TRAFFIC SIGN ON BOTH SIDES
- VERTICAL PANEL (VP)
- TYPE III BARRICADE
- STORM BUILT THIS PHASE
- STORM BUILT PREVIOUS PHASE
- 12' WTR WATER BUILT THIS PHASE
- 12' WTR WATER BUILT PREVIOUS PHASE
- 8' SS SANITARY BUILT THIS PHASE
- 8' SS SANITARY BUILT PREVIOUS PHASE
- UG ELEC DUCT BANK BUILT THIS PHASE
- UG ELEC DUCT BANK BUILT PREVIOUS PHASE
- OH ELEC OVERHEAD ELECT. BUILT THIS PHASE
- OH ELEC OVERHEAD ELECT. BUILT PREVIOUS PHASE
- REMOVABLE 4' SOLID WHITE
- REMOVABLE 4' BROKEN WHITE
- REMOVABLE 4' DOTTED WHITE
- REMOVABLE 24" STOP BAR
- REMOVABLE 4' SOLID YELLOW
- EXISTING / PREVIOUS PAV MARKINGS

RECORD DOCUMENTS
 December, 2011
 These Record Documents have been prepared based upon information provided by North Texas Contracting, Inc. The Design Professional has not verified the accuracy and / or completeness of this information and shall not be responsible for any errors or omissions which may be incorporated herein as a result.

Design Consultant: Half Associates, Inc.
 RECORD DRAWING SUBMITTAL

Signature of Registrant: *[Signature]* Date: 12/6/2011

NO.	REVISION	BY	DATE
TOWN OF ADDISON DALLAS COUNTY, TEXAS SPRING VALLEY ROAD TRAFFIC CONTROL PLAN PHASE 1A			
HALFF <small>1201 NORTH BOWSER ROAD, RICHARDSON, TEXAS 75081-2275 TEL (214) 348-8200 FAX (214) 730-0085</small>			
PROJECT	DESIGN	DRAWN	DATE
27530	MPB	TMM	OCTOBER 2010
FILE	SHEET		
27530 TCP 01-01-01	TCP-1		

SHEET 59 OF 163 RECORD DRAWINGS

DATE: 12/7/2011 TIME: 10:32:21 AM FILE: 27530 TCP 01-02-01.dgn PROJECT: 27530 OFFICE: RCH USER: oh1299




TRAFFIC CONTROL LEGEND:

- TEMPORARY 8" HMAC PAVEMENT
- PAVEMENT CONSTRUCTED IN THIS PHASE
- PAVEMENT CONSTRUCTED IN PREVIOUS PHASE
- TEMPORARY PAVEMENT HMAC WIDENING PREVIOUS PHASE
- TRAFFIC FLOW DIRECTION
- CONSTRUCTION SIGN
- PLASTIC DRUM CHANNELIZING DEVICE
- VERTICAL PANEL WITH TWO WAY TRAFFIC SIGN ON BOTH SIDES
- VERTICAL PANEL (VP)
- TYPE III BARRICADE
- STORM BUILT THIS PHASE
- STORM BUILT PREVIOUS PHASE
- 12" W WATER BUILT THIS PHASE
- 12" W WATER BUILT PREVIOUS PHASE
- 8" SS SANITARY BUILT THIS PHASE
- 8" SS SANITARY BUILT PREVIOUS PHASE
- UG ELEC DUCT BANK BUILT THIS PHASE
- UG ELEC DUCT BANK BUILT PREVIOUS PHASE
- OH ELEC OVERHEAD ELECT. BUILT THIS PHASE
- OH ELEC OVERHEAD ELECT. BUILT PREVIOUS PHASE
- REMOVABLE 4" SOLID WHITE
- REMOVABLE 4" BROKEN WHITE
- REMOVABLE 4" DOTTED WHITE
- REMOVABLE 24" STOP BAR
- REMOVABLE 4" SOLID YELLOW
- EXISTING / PREVIOUS PAV MARKINGS

RECORD DOCUMENTS
 December, 2011
 These Record Documents have been prepared based upon information provided by North Texas Contracting, Inc. The Design Professional has not verified the accuracy and / or completeness of this information and shall not be responsible for any errors or omissions which may be incorporated herein as a result.

Design Consultant: Half Associates, Inc.
 RECORD DRAWING SUBMITTAL


Signature of Registrant: *M.E. Romanowski* Date: 12/8/2011

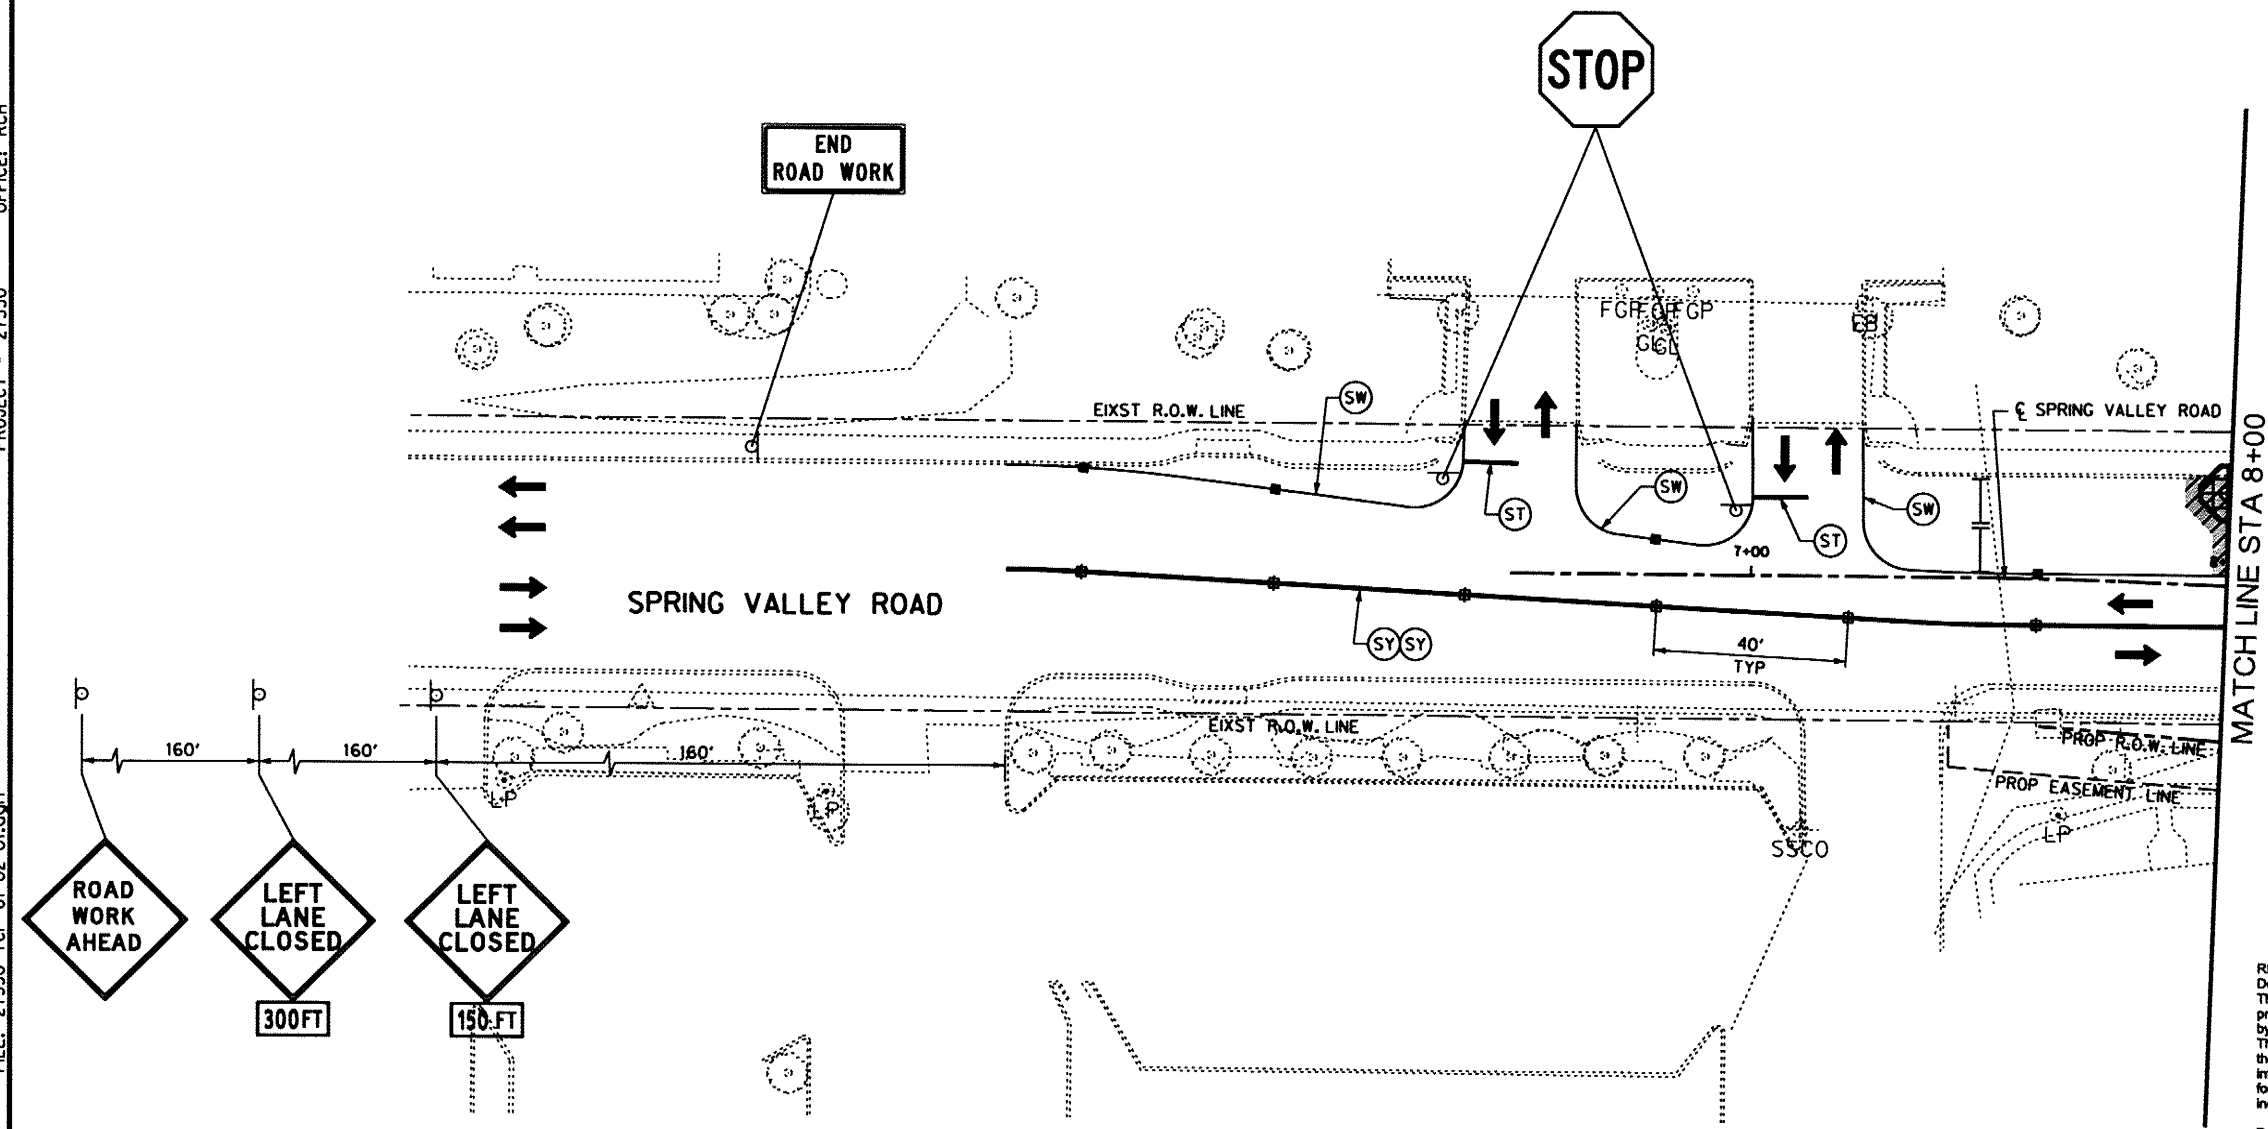

SHEET 60 OF 163

RECORD DRAWINGS

NO.	REVISION	BY	DATE		
TOWN OF ADDISON DALLAS COUNTY, TEXAS SPRING VALLEY ROAD TRAFFIC CONTROL PLAN PHASE 1B					
1201 NORTH BOWBER ROAD, RICHARDSON, TEXAS 75081-2275 TEL (214) 348-4200 FAX (214) 738-0085					
PROJECT	DESIGN	DRAWN	DATE	FILE	SHEET
27530	MPB	TMM	OCTOBER 2010	27530 TCP 01-02-01	TCP-02

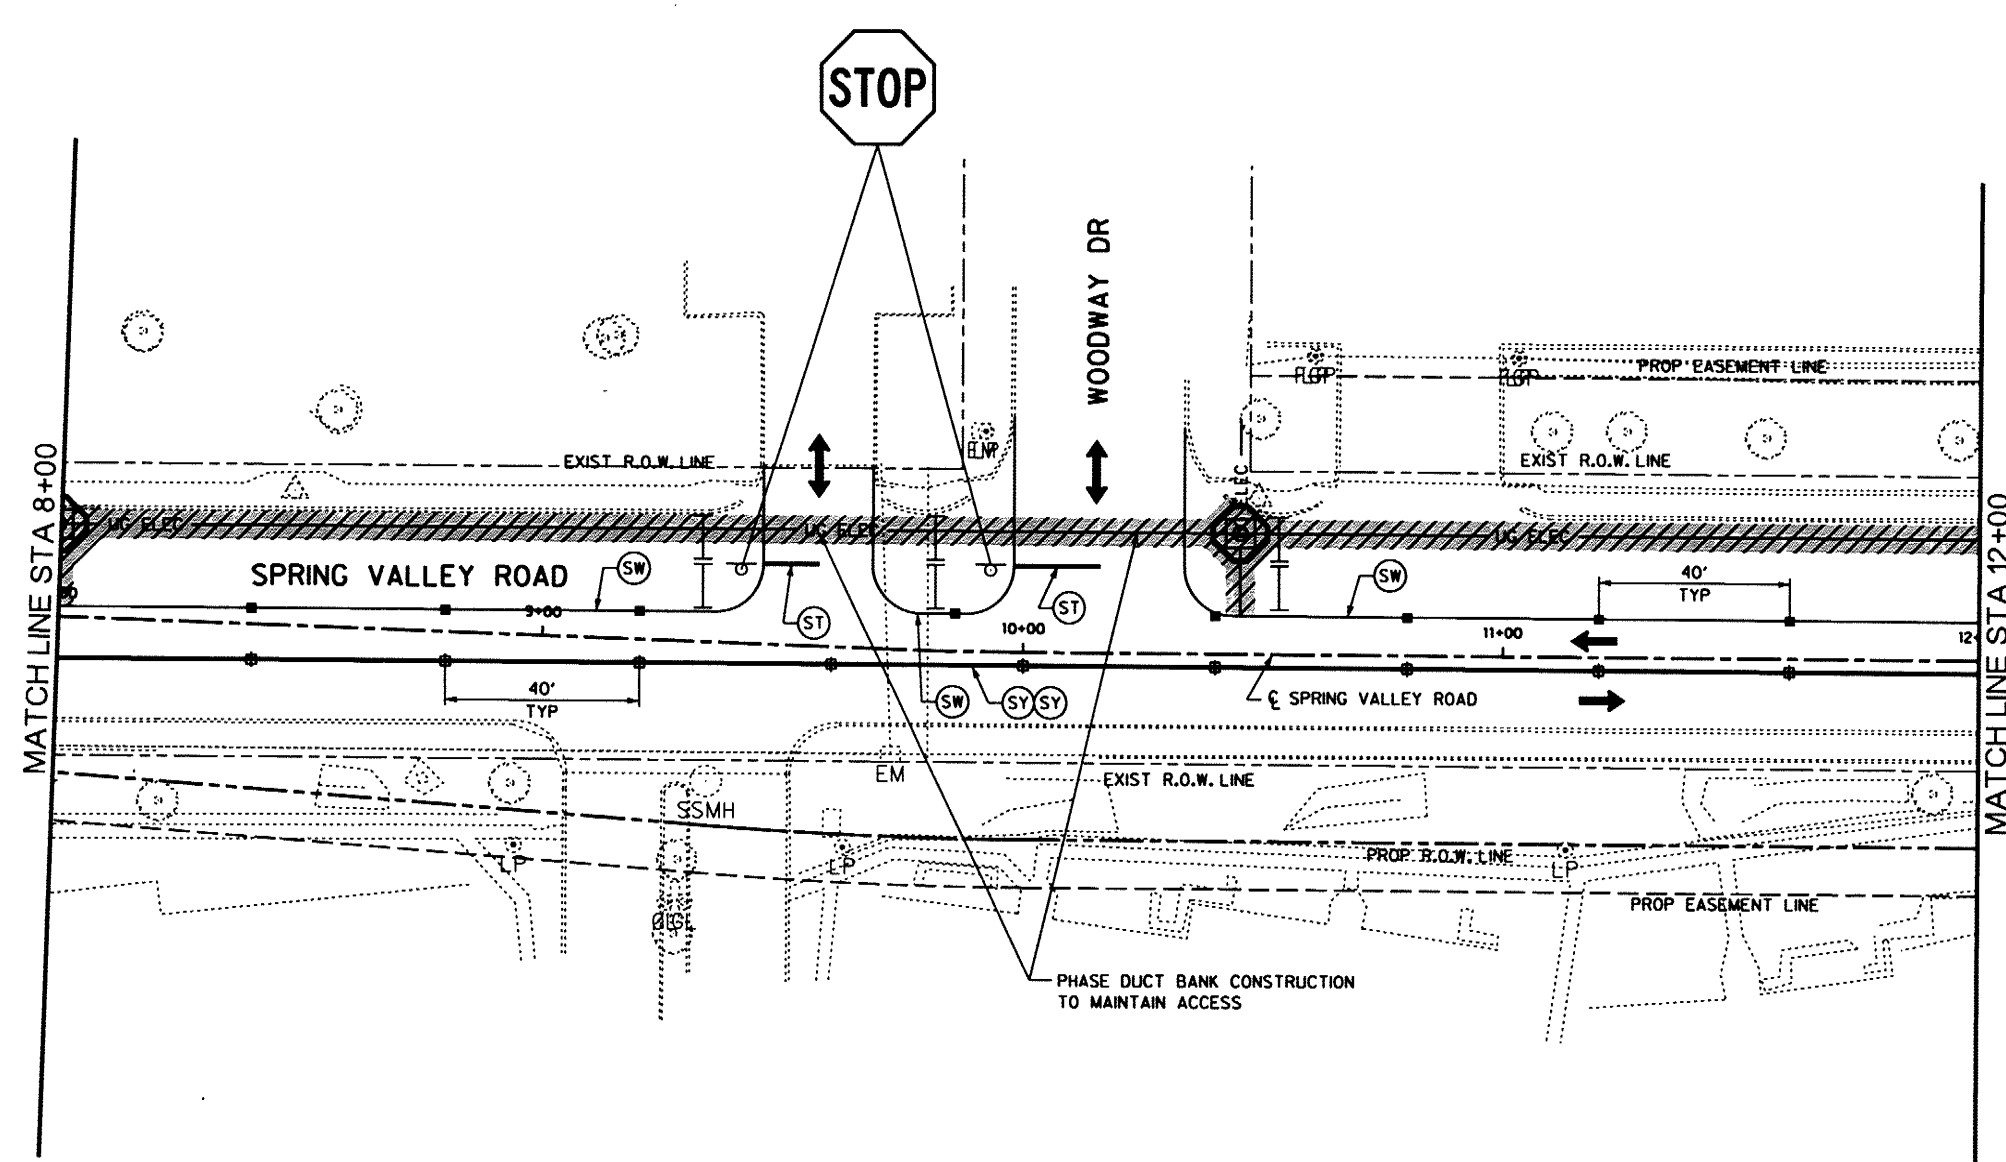

TRAFFIC CONTROL LEGEND:

- TEMPORARY 8" HMAC PAVEMENT
- PAVEMENT CONSTRUCTED IN THIS PHASE
- PAVEMENT CONSTRUCTED IN PREVIOUS PHASE
- TEMPORARY PAVEMENT HMAC WIDENING PREVIOUS PHASE
- TRAFFIC FLOW DIRECTION
- CONSTRUCTION SIGN
- PLASTIC DRUM CHANNELIZING DEVICE
- VERTICAL PANEL WITH TWO WAY TRAFFIC SIGN ON BOTH SIDES
- VERTICAL PANEL (VP)
- TYPE III BARRICADE
- STORM BUILT THIS PHASE
- STORM BUILT PREVIOUS PHASE
- 12" W - WATER BUILT THIS PHASE
- 12" W - WATER BUILT PREVIOUS PHASE
- 8" SS - SANITARY BUILT THIS PHASE
- 8" SS - SANITARY BUILT PREVIOUS PHASE
- UG ELEC- DUCT BANK BUILT THIS PHASE
- UG ELEC- DUCT BANK BUILT PREVIOUS PHASE
- OH ELEC- OVERHEAD ELECT. BUILT THIS PHASE
- OH ELEC- OVERHEAD ELECT. BUILT PREVIOUS PHASE
- (SW) REMOVABLE 4" SOLID WHITE
- (BW) REMOVABLE 4" BROKEN WHITE
- (DW) REMOVABLE 4" DOTTED WHITE
- (ST) REMOVABLE 24" STOP BAR
- (SY) REMOVABLE 4" SOLID YELLOW
- (X) EXISTING / PREVIOUS PAV MARKINGS

RECORD DOCUMENTS
 December, 2011
 These Record Documents have been prepared based upon information provided by North Texas Contracting, Inc. The Design Professional has not verified the accuracy and / or completeness of this information and shall not be responsible for any errors or omissions which may be incorporated herein as a result.

Design Consultant: Half Associates, Inc.
 RECORD DRAWING SUBMITTAL


Signature of Registrant: *M.E. Romanowski* Date: 12/8/2011

NO.	REVISION	BY	DATE
TOWN OF ADDISON DALLAS COUNTY, TEXAS SPRING VALLEY ROAD TRAFFIC CONTROL PLAN PHASE 1B			
1201 NORTH BOWSER ROAD, RICHARDSON, TEXAS 75081-2275 TEL (214) 348-4200 FAX (214) 738-0095			
PROJECT	DESIGN	DRAWN	DATE
27530	MPB	TMM	OCTOBER 2010
FILE	SHEET		
27530 TCP 01-02-02	TCP-03		



TRAFFIC CONTROL LEGEND:

- TEMPORARY 8" HMAC PAVEMENT
- PAVEMENT CONSTRUCTED IN THIS PHASE
- PAVEMENT CONSTRUCTED IN PREVIOUS PHASE
- TEMPORARY PAVEMENT HMAC WIDENING PREVIOUS PHASE
- TRAFFIC FLOW DIRECTION
- CONSTRUCTION SIGN
- PLASTIC DRUM CHANNELIZING DEVICE
- VERTICAL PANEL WITH TWO WAY TRAFFIC SIGN ON BOTH SIDES
- VERTICAL PANEL (VP)
- TYPE III BARRIAGE
- STORM BUILT THIS PHASE
- STORM BUILT PREVIOUS PHASE
- 12" W WATER BUILT THIS PHASE
- 12" W WATER BUILT PREVIOUS PHASE
- 8" SS SANITARY BUILT THIS PHASE
- 8" SS SANITARY BUILT PREVIOUS PHASE
- UG ELEC DUCT BANK BUILT THIS PHASE
- UG ELEC DUCT BANK BUILT PREVIOUS PHASE
- OH ELEC OVERHEAD ELECT. BUILT THIS PHASE
- OH ELEC OVERHEAD ELECT. BUILT PREVIOUS PHASE
- REMOVABLE 4" SOLID WHITE
- REMOVABLE 4" BROKEN WHITE
- REMOVABLE 4" DOTTED WHITE
- REMOVABLE 24" STOP BAR
- REMOVABLE 4" SOLID YELLOW
- EXISTING / PREVIOUS PAV MARKINGS

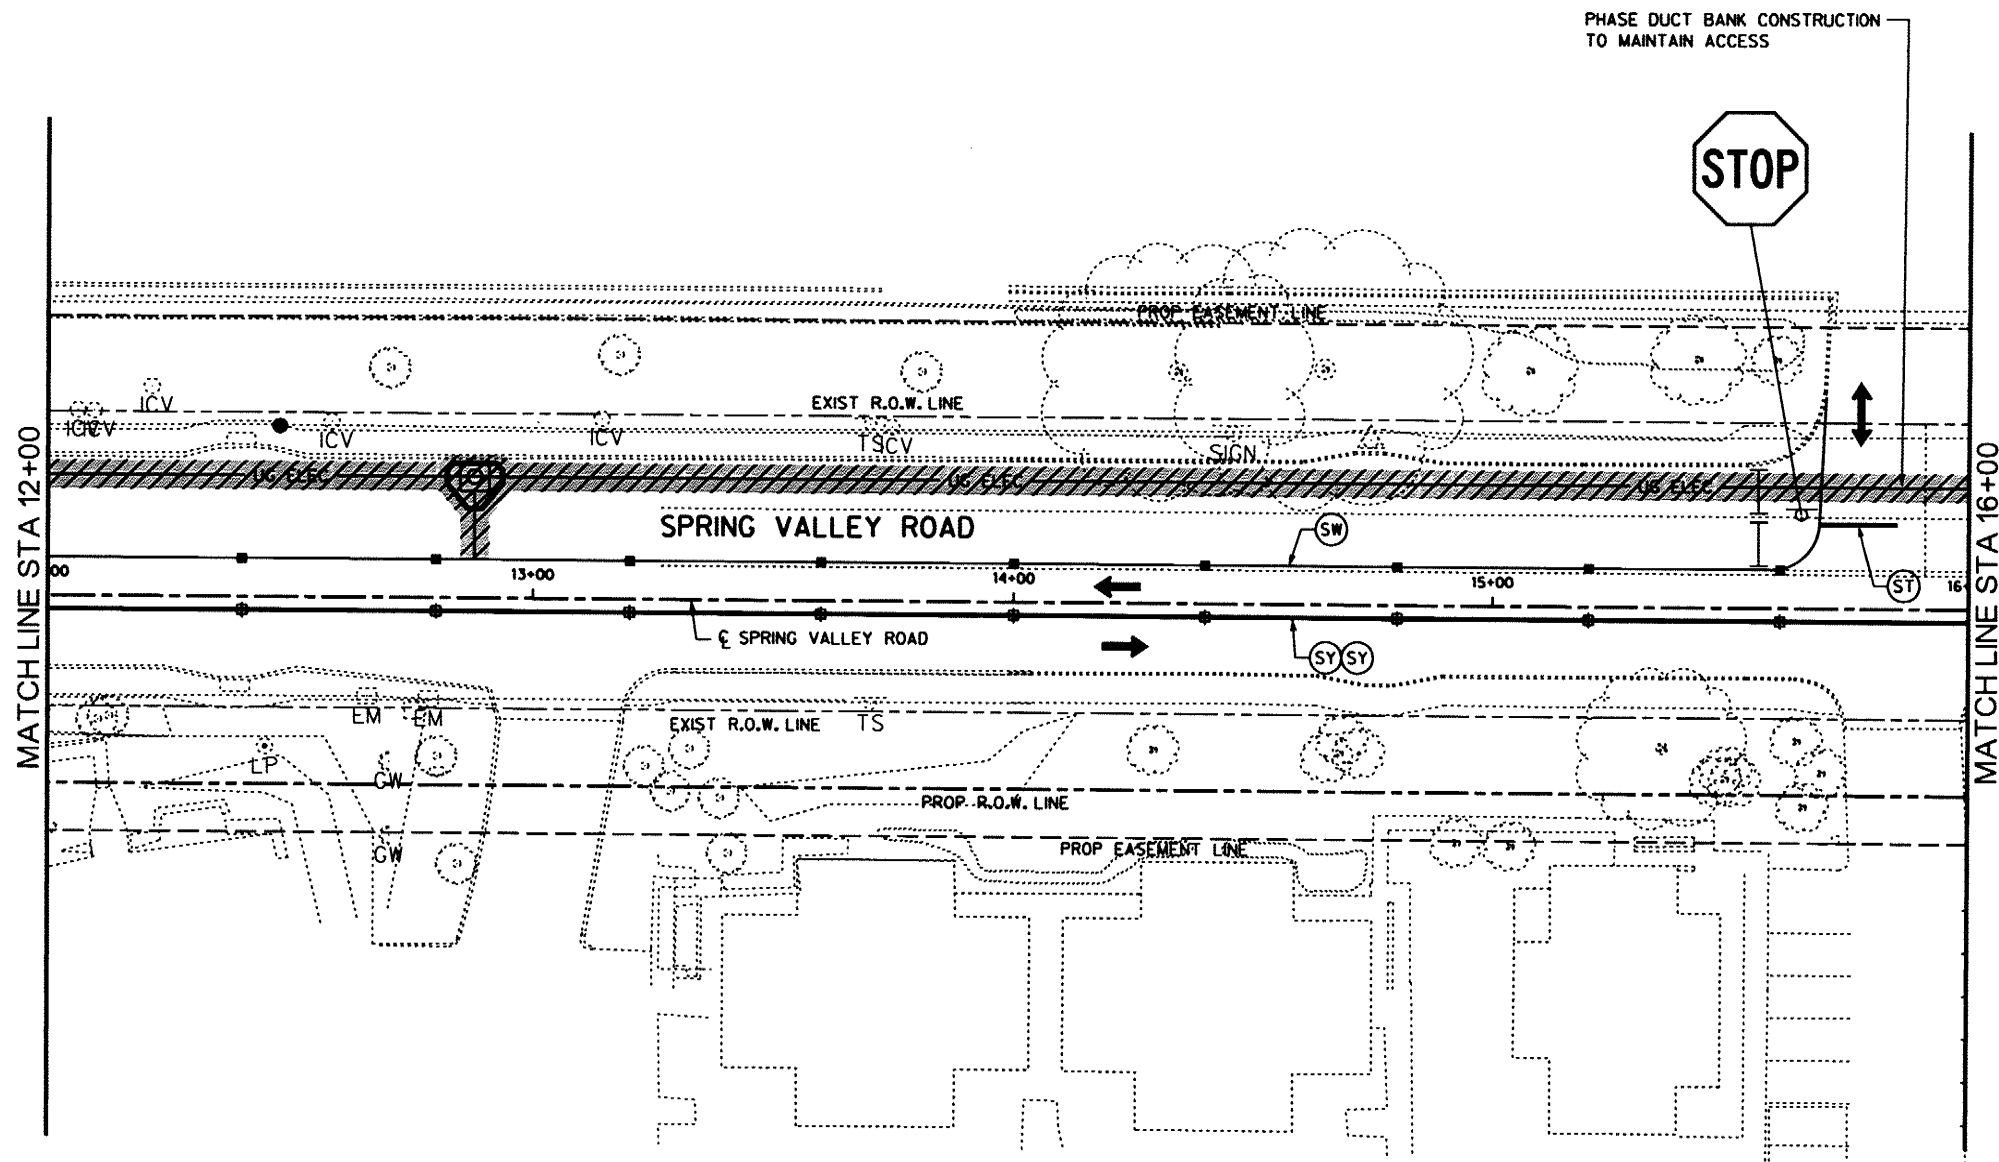

RECORD DOCUMENTS
 December, 2011
 These Record Documents have been prepared based upon information provided by North Texas Contracting, Inc. The Design Professional has not verified the accuracy and / or completeness of this information and shall not be responsible for any errors or omissions which may be incorporated herein as a result.


Design Consultant: Half Associates, Inc.
 RECORD DRAWING SUBMITTAL



M.E. Romandowski
 Signature of Registrant
 12/8/2011
 Date

NO.	REVISION	BY	DATE
TOWN OF ADDISON DALLAS COUNTY, TEXAS SPRING VALLEY ROAD TRAFFIC CONTROL PLAN PHASE 1B			
1201 NORTH BOWSER ROAD, RICHARDSON, TEXAS 75081-2275 TEL (214) 346-8200 FAX (214) 730-0085			
PROJECT	DESIGN	DRAWN	DATE
27530	MPB	TMM	OCTOBER 2010
FILE	SHEET		
27530 TCP 01-02-02	TCP-04		

DATE: 12/7/2011 TIME: 10:33:00 AM FILE: 27530 TCP 01-02-04.dgn PROJECT: 27530 OFFICE: RCH USER: ch1299

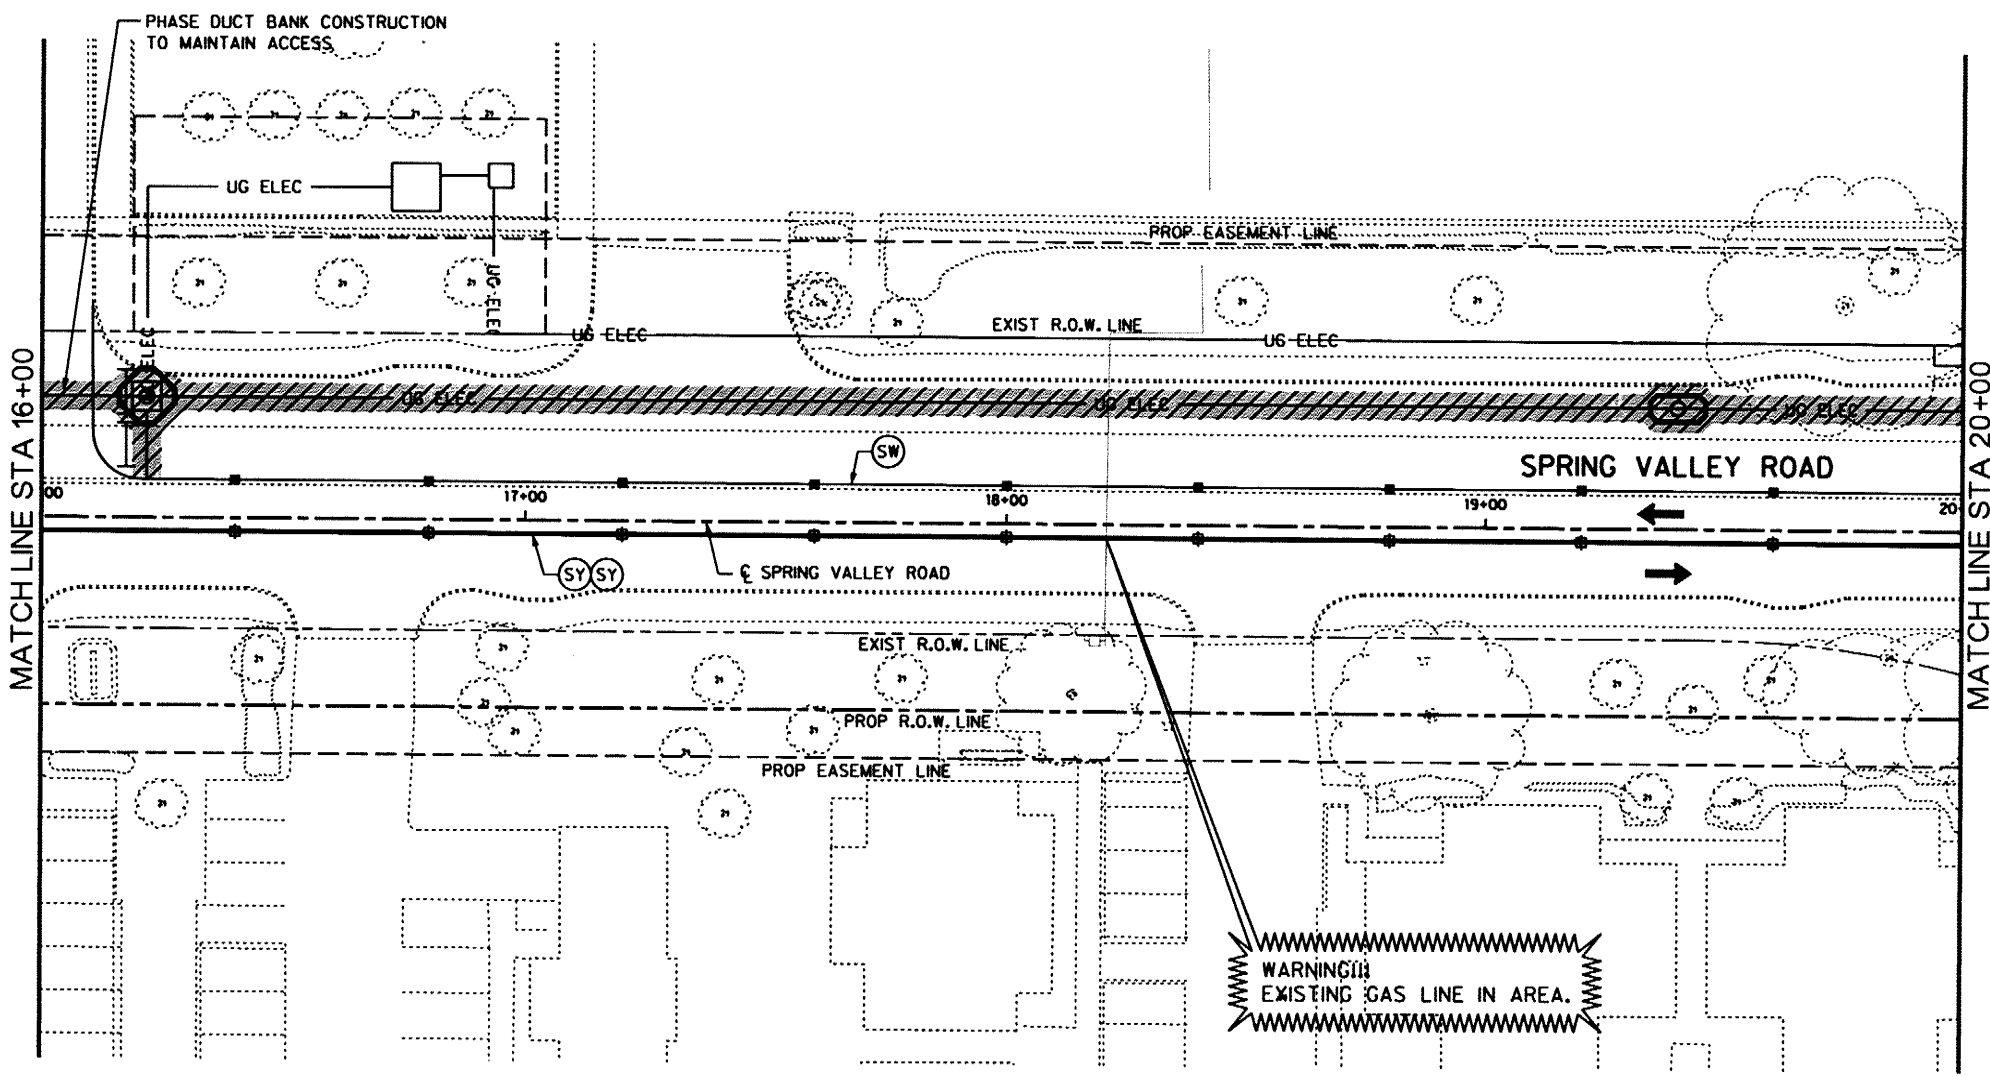

TRAFFIC CONTROL LEGEND:

- TEMPORARY 8\"/>
- PAVEMENT CONSTRUCTED IN THIS PHASE
- PAVEMENT CONSTRUCTED IN PREVIOUS PHASE
- TEMPORARY PAVEMENT HMAC WIDENING PREVIOUS PHASE
- TRAFFIC FLOW DIRECTION
- CONSTRUCTION SIGN
- PLASTIC DRUM CHANNELIZING DEVICE
- VERTICAL PANEL WITH TWO WAY TRAFFIC SIGN ON BOTH SIDES
- VERTICAL PANEL (VP)
- TYPE III BARRICADE
- STORM BUILT THIS PHASE
- STORM BUILT PREVIOUS PHASE
- 12\"/>
- 12\"/>
- 8\"/>
- 8\"/>
- UG ELEC- DUCT BANK BUILT THIS PHASE
- UG ELEC- DUCT BANK BUILT PREVIOUS PHASE
- OH ELEC- OVERHEAD ELECT. BUILT THIS PHASE
- OH ELEC- OVERHEAD ELECT. BUILT PREVIOUS PHASE
- REMOVABLE 4\"/>
- REMOVABLE 4\"/>
- REMOVABLE 4\"/>
- REMOVABLE 24\"/>
- REMOVABLE 4\"/>
- EXISTING / PREVIOUS PAV MARKINGS

RECORD DOCUMENTS
 December, 2011
 These Record Documents have been prepared based upon information provided by North Texas Contracting, Inc. The Design Professional has not verified the accuracy and / or completeness of this information and shall not be responsible for any errors or omissions which may be incorporated herein as a result

Design Consultant: Half Associates, Inc.
 RECORD DRAWING SUBMITTAL




[Signature]
 Signature of Registrant Date 12/6/2011

WARNING
 EXISTING GAS LINE IN AREA.

SHEET 63 OF 163 RECORD DRAWINGS

NO.	REVISION	BY	DATE		
TOWN OF ADDISON DALLAS COUNTY, TEXAS SPRING VALLEY ROAD TRAFFIC CONTROL PLAN PHASE 1B					
1301 NORTH BOWSER ROAD, RICHARDSON, TEXAS 75081-2275 TEL (214) 346-4200 FAX (214) 739-0085					
PROJECT	DESIGN	DRAWN	DATE	FILE	SHEET
27530	MPB	TMM	OCTOBER 2010	27530 TCP 01-02-03	TCP-05

DATE: 12/7/2011 TIME: 10:33:11 AM FILE: 27530.TCP.01-02-05.dgn PROJECT: 27530 OFFICE: RCH USER: ohi299

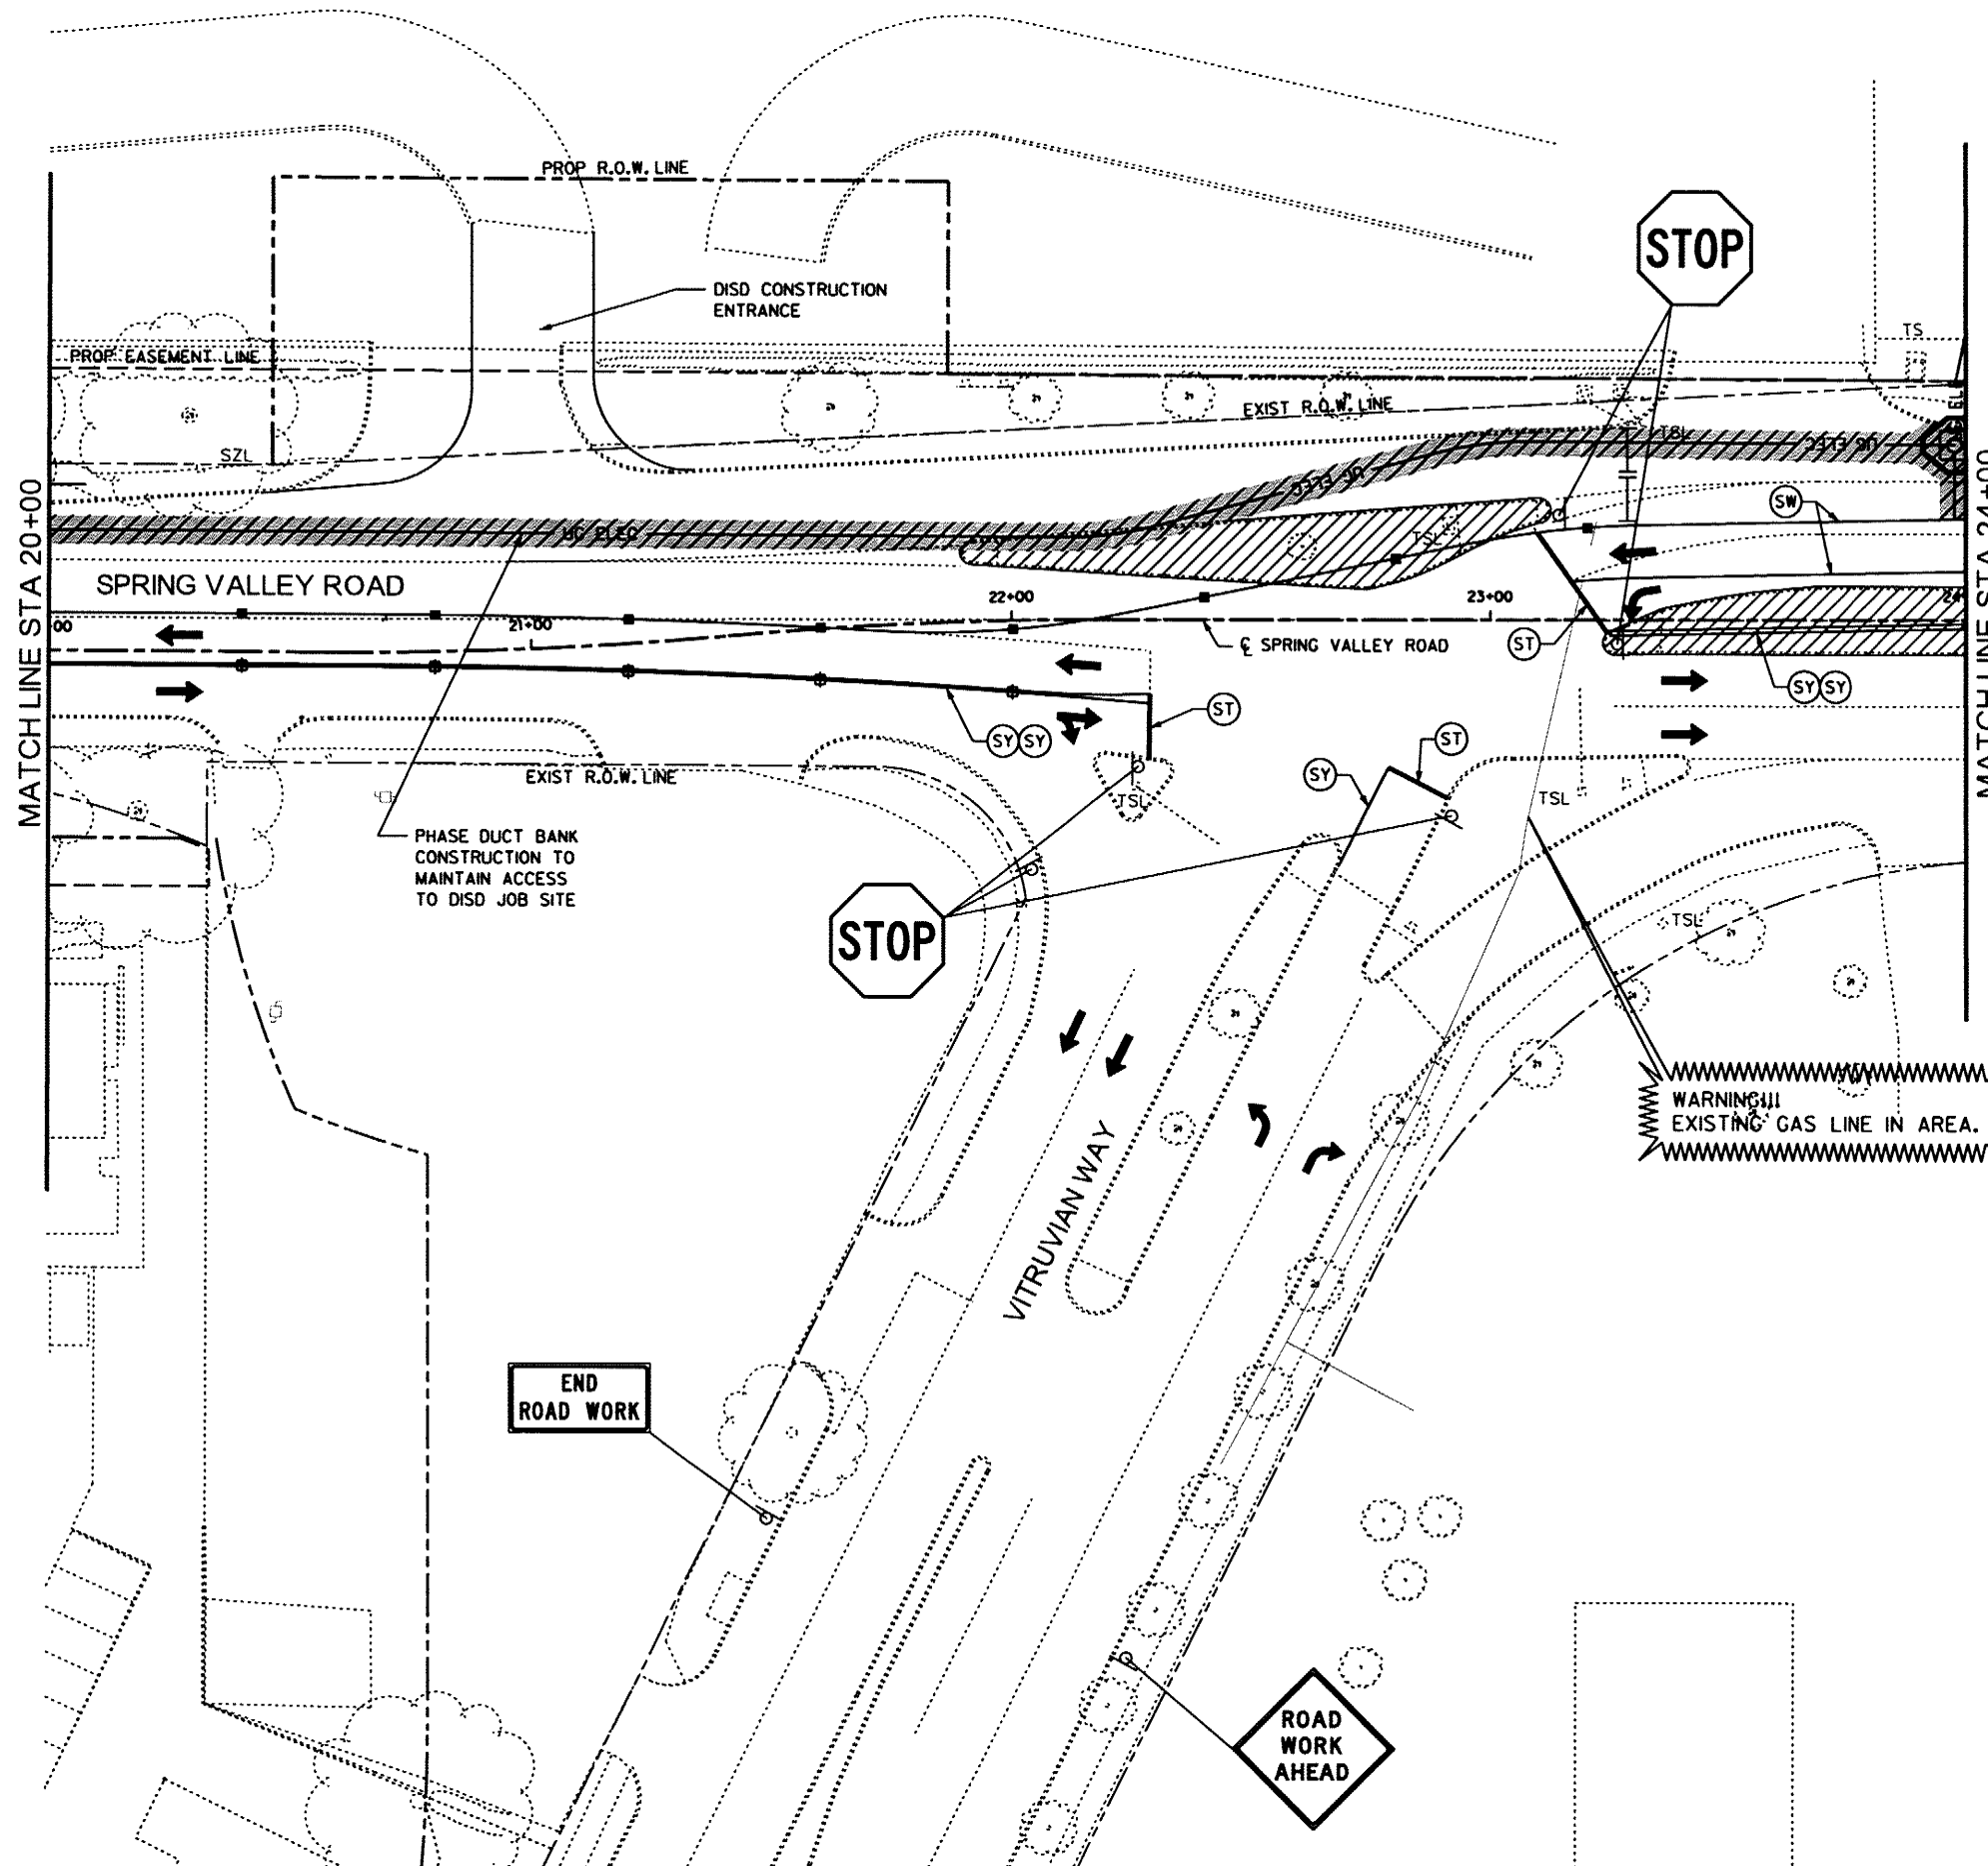

TRAFFIC CONTROL LEGEND:

- TEMPORARY 8" HMAC PAVEMENT
- PAVEMENT CONSTRUCTED IN THIS PHASE
- PAVEMENT CONSTRUCTED IN PREVIOUS PHASE
- TEMPORARY PAVEMENT HMAC WIDENING PREVIOUS PHASE
- TRAFFIC FLOW DIRECTION
- CONSTRUCTION SIGN
- PLASTIC DRUM CHANNELIZING DEVICE
- VERTICAL PANEL WITH TWO WAY TRAFFIC SIGN ON BOTH SIDES
- VERTICAL PANEL (VP)
- TYPE III BARRIcade
- STORM BUILT THIS PHASE
- STORM BUILT PREVIOUS PHASE
- 12" W WATER BUILT THIS PHASE
- 12" W WATER BUILT PREVIOUS PHASE
- 8" SS SANITARY BUILT THIS PHASE
- 8" SS SANITARY BUILT PREVIOUS PHASE
- UG ELEC DUCT BANK BUILT THIS PHASE
- UG ELEC DUCT BANK BUILT PREVIOUS PHASE
- OH ELEC OVERHEAD ELECT. BUILT THIS PHASE
- OH ELEC OVERHEAD ELECT. BUILT PREVIOUS PHASE
- REMOVABLE 4" SOLID WHITE
- REMOVABLE 4" BROKEN WHITE
- REMOVABLE 4" DOTTED WHITE
- REMOVABLE 24" STOP BAR
- REMOVABLE 4" SOLID YELLOW
- EXISTING / PREVIOUS PAV MARKINGS

RECORD DOCUMENTS
 December, 2011
 These Record Documents have been prepared based upon information provided by North Texas Contracting, Inc. The Design Professional has not verified the accuracy and / or completeness of this information and shall not be responsible for any errors or omissions which may be incorporated herein as a result.




Design Consultant: Half Associates, Inc.
 RECORD DRAWING SUBMITTAL
 Signature of Registrant: *[Signature]* Date: 12/8/2011

RECORD DRAWINGS SHEET 64 OF 163

NO.		REVISION		BY		DATE	
TOWN OF ADDISON DALLAS COUNTY, TEXAS SPRING VALLEY ROAD TRAFFIC CONTROL PLAN PHASE 1B							
		1201 NORTH BOWSER ROAD, RICHARDSON, TEXAS 75081-2275 TEL (214) 348-6200 FAX (214) 736-0085					
PROJECT	DESIGN	DRAWN	DATE	FILE	SHEET		
27530	MPB	TMM	OCTOBER 2010	27530 TCP 01-02-05	TCP-06		

DATE: 12/7/2011 TIME: 10:33:25 AM FILE: 27530 TCP 01-02-06.dgn PROJECT: 27530 OFFICE: RCH USER: chl299

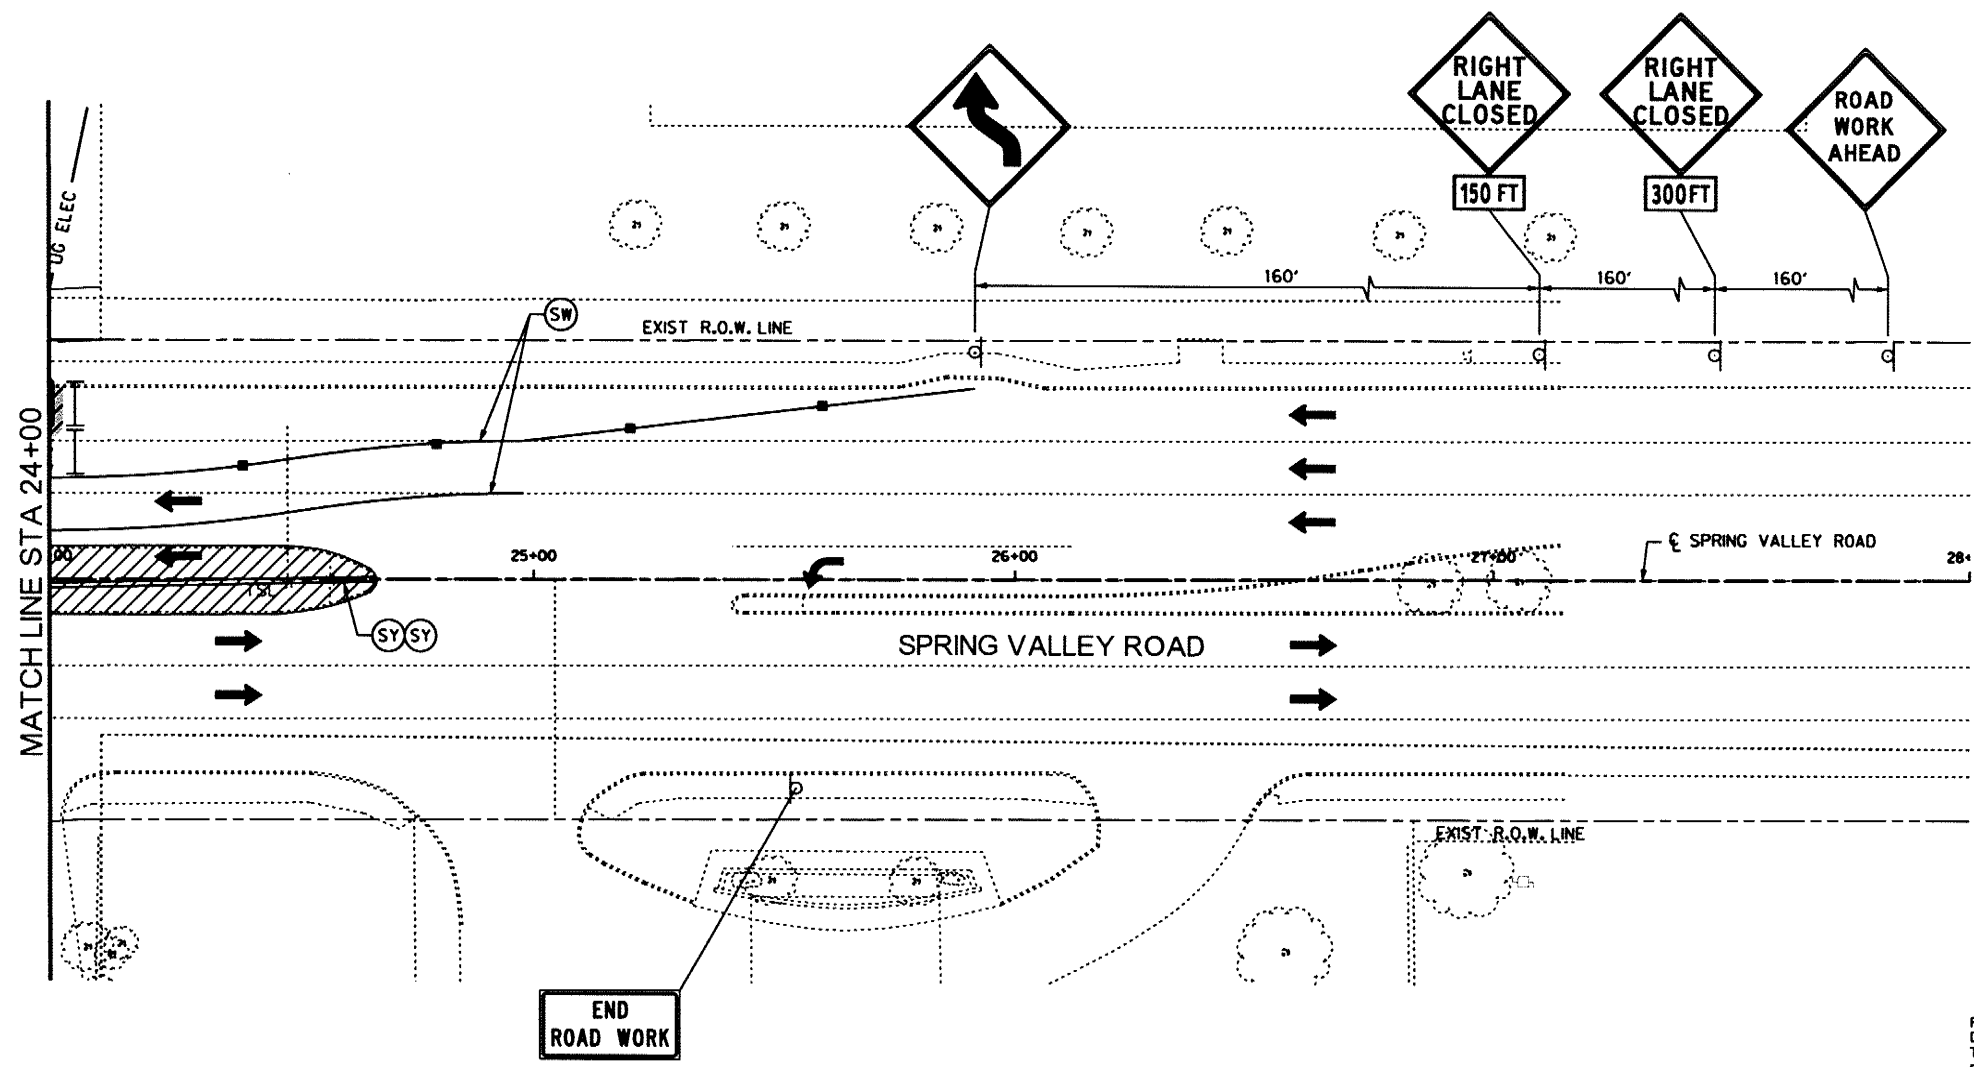

TRAFFIC CONTROL LEGEND:

- TEMPORARY 8\"/>
- PAVEMENT CONSTRUCTED IN THIS PHASE
- PAVEMENT CONSTRUCTED IN PREVIOUS PHASE
- TEMPORARY PAVEMENT HMAC WIDENING PREVIOUS PHASE
- TRAFFIC FLOW DIRECTION
- CONSTRUCTION SIGN
- PLASTIC DRUM CHANNELIZING DEVICE
- VERTICAL PANEL WITH TWO WAY TRAFFIC SIGN ON BOTH SIDES
- VERTICAL PANEL (VP)
- TYPE III BARRICADE
- STORM BUILT THIS PHASE
- STORM BUILT PREVIOUS PHASE
- 12\"/>
- 12\"/>
- 8\"/>
- 8\"/>
- DUCT BANK BUILT THIS PHASE
- DUCT BANK BUILT PREVIOUS PHASE
- OVERHEAD ELECT. BUILT THIS PHASE
- OVERHEAD ELECT. BUILT PREVIOUS PHASE
- REMOVABLE 4\"/>
- REMOVABLE 4\"/>
- REMOVABLE 4\"/>
- REMOVABLE 24\"/>
- REMOVABLE 4\"/>
- EXISTING / PREVIOUS PAV MARKINGS

RECORD DOCUMENTS
 December, 2011
 These Record Documents have been prepared based upon information provided by North Texas Contracting, Inc. The Design Professional has not verified the accuracy and / or completeness of this information and shall not be responsible for any errors or omissions which may be incorporated herein as a result.

Design Consultant: Half Associates, Inc.
 RECORD DRAWING SUBMITTAL



Signature of Registrant: *M.E. Romanowski* P.E. Date: 12/6/2011

SHEET 65 OF 163 RECORD DRAWINGS

NO.	REVISION	BY	DATE
TOWN OF ADDISON DALLAS COUNTY, TEXAS SPRING VALLEY ROAD TRAFFIC CONTROL PLAN PHASE 1B			
1201 NORTH BOWSER ROAD, RICHARDSON, TEXAS 75081-2275 TEL (214) 348-6200 FAX (214) 738-0085			
PROJECT	DESIGN	DRAWN	DATE
27530	MPB	TMM	OCTOBER 2010
FILE	SHEET		
27530 TCP 01-02-05	TCP-07		

DATE: 12/7/2011 TIME: 10:33:41 AM FILE: 27530.TCP.02-01-01.dwg PROJECT: 27530 OFFICE: RCH USER: oh1299

SCALE IN FEET

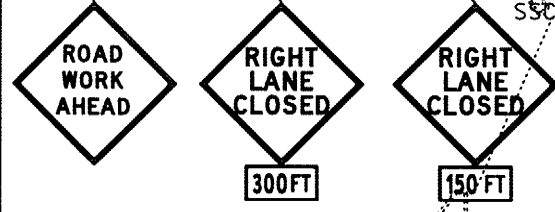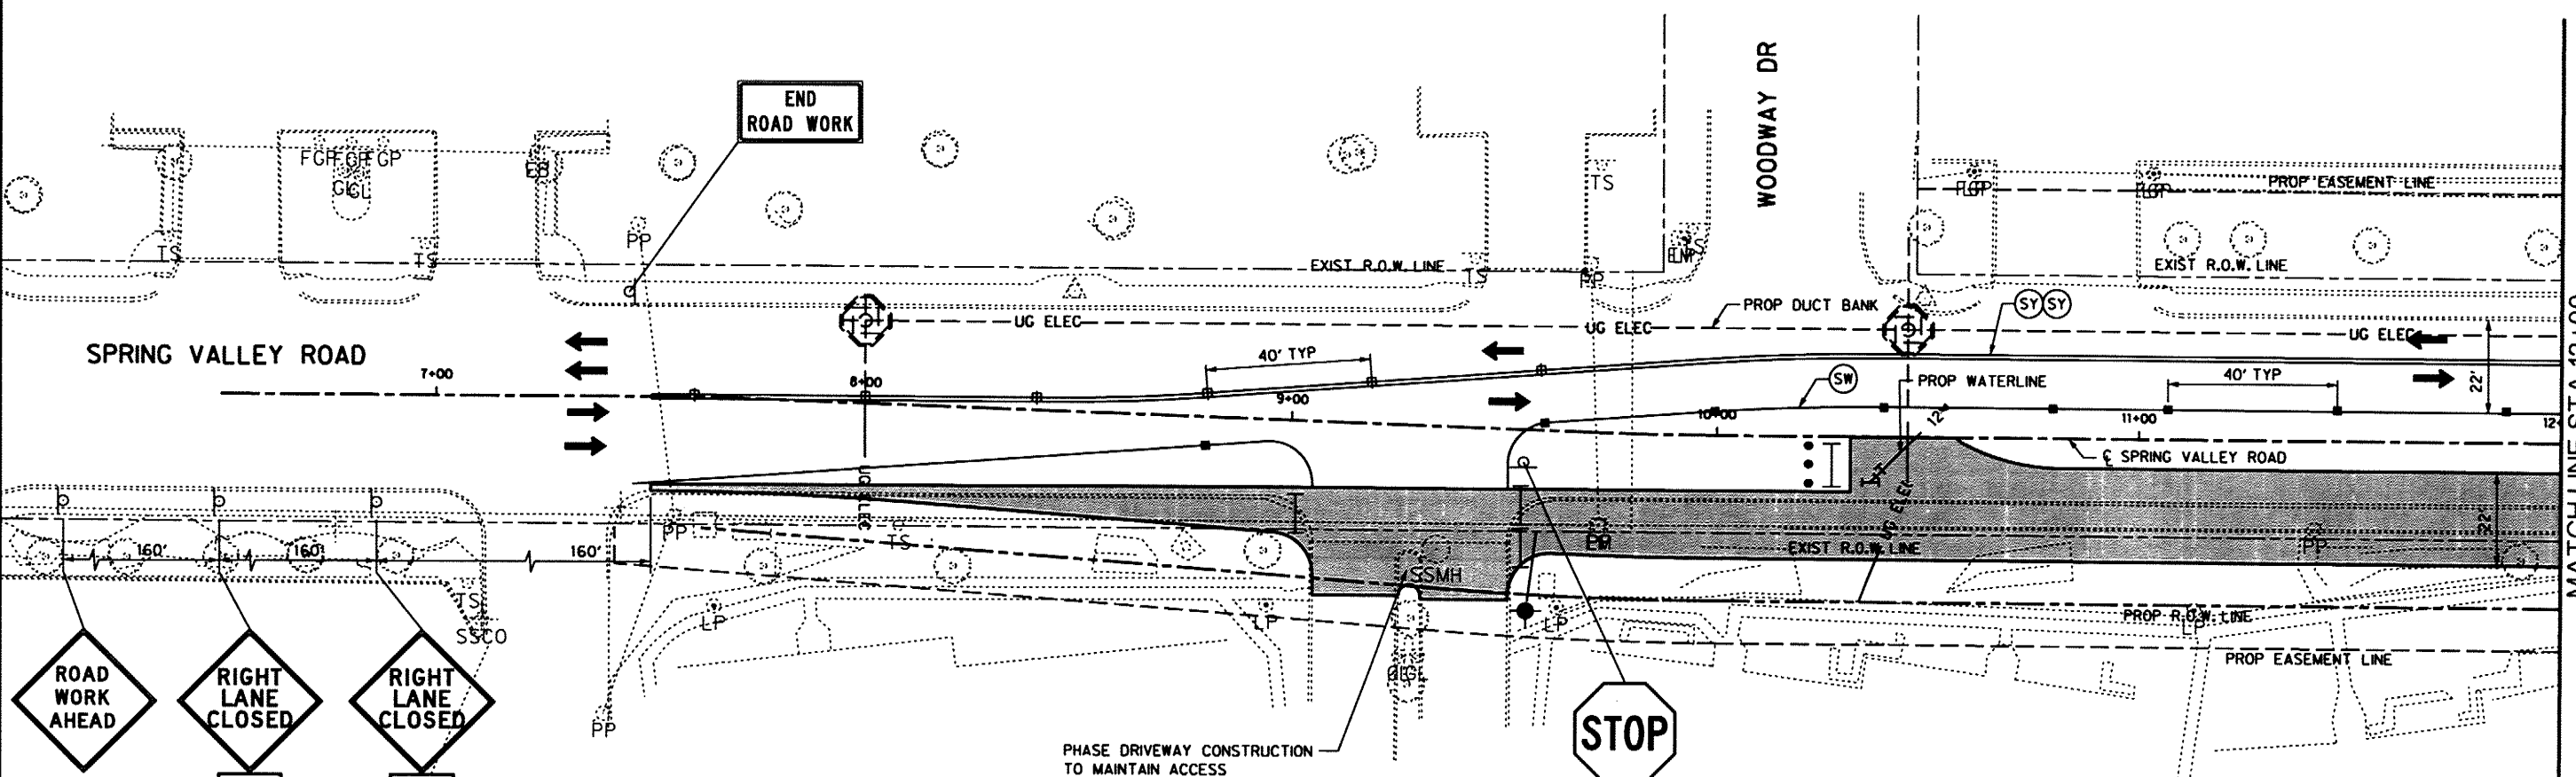

PHASE DRIVEWAY CONSTRUCTION TO MAINTAIN ACCESS



TRAFFIC CONTROL LEGEND:

- TEMPORARY 8" HMAC PAVEMENT
- PAVEMENT CONSTRUCTED IN THIS PHASE
- PAVEMENT CONSTRUCTED IN PREVIOUS PHASE
- TEMPORARY PAVEMENT HMAC WIDENING PREVIOUS PHASE
- TRAFFIC FLOW DIRECTION
- CONSTRUCTION SIGN
- PLASTIC DRUM CHANNELIZING DEVICE
- VERTICAL PANEL WITH TWO WAY TRAFFIC SIGN ON BOTH SIDES
- VERTICAL PANEL (VP)
- TYPE III BARRICADE
- STORM BUILT THIS PHASE
- STORM BUILT PREVIOUS PHASE
- 12" W WATER BUILT THIS PHASE
- 12" W WATER BUILT PREVIOUS PHASE
- 8" SS SANITARY BUILT THIS PHASE
- 8" SS SANITARY BUILT PREVIOUS PHASE
- UG ELEC DUCT BANK BUILT THIS PHASE
- UG ELEC DUCT BANK BUILT PREVIOUS PHASE
- OH ELEC OVERHEAD ELECT. BUILT THIS PHASE
- OH ELEC OVERHEAD ELECT. BUILT PREVIOUS PHASE
- REMOVABLE 4" SOLID WHITE
- REMOVABLE 4" BROKEN WHITE
- REMOVABLE 4" DOTTED WHITE
- REMOVABLE 24" STOP BAR
- REMOVABLE 4" SOLID YELLOW
- EXISTING / PREVIOUS PAV MARKINGS

RECORD DOCUMENTS
 December, 2011
 These Record Documents have been prepared based upon information provided by North Texas Contracting, Inc. The Design Professional has not verified the accuracy and / or completeness of this information and shall not be responsible for any errors or omissions which may be incorporated herein as a result.

Design Consultant: Half Associates, Inc.
 RECORD DRAWING SUBMITTAL



M.E. Romanowski
 Signature of Registrant Date 12/8/2011

NO.	REVISION	BY	DATE		
TOWN OF ADDISON DALLAS COUNTY, TEXAS SPRING VALLEY ROAD					
TRAFFIC CONTROL PLAN PHASE 2					
HALFF 1201 NORTH BOWSER ROAD, RICHARDSON, TEXAS 75081-2275 TEL (214) 348-6200 FAX (214) 738-0095					
PROJECT	DESIGN	DRAWN	DATE	FILE	SHEET
27530	MPB	TMM	OCTOBER 2010	27530 TCP 02-01-01	TCP-08


DATE: 12/7/2011 TIME: 10:33:54 AM FILE: 27530.TCP.02-01-02.dgn PROJECT: 27530 OFFICE: RCH USER: gh1299

SCALE IN FEET



TRAFFIC CONTROL LEGEND:

- TEMPORARY 8" HMAC PAVEMENT
- PAVEMENT CONSTRUCTED IN THIS PHASE
- PAVEMENT CONSTRUCTED IN PREVIOUS PHASE
- TEMPORARY PAVEMENT HMAC WIDENING PREVIOUS PHASE
- TRAFFIC FLOW DIRECTION
- CONSTRUCTION SIGN
- PLASTIC DRUM CHANNELIZING DEVICE
- VERTICAL PANEL WITH TWO WAY TRAFFIC SIGN ON BOTH SIDES
- VERTICAL PANEL (VP)
- TYPE III BARRICADE
- STORM BUILT THIS PHASE
- STORM BUILT PREVIOUS PHASE
- 12" W WATER BUILT THIS PHASE
- 12" W WATER BUILT PREVIOUS PHASE
- 8" SS SANITARY BUILT THIS PHASE
- 8" SS SANITARY BUILT PREVIOUS PHASE
- UG ELEC- DUCT BANK BUILT THIS PHASE
- UG ELEC- DUCT BANK BUILT PREVIOUS PHASE
- OH ELEC- OVERHEAD ELECT. BUILT THIS PHASE
- OH ELEC- OVERHEAD ELECT. BUILT PREVIOUS PHASE
- REMOVABLE 4" SOLID WHITE
- REMOVABLE 4" BROKEN WHITE
- REMOVABLE 4" DOTTED WHITE
- REMOVABLE 24" STOP BAR
- REMOVABLE 4" SOLID YELLOW
- EXISTING / PREVIOUS PAV MARKINGS

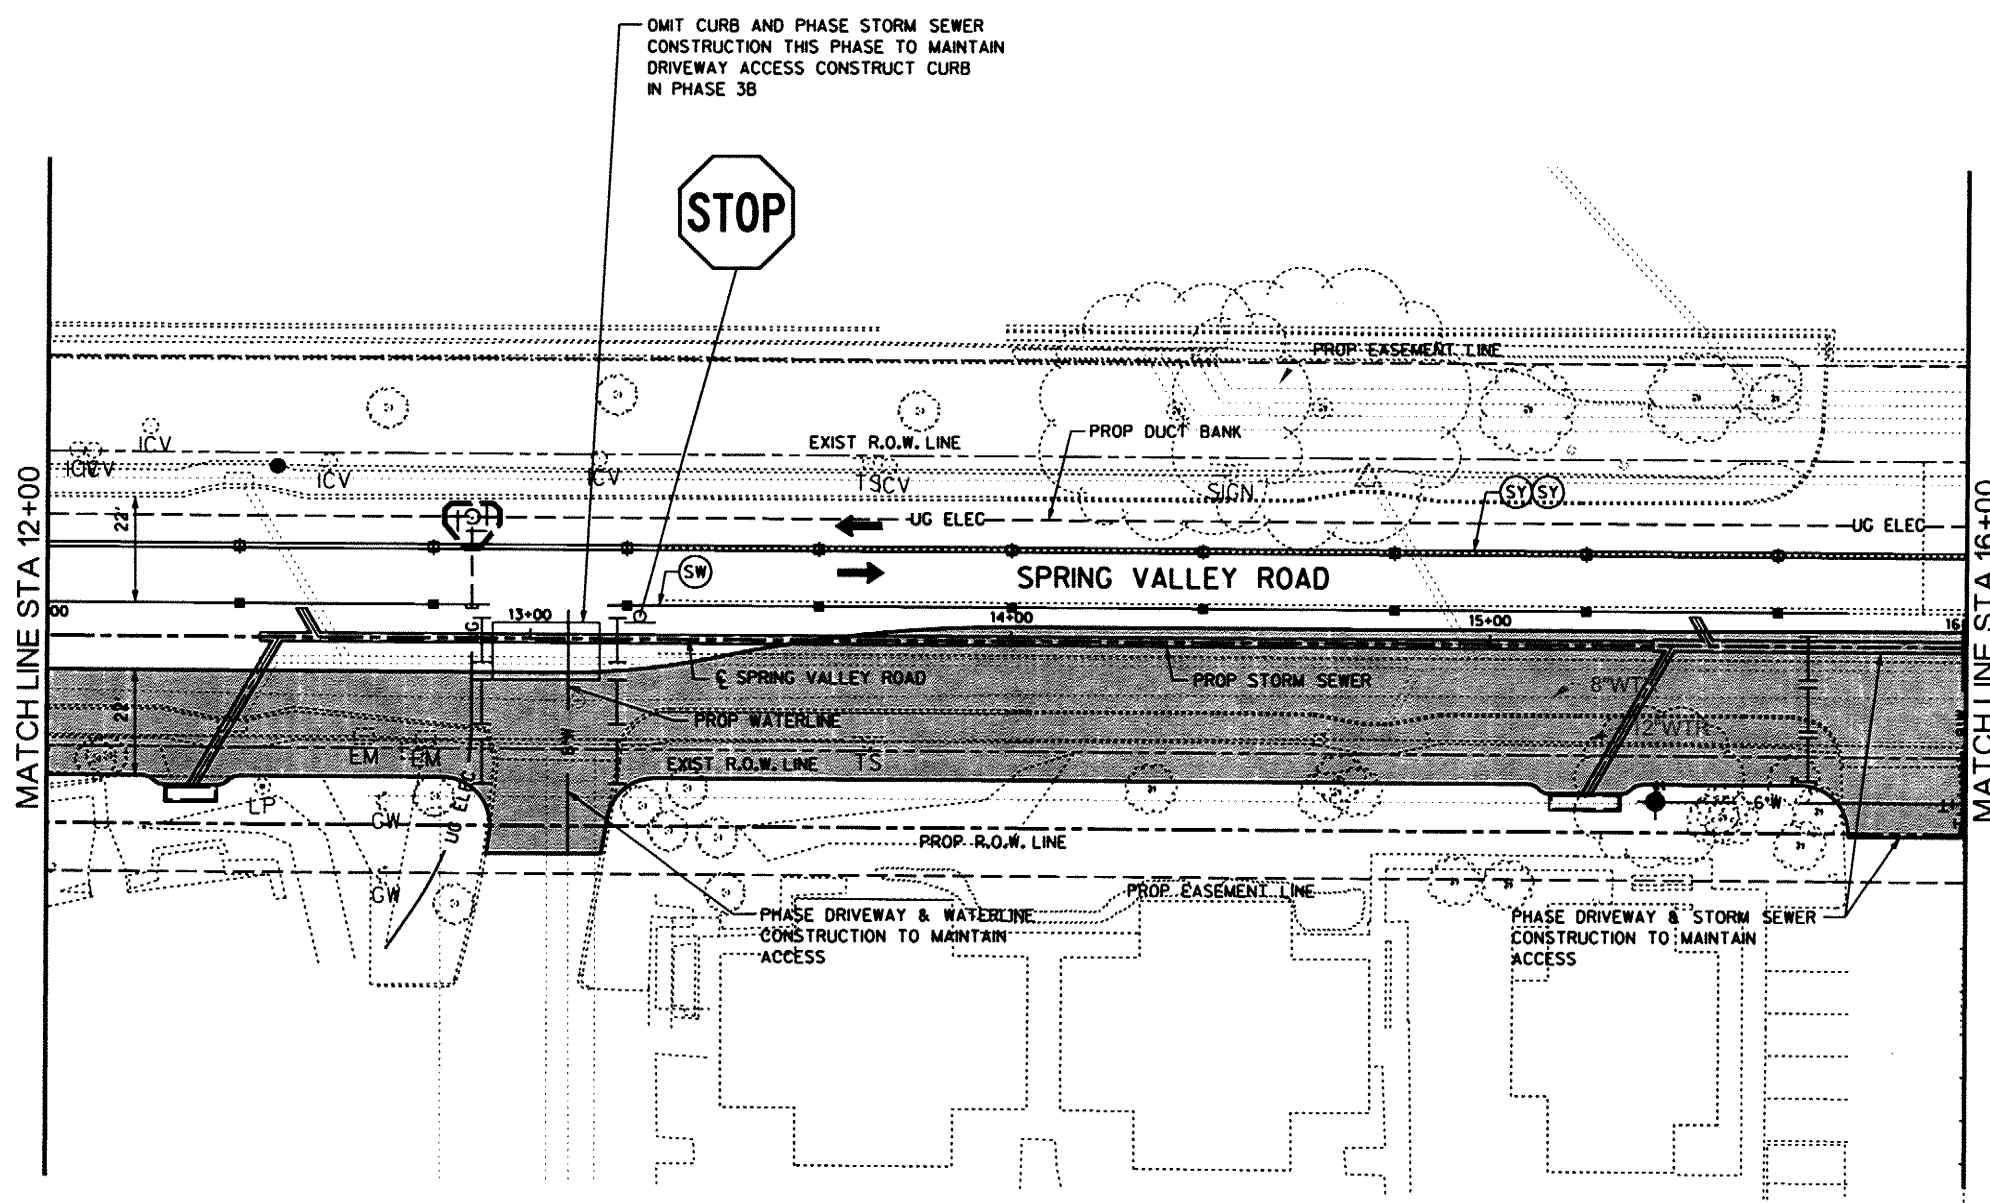


RECORD DOCUMENTS
 December, 2011
 These Record Documents have been prepared based upon information provided by North Texas Contracting, Inc. The Design Professional has not verified the accuracy and / or completeness of this information and shall not be responsible for any errors or omissions which may be incorporated herein as a result.
 Design Consultant: Half Associates, Inc.
 RECORD DRAWING SUBMITTAL

Signature of Registrant: *M.E. Romanowski*
 Date: 12/6/2011

NO.	REVISION	BY	DATE
TOWN OF ADDISON DALLAS COUNTY, TEXAS SPRING VALLEY ROAD TRAFFIC CONTROL PLAN PHASE 2			
1201 NORTH BOWSER ROAD, RICHARDSON, TEXAS 75081-2275 TEL (214) 348-6200 FAX (214) 738-0086			
PROJECT	DESIGN	DRAWN	DATE
27530	MPB	TMM	OCTOBER 2010
FILE	SHEET		
27530 TCP-01-02	TCP-09		

RECORD DRAWINGS SHEET 67 OF 163

DATE: 12/7/2011 TIME: 10:34:08 AM FILE: 27530.TCP.02-01-03.dgn PROJECT: 27530 OFFICE: RCH USER: ah1299

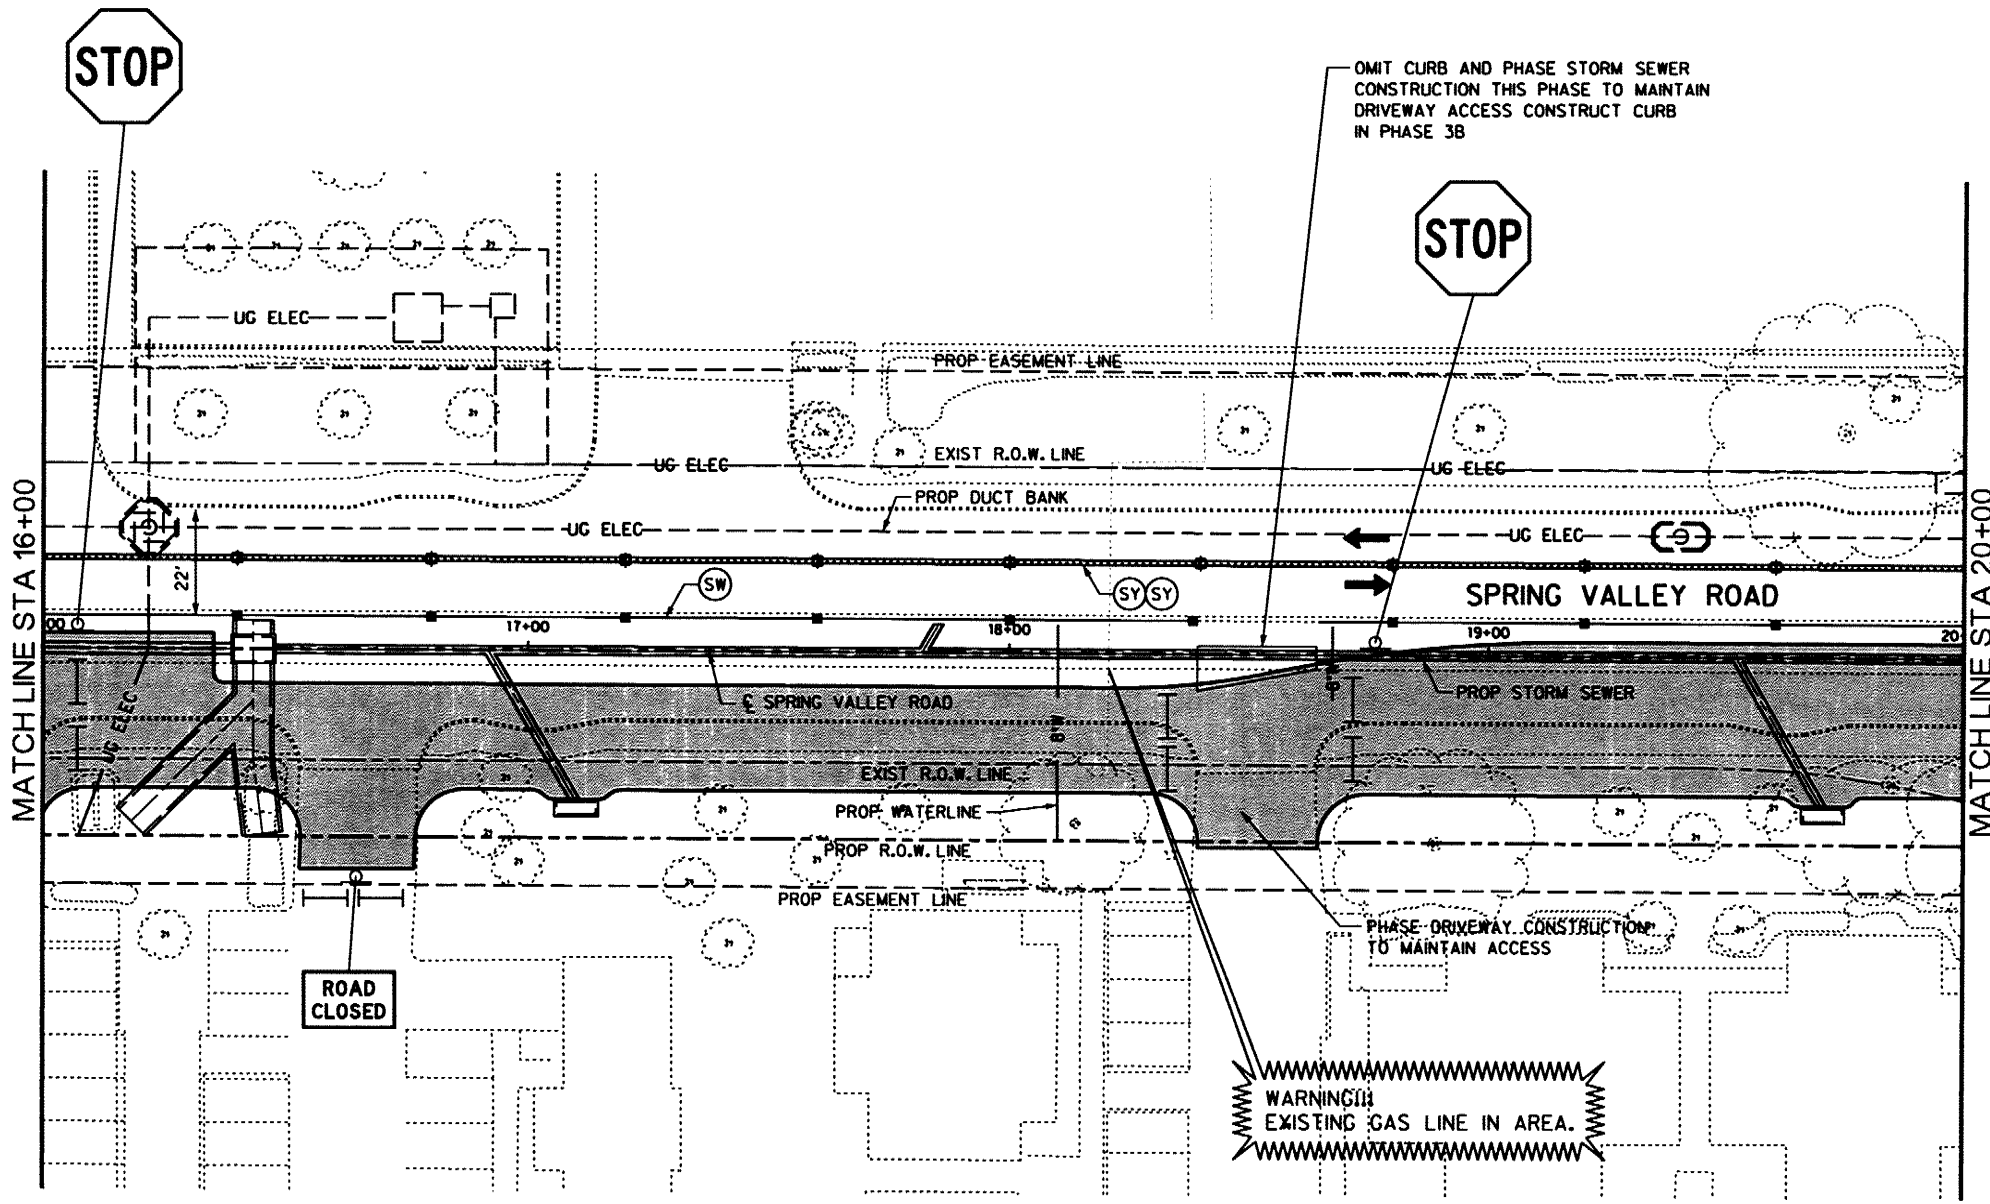

TRAFFIC CONTROL LEGEND:

- TEMPORARY 8" HMAC PAVEMENT
- PAVEMENT CONSTRUCTED IN THIS PHASE
- PAVEMENT CONSTRUCTED IN PREVIOUS PHASE
- TEMPORARY PAVEMENT HMAC WIDENING PREVIOUS PHASE
- TRAFFIC FLOW DIRECTION
- CONSTRUCTION SIGN
- PLASTIC DRUM CHANNELIZING DEVICE
- VERTICAL PANEL WITH TWO WAY TRAFFIC SIGN ON BOTH SIDES
- VERTICAL PANEL (VP)
- TYPE III BARRICADE
- STORM BUILT THIS PHASE
- STORM BUILT PREVIOUS PHASE
- 12"W WATER BUILT THIS PHASE
- 12"W WATER BUILT PREVIOUS PHASE
- 8" SS SANITARY BUILT THIS PHASE
- 8" SS SANITARY BUILT PREVIOUS PHASE
- UG ELEC DUCT BANK BUILT THIS PHASE
- UG ELEC DUCT BANK BUILT PREVIOUS PHASE
- OH ELEC OVERHEAD ELECT. BUILT THIS PHASE
- OH ELEC OVERHEAD ELECT. BUILT PREVIOUS PHASE
- REMOVABLE 4" SOLID WHITE
- REMOVABLE 4" BROKEN WHITE
- REMOVABLE 4" DOTTED WHITE
- REMOVABLE 24" STOP BAR
- REMOVABLE 4" SOLID YELLOW
- EXISTING / PREVIOUS PAV MARKINGS

OMIT CURB AND PHASE STORM SEWER CONSTRUCTION THIS PHASE TO MAINTAIN DRIVEWAY ACCESS CONSTRUCT CURB IN PHASE 3B

WARNING!! EXISTING GAS LINE IN AREA.

RECORD DOCUMENTS
December, 2011
These Record Documents have been prepared based upon information provided by North Texas Contracting, Inc. The Design Professional has not verified the accuracy and / or completeness of this information and shall not be responsible for any errors or omissions which may be incorporated herein as a result.

Design Consultant: Half Associates, Inc.
RECORD DRAWING SUBMITTAL


Signature of Registrant: *[Signature]* Date: 12/8/2011

SHEET 68 OF 163

RECORD DRAWINGS

NO.	REVISION	BY	DATE		
TOWN OF ADDISON DALLAS COUNTY, TEXAS SPRING VALLEY ROAD TRAFFIC CONTROL PLAN PHASE 2					
1201 NORTH BOWSER ROAD, RICHARDSON, TEXAS 75081-2275 TEL (214) 348-8200 FAX (214) 730-0085					
PROJECT	DESIGN	DRAWN	DATE	FILE	SHEET
27530	MPB	TMM	OCTOBER 2010	27530 TCP 02-01-03	TCP-10

DATE: 12/7/2011 TIME: 10:34:21 AM FILE: 27530 TCP 02-01-04.dgn PROJECT: 27530 OFFICE: RCH USER: ohi299

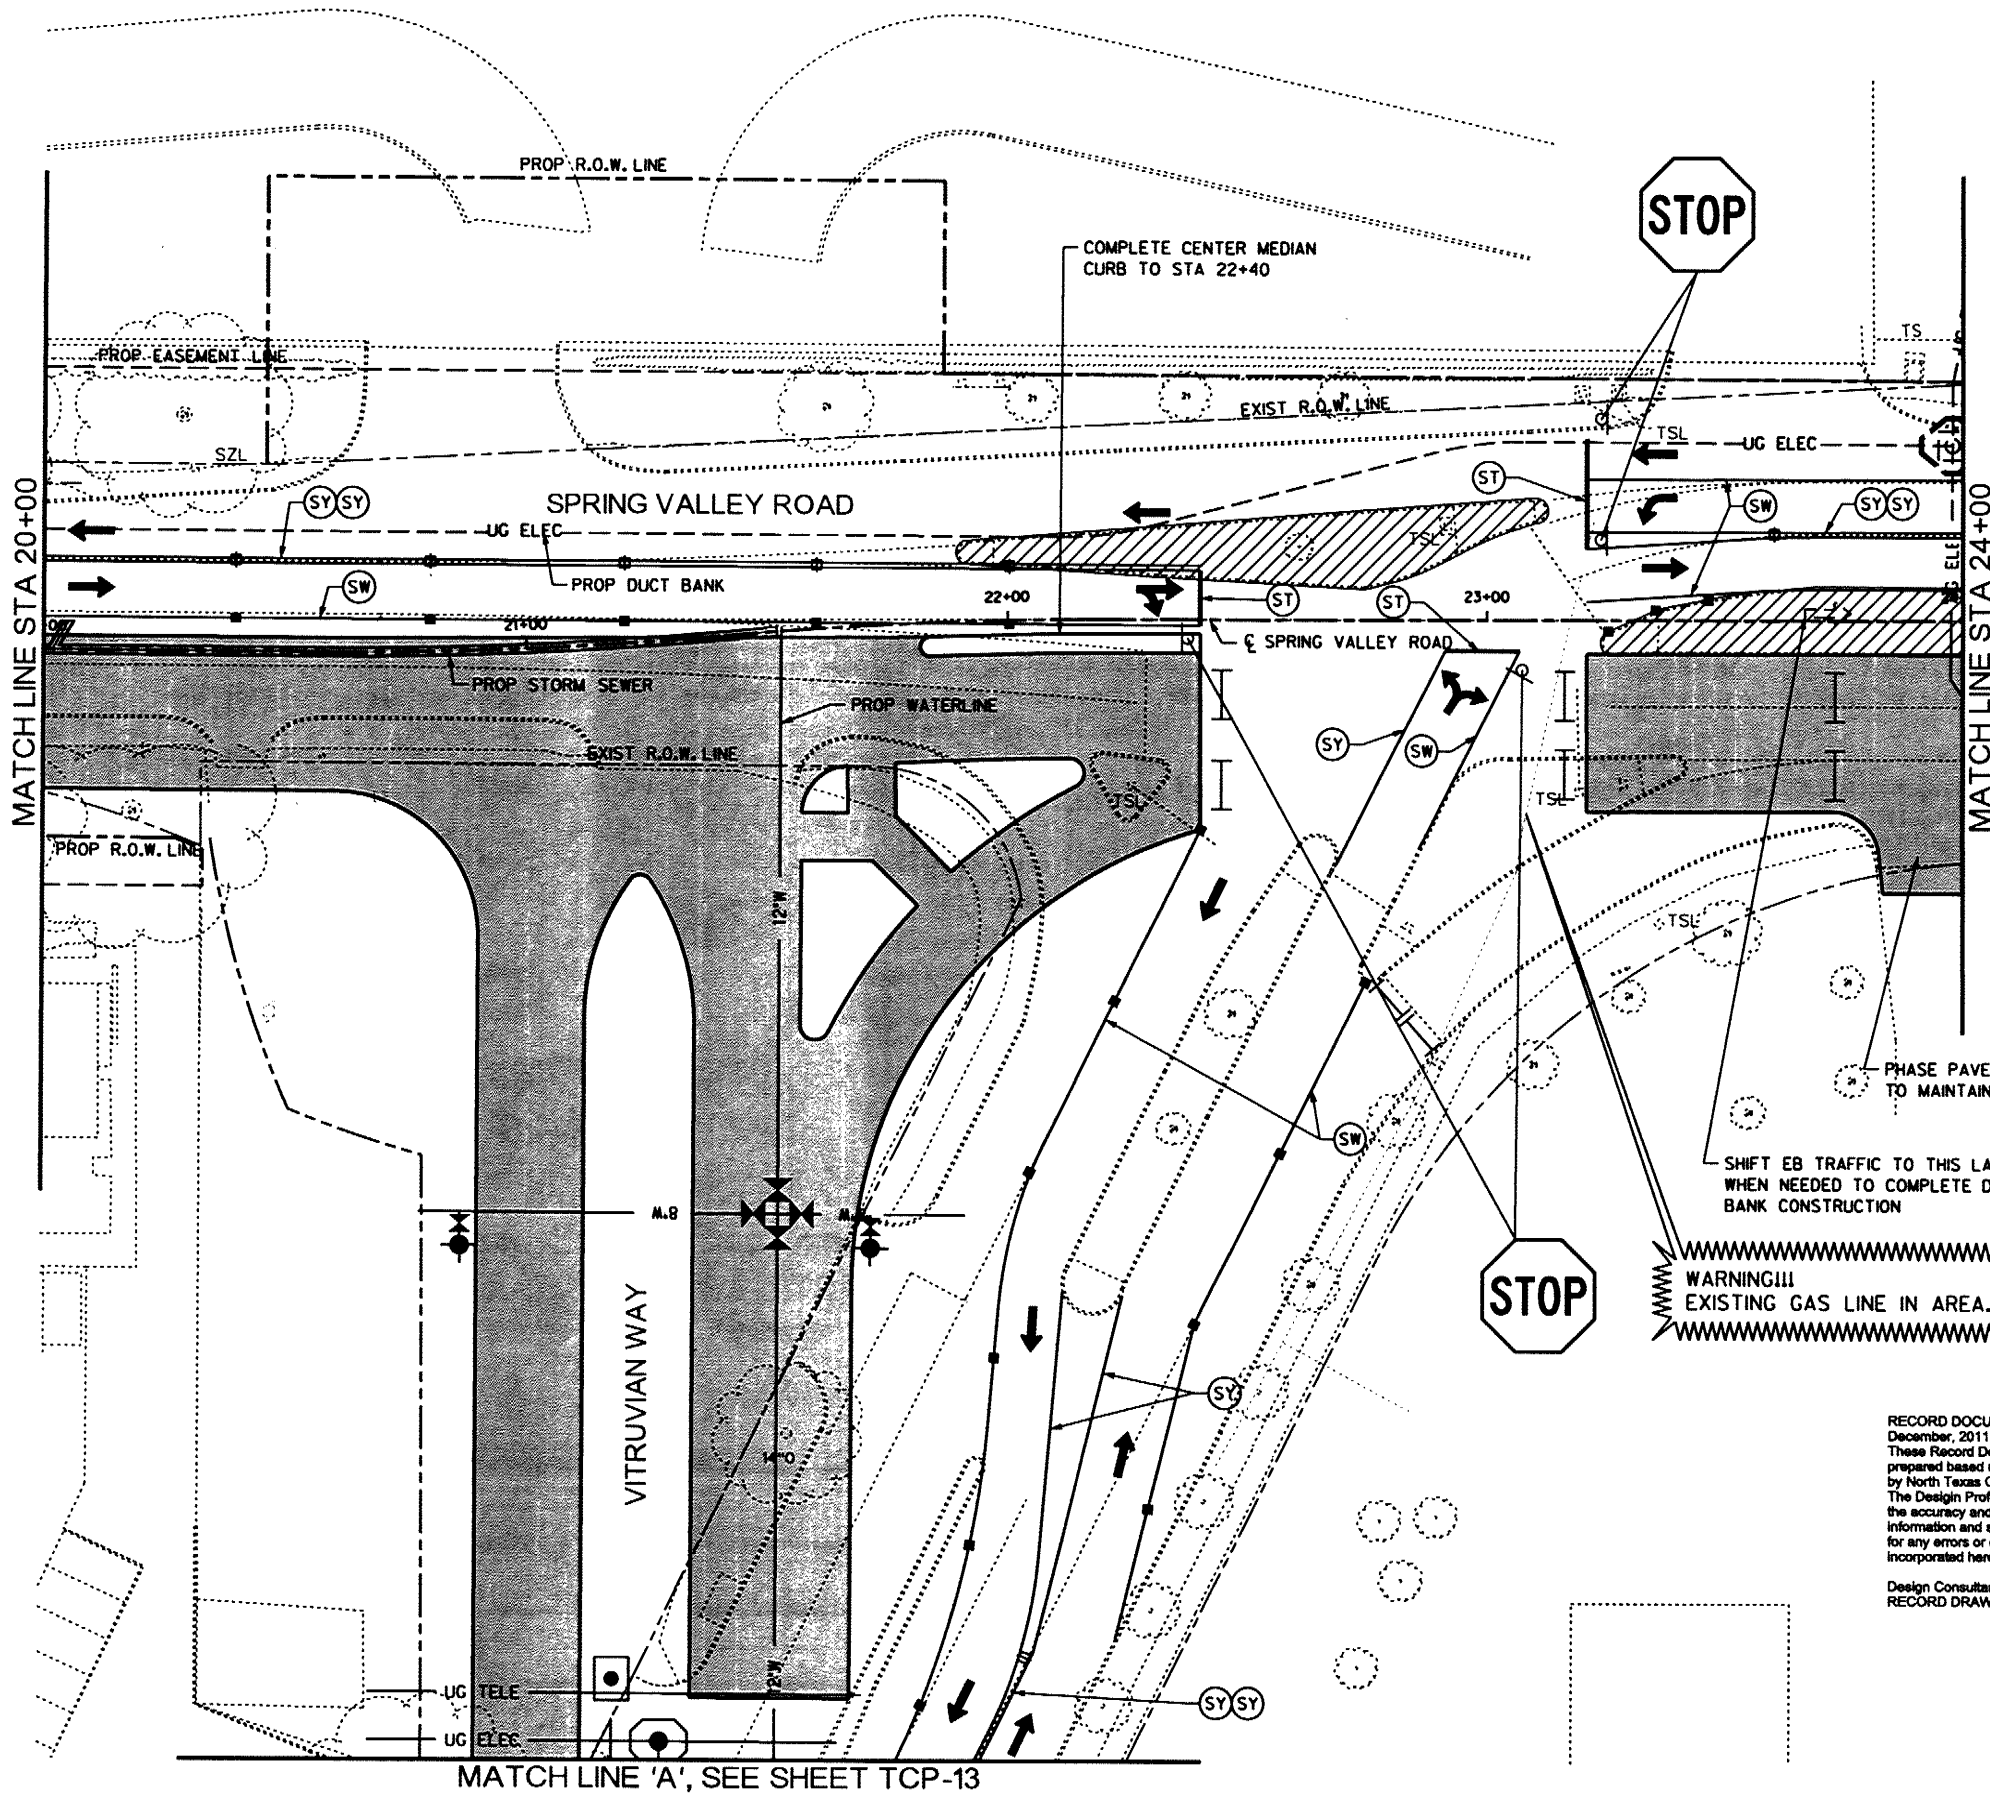

TRAFFIC CONTROL LEGEND:

- TEMPORARY 8" HMAC PAVEMENT
- PAVEMENT CONSTRUCTED IN THIS PHASE
- PAVEMENT CONSTRUCTED IN PREVIOUS PHASE
- TEMPORARY PAVEMENT HMAC WIDENING PREVIOUS PHASE
- TRAFFIC FLOW DIRECTION
- CONSTRUCTION SIGN
- PLASTIC DRUM CHANNELIZING DEVICE
- VERTICAL PANEL WITH TWO WAY TRAFFIC SIGN ON BOTH SIDES
- VERTICAL PANEL (VP)
- TYPE III BARRICADE
- STORM BUILT THIS PHASE
- STORM BUILT PREVIOUS PHASE
- 12"W WATER BUILT THIS PHASE
- 12"W WATER BUILT PREVIOUS PHASE
- 8" SS SANITARY BUILT THIS PHASE
- 8" SS SANITARY BUILT PREVIOUS PHASE
- UG ELEC DUCT BANK BUILT THIS PHASE
- UG ELEC DUCT BANK BUILT PREVIOUS PHASE
- OH ELEC OVERHEAD ELECT. BUILT THIS PHASE
- OH ELEC OVERHEAD ELECT. BUILT PREVIOUS PHASE
- REMOVABLE 4" SOLID WHITE
- REMOVABLE 4" BROKEN WHITE
- REMOVABLE 4" DOTTED WHITE
- REMOVABLE 24" STOP BAR
- REMOVABLE 4" SOLID YELLOW
- EXISTING / PREVIOUS PAV MARKINGS



SHIFT EB TRAFFIC TO THIS LANE WHEN NEEDED TO COMPLETE DUCT BANK CONSTRUCTION

WARNING!!! EXISTING GAS LINE IN AREA.

RECORD DOCUMENTS
 December, 2011
 These Record Documents have been prepared based upon information provided by North Texas Contracting, Inc. The Design Professional has not verified the accuracy and / or completeness of this information and shall not be responsible for any errors or omissions which may be incorporated herein as a result

Design Consultant: Half Associates, Inc.
 RECORD DRAWING SUBMITTAL

Signature of Registrant: *M.E. Romanowski* Date: 12/8/2011

MATCH LINE 'A', SEE SHEET TCP-13

SHEET 69 OF 163

RECORD DRAWINGS


NO.	REVISION	BY	DATE
TOWN OF ADDISON DALLAS COUNTY, TEXAS SPRING VALLEY ROAD			
TRAFFIC CONTROL PLAN PHASE 2			
1201 NORTH BOWSER ROAD, RICHARDSON, TEXAS 75081-2275 TEL (214) 346-4200 FAX (214) 730-0085			
PROJECT	DESIGN	DRAWN	DATE
27530	MPB	TMM	OCTOBER 2010
FILE	SHEET		
27530 TCP 02-01-04	TCP-11		

DATE: 12/17/2011 TIME: 10:34:34 AM FILE: 27530 TCP 02-01-05.dgn PROJECT: 27530 OFFICE: RCH USER: gh1299



TRAFFIC CONTROL LEGEND:

- TEMPORARY 8" HMAC PAVEMENT
- PAVEMENT CONSTRUCTED IN THIS PHASE
- PAVEMENT CONSTRUCTED IN PREVIOUS PHASE
- TEMPORARY PAVEMENT HMAC WIDENING PREVIOUS PHASE
- TRAFFIC FLOW DIRECTION
- CONSTRUCTION SIGN
- PLASTIC DRUM CHANNELIZING DEVICE
- VERTICAL PANEL WITH TWO WAY TRAFFIC SIGN ON BOTH SIDES
- VERTICAL PANEL (VP)
- TYPE III BARRICADE
- STORM BUILT THIS PHASE
- STORM BUILT PREVIOUS PHASE
- 12" W WATER BUILT THIS PHASE
- 12" W WATER BUILT PREVIOUS PHASE
- 8" SS SANITARY BUILT THIS PHASE
- 8" SS SANITARY BUILT PREVIOUS PHASE
- UG ELEC DUCT BANK BUILT THIS PHASE
- UG ELEC DUCT BANK BUILT PREVIOUS PHASE
- OH ELEC OVERHEAD ELECT. BUILT THIS PHASE
- OH ELEC OVERHEAD ELECT. BUILT PREVIOUS PHASE
- REMOVABLE 4" SOLID WHITE
- REMOVABLE 4" BROKEN WHITE
- REMOVABLE 4" DOTTED WHITE
- REMOVABLE 24" STOP BAR
- REMOVABLE 4" SOLID YELLOW
- EXISTING / PREVIOUS PAV MARKINGS

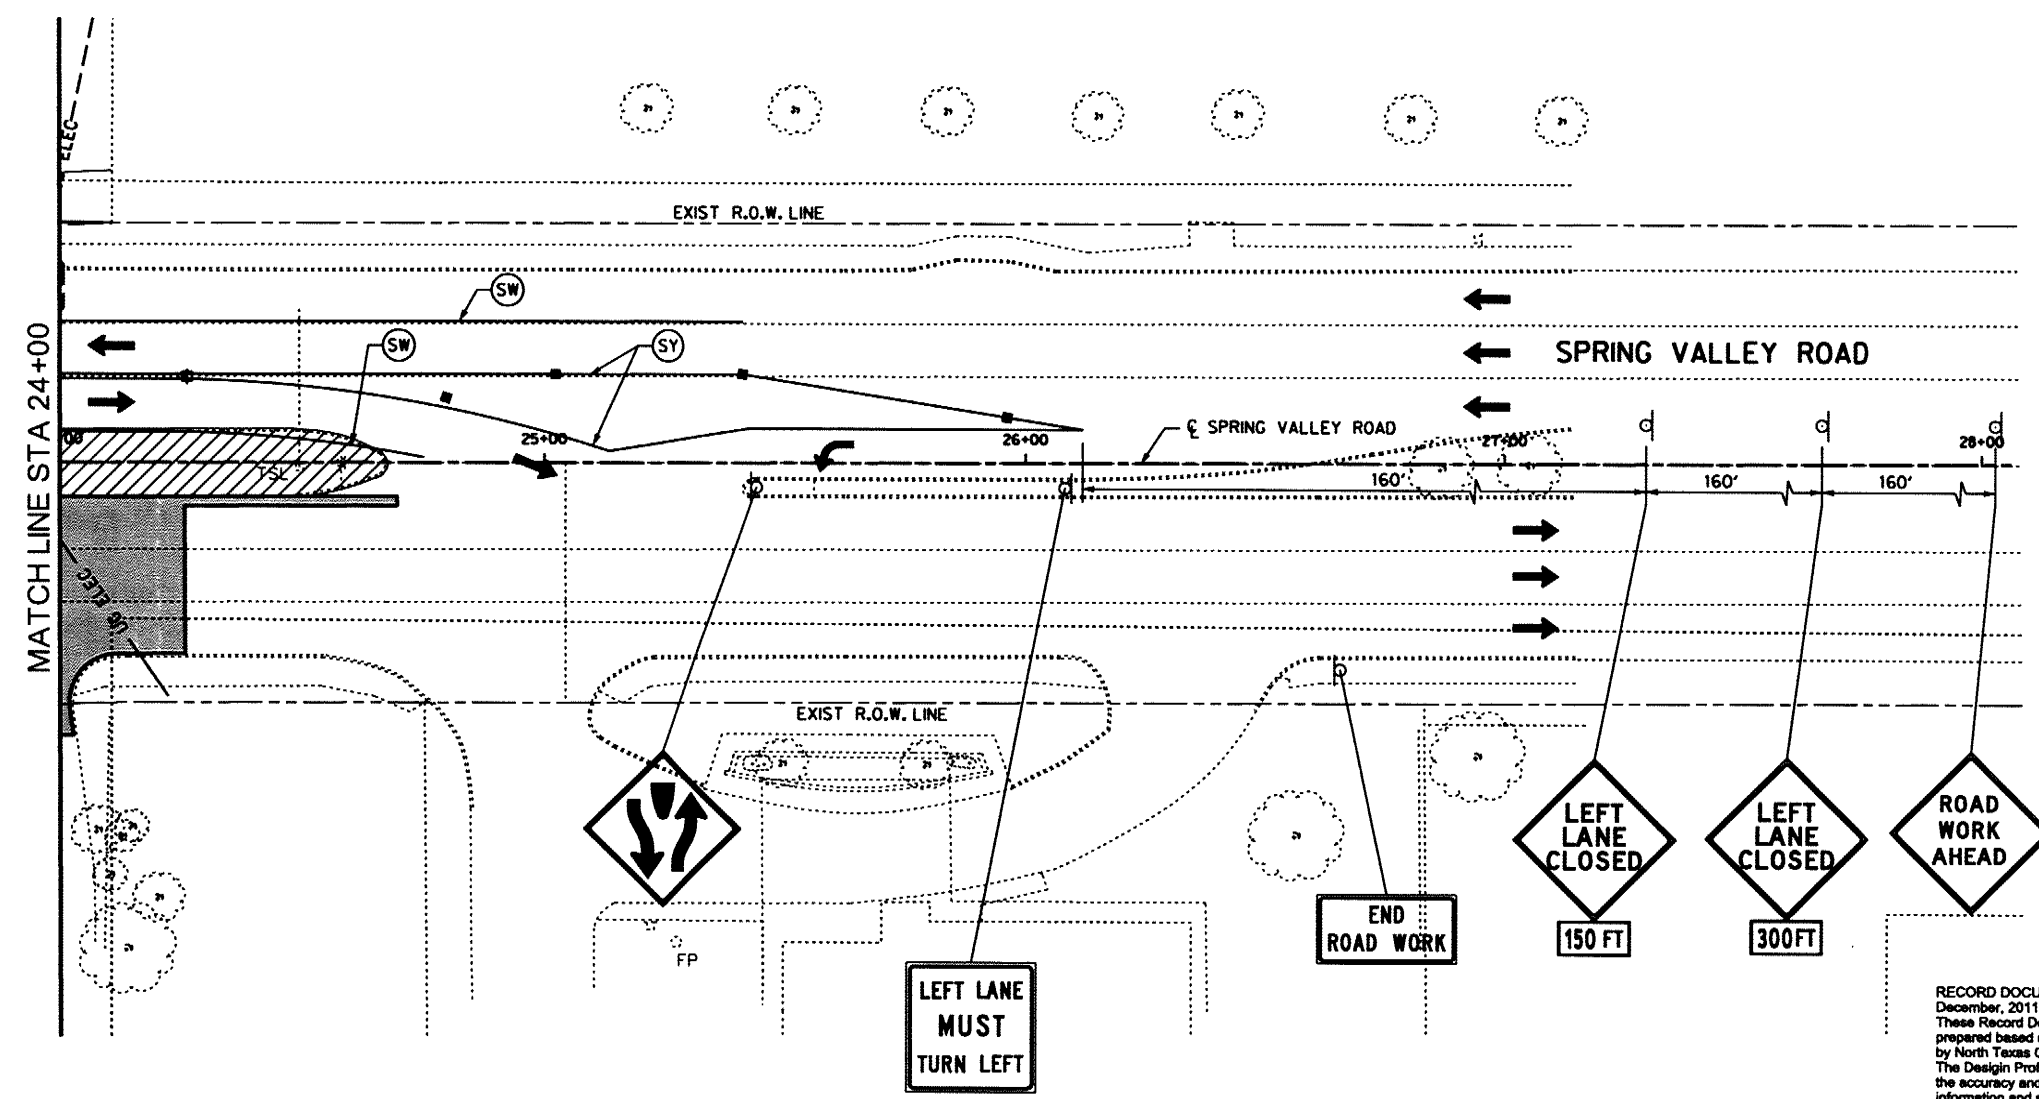

RECORD DOCUMENTS
 December, 2011
 These Record Documents have been prepared based upon information provided by North Texas Contracting, Inc. The Design Professional has not verified the accuracy and / or completeness of this information and shall not be responsible for any errors or omissions which may be incorporated herein as a result.




Design Consultant: Half Associates, Inc.
 RECORD DRAWING SUBMITTAL

M.E. Romanowski
 Signature of Registrant Date 12/18/2011 P.E.

SHEET 70 OF 163 RECORD DRAWINGS

NO.	REVISION	BY	DATE
TOWN OF ADDISON DALLAS COUNTY, TEXAS SPRING VALLEY ROAD TRAFFIC CONTROL PLAN PHASE 2			
1201 NORTH BOWSER ROAD, RICHARDSON, TEXAS 75081-2275 TEL (214) 346-8200 FAX (214) 738-0085			
PROJECT	DESIGN	DRAWN	DATE
27530	MPB	TMM	OCTOBER 2010
FILE	SHEET		
27530 TCP 02-01-05	TCP-12		

USER: ghl299
 OFFICE: RCH
 PROJECT: 27530
 FILE: 27530 TCP 02-01-06.dgn
 TIME: 10:34:49 AM
 DATE: 12/7/2011

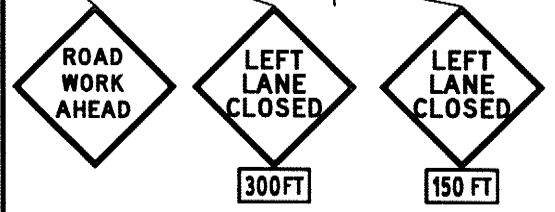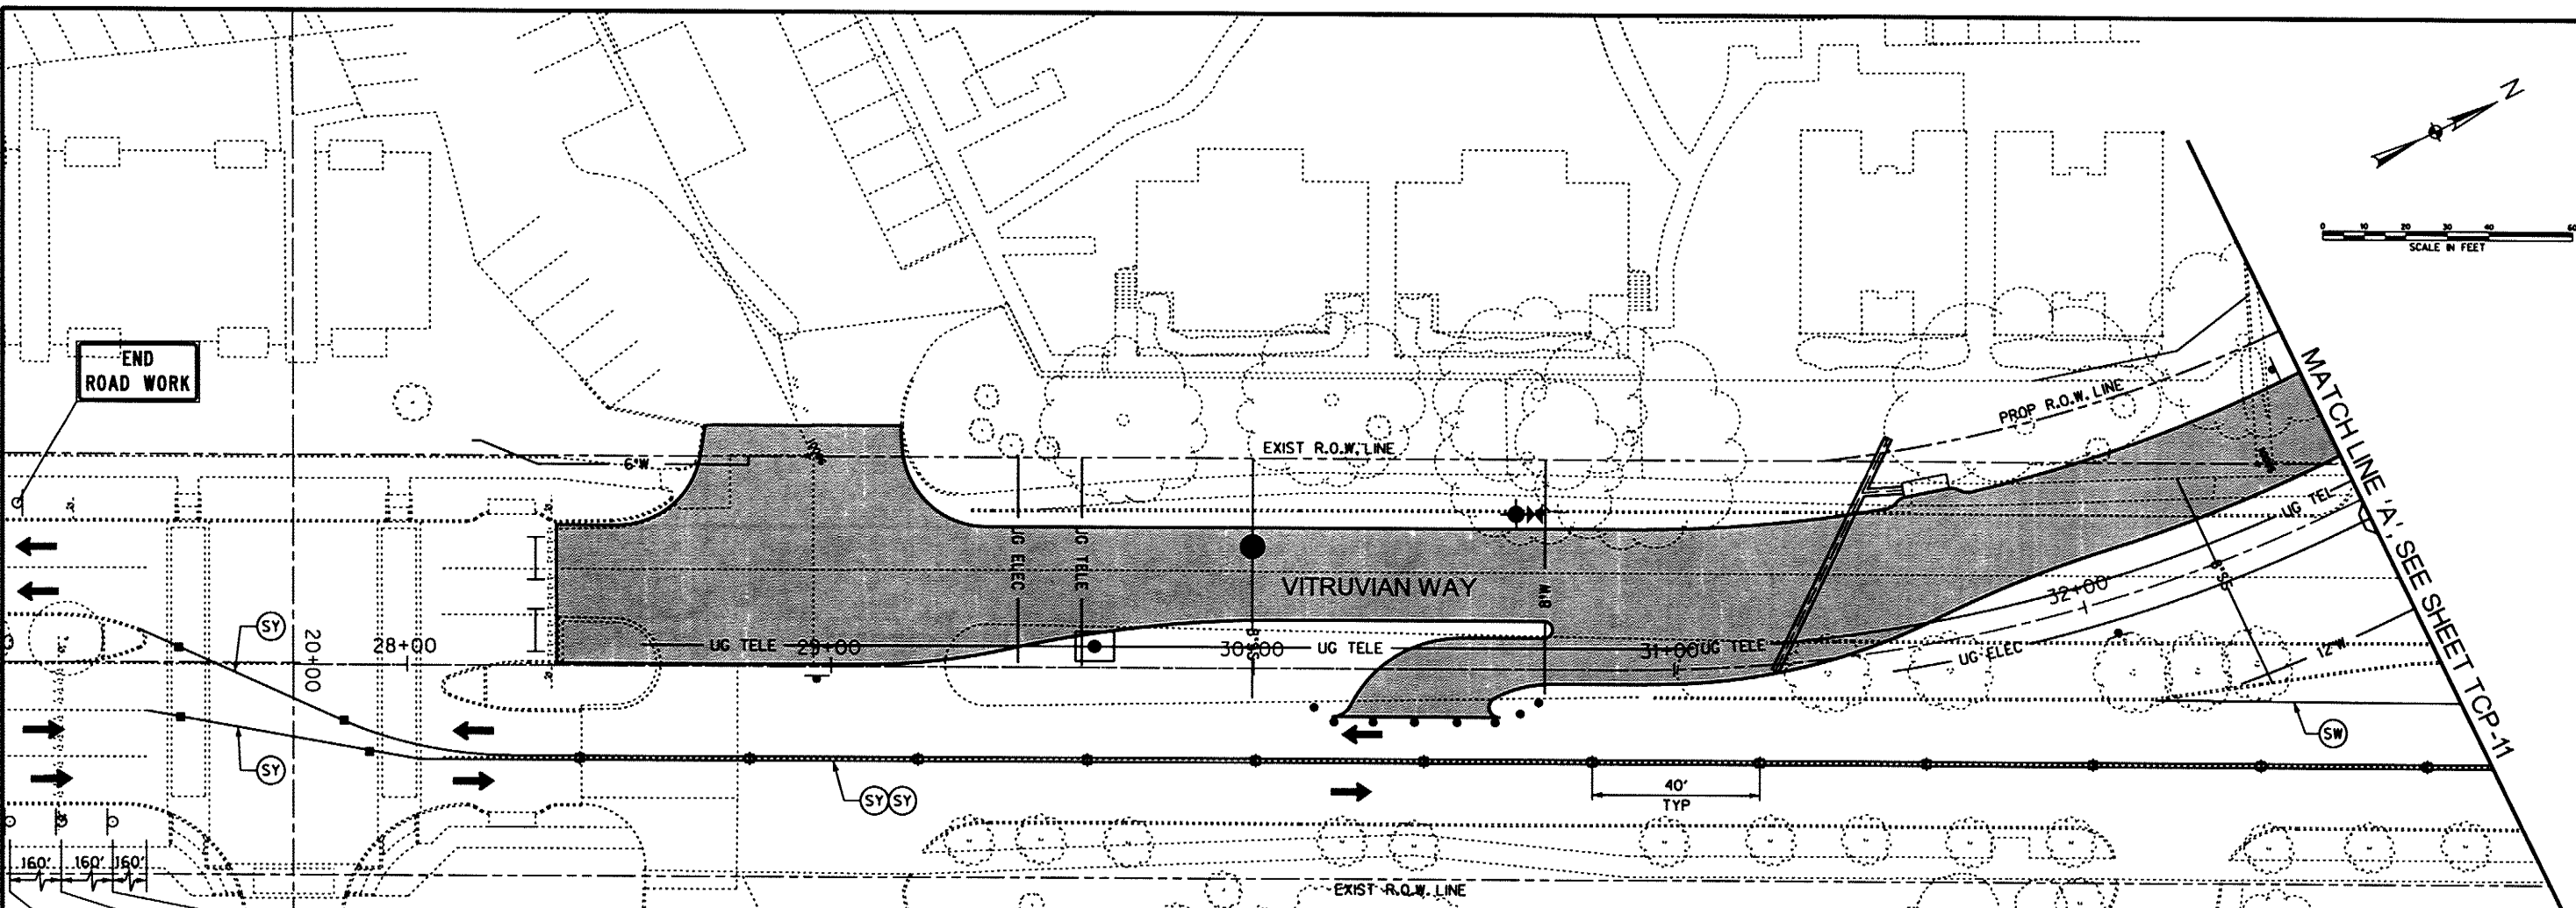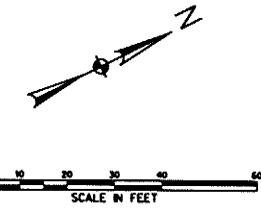

TRAFFIC CONTROL LEGEND:

- TEMPORARY 8" HMAC PAVEMENT
- PAVEMENT CONSTRUCTED IN THIS PHASE
- PAVEMENT CONSTRUCTED IN PREVIOUS PHASE
- TEMPORARY PAVEMENT HMAC WIDENING PREVIOUS PHASE
- TRAFFIC FLOW DIRECTION
- CONSTRUCTION SIGN
- PLASTIC DRUM CHANNELIZING DEVICE
- VERTICAL PANEL WITH TWO WAY TRAFFIC SIGN ON BOTH SIDES
- VERTICAL PANEL (VP)
- TYPE III BARRICADE
- STORM BUILT THIS PHASE
- STORM BUILT PREVIOUS PHASE
- 12" W WATER BUILT THIS PHASE
- 12" W WATER BUILT PREVIOUS PHASE
- 8" SS SANITARY BUILT THIS PHASE
- 8" SS SANITARY BUILT PREVIOUS PHASE
- UG ELEC DUCT BANK BUILT THIS PHASE
- UG ELEC DUCT BANK BUILT PREVIOUS PHASE
- OH ELEC OVERHEAD ELECT. BUILT THIS PHASE
- OH ELEC OVERHEAD ELECT. BUILT PREVIOUS PHASE
- REMOVABLE 4" SOLID WHITE
- REMOVABLE 4" BROKEN WHITE
- REMOVABLE 4" DOTTED WHITE
- REMOVABLE 24" STOP BAR
- REMOVABLE 4" SOLID YELLOW
- EXISTING / PREVIOUS PAV MARKINGS

RECORD DOCUMENTS
 December, 2011
 These Record Documents have been prepared based upon information provided by North Texas Contracting, Inc. The Design Professional has not verified the accuracy and / or completeness of this information and shall not be responsible for any errors or omissions which may be incorporated herein as a result.

Design Consultant: Half Associates, Inc.
 RECORD DRAWING SUBMITTAL




[Signature] P.E. *[Date]*
 Signature of Registrant Date

NO.		REVISION		BY	DATE
TOWN OF ADDISON DALLAS COUNTY, TEXAS SPRING VALLEY ROAD					
TRAFFIC CONTROL PLAN PHASE 2					
1201 NORTH BOWSER ROAD, RICHARDSON, TEXAS 75081-2275 TEL. (214) 346-6200 FAX (214) 738-0085					
PROJECT	DESIGN	DRAWN	DATE	FILE	SHEET
27530	MPB	TMM	OCTOBER 2010	27530 TCP 02-01-06	TCP-13

RECORD DRAWINGS SHEET 71 OF 163

DATE: 12/7/2011 TIME: 10:35:02 AM FILE: 27530.TCP_03-01-01.dgn PROJECT: 27530 OFFICE: RCH USER: oh1299

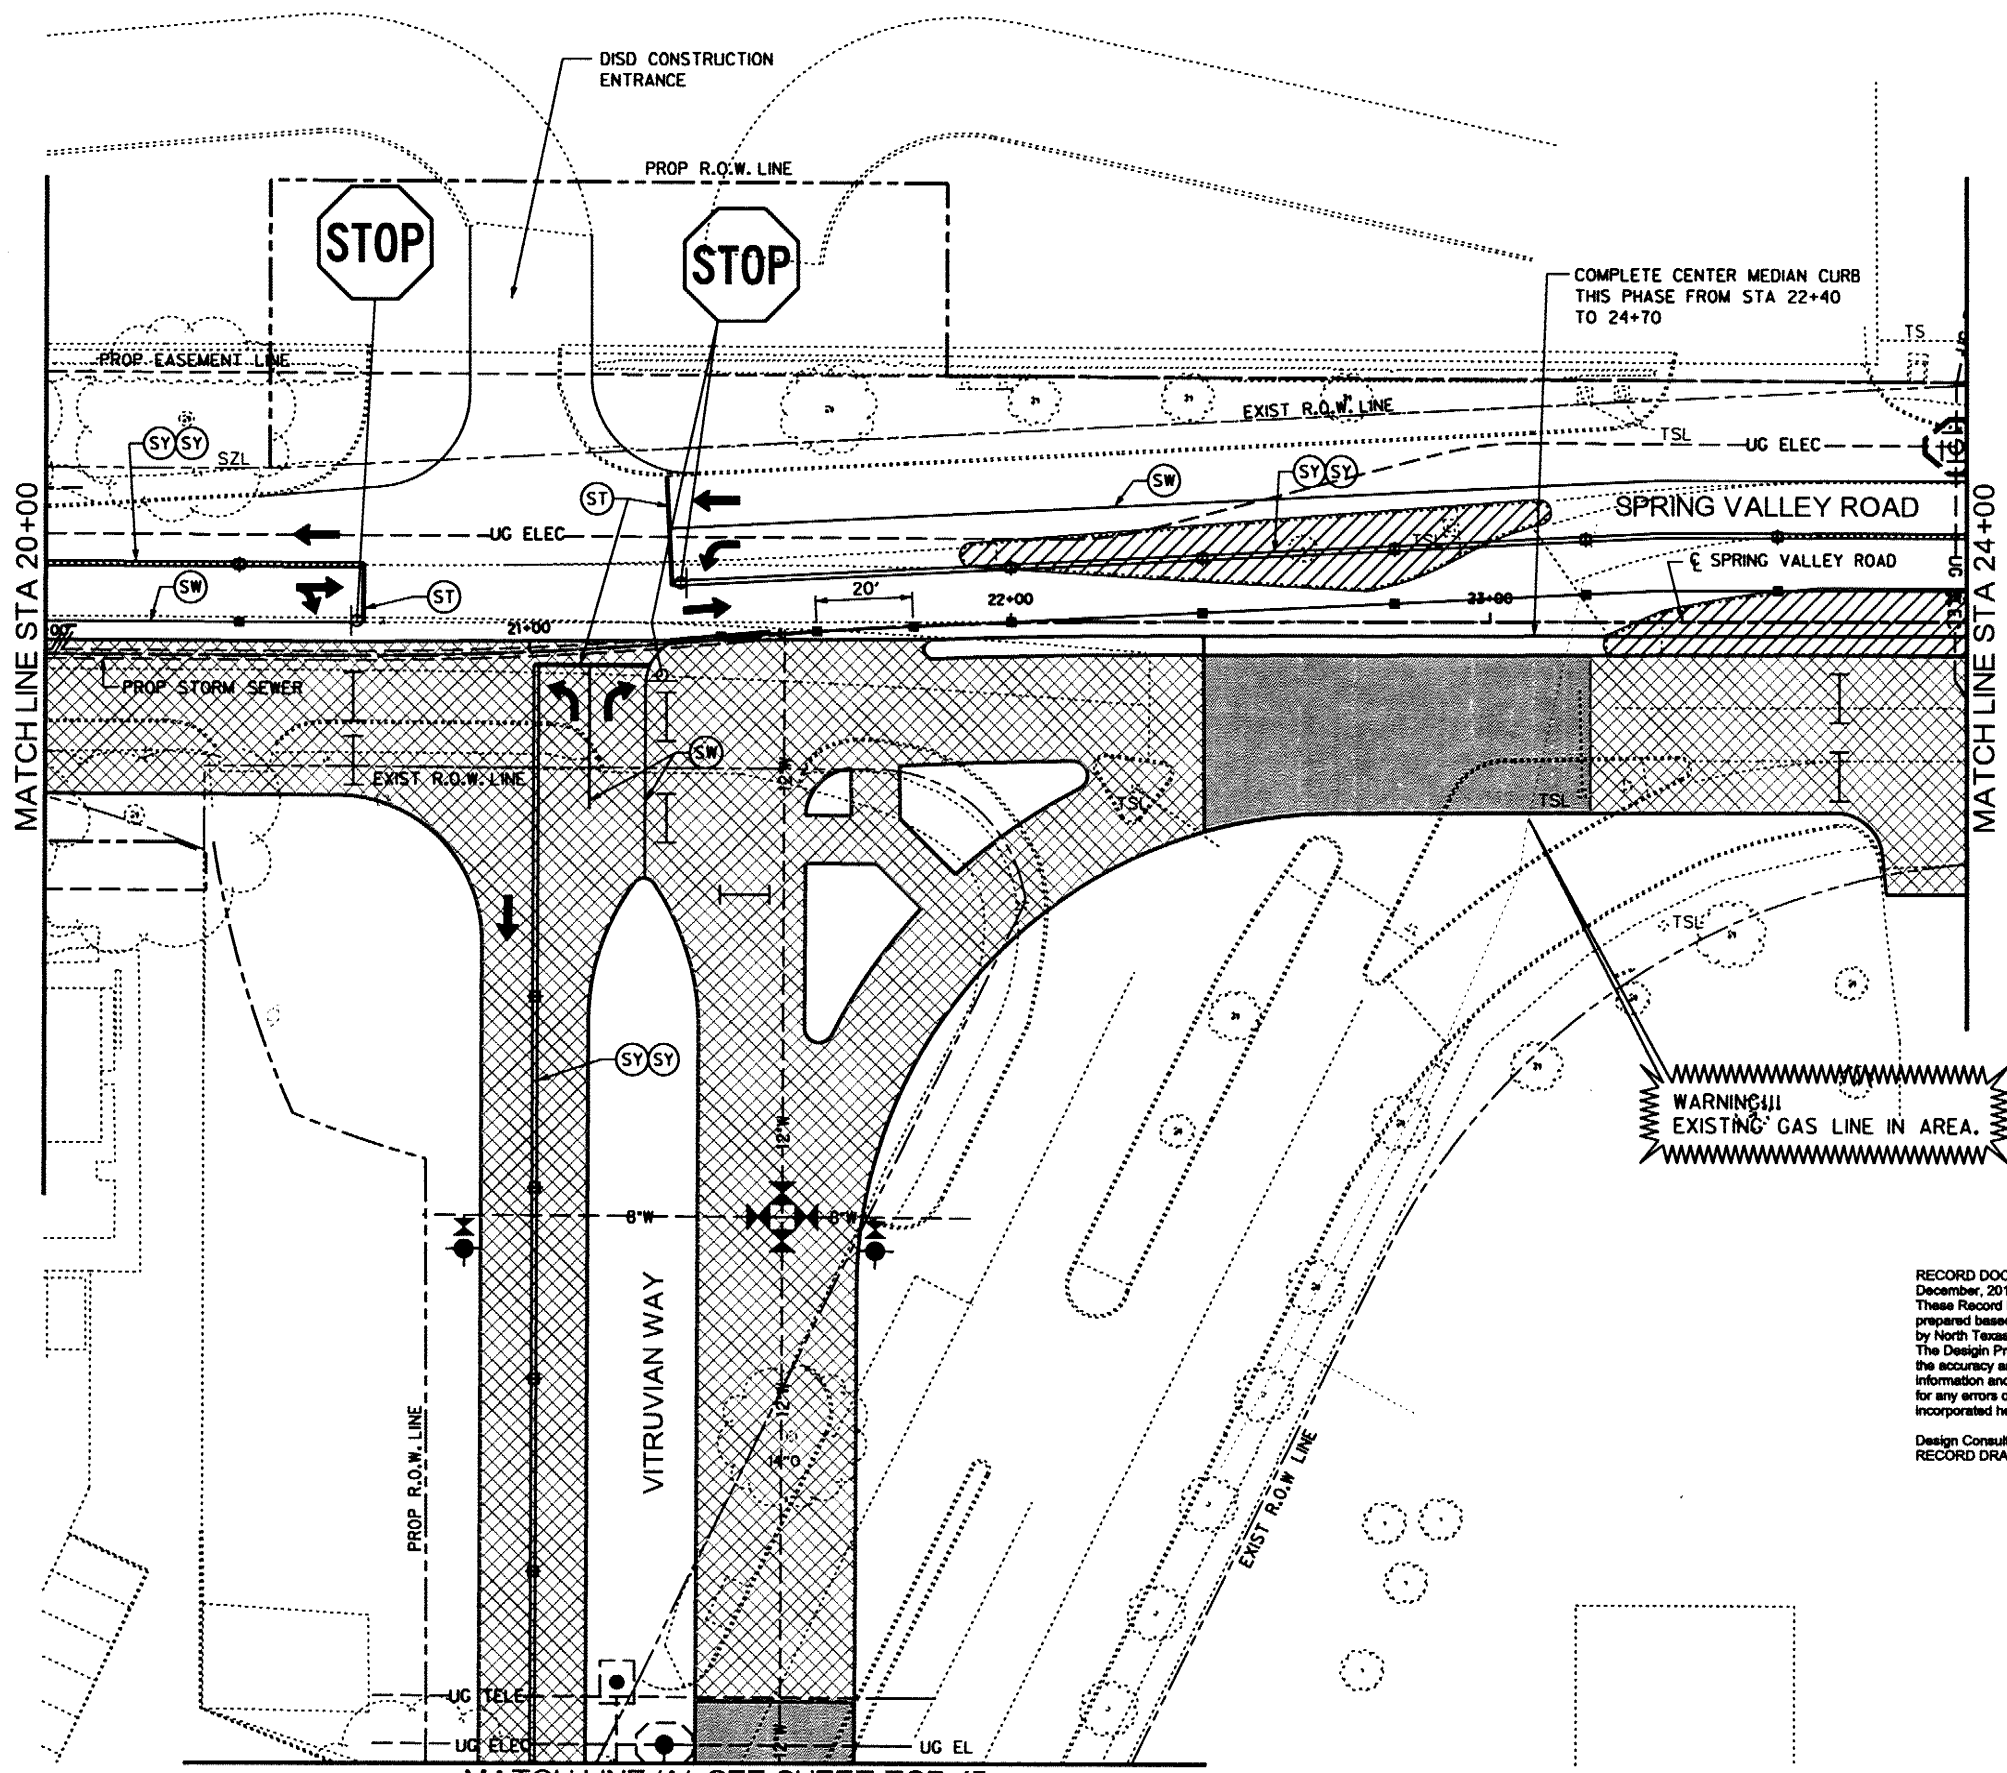

TRAFFIC CONTROL LEGEND:

- TEMPORARY 8" HMAC PAVEMENT
- PAVEMENT CONSTRUCTED IN THIS PHASE
- PAVEMENT CONSTRUCTED IN PREVIOUS PHASE
- TEMPORARY PAVEMENT HMAC WIDENING PREVIOUS PHASE
- TRAFFIC FLOW DIRECTION
- CONSTRUCTION SIGN
- PLASTIC DRUM CHANNELIZING DEVICE
- VERTICAL PANEL WITH TWO WAY TRAFFIC SIGN ON BOTH SIDES
- VERTICAL PANEL (VP)
- TYPE III BARRICADE
- STORM BUILT THIS PHASE
- STORM BUILT PREVIOUS PHASE
- 12" W WATER BUILT THIS PHASE
- 12" W WATER BUILT PREVIOUS PHASE
- 8" SS SANITARY BUILT THIS PHASE
- 8" SS SANITARY BUILT PREVIOUS PHASE
- UG ELEC DUCT BANK BUILT THIS PHASE
- UG ELEC DUCT BANK BUILT PREVIOUS PHASE
- OH ELEC OVERHEAD ELECT. BUILT THIS PHASE
- OH ELEC OVERHEAD ELECT. BUILT PREVIOUS PHASE
- REMOVABLE 4" SOLID WHITE
- REMOVABLE 4" BROKEN WHITE
- REMOVABLE 4" DOTTED WHITE
- REMOVABLE 24" STOP BAR
- REMOVABLE 4" SOLID YELLOW
- EXISTING / PREVIOUS PAV MARKINGS

WARNING!!!
EXISTING GAS LINE IN AREA.

RECORD DOCUMENTS
December, 2011
These Record Documents have been prepared based upon information provided by North Texas Contracting, Inc. The Design Professional has not verified the accuracy and / or completeness of this information and shall not be responsible for any errors or omissions which may be incorporated herein as a result.

Design Consultant: Half Associates, Inc.
RECORD DRAWING SUBMITTAL




Signature of Registrant: *[Signature]* Date: 12/5/2011

MATCH LINE 'A', SEE SHEET TCP-15

RECORD DRAWINGS SHEET 72 OF 163

NO.		REVISION		BY	DATE
TOWN OF ADDISON DALLAS COUNTY, TEXAS SPRING VALLEY ROAD TRAFFIC CONTROL PLAN PHASE 3A					
1201 NORTH BOWSER ROAD, RICHARDSON, TEXAS 75081-2275 TEL (214) 348-8200 FAX (214) 738-0085					
PROJECT	DESIGN	DRAWN	DATE	FILE	SHEET
27530	MPB	TMM	OCTOBER 2010	27530 TCP 03-01-01	TCP-14

DATE: 12/7/2011 TIME: 10:35:16 AM FILE: 27530 TCP 03-01-02.dgn PROJECT: 27530 OFFICE: RCH USER: oh1299

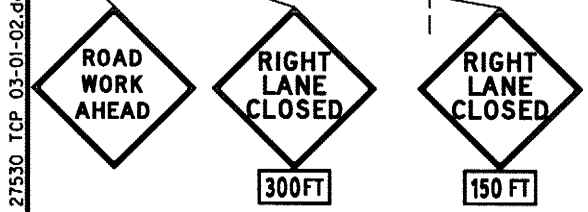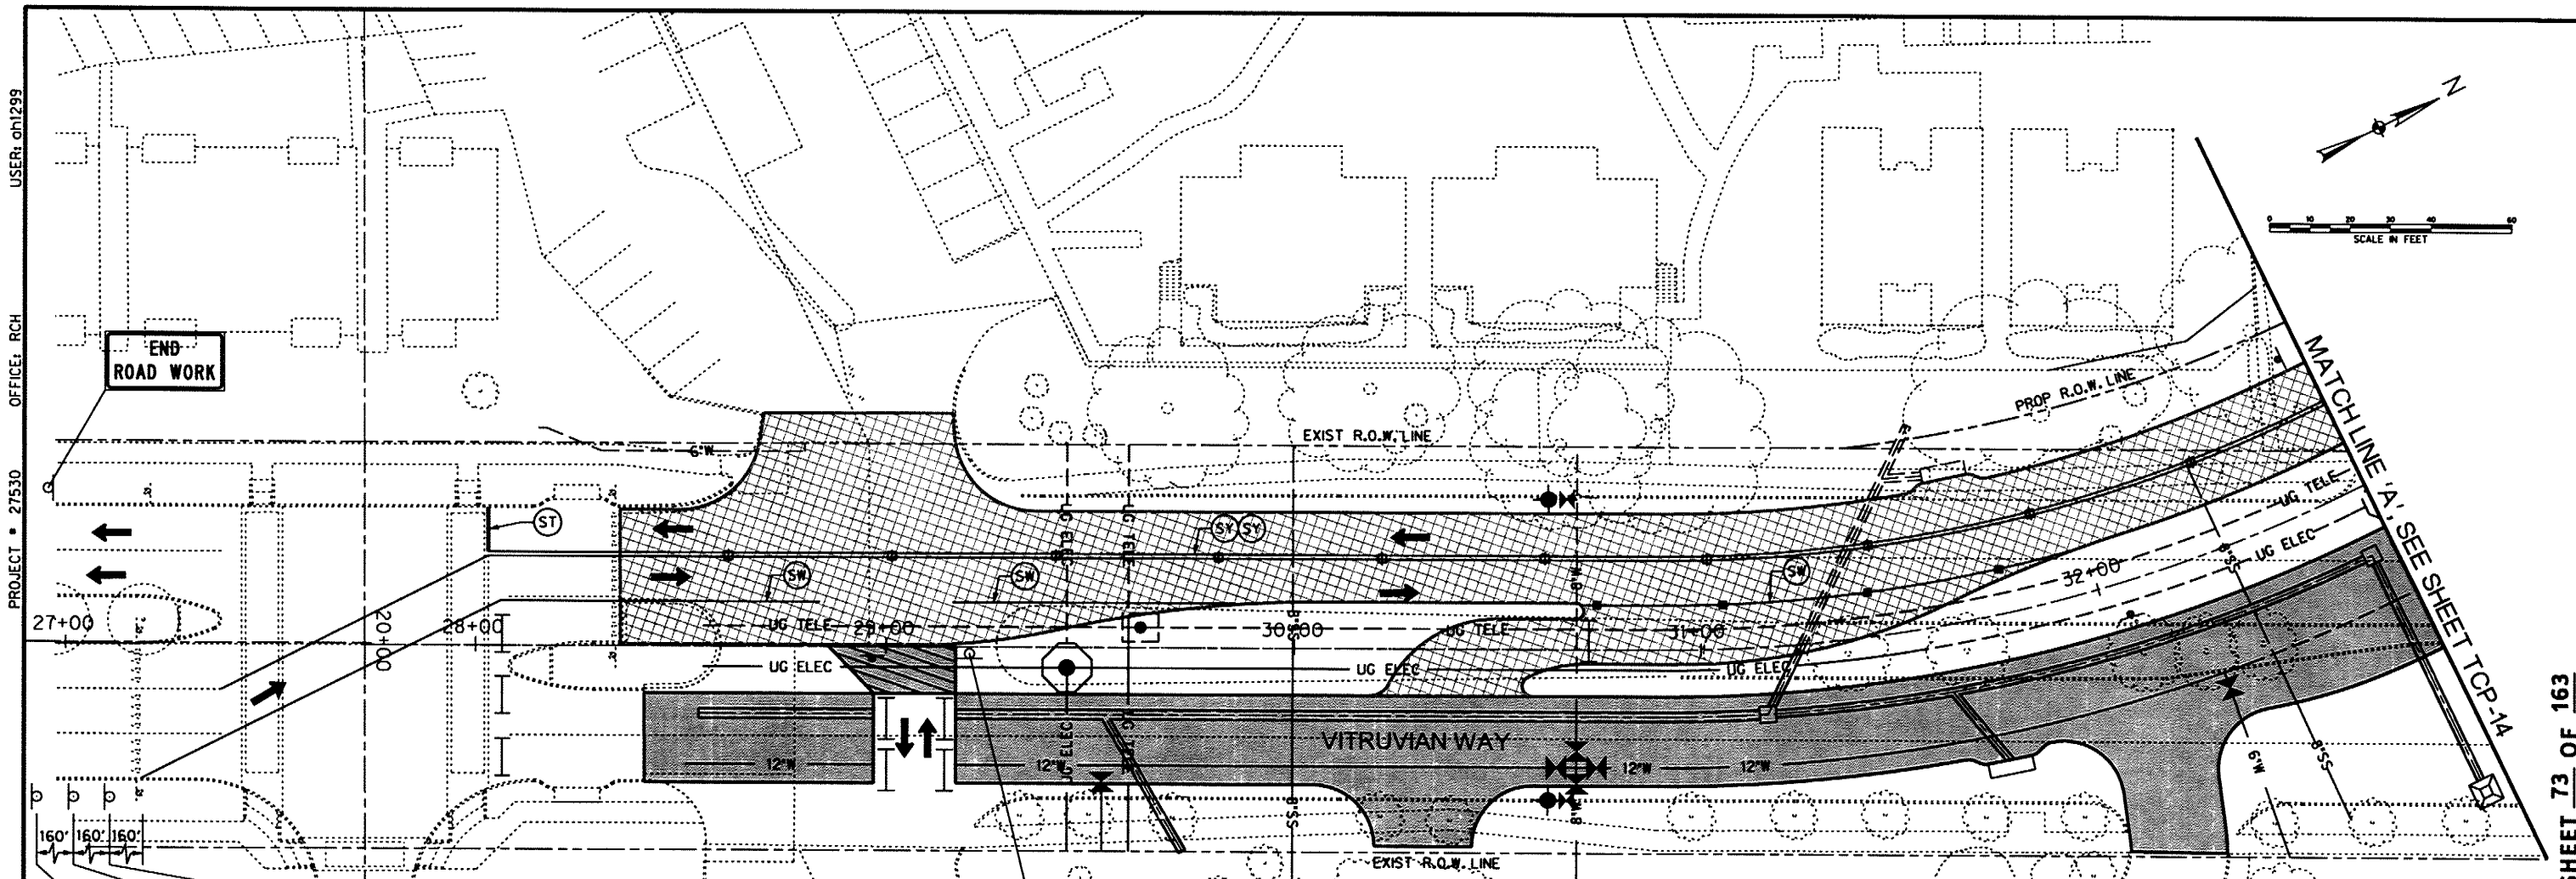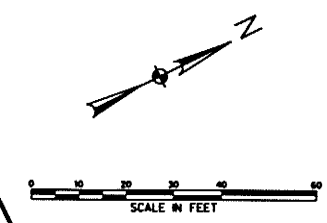

TRAFFIC CONTROL LEGEND:

- TEMPORARY 8" HMAC PAVEMENT
- PAVEMENT CONSTRUCTED IN THIS PHASE
- PAVEMENT CONSTRUCTED IN PREVIOUS PHASE
- TEMPORARY PAVEMENT HMAC WIDENING PREVIOUS PHASE
- TRAFFIC FLOW DIRECTION
- CONSTRUCTION SIGN
- PLASTIC DRUM CHANNELIZING DEVICE
- VERTICAL PANEL WITH TWO WAY TRAFFIC SIGN ON BOTH SIDES
- VERTICAL PANEL (VP)
- TYPE III BARRICADE
- STORM BUILT THIS PHASE
- STORM BUILT PREVIOUS PHASE
- 12"W WATER BUILT THIS PHASE
- 12"W WATER BUILT PREVIOUS PHASE
- 8" SS SANITARY BUILT THIS PHASE
- 8" SS SANITARY BUILT PREVIOUS PHASE
- UG ELEC- DUCT BANK BUILT THIS PHASE
- UG ELEC- DUCT BANK BUILT PREVIOUS PHASE
- OH ELEC- OVERHEAD ELECT. BUILT THIS PHASE
- OH ELEC- OVERHEAD ELECT. BUILT PREVIOUS PHASE
- (SW) REMOVABLE 4' SOLID WHITE
- (BW) REMOVABLE 4' BROKEN WHITE
- (DW) REMOVABLE 4' DOTTED WHITE
- (ST) REMOVABLE 24' STOP BAR
- (SY) REMOVABLE 4' SOLID YELLOW
- (X) EXISTING / PREVIOUS PAV MARKINGS

RECORD DOCUMENTS
 December, 2011
 These Record Documents have been prepared based upon information provided by North Texas Contracting, Inc. The Design Professional has not verified the accuracy and / or completeness of this information and shall not be responsible for any errors or omissions which may be incorporated herein as a result.
 Design Consultant: Half Associates, Inc.
 RECORD DRAWING SUBMITTAL





M.E. Romandowski P.E. 12/8/2011
 Signature of Registrant Date

NO.		REVISION		BY	DATE
TOWN OF ADDISON DALLAS COUNTY, TEXAS SPRING VALLEY ROAD TRAFFIC CONTROL PLAN PHASE 3A					
1201 NORTH BOWSER ROAD, RICHARDSON, TEXAS 75081-2275 TEL (214) 348-8200 FAX (214) 730-0085					
PROJECT	DESIGN	DRAWN	DATE	FILE	SHEET
27530	MPB	TMM	OCTOBER 2010	27530 TCP 03-01-02	TCP-15

RECORD DRAWINGS SHEET 73 OF 163

DATE: 12/7/2011 TIME: 10:35:32 AM FILE: 27530 TCP 03-02-01.dgn PROJECT: 27530 OFFICE: RCH USER: gh1299

SCALE IN FEET

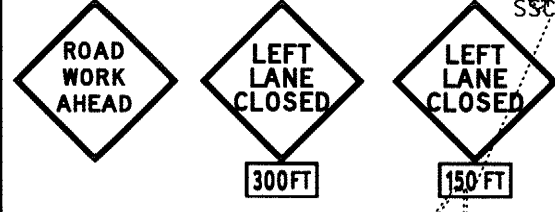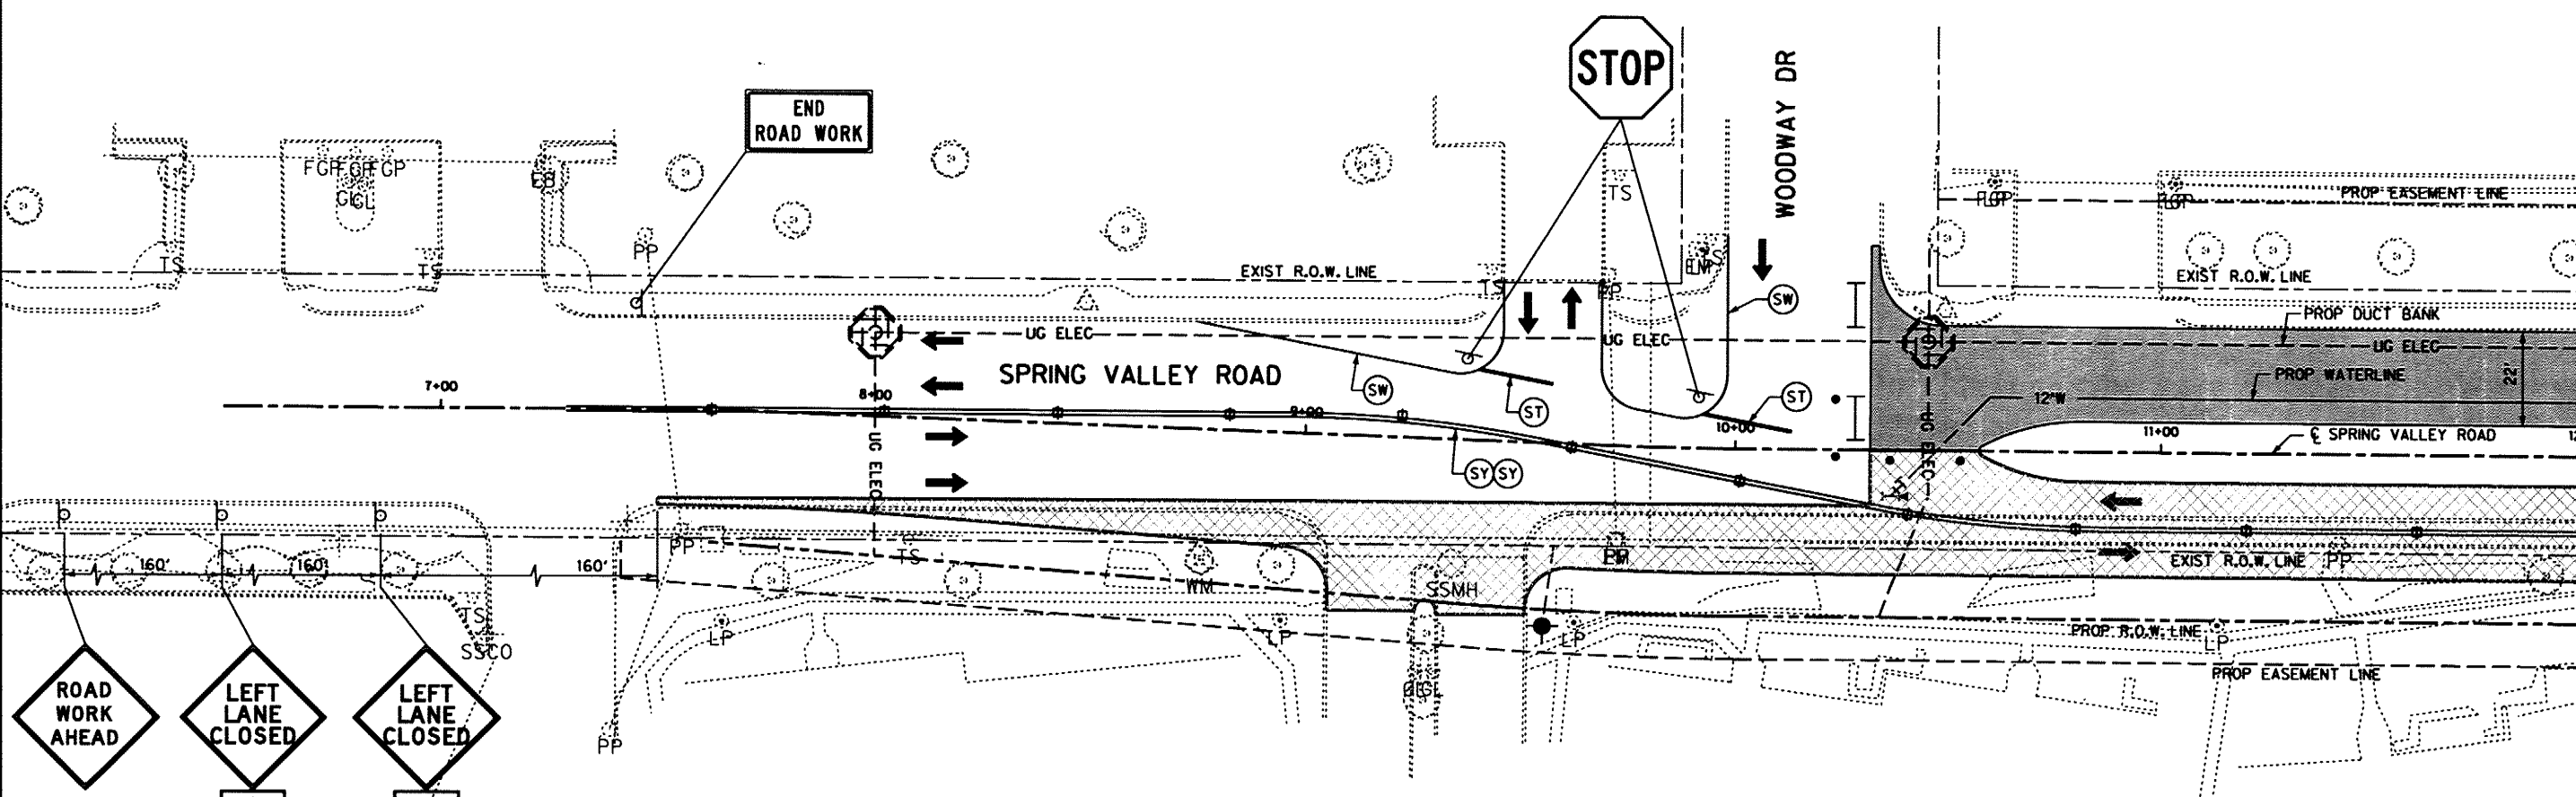

TRAFFIC CONTROL LEGEND:

- TEMPORARY 8\"/>
- PAVEMENT CONSTRUCTED IN THIS PHASE
- PAVEMENT CONSTRUCTED IN PREVIOUS PHASE
- TEMPORARY PAVEMENT HMAC WIDENING PREVIOUS PHASE
- TRAFFIC FLOW DIRECTION
- CONSTRUCTION SIGN
- PLASTIC DRUM CHANNELIZING DEVICE
- VERTICAL PANEL WITH TWO WAY TRAFFIC SIGN ON BOTH SIDES
- VERTICAL PANEL (VP)
- TYPE III BARRICADE
- STORM BUILT THIS PHASE
- STORM BUILT PREVIOUS PHASE
- 12\"/>
- 12\"/>
- 8\"/>
- 8\"/>
- UG ELEC- DUCT BANK BUILT THIS PHASE
- UG ELEC- DUCT BANK BUILT PREVIOUS PHASE
- OH ELEC- OVERHEAD ELECT. BUILT THIS PHASE
- OH ELEC- OVERHEAD ELECT. BUILT PREVIOUS PHASE
- (SW) REMOVABLE 4\"/>
- (BW) REMOVABLE 4\"/>
- (DW) REMOVABLE 4\"/>
- (ST) REMOVABLE 24\"/>
- (SY) REMOVABLE 4\"/>
- (X) EXISTING / PREVIOUS PAV MARKINGS

RECORD DOCUMENTS
 December, 2011
 These Record Documents have been prepared based upon information provided by North Texas Contracting, Inc. The Design Professional has not verified the accuracy and / or completeness of this information and shall not be responsible for any errors or omissions which may be incorporated herein as a result.
 Design Consultant: Half Associates, Inc.
 RECORD DRAWING SUBMITTAL




M.E. Romanowski P.E. 12/8/2011
 Signature of Registrant Date

NO.	REVISION	BY	DATE		
ADDITIONAL TOWN OF ADDISON DALLAS COUNTY, TEXAS SPRING VALLEY ROAD TRAFFIC CONTROL PLAN PHASE 3B					
HALFF 1201 NORTH BOWSER ROAD, RICHARDSON, TEXAS 75081-2275 TEL (214) 348-6200 FAX (214) 738-0095					
PROJECT	DESIGN	DRAWN	DATE	FILE	SHEET
27530	MPB	TMM	OCTOBER 2010	27530 TCP 03-02-01	TCP-16

MATCHLINE STA 12+00

SHEET 74 OF 163

RECORD DRAWINGS

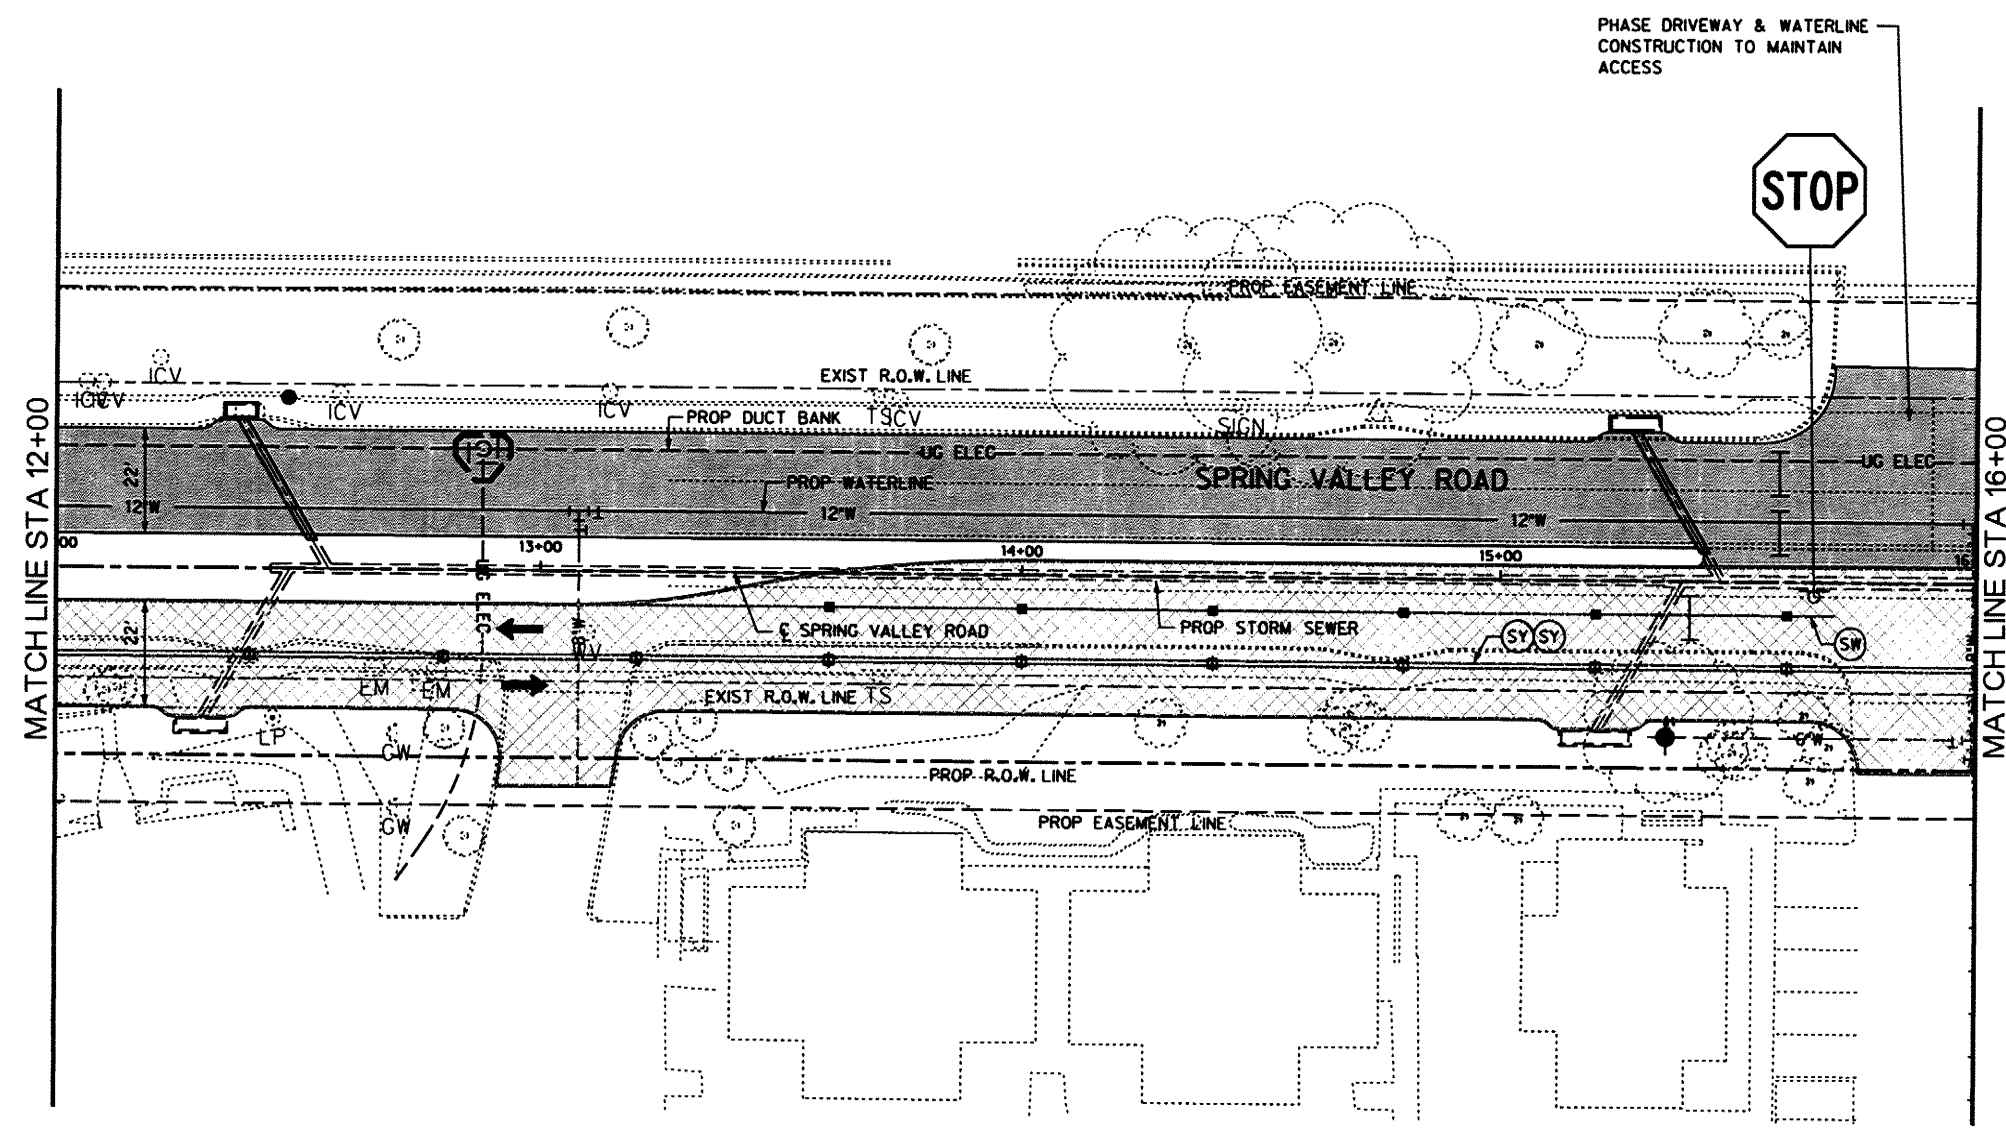

TRAFFIC CONTROL LEGEND:

- TEMPORARY 8" HMAC PAVEMENT
- PAVEMENT CONSTRUCTED IN THIS PHASE
- PAVEMENT CONSTRUCTED IN PREVIOUS PHASE
- TEMPORARY PAVEMENT HMAC WIDENING PREVIOUS PHASE
- TRAFFIC FLOW DIRECTION
- CONSTRUCTION SIGN
- PLASTIC DRUM CHANNELIZING DEVICE
- VERTICAL PANEL WITH TWO WAY TRAFFIC SIGN ON BOTH SIDES
- VERTICAL PANEL (VP)
- TYPE III BARRICADE
- STORM BUILT THIS PHASE
- STORM BUILT PREVIOUS PHASE
- 12" W WATER BUILT THIS PHASE
- 12" W WATER BUILT PREVIOUS PHASE
- 8" SS SANITARY BUILT THIS PHASE
- 8" SS SANITARY BUILT PREVIOUS PHASE
- UG ELEC DUCT BANK BUILT THIS PHASE
- UG ELEC DUCT BANK BUILT PREVIOUS PHASE
- OH ELEC OVERHEAD ELECT. BUILT THIS PHASE
- OH ELEC OVERHEAD ELECT. BUILT PREVIOUS PHASE
- REMOVABLE 4" SOLID WHITE
- REMOVABLE 4" BROKEN WHITE
- REMOVABLE 4" DOTTED WHITE
- REMOVABLE 24" STOP BAR
- REMOVABLE 4" SOLID YELLOW
- EXISTING / PREVIOUS PAV MARKINGS


RECORD DOCUMENTS
 December, 2011
 These Record Documents have been prepared based upon information provided by North Texas Contracting, Inc. The Design Professional has not verified the accuracy and / or completeness of this information and shall not be responsible for any errors or omissions which may be incorporated herein as a result.

Design Consultant: Half Associates, Inc.
 RECORD DRAWING SUBMITTAL

Signature of Registrant: *[Signature]* P.E. Date: 12/8/2011

NO.	REVISION	BY	DATE
TOWN OF ADDISON DALLAS COUNTY, TEXAS			
SPRING VALLEY ROAD			
TRAFFIC CONTROL PLAN PHASE 3B			
HALFF 1201 NORTH BOWSER ROAD, RICHARDSON, TEXAS 75081-2275 TEL (214) 346-6200 FAX (214) 730-0085			
PROJECT	DESIGN	DRAWN	DATE
27530	MPB	TMM	OCTOBER 2010
FILE	SHEET		
27530 TCP 03-02-02	TCP-17		

DATE: 12/7/2011 TIME: 10:41:18 AM FILE: 27530 TCP 03-02-03.dgn PROJECT: 27530 OFFICE: RCH USER: gh1299

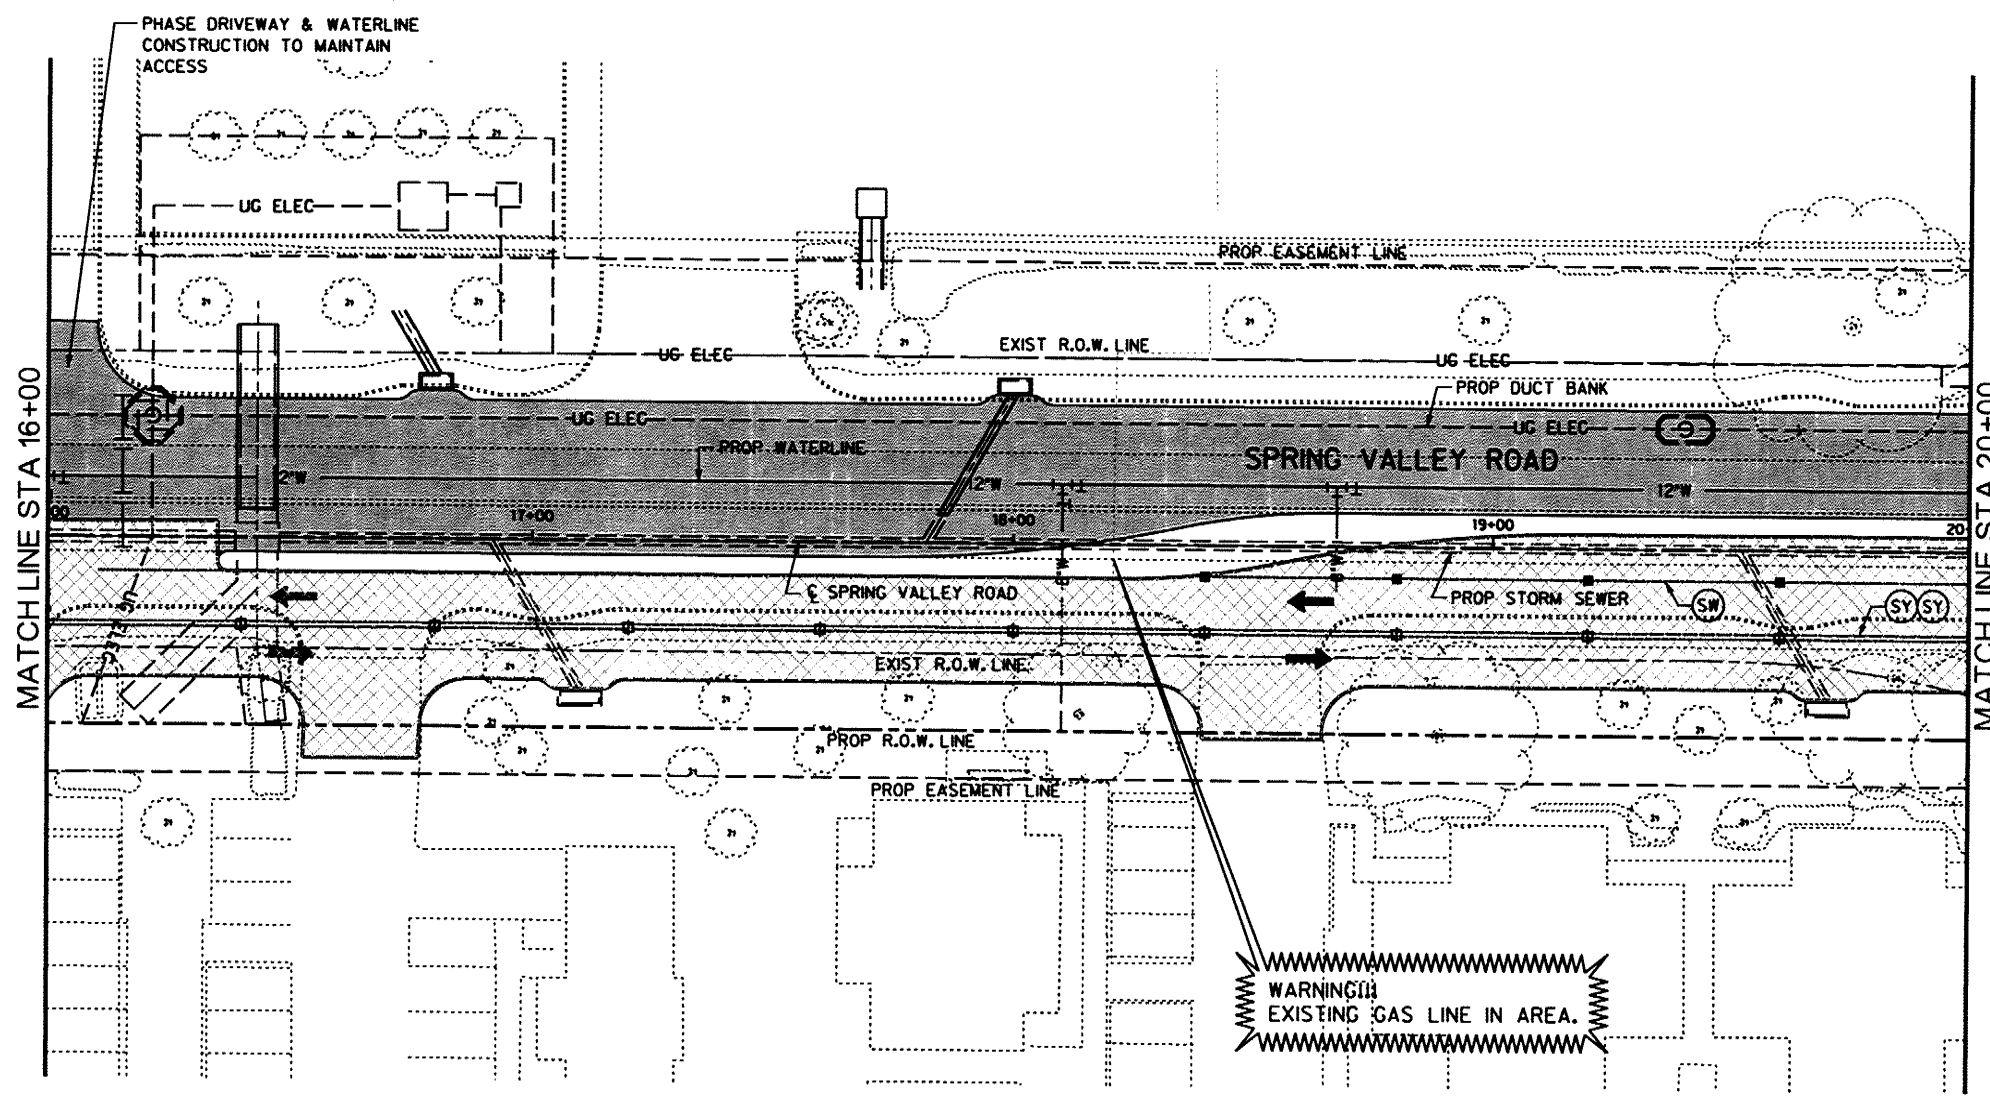

TRAFFIC CONTROL LEGEND:

- TEMPORARY 8" HMAC PAVEMENT
- PAVEMENT CONSTRUCTED IN THIS PHASE
- PAVEMENT CONSTRUCTED IN PREVIOUS PHASE
- TEMPORARY PAVEMENT HMAC WIDENING PREVIOUS PHASE
- TRAFFIC FLOW DIRECTION
- CONSTRUCTION SIGN
- PLASTIC DRUM CHANNELIZING DEVICE
- VERTICAL PANEL WITH TWO WAY TRAFFIC SIGN ON BOTH SIDES
- VERTICAL PANEL (VP)
- TYPE III BARRICADE
- STORM BUILT THIS PHASE
- STORM BUILT PREVIOUS PHASE
- 12" W WATER BUILT THIS PHASE
- 12" W WATER BUILT PREVIOUS PHASE
- 8" SS SANITARY BUILT THIS PHASE
- 8" SS SANITARY BUILT PREVIOUS PHASE
- UG ELEC DUCT BANK BUILT THIS PHASE
- UG ELEC DUCT BANK BUILT PREVIOUS PHASE
- OH ELEC OVERHEAD ELECT. BUILT THIS PHASE
- OH ELEC OVERHEAD ELECT. BUILT PREVIOUS PHASE
- REMOVABLE 4' SOLID WHITE
- REMOVABLE 4' BROKEN WHITE
- REMOVABLE 4' DOTTED WHITE
- REMOVABLE 24" STOP BAR
- REMOVABLE 4' SOLID YELLOW
- EXISTING / PREVIOUS PAV MARKINGS

RECORD DOCUMENTS
December, 2011
These Record Documents have been prepared based upon information provided by North Texas Contracting, Inc. The Design Professional has not verified the accuracy and / or completeness of this information and shall not be responsible for any errors or omissions which may be incorporated herein as a result.




[Signature]
Signature of Registrant Date 12/8/2011

Design Consultant: Half Associates, Inc.
RECORD DRAWING SUBMITTAL

RECORD DRAWINGS SHEET 76 OF 163

NO.	REVISION	BY	DATE
TOWN OF ADDISON DALLAS COUNTY, TEXAS SPRING VALLEY ROAD TRAFFIC CONTROL PLAN PHASE 3B			
1201 NORTH BOWSER ROAD, RICHARDSON, TEXAS 75081-2275 TEL (214) 346-6200 FAX (214) 736-0065			
PROJECT	DESIGN	DRAWN	DATE
27530	MPB	TMM	OCTOBER 2010
FILE	SHEET		
27530 TCP 03-02-03	TCP-18		

DATE: 12/7/2011 TIME: 10:41:30 AM FILE: 27530 TCP 03-02-04.dgn PROJECT: 27530 OFFICE: RCH USER: chl299

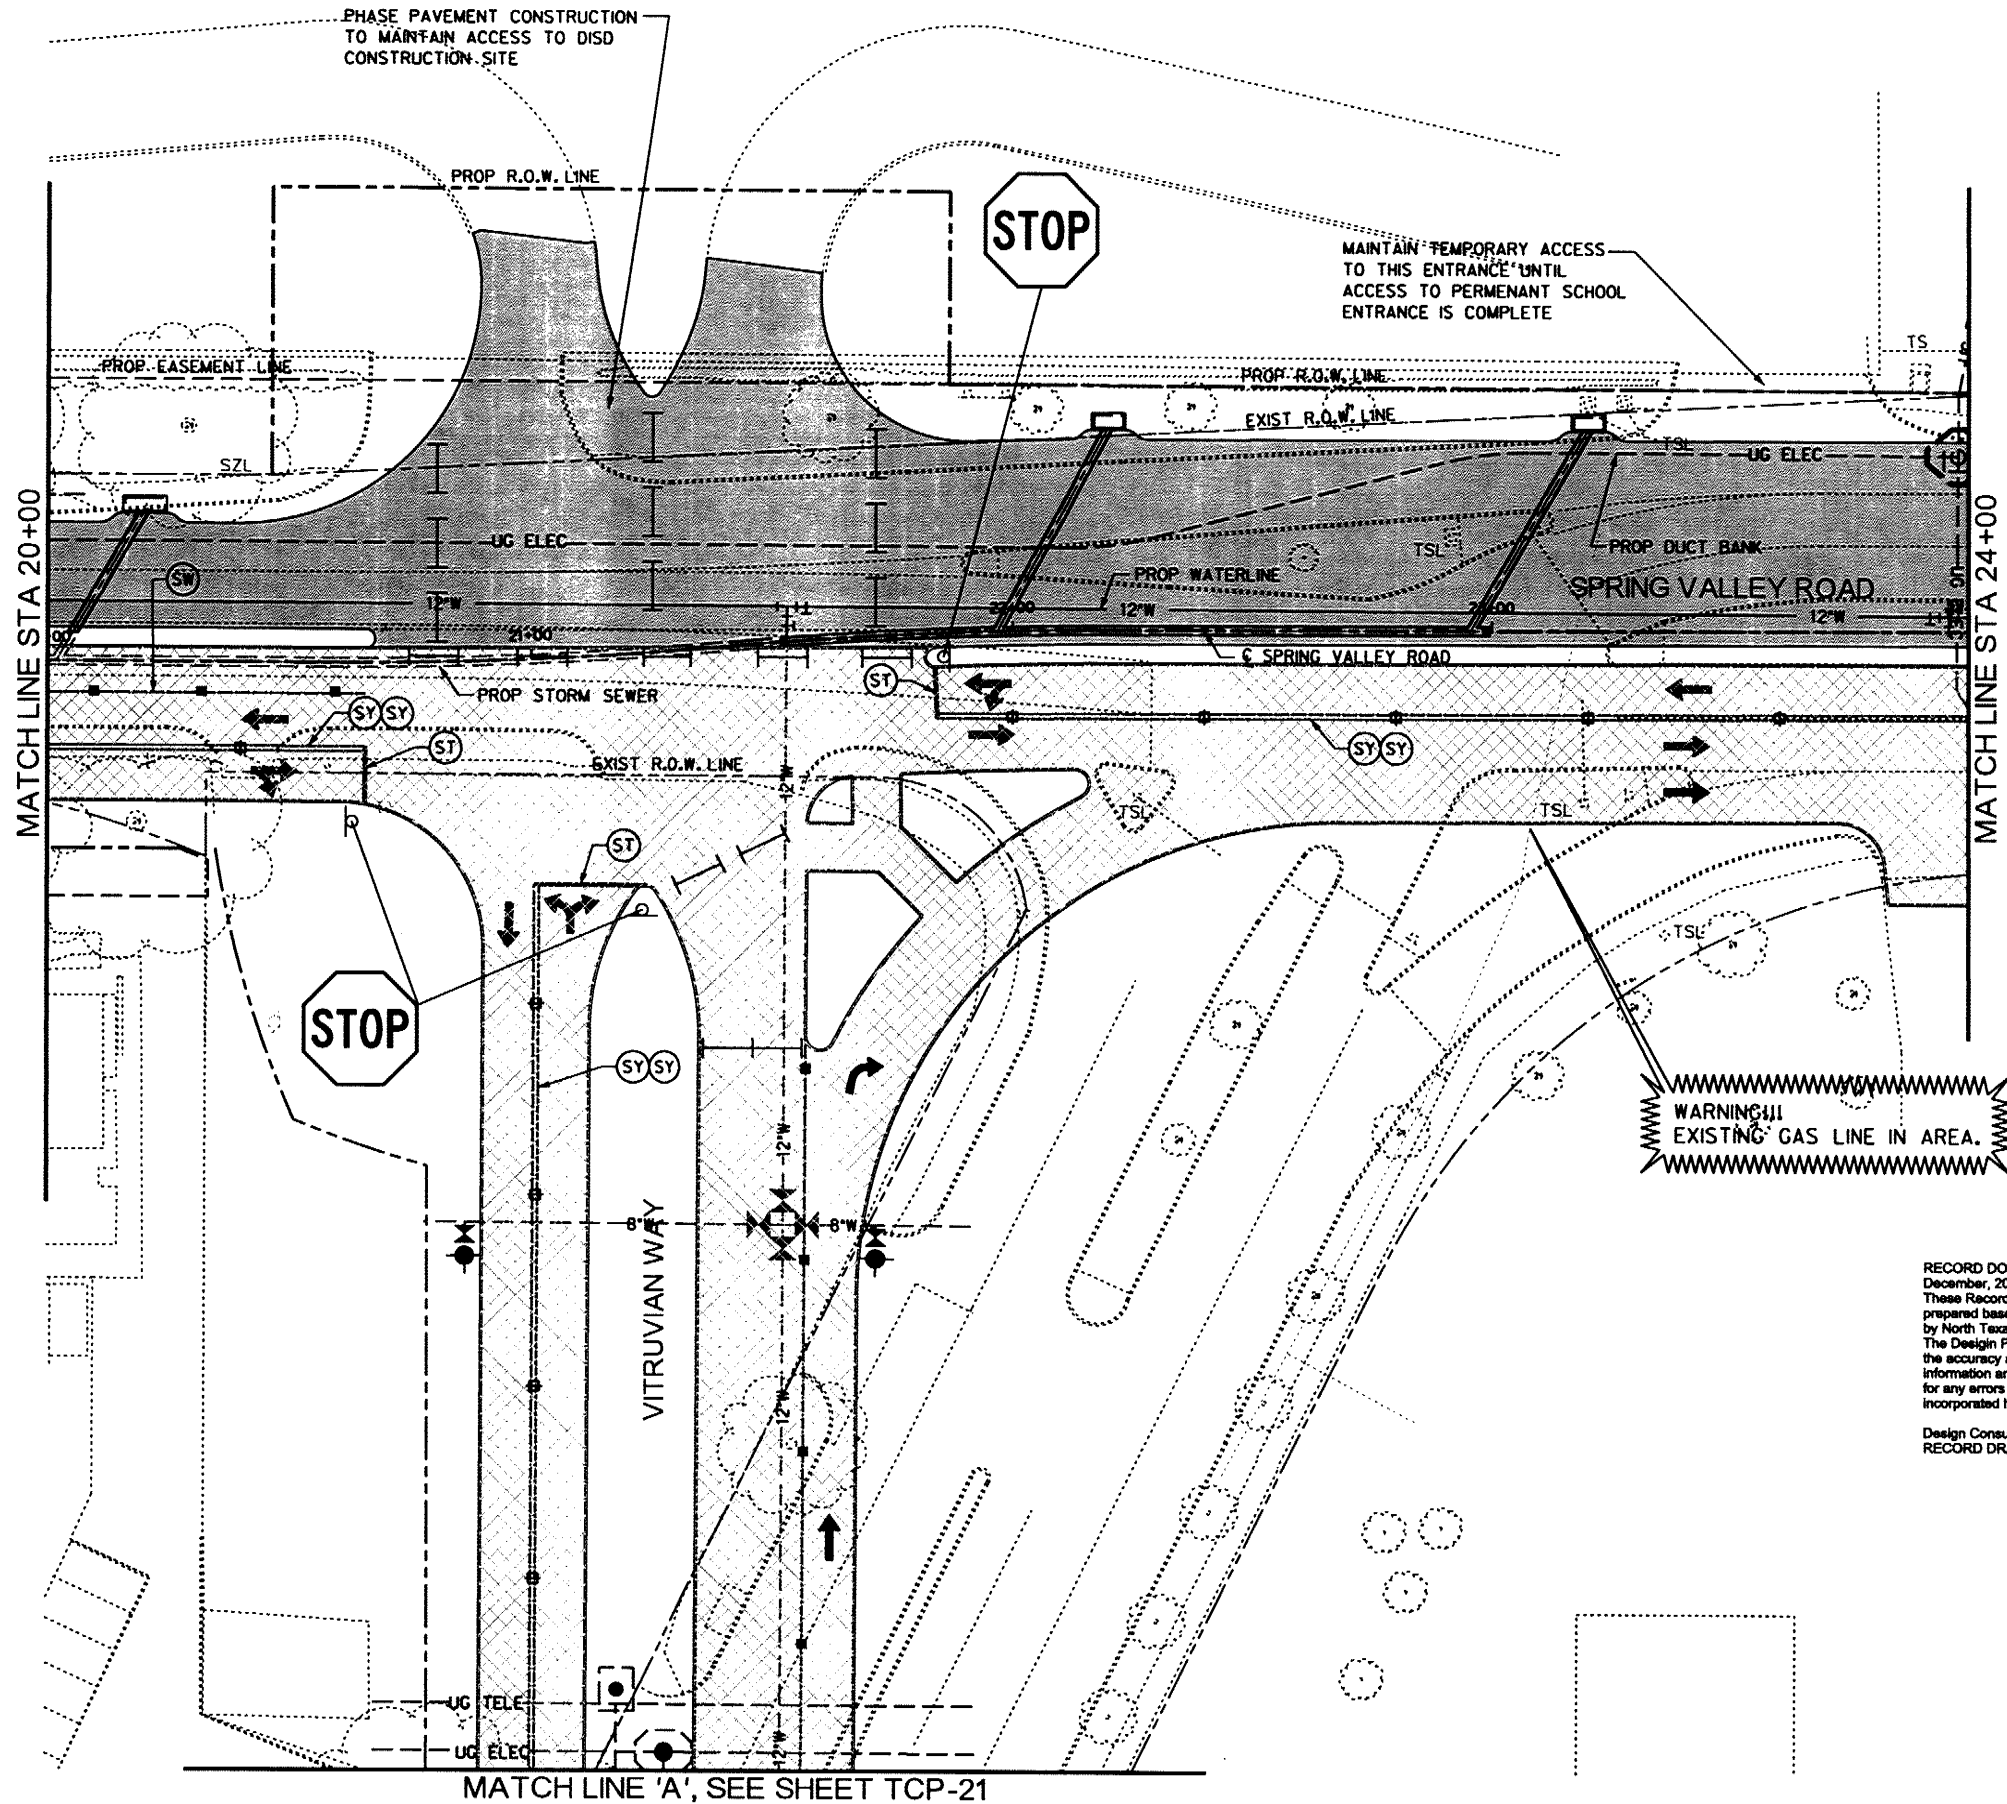

TRAFFIC CONTROL LEGEND:

- TEMPORARY 8" HMAC PAVEMENT
- PAVEMENT CONSTRUCTED IN THIS PHASE
- PAVEMENT CONSTRUCTED IN PREVIOUS PHASE
- TEMPORARY PAVEMENT HMAC WIDENING PREVIOUS PHASE
- TRAFFIC FLOW DIRECTION
- CONSTRUCTION SIGN
- PLASTIC DRUM CHANNELIZING DEVICE
- VERTICAL PANEL WITH TWO WAY TRAFFIC SIGN ON BOTH SIDES
- VERTICAL PANEL (VP)
- TYPE III BARRICADE
- STORM BUILT THIS PHASE
- STORM BUILT PREVIOUS PHASE
- 12"W WATER BUILT THIS PHASE
- 12"W WATER BUILT PREVIOUS PHASE
- 8" SS SANITARY BUILT THIS PHASE
- 8" SS SANITARY BUILT PREVIOUS PHASE
- UG ELEC DUCT BANK BUILT THIS PHASE
- UG ELEC DUCT BANK BUILT PREVIOUS PHASE
- OH ELEC OVERHEAD ELECT. BUILT THIS PHASE
- OH ELEC OVERHEAD ELECT. BUILT PREVIOUS PHASE
- REMOVABLE 4" SOLID WHITE
- REMOVABLE 4" BROKEN WHITE
- REMOVABLE 4" DOTTED WHITE
- REMOVABLE 24" STOP BAR
- REMOVABLE 4" SOLID YELLOW
- EXISTING / PREVIOUS PAV MARKINGS

RECORD DOCUMENTS
 December, 2011
 These Record Documents have been prepared based upon information provided by North Texas Contracting, Inc. The Design Professional has not verified the accuracy and / or completeness of this information and shall not be responsible for any errors or omissions which may be incorporated herein as a result.


Design Consultant: Half Associates, Inc.
 RECORD DRAWING SUBMITTAL

Signature of Registrant: *U.E. Romanowski* Date: *12/8/2011*

NO.	REVISION	BY	DATE
ADDISON TOWN OF ADDISON DALLAS COUNTY, TEXAS SPRING VALLEY ROAD			
TRAFFIC CONTROL PLAN PHASE 3B			
HALFF 1201 NORTH BOWSER ROAD, RICHARDSON, TEXAS 75081-2275 TEL (214) 348-6200 FAX (214) 738-0095			
PROJECT	DESIGN	DRAWN	DATE
27530	MPB	TMM	OCTOBER 2010
FILE	SHEET		
27530 TCP 03-02-04	TCP-19		

SHEET 77 OF 163 RECORD DRAWINGS

DATE: 12/7/2011 TIME: 10:41:41 AM FILE: 27530.TCP.03-02-05.dgn PROJECT: 27530 OFFICE: RCH USER: ch1299

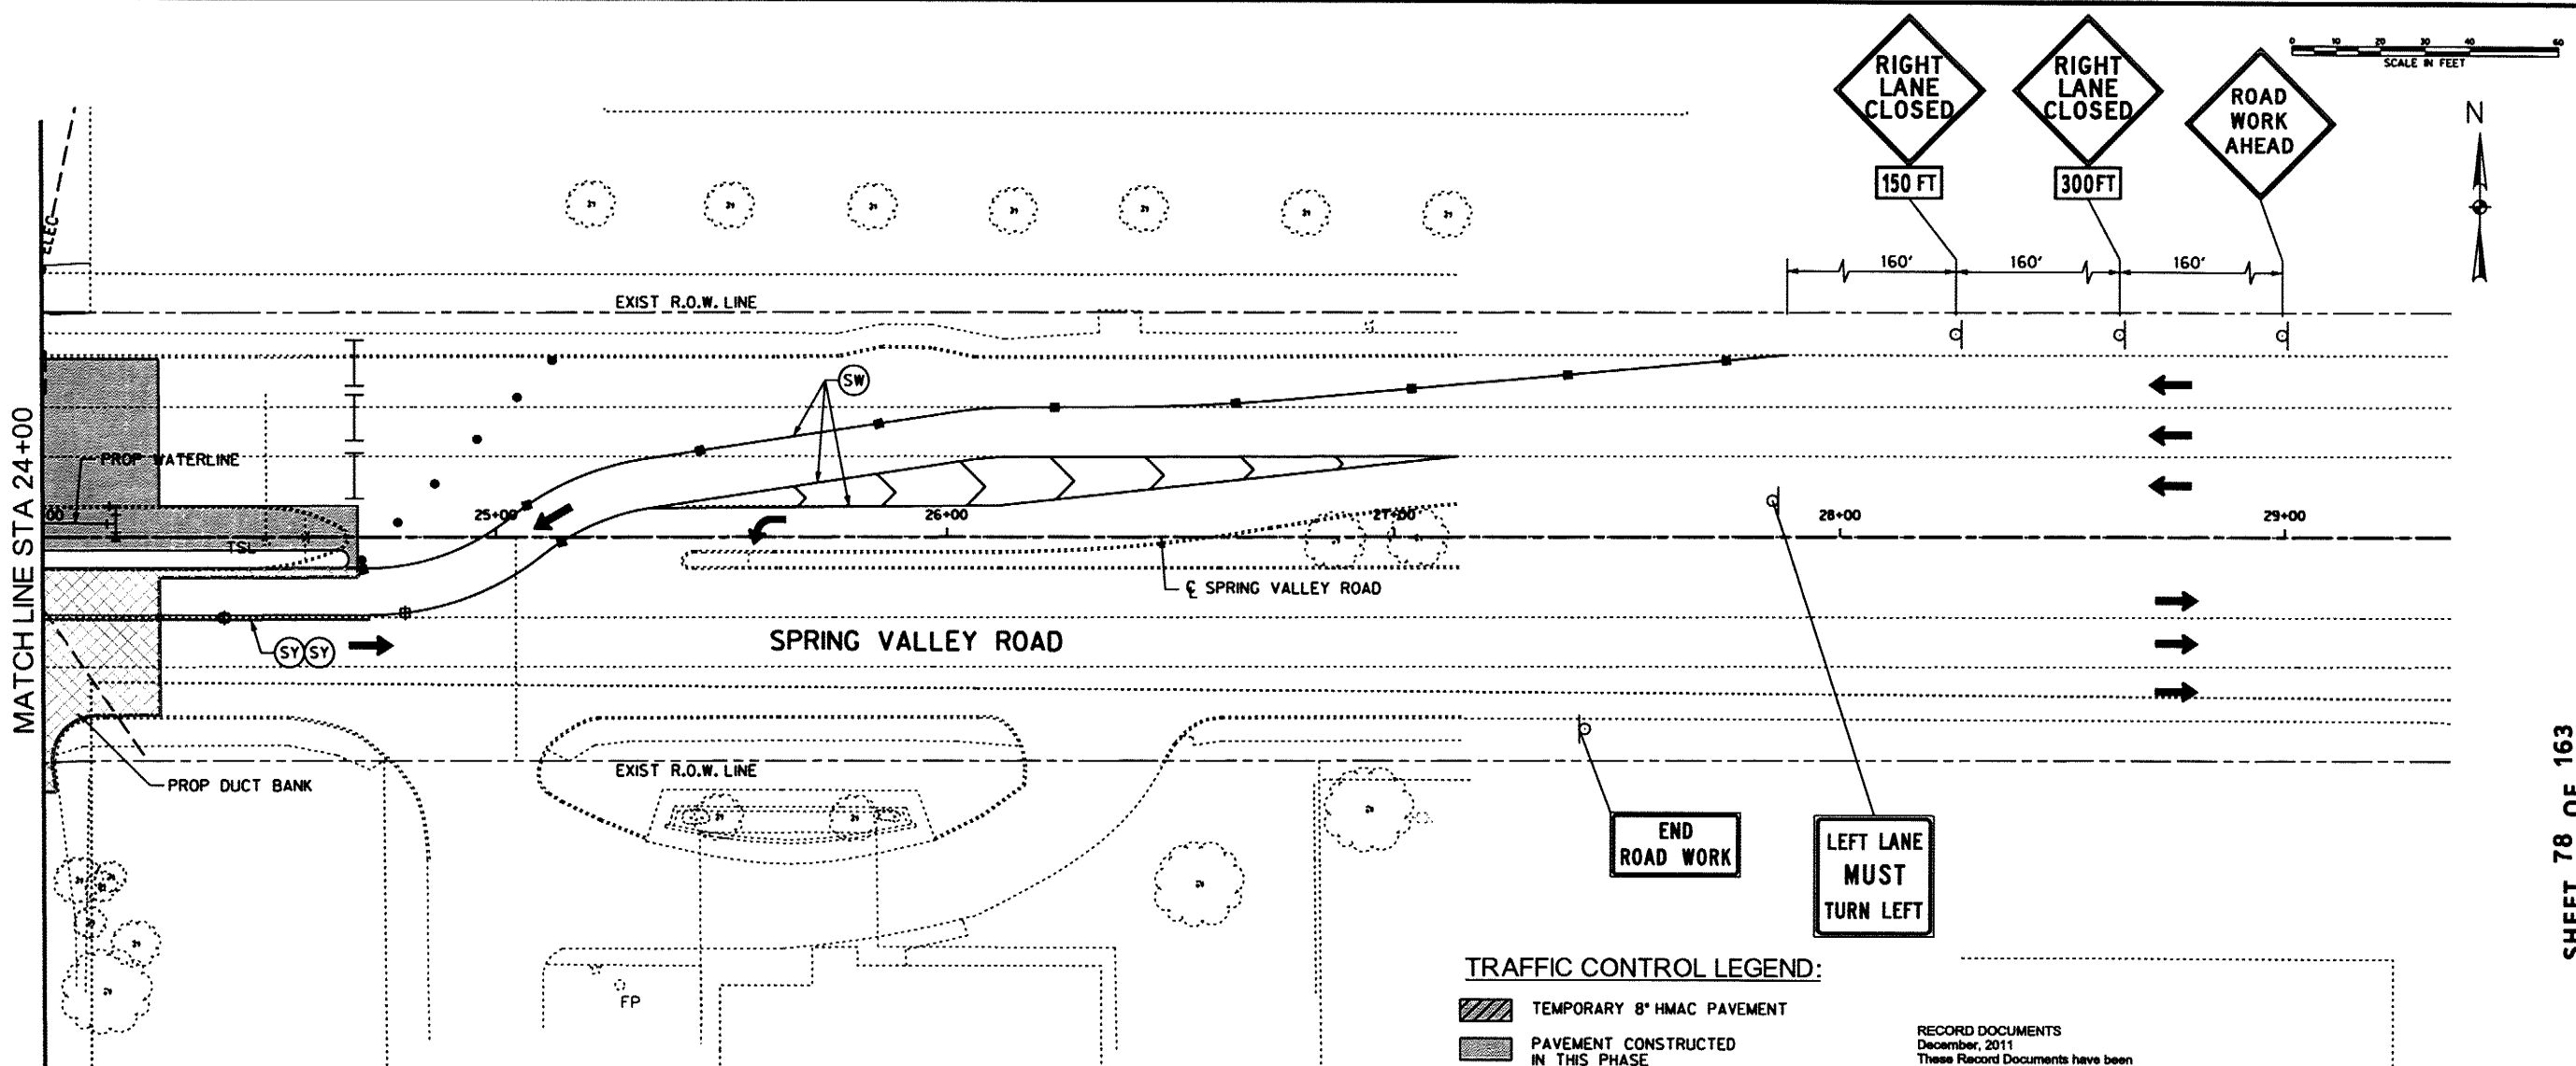

TRAFFIC CONTROL LEGEND:

- TEMPORARY 8" HMAC PAVEMENT
- PAVEMENT CONSTRUCTED IN THIS PHASE
- PAVEMENT CONSTRUCTED IN PREVIOUS PHASE
- TEMPORARY PAVEMENT HMAC WIDENING PREVIOUS PHASE
- TRAFFIC FLOW DIRECTION
- CONSTRUCTION SIGN
- PLASTIC DRUM CHANNELIZING DEVICE
- VERTICAL PANEL WITH TWO WAY TRAFFIC SIGN ON BOTH SIDES
- VERTICAL PANEL (VP)
- TYPE III BARRICADE
- STORM BUILT THIS PHASE
- STORM BUILT PREVIOUS PHASE
- 12" W WATER BUILT THIS PHASE
- 12" W WATER BUILT PREVIOUS PHASE
- 8" SS SANITARY BUILT THIS PHASE
- 8" SS SANITARY BUILT PREVIOUS PHASE
- UG ELEC DUCT BANK BUILT THIS PHASE
- UG ELEC DUCT BANK BUILT PREVIOUS PHASE
- OH ELEC OVERHEAD ELECT. BUILT THIS PHASE
- OH ELEC OVERHEAD ELECT. BUILT PREVIOUS PHASE
- REMOVABLE 4" SOLID WHITE
- REMOVABLE 4" BROKEN WHITE
- REMOVABLE 4" DOTTED WHITE
- REMOVABLE 24" STOP BAR
- REMOVABLE 4" SOLID YELLOW
- EXISTING / PREVIOUS PAV MARKINGS



RECORD DOCUMENTS
 December, 2011
 These Record Documents have been prepared based upon information provided by North Texas Contracting, Inc. The Design Professional has not verified the accuracy and / or completeness of this information and shall not be responsible for any errors or omissions which may be incorporated herein as a result.
 Design Consultant: Halff Associates, Inc.
 RECORD DRAWING SUBMITTAL

Signature of Registrant: *M.F. Romanowski* Date: 12/8/2011

NO.	REVISION	BY	DATE
Additional TOWN OF ADDISON DALLAS COUNTY, TEXAS SPRING VALLEY ROAD			
TRAFFIC CONTROL PLAN PHASE 3B			
HALFF 1201 NORTH BOWSER ROAD, RICHARDSON, TEXAS 75081-3275 TEL (214) 346-8200 FAX (214) 730-0065			
PROJECT	DESIGN	DRAWN	DATE
27530	MPB	TMM	OCTOBER 2010
FILE	SHEET		
27530 TCP 03-02-05	TCP-20		

RECORD DRAWINGS SHEET 78 OF 163

DATE: 12/7/2011 TIME: 10:41:53 AM FILE: 27530 TCP 03-02-06.dgn PROJECT: 27530 OFFICE: RCH USER: ah299

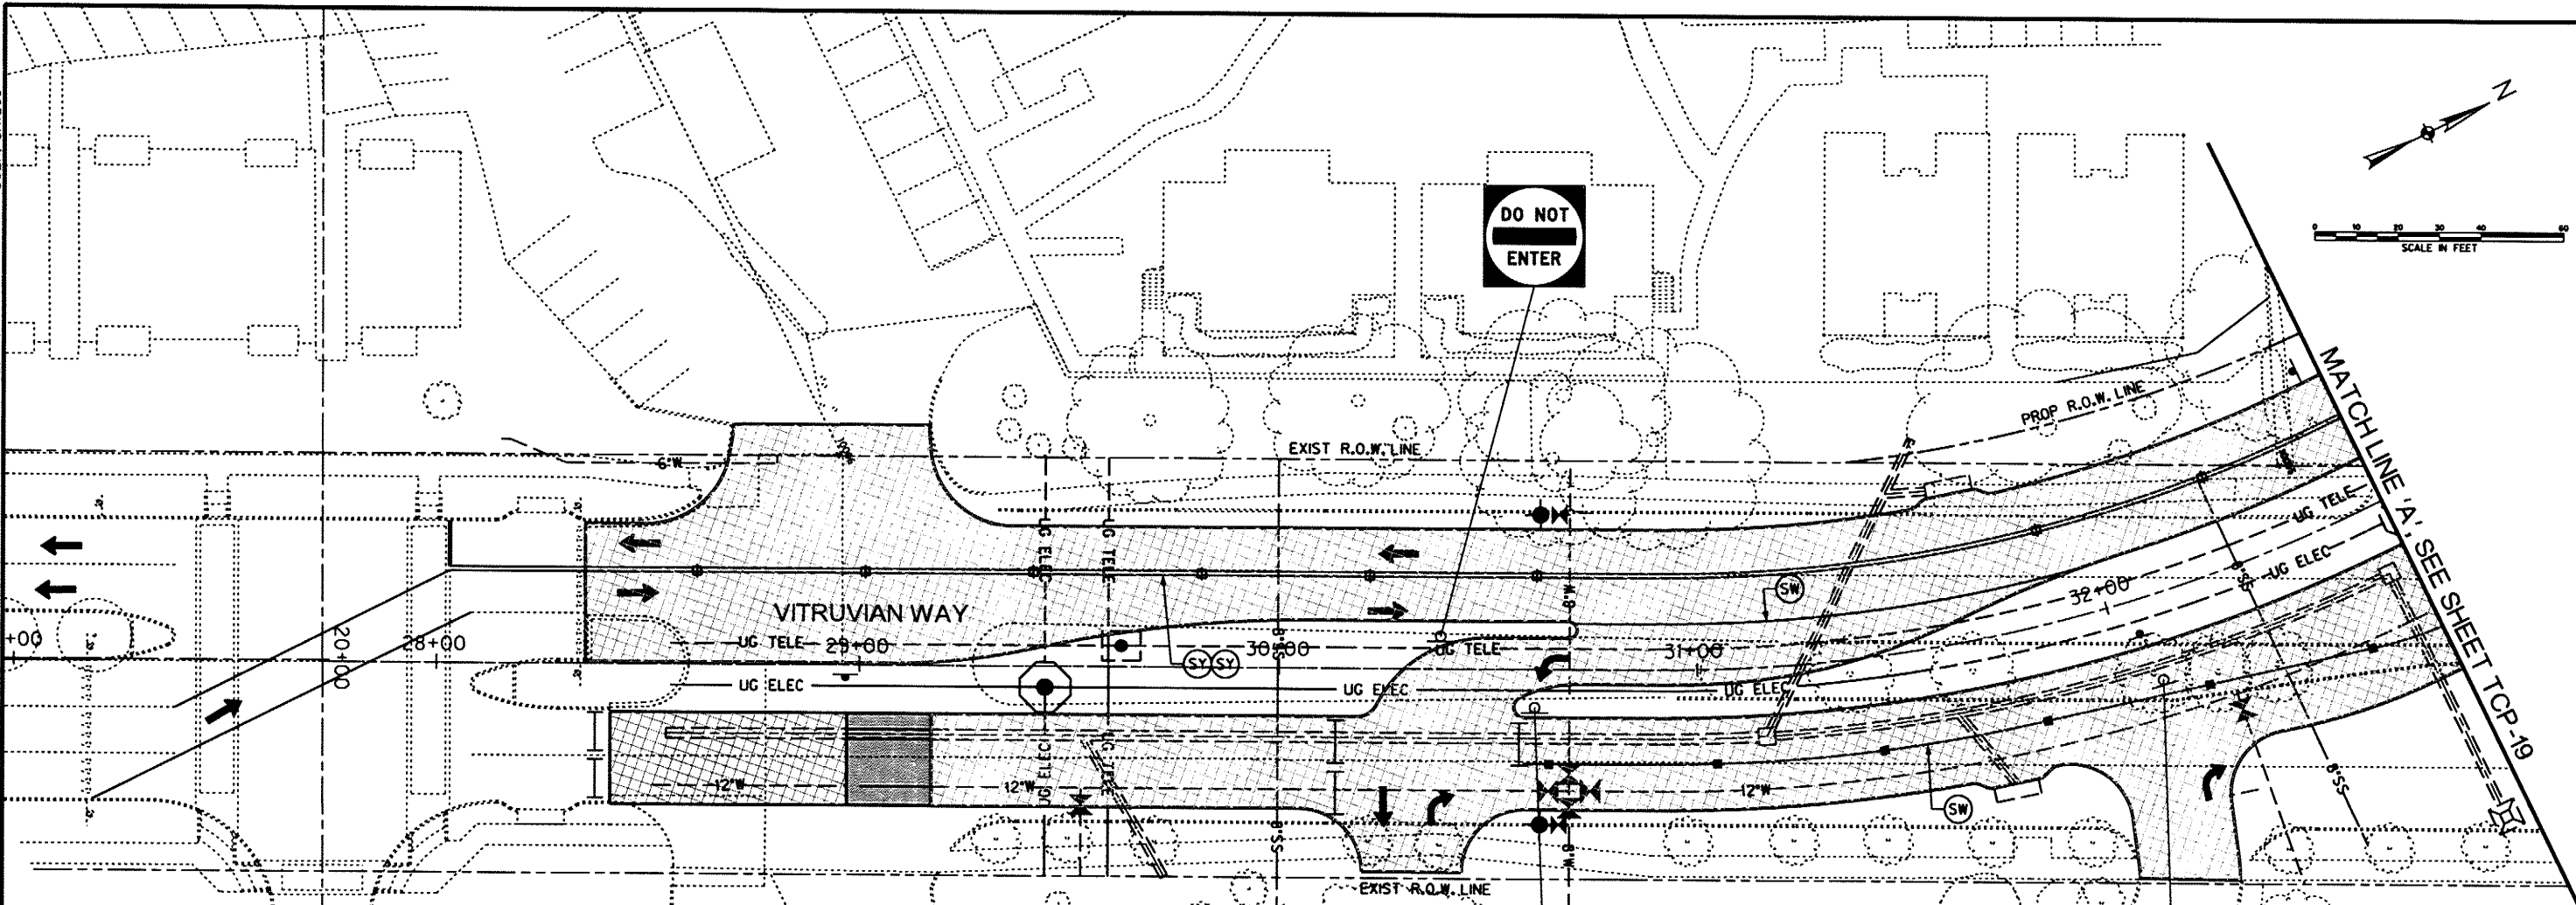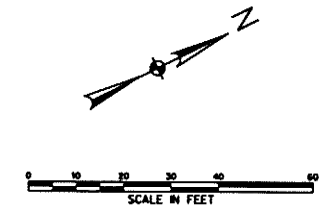

TRAFFIC CONTROL LEGEND:

- TEMPORARY 8" HMAC PAVEMENT
- PAVEMENT CONSTRUCTED IN THIS PHASE
- PAVEMENT CONSTRUCTED IN PREVIOUS PHASE
- TEMPORARY PAVEMENT HMAC WIDENING PREVIOUS PHASE
- TRAFFIC FLOW DIRECTION
- CONSTRUCTION SIGN
- PLASTIC DRUM CHANNELIZING DEVICE
- VERTICAL PANEL WITH TWO WAY TRAFFIC SIGN ON BOTH SIDES
- VERTICAL PANEL (VP)
- TYPE III BARRICADE
- STORM BUILT THIS PHASE
- STORM BUILT PREVIOUS PHASE
- 12" W WATER BUILT THIS PHASE
- 12" W WATER BUILT PREVIOUS PHASE
- 8" SS SANITARY BUILT THIS PHASE
- 8" SS SANITARY BUILT PREVIOUS PHASE
- UG ELEC DUCT BANK BUILT THIS PHASE
- UG ELEC DUCT BANK BUILT PREVIOUS PHASE
- OH ELEC OVERHEAD ELECT. BUILT THIS PHASE
- OH ELEC OVERHEAD ELECT. BUILT PREVIOUS PHASE
- (SW) REMOVABLE 4" SOLID WHITE
- (BW) REMOVABLE 4" BROKEN WHITE
- (DW) REMOVABLE 4" DOTTED WHITE
- (ST) REMOVABLE 24" STOP BAR
- (SY) REMOVABLE 4" SOLID YELLOW
- (X) EXISTING / PREVIOUS PAV MARKINGS





[Signature] P.E. *rdg/2011*
 Signature of Registrant Date

RECORD DOCUMENTS
 December, 2011
 These Record Documents have been prepared based upon information provided by North Texas Contracting, Inc. The Design Professional has not verified the accuracy and/or completeness of this information and shall not be responsible for any errors or omissions which may be incorporated herein as a result.
 Design Consultant: Half Associates, Inc.
 RECORD DRAWING SUBMITTAL

NO.	REVISION	BY	DATE
TOWN OF ADDISON DALLAS COUNTY, TEXAS SPRING VALLEY ROAD			
TRAFFIC CONTROL PLAN PHASE 3B			
1201 NORTH BOWSER ROAD, RICHARDSON, TEXAS 75081-2275 TEL (214) 348-8200 FAX (214) 798-0085			
PROJECT	DESIGN	DRAWN	DATE
27530	MPB	TMM	OCTOBER 2010
FILE	SHEET		
27530 TCP 03-02-06	TCP-21		

SHEET 79 OF 163 RECORD DRAWINGS

USER: oh1299
 OFFICE: RCH
 PROJECT: 27530
 DATE: 12/7/2011
 TIME: 10:42:16 AM
 FILE: 27530_SW3P_01.dgn

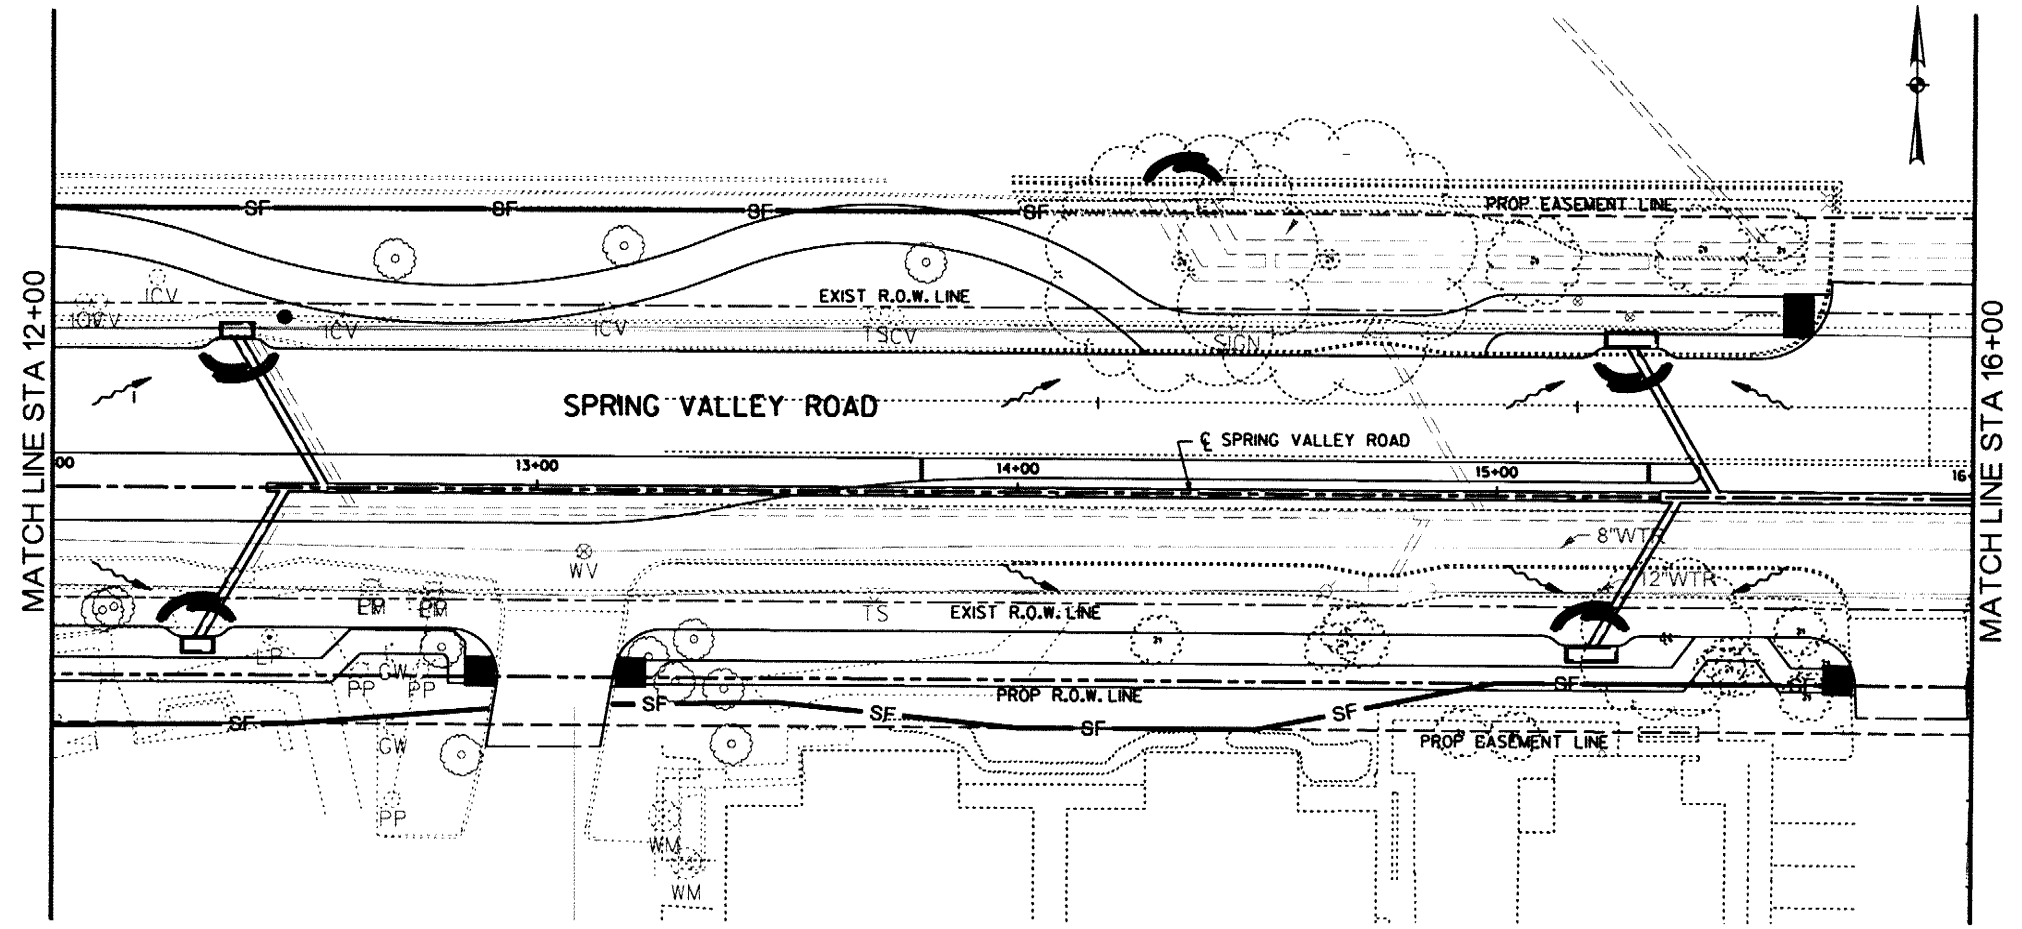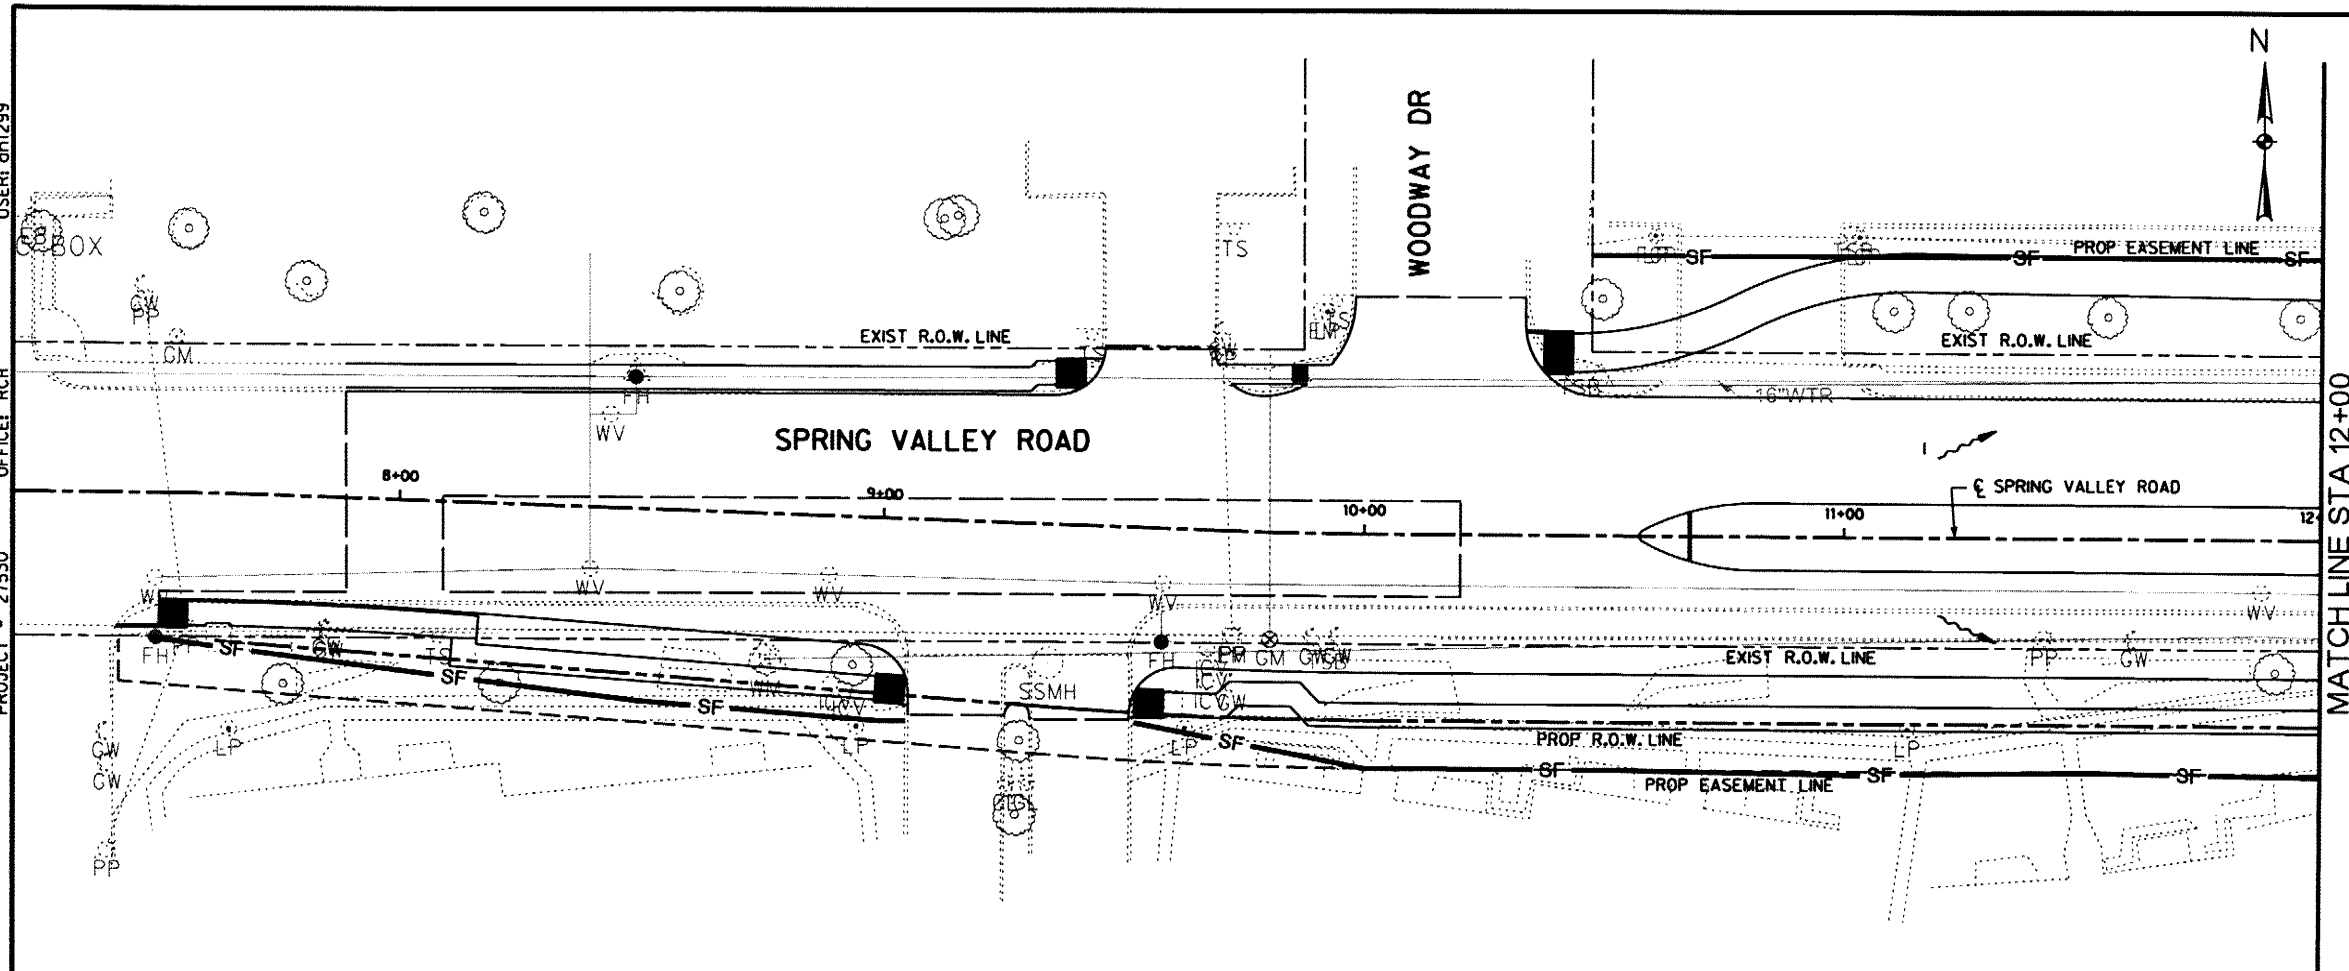

LEGEND

- DIRECTION OF DRAINAGE FLOW
- PROP STORM DRAIN
- EXIST STORM DRAIN
- SEDIMENT CONTROL FENCE
- INLET PROTECTION


RECORD DOCUMENTS
 December, 2011
 These Record Documents have been prepared based upon information provided by North Texas Contracting, Inc. The Design Professional has not verified the accuracy and / or completeness of this information and shall not be responsible for any errors or omissions which may be incorporated herein as a result.

Design Consultant: Half Associates, Inc.
 RECORD DRAWING SUBMITTAL

Signature of Registrant: *M.E. Romandowski*
 Date: 12/6/2011

NO.	REVISION	BY	DATE		
TOWN OF ADDISON DALLAS COUNTY, TEXAS SPRING VALLEY ROAD					
SW3P LAYOUTS STA 7+49.89 TO STA 16+00					
HALFF 1201 NORTH BOWSER ROAD, RICHARDSON, TEXAS 75081-2275 TEL (214) 346-4200 FAX (214) 738-0085					
PROJECT	DESIGN	DRAWN	DATE	FILE	SHEET
27530	MPB	TMM	OCTOBER 2010	27530 SW3P 01	EC-1

RECORD DRAWINGS SHEET 80 OF 163

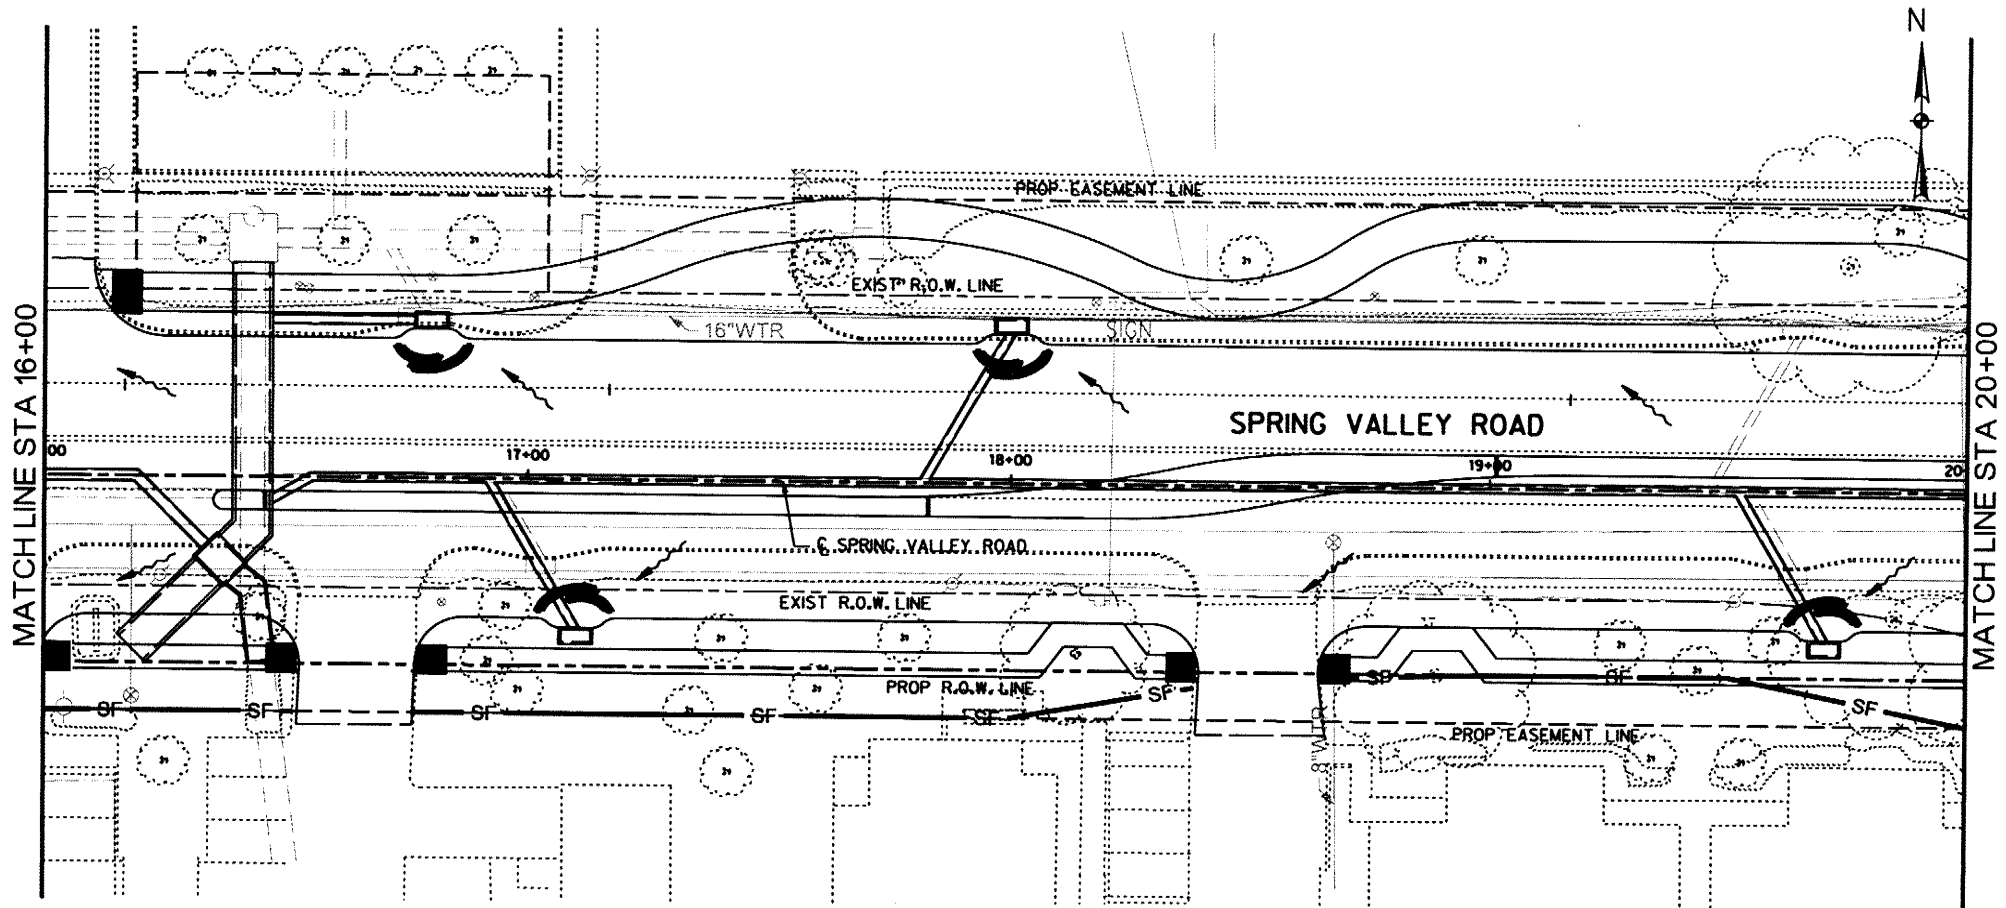


LEGEND

- DIRECTION OF DRAINAGE FLOW
- PROP STORM DRAIN
- EXIST STORM DRAIN
- SEDIMENT CONTROL FENCE
- INLET PROTECTION

RECORD DOCUMENTS
 December, 2011
 These Record Documents have been prepared based upon information provided by North Texas Contracting, Inc. The Design Professional has not verified the accuracy and / or completeness of this information and shall not be responsible for any errors or omissions which may be incorporated herein as a result.




Design Consultant: Half Associates, Inc.
 RECORD DRAWING SUBMITTAL

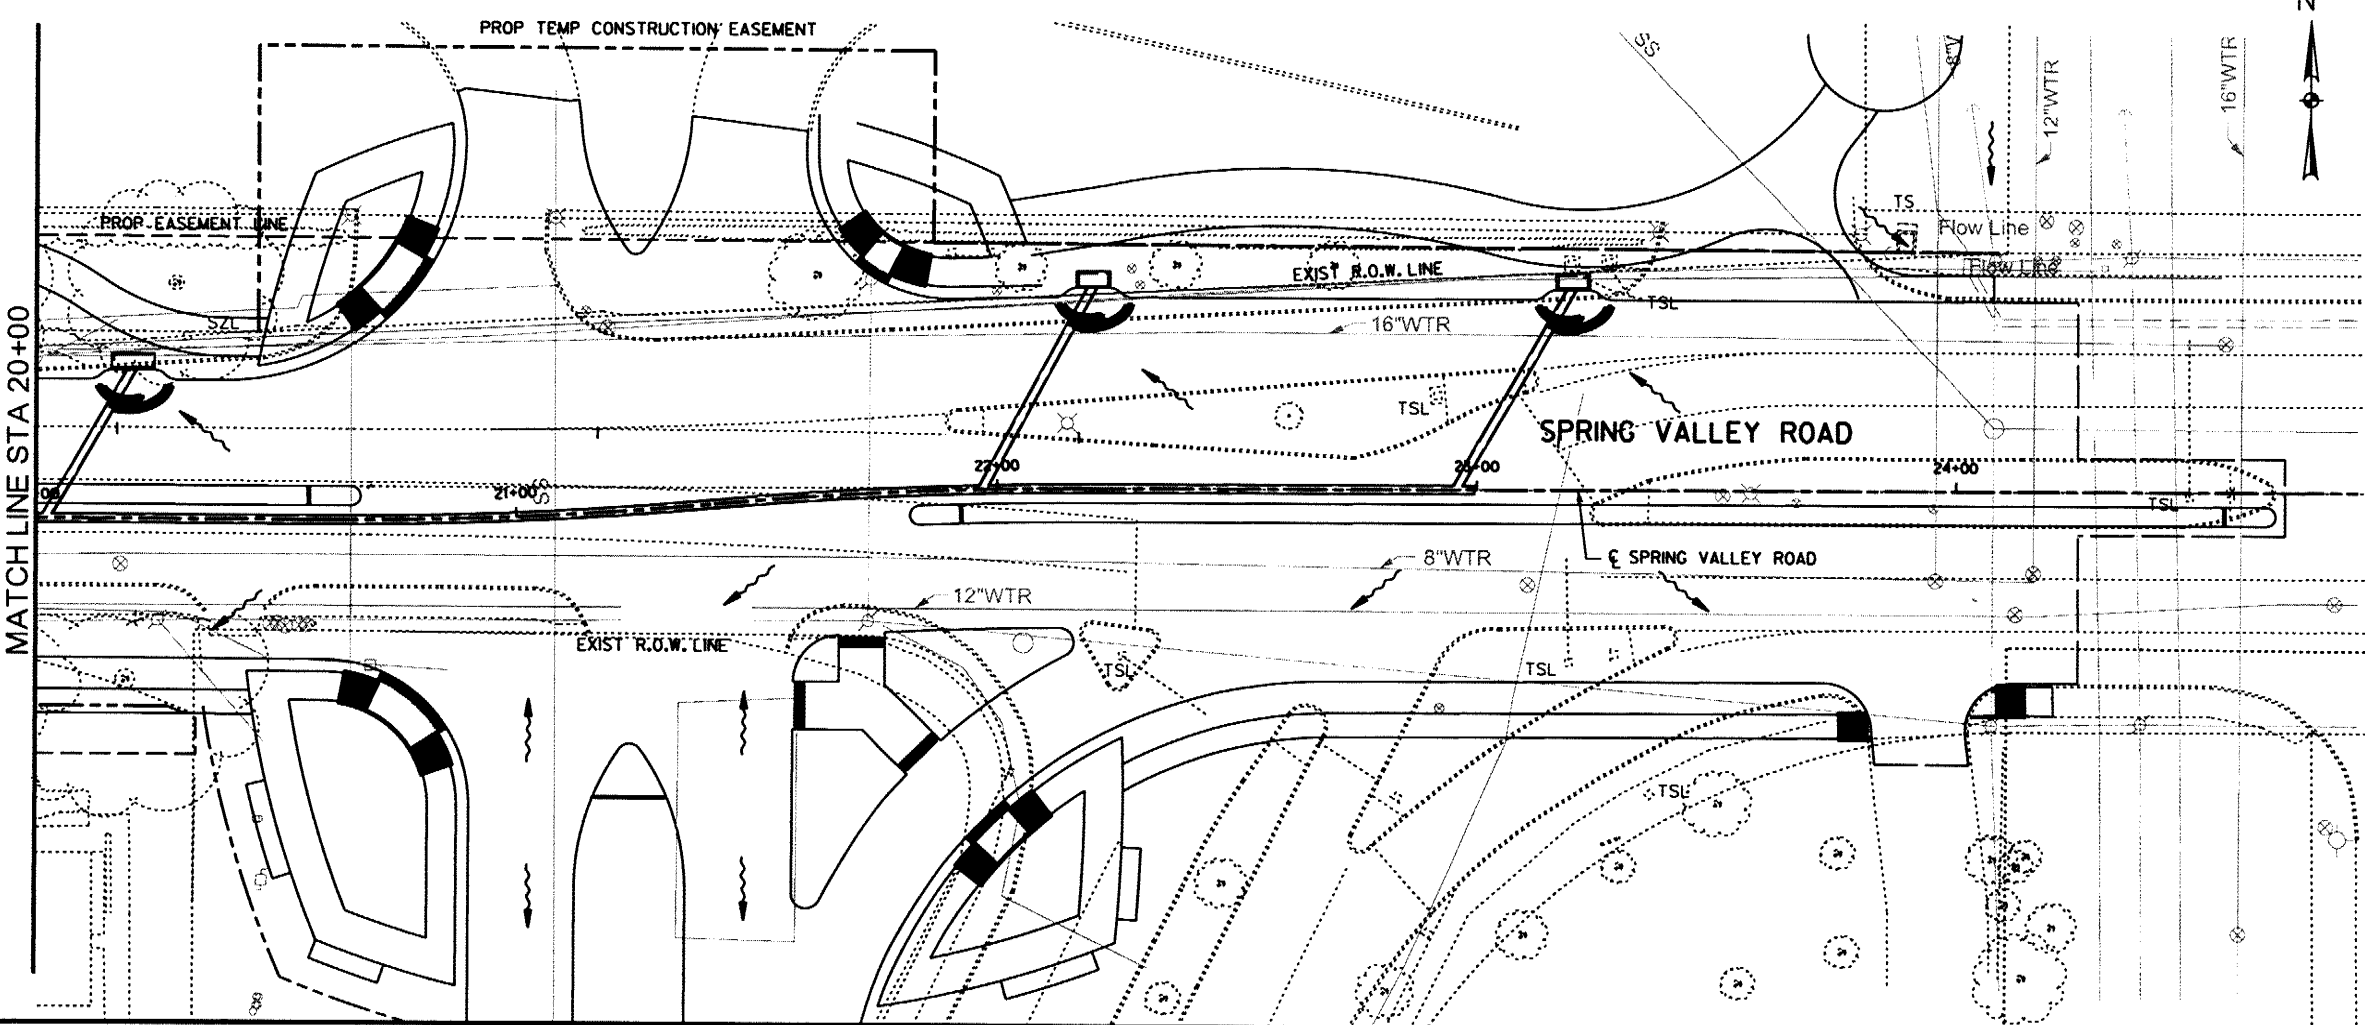

Signature of Registrant: *M.E. Romanowski* P.E. Date: *12/21/11*

NO.		REVISION		BY	DATE
TOWN OF ADDISON DALLAS COUNTY, TEXAS SPRING VALLEY ROAD SW3P LAYOUTS STA 16+00 TO STA 26+11.52					
HALFF 1201 NORTH BOWSER ROAD, RICHARDSON, TEXAS 75081-2275 TEL (214) 346-8200 FAX (214) 730-0095					
PROJECT	DESIGN	DRAWN	DATE	FILE	SHEET
27530	MPB	TMM	OCTOBER 2010	27530 SW3P 02	EC-2

DATE: 12/17/2011 TIME: 10:42:55 AM FILE: 27530 DTEC 01.dgn PROJECT: 27530 OFFICE: RCH USER: gh1299

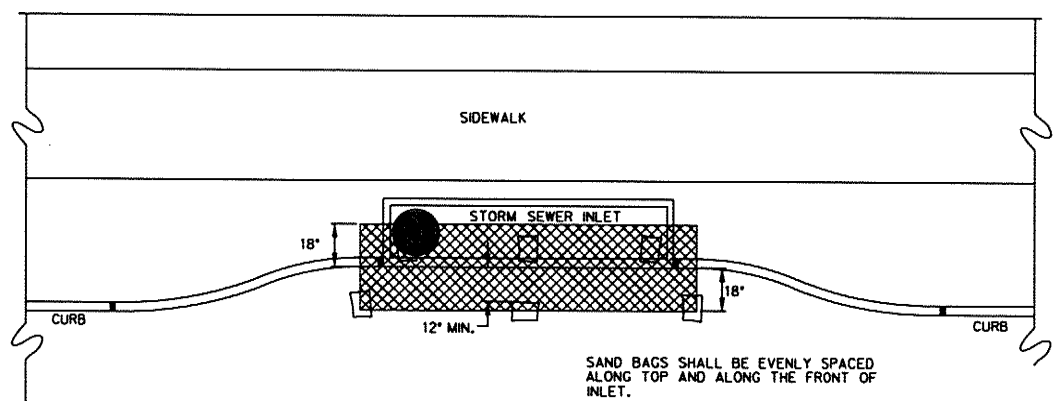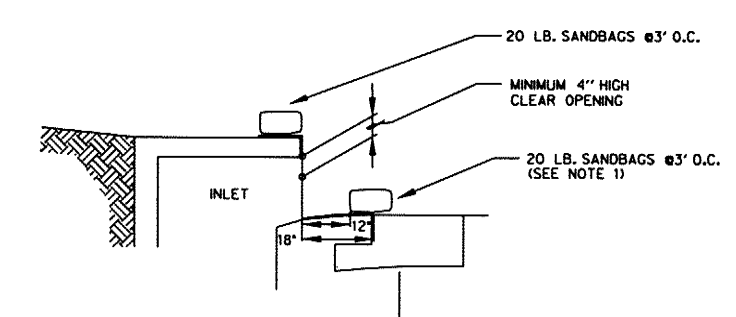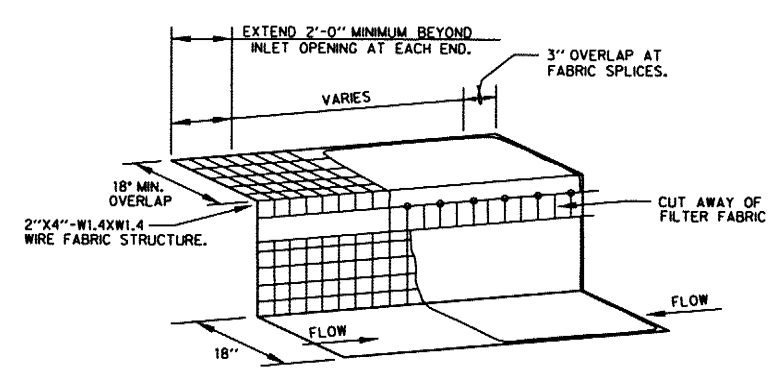


NOTES:

1. A SECTION OF FILTER FABRIC SHALL BE REMOVED AS SHOWN ON THIS DETAIL TO PROVIDE A 4" MINIMUM CLEAR OPENING. FABRIC MUST BE SECURED TO WIRE BACKING WITH CLIPS OR HOG RINGS AT THIS LOCATION.
2. INSPECTION SHALL BE MADE BY THE CONTRACTOR AND SILT ACCUMULATION MUST BE REMOVED WHEN DEPTH REACHES 2".
3. CONTRACTOR SHALL MONITOR THE PERFORMANCE OF INLET PROTECTION DURING EACH RAINFALL EVENT AND IMMEDIATELY REMOVE THE INLET PROTECTIONS IF THE STORM-WATER BEGINS TO OVERTOP THE CURB.
4. INLET PROTECTIONS SHALL BE REMOVED AS SOON AS THE SOURCE OF SEDIMENT IS STABILIZED.

INLET OPENING	MINIMUM NUMBER OF SAND BAGS	
	TOP	FRONT
5'	2	3
10'	3	3
15'	3	4
20'	4	4

CURB INLET PROTECTION DETAIL
NOT TO SCALE

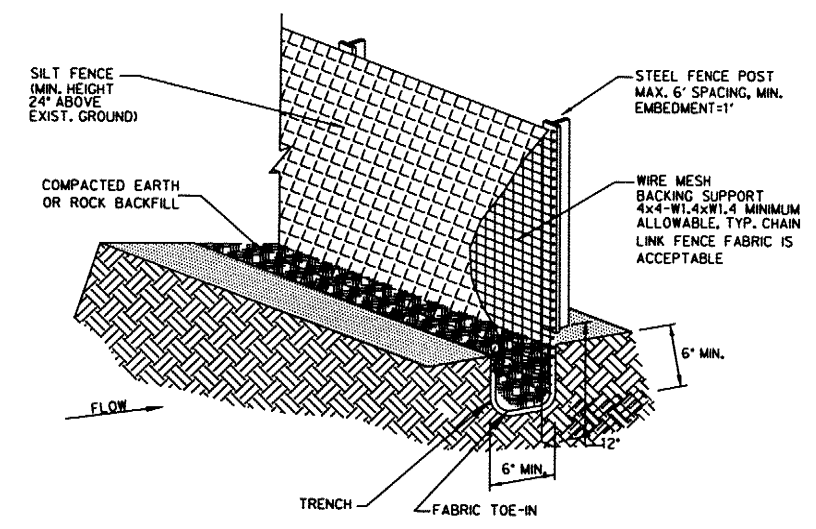

SILT FENCE ISOMETRIC PLAN VIEW
NOT TO SCALE


- SILT FENCE GENERAL NOTES**
1. STEEL POSTS WHICH SUPPORT THE SILT FENCE SHALL BE INSTALLED ON A SLIGHT ANGLE TOWARD THE ANTICIPATED RUNOFF SOURCE. POST MUST BE EMBEDDED A MINIMUM OF ONE FOOT.
 2. THE TOE OF THE SILT FENCE SHALL BE TRENCHED IN WITH A SPADE OR MECHANICAL TRENCHER, SO THAT THE DOWNSLOPE FACE OF THE TRENCH IS FLAT AND PERPENDICULAR TO THE LINE OF FLOW. WHERE FENCE CANNOT BE TRENCHED IN (e.g. PAVEMENT), WEIGHT FABRIC FLAP WITH ROCK ON UPHILL SIDE TO PREVENT FLOW FROM SEEPING UNDER FENCE.
 3. THE TRENCH MUST BE A MINIMUM OF 6 INCHES DEEP AND 6 INCHES WIDE TO ALLOW FOR THE SILT FENCE FABRIC TO BE LAID IN THE GROUND AND BACKFILLED WITH COMPACTED MATERIAL.
 4. SILT FENCE SHOULD BE SECURELY FASTENED TO EACH STEEL SUPPORT POST OR TO WOVEN WIRE, WHICH IN TURN IS ATTACHED TO THE STEEL FENCE POST. THERE SHALL BE A 3 FOOT OVERLAP, SECURELY FASTENED WHERE ENDS OF FABRIC MEET.
 5. INSPECTION SHALL BE MADE EVERY TWO WEEKS AND AFTER EACH 1/2" RAINFALL. REPAIR OR REPLACEMENT SHALL BE MADE PROMPTLY AS NEEDED.
 6. SILT FENCE SHALL BE REMOVED WHEN THE SITE IS COMPLETELY STABILIZED SO AS NOT TO BLOCK OR IMPEDE STORM FLOW OR DRAINAGE.
 7. ACCUMULATED SILT SHALL BE REMOVED WHEN IT REACHES A DEPTH OF HALF THE HEIGHT OF THE FENCE. THE SILT SHALL BE DISPOSED OF AT AN APPROVED SITE AND IN SUCH A MANNER AS TO NOT CONTRIBUTE TO ADDITIONAL SILTATION.

RECORD DOCUMENTS
December, 2011
These Record Documents have been prepared based upon information provided by North Texas Contracting, Inc. The Design Professional has not verified the accuracy and / or completeness of this information and shall not be responsible for any errors or omissions which may be incorporated herein as a result.
Design Consultant: Half Associates, Inc.
RECORD DRAWING SUBMITTAL


Signature of Registrant: *M.E. Romanowski* Date: *12/17/2011*
P.E.

NO.	REVISION	BY	DATE		
<i>Addison</i> TOWN OF ADDISON DALLAS COUNTY, TEXAS					
SPRING VALLEY ROAD					
EROSION CONTROL DETAILS					
HALFF 1201 NORTH BOWSER ROAD, RICHARDSON, TEXAS 75081-2275 TEL (214) 348-8200 FAX (214) 738-0095					
PROJECT	DESIGN	DRAWN	DATE	FILE	SHEET
27530	MPB	TMM	OCTOBER 2010	27530 DTEC 01	DT-EC

DATE: 12/7/2011 TIME: 10:46:06 AM FILE: TR-XSSH-27530.dgn PROJECT: 27530 OFFICE: RCH USER: dh1299

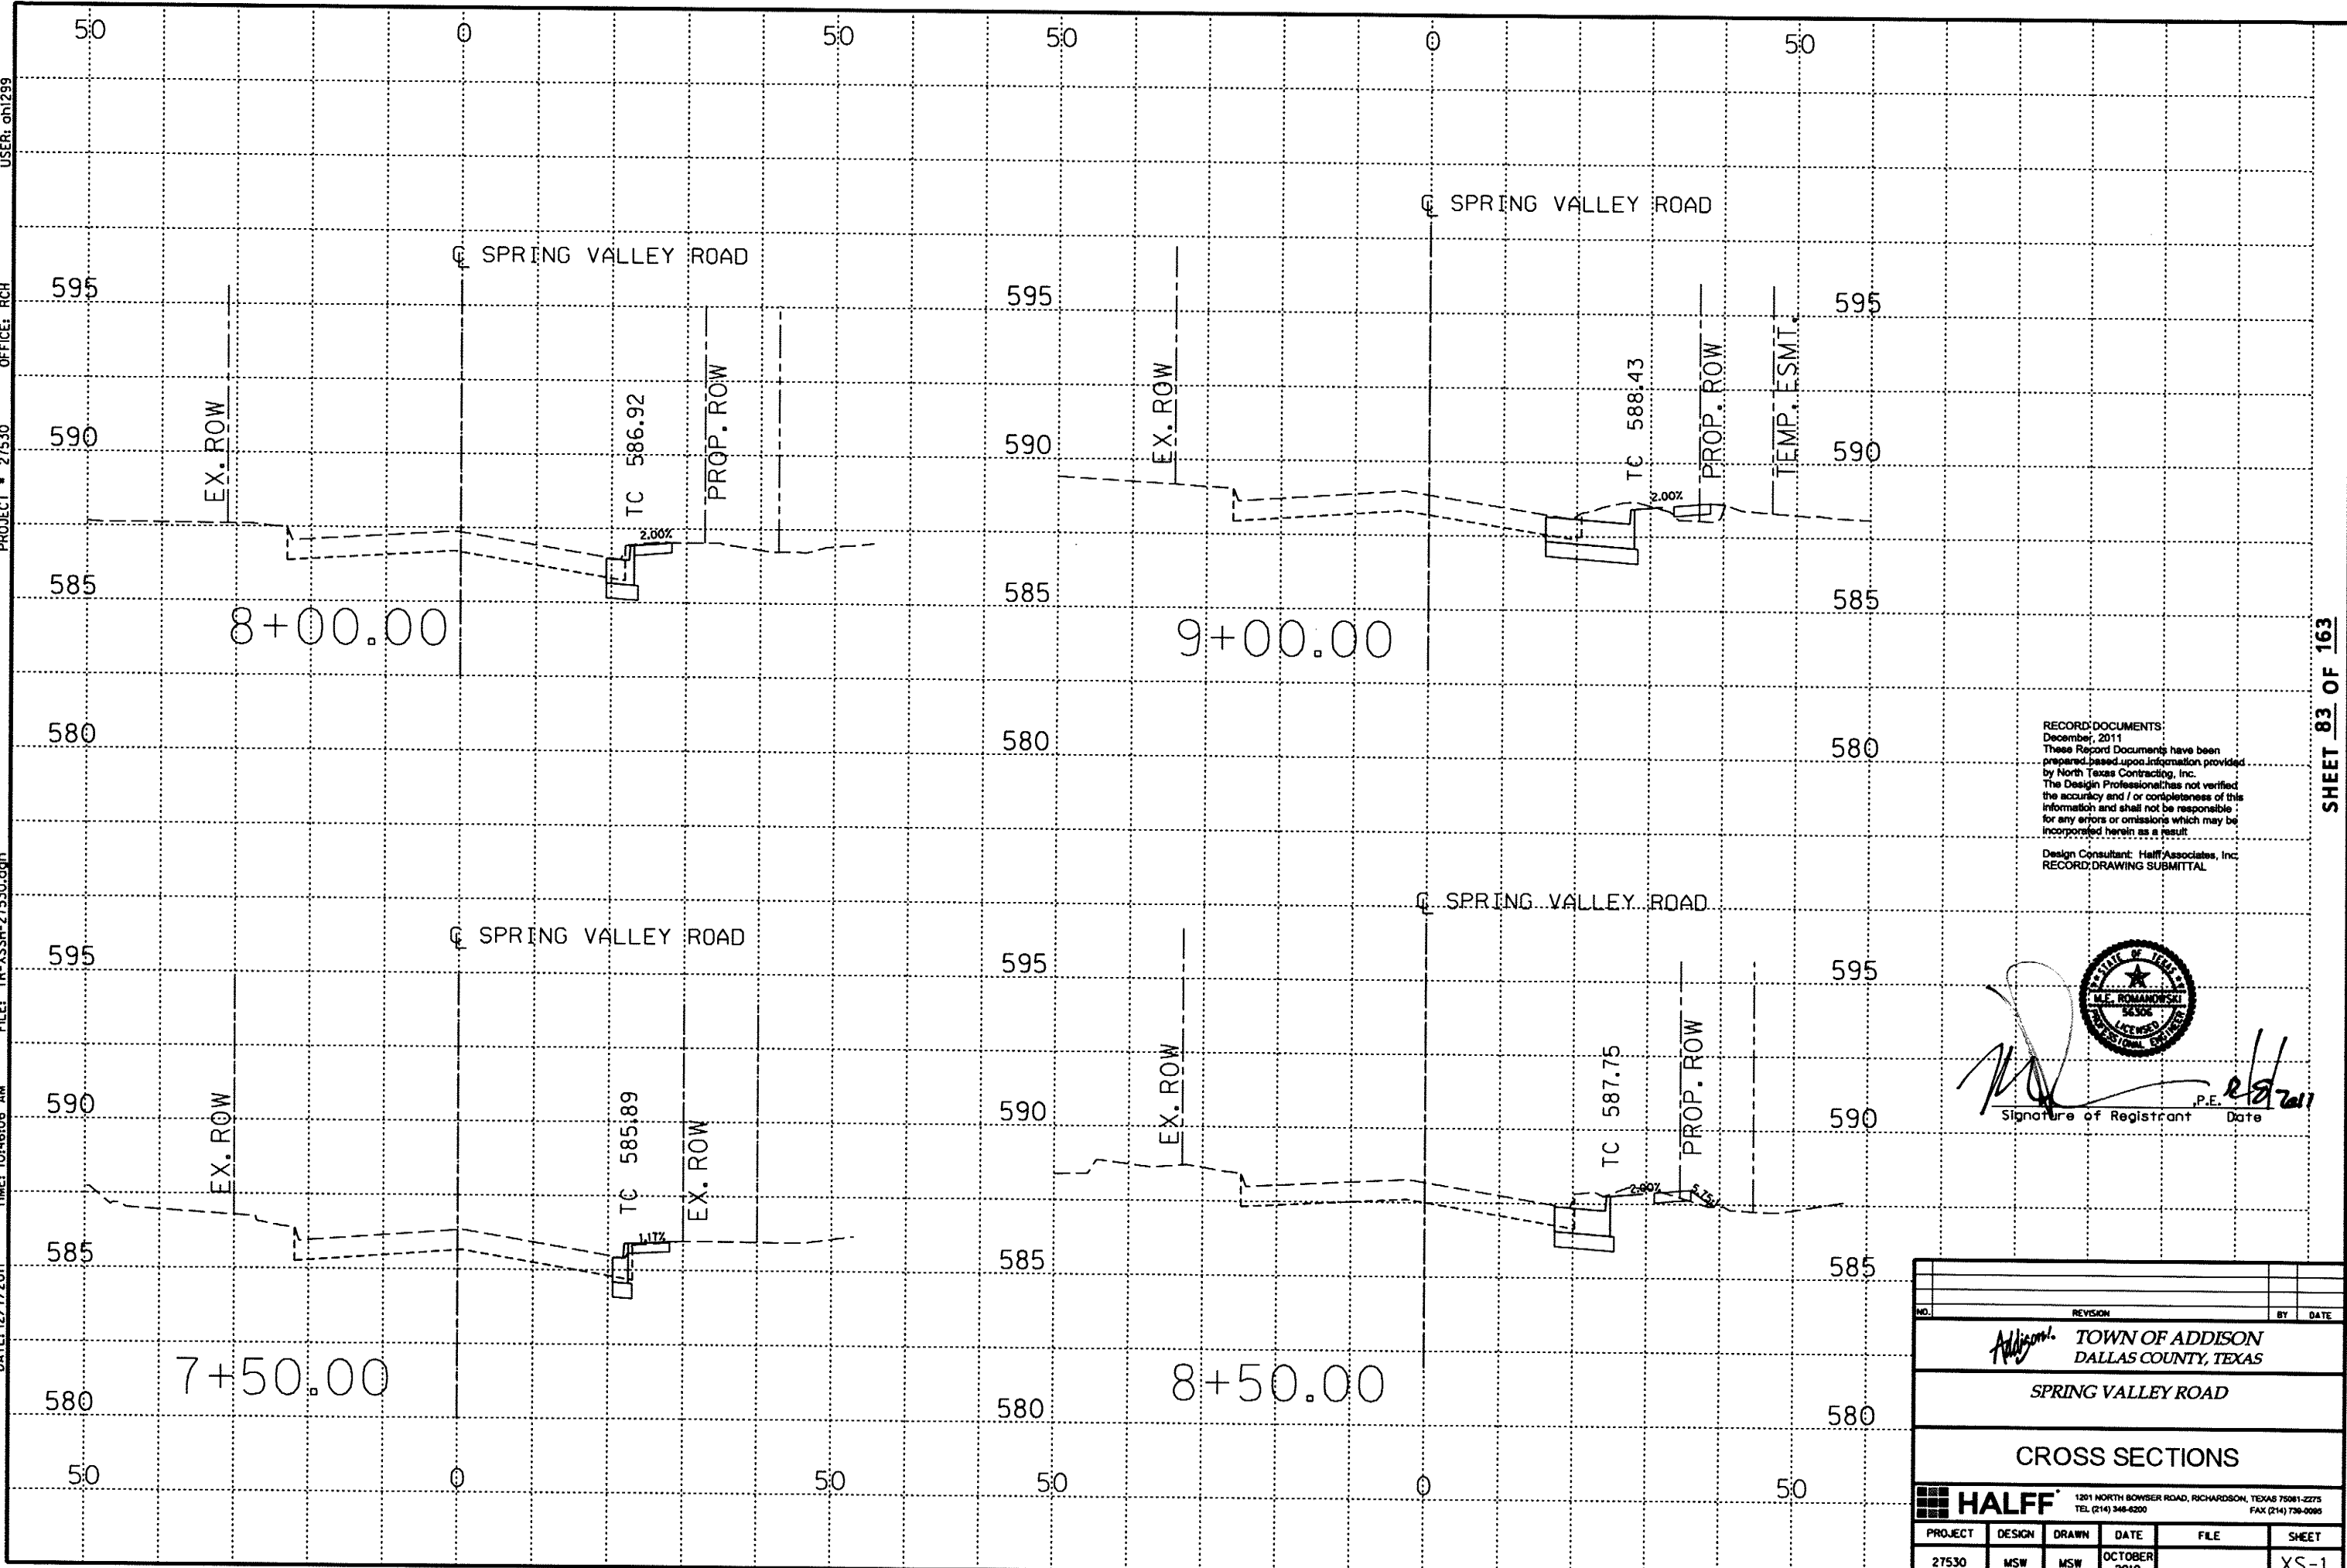

RECORD DOCUMENTS:
 December, 2011
 These Record Documents have been prepared based upon information provided by North Texas Contracting, Inc. The Design Professional has not verified the accuracy and / or completeness of this information and shall not be responsible for any errors or omissions which may be incorporated herein as a result.
 Design Consultant: Half Associates, Inc.
 RECORD DRAWING SUBMITTAL



 Signature of Registrant: *[Signature]* P.E. Date: *12/7/2011*

NO.	REVISION	BY	DATE
<i>Addison</i> TOWN OF ADDISON DALLAS COUNTY, TEXAS			
SPRING VALLEY ROAD			
CROSS SECTIONS			
HALFF 1201 NORTH BOWSER ROAD, RICHARDSON, TEXAS 75081-2275 TEL (214) 348-6200 FAX (214) 720-0095			
PROJECT	DESIGN	DRAWN	DATE
27530	MSW	MSW	OCTOBER 2010
			SHEET
			XS-1


SHEET 83 OF 163


RECORD DRAWINGS

DATE: 12/7/2011 TIME: 10:46:14 AM FILE: TR-XSSH-27530.dgn PROJECT: 27530 OFFICE: RCH USER: gh1299

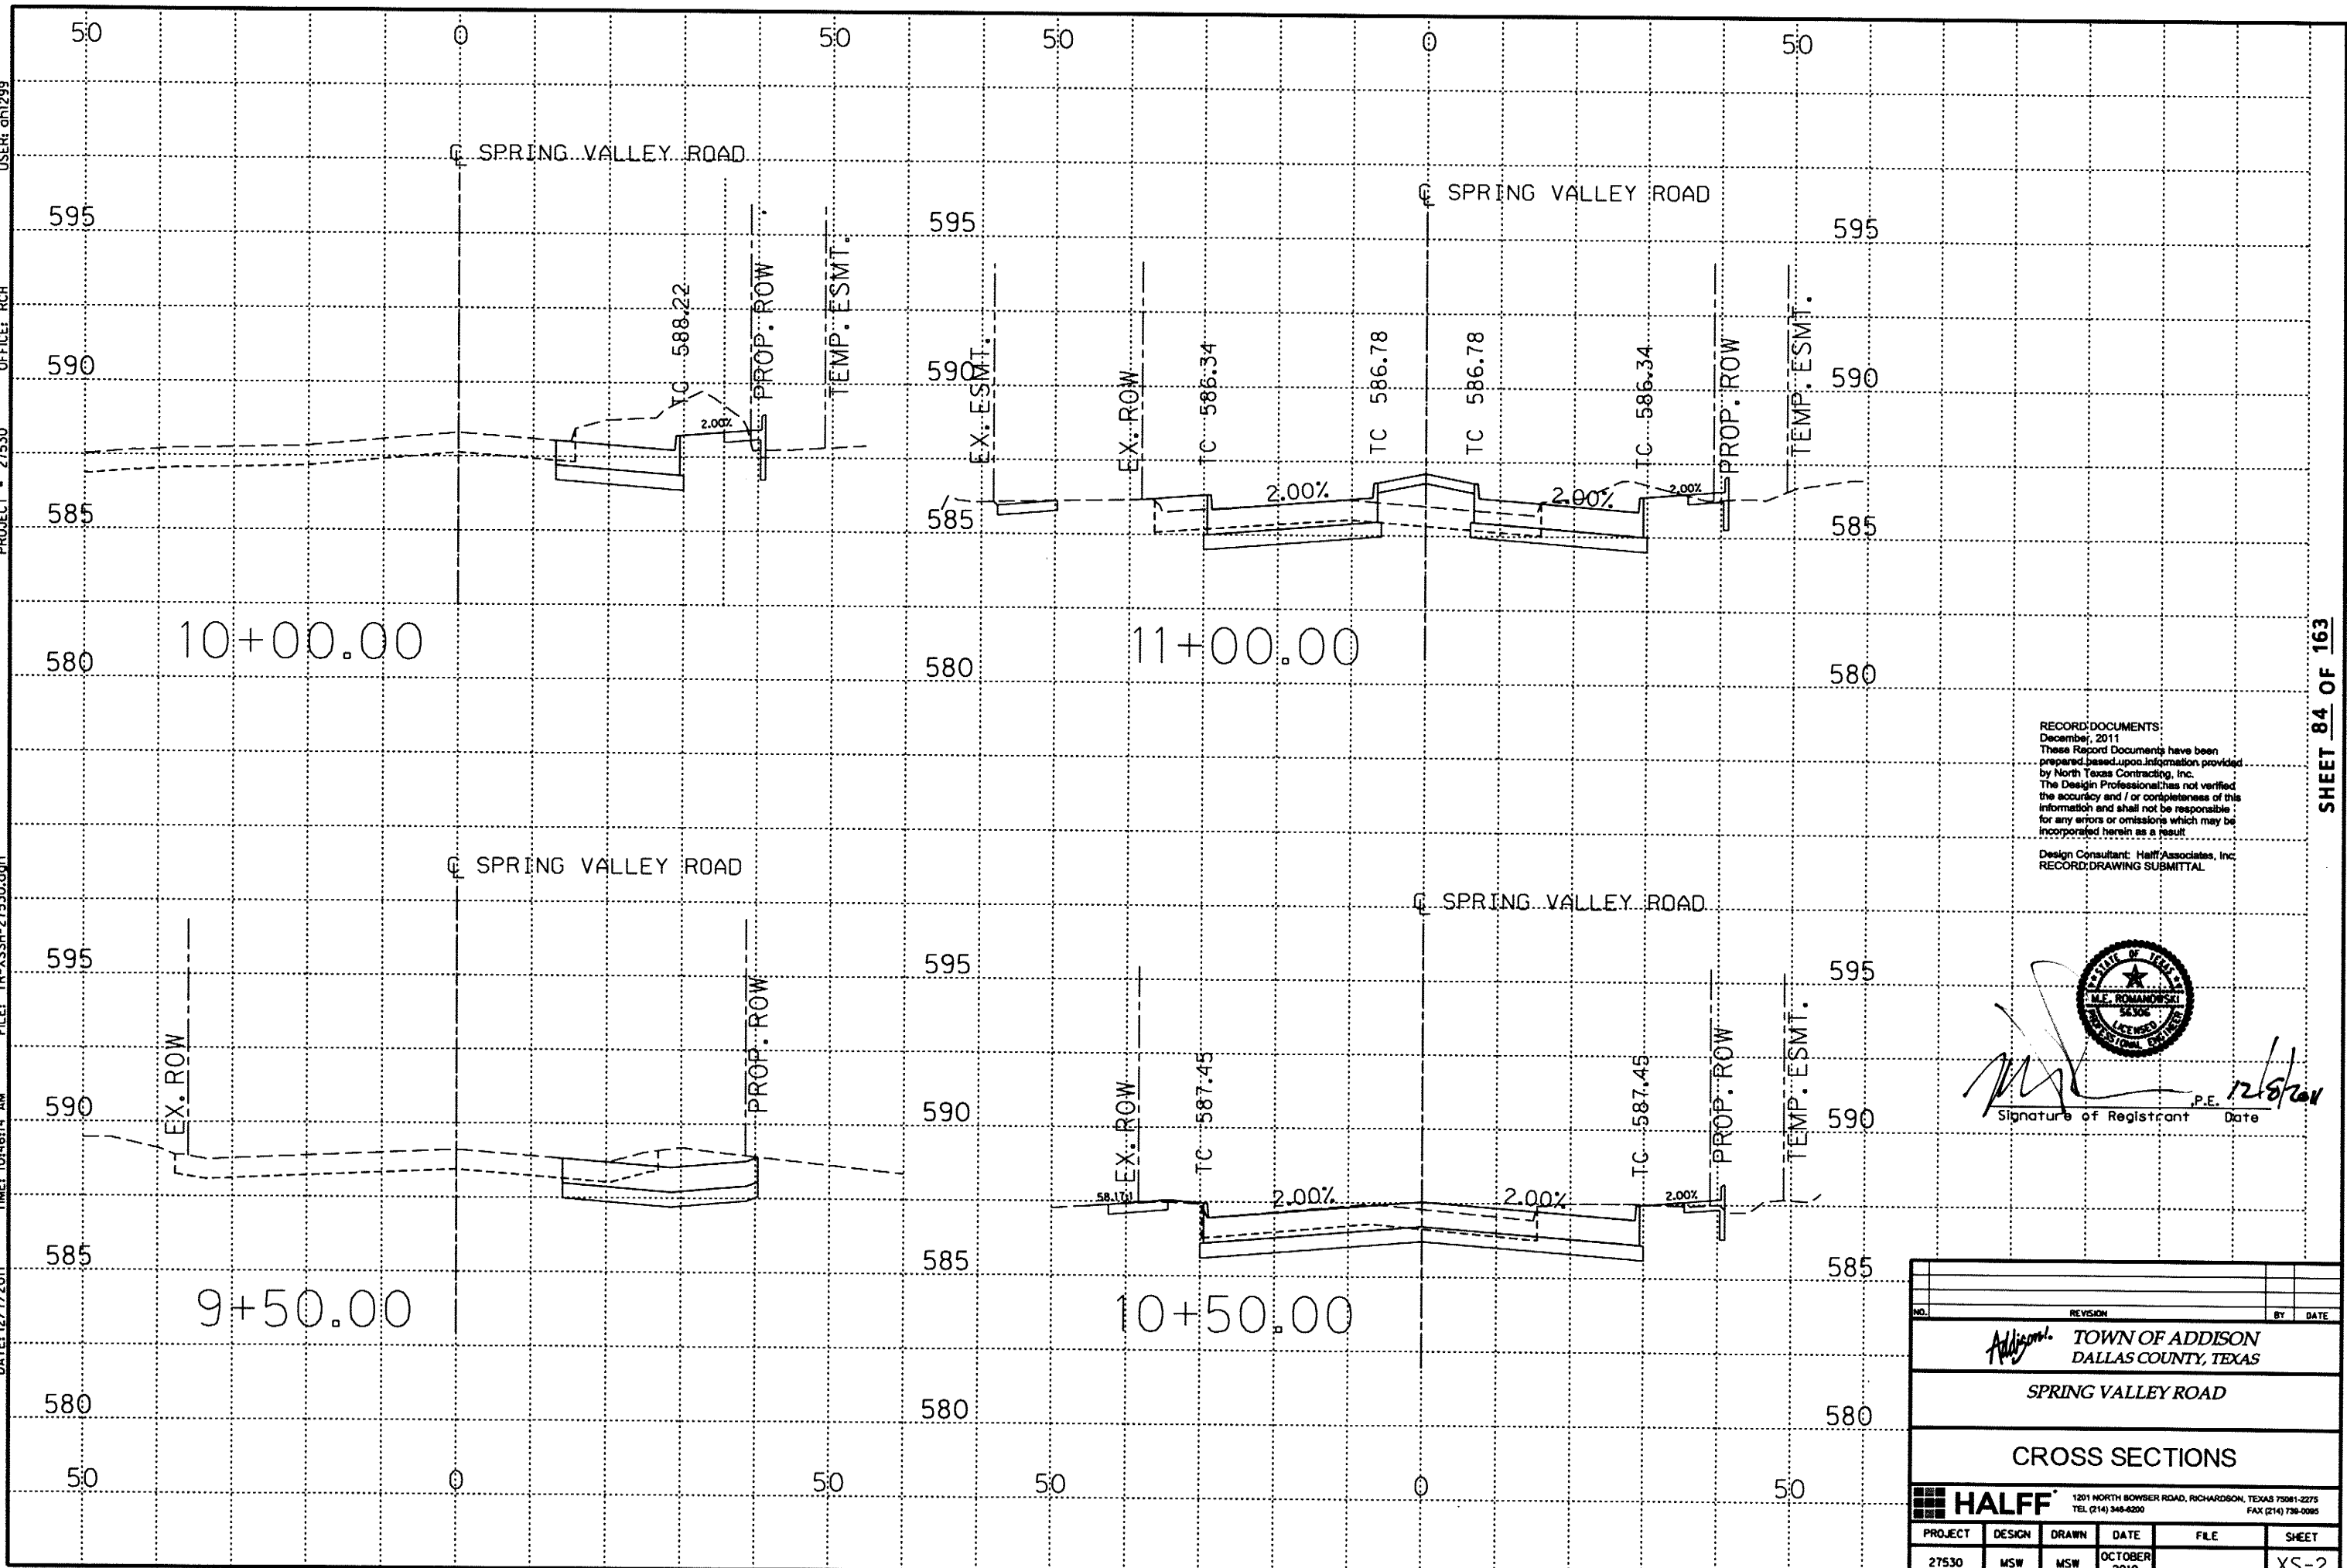


RECORD DOCUMENTS:
 December, 2011
 These Record Documents have been prepared based upon information provided by North Texas Contracting, Inc. The Design Professional has not verified the accuracy and / or completeness of this information and shall not be responsible for any errors or omissions which may be incorporated herein as a result.
 Design Consultant: Half Associates, Inc.
 RECORD DRAWING SUBMITTAL


 Signature of Registrant: *M.E. Romaniuk* P.E. Date: 12/8/2011

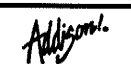
NO.	REVISION	BY	DATE
 TOWN OF ADDISON DALLAS COUNTY, TEXAS SPRING VALLEY ROAD CROSS SECTIONS HALFF 1201 NORTH BOWSER ROAD, RICHARDSON, TEXAS 75081-2275 TEL (214) 348-4200 FAX (214) 738-0285			
PROJECT	DESIGN	DRAWN	DATE
27530	MSW	MSW	OCTOBER 2010
FILE	SHEET		
	XS-2		



SHEET 84 OF 163 RECORD DRAWINGS

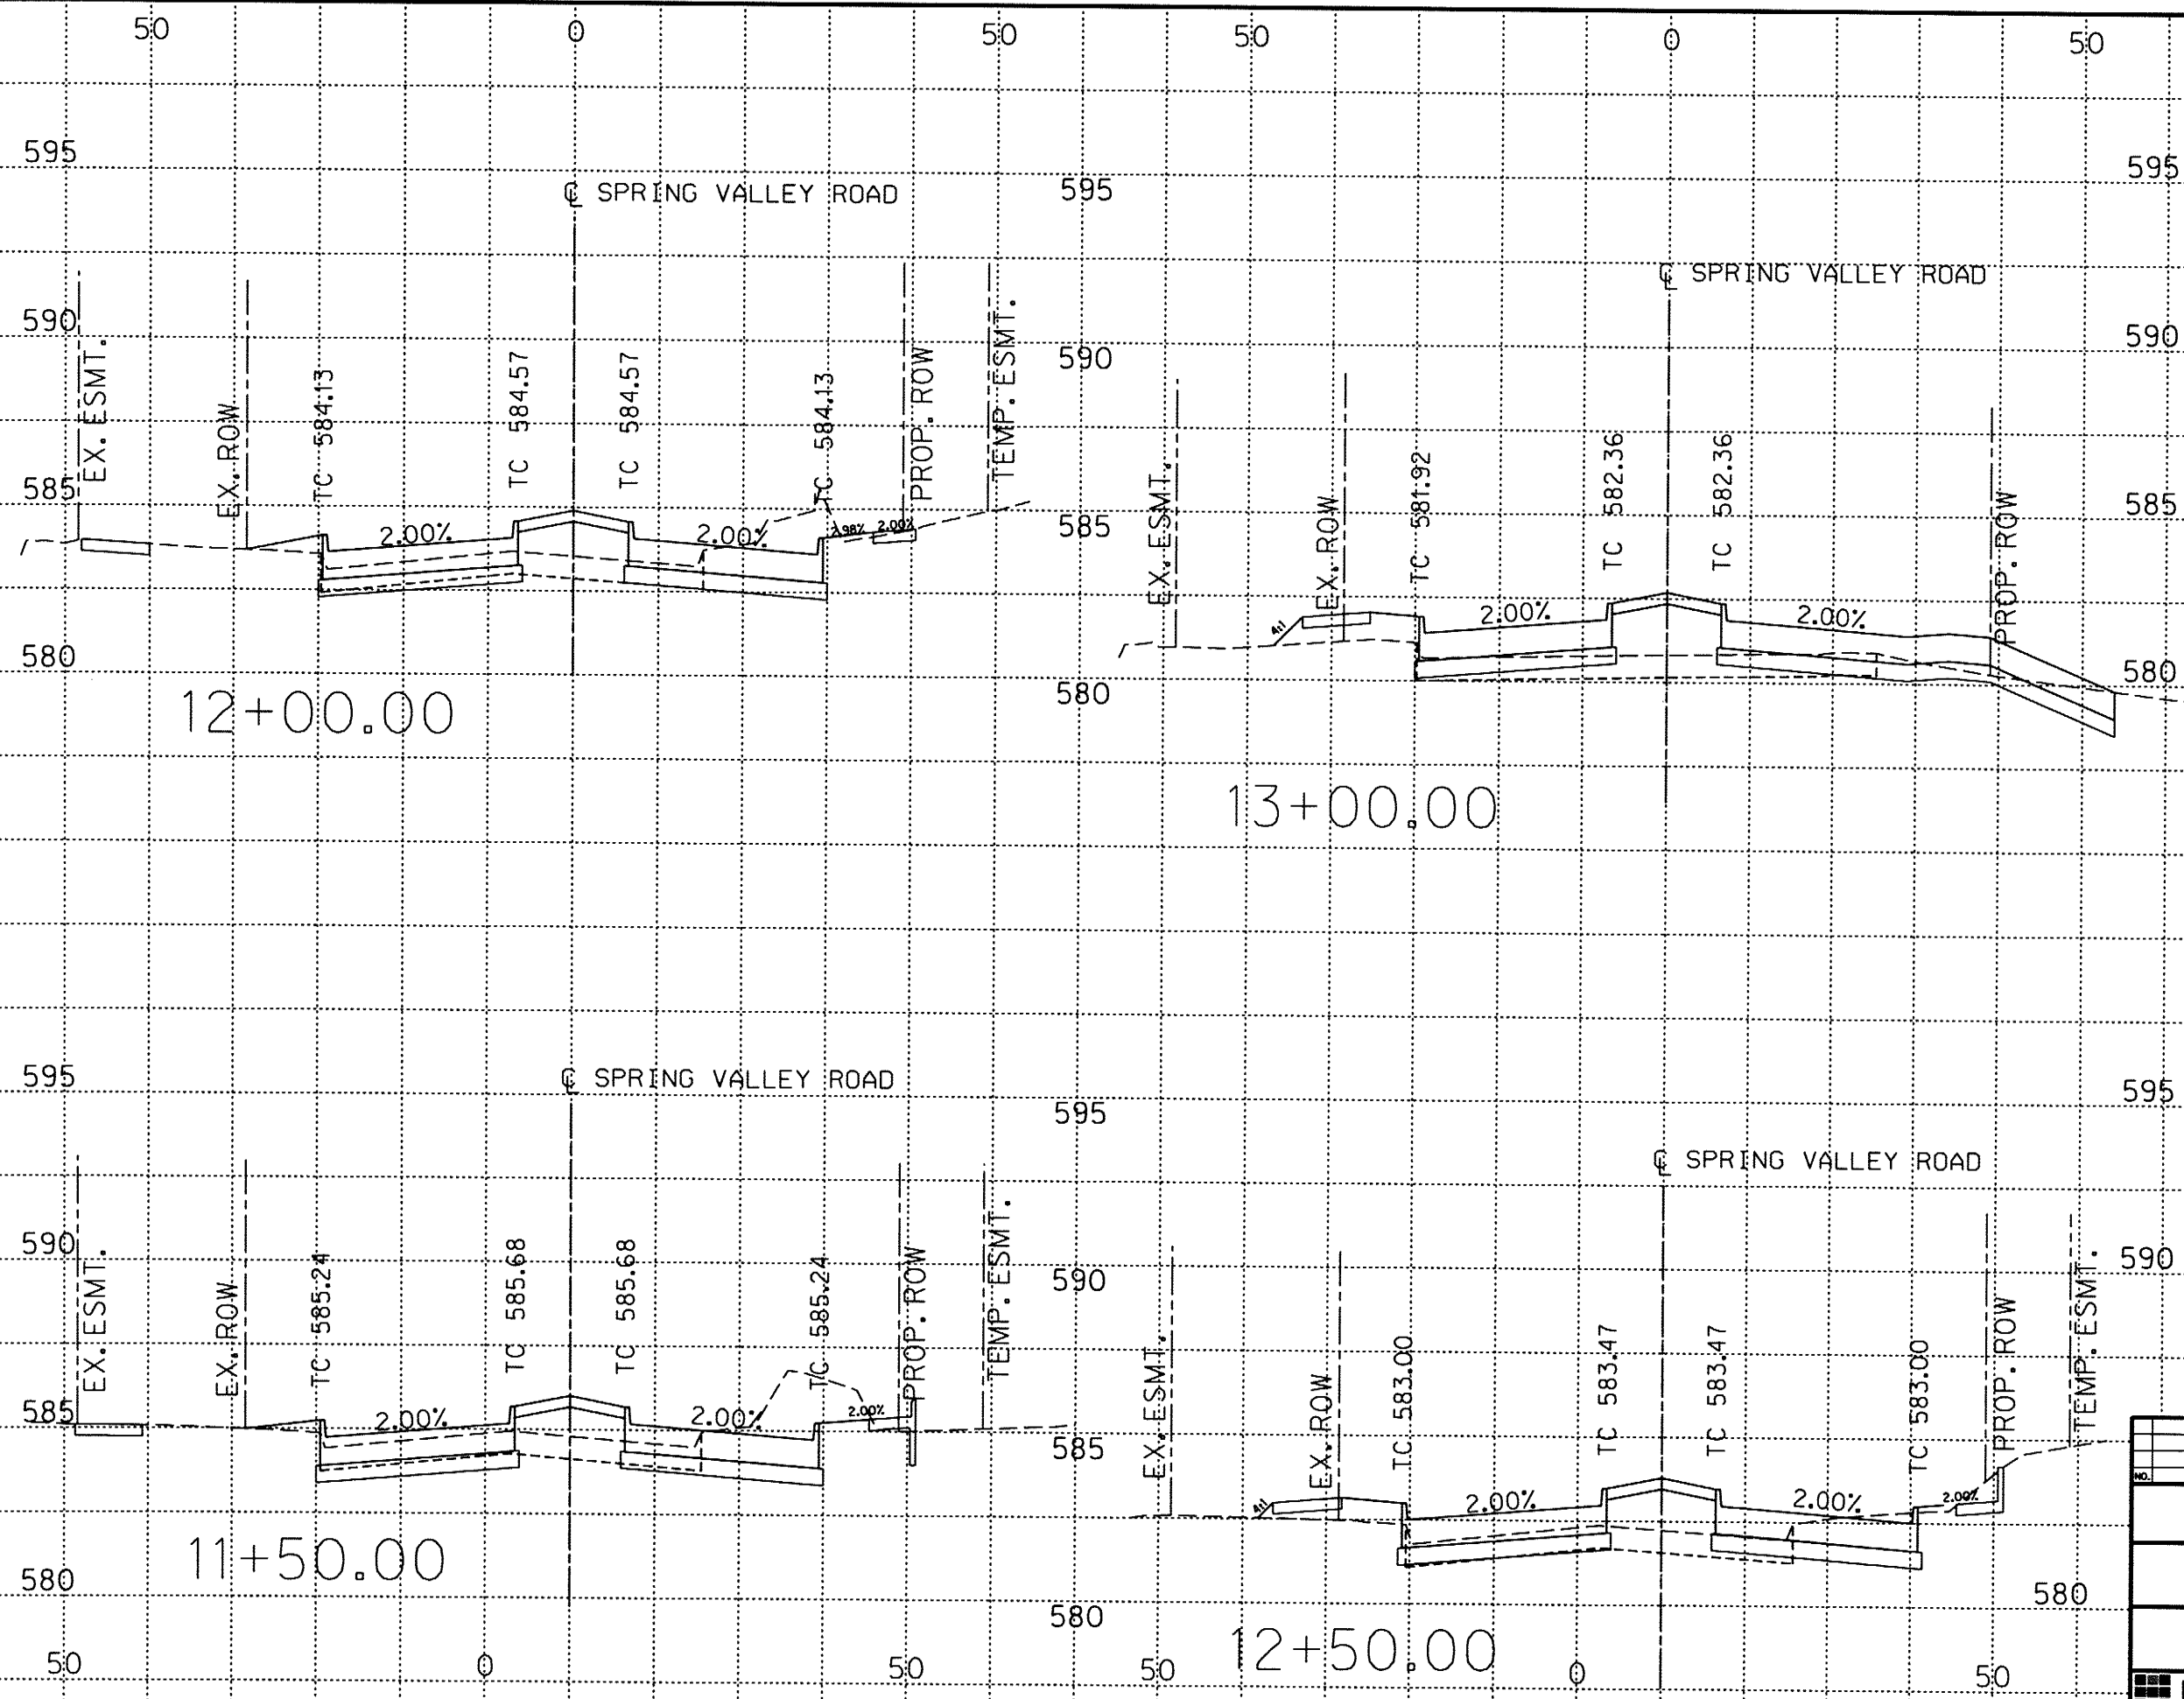DATE: 12/7/2011 TIME: 10:46:23 AM FILE: TR-XSSH-27530.dgn PROJECT: 27530 OFFICE: RCH USER: oh1299




RECORD DOCUMENTS:
 December, 2011
 These Record Documents have been prepared based upon information provided by North Texas Contracting, Inc. The Design Professional has not verified the accuracy and / or completeness of this information and shall not be responsible for any errors or omissions which may be incorporated herein as a result.
 Design Consultant: Halff Associates, Inc.
 RECORD DRAWING SUBMITTAL


 Signature of Registrant: *M.F. Romanowski*
 Date: 12/6/2011

NO.	REVISION	BY	DATE		
 TOWN OF ADDISON DALLAS COUNTY, TEXAS					
SPRING VALLEY ROAD					
CROSS SECTIONS					
 1201 NORTH BOWSER ROAD, RICHARDSON, TEXAS 75081-3275 TEL. (214) 348-4200 FAX (214) 738-0995					
PROJECT	DESIGN	DRAWN	DATE	FILE	SHEET
27530	MSW	MSW	OCTOBER 2010		XS-3

SHEET 85 OF 163 RECORD DRAWINGS

DATE: 12/7/2011 TIME: 10:46:30 AM FILE: TR-XSSH-27530.dgn PROJECT: 27530 OFFICE: RCH USER: dh1299

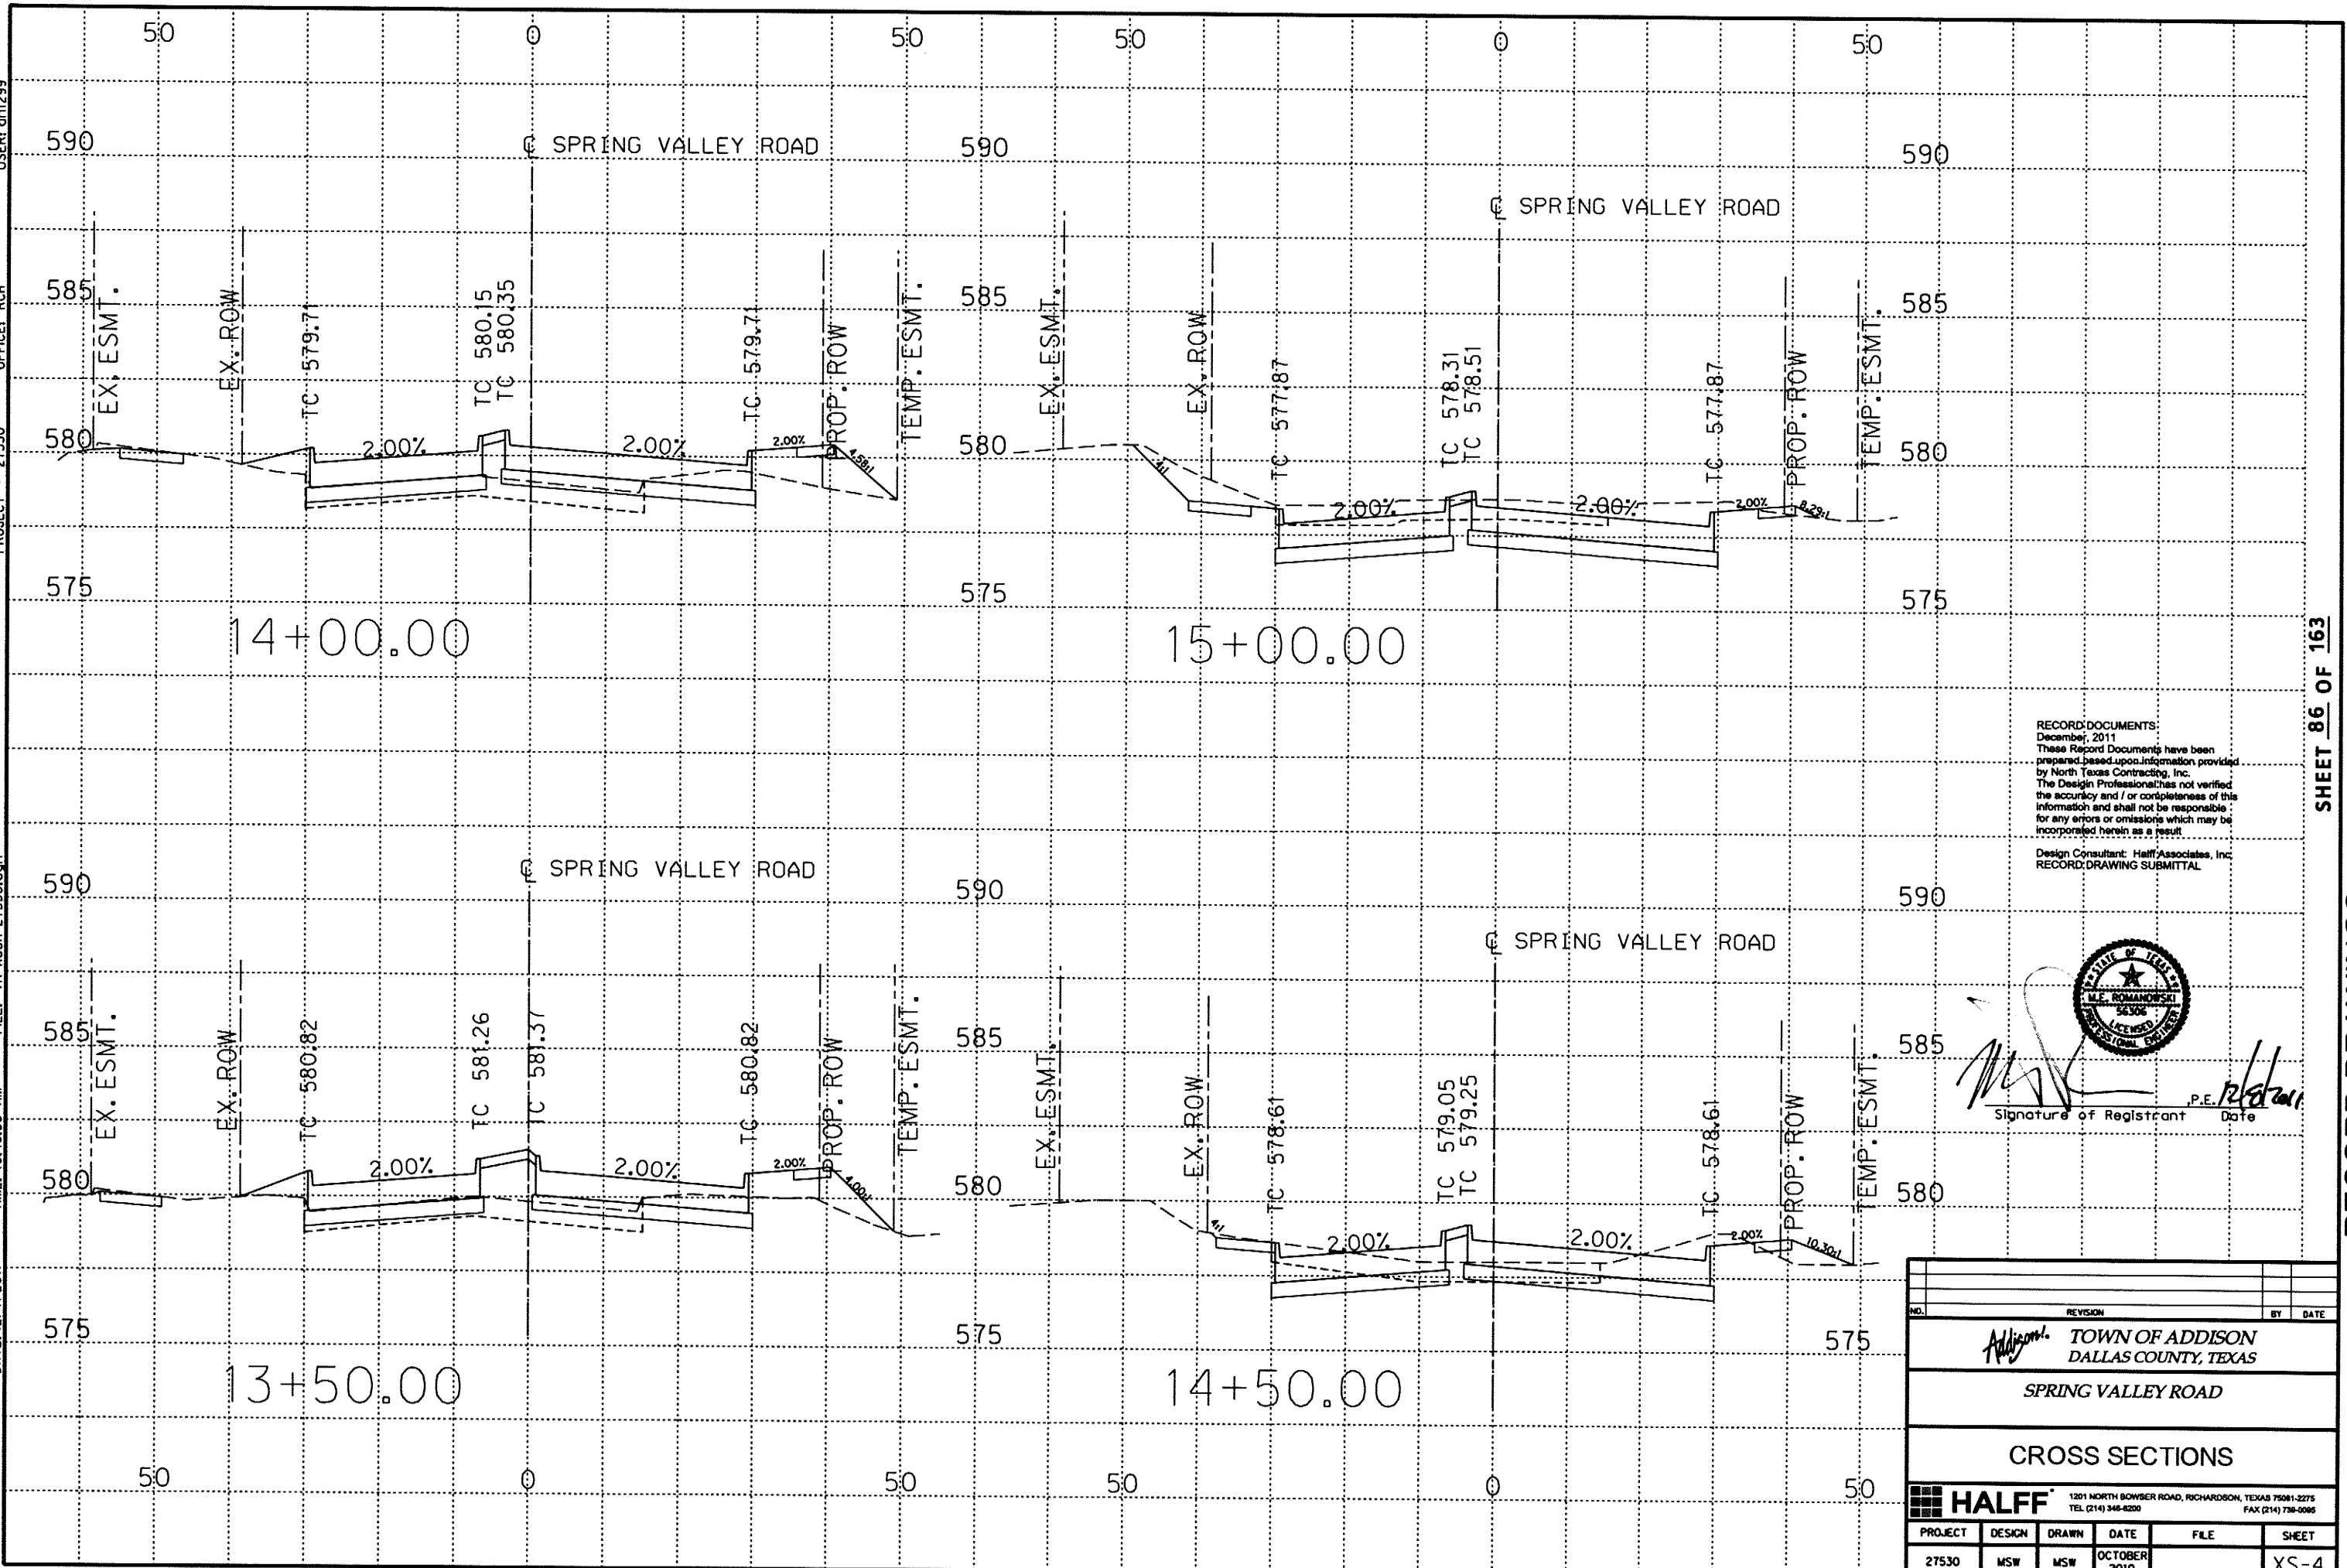

RECORD DOCUMENTS:
 December, 2011
 These Record Documents have been prepared based upon information provided by North Texas Contracting, Inc. The Design Professional has not verified the accuracy and / or completeness of this information and shall not be responsible for any errors or omissions which may be incorporated herein as a result.
 Design Consultant: Halff Associates, Inc.
 RECORD: DRAWING SUBMITTAL




[Signature]
 Signature of Registrant
 12/27/2011
 Date

NO.	REVISION	BY	DATE
ADDISON TOWN OF ADDISON DALLAS COUNTY, TEXAS SPRING VALLEY ROAD CROSS SECTIONS			
HALFF 1201 NORTH BOWSER ROAD, RICHARDSON, TEXAS 75081-2275 TEL (214) 346-8200 FAX (214) 738-0066			
PROJECT	DESIGN	DRAWN	DATE
27530	MSW	MSW	OCTOBER 2010
			SHEET
			XS-4

SHEET 86 OF 163 RECORD DRAWINGS

DATE: 12/7/2011 TIME: 10:46:40 AM FILE: TR-XSSH-27530.dwg PROJECT: 27530 OFFICE: RCH USER: chl299

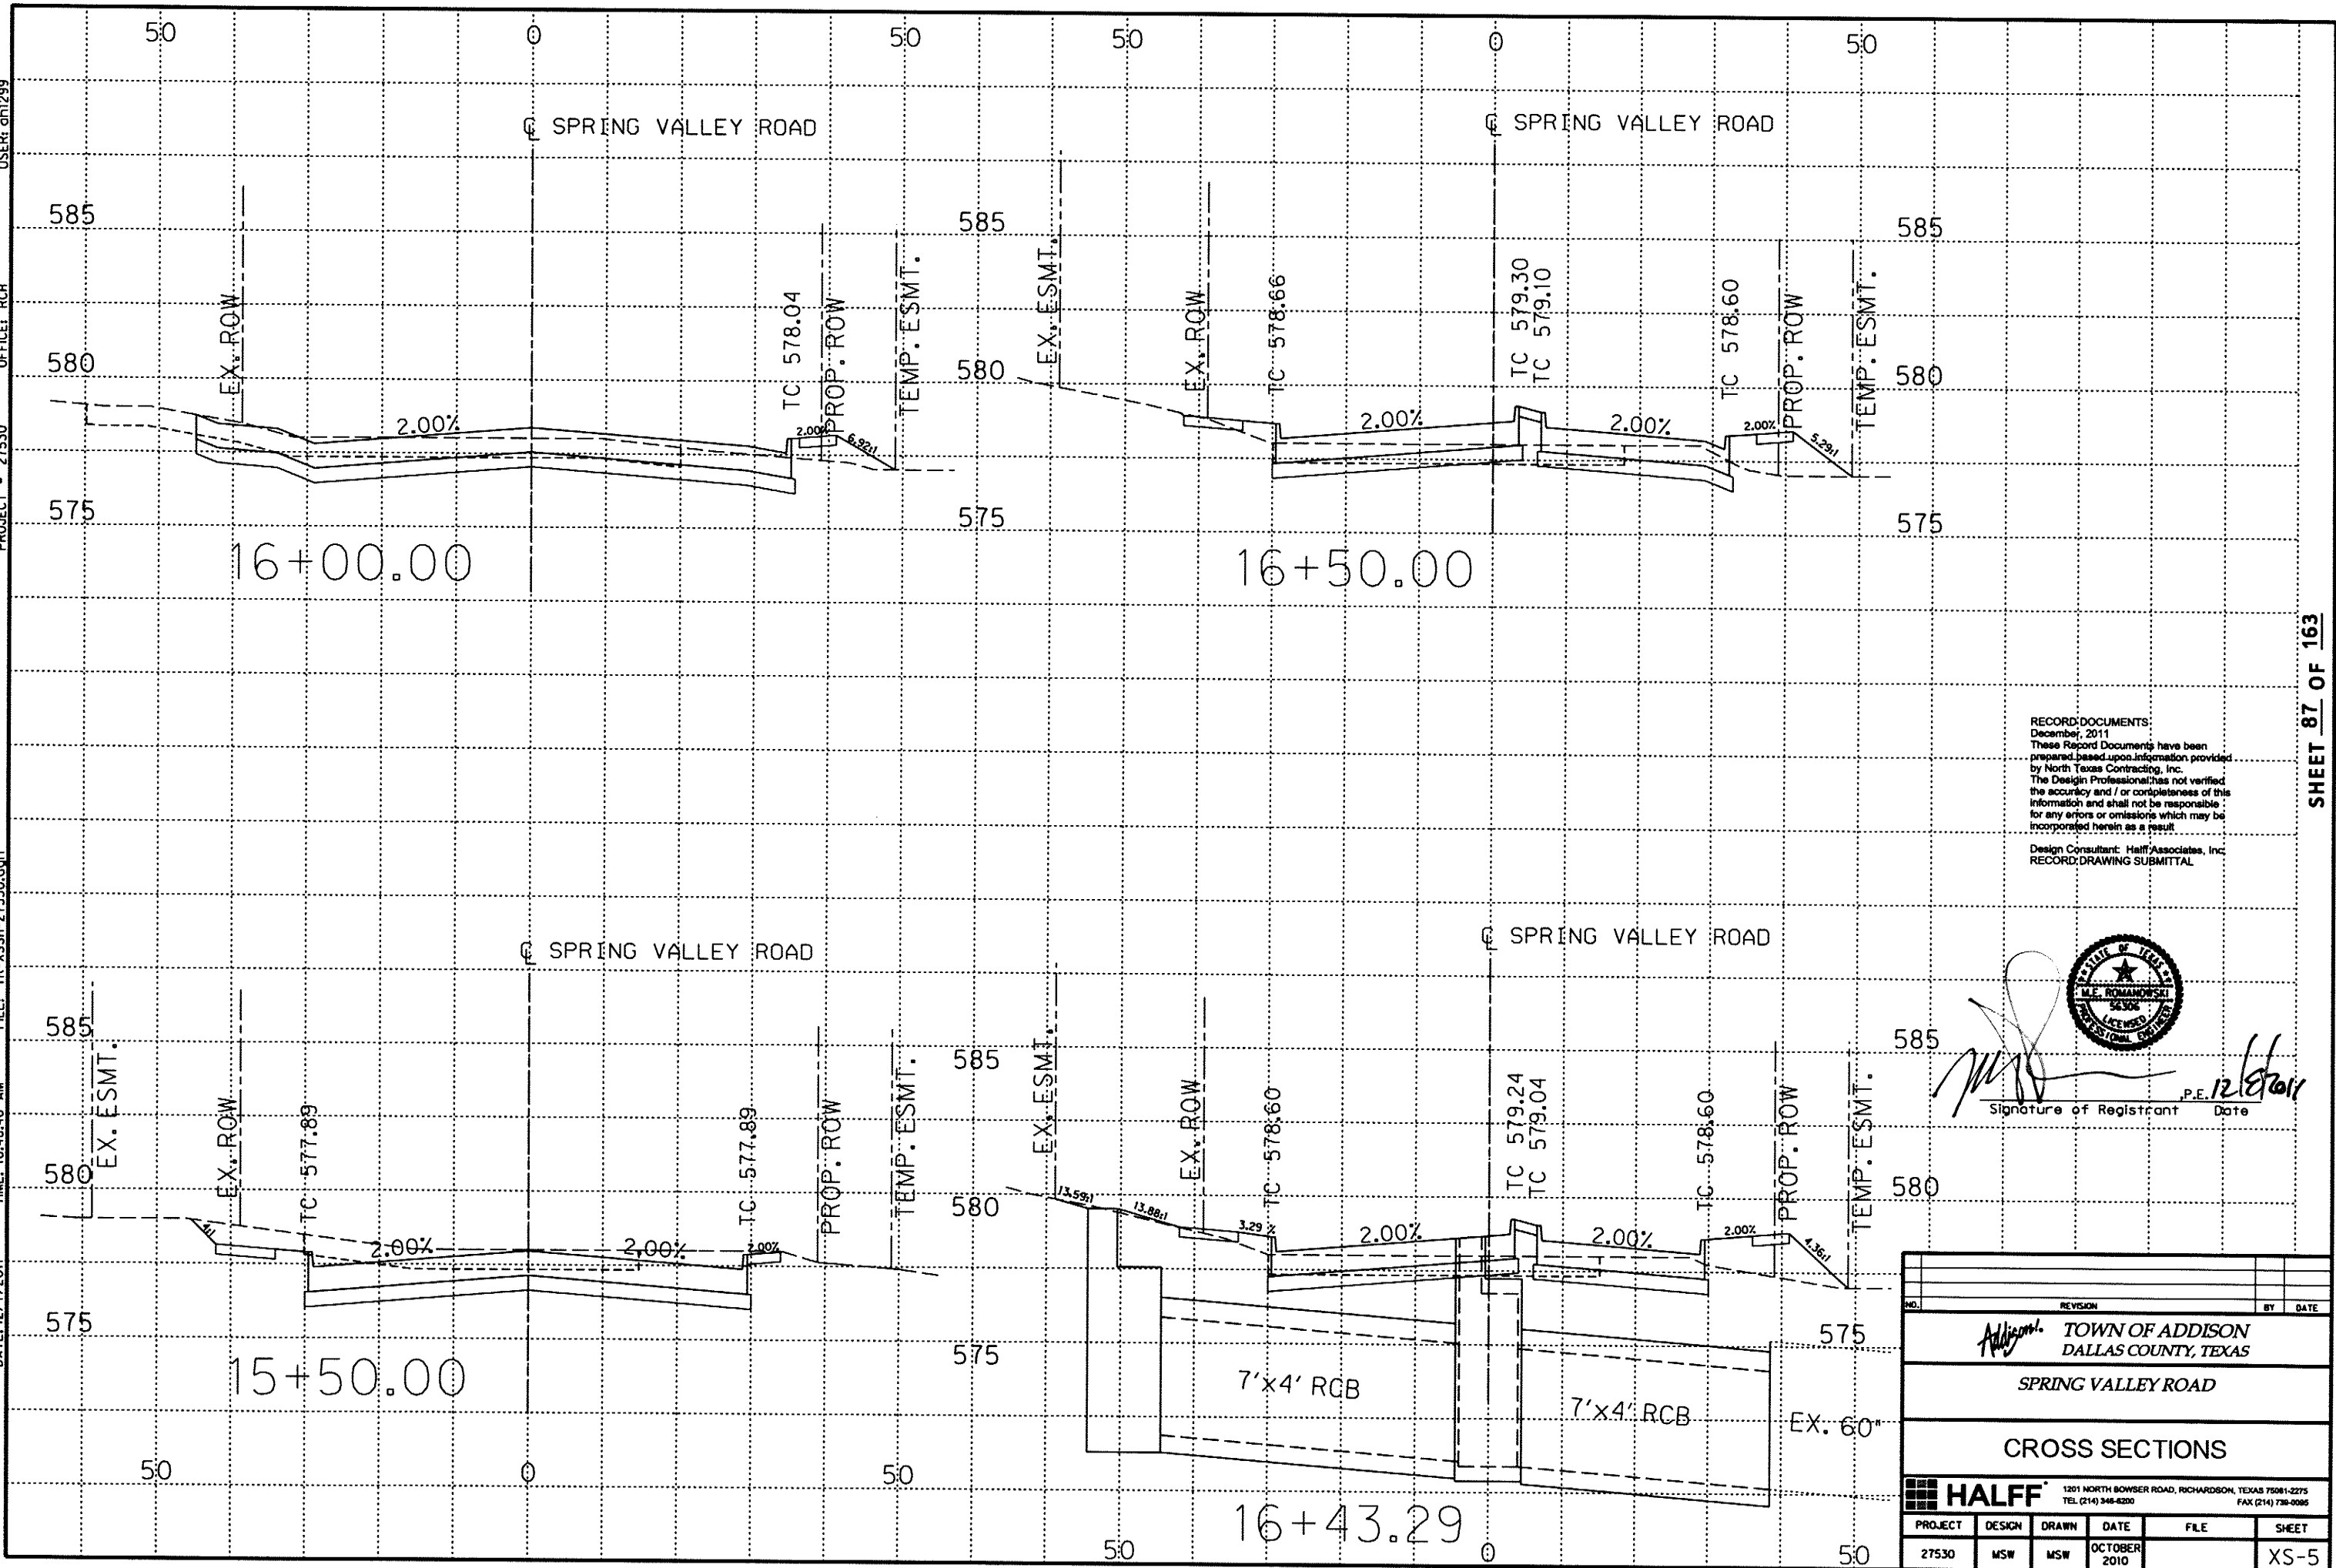

RECORD DOCUMENTS:
 December, 2011
 These Record Documents have been prepared based upon information provided by North Texas Contracting, Inc. The Design Professional has not verified the accuracy and / or completeness of this information and shall not be responsible for any errors or omissions which may be incorporated herein as a result.
 Design Consultant: Half Associates, Inc.
 RECORD DRAWING SUBMITTAL




[Signature]
 Signature of Registrant
 12/16/2011
 Date


NO.	REVISION	BY	DATE
Addisom TOWN OF ADDISON DALLAS COUNTY, TEXAS SPRING VALLEY ROAD CROSS SECTIONS			
HALFF 1201 NORTH BOWSER ROAD, RICHARDSON, TEXAS 75081-2275 TEL (214) 346-4200 FAX (214) 730-0085			
PROJECT	DESIGN	DRAWN	DATE
27530	MSW	MSW	OCTOBER 2010
			SHEET
			XS-5

SHEET 87 OF 163 RECORD DRAWINGS

DATE: 12/7/2011 TIME: 10:46:53 AM FILE: TR-XSSH-27530.dgn PROJECT: 27530 OFFICE: RCH USER: oh1299

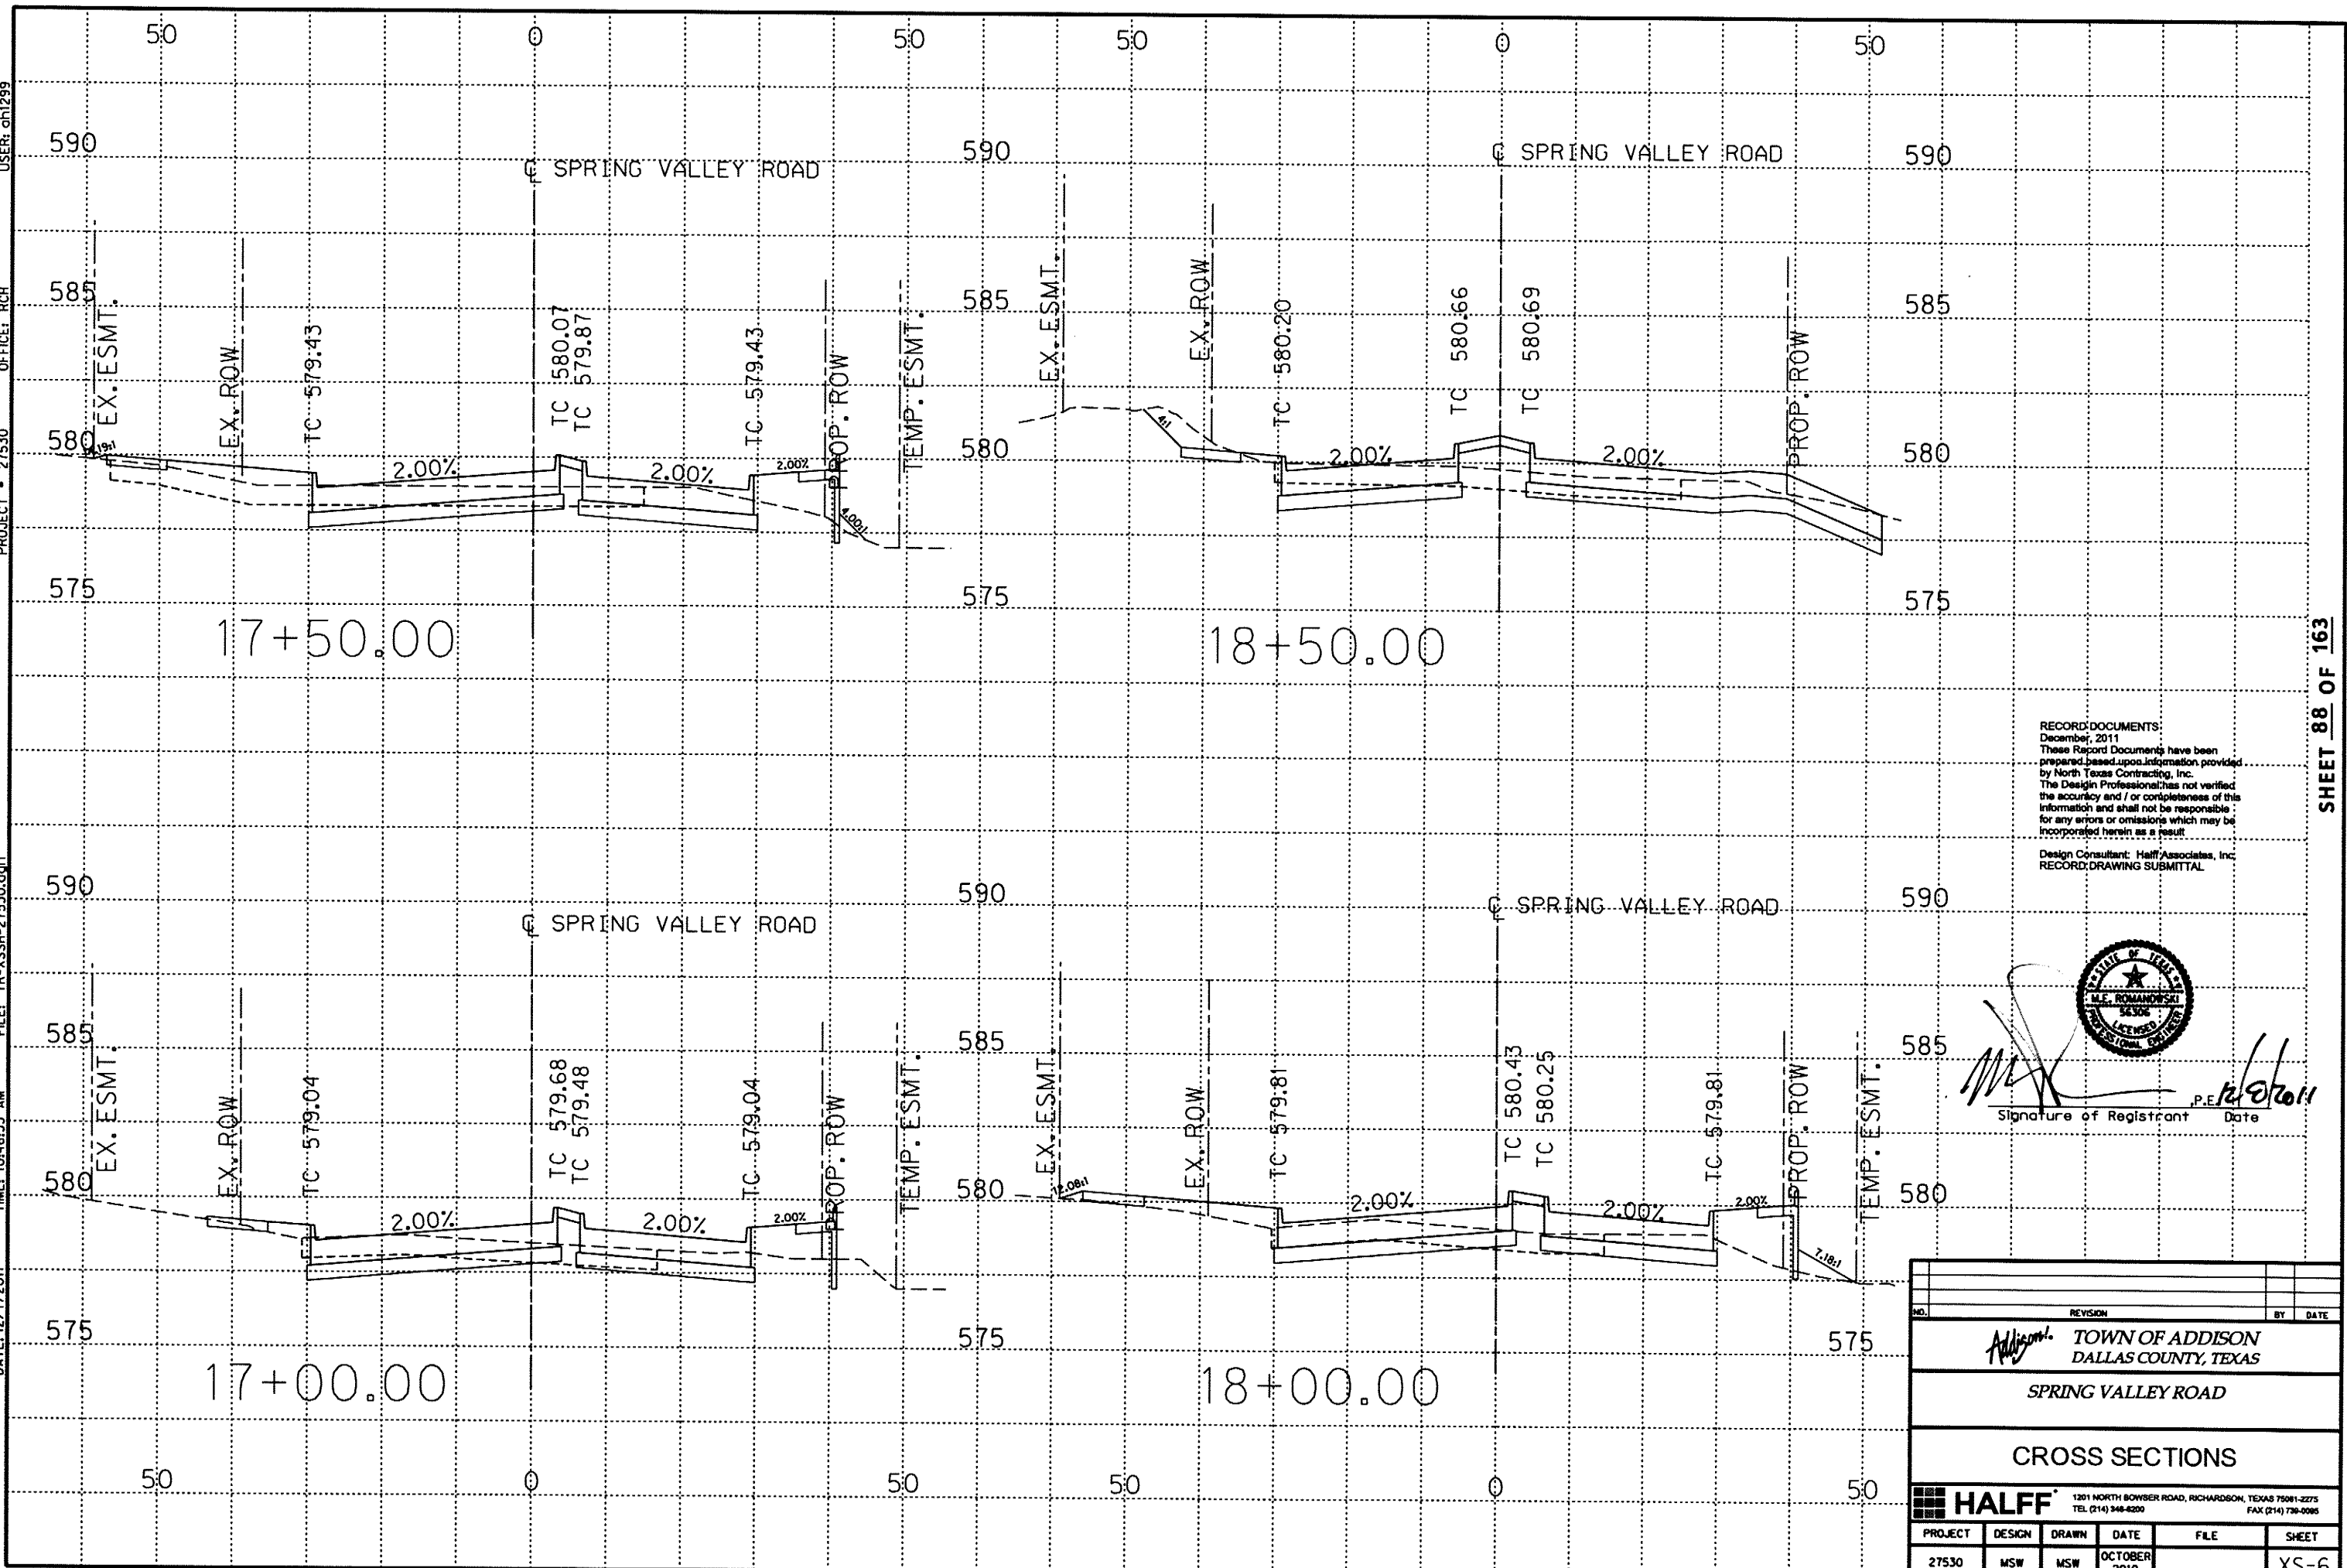


RECORD DOCUMENTS:
 December, 2011
 These Record Documents have been prepared based upon information provided by North Texas Contracting, Inc. The Design Professional has not verified the accuracy and / or completeness of this information and shall not be responsible for any errors or omissions which may be incorporated herein as a result.
 Design Consultant: Half Associates, Inc.
 RECORD DRAWING SUBMITTAL


 Signature of Registrant: *[Signature]* Date: 12/7/2011


NO.	REVISION	BY	DATE
<p><i>Addison</i> TOWN OF ADDISON DALLAS COUNTY, TEXAS</p> <p>SPRING VALLEY ROAD</p> <p>CROSS SECTIONS</p>			
<p>HALFF 1201 NORTH BOWSER ROAD, RICHARDSON, TEXAS 75081-2275 TEL. (214) 348-4200 FAX (214) 730-0985</p>			
PROJECT	DESIGN	DRAWN	DATE
27530	MSW	MSW	OCTOBER 2010
			SHEET
			XS-6



SHEET 88 OF 163 RECORD DRAWINGS

DATE: 12/7/2011 TIME: 10:47:01 AM FILE: TR-XSSH-27530.dgn PROJECT: 27530 OFFICE: RCH USER: chl299

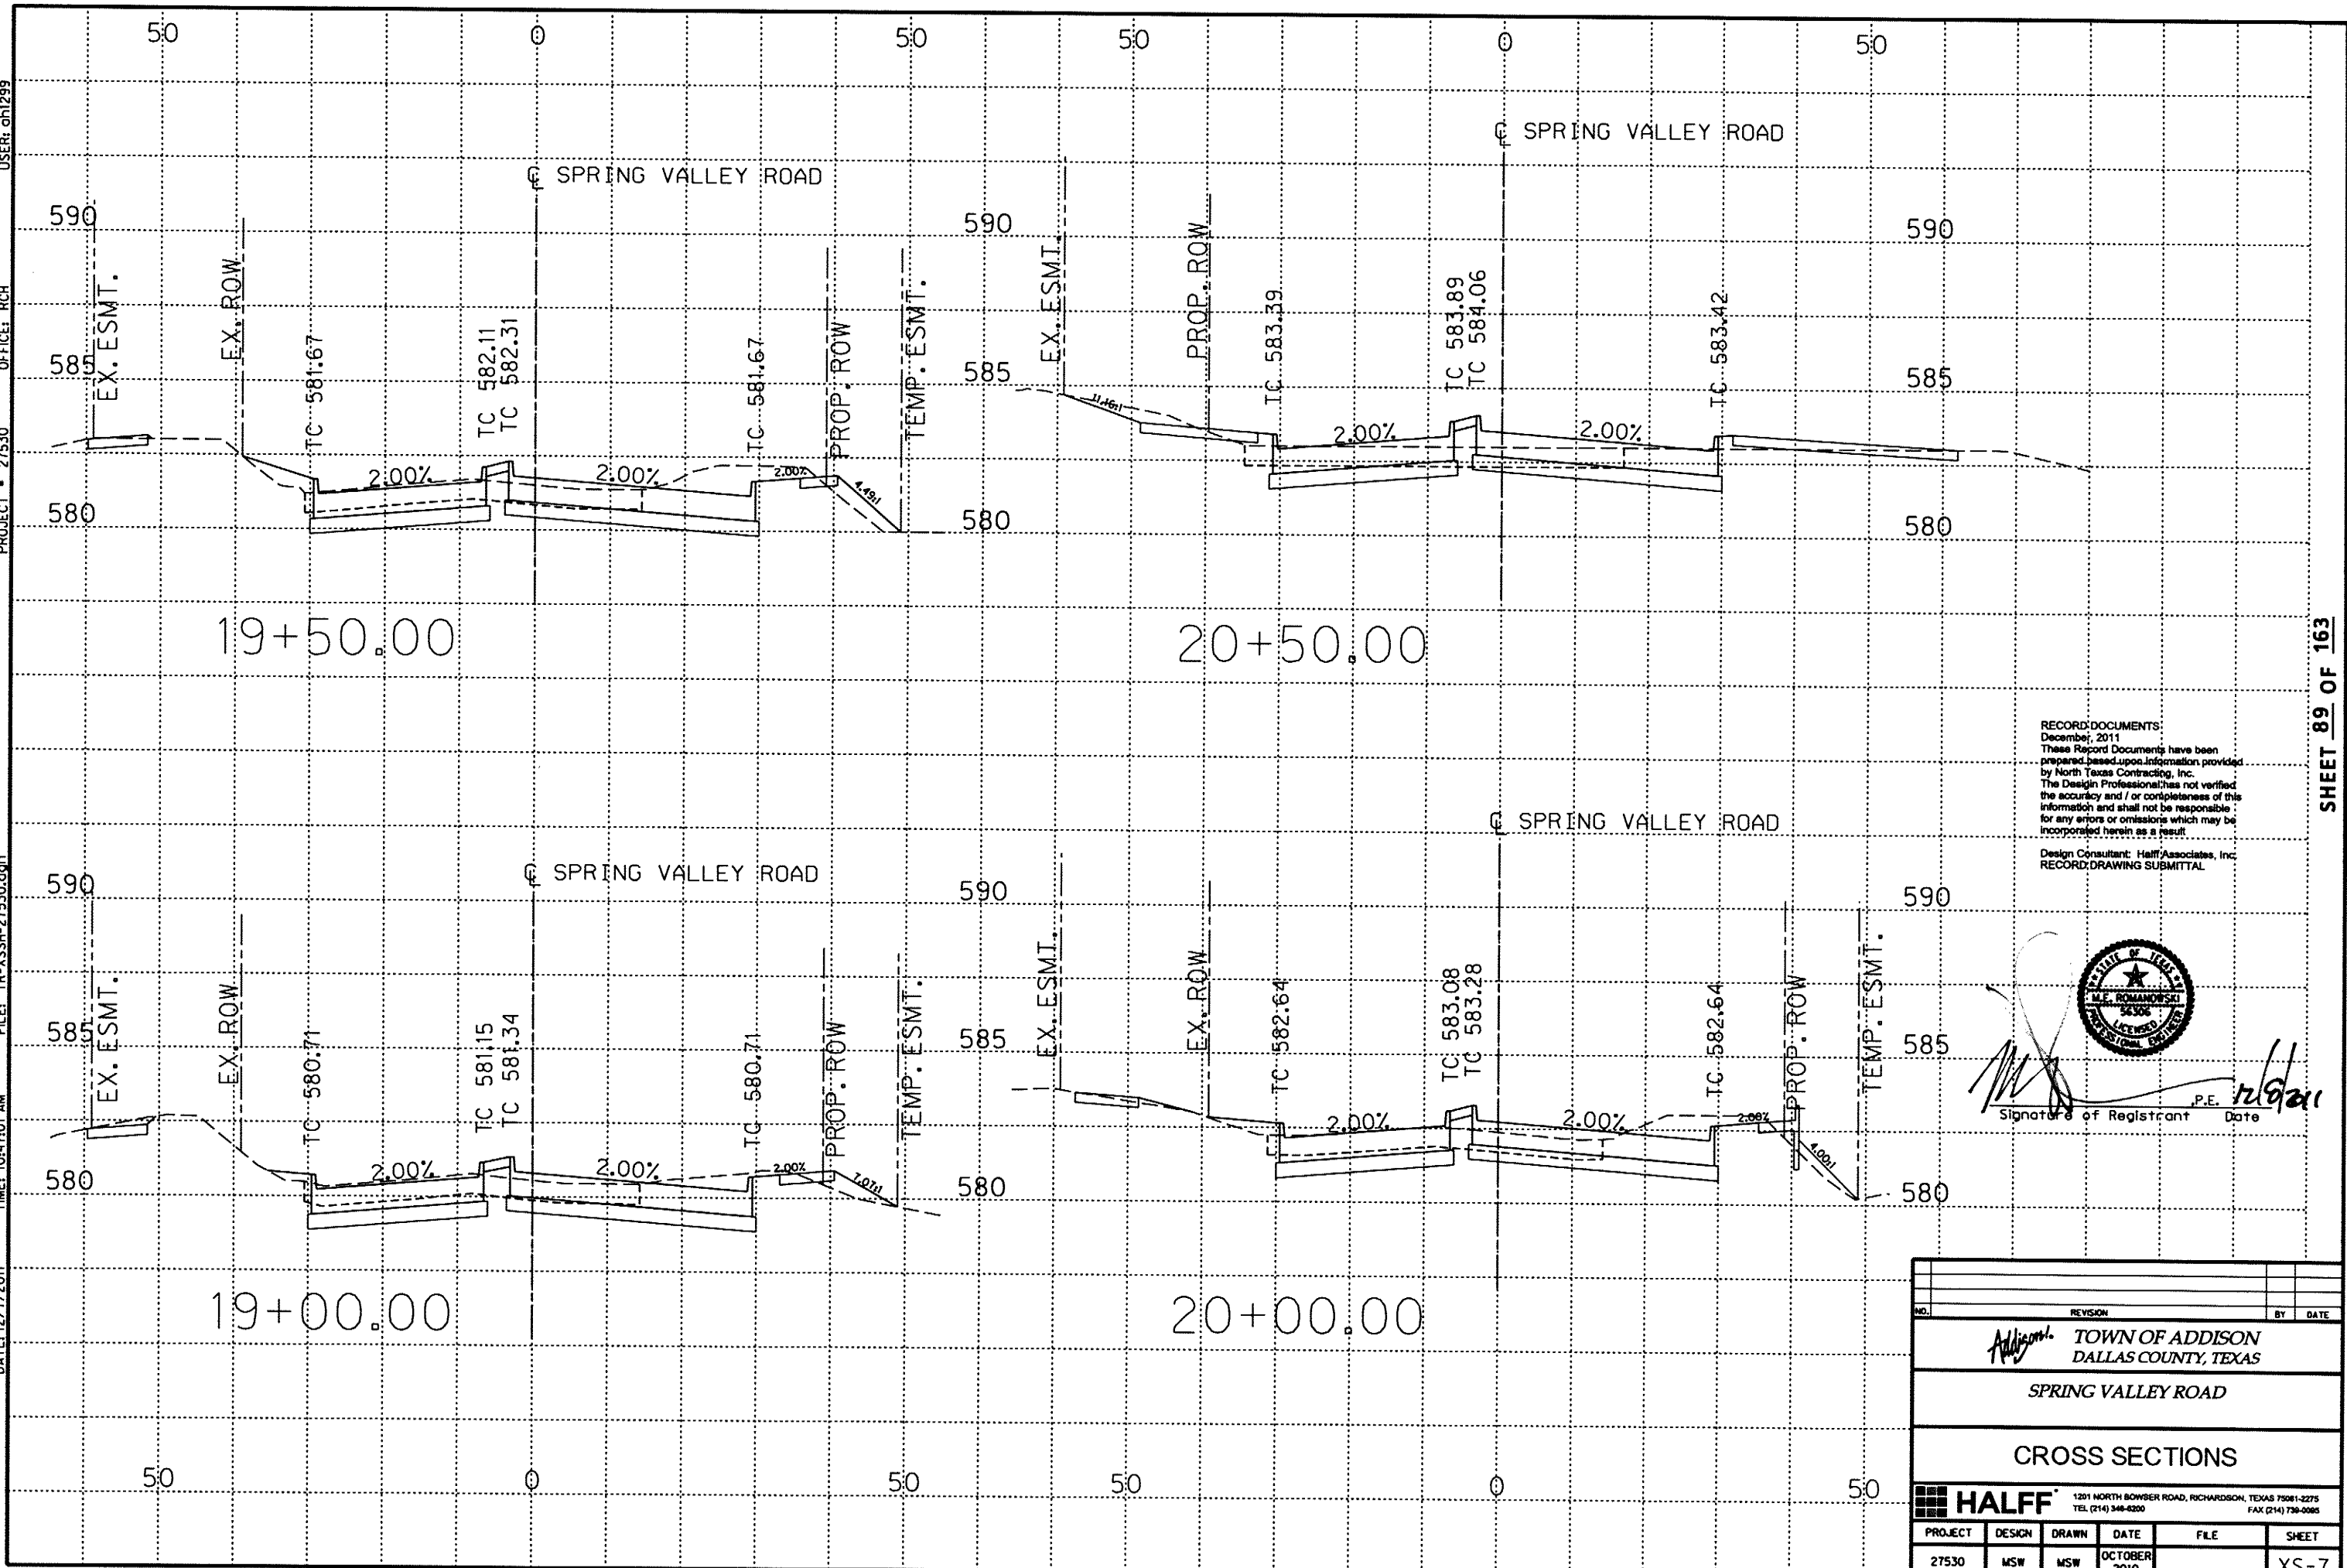

RECORD DOCUMENTS:
 December, 2011
 These Record Documents have been prepared based upon information provided by North Texas Contracting, Inc. The Design Professional has not verified the accuracy and / or completeness of this information and shall not be responsible for any errors or omissions which may be incorporated herein as a result.
 Design Consultant: Half Associates, Inc.
 RECORD DRAWING SUBMITTAL



 Signature of Registrant: *[Signature]* P.E. Date: 12/9/11

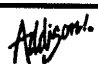NO.	REVISION	BY	DATE
 TOWN OF ADDISON DALLAS COUNTY, TEXAS SPRING VALLEY ROAD CROSS SECTIONS			
 1201 NORTH BOWSER ROAD, RICHARDSON, TEXAS 75081-2275 TEL (214) 346-4200 FAX (214) 730-0985			
PROJECT	DESIGN	DRAWN	DATE
27530	MSW	MSW	OCTOBER 2010
			SHEET
			XS-7


SHEET 89 OF 163



RECORD DRAWINGS

USER: oh1299
 OFFICE: RCH
 PROJECT: 27530
 FILE: TR-XSSH-27530.dgn
 TIME: 10:47:07 AM
 DATE: 12/7/2011

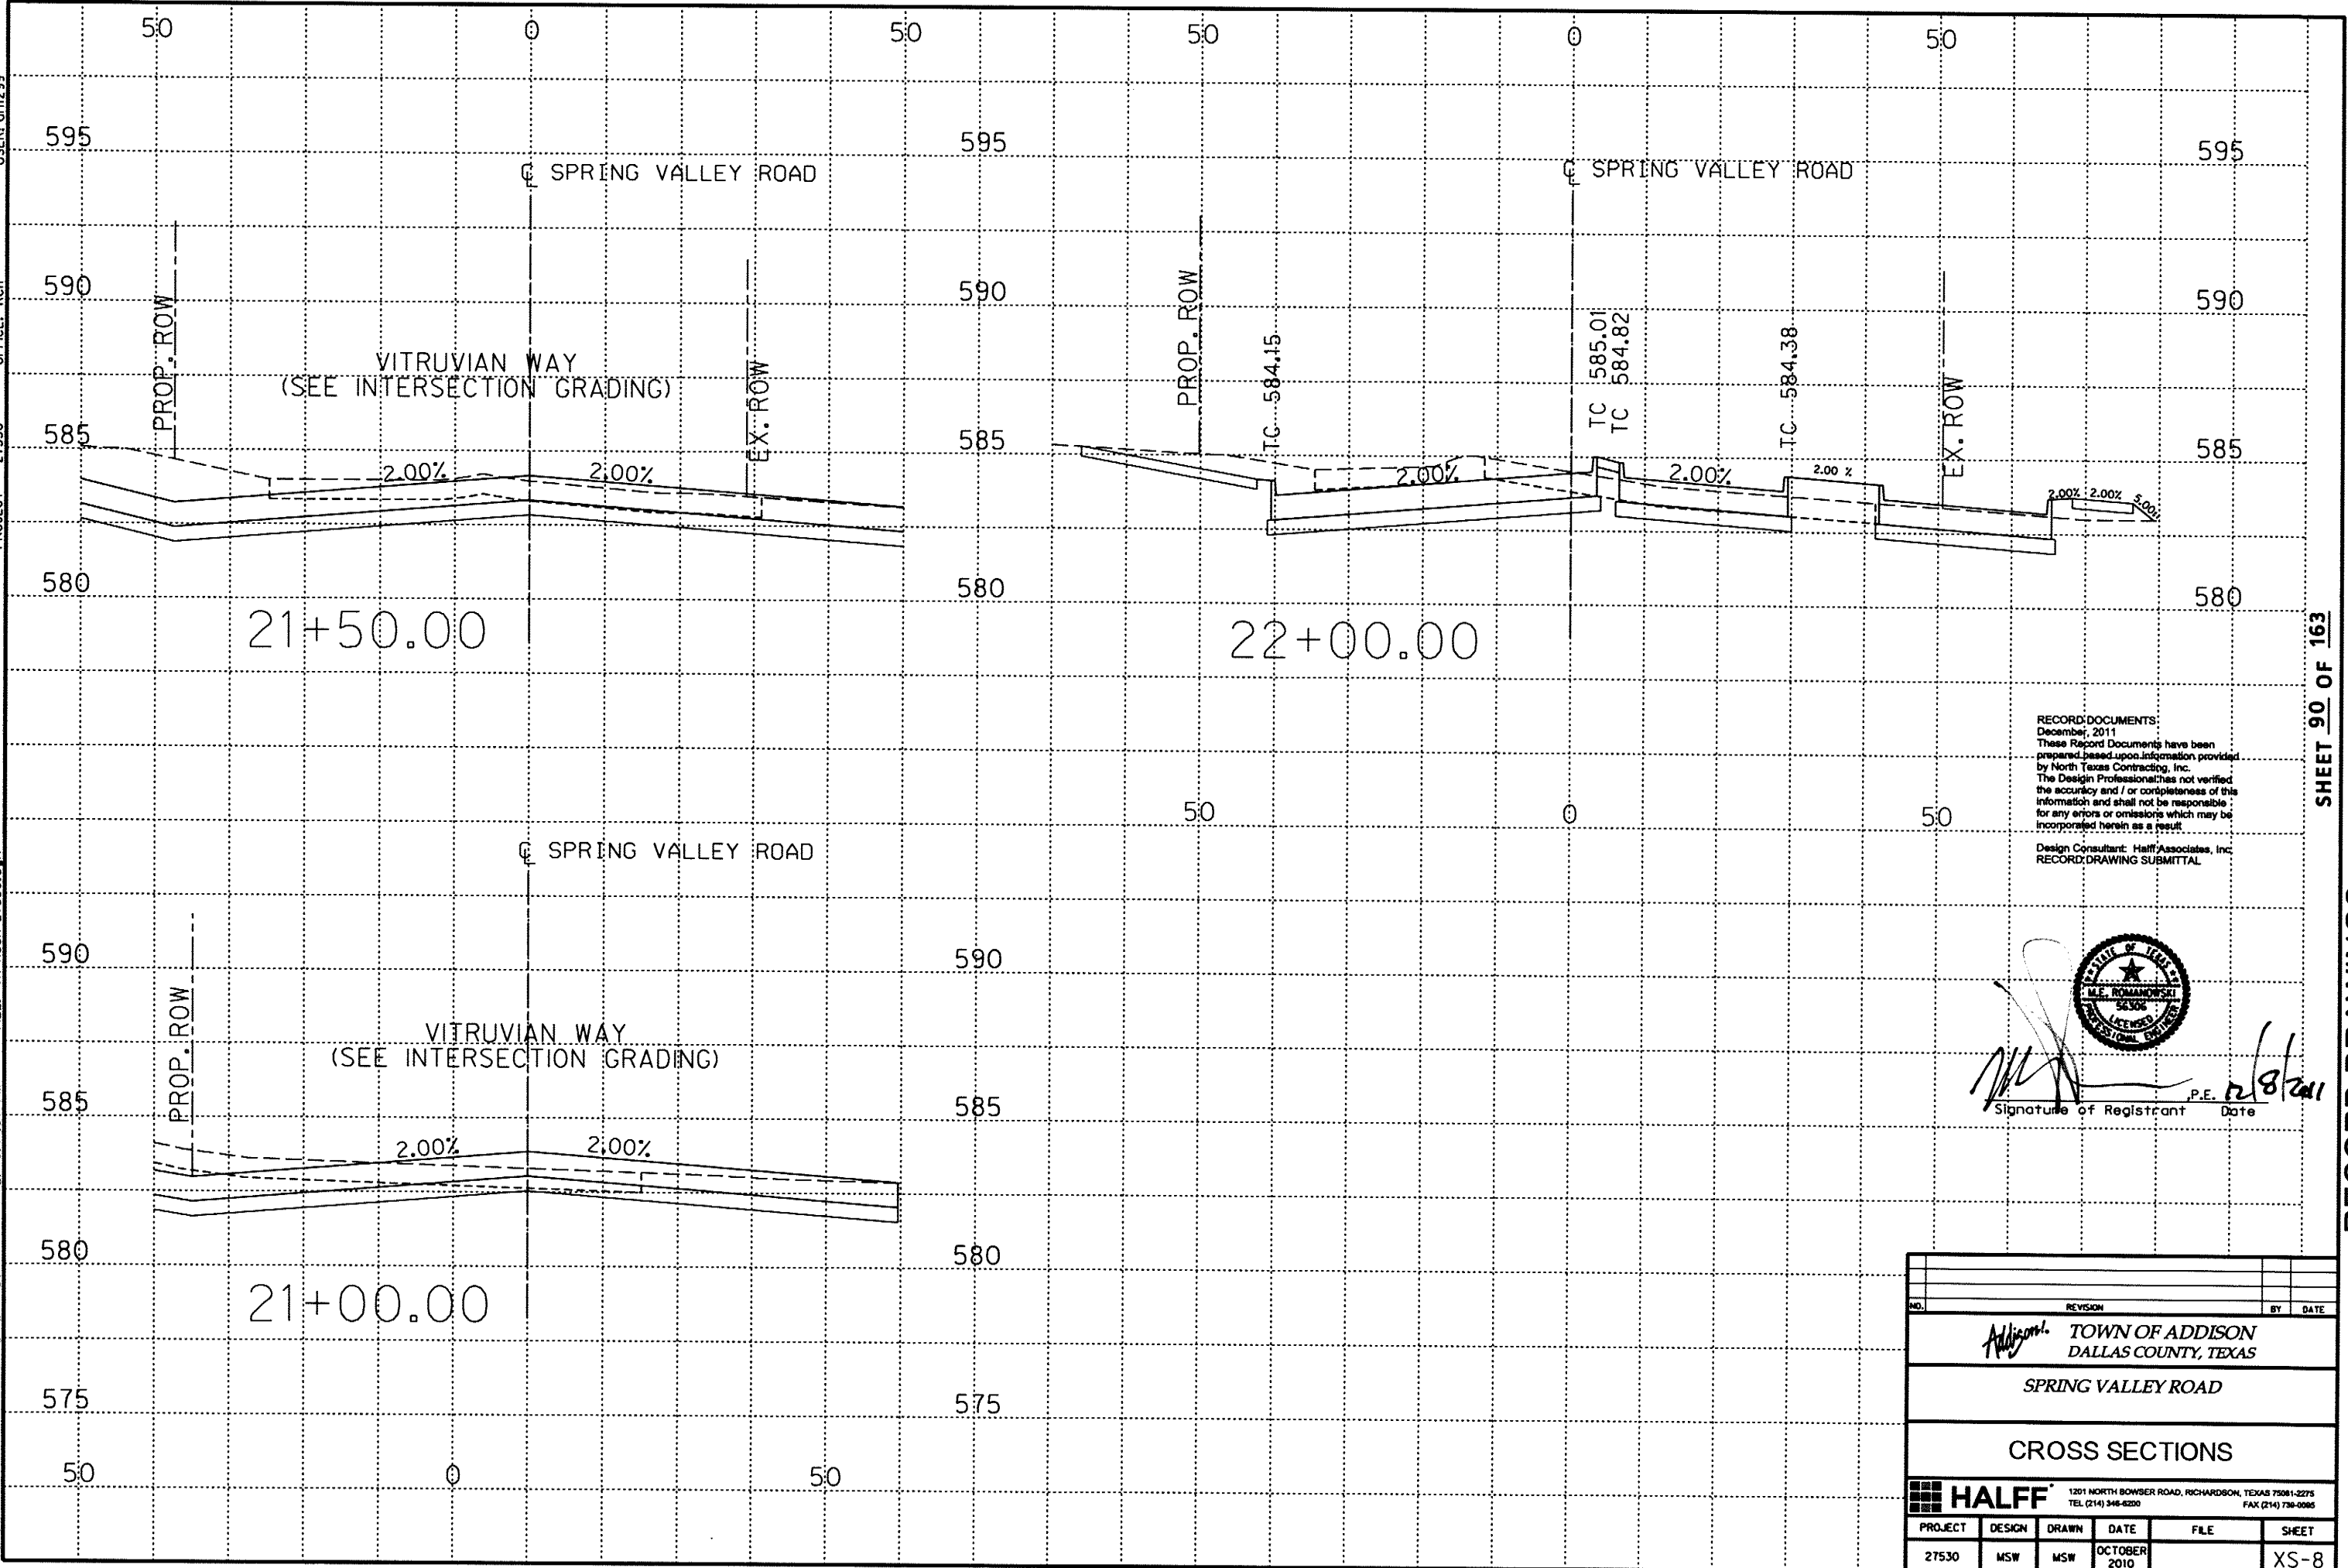


RECORD DOCUMENTS:
 December, 2011
 These Report Documents have been prepared based upon information provided by North Texas Contracting, Inc. The Design Professional has not verified the accuracy and / or completeness of this information and shall not be responsible for any errors or omissions which may be incorporated herein as a result.
 Design Consultant: Halff Associates, Inc.
 RECORD DRAWING SUBMITTAL


 Signature of Registrant: *M.F. Romandowski*
 Date: 12/8/2011

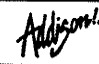
NO.	REVISION	BY	DATE
 TOWN OF ADDISON DALLAS COUNTY, TEXAS			
SPRING VALLEY ROAD			
CROSS SECTIONS			
 HALFF 1201 NORTH BOWSER ROAD, RICHARDSON, TEXAS 75081-2275 TEL (214) 348-4200 FAX (214) 739-0085			
PROJECT	DESIGN	DRAWN	DATE
27530	MSW	MSW	OCTOBER 2010
			SHEET
			XS-8



SHEET 90 OF 163
 RECORD DRAWINGS

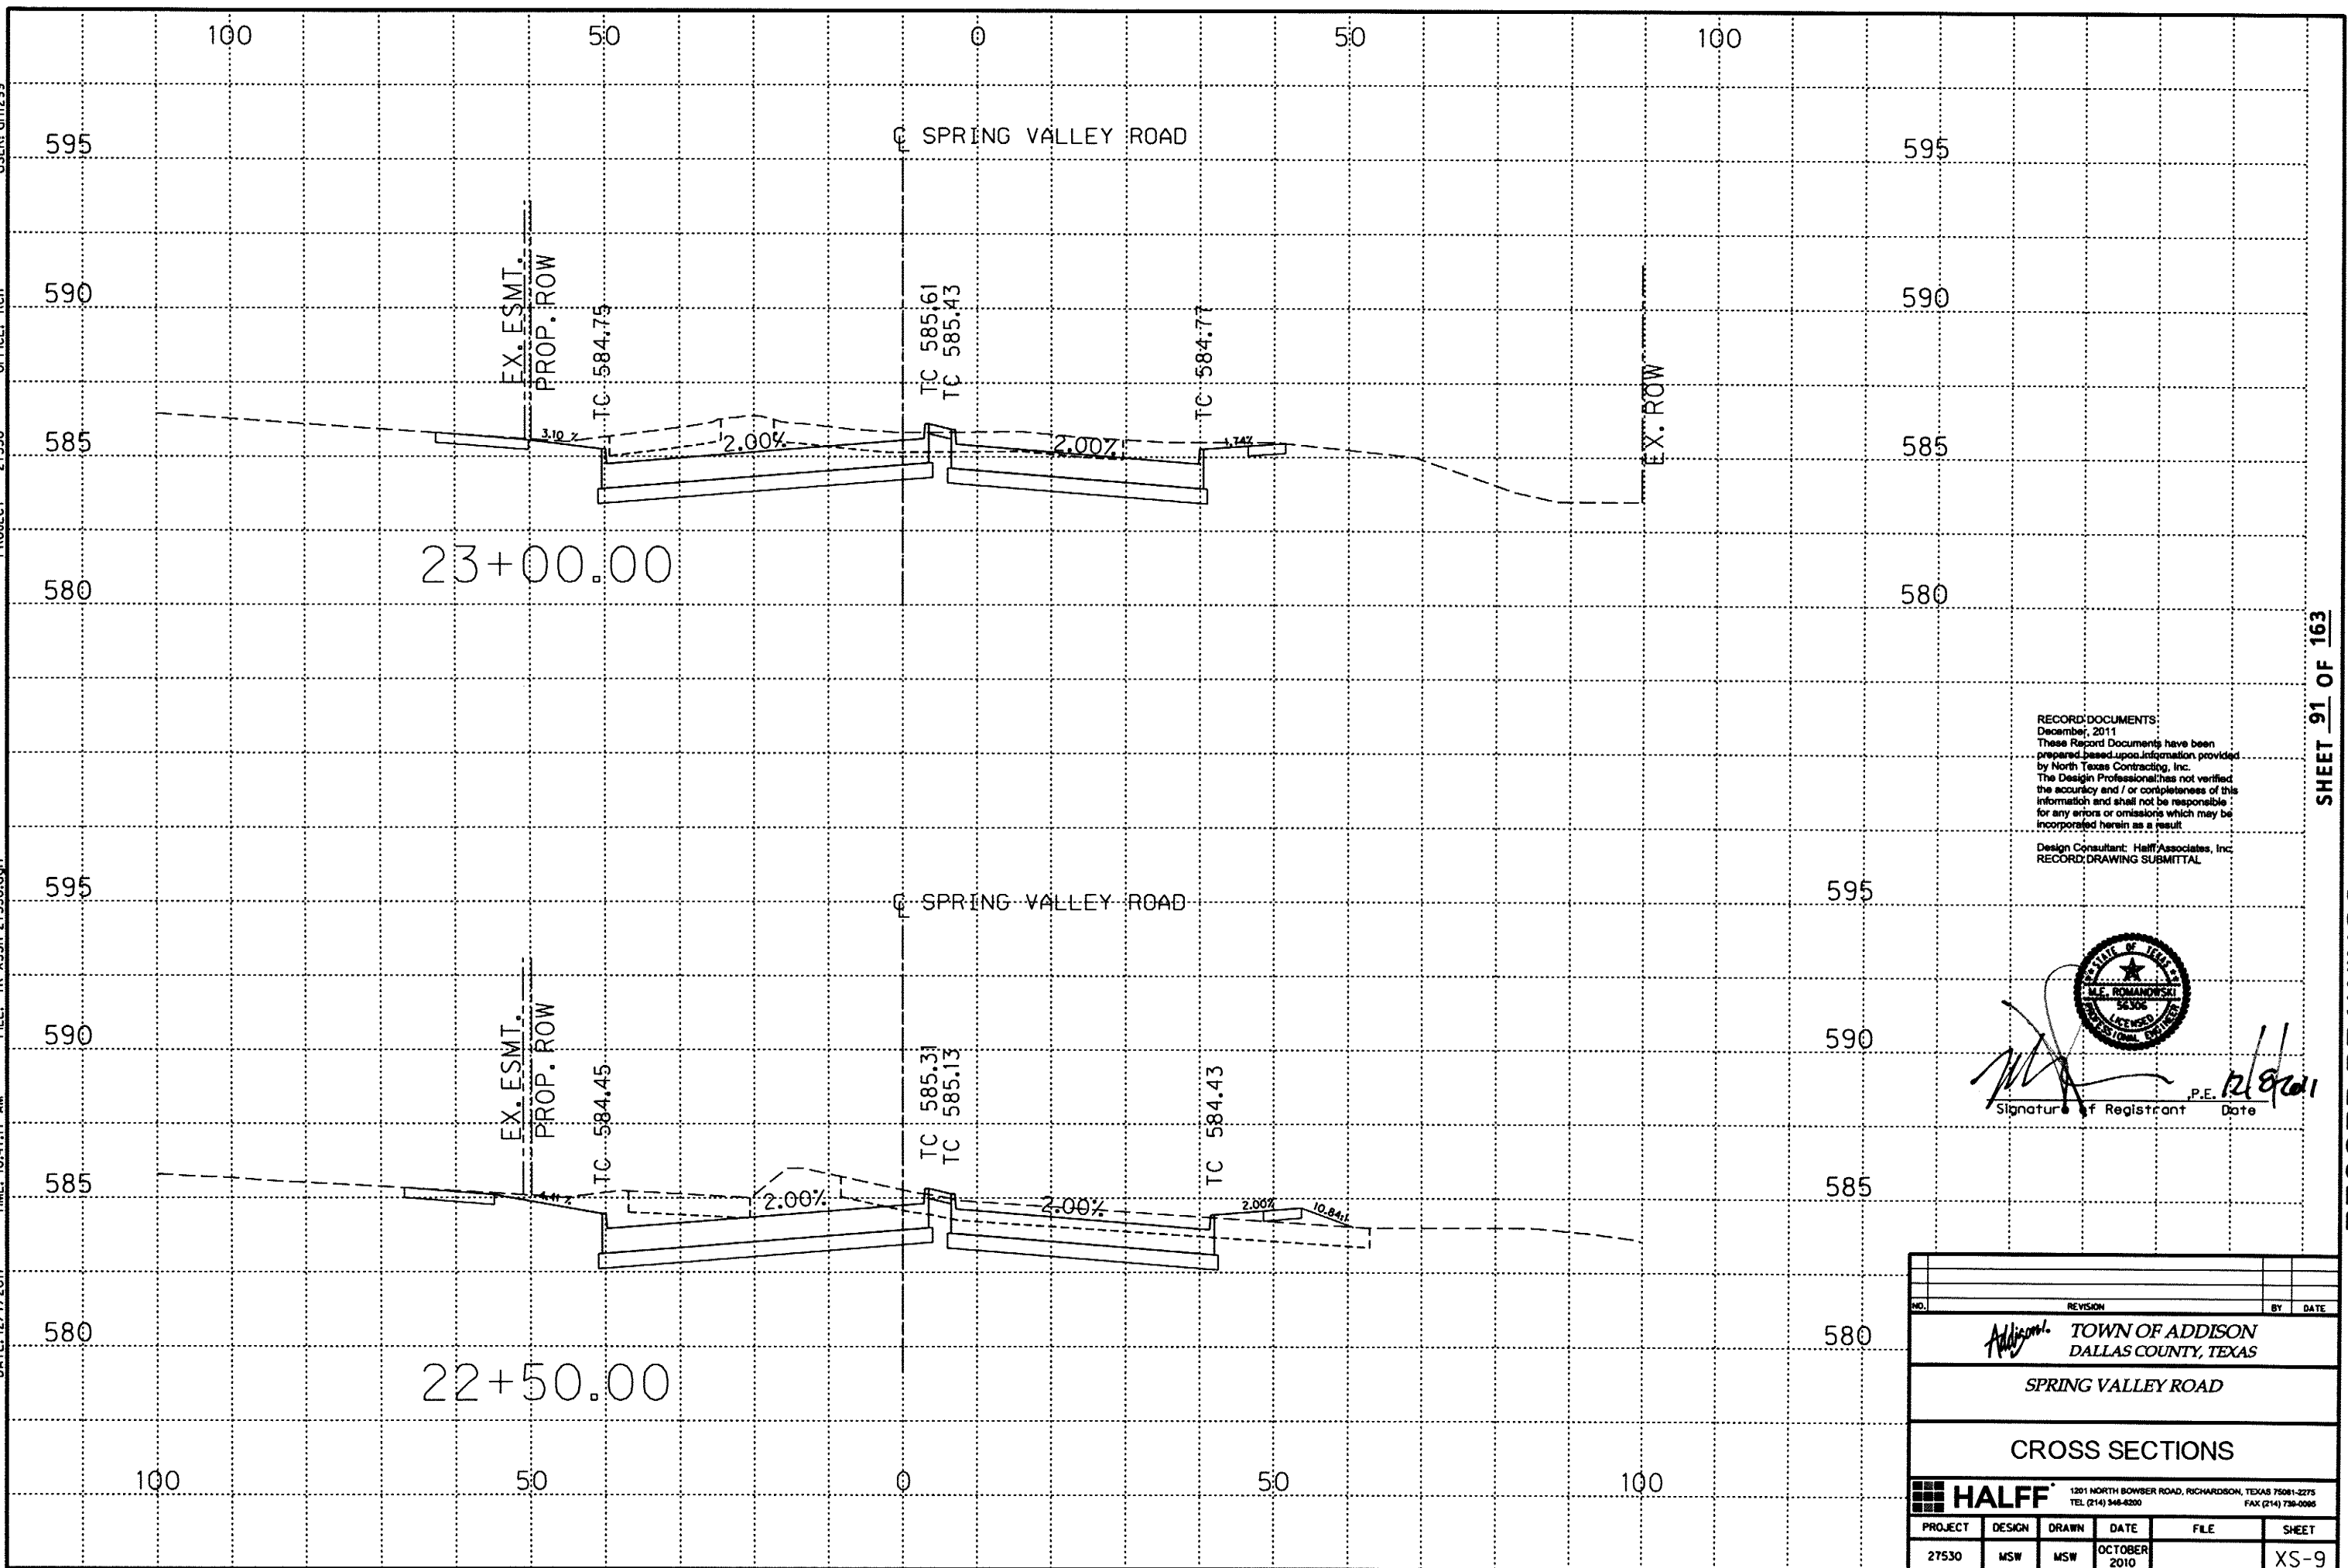DATE: 12/7/2011 TIME: 10:47:17 AM FILE: TR-XSSH-27530.dgn PROJECT: 27530 OFFICE: RCH USER: dhl299




RECORD DOCUMENTS:
 December, 2011
 These Record Documents have been prepared based upon information provided by North Texas Contracting, Inc. The Design Professional has not verified the accuracy and / or completeness of this information and shall not be responsible for any errors or omissions which may be incorporated herein as a result.
 Design Consultant: Halff Associates, Inc.
 RECORD DRAWING SUBMITTAL


 Signature: *[Signature]* P.E. Date: 12/8/2011


NO.	REVISION	BY	DATE
 TOWN OF ADDISON DALLAS COUNTY, TEXAS SPRING VALLEY ROAD CROSS SECTIONS			
 HALFF <small>1201 NORTH BOWSER ROAD, RICHARDSON, TEXAS 75081-2275 TEL (214) 348-4200 FAX (214) 738-0095</small>			
PROJECT	DESIGN	DRAWN	DATE
27530	MSW	MSW	OCTOBER 2010
			SHEET
			XS-9

RECORD DRAWINGS SHEET 91 OF 163

DATE: 12/7/2011 TIME: 10:47:23 AM FILE: TR-XSSH-27530.dgn PROJECT: 27530 OFFICE: RCH USER: qh299

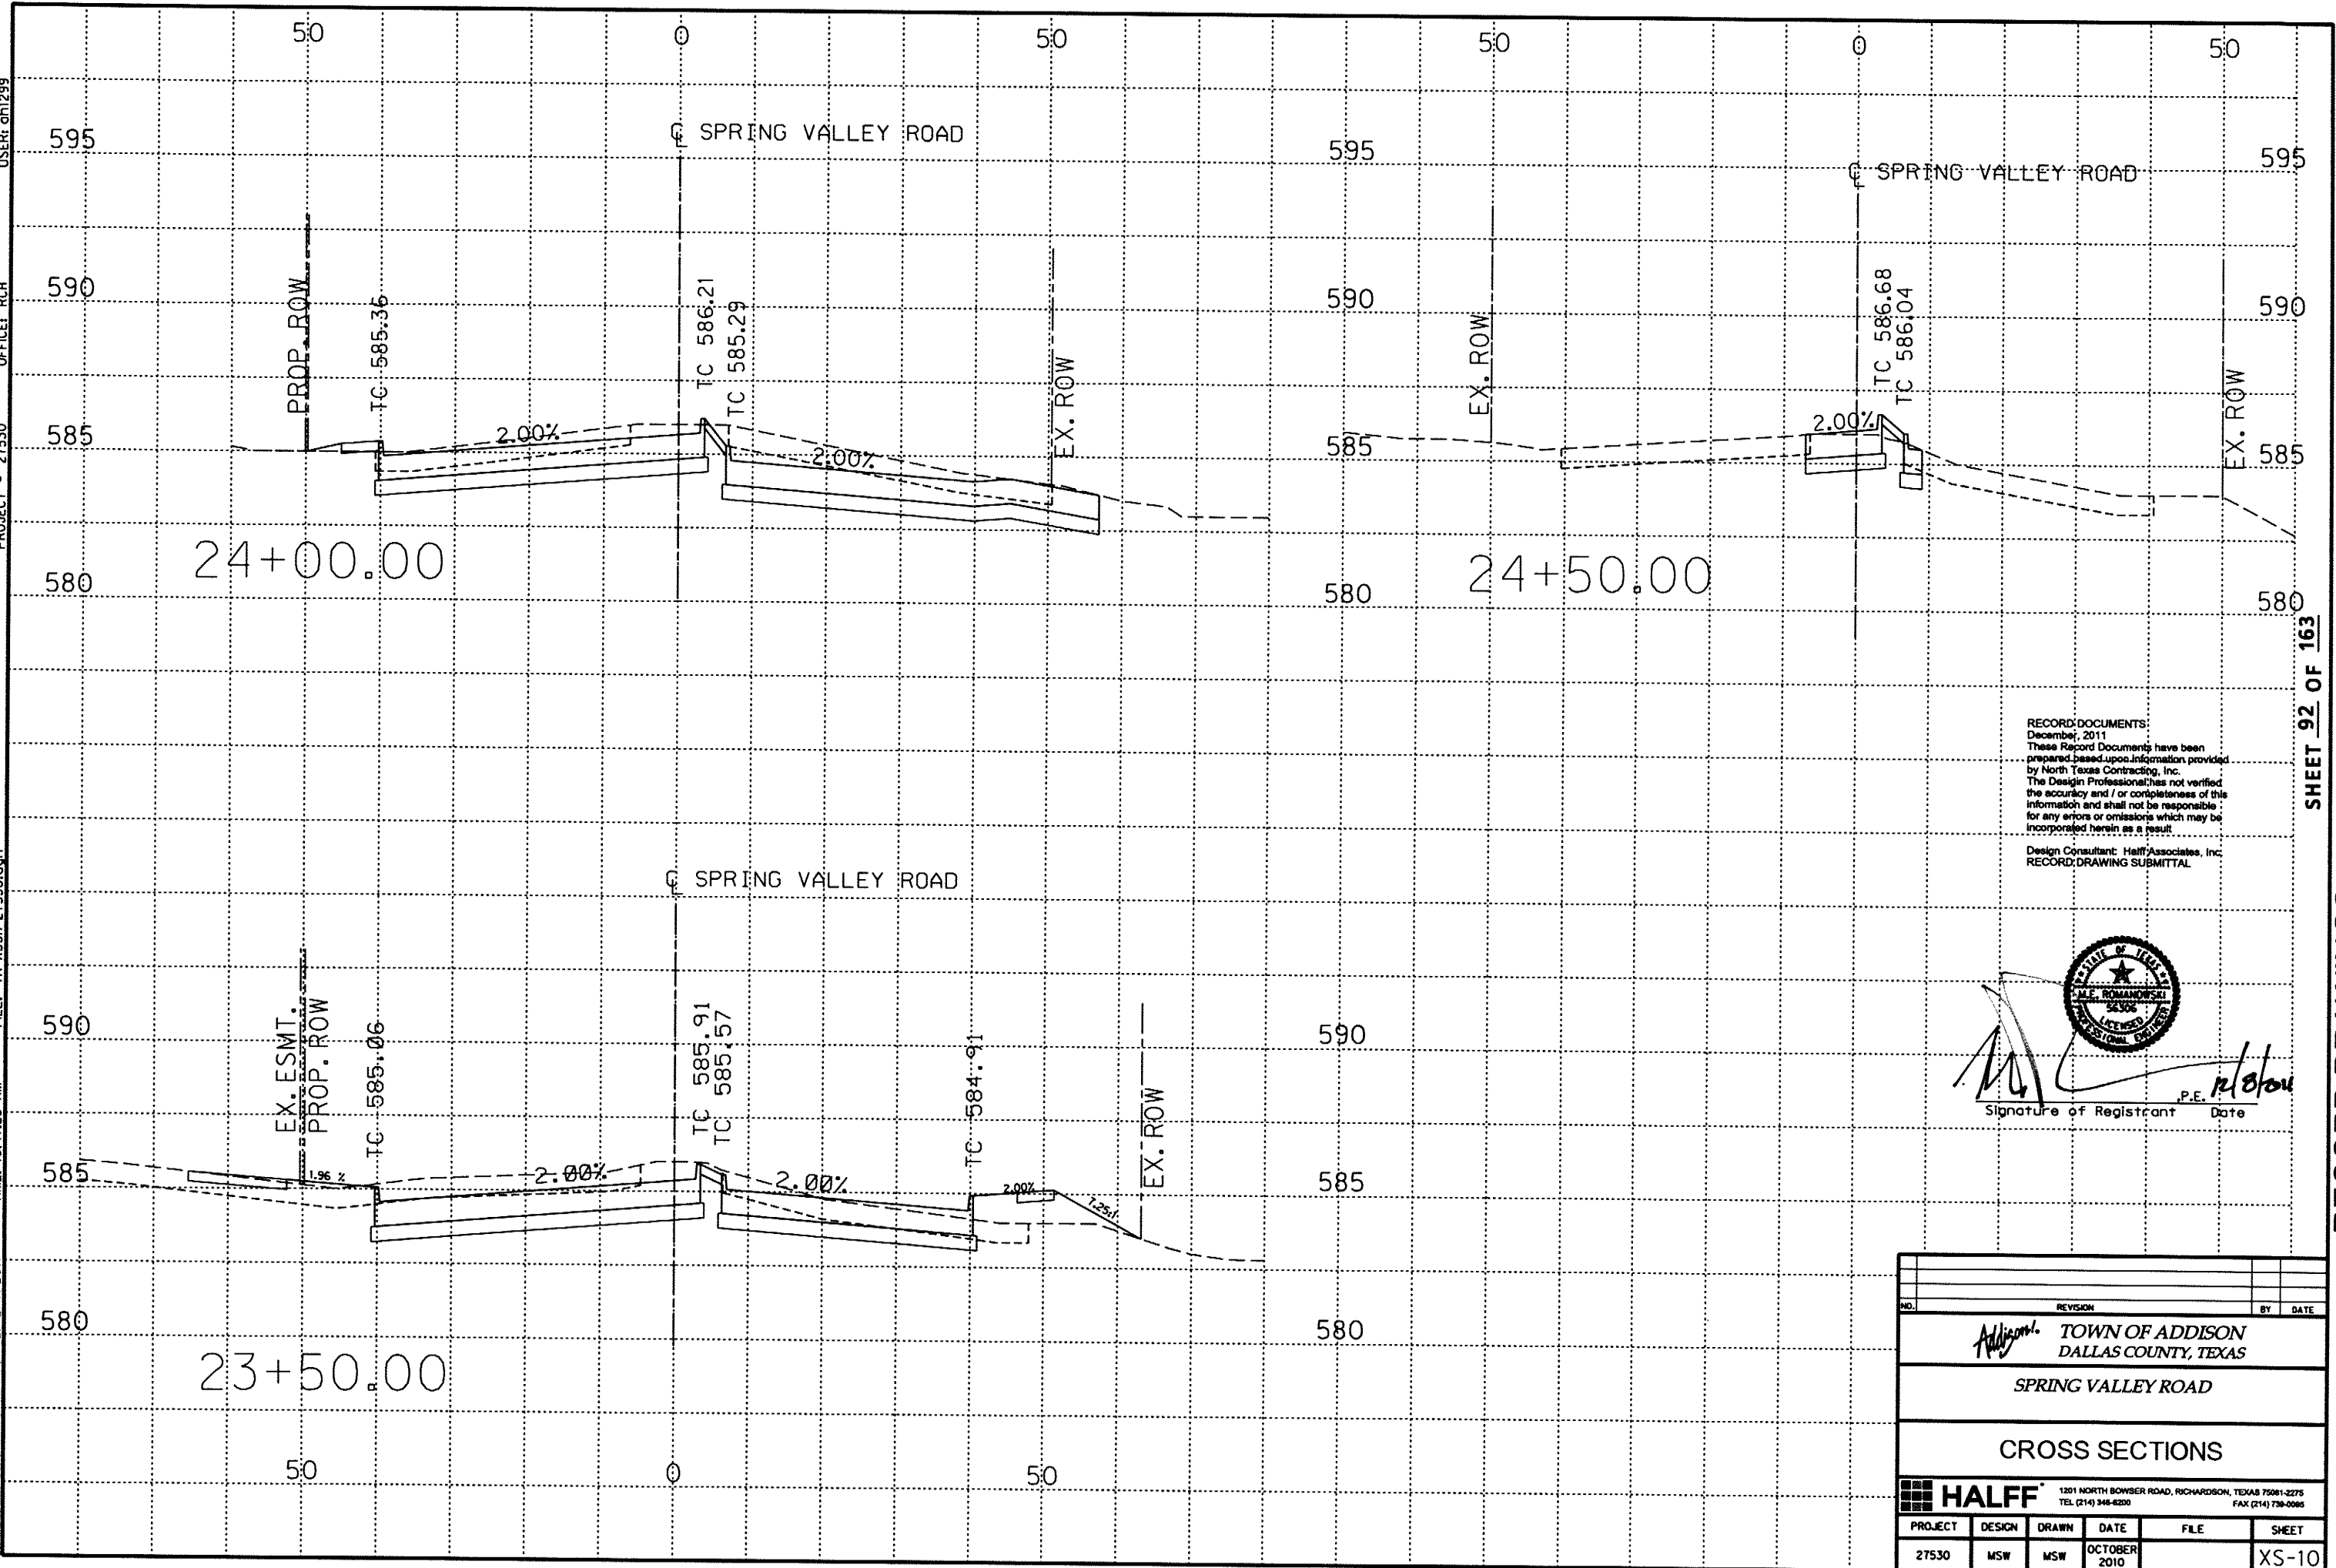


RECORD DOCUMENTS:
 December, 2011
 These Record Documents have been prepared based upon information provided by North Texas Contracting, Inc. The Design Professional has not verified the accuracy and / or completeness of this information and shall not be responsible for any errors or omissions which may be incorporated herein as a result.
 Design Consultant: Halff Associates, Inc.
 RECORD DRAWING SUBMITTAL


 Signature of Registrant: *M.P. Romanowski* P.E. Date: *12/8/10*

NO.	REVISION	BY	DATE
ADDISON TOWN OF ADDISON DALLAS COUNTY, TEXAS SPRING VALLEY ROAD CROSS SECTIONS			
HALFF 1201 NORTH BOWSER ROAD, RICHARDSON, TEXAS 75081-2275 TEL (214) 346-4200 FAX (214) 738-0985			
PROJECT	DESIGN	DRAWN	DATE
27530	MSW	MSW	OCTOBER 2010
			SHEET
			XS-10


SHEET 92 OF 163 RECORD DRAWINGS

Z:\log\spring valley road addison (10493)04 cd\wp-k\10493-11a.dwg

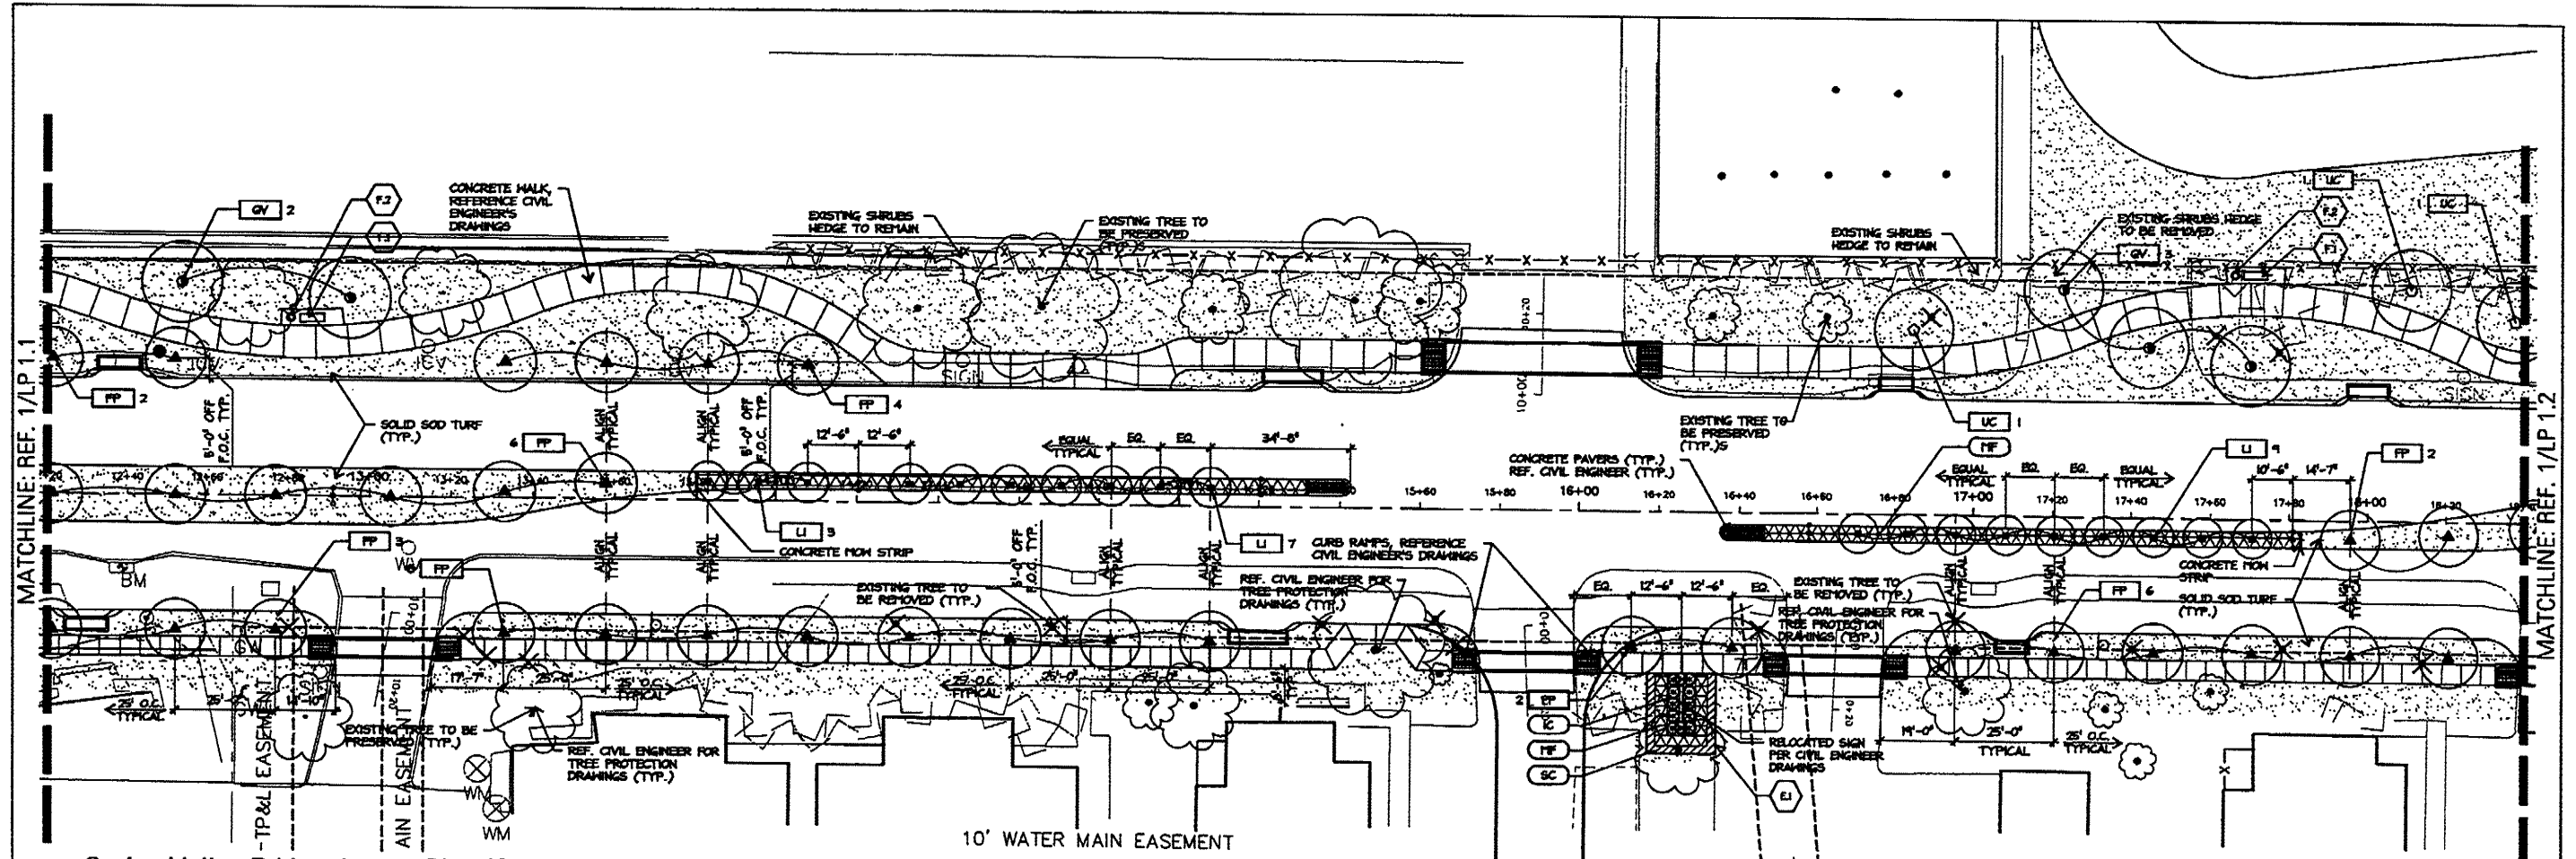

2 Spring Valley Rd Landscape Plan (Sta 12+20 - 18+20)
PLAN

SCALE 1"=20' NORTH

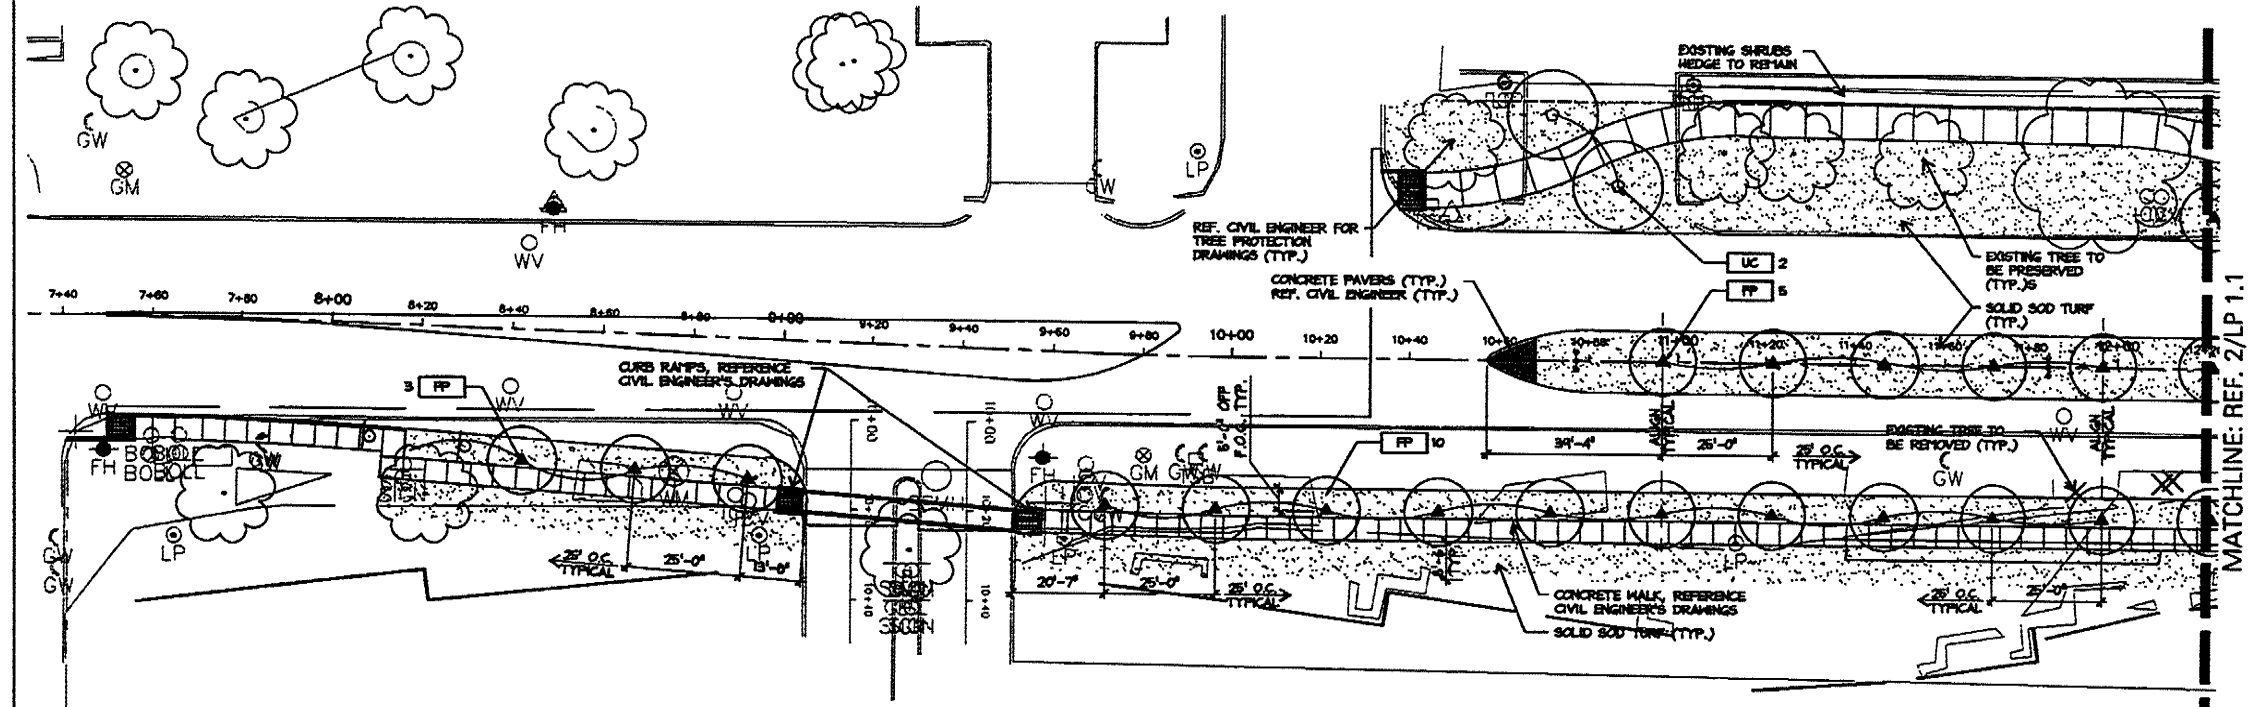

1 Spring Valley Rd Landscape Plan (Sta 7+40 - 12+20)
PLAN


SCALE 1"=20' NORTH

NOTE:
ALL TREES MUST BE A MINIMUM OF 5'
OFF THE EDGE OF HIGHWAY BIKE TRAILS
PER ASHTO STANDARDS.



NO.	REVISION	BY	DATE		
TOWN OF ADDISON DALLAS COUNTY, TEXAS SPRING VALLEY ROAD LANDSCAPE PLANTING PLAN					
PROJECT	DESIGN	DRAWN	DATE	FILE	SHEET
D10493	REV	SA	OCTOBER 2000		LP 11

Z:\top\spring_valley_road_addison\dl0438\A\04_cdw\work\B10438-111e.dwg

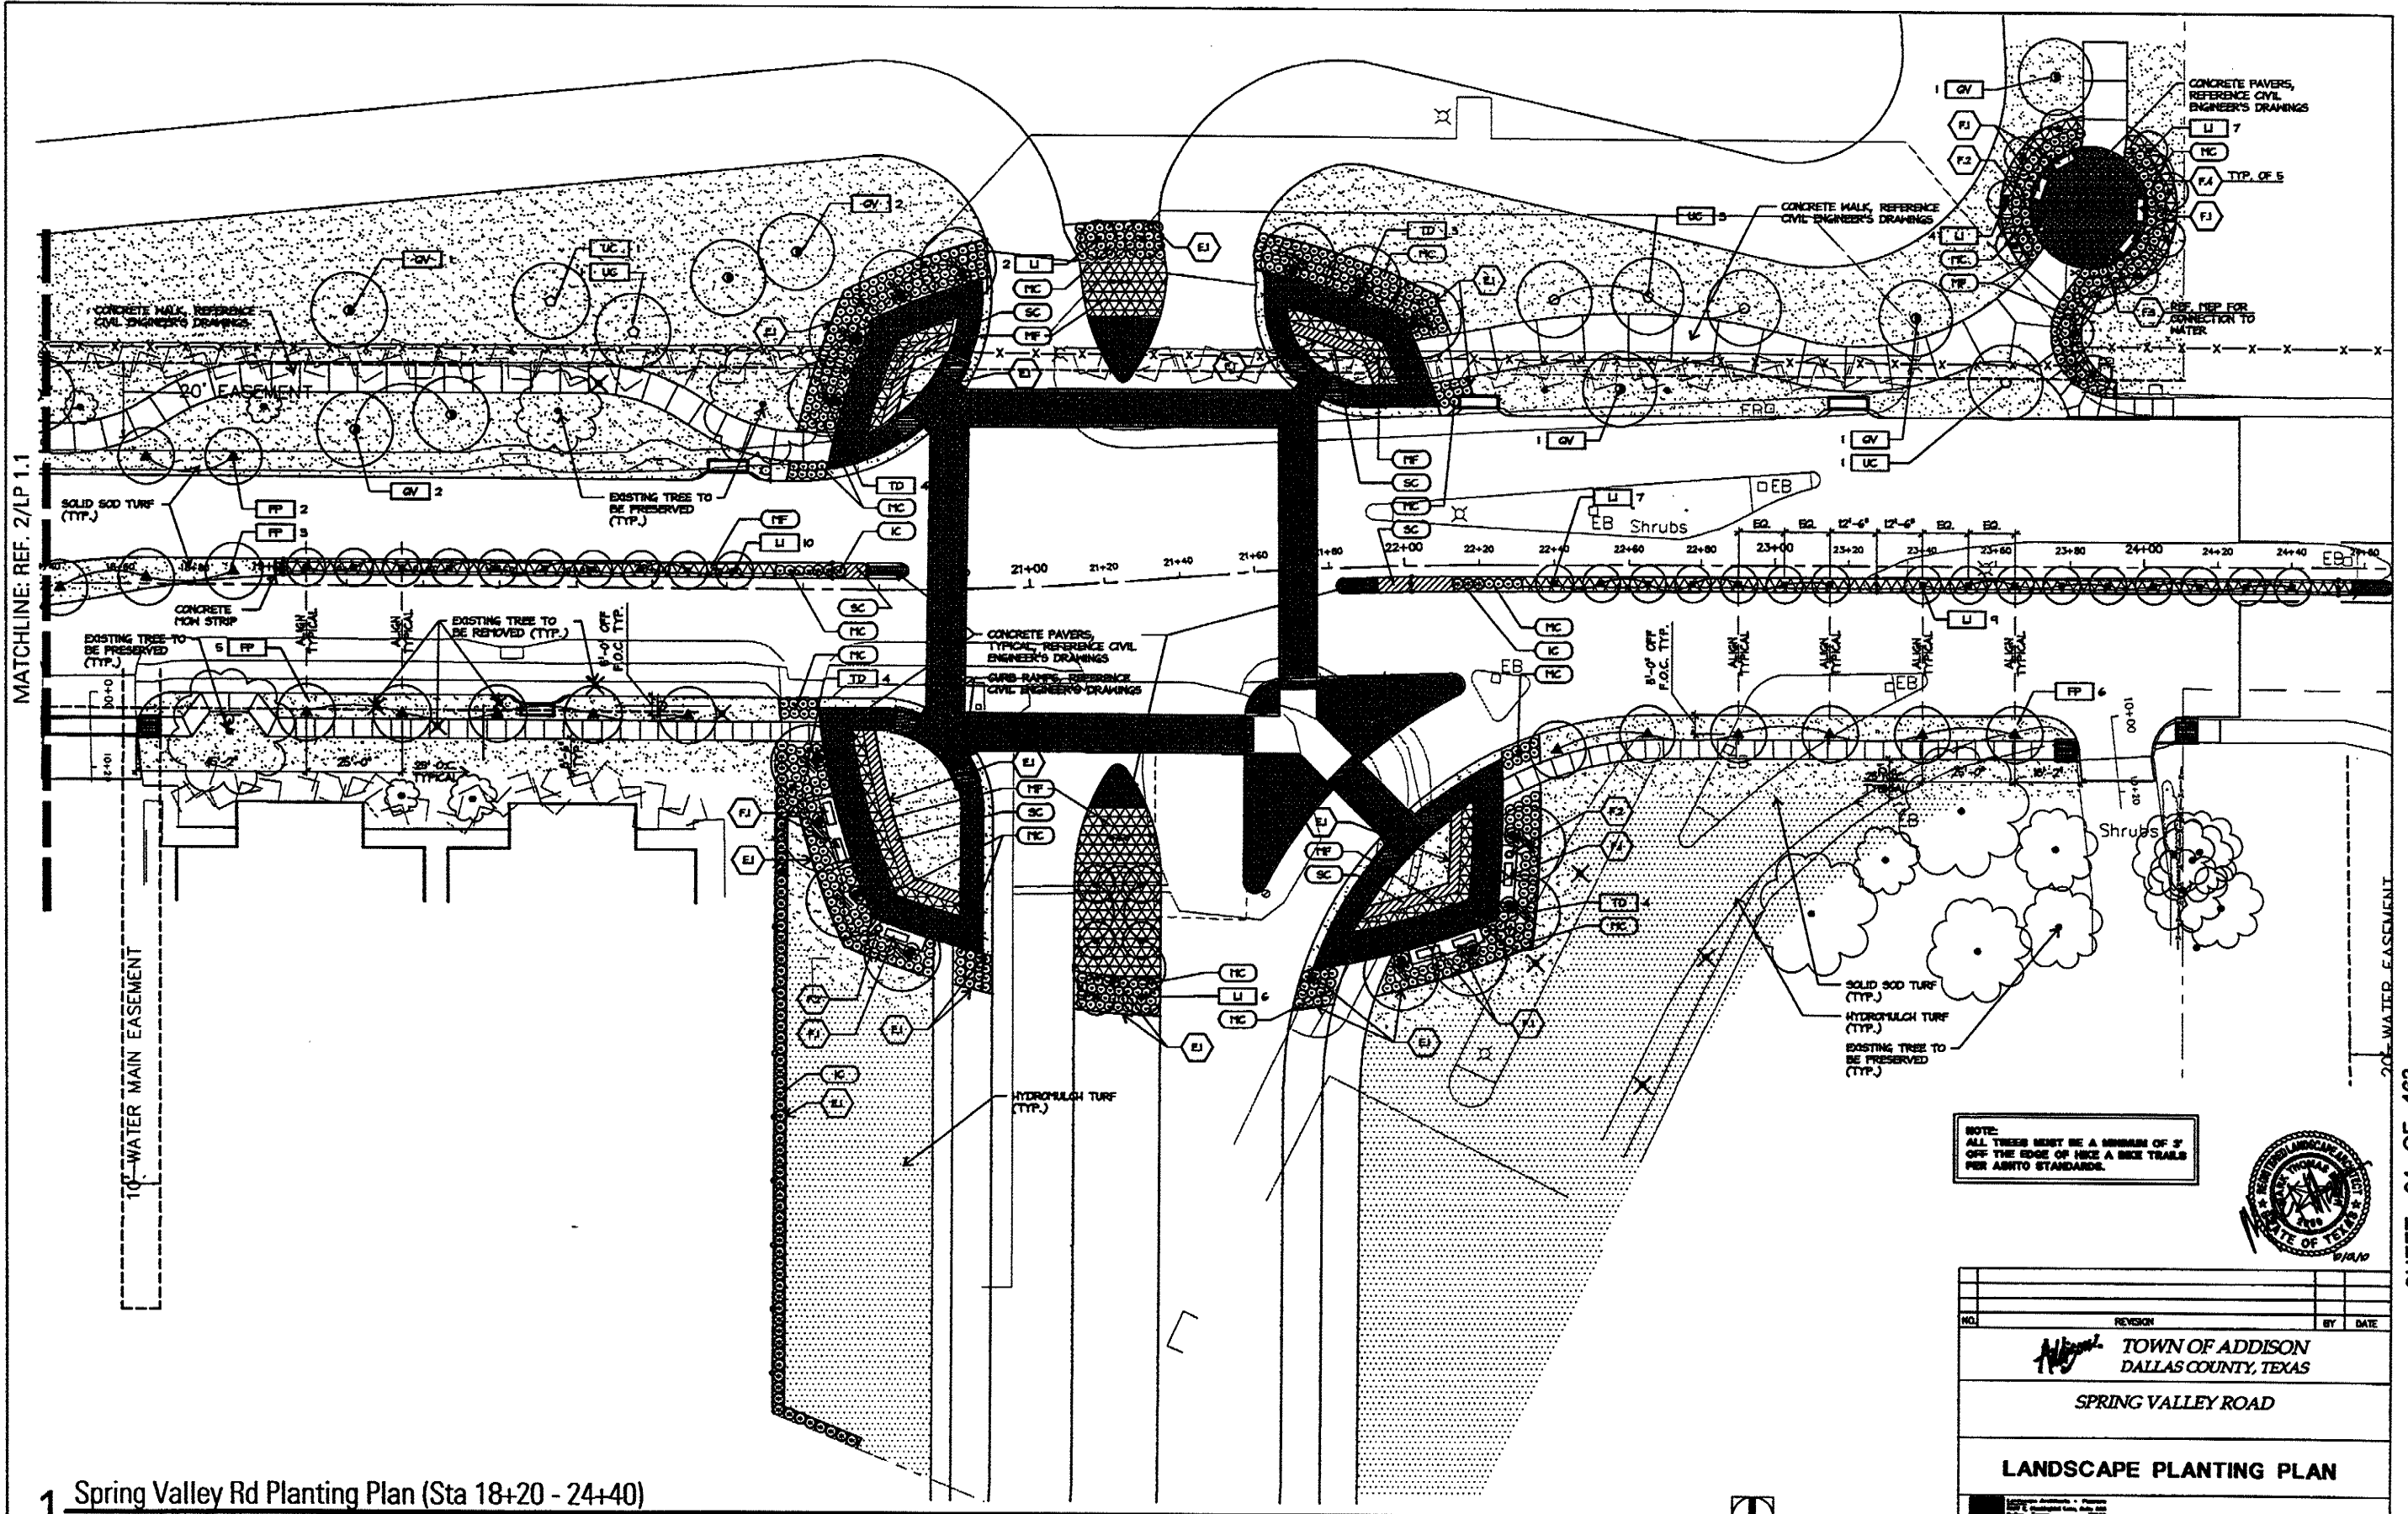





NOTE:
ALL TREES MUST BE A MINIMUM OF 3'
OFF THE EDGE OF HIGHWAY A BIKER TRAIL
PER ABNTD STANDARDS.



1 Spring Valley Rd Planting Plan (Sta 18+20 - 24+40)
PLAN



NO.		REVISION		BY DATE	
TOWN OF ADDISON DALLAS COUNTY, TEXAS					
SPRING VALLEY ROAD					
LANDSCAPE PLANTING PLAN					
PROJECT	DESIGN	DRAWN	DATE	FILE	SHEET
D10-88	TFT	SA	AUGUST 2000		LP 1.2

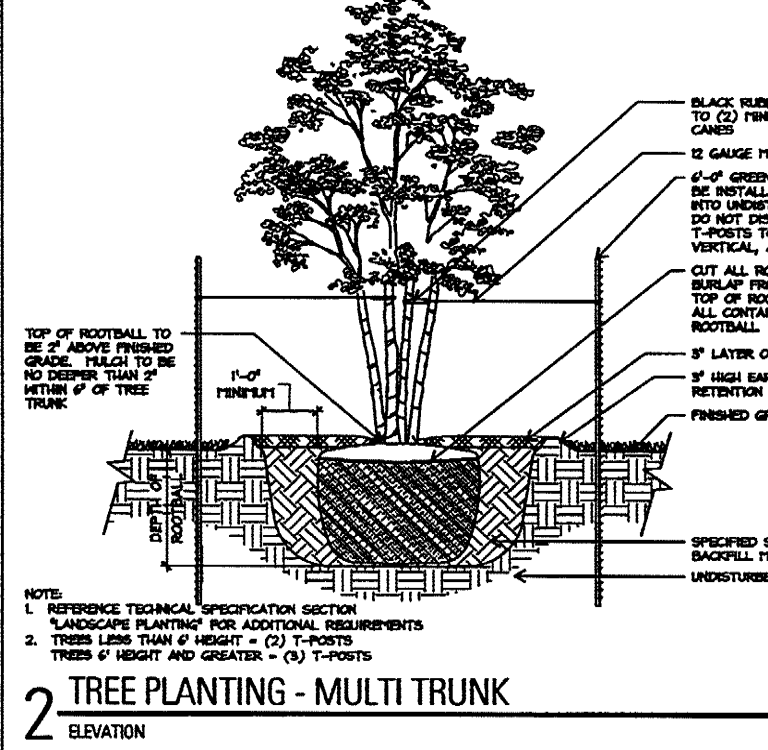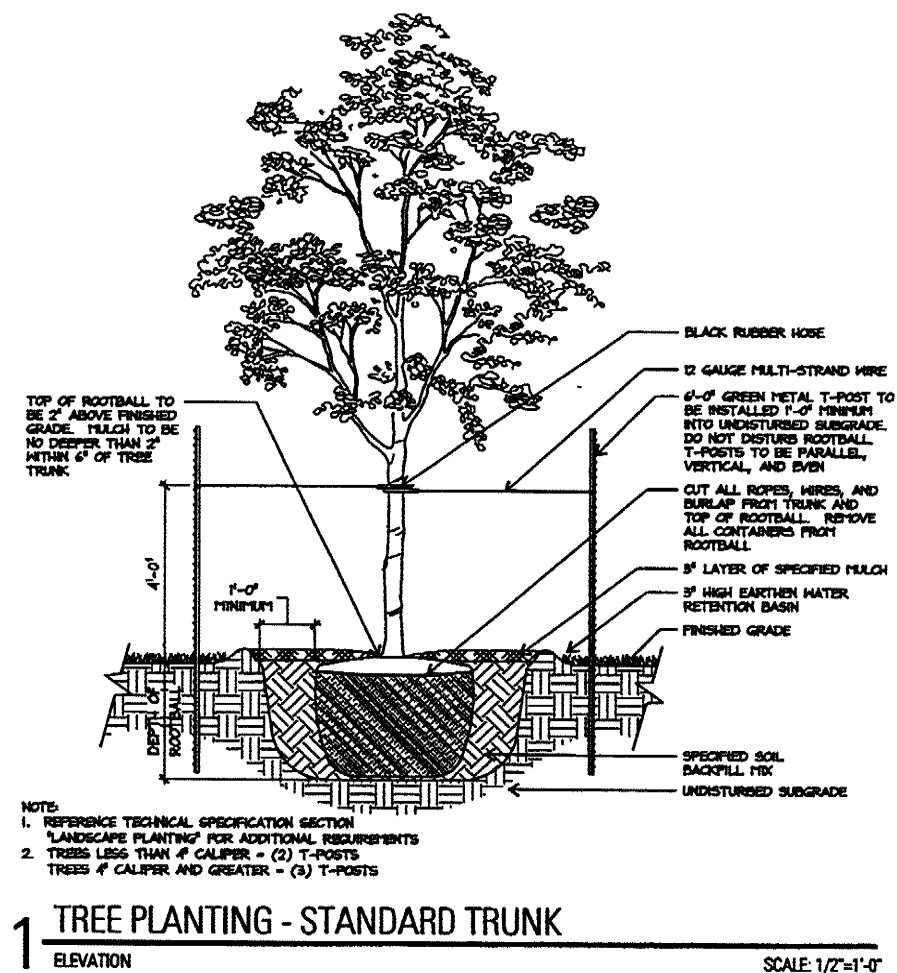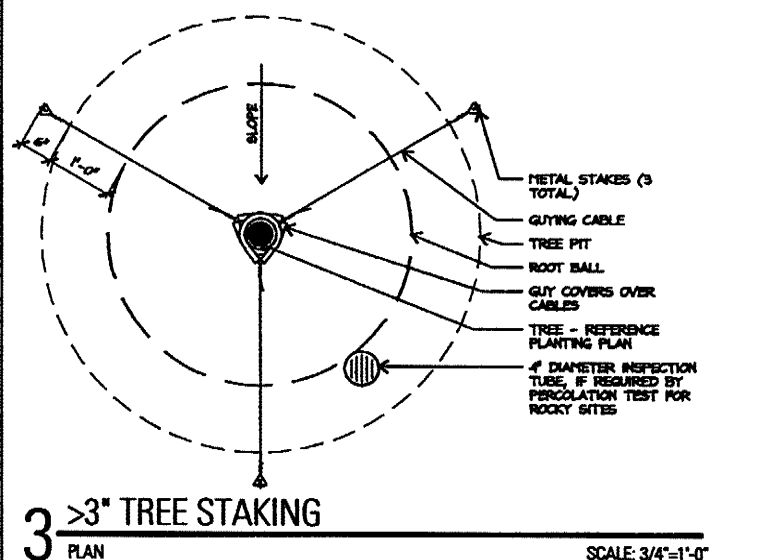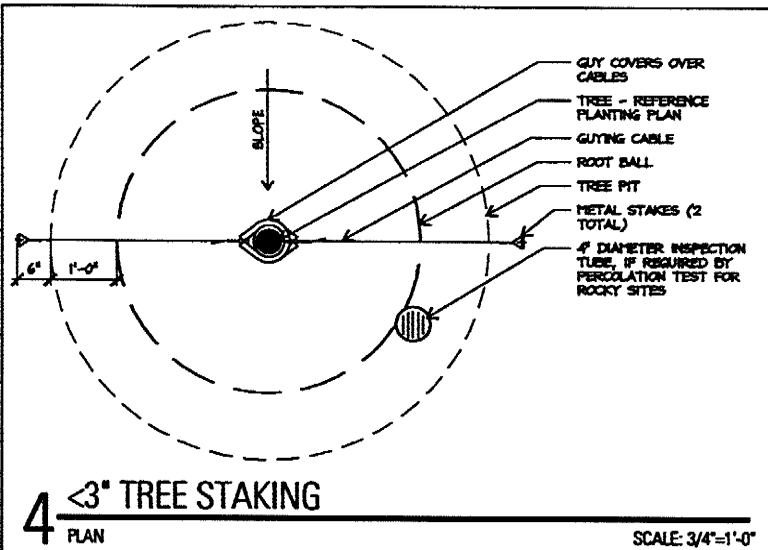

TREES			
SYMBOL	COMMON NAME BOTANICAL NAME	SIZE	REMARKS
65	URBANITE ASH <i>Fraxinus pennsylvanica</i> <i>Urbanite</i>	4" cal; min 14' ht; min 8' sprd., 100 gal.	Container grown; straight trunk with full and uniform canopy.
18	MULTI-TRUNK LIVE OAK <i>Quercus virginiana</i>	4" cal; min 14' ht; min 8' sprd., 100 gal.	Container grown; straight trunk with full and uniform canopy.
12	CEDAR ELM <i>Ulmus crassifolia</i>	4" cal; min 14' ht; min 8' sprd., 200 gal.	Container grown; straight trunk with full and uniform canopy.
15	BALD CYPRESS <i>Taxodium distichum</i>	4" cal; min 14' ht; min 8' sprd., 100 gal.	Container grown; straight trunk with full and uniform canopy.
ORNAMENTAL TREES			
SYMBOL	COMMON NAME BOTANICAL NAME	SIZE	REMARKS
62	GRAPE MYRTLE <i>Lycopersicon esculentum</i> <i>Nelica</i>	4.5' cal; min 12' ht; min 2' sprd.	Single trunk 65 gal.; straight trunk with full and uniform canopy.
SHRUBS			
SYMBOL	COMMON NAME BOTANICAL NAME	SIZE	REMARKS
(MC)	GULF MULBERRY <i>Morinda citrifolia</i>	3 gal. min; 2' ht; min 2' sprd.	Plant 30" o.c.; Full Plant; 18 plants/SF
(TF)	MEXICAN FEATHER GRASS <i>Scleria torreyana</i>	1 gal. min; 12' ht; min 12" sprd.	Plant 15" o.c.; Full Plant; 74 plants/SF
(C)	BURFORD HOLLY <i>Ilex cornuta</i> 'Burfordii'	5 gal. min; 2' ht; min 2' sprd.	Plant as shown on plans Dark Green, Full Plant
GROUNDCOVERS			
SYMBOL	COMMON NAME BOTANICAL NAME	SIZE	REMARKS
(SC)	SEASONAL COLOR		
LAWN			
SYMBOL	COMMON NAME BOTANICAL NAME	SIZE	REMARKS

	Turf Sod <i>St. Augustine 'Raleigh'</i>
	Turf Hydrumulch <i>Bermuda</i>

1 TREE PLANTING - STANDARD TRUNK

MATERIALS SCHEDULE					
EDGING					
KEY	DESCRIPTION / MODEL NUMBER	COLOR	FINISH	CONTACT	REMARKS
(E1)	3/16" STEEL EDGING	BLACK	PAINTED		- SUBMIT PRODUCT INFORMATION FOR OWNER APPROVAL PRIOR TO ORDERING
FURNITURE					
KEY	DESCRIPTION / MODEL NUMBER	COLOR	FINISH	CONTACT	REMARKS
(F1)	BENCH - ARCATO, ALUMINUM W/ DRIFTWOOD POLYSITE SLATS - 74" BACKED - WITH ARCS	TITANIUM	PONDERCOAT FRAME	CONTACT: DIANE COLLIER COMPANY: LANDSCAPE FORMS PHONE: (800) 667-1146	- SUBMIT PRODUCT INFORMATION FOR OWNER APPROVAL PRIOR TO ORDERING - SURFACE MOUNT PER MANUFACTURER'S RECOMMENDATION
(F2)	TRASH RECEPTACLE - CHASE PARK - SIDE OPENING - WITH LINER	TITANIUM	PONDERCOAT	CONTACT: DIANE COLLIER COMPANY: LANDSCAPE FORMS PHONE: (800) 667-1146	- SUBMIT PRODUCT INFORMATION FOR OWNER APPROVAL PRIOR TO ORDERING - SURFACE MOUNT PER MANUFACTURER'S RECOMMENDATION
(F3)	DRINKING FOUNTAIN - MDF; 40SS - WITH JUG FILLER - ATTACHED PET FOUNTAIN	STAINLESS STEEL		COMPANY: MOST DEPENDABLE FOUNTAINS, INC PHONE: (800) 552-6281	- SUBMIT PRODUCT INFORMATION FOR OWNER APPROVAL PRIOR TO ORDERING - SURFACE MOUNT PER MANUFACTURER'S RECOMMENDATION
(F4)	BIKE RACK - SOLA - SURFACE MOUNT	STAINLESS STEEL		CONTACT: DIANE COLLIER COMPANY: LANDSCAPE FORMS PHONE: (800) 667-1146	- SUBMIT PRODUCT INFORMATION FOR OWNER APPROVAL PRIOR TO ORDERING - SURFACE MOUNT PER MANUFACTURER'S RECOMMENDATION

TOWN OF ADDISON
DALLAS COUNTY, TEXAS


SPRING VALLEY ROAD

LANDSCAPE MATERIALS AND DETAILS


PROJECT	DESIGN	DRAWN	DATE	FILE	SHEET
D10488	PH	SA	AUGUST 2000		LP 21

Z:\tag\spring valley road addison (010438)A\04 cd\work\1010438-1111e.rvt


Z:\hsp\spring valley road addison cd\work\10438-1116.dwg

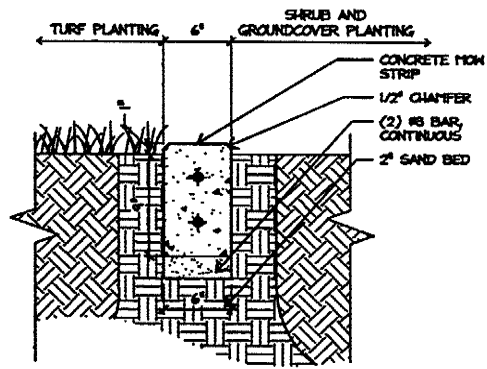


7 CONCRETE MOW STRIP
SECTION SCALE: 1-1/2"=1'-0"

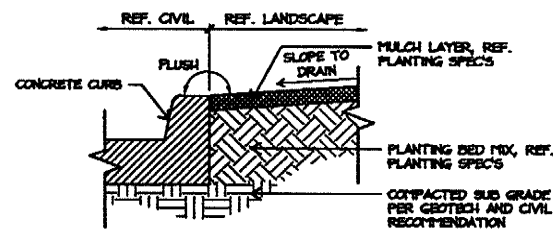


6 PLANTING AT CURB
SECTION SCALE: 1"=1'-0"

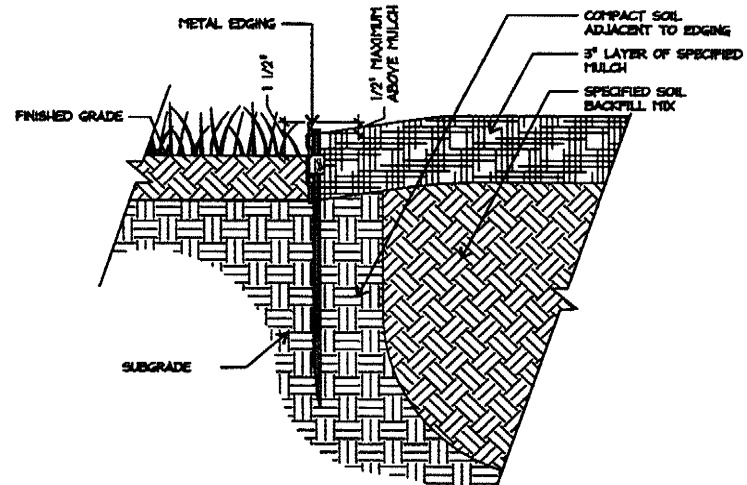


5 METAL EDGING AT PLANTING AND LAWN
SECTION SCALE: 3"=1'-0"

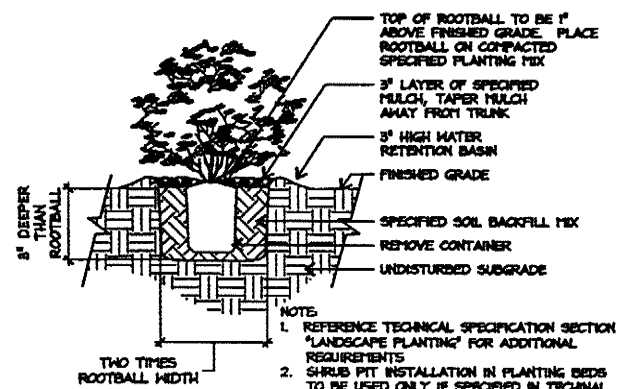


4 INDIVIDUAL SHRUB PLANTING
SECTIONS SCALE: 3/8"=1'-0"

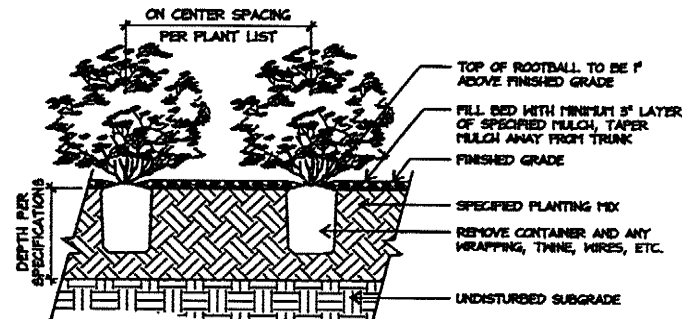

3 SHRUB BED PLANTING
SECTION SCALE: 3/8"=1'-0"

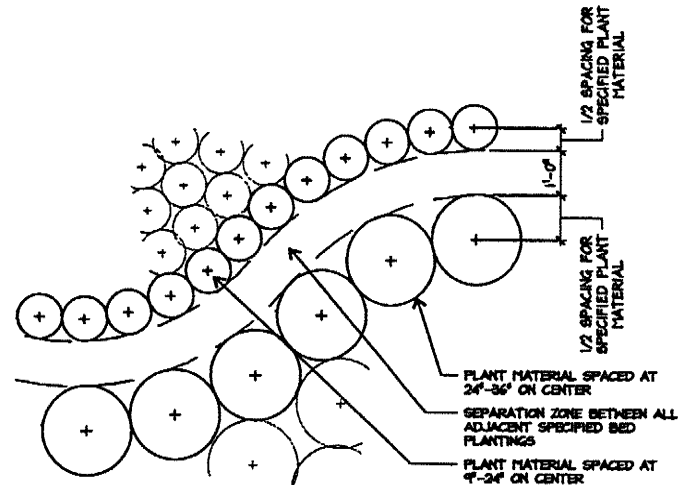

2 CURVED BED LAYOUT
PLAN SCALE: 1/2"=1'-0"

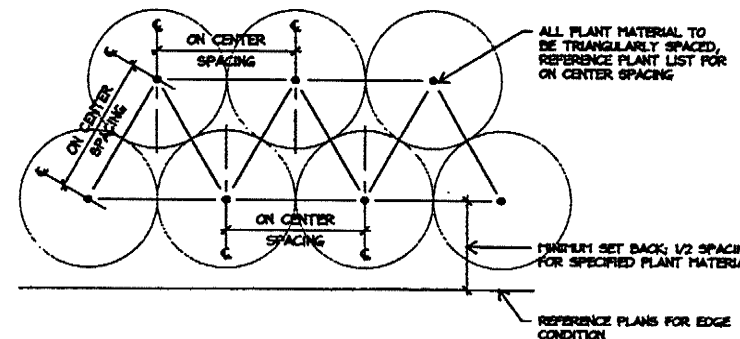

1 PLANT SPACING DIAGRAM
PLAN SCALE: 1/2"=1'-0"

LANDSCAPE PLANTING NOTES:

- 1) THE CONTRACTOR SHALL RECEIVE THE SITE AT APPROXIMATELY FINAL GRADE. ALL SLOPES SHALL BE SMOOTH AND UNIFORM WITH A MAXIMUM SLOPE OF 3:1 UNLESS OTHERWISE NOTED. TIE INTO EXISTING ADJACENT GRADES SMOOTHLY AND FINE GRADE FOR POSITIVE DRAINAGE AND TO PREVENT WATER FROM STANDING. CUT SHALES TO DIRECT WATER AWAY FROM ALL STRUCTURES AND PROPERTY LINES, AND TOWARDS STORM SEWER INLETS. DO NOT DRAIN ANY WATER TOWARDS LOTS/EASEMENTS. THE FINAL LOCATION AND HEIGHT OF BERTS SHALL BE APPROVED BY THE LANDSCAPE ARCHITECT IN THE FIELD.
- 2) TREE PLANTING- REFERENCE SPECIFICATIONS AND DETAILS FOR PLANTING REQUIREMENTS, MATERIALS, AND EXECUTION, (INCLUDING STAKING METHODS, PLANT PIT DIMENSIONS, AND BACKFILL REQUIREMENTS.) REFERENCE DETAILS FOR PROPER STAKING METHOD, STAKE SIZE AND COMPANY INFORMATION.

BACKFILL ALL TREE PITS WITH SPECIFIED PLANTING MIX AND INCORPORATE 5 LBS OF 8-8-8 FERTILIZER PER CU. YD. OF MIX INTO ALL TREE PITS. ALL TREE WATER RETENTION BASINS SHALL RECEIVE MIN. 3" DEEP COMPOSTED HARDWOOD BARK MULCH.
- 3) MACHINE MOVED OR HAND DUG TREES- ALL TREES TO BE MACHINE MOVED OR HAND DUG DIRECTLY FROM SITE SHALL BE APPROVED BY THE LANDSCAPE ARCHITECT PRIOR TO RELOCATION. COORDINATE TREE PRUNING TO BALANCE ROOT LOSS WITH LANDSCAPE ARCHITECT. TREES TO BE MECHANICALLY TRANSPLANTED USING TREE SPADE MUST ALLOW 4" OF ROOTBALL PER CALIPER INCH OF TREE.



SET TREE STRAIGHT AND PLUMB, AND FILL ANY AIR SPACES AROUND TREE WITH SPECIFIED SAND OR SANDY LOAM TOPSOIL. WATER IN TO DISPLACE AIR POCKETS. INSTALL 3" HIGH WATER RETENTION BASIN PER SPECIFICATIONS WITH 2" DEEP COMPOSTED BARK MULCH AND WATER THE SPADED TREES THE DAY OF TRANSPLANTING.
- 4) TREES SHALL BE LOCATED A MINIMUM OF 5' - 0" FROM WALLS, OVERHEADS, WALKS, EDGING, CURBS AND OTHER TREES WITHIN THE PROJECT. IF CONFLICTS ARISE BETWEEN THE SIZE OF AREAS AND PLANS, THE CONTRACTOR SHALL CONTACT THE LANDSCAPE ARCHITECT FOR RESOLUTION. FAILURE TO MAKE SUCH CONFLICTS KNOWN TO THE LANDSCAPE ARCHITECT MAY RESULT IN THE CONTRACTOR'S LIABILITY TO RELOCATE MATERIALS.
- 5) ALL PLANT MATERIALS SHALL BE APPROVED BY THE LANDSCAPE ARCHITECT PRIOR TO INSTALLATION. THE FINAL LOCATION OF ALL PLANT MATERIAL SHALL BE SUBJECT TO THE APPROVAL OF THE LANDSCAPE ARCHITECT. THE CONTRACTOR SHALL NOTIFY THE LANDSCAPE ARCHITECT 48 HOURS PRIOR TO COMMENCEMENT OF WORK TO COORDINATE PROJECT INSPECTION SCHEDULES. ALL MATERIAL SHALL BE MAINTAINED IN A HEALTHY AND GROWING CONDITION, AND MUST BE REPLACED WITH PLANT MATERIAL OF SIMILAR VARIETY AND SIZE IF DAMAGED, DESTROYED, OR REMOVED.
- 6) LAWN INSTALLATION- PRIOR TO APPLICATION OF HYDROMULCH OR SOD, THE CONTRACTOR SHALL APPLY CONTACT HERBICIDE (RECOMMENDED MIXTURE OF IFRAGE AND ROUNDUP) TO REMOVE ALL EXISTING WEEDS AS NECESSARY, AND SCARIFY EXISTING SOIL TO SPECIFIED DEPTHS. REMOVE ALL LIMPS, CLODS, TRASH AND STICKS GREATER THAN 1". FINE GRADE TO PROVIDE POSITIVE DRAINAGE AND SMOOTH LAWN AREAS AND CUT SHALES AS NECESSARY TO ENSURE NO PONDING OF WATER. FINISHED GRADE OF LAWN AND PLANTING BED AREAS TO BE MINIMUM 1/2" BELOW FINISHED GRADE OF ADJACENT PAVEMENT.
- 7) ALL QUANTITIES ON THIS PLAN ARE FOR INFORMATION ONLY (PLANT SPACING IS AS INDICATED ON PLANT SCHEDULE UNLESS OTHERWISE NOTED). IT IS THE CONTRACTOR'S RESPONSIBILITY TO PROVIDE FULL COVERAGE IN ALL PLANTING AREAS AS SPECIFIED IN THE PLANT SCHEDULE REMARKS.
- 8) THE CONTRACTOR SHALL PROVIDE THE SOILS TESTING LAB SOIL SAMPLES. A MINIMUM OF TWO SAMPLES FROM EACH DIFFERENT SOIL AREA AND FROM EACH IMPORT SOIL SOURCE IS REQUIRED. VERIFY APPROPRIATE QUANTITY OF SAMPLES WITH THE LANDSCAPE ARCHITECT AND AGRONOMIST. SAMPLES SHALL THEN BE TESTED AND ANALYZED FOR AGRICULTURAL SUITABILITY AND FERTILITY BY AN ACCREDITED SOIL TESTING LABORATORY. ANALYSIS SHALL INCLUDE REVIEW AND COORDINATION WITH SPECIFICATIONS AND RECOMMENDATIONS FOR SOIL PREPARATION AND BACKFILL MIX. SUBMIT SOILS ANALYSES TO LANDSCAPE ARCHITECT FOR APPROVAL PRIOR TO SOIL PREPARATION. THIS REQUIREMENT APPLIES TO ALL SOILS AND CONDITIONS WITHIN THIS PROJECT INCLUDING IMPORT SOILS, AND ON GRADE SOILS. REFER TO SPECIFICATIONS.
- 9) THE CONTRACTOR SHALL APPLY RECOMMENDED PRE-EMERGENT HERBICIDE FOR PREVENTION OF NUTGRASS AND WEEDS UPON ESTABLISHMENT OF BERMUDA LAWN APPROXIMATELY ONE MONTH AFTER HYDROMULCH APPLICATION. FERTILIZE AT SPECIFIED RATES MONTHLY DURING 90 DAY MAINTENANCE PERIOD.

GENERAL LANDSCAPE NOTES:

- 1) THE CONTRACTOR SHALL BE FAMILIAR WITH EXISTING SITE CONDITIONS AND UNDERGROUND UTILITIES, SMALL PIPES AND STRUCTURES. THE CONTRACTOR SHALL TAKE SOLE RESPONSIBILITY FOR ANY COST INCURRED DUE TO BODILY INJURY AND/OR DAMAGE TO OWNER'S PROPERTY OR SAID UTILITIES. THE CONTRACTOR IS RESPONSIBLE FOR CONTACTING UTILITY COMPANIES BEFORE EXCAVATION.
- 2) THE CONTRACTOR SHALL LOCATE AND VERIFY THE CONDITION OF UTILITIES PRIOR TO ANY EXCAVATION. EXTREME CARE SHALL BE EXERCISED IN EXCAVATING AND WORKING NEAR EXISTING UTILITIES. THE CONTRACTOR SHALL HAND DIG PLANTING PITS AND HAND RAKE LAWN AREAS AS REQUIRED.
- 3) ALL CONFLICTING INFORMATION SHALL BE BROUGHT TO THE ATTENTION OF THE LANDSCAPE ARCHITECT.
- 4) THE CONTRACTOR SHALL NOT HASTILY PROCEED WITH CONSTRUCTION AS DESIGNED WHEN OBSTRUCTIONS AND/OR GRADE DIFFERENCES EXIST THAT MAY HAVE NOT BEEN KNOWN DURING DESIGN. SUCH CONDITIONS SHALL BE IMMEDIATELY BROUGHT TO THE ATTENTION OF THE LANDSCAPE ARCHITECT. THE CONTRACTOR SHALL ASSUME FULL RESPONSIBILITY FOR ALL NECESSARY REVISIONS DUE TO FAILURE TO GIVE SUCH NOTIFICATION.
- 5) THE CONTRACTOR SHALL BE RESPONSIBLE FOR ALL COORDINATION WITH HIS SUBCONTRACTORS TO ACCOMPLISH HIS SCOPE OF WORK. THE CONTRACTOR SHALL COORDINATE WITH OTHER TRADES WORKING ON THE SITE SIMULTANEOUSLY.
- 6) THE CONTRACTOR SHALL NOTIFY THE OWNER AND LANDSCAPE ARCHITECT 48 HOURS PRIOR TO THE COMMENCEMENT OF WORK TO COORDINATE PROJECT INSPECTION SCHEDULES.
- 7) THE CONTRACTOR SHALL BE RESPONSIBLE FOR FIELD VERIFICATION OF EXISTING CONDITIONS, AND SHALL PERFORM FIELD MEASUREMENTS PRIOR TO FABRICATION AND/OR PURCHASE OF ANY MATERIAL. THE CONTRACTOR SHALL CONTACT THE LANDSCAPE ARCHITECT SHOULD EXISTING CONDITIONS BE DIFFERENT FROM THE DESIGN DRAWINGS FOR THIS PROJECT. ALL CONFLICTS ARISING DUE TO LACK OF COORDINATION SHALL BE THE RESPONSIBILITY AND EXPENSE OF THE CONTRACTOR.
- 8) ANY REQUIRED CHANGES TO THE DRAWINGS RESULTING FROM THE ACCEPTANCE OF THE CONTRACTOR'S ALTERNATES AND/OR SUBSTITUTIONS ARE THE RESPONSIBILITY OF THE CONTRACTOR AND SHALL BE SUBMITTED TO THE LANDSCAPE ARCHITECT AND THE OWNER FOR APPROVAL.
- 9) THE CONTRACTOR SHALL COORDINATE THE STORAGE OF MATERIALS, PARKING OF VEHICLES AND RESTRICTIONS OF WORK AND ACCESS WITH THE OWNER. UNDER NO CIRCUMSTANCES SHALL ANY CONTRACTOR STORE MATERIALS OR PARK VEHICLES UNDER THE CANOPY OF EXISTING TREES.
- 10) THE CONTRACTOR SHALL COMPLY WITH ALL APPLICABLE FEDERAL, STATE AND LOCAL LAWS, ORDINANCES & CODE REQUIREMENTS. REQUIRED PERMITS SHALL BE OBTAINED BY THE CONTRACTOR.
- 11) THE CONTRACTOR SHALL PROVIDE UNIT PRICES BASED UPON THE QUANTITIES SHOWN WITHIN THE DOCUMENTS. FIELD CONDITIONS MAY REVISE ACTUAL LOCATION, INCREASING OR DECREASING THE EXTENT OF WORK PERFORMED. CHANGES TO THE EXTENT OF WORK RESULTING IN AN INCREASE OR DECREASE WILL BE BASED ON UNIT PRICES AND PERFORMED SUBJECT TO APPROVAL OF THE OWNER AND THE LANDSCAPE ARCHITECT IN THE FORM OF A CHANGE ORDER.
- 12) UNIT PRICES SHALL NOT ONLY INCLUDE THE COST OF THE ITEM BUT ALSO ALL LABOR, EQUIPMENT, AND OTHER MATERIALS (I.E. BACKFILL MIX, MULCH, STEEL EDGING, ETC.) ASSOCIATED WITH AND NECESSARY TO DELIVER THE ITEM COMPLETE AS DOCUMENTED IN THE DRAWINGS AND SPECIFICATIONS.
- 13) THE CONTRACTOR SHALL PROVIDE ALL LABOR, MATERIALS AND SUPERVISION NECESSARY TO ACCOMPLISH THE WORK AS SHOWN AND NOTED ON THE DRAWINGS, UNLESS OTHERWISE NOTED.
- 14) ALL CONTRACTORS AND SUBCONTRACTORS ARE RESPONSIBLE FOR REMOVAL OF TRASH AND REPAIR OF HAZARDOUS CONDITIONS (I.E. TOOLS, OPEN HOLES, ETC.) ON A DAILY BASIS BY END OF WORK DAY.
- 15) UPON COMPLETION OF CONSTRUCTION AND PRIOR TO FINAL APPROVAL, THE CONTRACTOR SHALL THOROUGHLY CLEAN UP THE PROJECT SITE OF ALL TRASH, SCRAPS, BRICK, ROCKS, MORTAR, ETC. REPAIR ALL DAMAGE TO FINISH GRADE INCLUDING TAILINGS FROM EXCAVATIONS, WHEEL RUTS OR ANY SETTLING OR EROSION OCCURRING PRIOR TO COMPLETION.



NO.	REVISION	BY	DATE
TOWN OF ADDISON DALLAS COUNTY, TEXAS SPRING VALLEY ROAD LANDSCAPE DETAILS AND NOTES			
PROJECT	DESIGN	DRAWN	DATE
DIVISION	MT	SA	JULY 200
FILE	SHEET		
	LP 22		

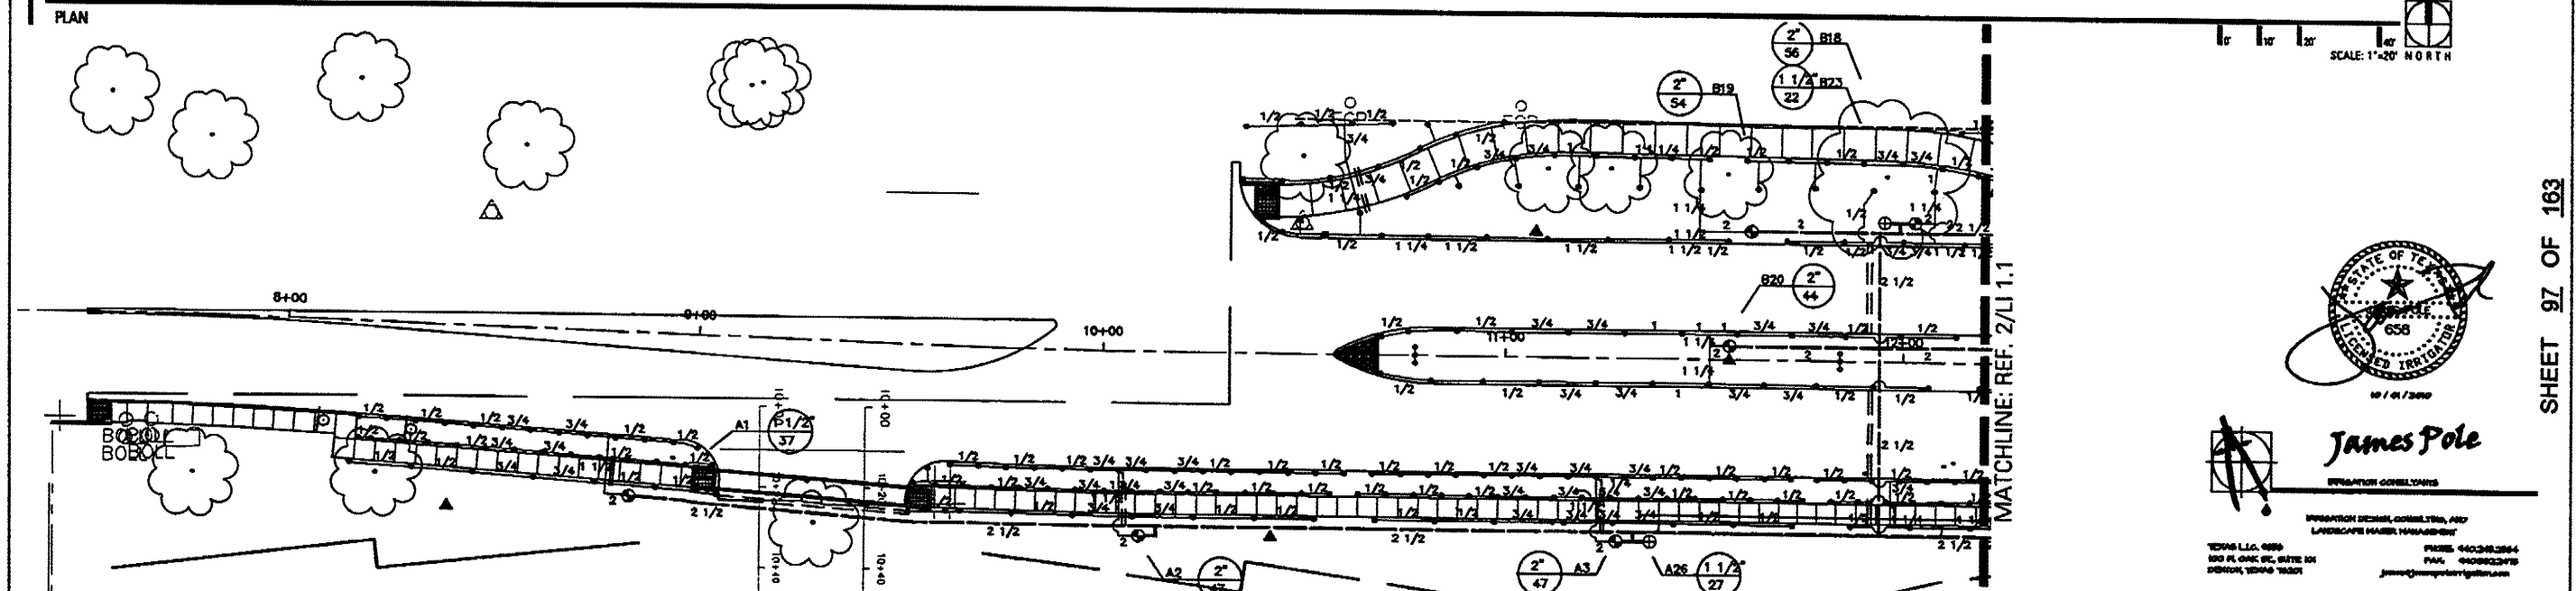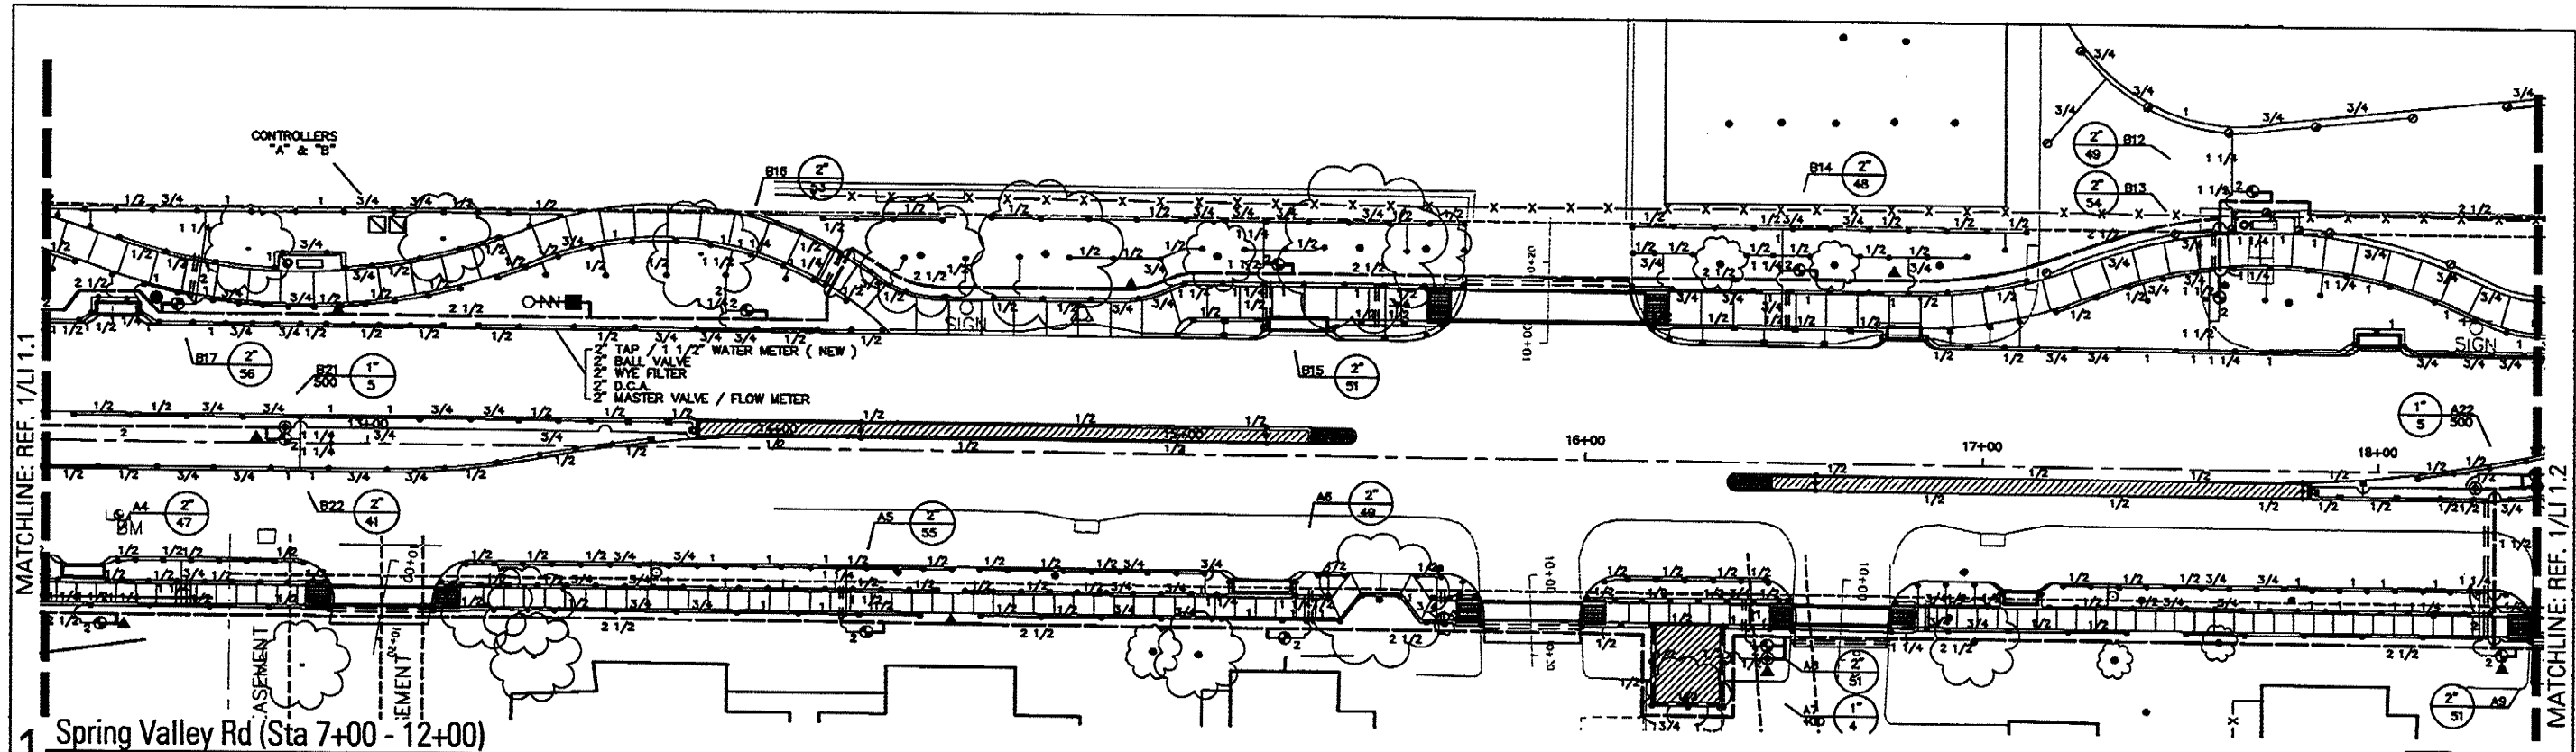

Spring Valley Rd (Sta 7+00 - 12+00)

PLAN

L.I.C. SHALL SELECT MPR SERIES SPRAY NOZZLES FOR "HEAD-TO-HEAD" COVERAGE, ADJUSTED FOR NO OVSERSPRAY ONTO WALLS AND WALKS. NO OVSERSPRAY INTO STREETS IS PERMITTED.

<ul style="list-style-type: none"> □ RAINBIRD 1804-PRS SERIES POP UP SPRAY HEADS WITH HUNTER PCH-50 BUBBLER NOZZLES. (TWO PER TREE) SEE INSTALLATION NOTE #13 REGARDING TREE BUBBLER LATERAL PIPE ● RAINBIRD 1804-PRS SERIES POP UP SPRAY HEAD WITH SS / ES SERIES STRIP NOZZLE UNLESS NOTED OTHERWISE. ● RAINBIRD 1804-PRS SERIES POP UP SPRAY HEAD WITH MPR SERIES NOZZLE AS NOTED BELOW ▨ NETAFIM TECHLINE CV SERIES DRIP TUBE IN SHRUB BED INSTALLED AT 2" DEPTH SEE INSTALLATION NOTE #16 REGARDING DRIP TUBE LAYOUT IN SHRUB BEDS. ○ HUNTER 1-20 4" POP UP ROTARY HEAD, PART CIRCLE, #2.0 NOZZLE UNLESS NOTED OTHERWISE ○ HUNTER 1-20 4" POP UP ROTARY HEAD, PART CIRCLE, #3.0 BLUE NOZZLE UNLESS NOTED OTHERWISE ○ HUNTER 1-20 4" POP UP ROTARY HEAD, FULL CIRCLE, #6.0 BLUE NOZZLE UNLESS NOTED OTHERWISE ⊕ IRRITROL 200 B SERIES ELECTRIC REMOTE CONTROL VALVE, WITH SAME SIZE PVC BALL VALVE ⊕ IRRITROL 200 B SERIES ELECTRIC REMOTE CONTROL, "TREE BUBBLER ZONE" VALVE WITH SAME SIZE PVC BALL VALVE SEE INSTALLATION NOTE #13 REGARDING TREE BUBBLER LATERAL PIPE ⊕ IRRITROL 200 B SERIES ELECTRIC REMOTE CONTROL VALVE WITH SAME SIZE PVC BALL VALVE, OMNI-REG PRESSURE REGULATOR AND SAME SIZE NETAFIM DISK FILTER (120 MESH) - FOR "DRIP" ZONES. SET REGULATOR AT 30 P.S.I. 	<p>LEGEND</p> <ul style="list-style-type: none"> ▲ BUCKNER V075 QUICK COUPLING VALVE WITH LOCKING PURPLE COVER AND 3/4" PVC BALL VALVE ⊕ SPEARS T-HANDLE PVC BALL VALVE, LOCATED EVERY 200 LINEAR FEET ALONG MAINLINE PIPE. ⊕ WATTS 007 SERIES D.C.A. INSTALLED PER CITY CODE, WITH SAME SIZE WILKINS 850 SERIES BRONZE BALL VALVE AND WILKINS YB SERIES BRONZE WYE FILTER WITH 20 MESH STAINLESS STEEL SCREEN ⊕ DATA INDUSTRIAL FLOW METER AND IRRITROL 200 B SERIES ELECTRIC MASTER VALVE. ○ IRRIGATION WATER METER AND TAP, SIZE AS NOTED ON THE PLAN ⊕ RAINMASTER 30 STATION EVOLUTION DX-2 PEDESTAL MOUNT CONTROLLER WITH 36" x 36" x 6" CONCRETE BASE PAD AND MINI-CLIK RAIN / FREEZE SENSOR. LOCATE SENSOR AS FIELD DIRECTED BY THE LANDSCAPE ARCHITECT REFERENCE SHEET LI.4 FOR ADDITIONAL SPECIFICATIONS FOR IRRIGATION CONTROLLERS — PVC MAINLINE PIPE: 2" AND SMALLER SHALL BE SCH. 40 2 1/2" SIZE AND LARGER SHALL BE CLASS 200. — CLASS 200 (EXCEPT 1/2 INCH #315) PVC LATERAL PIPE — ONE 2" SCH. 40 SLEEVE PIPE WITH ONE 4" CLASS 200 PVC SLEEVE PIPE UNLESS NOTED OTHERWISE
--	--

James Pole
PROFESSIONAL ENGINEER

IRRIGATION DESIGN, CONSULTING, AND
LANDSCAPE MAINTENANCE

TEMPLE LLC, 6800
500 N. OAK ST., SUITE 101
DENTON, TEXAS 76201

PHONE: 843.682.3864
FAX: 843.682.3865
j.pole@jamespoleengineer.com

NO.	REVISION	BY	DATE

TOWN OF ADDISON
DALLAS COUNTY, TEXAS

SPRING VALLEY ROAD


LANDSCAPE IRRIGATION PLAN

PROJECT	DESIGN	DRAWN	DATE	FILE	SHEET
D10408	JP	JP	OCTOBER 2009		LI 1.1

Z:\bgs\spring_valley_road_addison_c6104381\04_c6104381\04_1111e.dwg

SHEET 97 OF 163

2:\tblg\spring valley road addison (1014318)04.cdw\wp-k\1310438-111e.dwg

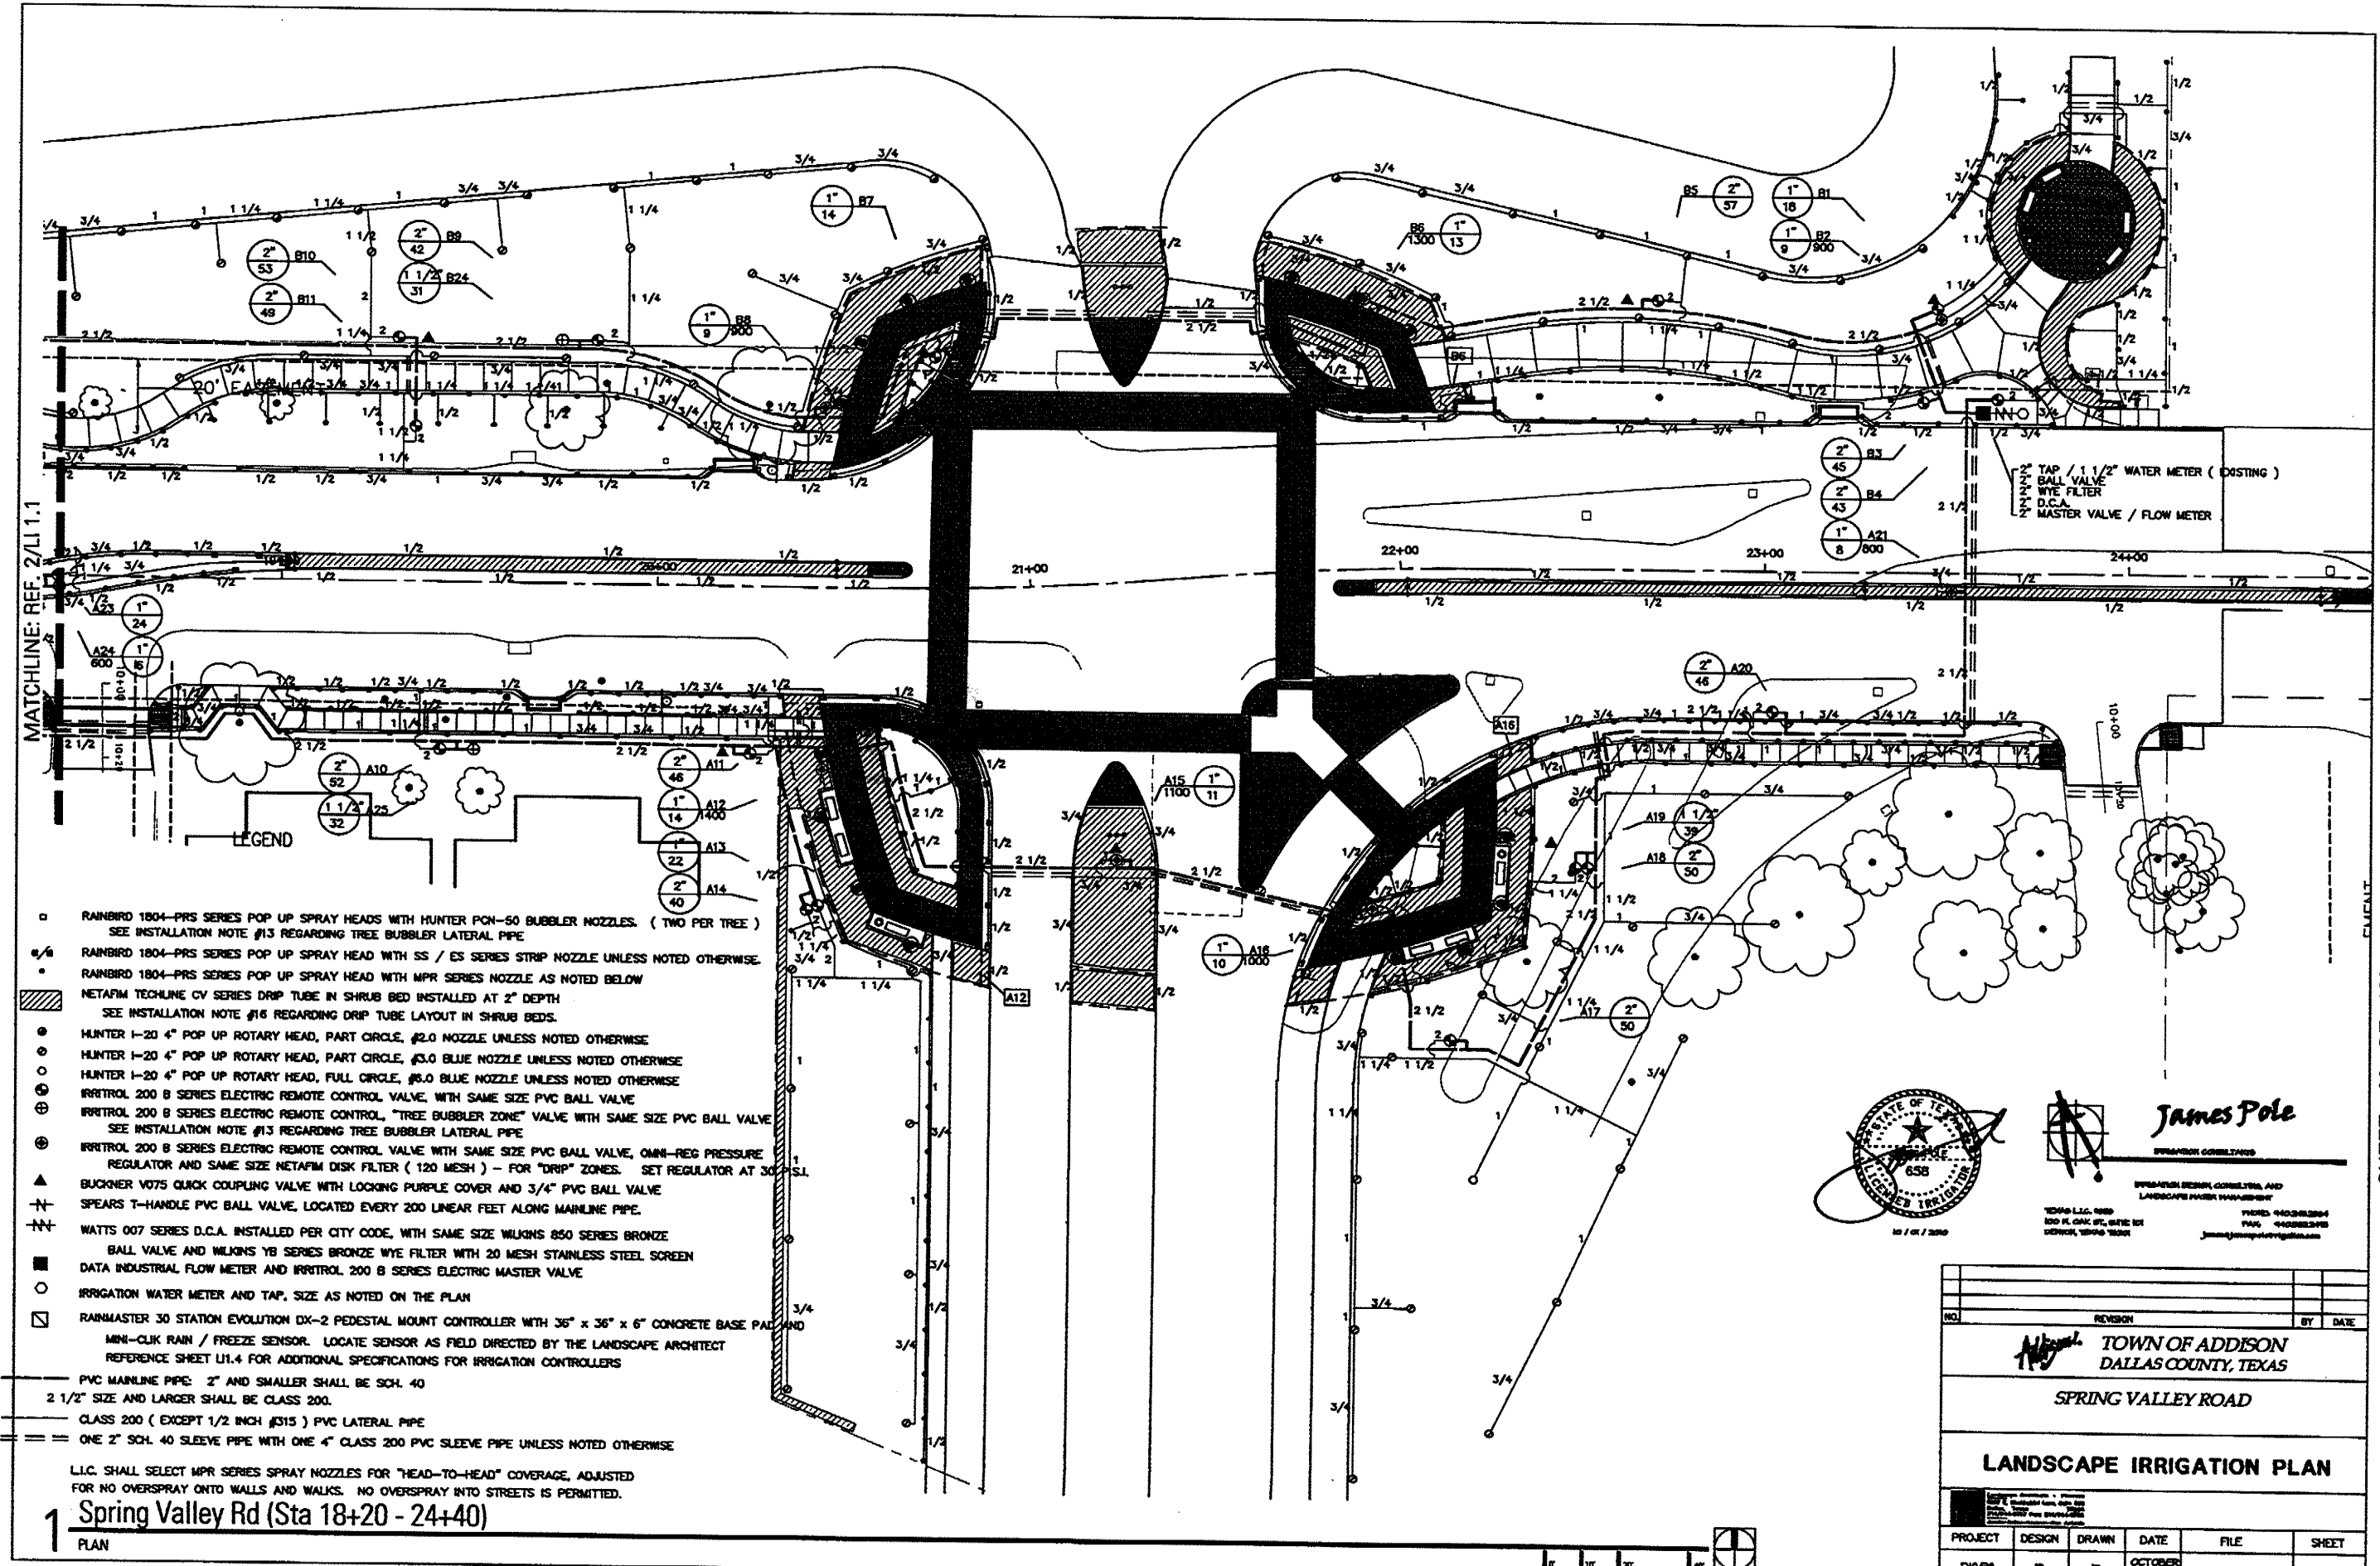

MATCHLINE: REF. 2/LI 1.1

- RAINBIRD 1804-PRS SERIES POP UP SPRAY HEADS WITH HUNTER PON-50 BUBBLER NOZZLES. (TWO PER TREE)
SEE INSTALLATION NOTE #13 REGARDING TREE BUBBLER LATERAL PIPE
- RAINBIRD 1804-PRS SERIES POP UP SPRAY HEAD WITH SS / ES SERIES STRIP NOZZLE UNLESS NOTED OTHERWISE.
- RAINBIRD 1804-PRS SERIES POP UP SPRAY HEAD WITH MPR SERIES NOZZLE AS NOTED BELOW
- ▨ NETAFIM TECHLINE CV SERIES DRIP TUBE IN SHRUB BED INSTALLED AT 2" DEPTH
SEE INSTALLATION NOTE #16 REGARDING DRIP TUBE LAYOUT IN SHRUB BEDS.
- HUNTER 1-20 4" POP UP ROTARY HEAD, PART CIRCLE, #2.0 NOZZLE UNLESS NOTED OTHERWISE
- HUNTER 1-20 4" POP UP ROTARY HEAD, PART CIRCLE, #3.0 BLUE NOZZLE UNLESS NOTED OTHERWISE
- HUNTER 1-20 4" POP UP ROTARY HEAD, FULL CIRCLE, #6.0 BLUE NOZZLE UNLESS NOTED OTHERWISE
- ⊕ IRRITROL 200 B SERIES ELECTRIC REMOTE CONTROL VALVE, WITH SAME SIZE PVC BALL VALVE
SEE INSTALLATION NOTE #13 REGARDING TREE BUBBLER LATERAL PIPE
- ⊕ IRRITROL 200 B SERIES ELECTRIC REMOTE CONTROL VALVE WITH SAME SIZE PVC BALL VALVE, OMNI-REG PRESSURE
REGULATOR AND SAME SIZE NETAFIM DISK FILTER (120 MESH) - FOR "DRIP" ZONES. SET REGULATOR AT 30 PSI.
- ▲ BUCKNER V075 QUICK COUPLING VALVE WITH LOCKING PURPLE COVER AND 3/4" PVC BALL VALVE
- ⊕ SPEARS T-HANDLE PVC BALL VALVE, LOCATED EVERY 200 LINEAR FEET ALONG MAINLINE PIPE.
- ⊕ WATTS 007 SERIES D.C.A. INSTALLED PER CITY CODE, WITH SAME SIZE WILKINS 850 SERIES BRONZE
BALL VALVE AND WILKINS YB SERIES BRONZE WYE FILTER WITH 20 MESH STAINLESS STEEL SCREEN
- DATA INDUSTRIAL FLOW METER AND IRRITROL 200 B SERIES ELECTRIC MASTER VALVE
- IRRIGATION WATER METER AND TAP, SIZE AS NOTED ON THE PLAN
- ☑ RAINMASTER 30 STATION EVOLUTION DX-2 PEDESTAL MOUNT CONTROLLER WITH 36" x 36" x 6" CONCRETE BASE PAD AND
MINI-CLICK RAIN / FREEZE SENSOR. LOCATE SENSOR AS FIELD DIRECTED BY THE LANDSCAPE ARCHITECT
REFERENCE SHEET LI1.4 FOR ADDITIONAL SPECIFICATIONS FOR IRRIGATION CONTROLLERS
- PVC MAINLINE PIPE: 2" AND SMALLER SHALL BE SCH. 40
2 1/2" SIZE AND LARGER SHALL BE CLASS 200.
- CLASS 200 (EXCEPT 1/2 INCH #315) PVC LATERAL PIPE
- ONE 2" SCH. 40 SLEEVE PIPE WITH ONE 4" CLASS 200 PVC SLEEVE PIPE UNLESS NOTED OTHERWISE


L.I.C. SHALL SELECT MPR SERIES SPRAY NOZZLES FOR "HEAD-TO-HEAD" COVERAGE, ADJUSTED FOR NO OVERSPRAY ONTO WALLS AND WALKS. NO OVERSPRAY INTO STREETS IS PERMITTED.

1 Spring Valley Rd (Sta 18+20 - 24+40)

PLAN

2" TAP / 1 1/2" WATER METER (COASTING)
2" BALL VALVE
2" WYE FILTER
2" D.C.A.
2" MASTER VALVE / FLOW METER

LEGEND

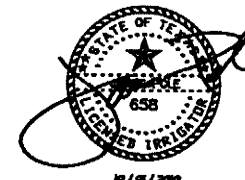

James Pole
PROFESSIONAL ENGINEER
CREATION DESIGN CONSULTING AND
LANDSCAPE PAPER MANAGEMENT
15000 L.L. WEBB
500 W. GARCIA ST. SUITE 101
DALLAS, TEXAS 75244
PHONE: 940.383.8344
FAX: 940.383.8345
j.pole@creationdesign.com

NO.	REVISION	BY	DATE


TOWN OF ADDISON
DALLAS COUNTY, TEXAS

SPRING VALLEY ROAD

LANDSCAPE IRRIGATION PLAN

PROJECT	DESIGN	DRAWN	DATE	FILE	SHEET
D10-88	JP	JP	OCTOBER 2000		LI 12





SHEET 98 OF 163

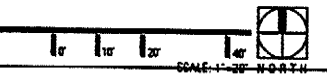

INSTALLATION NOTES

L.I.C. SHALL REFER TO AND FOLLOW THE TOWN OF ADDISON IRRIGATION REQUIREMENTS, REVISED 04 / 29 / 2010

- COORDINATE IRRIGATION INSTALLATION WITH PLANTING PLAN AND SITE CONDITIONS TO PROVIDE COMPLETE COVERAGE WITH MINIMUM OVERSPRAY. THE IRRIGATION CONTRACTOR SHALL MAKE MINOR ADJUSTMENTS TO ENSURE PROPER COVERAGE AT NO ADDITIONAL COST TO THE OWNER.
- THE IRRIGATION CONTRACTOR SHALL COMPLY WITH ALL LOCAL AND STATE MANDATED IRRIGATION ORDINANCES AND CODES, AND WILL SECURE ALL REQUIRED PERMITS. L.I.C. SHALL PAY ANY ASSOCIATED FEES UNLESS OTHERWISE NOTED. ALL LOCAL CODES SHALL PREVAIL OVER ANY DISCREPANCIES HEREIN AND SHALL BE ADDRESSED BEFORE ANY CONSTRUCTION BEGINS.
- CONFIRM MINIMUM STATIC WATER PRESSURE OF 60 PSI AT THE HIGHEST ELEVATION OF THE SYSTEM LIMITS, AND MAXIMUM STATIC WATER PRESSURE OF 90 P.S.I. AT THE LOWEST ELEVATION OF THE SYSTEM LIMITS AT LEAST 7 DAYS BEFORE BEGINNING WORK. IF STATIC WATER PRESSURE IS OUTSIDE THE RANGE STATED ABOVE, DO NOT PROCEED UNTIL DIRECTED BY THE LANDSCAPE ARCHITECT.
- LATERAL PIPE SHALL BE INSTALLED AT A MINIMUM DEPTH OF 12 INCHES. MAINLINE PIPE AND WIRES SHALL BE INSTALLED AT A MINIMUM DEPTH OF 18 INCHES. NO MACHINE TRENCHING SHALL BE PERMITTED WITHIN EXISTING TREE ROOT ZONES. WHEN HAND - TRENCHING WITHIN EXISTING TREE ROOT ZONES, NO ROOTS LARGER THAN 1" DIAMETER SHALL BE CUT.
- UNSLEEVED PIPES MAY BE SHOWN UNDER PAVEMENT FOR GRAPHIC CLARITY ONLY. INSTALL THESE PIPES IN ADJACENT LANDSCAPED AREAS.
- ELECTRIC POWER, AND DATA PHONE LINE SHALL BE PROVIDED WITHIN FIVE FEET OF CONTROLLER LOCATION BY GENERAL CONTRACTOR. L.I.C. TO PROVIDE FINAL HARD-WIRE CONNECTIONS TO CONTROLLERS.
- 24 VOLT VALVE WIRE SHALL BE A MINIMUM OF #14 GAUGE, U.F. APPROVED FOR DIRECT BURIAL, SINGLE CONDUCTOR "IRRIGATION WIRE". WIRE SPLICES SHALL INCLUDE DBY CONNECTORS AS MANUFACTURED BY 3M COMPANY. ALL FIELD SPLICES SHALL BE LOCATED IN A ROUND VALVE BOX OF SUFFICIENT SIZE TO ALLOW INSPECTION.
- VALVE BOXES SHALL BE INSTALLED FLUSH WITH GRADE, SUPPORTED BY BRICKS IF NEEDED, WITH 3 INCHES OF CLEAN PEA GRAVEL LOCATED BELOW THE VALVE. USE 12" x 17" RECTANGULAR VALVE BOXES FOR QUICK COUPLERS AND FOR ALL ELECTRIC VALVES.
D.C.A., WITH UPSTREAM BALL VALVE AND WYE FILTER SHALL BE BOXED AND LOCATED ACCORDING TO LOCAL CODE.
- USE RIGID SCH. 80 PVC SWING JOINT ASSEMBLIES TO CONNECT ALL ROTARY HEADS AND QUICK COUPLERS.
- ALL SPRAY HEADS SHALL BE CONNECTED WITH A 6" LENGTH 1/2" POLY. NIPPLE. ALL ROTARY HEADS SHALL BE CONNECTED WITH A 6" LENGTH 3/4" POLY. NIPPLE.
- PROVIDE ONE QUICK COUPLER KEY WITH SWIVEL HOSE ELL FOR EVERY SIX Q.C. VALVES. (MINIMUM ONE SET).
- CONTRACTOR IS TO CONTACT APPROPRIATE AUTHORITIES AND LOCATE ALL UTILITIES PRIOR TO CONSTRUCTION.
- LATERAL PIPE TO TREE STREAM BUBBLER HEADS IS OMITTED FOR GRAPHIC CLARITY. CONNECT TREE BUBBLER HEADS TO VALVES AS SHOWN WITH CLASS 200 PVC PIPE SIZED TO ALLOW A MAXIMUM FLOW VELOCITY OF 5 FEET PER SECOND
- THE PROPOSED LOCATIONS OF ALL ABOVE- GROUND EQUIPMENT INCLUDING BACKFLOW PREVENTORS, CONTROLLERS AND WEATHER SENSORS SHALL BE STAKED BY THE CONTRACTOR FOR APPROVAL BY THE LANDSCAPE ARCHITECT OR OWNER'S REPRESENTATIVE BEFORE THESE ITEMS ARE INSTALLED.
- ALL HEADS SHALL BE INSTALLED A MINIMUM OF 4" FROM PAVEMENT EDGES.
FINAL HEAD ADJUSTMENTS BY THE CONTRACTOR SHALL INCLUDE THE ADDITION OF CHECK VALVES WHERE NEEDED TO PREVENT EXCESSIVE LOW HEAD DRAINAGE. THE CONTRACTOR SHALL BUDGET FOR, AND INSTALL, CHECK VALVES FOR UP TO 10% OF THE TOTAL NUMBER OF HEADS WHEN NEEDED, WITH NO ADDITIONAL COST TO THE OWNER.
- WHERE SHOWN ON THE PLANS, MASS SHRUB / GROUNDCOVER BEDS SHALL INCLUDE NETAFIM TECHLINE CV SERIES DRIP TUBE WITH PRE-INSTALLED .9 GPH DRIP EMITTERS AT 12" INTERVALS (TLCV-12), INSTALLED IN CENTER-FED GRIDS WITH ROWS SPACED 12" APART. INDIVIDUAL DRIP TUBE RUNS SHALL NOT EXCEED 150 L.F.. PVC LATERAL "TRUNK" LINES SHALL BE INSTALLED 10" DEEP. DRIP TUBE SHALL BE SET 2" BELOW FINISHED SOIL GRADE (NOT INCLUDING MULCH LAYER), SECURELY STAKED EVERY 18". NETAFIM #TLOSOMFY-1 FLUSH VALVES SHALL BE INSTALLED AT THE FARTHEST POINTS FROM THE ZONE VALVE. USE 17 MM BARBED FITTINGS FOR DRIP LINE CONNECTIONS, SET THE MAXIMUM OPERATING PRESSURE AT 30 PSI. TECHLINE CV SHALL BE INSTALLED PERPENDICULAR TO SLOPE FACE. INSTALL TLCV IN-LINE CHECK VALVES FOR EVERY 4.5 FEET OF DRIP LINE ELEVATION CHANGE WITHIN THE ZONE. USE NETAFIM STAPLES (#TLSB) TO SECURE TUBING EVERY 18" EACH DRIP ZONE SHALL INCLUDE ONE MAINTENANCE "FLAG" WHICH SHALL CONSIST OF A 12" POP-UP SPRAY HEAD AND COMPLETELY CLOSED SPRAY NOZZLE. THE POP-UP HEAD SHALL BE CONNECTED TO THE DRIP ZONE PIPE, SET FLUSH WITH GRADE, AND LOCATED AT THE FARTHEST DISTANCE FROM THE DRIP VALVE ASSEMBLY. INSTALL THE "FLAG" HEAD ADJACENT TO EDGING OR IN LOW PLANTINGS FOR EASE OF VIEWING.

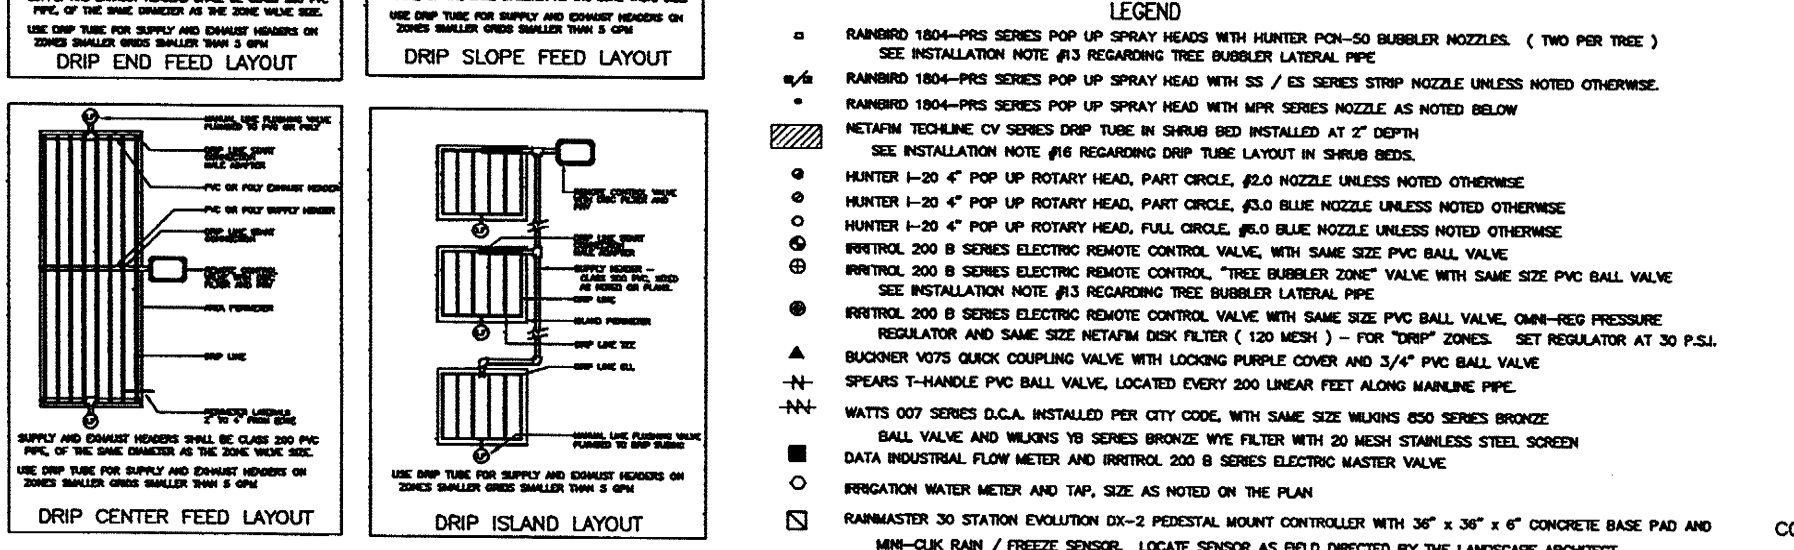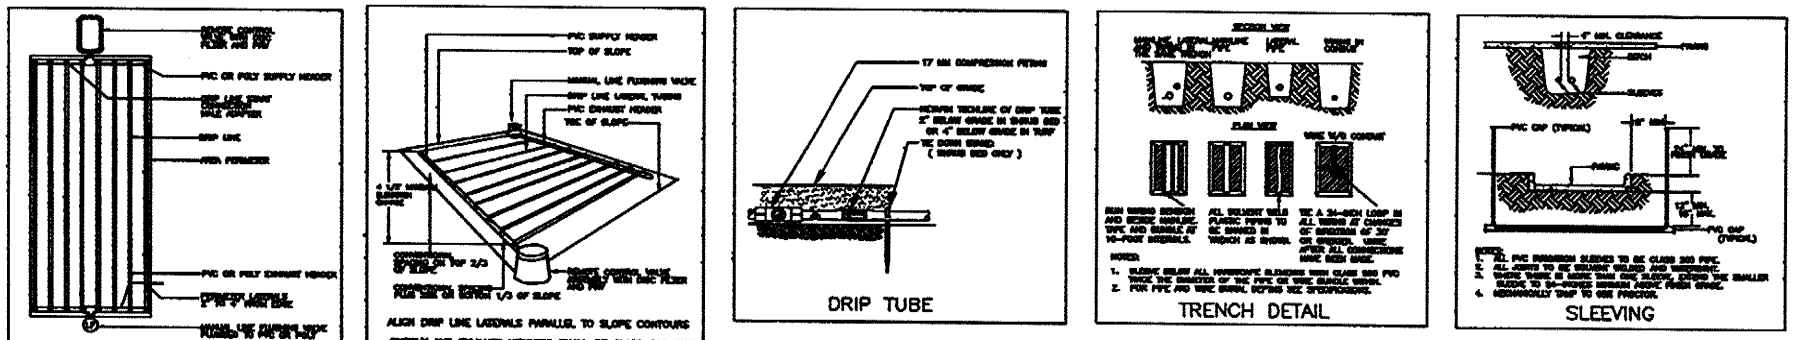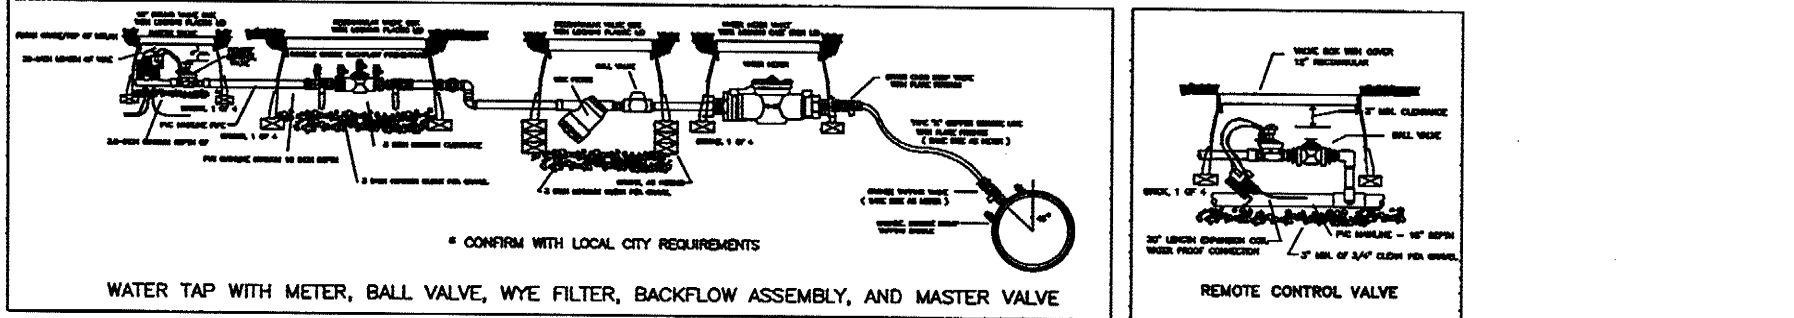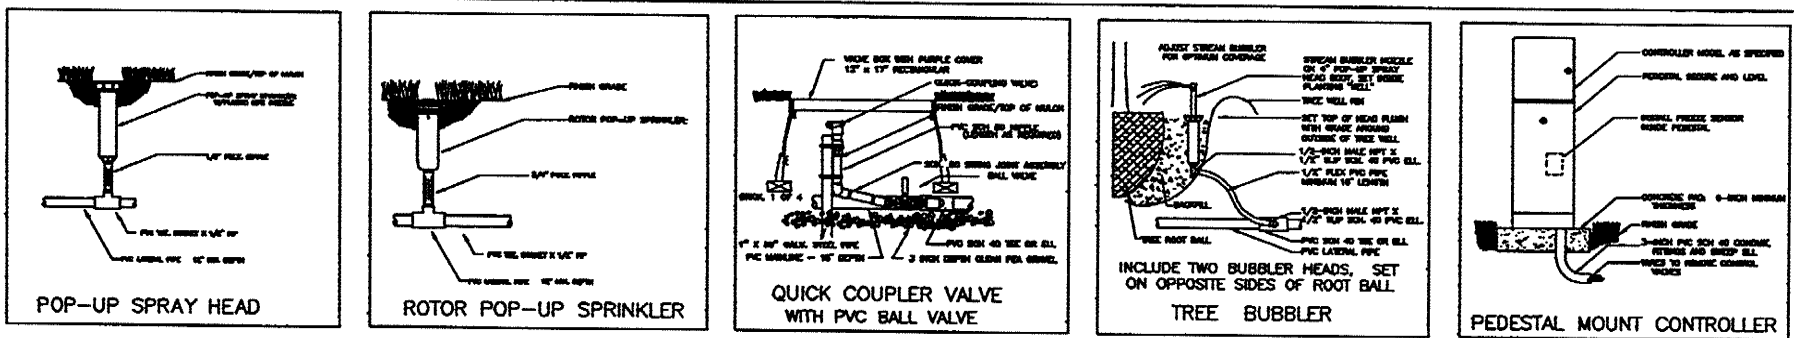


LEGEND

- ◻ RAINBIRD 1804-PRS SERIES POP UP SPRAY HEADS WITH HUNTER PON-50 BUBBLER NOZZLES. (TWO PER TREE)
SEE INSTALLATION NOTE #13 REGARDING TREE BUBBLER LATERAL PIPE
- ◻ RAINBIRD 1804-PRS SERIES POP UP SPRAY HEAD WITH SS / ES SERIES STRIP NOZZLE UNLESS NOTED OTHERWISE.
- ◻ RAINBIRD 1804-PRS SERIES POP UP SPRAY HEAD WITH MPR SERIES NOZZLE AS NOTED BELOW
- ▨ NETAFIM TECHLINE CV SERIES DRIP TUBE IN SHRUB BED INSTALLED AT 2" DEPTH
SEE INSTALLATION NOTE #16 REGARDING DRIP TUBE LAYOUT IN SHRUB BEDS.
- ⊙ HUNTER 1-20 4" POP UP ROTARY HEAD, PART CIRCLE, #2.0 NOZZLE UNLESS NOTED OTHERWISE
- ⊙ HUNTER 1-20 4" POP UP ROTARY HEAD, PART CIRCLE, #3.0 BLUE NOZZLE UNLESS NOTED OTHERWISE
- ⊙ HUNTER 1-20 4" POP UP ROTARY HEAD, FULL CIRCLE, #3.0 BLUE NOZZLE UNLESS NOTED OTHERWISE
- ⊕ IRRITROL 200 B SERIES ELECTRIC REMOTE CONTROL VALVE, WITH SAME SIZE PVC BALL VALVE
- ⊕ IRRITROL 200 B SERIES ELECTRIC REMOTE CONTROL, "TREE BUBBLER ZONE" VALVE WITH SAME SIZE PVC BALL VALVE
SEE INSTALLATION NOTE #13 REGARDING TREE BUBBLER LATERAL PIPE
- ⊕ IRRITROL 200 B SERIES ELECTRIC REMOTE CONTROL VALVE WITH SAME SIZE PVC BALL VALVE, OMNI-REG PRESSURE REGULATOR AND SAME SIZE NETAFIM DISK FILTER (120 MESH) - FOR "DRIP" ZONES. SET REGULATOR AT 30 P.S.I.
- ▲ BUCKNER V075 QUICK COUPLING VALVE WITH LOCKING PURPLE COVER AND 3/4" PVC BALL VALVE
- ⊕ SPEARS T-HANDLE PVC BALL VALVE, LOCATED EVERY 200 LINEAR FEET ALONG MAINLINE PIPE.
- ⊕ WATTS 007 SERIES D.C.A. INSTALLED PER CITY CODE, WITH SAME SIZE WILKINS 850 SERIES BRONZE BALL VALVE AND WILKINS Y8 SERIES BRONZE WYE FILTER WITH 20 MESH STAINLESS STEEL SCREEN
- DATA INDUSTRIAL FLOW METER AND IRRITROL 200 B SERIES ELECTRIC MASTER VALVE
- IRRIGATION WATER METER AND TAP, SIZE AS NOTED ON THE PLAN
- ⊕ RAINMASTER 30 STATION EVOLUTION DX-2 PEDESTAL MOUNT CONTROLLER WITH 36" x 36" x 6" CONCRETE BASE PAD AND MINI-CLIK RAIN / FREEZE SENSOR. LOCATE SENSOR AS FIELD DIRECTED BY THE LANDSCAPE ARCHITECT
REFERENCE SHEET U1.4 FOR ADDITIONAL SPECIFICATIONS FOR IRRIGATION CONTROLLERS
- PVC MAINLINE PIPE: 2" AND SMALLER SHALL BE SCH. 40
2 1/2" SIZE AND LARGER SHALL BE CLASS 200.
- CLASS 200 (EXCEPT 1/2 INCH #315) PVC LATERAL PIPE
- ONE 2" SCH. 40 SLEEVE PIPE WITH ONE 4" CLASS 200 PVC SLEEVE PIPE UNLESS NOTED OTHERWISE

L.I.C. SHALL SELECT MPR SERIES SPRAY NOZZLES FOR "HEAD-TO-HEAD" COVERAGE, ADJUSTED FOR NO OVERSPRAY ONTO WALLS AND WALKS. NO OVERSPRAY INTO STREETS IS PERMITTED.

CONTROLLER STATION

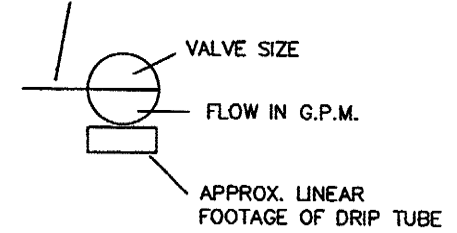

James Pole
IRRIGATION CONSULTING AND LANDSCAPE ARCHITECTURE
12040 L.L. LOOP
100 N. GARCIA ST. SUITE 101
DENVER, COLORADO 80202
PHONE: 402.241.2304
FAX: 402.241.2378
j.pole@jamespoleirrigation.com

NO.	REVISION	BY	DATE
TOWN OF ADDISON DALLAS COUNTY, TEXAS			
SPRING VALLEY ROAD			
LANDSCAPE IRRIGATION DETAILS AND NOTES			
PROJECT	DESIGN	DRAWN	DATE
DI0436	J.P.	J.P.	OCTOBER 2010
FILE	SHEET		
	LI 13		

Town of Addison Irrigation Specifications

Revised 04/29/10

These revised specifications supersede any and all others. However, any discrepancies between the approved construction plans and those of the Town **MUST** be brought to the attention of the Town's designated representative for a final determination. The contractor will present the Town's representative an as-built plan at the final walk-through, along with three Buckner V075 quick coupling keys with hose-end swivels.

1. All work is to be accomplished by or directly supervised at all times by an on-site Irrigator licensed by the State of Texas.

2. The contractor shall verify the water pressure before the installation begins. If the static pressure is different than that of the design pressure, contact the designer and Town's representative immediately so changes can be made. Send a fax to the Parks Dept. at 972-450-2834 with the current dated and timed static pressure reading. Design head to head with no single head coverage. Use appropriate size nozzles for a given landscape area so as not to spray onto or over paved surfaces or structures. Do not exceed manufacturer's recommendations.

3. The irrigation installer is responsible for resetting head and/or box height due to settling and after turf, groundcover, shrubs, trees, and mulch is added to the landscape areas. The irrigation contractor must supply a workmanship warranty for (1) year from date of acceptance.

4. Plans are diagrammatic and field adjustments are often necessary. For this reason, prior to trenching, valve locations and head layout with flags needs to be done and approved by the Town's irrigation inspector. Not doing so may result in the relocation of heads and/or valves at the irrigation contractor's expense.

5. Water Taps: Water taps will be 2" in size. **Note:** This does not imply that a 2" meter will be used; see Water Meters below. All parts must conform to the Town of Addison Water Department specifications and are the responsibility of the irrigation contractor to provide. Inspection of taps by the Water Department Representative **must** occur. Excavation and tap permits are required. Contact the Town of Addison Water Department at (972) 450-2871.

6. Water Meters: Only meter types approved by the Town of Addison Water Department with an electronic encoder register and touch pad reader and two (2) brass flanges are acceptable. Meter lay lengths must be in accordance with the Town of Addison Water Department's specifications, housed in appropriate size (to be determined by the Town's Irrigation Inspector) concrete box with lid. New stainless steel bolts and nuts must be used in the installation along with new neoprene gaskets. The box should be level with the final grade using concrete pavers to support and prevent sinking. Backfill inside the box, 3" below meter base with at least 6" of fine (1/2") pea gravel. Connection to main must be approved and inspected by the Town's Water Department Inspector and all tap materials are to be purchased at the expense of the contractor and must comply with the Town of Addison's specifications. **Note:** Meter size shall not exceed 1 1/2" in size unless written approval is given by the Town of Addison Parks Department. All portions of this installation must adhere to the Town of Addison Water Department specifications as well.

7. Backflow Devices: Only Watts 007 M series inline check valve assemblies with the stainless steel ball valve handles and nuts are to be used. Irrigation contractor shall provide and install plugs for the test cocks in accordance to the Town of Addison Water Department specifications. Connect the device to the water meter via a separate brass flange, neoprene gasket and stainless steel nuts and bolts. Install to the flange a Teflon taped copper nipple and soldered copper pipe of sufficient length to center the DCA within its housing. The device will be housed in an appropriate size, (to be determined by the Town's Irrigation Inspector) rectangular concrete box with lid using concrete pavers for proper stability and height adjustment. The irrigation contractor shall be responsible for the DCA testing in accordance with State of Texas law, using a Licensed Backflow Assembly Tester registered with the Town of Addison Water Department. Copies of the results must be given to both the Town of Addison Parks and Water Departments. **Note:** All portions of this installation must adhere to the Town of Addison Water Department specifications as well.

8. Sleeves: All paving must have Town approved sleeve sizes and quantities present. It is the responsibility of the irrigation contractor to notify the Town's Irrigation Inspector of any area where sleeves should be present but are not and provide such materials at his cost. Any paving installed without sleeves will necessitate a bore and subsequent

materials at the irrigation contractor's expense. All sleeves 2" and smaller will be Schedule 40 PVC with size and location noted on the plan. Larger sizes will be Class 200. All piping underneath paving, including sidewalks, must be sleeved. All sleeves are to be belled end PVC pipe. A minimum length of 12 inches of sleeve material must extend beyond the pavement.

9. Glue and Primer: Use Turfite brand glue on laterals and IPS Grey Heavy Body on main lines and a good quality purple primer on all. Avoid excessive use and wipe excess glue off of all joints and fittings with a clean rag.

10. Pipe: All main line pipe 2 inches and smaller is to be Schedule 40 belled PVC; larger sizes are to be Class 200 belled PVC with a minimum depth of 14" and a maximum depth of 16". Put not more than two (2) pipes in any one trench and separate the main line from the lateral line with at least two (2) inch of cover. Class 200 belled PVC lateral piping is to be used with a minimum depth of 12" and a maximum depth of 14".

11. Fittings: No crosses are permitted. Separate tees, 45's, elbows and other fittings by at least 12 inches. Reduction tees are preferred over use of single reducer bushings. Multiple reducer bushings will not be accepted. Only Spears and/or Lasco fittings are permitted. Allow 18 inches outside of sleeve before the first fitting. No 45 degree elbows on 1 inch and larger pipe are allowed.

12. Valves:
A. Master Valves: Every point of connection to the water supply system shall have an Irritrol 200 B series valve as the Master Valve, housed in a standard (large) Armor rectangular plastic valve box with 4 to 6 inches of small (1/2") pea gravel placed underneath the valve in such a manner as to prevent soil infiltration into the box. Use concrete pavers or bricks placed under edges of valve box for stability. **Note:** Valve box must not rest on pipe. Blue wire shall be used as the station wire for the Master Valve.

B. Station Valves: Only Irritrol 200 B series valves are permitted. A Ball Valve will be installed before every station or zone valve. They are to be located within a standard (large) Armor rectangular plastic valve boxes with 4 to 6 inches of (1/2") pea gravel placed underneath the valve in such a manner as to prevent soil infiltration into the box. The pea gravel should be 2 inches from the bottom of the valve body. A minimum of 3" of valve box must extend below bottom of valve. If necessary, use valve box extensions.

C. Ball Valves: Female threaded plastic Spears or Lasco ball valves with positive T-handle cut off must be installed on every 200 feet of mainline for isolation purposes. A ball valve is also required to be installed before every station valves. Use 10" Armor valve box with a minimum of 3" extending below bottom of valve and fill to bottom of valve with 1/2" pea gravel. Use bricks or concrete box.

D. Quick Coupler Valves: Use only Buckner V075 single lug 3/4" quick coupling valves with a metal top. They are to be connected to a threaded fitting. Teflon tape and appropriate length of gray schedule 80 nipples and schedule 40 fittings are to be used for the swing joint. Secure to 18 inch by 1/2 inch steel rebar with a stainless steel worm screw clamp. House QCV in a 10 inch round plastic Armor valve box. Install Spears ball valve prior to each QCV. Bricks or pavers need to be installed under edges of valve boxes for stability. Backfill bottom of box with 1/2" pea gravel half way up body of valve.

E. Flowmeters: Purchase from a Rain Master supplier and install appropriately sized Data Industrial flowmeter. Follow all installation instructions as approved by Rain Master. House in a standard (large) Armor rectangular plastic valve box with 4 to 6 inches of small (1/2") pea gravel placed underneath the valve in such a manner as to prevent soil infiltration into the box. Use concrete pavers or bricks placed under edges of valve box for stability. **Note:** Valve box must not rest on pipe. The irrigation contractor must also purchase from Rain Master and install shielded Rain Master EV-Cab-Sen flow meter cable and install within continuous 3/4" or larger gray PVC conduit with 6 inch or larger J-boxes placed every 200 feet or where 360 degrees of fittings are installed; only sweep fittings are permitted. Only a continuous run of cable is allowed; no splices will be allowed except at the point of connection to the flow meter. Connections at the flow meter must first be soldered and then water proofed within a 3-M DBY connector. **Note:** Certain Rain Master requirements must also be met regarding installation order and distances of separation between DCA, flow meter, master valve and the first fitting. It is the responsibility of the irrigation contractor to adhere to these requirements. At final walk

through, proper operation of the flow meter at the Rain Master controller must be demonstrated by the irrigation contractor.

13. Heads: All heads will be installed using polyethylene green nipples (3/4"x6" for rotors and 1/2"x6" for pop-ups) screwed into threaded fittings unless noted otherwise. No swing joints on 4" pop-ups or rotors will be allowed.

A. Pop-ups - Only Rainbird 1800 series are permitted. Install 3/4 inch above the finished grade.

a. 4 inch pop-ups: turf, tree bubblers within turf areas (use Hunter PCN 10 bubbler nozzles on spray heads).

b. 6 inch pop-ups with no side inlet: very low ground cover (less than 6 inches at mature height).

c. 12 inch pop-ups with side inlet: Ground cover and low growing shrubs. The ground cover and shrubs should not be more than 12" at maturity. The Town Inspector reserves the right to determine if and when side inlets installed using funny pipe versus the bottom inlet will be allowed. When authorized, use Hardie Blue Line Pipe with Toro barb fittings.

B. Bubblers - Use 3/4" Schedule 80 risers with shrub adapter and Hunter PCN 10, 1 gpm, bubbler nozzles for all tree wells with tree grates. Risers shall be a minimum of 2" below bottom of tree grates with nozzle 2" above mulch. Use (2) bubblers 180-degree opposed.

C. Rotors - Only Hunter I-20 Series are permitted, unless noted otherwise. Install 3/4" above finished grade.

14. Drip: **Use Netafim products only.** Use 0.9 gph pressure compensated self flushing dripper tubing with 12" emitter spacing. Install appropriate pressure reducer and filter in one standard rectangular plastic valve box and a ball valve (see Section 12.C) and station valve (see Section 12.B) in another standard rectangular plastic valve box. Use 17 mm Netafim barbed fittings. Secure tubing to the ground every 3' or less with heavy duty jute netting pins. Use air relief valves housed in 10" round valve boxes. Use Netafim indicator flags. Adhere to all Netafim design and installation specifications.

15. Risers: Use Sch 80 PVC with Weathermatic LXS Series shrub head adapters with a 1/2"x6" green poly cut-off nipple screwed into the threaded fitting in the ground. The irrigation inspector reserves the right to determine placement of risers versus pop-ups.

16. Wiring: All wires will be 14 gauge UF. Station wires will be red. Common wires will be white. Master valve wire will be blue. Anytime the wiring changes direction, such as at an elbow or a tee, allow a loop of at least 12 inches alongside the fitting at that location. Only continuous wire runs are permissible. Wire should follow the main line where possible and lay along a single side not crossing over lateral lines. Wire is to be placed under mainline with 2" of dirt between wire and pipe.

17. Wire Connectors: **Use only DBY connectors** for all field wire splices other than at the valves themselves. Allow at least 36 inches of pigtailed wire at each splice. **Use King One Step** tan colored connectors for all valve splices. All valve box splices are to be housed in standard (large) Armor rectangular plastic valve boxes. All field splices are to be in 10 inch round Ametek plastic valve boxes or standard, large rectangular Ametek plastic valve boxes at the discretion of the Town's representative.

18. Backfilling: Prior to any backfilling of trenches, an inspection by the Town's irrigation representative must take place and any necessary changes implemented; otherwise manual excavation to enable proper inspection will be necessary. Use clean and approved topsoil to backfill all pipe to a depth. All heads and boxes are to be backfilled to grade with clean topsoil. No rocks greater than 1 inch are allowed. Compact trenches to alleviate settling. Minimal depth of coverage is 12 inches.

19. Valve sequencing must be performed by the contractor and in an order approved by the Town Irrigation Inspector. At least 12 inches of extra station wiring within the bottom of the pedestal is necessary for each zone and must be of neat and orderly appearance.

20. Any deficiencies in coverage noted by the Town's irrigation inspector will be rectified at the cost of the contractor.

21. Controller: A Town irrigation representative will determine the type of controller to be used. All controllers shall have a concrete pad of 36"x36"x6". Pad will be set at 3" above final grade. Install the

controller after the concrete pad is completely cured (two days). Use only appropriately sized stainless steel bolts, washers and nuts to secure the controller to the concrete pad. All wiring is to enter the pedestal via appropriately sized PVC sweep elbows extending at least 1" thru and 6" out from under the pad. Control/master valve wiring, flow meter wiring and 120-V service wiring are to be separated with each having its own access elbow. An additional spare 3/4" sweep elbow for phone service is to be installed as well. All national and local codes must be followed during the installation.



A. A/C controller - Only Irritrol MC Plus controllers will be acceptable. Both Mini-dick rain and freeze sensors will be installed and placed where they can operate properly. All non-Rain Master controllers must be permanently wired for quick attachment to a Rain Master remote control unit.

B. Battery and/or Solar Operated Controllers - Only LEIT controllers will be acceptable. Install rain or freeze sensors on these controllers with SKIT8821-4 installation kit. Install on galvanized thick wall poles and set controller panel to height above finished grade to be determined by Town's representative.

C. Rain Master: Only an approved size stainless steel Rain Master Evolution DX-2 controller with a Stainless Steel Pedestal and Heavy Duty Lightning/Surge Protection is permitted. The controller must include all necessary hardware to ensure reliable communication and operation with the Town's central control located at 16801 Westgrove. Installation must include the following Rain Master hardware, purchased only from a certified Rain Master supplier: DX-FLOW sensor board, DX-PH phone communication option, Data Industrial flow meter (same size as the mainline), and shielded EV-CAB-SEN flow meter cable. It is the irrigation contractor's responsibility to entail the cost of and work in conjunction with South Western Bell Telephone to establish a dedicated phone service and install an interface within the pedestal at each controller location via direct burial cable within 1" PVC conduit. The entire installation must conform to Rain Master specifications and be approved by the Town's irrigation inspector prior to and be inspected during installation. Such specifications will include grounding and pad configurations and distances of separation from water meter to DCA to master valve to flow meter and the first fitting. A functional Mini-dick freeze and rain sensor with a Hunter bypass switch must be installed in an approved location and by an approved method.

For part numbers and pricing of any Rain Master equipment, contact Ray Schramm of John Deere Landscapes at (214) 347-3628. For technical questions, call John DuBose of RainMaster at (214) 632-2289.

22. Communication is the key. If you are unsure, CALL Ron Lee, the Operations Manager of the Addison Parks Department: Office (972) 450-2863/Cell (972) 672-1817.

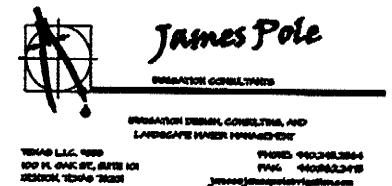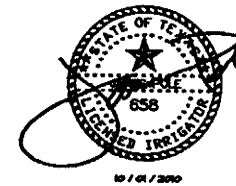


<p>TOWN OF ADDISON DALLAS COUNTY, TEXAS</p> <p>SPRING VALLEY ROAD</p> <p>LANDSCAPE IRRIGATION SPECIFICATIONS</p>					
PROJECT	DESIGN	DRAWN	DATE	FILE	SHEET
DI0488	JP	JP	OCTOBER 2010		LI 14


DISCLAIMER: The use of this standard is governed by the Texas Engineering Practices Act. No warranty of any kind is made by TxDOT for any purpose whatsoever. TxDOT assumes no responsibility for the conversion of this standard to other formats or for incorrect results or damages resulting from its use.

ACC:


1	2	3	4	5	6	7	8	9	10	11	12	13	14	15	16
17	18	19	20	21	22	23	24	25	26	27	28	29	30	31	32
33	34	35	36	37	38	39	40	41	42	43	44	45	46	47	48
49	50	51	52	53	54	55	56	57	58	59	60	61	62	63	64
65	66	67	68	69	70	71	72	73	74	75	76	77	78	79	80
81	82	83	84	85	86	87	88	89	90	91	92	93	94	95	96
97	98	99	100												

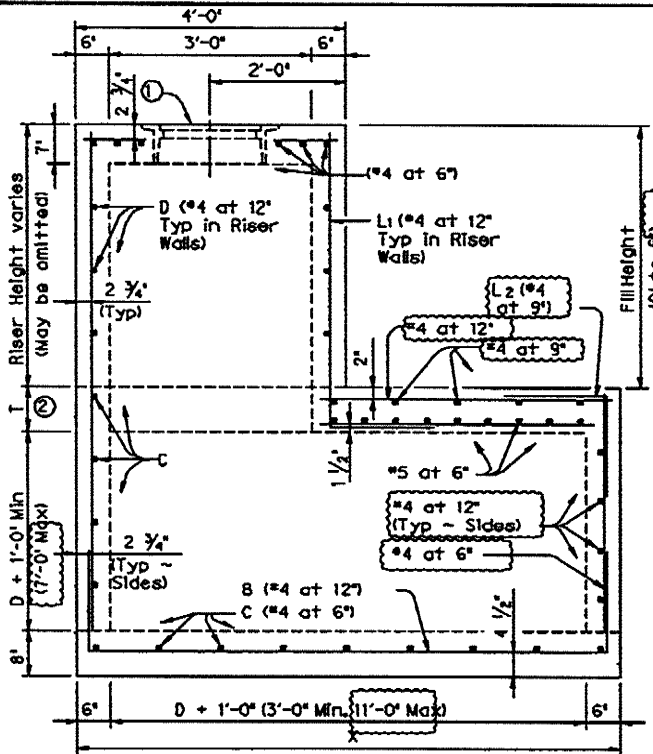


ELEVATION
D = Maximum inside diameter of any pipe entering the side shown or the opposite side

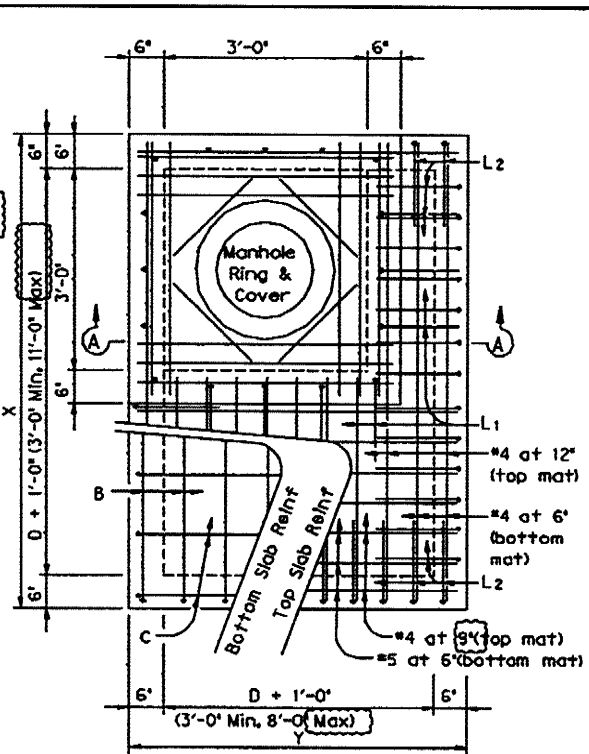


PLAN
MANHOLE WITH CAST-IN-PLACE RISER

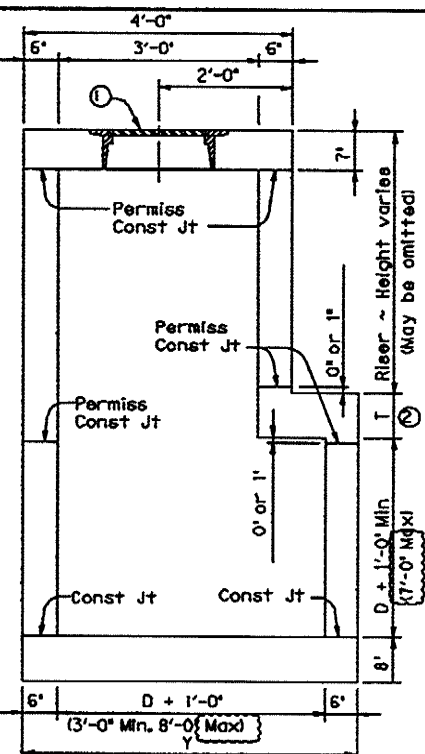


SECTION A-A

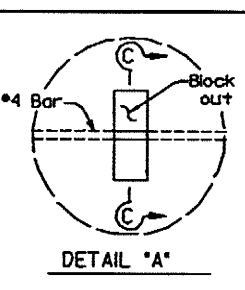


DETAIL "A"

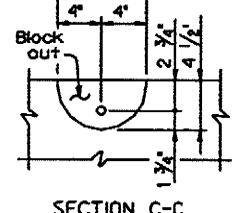


SECTION C-C

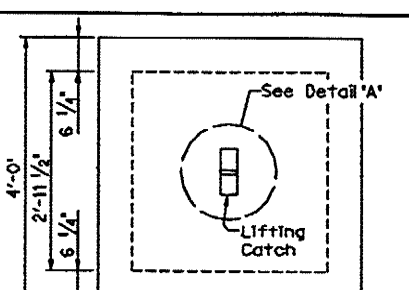


PLAN

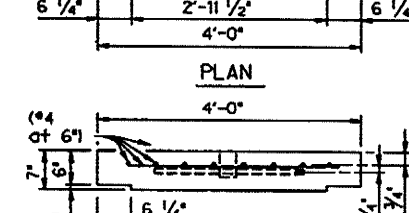

ELEVATION

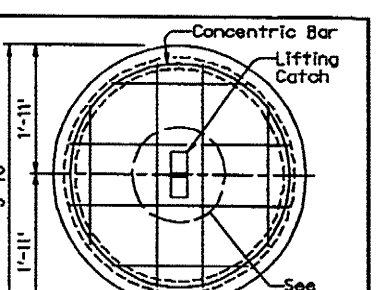


PLAN

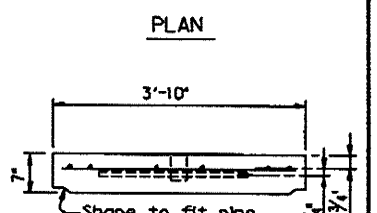


ELEVATION


OPTIONAL PRECAST CONCRETE LIFT-OFF COVERS

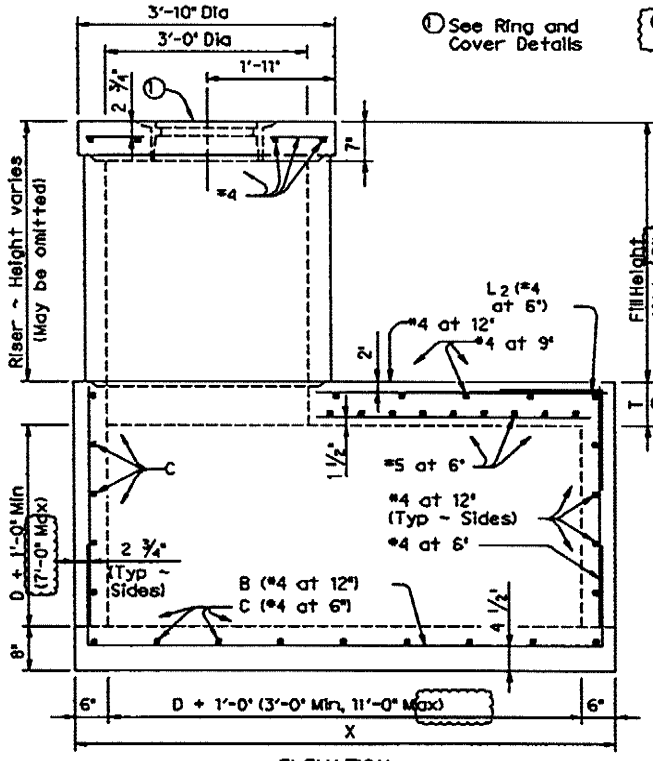


ELEVATION

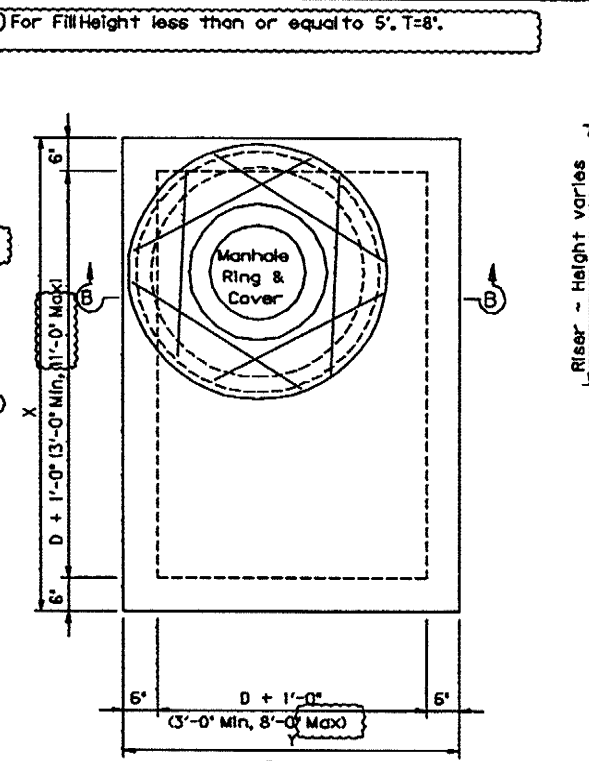

PLAN

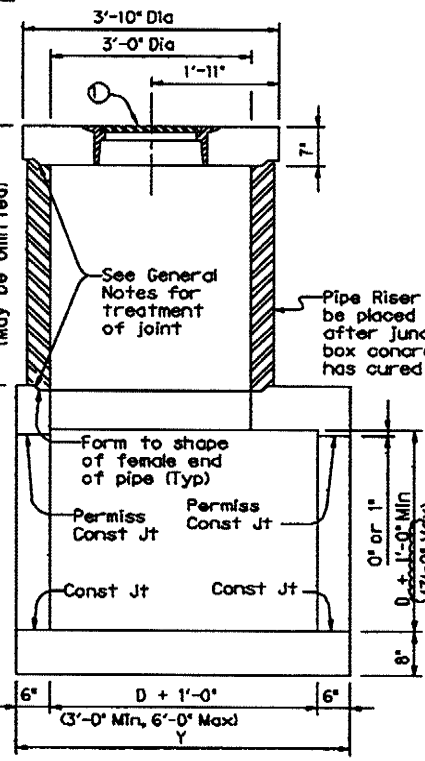


SECTION B-B

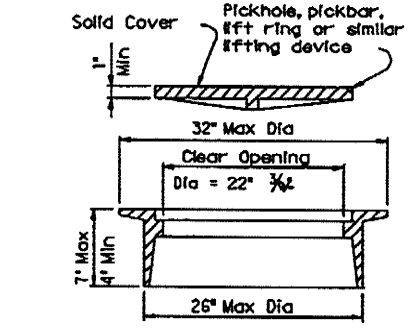

RING AND COVER DETAILS

Approximate Weight = 245 lb

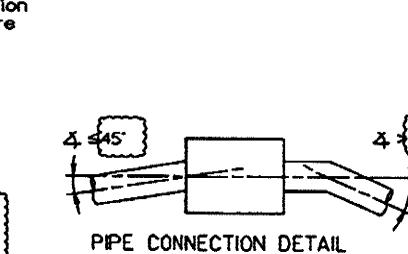


PIPE CONNECTION DETAIL

Connecting pipes should enter within 45° of normal to inlet wall. If necessary, pipe elbow or curved approach alignment should be used to stay within this limit.

GENERAL NOTES:
Unless otherwise shown in the plans, payment will be made for each manhole of the Type M. When approved, precast inlets with equivalent structural capacity may be furnished. Sealed engineering calculations and drawings shall be submitted for approval prior to construction. Shop drawings will not be required. In areas of conflict between reinforcing steel, blockouts, pipes, anchor bolts or other reinforcing steel, the reinforcement shall be bent or adjusted to clear as directed by the Engineer. The riser may be constructed of reinforced concrete as shown or of Reinforced Concrete Pipe, Class III, in accordance with ASTM Designation C-76. If pipe is used, joints shall conform to the item 'Reinforced Concrete Pipe Culverts', Precast Concrete Lift-Off Cover may be substituted for Ring and Cover. The riser, either cast-in-place or concrete pipe, may be located in any corner. All reinforcing steel shall be #4 unless otherwise noted. Pipes may enter any or all walls. The maximum size of pipe that can be accommodated is 36". More than one pipe may enter a side, subject to the maximum box dimension shown. The clear distance between adjacent pipes should be 9" minimum. Ring and cover shall conform to the requirements of AASHTO M306, 'Standard Specification for Drainage Structure Castings'. Materials shall conform to ASTM A48, Class 35B for gray iron castings or ASTM A536, Grade 65-45-12 for ductile iron castings. Aluminum alloy castings shall not be permitted. All concrete shall be Class 'A' (f'c = 3000 psi). Refer to drainage drawings for cement stabilized backfill requirements.

OPTIONAL MANHOLE WITH CONCRETE PIPE RISER

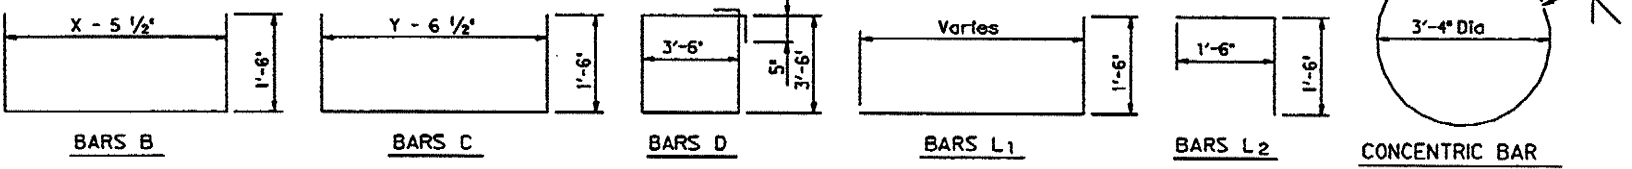

Modifications S.R.C. 07/29/2005

1. Changed box dimension limitations.
2. Changed maximum fill height.
3. Modified reinforcement spacing.
4. Modified pipe connection detail.
5. Changed maximum pipe size in General Notes.
6. Added general note concerning backfill.

Texas Department of Transportation
Bridge Division

MANHOLE TYPE M
(JUNCT DN BOX W TH ACCESS)
5' MAX FILL

FILE	mh-rst04.dgn	DATE	TxDOT	BY	TER	CHK	WCB	APP	TERL/GAF
DATE	December 2003	DISTRICT		FEDERAL AID PROJECT					
REVISIONS		DALLAS		SEE TITLE BLOCK					357
COUNTY	DENTON	CONTRACT	268	POST	01	JOB	016	REV	FRZ/99

MH-M(MOD)

DISCLAIMER: The use of this standard is governed by the Texas Engineering Practice Act. No warranty of any kind is made by TxDOT for any purpose whatsoever. TxDOT assumes no responsibility for the conversion of this standard to other formats or for incorrect results or damages resulting from its use.

ELECTRICAL SERVICES NOTES

All work, materials, services, and incidentals, whether or not specifically shown on the plans, which may be necessary for a complete and proper electrical service installation as specified in the plans to obtain electrical power shall be paid for, performed, furnished and installed by the Contractor. The Contractor shall contact the Utility for metering and shall comply with all Utility requirements.

Primary line extensions, connection charges, meter charges, and other charges by the Utility company to provide power to the location shown, when required, shall be paid for under force account work. The costs associated with these charges shall be approved by the Engineer prior to engaging the Utility company to do the work. The Contractor shall consult with the appropriate Utility to determine costs and requirements, and shall coordinate the Utility's work as approved by the Engineer. The Contractor shall be reimbursed only the amount billed by the Utility. No additional amount for supervision of the Utility's work will be paid.

Materials shall be new and unused, materials and installation shall comply with the applicable provisions of the National Electrical Code (NEC) and National Electrical Manufacturers Association (NEMA) standards and shall be Underwriters Laboratories (UL) Listed. Electrical Service conduits, conductors, disconnects, contactors, circuit breaker panelsets, and branch circuit breakers, shall be as shown in the Electrical Service Data elsewhere in the plans. Faulty fabrication or poor workmanship in any material, equipment, or installation shall be justification for rejection.

The Contractor shall submit for approval no less than six (6) copies of catalog cut sheets on electrical service materials. Submittals shall be legible and shall be marked to indicate which product on a cut-sheet is to be supplied. Where manufacturers provide warranties and guarantees as a customary trade practice, Contractor shall furnish to the State such warranties or guarantees.

The Contractor shall provide locks keyed with Master #2195 for all lockable electrical enclosures. Keys and locks become property of the State. Unless otherwise approved by the Engineer, enclosures shall not be energized until locks are provided and all bolts are installed. Circuit directories, where provided, shall be filled out. All breakers and components in shop built panels and enclosures shall be labeled with two-colored plastic labels. Letters shall be a minimum 3/8" in height.

Enclosures with external disconnects that de-energize all equipment inside the enclosure, need not have dead front trim, except that incoming line terminations shall be protected from incidental contact.

When galvanized is specified for nuts, screws, bolts or miscellaneous hardware, stainless steel may be used. All wiring and components shall be rated for 75 degrees C. Minimum size for service entrance conductors shall be #6 AWG.

I. Safety Switch. A safety switch, placed ahead of the meter, shall only be used when specified by the Utility and when shown on the Electrical Service Data. The switch shall be UL Listed, heavy duty type, 600 volt, unfused, with a UL type 3R enclosure and equipped with a solid neutral(s)/n assembly. The switch shall be lockable in the "on" position.

II. Service Type. Electrical service types A, C, D, and T shall be as schematically detailed on ED(4) or ED(5). Other service types shall be as detailed elsewhere on the plans.

III. Branch Circuit Breakers. Circuit breakers shall be thermal magnetic and have a minimum interrupting capacity of 10,000 amps and a voltage rating compatible with their use. Circuit breakers shall be sized as shown in the electrical service data. Circuit breakers in panelboards and load centers shall be full size and designed exclusively for the panelboard or load center in use. Tandem and half-width breakers shall not be used. All circuit breakers shall be permanently and clearly marked identifying the circuit or device supplied. Circuit breakers shall be UL Listed to UL489.


IV. Circuit Breaker Panelboard. Panelboards shall be UL Listed. Panelboards shall have copper busses, a minimum of 6 one-pole spaces or as required in the electrical service data, and when required will be rated for service equipment. Enclosure shall meet or exceed UL type 3R classification. Panelboards shall have a threaded hub conduit entry for conduit entering the top of the enclosure. Circuit breakers shall be bolt-in type only.

V. Circuit Breaker Load Center. Load centers shall be UL Listed. Load centers for type T services may have copper or aluminum busses, all other load centers will be copper bus only. Load center will have a minimum of 4 one-pole spaces, and shall be rated for service equipment. Enclosure shall meet UL type 3R classification. Load centers shall have a threaded hub conduit entry for conduit entering the top of the enclosure. Circuit breakers shall be plug-in type only. Load centers for type T services shall accommodate a maximum of 6 one-pole breakers.


VI. Separate or Auxiliary Enclosure. Separate enclosures for MDA, photocell and lighting contactors for types D & T Services shall be a UL Listed assembly with outer door. Interior shall have dead front trim. MDA switch operator shall extend through the dead front trim. Photocell shall be mounted inside the enclosure as described in paragraph XII when required by descriptive code. Separate enclosures shall meet the construction requirements of paragraph VII.E, except that separate enclosure shall not have external operating handle, need not have a data pocket and door may latch at only one point. All equipment may be located in one enclosure instead of two, when approved by the Engineer.

VII. Where a Type D or T service is provided, laminated "as built" drawings are required as shown on ED(5) VII.E; shall be delivered before completion of the work to the Engineer in lieu of placement within these smaller enclosures. Conduit may not enter the back wall of a service enclosure penetrating the equipment mounting panel. Provide grounding bushings on all metal conduits, terminate bonding jumper to grounding bus. Grounding bushing is not required when the end of the metal conduit is fitted with a conduit sealing hub or threaded boss such as a meter base.

EXPLANATION OF ELECTRICAL SERVICE DESCRIPTIVE CODE

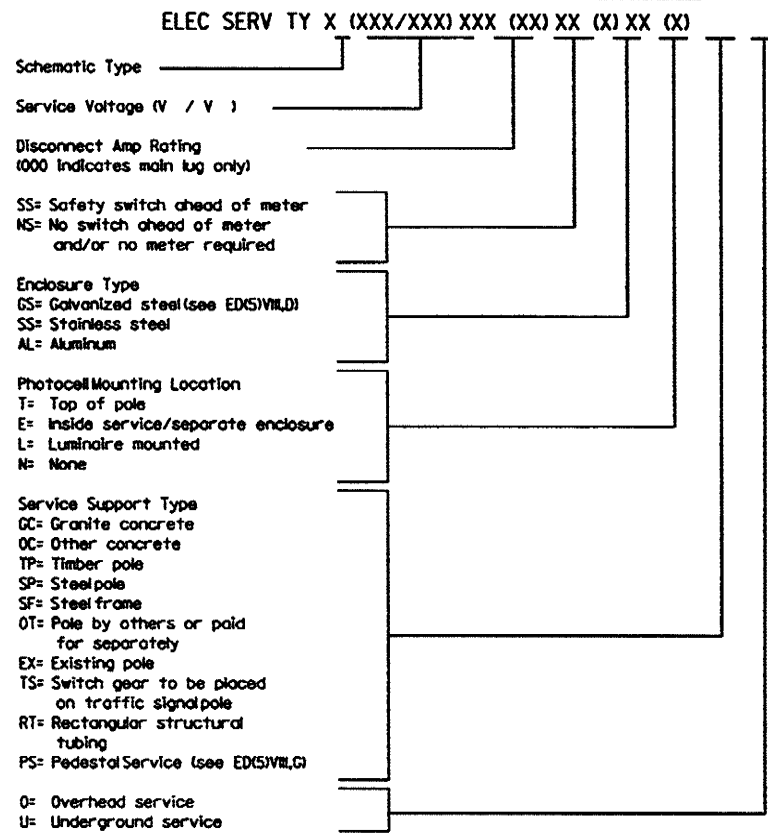

Example: ELEC SERV TY A240/4801100NSISSEJGC01

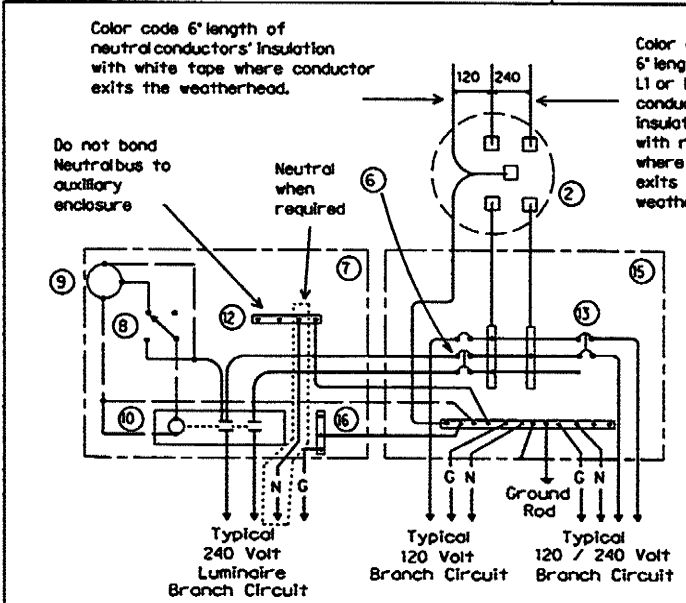


SCHMATIC TYPE T
120/240 VOLTS - THREE WIRE


Install photocell and lighting contactor when shown on Electrical Service Data.

SCHMATIC LEGEND


- 1 - omitted
 - 2 - Meter (when required)
 - 3 - Service Assembly Enclosure
 - 4 - Main Disconnect Breaker (Not Used)
 - 5 - Omit
 - 6 - Circuit Breaker, 15 Amp typical for control circuit wiring
 - 7 - Auxiliary Enclosure
 - 8 - Central Station (M-O-A' Switch)
 - 9 - Photo Electric Control (enclosure-mounted shown)
 - 10 - Lighting Contactor
 - 11 - Power Distribution Terminal Blocks (Not Used)
 - 12 - Neutral Bus required when 120 v. lights are controlled by lighting contactor
 - 13 - Branch Circuit Breaker (See Electrical Service Data)
 - 14 - Circuit Breaker Panelboard (Not Used)
 - 15 - Load Center
 - 16 - Ground Bus
- Power Wiring
- - - Control Wiring
- N - Neutral Conductor (when required to serve 120 v. loads only)
- G - Equipment grounding conductor - always required

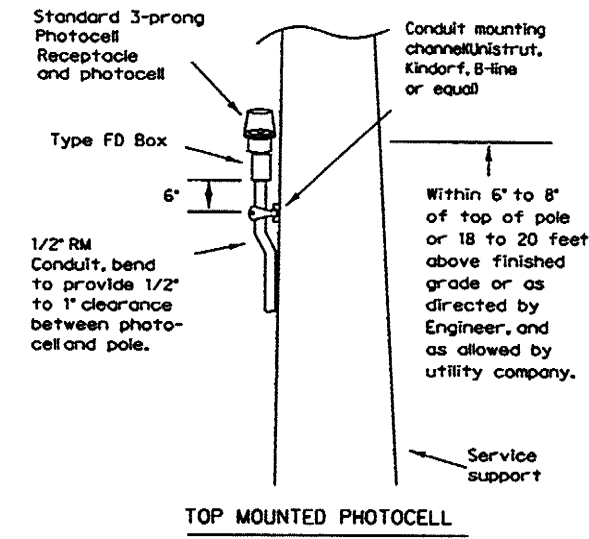

Conduit support spacing 3 feet from enclosure; 5 feet max.

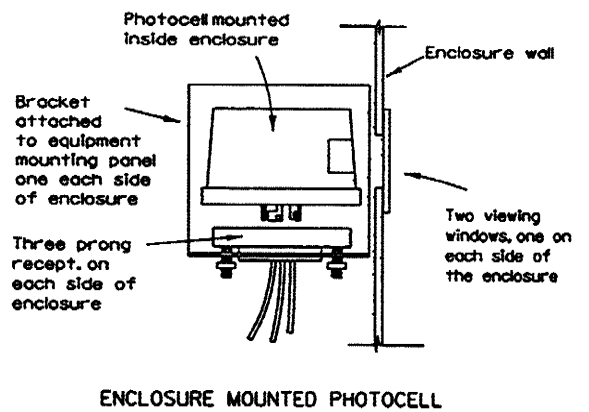

For photocell specifications see ED(5), XII.

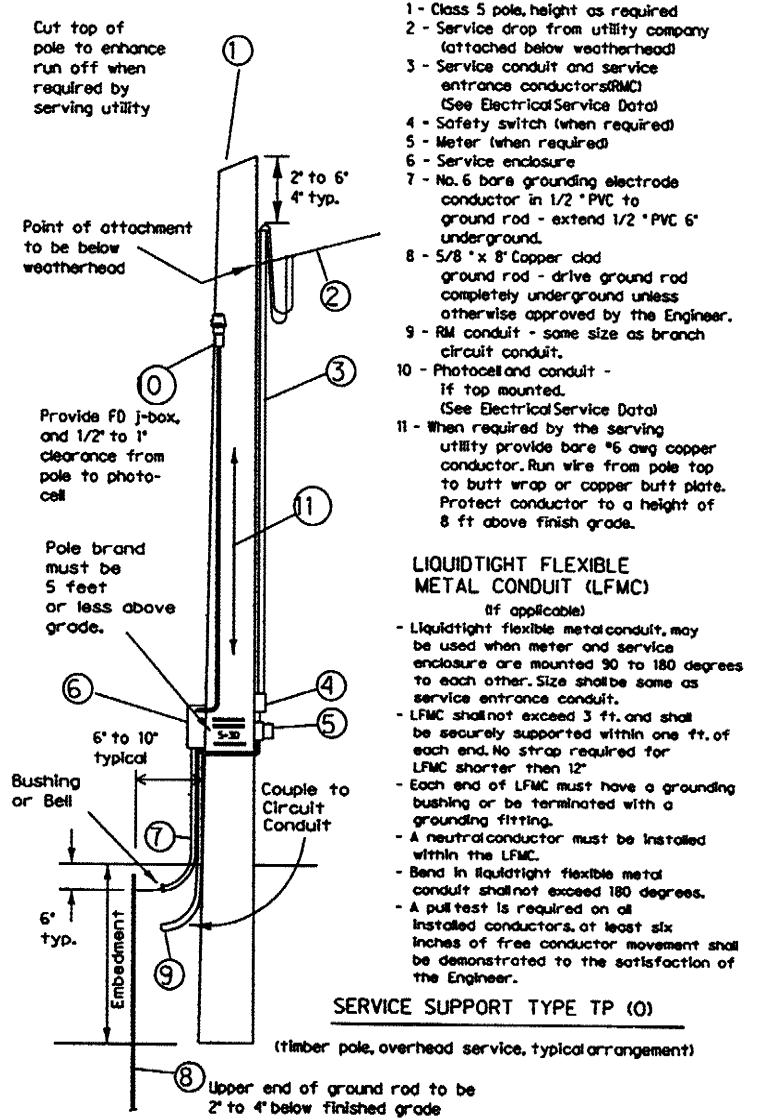


- 1 - Class 5 pole, height as required
- 2 - Service drop from utility company (attached below weatherhead)
- 3 - Service conduit and service entrance conductors (RMC) (See Electrical Service Data)
- 4 - Safety switch (when required)
- 5 - Meter (when required)
- 6 - Service enclosure
- 7 - No. 6 bare grounding electrode conductor in 1/2" PVC to ground rod - extend 1/2" PVC 6' underground.
- 8 - 5/8" x 8' Copper clad ground rod - drive ground rod completely underground unless otherwise approved by the Engineer.
- 9 - RMC conduit - same size as branch circuit conduit.
- 10 - Photocell and conduit - (See Electrical Service Data) if top mounted.
- 11 - When required by the serving utility provide bare #6 AWG copper conductor. Run wire from pole top to butt wrap or copper butt plate. Protect conductor to a height of 8 ft above finish grade.

LIQUIDTIGHT FLEXIBLE METAL CONDUIT (LFMC)

- (if applicable)
- Liquidtight flexible metal conduit, may be used when meter and service enclosure are mounted 90 to 180 degrees to each other. Size shall be same as service entrance conduit.
- LFMC shall not exceed 3 ft. and shall be securely supported within one ft. of each end. No strap required for LFMC shorter than 12"
- Each end of LFMC must have a grounding bushing or be terminated with a grounding fitting.
- A neutral conductor must be installed within the LFMC.
- Bend in liquidtight flexible metal conduit shall not exceed 180 degrees.
- A pull test is required on all installed conductors, at least six inches of free conductor movement shall be demonstrated to the satisfaction of the Engineer.

TIMBER POLE NOTES

- 1. Conduit and electrical conductors attached to the electrical service pole and underground within 12 inches of service pole shall not be paid for directly but shall be subsidiary to the service pole.
- 2. Pole top mounted photocell, installation north side of pole or in service enclosure as required. See Electrical Service Data.
- 3. Attach meter and service equipment with stainless steel or galvanized channel Unistrut, Kindorf, or equal. Gain pole as required to provide flat surfaces for each strut. Point ends of galvanized channel with zinc rich paint. Gain depth 5/8" max. Gain height 1 7/8" max. Strut to be 1" max. deep, and 1 5/8" wide max. Secure each strut section to timber pole with two galvanized or SS lag bolts, 1/4" diameter min. by 1 1/2" length min. Place flat cut galvanized or SS washer on each lag bolt. Gain pole in a neat and workmanlike manner.
- 4. Embedment depth shall be as required in Item E27 Treated Timber Poles.
- 5. Poles trimmed for excess length shall be trimmed from the top end only.

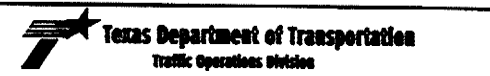

ELECTRICAL DETAILS - SERVICE SCHEMATICS AND SUPPORT-TYPE TP (OVERHEAD)

ED(4)-03

© TxDOT April 1998		DN TxDOT	CU TxDOT	DR TxDOT	CR TxDOT
12-00	REVISED	CONT	SECT	JOB	HOWAY
3-03		DIST		COUNTY	SHEET NO.


DISCLAIMER: The use of this standard is governed by the Texas Engineering Practice Act. No warranty of any kind is made by TxDOT for any purpose whatsoever. TxDOT assumes no responsibility for the conversion of this standard to other formats or for incorrect results or damages resulting from its use.

SERVICE ENCLOSURE NOTES

- VII. Service Assembly Enclosures.** All service assemblies and enclosures shall be UL Listed for the intended purpose.
- Shop built or shop assembled service assemblies (all types except Type T and Type D without lighting contactor or enclosure mounted photocell and auxiliary equipment enclosures mounted with service equipment and sold for as part of Item 628, "Electrical Services", shall be built or assembled by a UL Listed Industrial Control Panel shop and shall have a unique serial numbered UL Label with the words "LISTED ENCLOSED INDUSTRIAL CONTROL PANEL". The same or an additional label shall have the name, location, and phone number of the shop, the UL file number of the shop, the shop order or drawing number, date of manufacture or assembly, and the line voltage. The service assembly enclosure shall also be labeled "SUITABLE ONLY FOR USE AS SERVICE EQUIPMENT".
 - Conduit entries into the top of enclosures shall have threaded hub. Conduit entries through the equipment mounting back plate will not be allowed.
 - All service enclosure front doors shall be permanently labeled "DANGER HIGH VOLTAGE". Label shall be a self sticking type, intended for outdoor installation. Lettering style, layout and colors of red, black and white shall be as required by OSHA. Label letters shall be 1 to 1 1/2 inches high or as high as the enclosure door width will permit for smaller services. Separate or auxiliary lighting enclosures need not be OSHA labeled when mounted in the same viewing plane as the service enclosure front door. Where only one type of load is served by the service, the service door shall be marked using duo-colored plastic labels or self adhesive vinyl weather resistant labels, minimum of 1 inch high applied in a neat and workmanlike manner. On the label will be the service number shown on the plans as well as identifying the load served specifically (i.e., lighting, landscaping, signals, traffic management or other wording as directed by the Engineer). Safety switches need not be OSHA labeled unless specifically required by the serving utility.
 - Type GS enclosures will only be allowed for service Types D and T without an enclosure mounted photocell and/or lighting contactor and the Type C panelboard. This spec will allow an "off the shelf" product meeting these specifications to be used. Type GS enclosures shall be made from pre-galvanized steel sheeting, hot dipped galvanized steel, or powder coat painted steel unless shown differently on the plans. Steel enclosures shall be painted inside and outside; galvanized enclosures may be painted. Unless otherwise approved by the Engineer, painted enclosures shall be gray, beige, white or light green. Panelboard/load center enclosures shall meet UL type 3R requirements, shall have a dead front trim, and an outer padlockable door preventing unauthorized persons from operating contained equipment. Galvanized steels no longer allowed for Types A, C, or T enclosures. If GS is shown in the descriptive code for any of these, an AL shall be provided.
 - Type AL enclosures for service Types A and C shall meet UL type 3R requirements and shall also meet additional requirements of this paragraph. The enclosure shall have both a main disconnect remote operator handle and a door latch handle. Die-coat handles are not acceptable. The main disconnect remote operator shall be flange-mounted, shall interlock the door when in the "on" position, and shall be padlockable in both the "on" or "off" positions. Door latch shall latch at two or more points, operate by a handle separate from disconnect switch and be capable of being locked. Door closure clamps will not be allowed. Lock must be keyed to Master #2195. All the enclosures shall have either a continuous stainless steel piano hinge with stainless steel pin or enclosures less than 30 inches may have two heavy duty hinges, those over 30 inches must have three. Heavy duty two and three point hinges shall have a 0.185 inch minimum diameter electro-zinc plated steel pin or a stainless steel pin. Two point hinged doors shall be rated for 56 lbs of loading. Three point hinged doors shall be rated for 70 lbs of loading. The door shall have an attached data pocket constructed of either thermoplastic or metal. Pocket shall be 12" x 12", unless that size will not fit in enclosure. The pocket shall then be as large as possible, as approved by the Engineer, and mechanically attached with stainless steel nuts and bolts, or stainless steel or aluminum rivets. Enclosure shall include an equipment mounting panel installed inside the enclosure on color studs or tapped bosses, and constructed of a minimum 12 gauge galvanized steel. Equipment mounting panels shall not be painted. Enclosure shall have factory installed external mounting feet. Enclosure door shall be capable of opening at least 130 degrees, with arm or other approved means to hold the door open. Only the enclosure exterior will be primed and painted. Paint color shall be beige or gray and shall be powder coat paint as shown below. Condensation drainage shall be provided in the bottom of the enclosure before leaving the factory. The Contractor shall prepare and submit a schematic drawing unique to an individual service. The approved drawing shall be laminated and placed in the document pocket of the service at the time of shipment to the job site. All applicable wiring diagrams and plan sheet layouts for all equipment and branch breaker circuits supplied by that service shall also be laminated and placed in the document pocket prior to shipping. Type AL enclosures for Type D and T services with enclosure mounted photocell and/or lighting contactor shall have the load center interior mounted in an enclosure with property adapted dead front trim. Types D and T shall not have a load center exterior "can" mounted inside another enclosure meeting these specifications. Do not put one enclosure inside another enclosure. Types D and T with enclosure mounted photocell and/or lighting contactor shall meet the additional requirements of this paragraph except that remote-operating handle will not be provided.
 - Type SS enclosures for Type A and C shall meet all the requirements above for their respective type AL. Type SS enclosures for D and T shall meet all the requirements above for their respective type AL. Stainless Steel shall not be painted.
 - PS enclosure shall be as detailed and specified on ED88. Galvanized steel will not be allowed for any pedestal service. If GS is shown in the descriptive code an AL will be provided.
 - Powder Coat Paint.** Powder coating shall be either a polyester thermosetting resin, a zinc rich primer with a TGC (tri-glycidyl isocyanurate) powder overcoating, or a zinc-rich epoxy powder, applied by either electrostatic spray or fluidized bed immersion, high temperature oven cured, high density, low gloss, 4 mil thick minimum, coating. Adhesion shall meet the 5A or 5B classifications of ASTM D3359. Finish shall be uniform in appearance and free of scratches.
 - Main Disconnect.** Main disconnect device shall be a circuit breaker, as specified in the Electrical Service Data, shall be two or three pole, and rated for the voltage and amperage specified. Circuit breaker shall be UL Listed thermal-magnetic circuit breaker controlled by flange-mounted remote operator in the service assembly enclosure when required. Circuit breakers shall have a minimum interrupting rating of 10,000 Amps. When the utility company provides a transformer larger than 50 KVA, Contractor shall verify that the available fault current is less than the circuit breaker amp interrupting capacity (AIC) rating and shall provide documentation from the utility to the Engineer. Documentation shall be submitted at the same time as other electrical submittals. Circuit breaker shall be UL Listed to UL489. No backfed breakers will be allowed for use as a main disconnect.
 - Control Circuit.** Control circuit protection shall be 15 amp circuit breaker.
 - Control Station (H-O-A' Switch).** Control station shall be a maintained-contact, three position selector switch in an UL type enclosure. Switch shall be rated 600 volts and shall be fitted with "Hand-Off-Auto" legend.
 - Photo Electric Control.** Photo electric control shall consist of a photocell, internal lightning arrester, and relay or bimetallic switch mounted inside a weatherproof enclosure with standard 3-prong twist lock photocell plug and receptacle. The enclosure shall be made of poly-acrylic with clear acrylic window. Enclosure chassis shall be molded thermosetting plastic. The photocell shall have a polyethylene gasket, and shall have a hermetically sealed cadmium sulfide cell. The arrester shall have an enclosed type expulsion arrester rated 2.0 kV sparkover with 5,000 amps follow-through. Relay or switch shall be time delay type with normally closed contacts. Photo electric control shall be rated a minimum of 1800 VA, voltage as required. Enclosure mounted photocells shall be the same as above except that the photocell shall be mounted inside the enclosure. The enclosure shall have two acrylic paneled windows, or other material approved by the Engineer, one on each side of the enclosure. Each window shall be rectangular approximately one inch by two inches, round 2 inch diameter, or as otherwise approved by the Engineer. Bracket and photocell's receptacle will be mounted inside enclosure next to each window. Except for window side, 2" of clearance is required on all sides of photocell for ease of replacement. The photocell's receptacle is held in place by two mounting screws on bracket and located next to each window of the enclosure. The 3-prong twist lock photocell shall be mounted in a position to receive light from the window closest to the photocell. The photocell shall be mounted in a position to receive light from one window. Top of pole mounted photocells shall be mounted as shown on ED44. The Contractor shall be responsible for proper operation of the photo-electric control. The Contractor shall move and/or adjust or shield the photocell from stray or ambient nighttime light or shall make any other adjustments required for proper operation. The photocell shall face North when practicable. Unless otherwise shown on the plans, the photocell shall turn on the illumination system at 1.0 +/- 0.5 footcandle and turn off the illumination system at two footcandles higher than turn on.
 - Lighting Contactor.** Lighting contactor shall be a UL Listed NEMA rated lighting contactor, two-pole or multipole as required, electrically held type designed to control high pressure sodium lighting loads, with silver alloy double break contacts rated at 240 volts, 480 volts or 600 volts as required. Lighting contactor shall not be the DM roll mounted type.
 - Power Distribution Terminal Blocks.** Power distribution terminal blocks shall be rated for 600 volts and shall be used for line side connections to branch circuit breakers where more than one circuit breaker is required. Lugs on blocks shall be properly sized for conductors being used. Only one conductor shall be placed under each lug.
 - Neutral/Ground Bus.** Neutral/ground bus shall be a factory made bus permanently bonded to the enclosure with properly sized lugs for grounding and neutral conductors.

- SCHEMATIC LEGEND**
- 1 - Safety Switch (when required)
 - 2 - Meter (when required)
 - 3 - Service Assembly Enclosure
 - 4 - Main Disconnect Breaker (See Electrical Service Data)
 - 5 - Omit
 - 6 - Circuit Breaker, 15 Amp
 - 7 - Auxiliary Enclosure
 - 8 - Control Station (H-O-A' Switch)
 - 9 - Photo Electric Control (enclosure-mounted shown)
 - 10 - Lighting Contactor
 - 11 - Power Distribution Terminal Blocks
 - 12 - Neutral/Ground Bus
 - 13 - Branch Circuit Breaker (See Electrical Service Data)
 - 14 - Circuit Breaker Panelboard (See Electrical Service Data) (If Type C is shown as AL or SS on descriptive code, this is the service assembly enclosure only. Panelboard enclosure is GS unless otherwise noted.)
 - 15 - Load Center


- Power Wiring**
- Control Wiring —
 - N — Neutral Conductor (when required serve 120 v. loads only)
 - Equipment grounding conductor—always required

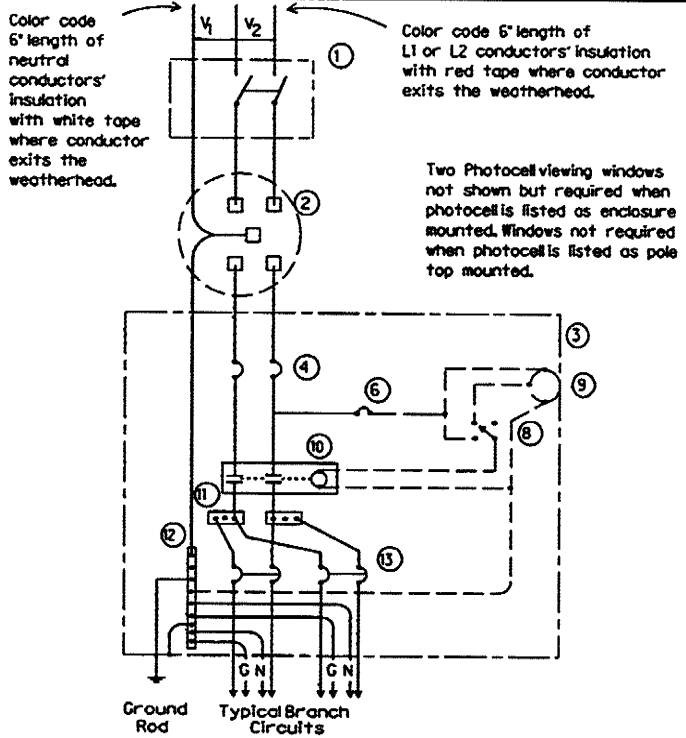

SCHEMATIC TYPE A

THREE WIRE


Maximum feeder circuit size (High Mast Poles): 100 amps for two pole 480V, 125 amps for one or two pole 120V or 240V. Maximum branch circuit size: 50 amps.

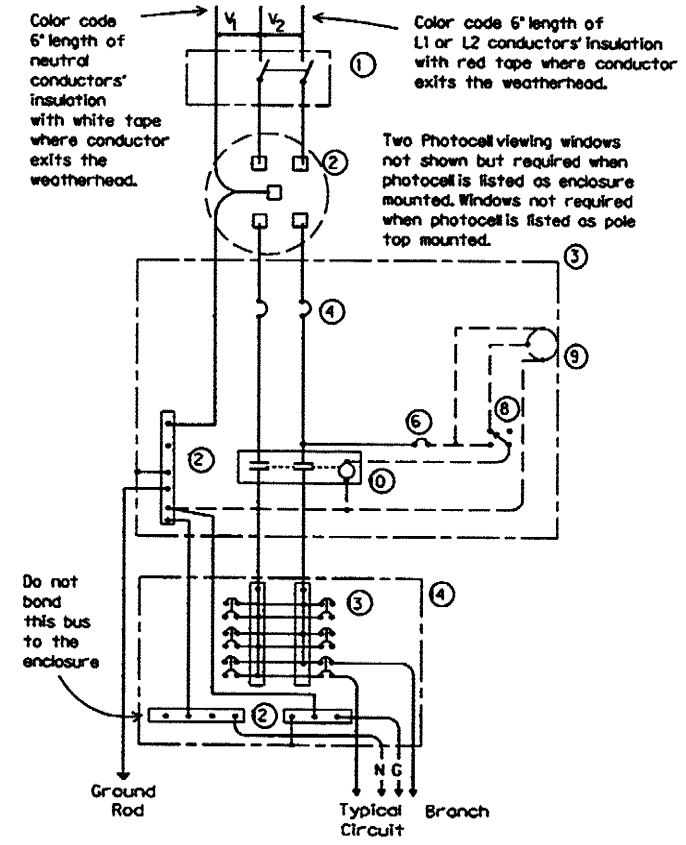

SCHEMATIC TYPE C

THREE WIRE

Maximum feeder circuit size (High Mast Poles): 100 amps for two pole 480V, 125 amps for one or two pole 120V or 240V. Maximum branch circuit size: 50 amps.

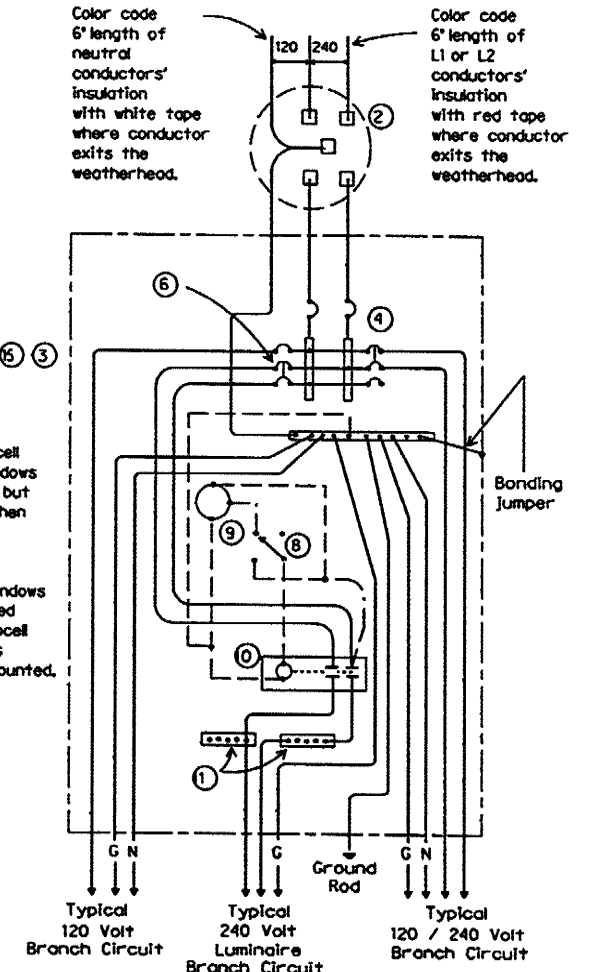

SCHEMATIC TYPE D

120/240 VOLTS - THREE WIRE

Install photocell and lighting contactor when shown on Electrical Service Data. See Type D service notes.

TYPE D SERVICE NOTES

Photocell and lighting contactor shall be located either in the same UL type 3R enclosure with load center or, if approved by Engineer, in separate enclosure. There shall be a window on each side of enclosure to allow operation of photocell. Both photocell contactor and breaker area shall have dead front trim. Enclosure, except for RT and PS supports, shall not exceed 36 inches in height or 16 inches in width unless approved by the Engineer. Ty D load center with lighting controls or Ty D separate lighting control enclosure shall have power distribution blocks for a minimum of 4 #8 conductors per phase.




ELECTRICAL DETAILS - SERVICE ENCLOSURE & NOTES

ED(5)-03

© TxDOT Apr 1998		DN TxDOT	DR TxDOT	DS TxDOT	DT TxDOT
12-00	REVISED	CNT	SECT	JOB	NOWAY
3-03		BST		COUNTY	SHEET NO.


DISCLAIMER: The use of this standard is governed by the Texas Engineering Practice Act. No warranty of any kind is made by TxDOT for any purpose whatsoever. TxDOT assumes no responsibility for the conversion of this standard to other formats or for incorrect results or damages resulting from its use.

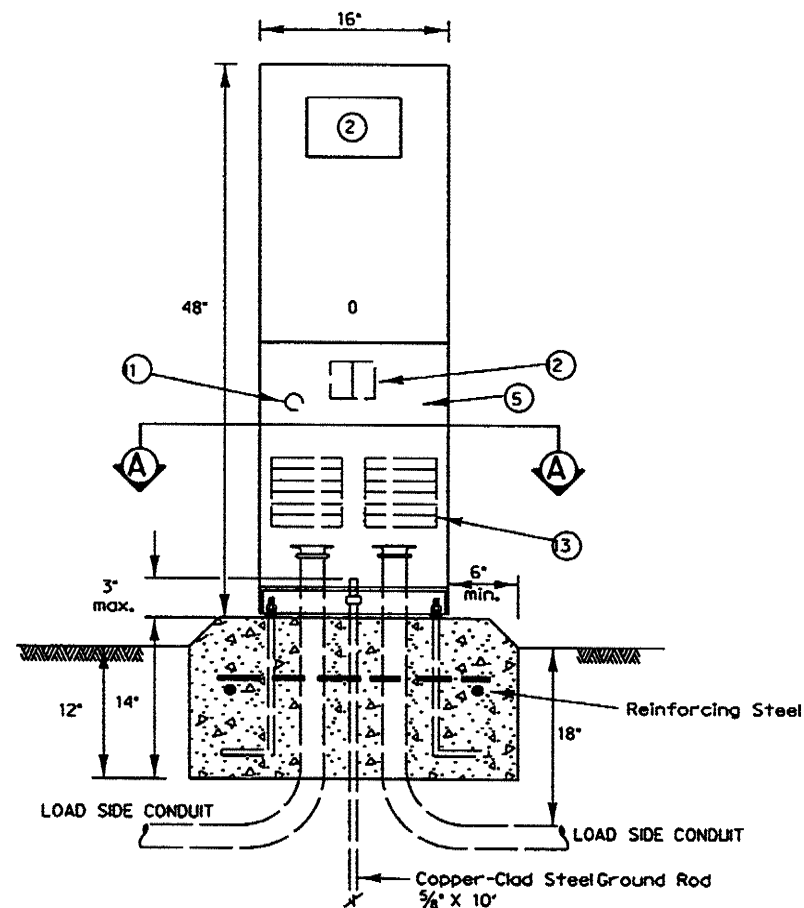


Note: Ells in foundation are rigid metal, size called for on the plans. Extension conduits from these ellis may be PVC, provided ends of rigid metal conduits are more than 2 in. below top of concrete foundation. Where extension conduits are metal, grounding bushing must be installed and a bonding jumper properly terminated.

FRONT VIEW


Ty C shown, Ty A similar except that Ty A shall have individual circuit breakers mounted on a equipment mounting panel. CB Handles shall protrude through hinged deadfront trim.

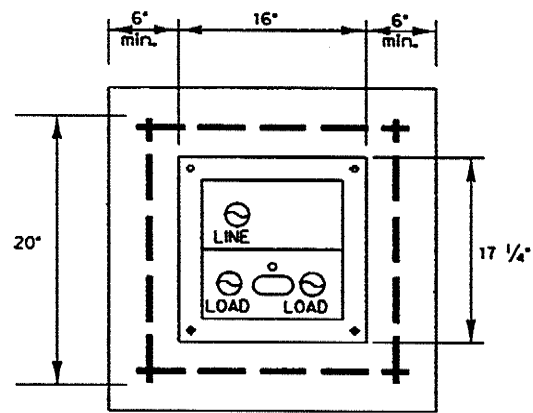

SECTION A-A

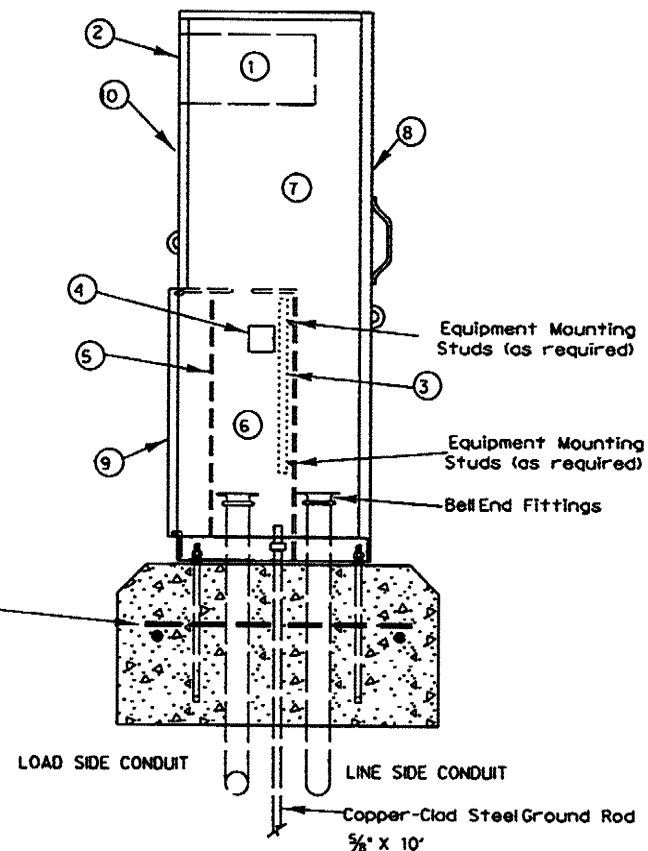

SIDE VIEW

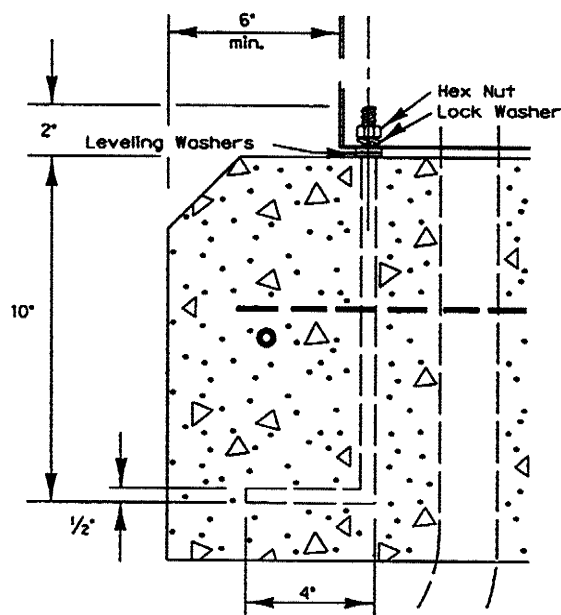

ANCHOR BOLT
DETAIL

GENERAL NOTES

- The pedestal service shall be UL type 3R, and shall be constructed of a minimum of 12 gauge stainless steel or aluminum as required by descriptive code. Stainless steel shall not be painted. For aluminum, the finish shall be an electrostatic applied polyurethane baked on powder, light green in color, or color as shown elsewhere and as approved by the Engineer. The front of the interior dead front trim shall be permanently labeled, "Danger High Voltage" with OSHA style label. The exterior of the pedestal service door shall be permanently labeled with a placard as to its use (i.e. Roadway Lighting, Traffic Signals, etc.). Placard shall be neat and professional in appearance. Lettering shall be 1" minimum height.
- Utility Access Door shall have stainless steel piano hinge and provisions for padlocking.
- Pedestal door shall have stainless steel piano hinge and stainless steel latch with provisions for padlocking.
- Meter Access shall be hinged and capable of padlocking.
- All mounting hardware and installation details of services shall be in accordance with utility company specifications. The Contractor is responsible for contacting the local utility company and obtaining their approval of pedestal details prior to making submittal to the Department and prior to constructing the electrical pedestal service. Any changes required by the utility company shall be noted on the submittals.
- Meter Socket shall be a minimum of 100 amp rating and shall comply with the local utility requirements.
- Photoelectric Control shall meet the requirements as shown on ED(8). Shield to control stray light is allowable. The Contractor shall be responsible for proper operation of the photo-electric control. The Contractor shall move and/or adjust or shield the photocell from stray or ambient nighttime light or shall make any other adjustments required for proper operation. The photocell shall face North when practicable. Unless otherwise shown on the plans, the photocell shall turn on the illumination system at 1.0 +/- 0.5 foot-candle and turn off the illumination system at two foot-candles higher than turn on.
- The Control Station (H-O-A Switch) shall be as shown on ED(8) except that H-O-A Switch operating handle shall protrude through hinged deadfront trim and NEMA 1 enclosure will not be required.
- Concrete for pedestal service foundation shall be class A or C and shall be in accordance with Item 420, "CONCRETE STRUCTURES", except that concrete will not be paid for directly but shall be considered subsidiary to Item 628, "ELECTRICAL SERVICES".
- Reinforcing steel shall be #4 rebar in accordance with Item 440, "REINFORCING STEEL".
- Anchor bolts shall be A36MS5 in accordance with Item 443, "ANCHOR BOLTS". Anchor bolts shall be 3/4 inch x 12 inches x 4 inches (dia. x length x hook length).
- All conduit and conductors attached to the pedestal service and within 12 inches of the pedestal service will not be paid for directly, but shall be subsidiary to the pedestal service. All service conduit and conductors from the utility company transformer to a point 12 inches from the pedestal service shall be paid for separately. Service conduit shall be the size and type as shown in the Electrical Service Data.
- Dimensions may vary to accommodate required equipment, utility company requirements, or manufacturer's standard equipment dimensions. The Contractor shall submit to the Engineer for approval six (6) copies of brochures and/or drawings of the pedestal service to be supplied, including actual dimensions, and a paint color sample.
- A separate enclosure as shown on ED(4) or ED(5) for photocell shall not be used for pedestal services. Photocell shall be installed as shown here.
- The pedestal door shall have a mechanically attached data pocket on the inside. Pocket shall be either metal or thermoplastic and shall measure at least 12 inches by 12 inches. The Contractor shall prepare and submit a schematic drawing unique to an individual service. The approved drawing shall be laminated and placed in the document pocket of the service at the time of shipment to the job site. All applicable wiring diagrams and plan sheet layouts for all equipment and branch breaker circuits supplied by that service shall also be laminated and placed in the document pocket prior to shipping.
- Ground rod clamp to be UL listed for direct burial. All non-conductive coating to be removed from ground rod at clamp location. Ground rod wire to be #6 AWG solid copper. Metal conduit ellis to have grounding bushing and bonding jumpers correctly installed.
- All conduits entering enclosures from underground must be sealed. Silicone shall not be allowed.
- All conductors shall be megged and pull tested. Traffic signal cable not to be megged after connection, as electronics will be damaged.
- Top of concrete foundation to be finished in a neat and workman like manner. If leveling washers are used, no more than 1/4 inch height shall be used at any one corner. Maximum dip or rise in foundation is not to exceed 1/8 inch per foot. When properly installed, top of service enclosure shall read level front to back and side to side within 1/8 inch. Rocking or movement of the service enclosure shall be repaired by the contractor at no cost to the state.
- Liquid tight flexible metal conduit shall not be allowed on PS type services.

LEGEND

- METER SOCKET, (when required)
- METER SOCKET WINDOW, (when required)
- EQUIPMENT MOUNTING PANEL
- PHOTO ELECTRIC CONTROL WINDOW, (when required)
- HINGED DEADFRONT TRIM
- LOAD SIDE CONDUIT AREA
- LINE SIDE CONDUIT AREA
- UTILITY ACCESS DOOR, with handle
- PEDESTAL DOOR
- HINGED METER ACCESS
- CONTROL STATION (H-O-A Switch)
- MAIN DISCONNECT
- BRANCH CIRCUIT BREAKERS



ELECTRICAL DETAILS
ELECTRICAL SERVICE SUPPORT
PEDESTAL SERVICE TYPE PS

ED(8)-03

5/03 Revision	©TxDOT April 1998	014 TxDOT	014 TxDOT	014 TxDOT	014 TxDOT
△ Revised notes.	12-00 REVISIONS	CONT	SECT	JOB	ROADWAY
	3-03	DIST	COUNTY	SHEET NO.	
	5-03				

ROADWAY ILLUMINATION LIGHT FIXTURES

Fixture Housing:

- A. Provide #UL listed fixture suitable for use in wet locations. Ensure optical compartment meets IEC Standard 60529-IP 65. Place a permanent label inside fixture indicating fixture meets #UL, IP 65 optical, and shows date of manufacture. Meet ANSI 136.15 wattage label requirements.
- B. Construct fixture housing, lens frame, and door from 96% copper-free, die cast aluminum. Provide fixture mounting to a 2-in. pipe arm. Equip fixture with a 4-bolt clamp capable of adjustments plus or minus 5 degrees from level. Meet ANSI 136.31 3.0 G vibration requirements.
- C. Attach a level bubble to the fixture housing. Ensure the level bubble is sensitive to 1 degree changes in position at any point within 5 degrees of the level position. Ensure the level bubble is clearly visible from the ground up to a 50 ft. mounting height. Ensure level bubble corresponds to level position of fixture.
- D. Do not exceed 1.6 sq. ft. effective projected area. Do not exceed 60 lb. maximum weight.
- E. Equip fixture with a 3-prong photocell receptacle with shorting cap installed.
- F. Paint inside and outside of fixture light gray, when installing on galvanized poles. For all other fixtures, paint to match the color of the pole as directed by the Department.
- G. Use a thermoset powder coat system. Ensure paint exceeds 1000-hr. salt-spray test in accordance with ASTM B117. Ensure a nominal thickness of 2.5 mil and no pigment loss upon 50 double-rubs using Methyl Ethyl Ketone (MEK) solvent in accordance with ASTM D5402, "Standard Practice for Assessing the Solvent Resistance of Organic Coatings Using Solvent Rubs."
- H. Fabricate brackets, nuts, bolts, washers, ballast tray, and parts from stainless-steel, or aluminum of adequate thickness as approved by the Department except that:
 1. The 4 bolts/studs, 4 flat washers, 4 lock washers, and clamp that attach the luminaire to the arm may be galvanized in accordance with ASTM A123, A153 or B633. Provide means to ensure clamp is in the open position when installing.
 2. Glass lens retainer spring clips may be fabricated from galvanized steel in accordance with ASTM A153.
 3. Provide nylon throat or other approved locking means for all stainless steel nuts.
- I. Provide optical assemblies which meet the following:
 1. Polished aluminum reflectors with Alzak or equal coating.
 2. Do not paint reflectors, except that, when approved by the Engineer, some surfaces may be painted with 92% reflective white paint.
 3. Reflectors may be one piece or segmented as follows.
 - a. One piece reflectors:
 1. Seal photometric compartment by the use of a seamless or vulcanized seam, closed-cell silicone gasket, or other method approved by the Department.
 2. Provide a non-adjustable lamp socket mounting method so the lamp center is consistent with the reflector.
 - b. Segmented reflectors:
 1. Attach segments at both ends (or opposite sides if segments are square) of the segment to a rigid aluminum base plate and side wall support assembly. Seal glass lens to lens frame with a one piece seamless silicone gasket.
 4. Equip the optical assembly with a lamp support in addition to the lamp socket to ensure the outer envelope is positioned as intended.
- J. Provide 5/32 in. thick (min.) clear heat tempered or borosilicate glass.

Electrical Components:

- K. Meet the following ballast requirements and pass tests in accordance with Test Method Tex-1130-T, "Ballasts of Lighting Assemblies."
 1. Mount electrical components on a removable stainless steel or aluminum tray of adequate thickness.
 2. Provide a fixture wiring diagram on or near the ballast.
 3. Use a copper wound magnetic regulating three isolated coil ballast.
 4. Provide ballast factor between 0.95 and 1.0.
 5. When the circuit voltage indicated on the plans is applied, the ballast input wattage during fluctuations of the test voltage of plus 10 percent and minus 10 percent, do not exceed the following:
 - a. 220 Watts for 150 watt nominal lamp rating
 - b. 440 Watts for 250 watt nominal lamp rating
 - c. 552 Watts for 400 watt nominal lamp rating
 6. During fluctuation of the test voltage of plus 10 percent and minus 10 percent, ensure the lamp wattage fluctuation does not exceed a total of 20 percent and ballast maintains lamp wattage within the following limits:
 - a. 110 Watts minimum and 180 Watts maximum for 150 Watt nominal lamp rating
 - b. 175 Watts minimum and 370 Watts maximum for 250 Watt nominal lamp rating
 - c. 280 Watts minimum and 475 Watts maximum for 400 Watt nominal lamp rating
 7. Ensure the ballast power factor, when tested at circuit voltage indicated on the plans, is not less than 90%.
 8. Permanently and clearly mark ballast or fixture to indicate following:
 - a. Lamp type
 - b. Catalog number
 - c. Voltage rating
 - d. Connection diagram
 - e. Manufacturer
 - f. #UL listing
- L. Meet the following electronic starting aid requirements and pass tests in accordance with Test Method Tex-1140-T, "Electronic Starting Aids of High Pressure Sodium Vapor Lighting Assemblies."
 1. Provide a starting pulse with an amplitude of 2500 volts minimum, 4000 volts maximum.
 2. Ensure the pulse width is a minimum of 0.8 microseconds at 2250 volts.
 3. Ensure the pulse occurs when the open circuit voltage is equal to or greater than 90 percent of peak open circuit voltage.
 4. Ensure pulse repetition rate is a minimum of one per cycle.
 5. Provide a pulse current of 0.18 amperes (min.).
 6. Discontinue to pulse when, either,
 - a. the lamp starts, or
 - b. after a minimum of 3 minutes and a maximum of 10 minutes if the lamp fails to start.
- M. Do not place fuses inside pole mounted luminaires. For wall mount or underpass mounted luminaires, provide internal 10 amp time-delay fuses.
- N. Provide a two position terminal block for connecting supply wires which meet the following requirements:
 1. Insulate using nylon, porcelain, or phenolic material. Ensure phenolic terminal block is of adequate construction as approved by the Department.
 2. Fabricate terminals from nickel, tin plated brass, or aluminum.
- O. Equip fixture with MOV surge protection in accordance with IEEE recommendations.
 1. Connect MOV from line to neutral or from line to line.
 2. Install MOV on the terminal block.

Lamp & Socket:

- P. Provide #UL listed mogul base lamp sockets rated for 600 V, 1500 W that can withstand a 5000 V pulse. Meet #UL 496 requirements. Use porcelain-insulated lamp sockets with nickel plated copper alloy screw shells. Equip socket shell with a spring tensioned contact. Use nickel-plated copper alloy or stainless steel for the spring and contact.
- Q. Supply and secure lamps inside the fixture that meet the following:
 1. Use pre-qualified high pressure sodium (HPS) lamps from TxDOT's material producers list of the wattages shown on the plans. No alternatives allowed.
 2. Average rated lamp life 30,000 hours.
 3. Fully extinguish at end of usable lamp life and remain extinguished without cycling.
 4. Do not provide lamps that burn at reduced output at end of life.
 5. Meet the Federal Toxic Characteristic Leachate Procedure (TCLP) limits.

Performance:

- R. Meet the following photometric requirements using published photometric data and photometric data obtained by testing sampled fixtures.
 1. 150 Watt mast arm (underpass) mounted luminaire. Meet IESNA Cutoff requirements. Provide a minimum intensity of 0.20 foot-candle in a rectangular area measuring 110.0 ft. by 30.0 ft., when mounted in a level position as indicated on the properly mounted fixture level bubble 20.0 ft. above the midpoint of either long side of the surface area. Do not exceed 50:1 maximum to minimum horizontal illuminance uniformity ratio within the rectangular area.
 2. 250-watt mast arm mounted luminaire. Meet IESNA Cutoff requirements. Provide a minimum intensity of 0.20 foot-candle in a rectangular area measuring 190.0 ft. by 45.0 ft., when mounted properly in a level position as indicated on the level bubble 40.0 ft. above the midpoint either long side of the surface area. Ensure light intensities along a line parallel to and 20.0 ft. in from the long side of this rectangular area do not decrease by more than 0.50 foot-candles in any 5.0 ft. interval along the line from 10.0 ft. to 90.0 ft. on both sides of the luminaire and provide a minimum intensity of 0.30 foot-candles at any point along the line. Do not exceed 20:1 maximum-to-minimum horizontal illuminance uniformity ratio within the rectangular area.
 3. 400-watt mast arm mounted luminaire. Meet IESNA Cutoff requirements. Provide a minimum intensity of 0.20 foot-candle in a rectangular area measuring 220.0 ft. by 60.0 ft. when mounted properly in a level position as indicated on the level bubble 50.0 ft. above the midpoint of either long side of the surface area. Ensure light intensities along a line parallel to and 30.0 ft. in from the long side of this rectangular area do not decrease by more than 0.75 foot-candle in any 10.0 ft. interval along the line from 10.0 ft. to 90.0 ft. on both sides of the luminaire and provide a minimum intensity of 0.30 foot-candle at any point along the line. Do not exceed 20:1 maximum-to-minimum horizontal illuminance uniformity ratio within the rectangular area.
- S. Ensure photometric data is consistent from fixture to fixture. Match published photometric data (or approved photometric reports submitted during the prequalification process as the typical photometric output instead of published data) as follows:
 1. Point of maximum candela within 5 degrees horizontally and vertically.
 2. Maximum candela within 20% of published maximum candela.
 3. Fixture efficiency within 10% of published efficiency.

* When reference is made to UL, it can be considered to mean a Nationally Recognized Independent Testing Lab (NRTL). Comparable standards of Canadian Standard Association, Electrical Testing Laboratories or Factory Mutual can be equal to the referenced UL standard.

Sheet 1 of 2

Texas Department of Transportation
Traffic Operations Division

ROADWAY ILLUMINATION DETAILS

(RDWY ILLUM LIGHT FIXTURES)
RID(LUM1)-07

REVISIONS	DATE	BY	CHKD	APP'D	DESCRIPTION

72A

DISCLAIMER: The use of this standard is governed by the "Texas Engineering Practices Act". No warranty of any kind is made by TxDOT for any purpose whatsoever. TxDOT assumes no responsibility for the driver's selection of this standard to other formats or for incorrect results or damages resulting from its use.

DATE:
FILE:

SHEET 144 OF 163

The use of this standard is governed by the Texas Engineering Practice Act. No warranty of any kind is made by TxDOT for any purpose whatsoever. TxDOT assumes no responsibility for the conversion of this standard to other formats or for inaccurate results or damages resulting from its use.

DISCLAIMER:

DATE: FILE:

Prequalification:

- T. Use only pre-qualified fixtures. No alternates will be considered.
1. Only materials with approved product codes or designations from prequalified producers are accepted on bids. The Construction Division (CST) of the Texas Department of Transportation (TxDOT) maintains the material producers list of approved producer product codes or designations. Use the following website to view this list: http://www.dot.state.tx.us/business/producer_list.htm
Use of prequalified material does not relieve the contractor of the responsibility to provide materials that meet the specifications. All materials, including those shown on the prequalified material list, may be inspected and tested at any time and may be rejected if not in compliance with the specifications.
 2. Notify the Department in writing as to which fixture from the prequalified list of approved fixtures will be supplied on each project.
 3. To have a fixture listed as pre-qualified:
 - a. Submit a sample of each type of luminaire and all pertinent data, including published photometric data and recently tested photometric data (IES format, both "averaged" and both sides of "un-averaged" data) to: TxDOT- TRF 118 East Riverside Dr. Austin, TX 78704
 - b. Demonstrate a commitment to quality.
 - c. Submit the following documentation:
 1. QA/QC program documentation with the following minimum requirements:
 - a. Written statement of the company's QA/QC policy.
 - b. QA/QC person employed that has special QA/QC training and has QA/QC as their primary job responsibility.
 - c. A written procedure specifically for handling orders for fixtures built to TxDOT specifications.
 - d. A written procedure for keeping track of fixtures built, certified, and tested for TxDOT orders.
 - e. A check list of features for TxDOT fixtures with QA/QC person signature.
 2. Fixture UL certification
 3. IP 65 certification
 4. 3G certification
 5. Aluminum casting and paint analysis
 6. Socket, MOV, and shutoff ignitor data
 7. Stainless steel and aluminum bracket data
 8. Ballast electrical data
 9. Photometric data
 10. Lamp data
 - d. Prequalification samples, if approved, will not be returned to the manufacturer but will be retained by the Department for comparison testing. Once a fixture has been approved, do not change any material or manufacturing method without prior approval of the Department. Unapproved changes will result in rejection of the fixture.
 - e. In addition, luminaires will be tested for compliance with this specification. Luminaires that inconsistently pass testing or that are inconsistent with published photometric information will be removed from the pre-qualified list at the discretion of the Department.

Sampling:


U. Sample in accordance with Test Method Tex-1110-T, "Sampling Lighting Assemblies."

Manufacturer Warranty:


V. Replace failed fixtures, when non-operable due to defects in materials or workmanship within five years of installation with a fixture that passes all testing, delivered to the project location. Lamps and photocells are subject to the warranties of their respective manufacturers.

Testing:

- W. Conduct electrical testing required in the Ballast section. Provide photometric testing of fixtures. Test fixtures at the following rates.
1. Manufacturer Testing. Before fixtures are shipped from the manufacturer, test fixtures as follows. From each lot or manufacturing run, select one completed fixture of each 25, with a minimum of 2 and a maximum of 5. Test photometrics at an independent test lab inspected and approved by TxDOT. Electrical testing may be performed at manufacturer's facility.
 - a. Provide IES photometric report in two formats:
 1. Standard averaged format for asymmetric fixtures.
 2. Un-averaged format showing both sides. Un-averaged data may be supplied in two files or as approved by the Department.
 - b. Provide electrical and photometric test data directly to TRF-TE electronically for evaluation prior to shipping fixtures to the project. Do not ship fixtures until test data for each lot is approved by TRF-TE.
 - c. Provide the following information on test reports:
 1. TxDOT's Control-Section-Job number, maintenance contract number, or purchase order number the fixtures are assigned to,
 2. a unique fixture test number per fixture,
 3. date of manufacture, and
 4. quantities supplied and lot number per fixture type.
 - d. Write the unique lab report number on the top of the fixture housing with permanent marker. Ensure the test lab retains the results for 5 years. Provide the Department access to documentation.
 - e. Retain records of manufacturing lots, test reports, lot quantities, and other pertinent details. Submit records to the Department upon request.
 - f. Submit to TRF-TE a daily shipment report for shipments to each job.
 - g. Make available to TxDOT inspectors upon request, all manufacturing facilities involved in the production of fixtures for use on Department projects, inventories of fixtures produced to Department specifications, and records of fixture testing and tracking.
 2. Departmental Test Reporting. Departmental test reports will be issued in accordance with Tex 1110-T.

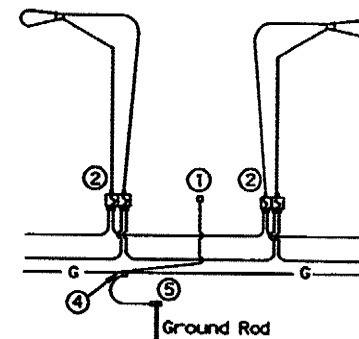

FOR THREE-WIRE CIRCUIT-CENTER GROUNDED LUMINAIRES SERVED AT 480V ON 240/480 VOLT SERVICE OR LUMINAIRES SERVED AT 240V FOR 120/240 VOLT SERVICE.

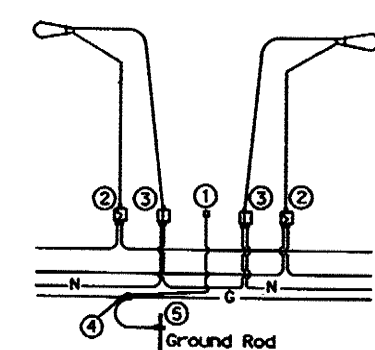

FOR FOUR-WIRE CIRCUIT-CENTER GROUNDED LUMINAIRES SERVED AT 240V (240/480 VOLT SERVICE)

NOTES:

- ① Use 1/2 in. -13 UNC threaded, copper or tin-plated copper, pole bonding connector, sized appropriately for conductors.
- ② ③ Use pre-qualified Breakaway Connectors for both T-Base and Shoe-Base installations.
- ④ Split Bolt or other connector.
- ⑤ Use Ground Rod Clamp listed for its intended purpose (i.e. concrete, direct burial...)

Sheet 2 of 2

Texas Department of Transportation
 Traffic Operations Division
ROADWAY ILLUMINATION DETAILS
 (RDWY ILLUM LIGHT FIXTURES)
RID (LUM2) -07

© TxDOT January 2007		REVISED	DATE	BY	REASON

SHEET 145 OF 163


DISCLAIMER: The use of this standard is governed by the Texas Engineering Practice Act. No warranty of any kind is made by TxDOT for any purpose whatsoever. TxDOT accepts no responsibility for the conversion of this standard to other formats or for incorrect results or damages resulting from its use.

LEVELS DISPLAYED
 ACC: d48hp1qr/usr/d482517
 Lvl.2 for English L3 for Metric




FDN TYPE	DRILLED SHAFT DIA	REINFORCING STEEL		DRILLED SHAFT LENGTH-ft			ANCHOR BOLT DESIGN				FOUNDATION DESIGN LOAD		TYPICAL APPLICATION
		VERT BARS	SPIRAL & PITCH	TEXAS CONE PENETROMETER N blows/ft			ANCHOR BOLT DIA	F _y (ksi)	BOLT CIR DIA	ANCHOR TYPE	MOMENT K-ft	SHEAR Kips	
				10	15	40							
24-A	24"	4- #6	#2 at 12"	5.7	5.3	4.5	3/4"	36	12 3/4"	1	10	1	Pedestal pole, pedestal mounted controller.
30-A	30"	8- #8	#3 at 6"	11.3	10.3	8.0	1 1/2"	55	17"	2	87	3	Most arm assembly. (see Selection Table)
36-A	36"	10- #8	#3 at 6"	13.2	12.0	9.4	1 3/4"	55	19"	2	131	5	Most arm assembly. (see Selection Table) 30' strain pole with or without luminaire.
36-B	36"	12- #8	#3 at 6"	15.2	13.6	10.4	2"	55	21"	2	190	7	Most arm assembly. (see Selection Table) Strain pole taller than 30' & strain pole with mast arm
42-A	42"	14- #8	#3 at 6"	17.4	15.6	11.9	2 1/4"	55	23"	2	271	9	Most arm assembly. (see Selection Table)

80 MPH DESIGN WIND SPEED	MAX SINGLE ARM LENGTH	FDN 30-A	FDN 36-A	FDN 36-B	FDN 42-A
		24' X 24'			
MAXIMUM DOUBLE ARM LENGTH COMBINATIONS	28' X 28'				
	32' X 28'				
	32' X 32'				
	36' X 36'				
100 MPH DESIGN WIND SPEED	MAX SINGLE ARM LENGTH				
	24' X 24'				
	28' X 28'				
	32' X 24'				
MAXIMUM DOUBLE ARM LENGTH COMBINATIONS	32' X 24'				
	32' X 32'				
	36' X 36'				
	40' X 36'				

EXAMPLE:
 1. For 80mph design wind speed, foundation 30-A can support up to a 32' arm with another arm up to 28'
 2. For 100mph design wind speed, foundation 36-A can support a single 36' mast arm.

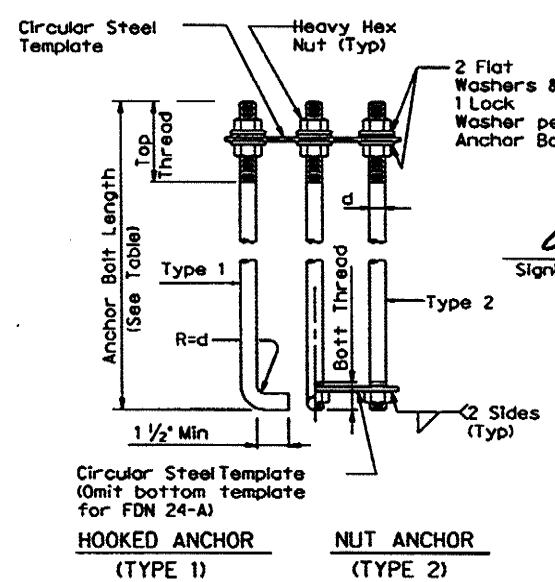



INSTALLATION PROCEDURE :
 Threads of anchor bolts shall be coated with pipe joint compound prior to installation of upper nuts when erecting pole. After pole is plumbed and in permanent alignment, the exposed threads of painted bolts shall be cleaned and an additional coating of zinc-rich paint applied to seal the bolt thread-nut joint.

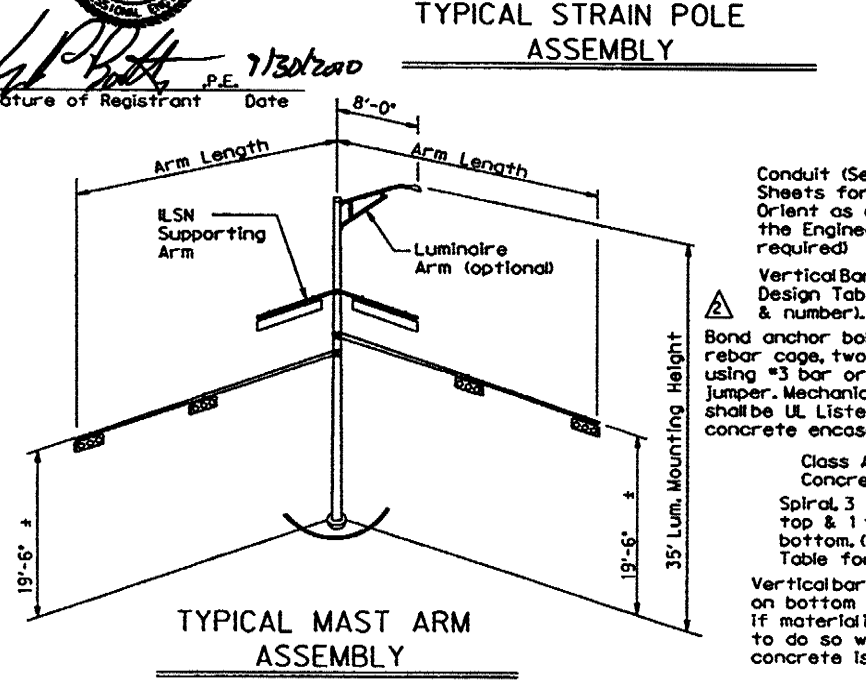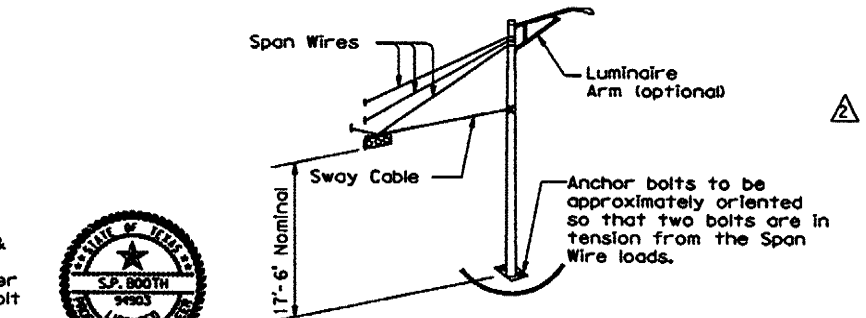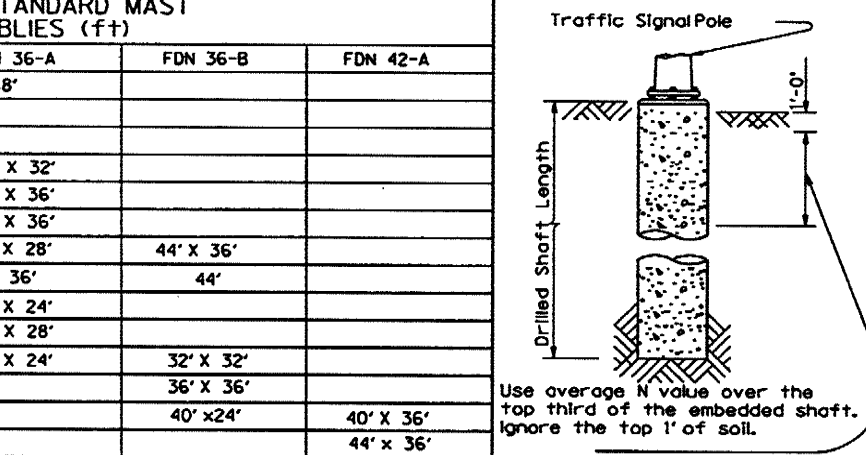

NOTES:
 ① Anchor bolt design develops the foundation capacity given under Foundation Design Loads.
 ② Foundation Design Loads are the allowable moments and shears at the base of the structure.
 ③ Foundations may be listed separately or grouped according to similarity of location and type. Quantities are for the Contractor's information only.
 ④ Field Penetrometer readings at a depth of approximately 3 to 5 feet may be used to adjust shaft lengths.
 ⑤ If rock is encountered, the Drilled Shaft shall extend a minimum of two diameters into solid rock.
 ⑥ Decimal lengths in Design Table are to allow interpolation for other penetrometer values. Round to nearest foot for entry into Summary Table.

BOLT DIA IN.	BOLT LENGTH	TOP THREAD	BOTT THREAD	BOLT CIRCLE	R ₂	R ₁
3/4"	1'-6"	3"	—	12 3/4"	7 1/8"	5 5/8"
1 1/2"	3'-4"	6"	2"	17"	10"	7"
1 3/4"	3'-10"	7"	2 1/4"	19"	11 1/4"	7 3/4"
2"	4'-3"	8"	2 1/2"	21"	12 1/2"	8 1/2"
2 1/4"	4'-9"	9"	3"	23"	13 3/4"	9 1/4"

⑦ Min dimensions given, longer bolts are acceptable.

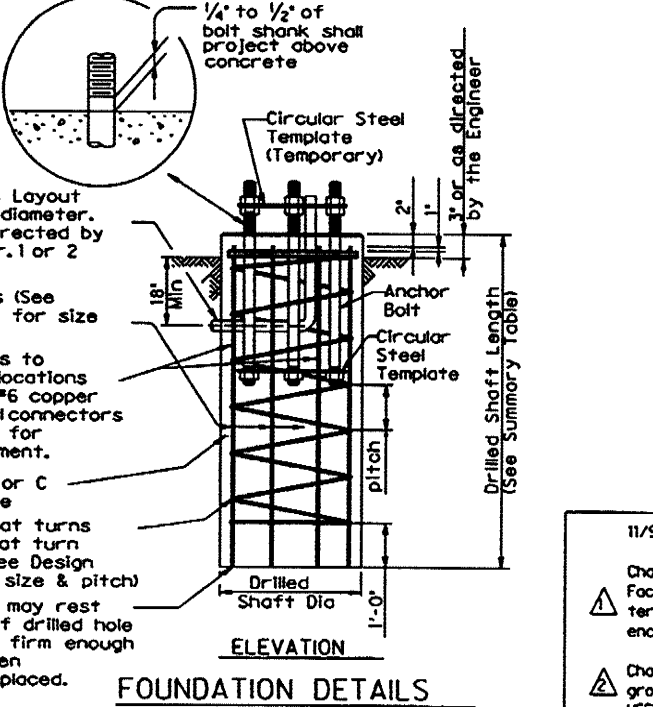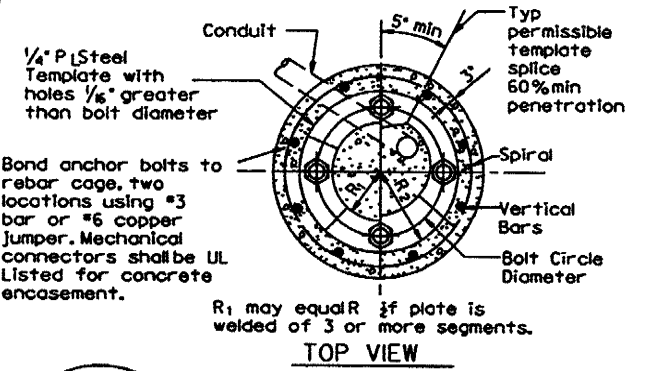

LOCATION IDENTIFICATION	AVG. N BLOW /ft.	FDN TYPE	NO. EA	DRILLED SHAFT LENGTH (FEET)				
				24-A	30-A	36-A	36-B	42-A
SPRING VALLEY								
AT	10	36-A	4			13		
VITRUVIAN PKWY								
TOTAL DRILLED SHAFT LENGTHS						52		

GENERAL NOTES :
 Design conforms to 1994 AASHTO Standard Specifications for Structural Supports for Highway Signs, Luminaires and Traffic Signals and Interim revisions thereto.
 Reinforcing steel shall conform to Item 440. Concrete shall be Class A or C.
 Threads for anchor bolts and nuts shall be rolled or cut threads of unified national coarse thread series except for A193B7 bolts which shall have 8 pitch thread series. Bolts and nuts shall have Class 2A and 2B fit tolerances. Galvanized nuts shall be tapped after galvanizing.
 Anchor bolts that are 1" in diameter or less shall conform to ASTM A36. Anchor bolts larger than 1" in diameter shall conform to A36M55 in accordance with the Item, "Anchor Bolts" or ASTM A193B7 or A687. Galvanize or coat with zinc-rich paint a minimum of the upper 14 inches of all anchor bolts unless otherwise noted. Exposed nuts shall be galvanized or coated with zinc-rich paint. Washers shall be galvanized. Templates and embedded nuts need not be galvanized.

STANDARD PLANS
 Texas Department of Transportation
 Traffic Operations Division

TRAFFIC SIGNAL
 POLE FOUNDATION

TS-FD-99

11/99 Revision
 Changed to Facilitate new terminal strip enclosure
 Changed from ground rod to UFER ground

© TxDOT August 1995
 5-96
 11-99

DISCLAIMER: The use of this standard is governed by the Texas Engineering Practice Act. No warranty of any kind is made by TxDOT for any purpose whatsoever. TxDOT assumes no responsibility for the conversion of this standard to other formats or for incorrect results or damages resulting from its use.


LEVELS DISPLAYED
 1 2 3 4 5 6 7 8 9 10 11 12 13 14 15 16
 ACC: d48hplq/uer/d482517
 Lvl. 2 for English 1,3 for Metric

Arm Length	ROUND POLES					POLYGONAL POLES					Foundation Type
	D ₈	D ₁₉	D ₂₄	D ₃₀	① thk	D ₈	D ₁₉	D ₂₄	D ₃₀	① thk	
20	10.5	7.8	7.1	6.3	.179	11.5	8.5	7.7	6.8	.179	30-A
24	11.0	8.3	7.6	6.8	.179	12.0	9.0	8.2	7.3	.179	30-A
28	11.5	8.8	8.1	7.3	.179	12.5	9.5	8.7	7.8	.179	30-A
32	12.5	9.8	9.1	8.3	.239	12.0	9.0	8.2	7.3	.239	30-A
36	12.0	9.3	8.6	7.8	.239	12.5	9.5	8.7	7.8	.239	36-A
40	12.0	9.3	8.6	7.8	.239	13.5	10.5	9.7	8.8	.239	36-A
44	12.5	9.8	9.1	8.3	.239	14.0	11.0	10.2	9.3	.239	36-A
48	13.0	10.3	9.6	8.8	.239	15.0	12.0	11.2	10.3	.239	36-A

Arm Length	ROUND ARMS					POLYGONAL ARMS				
	L ₁	D ₁	D ₂	① thk	Rise	L ₁	D ₁	D ₂	① thk	Rise
20	19.1	6.5	3.8	.179	1'-9"	19.1	7.0	3.5	.179	1'-8"
24	23.1	7.5	4.3	.179	1'-10"	23.1	7.5	3.5	.179	1'-9"
28	27.1	8.0	4.2	.179	1'-11"	27.1	8.0	3.5	.179	1'-10"
32	31.0	9.0	4.7	.179	2'-1"	31.0	9.0	3.5	.179	2'-0"
36	35.0	9.5	4.6	.179	2'-4"	35.0	10.0	3.5	.179	2'-1"
40	39.0	9.5	4.1	.239	2'-8"	39.0	9.5	3.5	.239	2'-3"
44	43.0	10.0	4.1	.239	2'-11"	43.0	10.0	3.5	.239	2'-6"
48	47.0	10.5	4.1	.239	3'-4"	47.0	11.0	3.5	.239	2'-9"

D₈ = Pole Base O.D.
 D₁₉ = Pole Top O.D. with no Luminaire and no ILSN
 D₂₄ = Pole Top O.D. with ILSN w/out Luminaire
 D₃₀ = Pole Top O.D. with Luminaire
 D₁ = Arm Base O.D.
 D₂ = Arm End O.D.
 L₁ = Shaft Length
 L = Nominal Arm Length


① Thickness shown are minimums, thicker materials may be used.
 ② D₂ may be increased by up to 1" for polygonal arms.

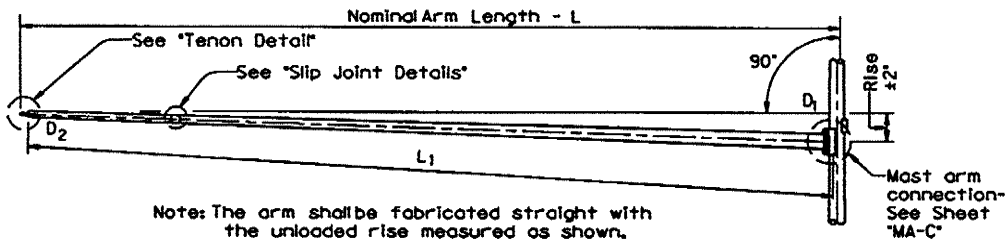

TRAFFIC SIGNAL ARM
(Fixed Mount)

VIBRATION WARNING

Most Arms of approximately 40' or longer are subject to possible harmonic vertical vibrations in light wind conditions due to unusual combinations of signal numbers, weights or positions, arm-wind orientation, and arm-pole stiffness. Arms shall be visually inspected in 5 to 20 mph wind conditions after signalhead installation and, if vertical movements with a total excursion (max positive to max negative) of more than approximately 8" are observed at arm tip, damping devices or other means shall be fitted to the arm(s). The necessary damping device(s) or other remedial measures shall be as recommended by the fabricator. Excessive vibrations shall not be allowed to continue for more than two days.

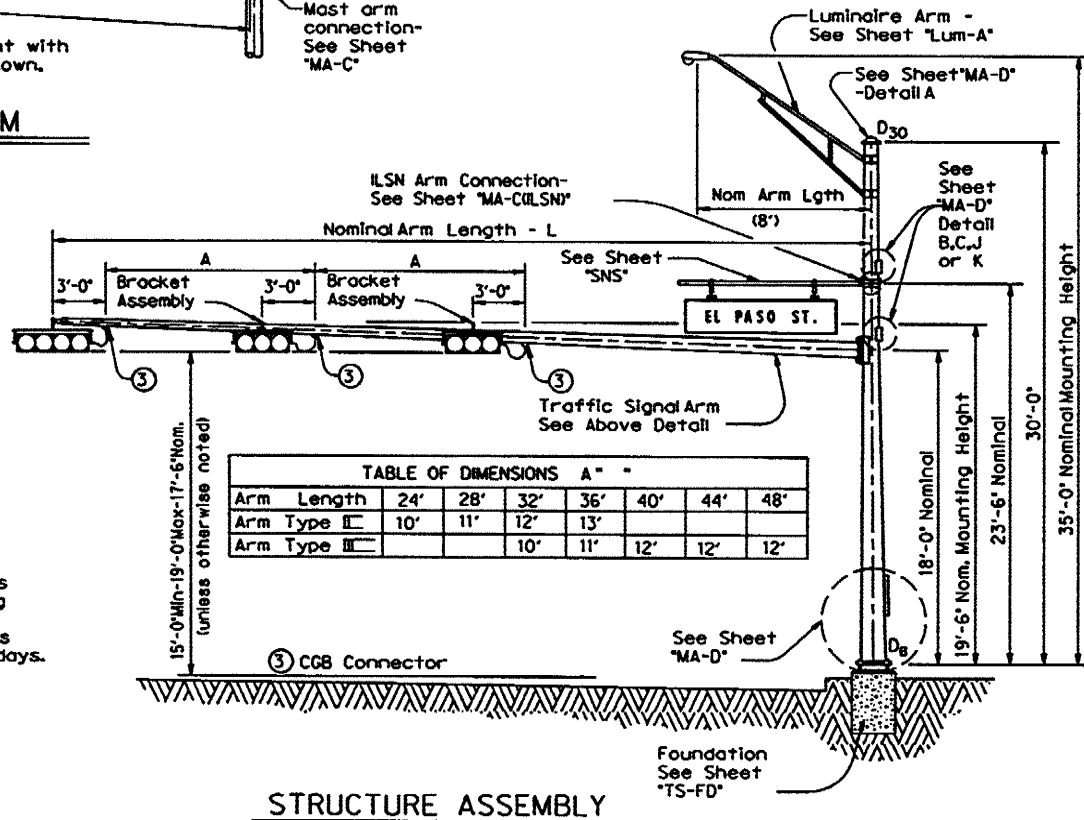

STRUCTURE ASSEMBLY

SHIPPING PARTS LIST

Ship each pole with the following attached: enlarged hand hole, pole cap, fixed-arm connection bolts and washers and any additional hardware listed in the table.

Nominal Arm Length	30' Poles With Luminaire		24' Poles With ILSN		19' Poles With No Luminaire and No ILSN	
	Above hardware plus: One (or two if ILSN attached) small hand hole, clamp-on simplex		Above hardware plus one small hand hole		See note above	
ft	Designation	Quantity	Designation	Quantity	Designation	Quantity
20	20L-80		20S-80		20-80	
24	24L-80		24S-80		24-80	
28	28L-80		28S-80		28-80	
32	32L-80		32S-80		32-80	
36	36L-80		36S-80	3	36-80	
40	40L-80		40S-80	1	40-80	
44	44L-80		44S-80		44-80	
48	48L-80		48S-80		48-80	

Traffic Signal Arms (1 per Pole)

Ship each arm with the listed equipment attached

Nominal Arm Length	Type I Arm (1 Signal)		Type II Arm (2 Signals)		Type III Arm (3 Signals)	
	1 CGB connector		1 Bracket Assembly and 2 CGB Connectors		2 Bracket Assemblies and 3 CGB Connectors	
ft	Designation	Quantity	Designation	Quantity	Designation	Quantity
20	20I-80					
24	24I-80		24II-80			
28	28I-80		28II-80			
32			32II-80		32III-80	
36			36II-80		36III-80	3
40					40III-80	1
44					44III-80	
48					48III-80	

Luminaire Arms (1 per 30' pole)

Nominal Arm Length	Quantity
8' Arm	

④ Supply Option 'A' unless otherwise noted

ILSN Arm (Max. 2 per pole) Ship with clamps, bolts and washers

Nominal Arm Length	Quantity
7' Arm	4
9' Arm	

Anchor Bolt Assemblies (1 per pole)

Anchor Bolt Diameter	Anchor Bolt Length	Quantity
1 1/2"	3'-4"	
1 3/4"	3'-10"	4

Each anchor bolt assembly consists of the following: Top and Bottom templates, 4 anchor bolts, 8 nuts, 8 flat washers, 4 lock washers and 4 nut anchor devices (Type 2) per Standard Drawing 'TS-FD'.

Templates may be removed for shipment.

SHEET 1 OF 2

Texas Department of Transportation
Traffic Operations Division

TRAFFIC SIGNAL
SUPPORT STRUCTURES
SINGLE MAST ARM ASSEMBLY
(80 MPH WIND ZONE)

SMA-80(1)-99

FILE	SMA-80.DGN	DATE	BY	CHK	APP	DATE	BY	CHK	APP
©TxDOT	August 1995	DIST	FED REG	FEDERAL AID PROJECT					
5-96		COUNTY	CONTROL	SECT	JOB	HOWDAY			



Signature of Registrant Date 9/20/2000

11/99 Revision


Changed to facilitate new terminal strip enclosure

SHEET 147 OF 163


122A

DISCLAIMER: The use of this standard is governed by the Texas Engineering Practice Act. No warranty of any kind is made by TxDOT for any purpose whatsoever. TxDOT assumes no responsibility for the conversion of this standard to other formats or for incorrect results or damages resulting from its use.

ACC: d48hplq/uar/d482517
 LEVELS DISPLAYED
 1 2 3 4 5 6 7 8 9 10 11 12 13 14 15 16
 17 18 19 20 21 22 23 24 25 26 27 28 29 30 31 32
 33 34 35 36 37 38 39 40 41 42 43 44 45 46 47 48
 49 50 51 52 53 54 55 56 57 58 59 60 61 62 63

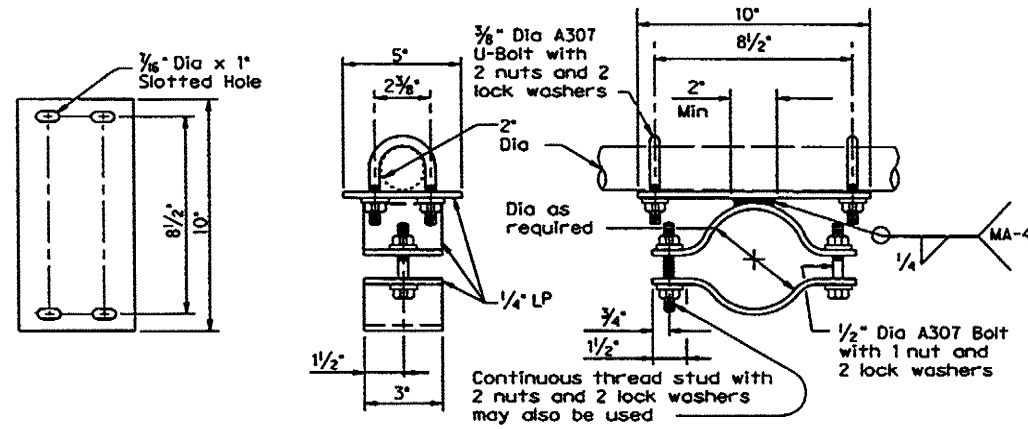

BRACKET ASSEMBLY DETAILS OPTION A

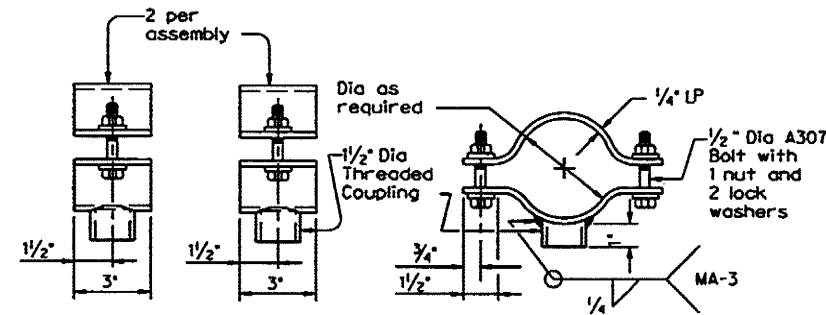


BRACKET ASSEMBLY DETAILS OPTION B


BRACKET ASSEMBLY OPTION C

Stainless steelbands and cast bracket as in 'Astro-Brac' with 1/2" Dia Threaded Coupling.

Second longitudinal Seam Weld is permitted for polygonal arms if D_1 exceeds 10"

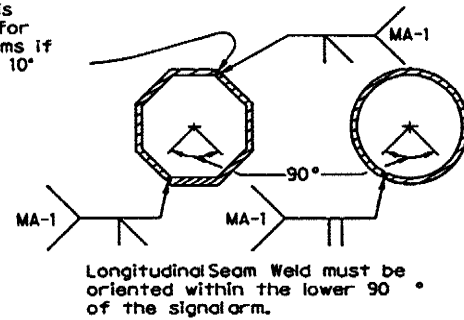

ARM WELD DETAIL

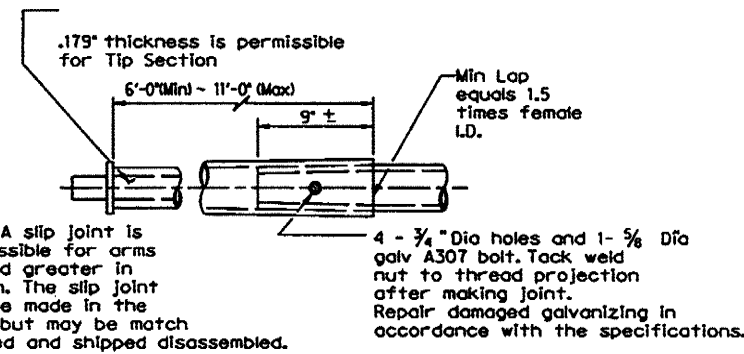

SLIP JOINT DETAIL

GENERAL NOTES:

Design conforms to 1994 AASHTO Standard Specifications for Structural Supports for Highway Signs, Luminaires, and Traffic Signals and Interim Specifications thereto. Design Wind Speed equals 80 mph plus a 1.3 gust factor.


Poles are designed to support one 8'-0" luminaire arm, one 9'-0" internally lighted street name sign and one traffic signal arm with a length as tabulated. The specified luminaire load applied at the end of the luminaire arm equals 75 lbs vertical dead load plus the horizontal wind load on an effective projected area of 1.5 sq ft. The specified internally lighted street name sign load applied 4.5 ft from the centerline of the pole equals 85 lbs vertical dead load plus horizontal wind load on an effective projected area of 11.5 sq ft. The specified signal load applied at the end of the traffic signal arm equals 180 lbs vertical dead load plus the horizontal wind load on an effective projected area of 32.4 sq ft (actual area times drag coefficient).

See Standard Sheet 'MA-D' for pole details, 'MA-C' for traffic signal arm connection details, 'MA-C (ILSN)' for internally lighted street name sign arm connection details, 'LUM-A' for luminaire arm and connection details, 'SNS' for internally lighted street name sign details, and 'TS-FD' for anchor bolt and foundation details. See 'MA-C' for materials specifications.


Fabrication shall be in accordance with the Specifications and with the details, dimensions, and weld procedures shown herein. Weld references call for preapproved weld procedures which the Fabricator must obtain prior to fabrication. Miscellaneous welds which do not call for preapproved weld procedures are nevertheless subject to rejection for poor workmanship. Materials, fabrication tolerances, and shipping practices shall meet the requirements of this sheet and the Specifications.

Unless otherwise noted, all parts shall be galvanized in accordance with the Specifications.

Special design require submission of shop drawings in accordance with the Item 'Steel Structures'.

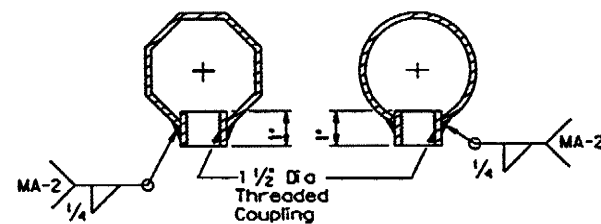

COUPLING DETAILS

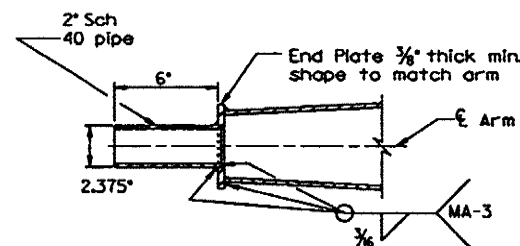

TENON DETAIL


Texas Department of Transportation
 Traffic Operations Division
TRAFFIC SIGNAL SUPPORT STRUCTURES
 SINGLE MAST ARM ASSEMBLY
 (80 MPH WIND ZONE)
SMA-80(2)-96

FILE: SMA-80.DGN	CHK MS	CHK JSY	CHK BMB	CHK JSY
©TxDOT August 1995	DIST	FED REG	FEDERAL AID PROJECT	SHEET
5-96	REVISING	6		446
	COUNTY	CONTROL	SECT	JOB
				MONDAY

The use of this standard is governed by the "Texas Engineering Practice Act". No warranty of any kind is made by TxDOT for any purpose whatsoever. TxDOT assumes no responsibility for the conversion of this standard to other formats or for incorrect results or damages resulting from its use.

DISCLAIMER


ARM SIZE		A	B	C	D	E	CONN. BOLT DIA.
D ₁	±	in.	in.	in.	in.	in.	in.
6.5	.179	12	9	9	6	1 3/4	1
7.5	.179	13	9	10	6	1 3/4	1
8.0	.179	14	10	11	7	2	1 1/4
9.0	.179	16	11	13	8	2	1 1/4
9.5	.179	17	12	14	9	2	1 1/4
9.5	.239	18	12	15	9	2	1 1/4
10.0	.239	18	12	15	9	2	1 1/4
10.5	.239	18	13	15	10	3	1 1/2
11.0	.239	18	13	15	10	3	1 1/2

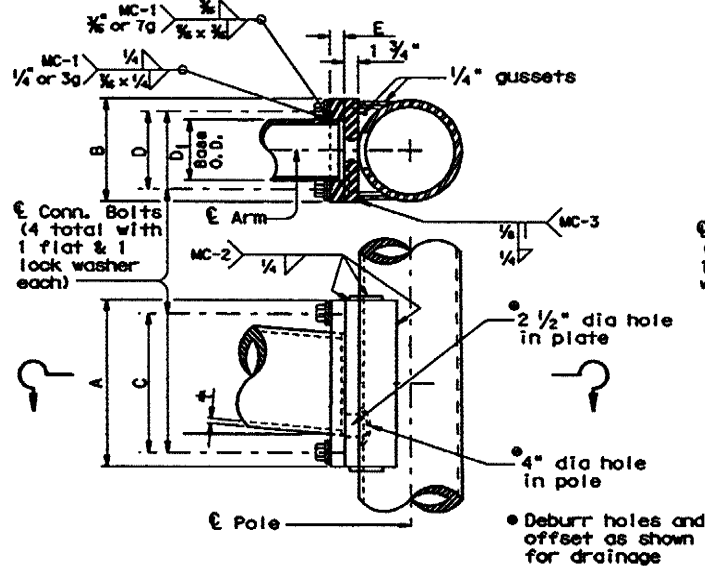

FIXED MOUNT DETAIL 1


ARM SIZE		A	F	CONN. BOLTS		PIN BOLTS	
D ₁	±	in.	in.	No.	Dia	No.	Dia
6.5	.179	12	8	4	3/4	2	3/8
7.5	.179	14	8	4	1	2	3/8
8.0	.179	14	8	4	1	2	3/8
9.0	.179	16	10	4	1	2	3/8
9.5	.179	18	12	4	1 1/4	3	3/8
9.5	.239	18	12	4	1 1/4	3	3/8
10.0	.239	18	12	4	1 1/4	3	3/8

*1" Dia connection bolts are permissible

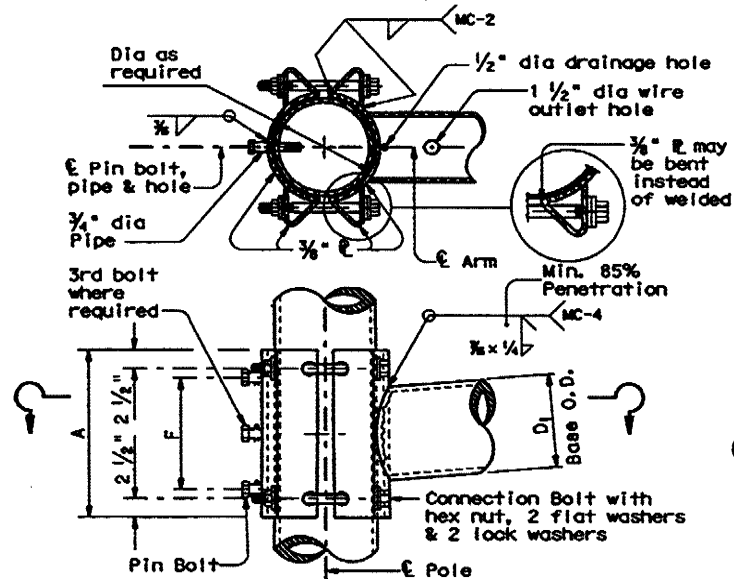


CLAMP-ON DETAIL 1

ARM SIZE		A	B	C	D	E	CONN. BOLT DIA.
D ₁	±	in.	in.	in.	in.	in.	in.
7.0	.179	11	11	8	8	1 3/4	1 1/4
7.5	.179	11	11	8	8	1 3/4	1 1/4
8.0	.179	11	11	8	8	2	1 1/4
9.0	.179	13	13	10	10	2	1 1/4
10.0	.179	13	13	10	10	2	1 1/4
9.5	.239	13	13	10	10	2	1 1/4
10.0	.239	14	14	11	11	2	1 1/2
11.0	.239	14	14	11	11	3	1 1/2
11.5	.239	14	14	11	11	3	1 1/2

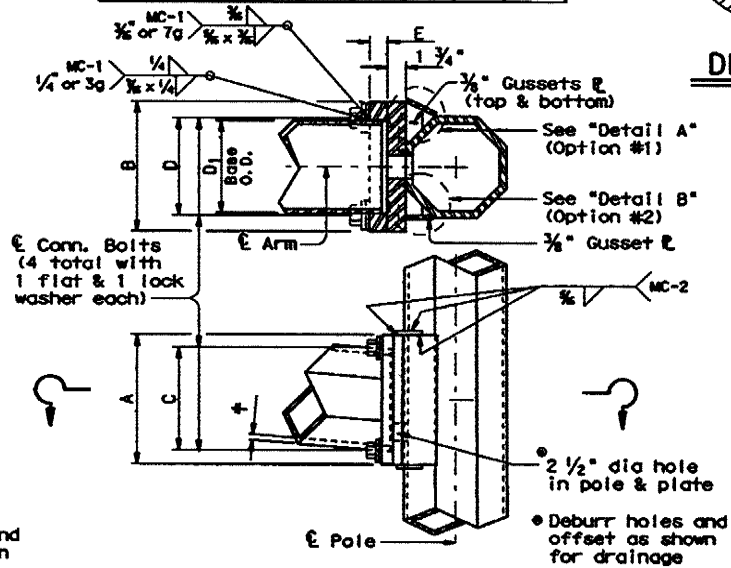


FIXED MOUNT DETAIL 2


ARM SIZE		A	F	T	CONN. BOLTS		PIN BOLTS	
D ₁	±	in.	in.	in.	No.	Dia	No.	Dia
7.0	.179	12	8	3/4	4	3/4	2	3/8
7.5	.179	14	8	3/4	4	3/4	2	3/8
8.0	.179	14	8	3/4	4	3/4	2	3/8
9.0	.179	16	10	3/4	4	1	2	3/8
10.0	.179	18	10	3/4	4	1	2	3/8
9.5	.239	18	10	1	6	1	3	3/8
10.0	.239	18	10	1	6	1	3	3/8

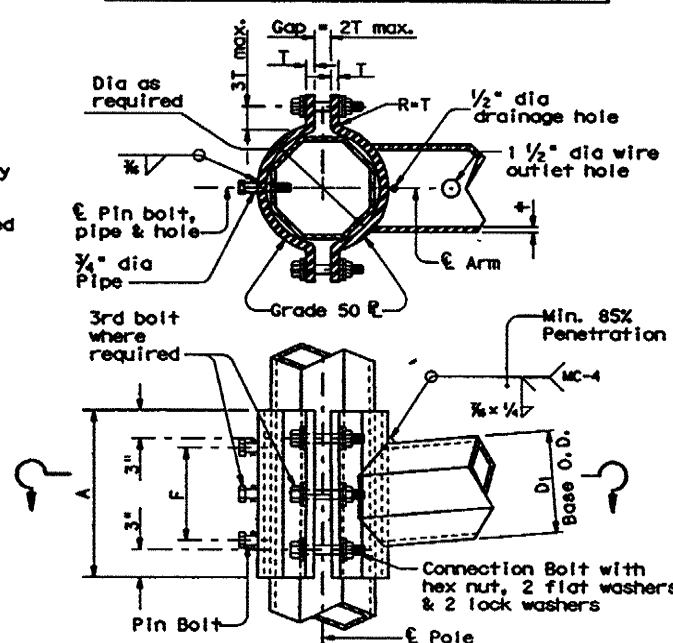


CLAMP-ON DETAIL 2

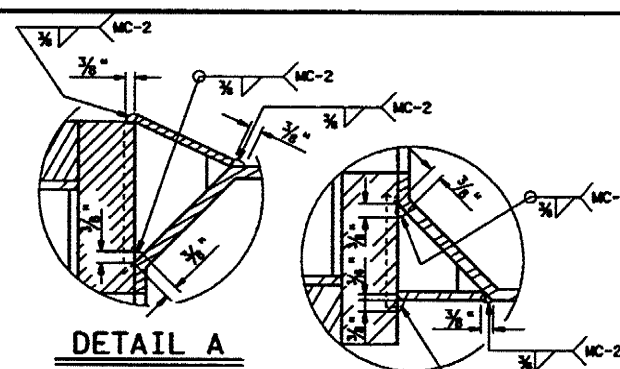


DETAIL A

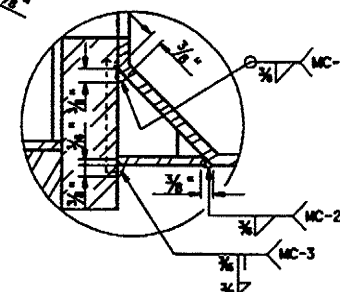

DETAIL B

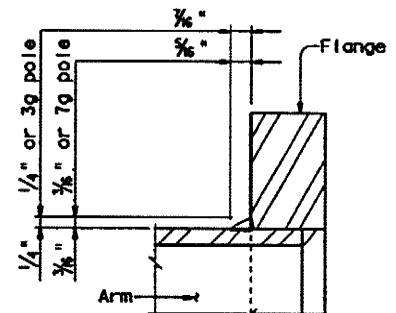

FIXED MOUNT ARM

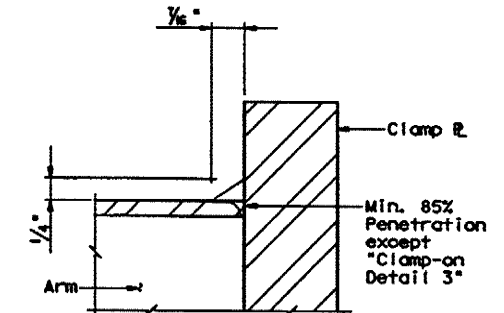

CLAMP-ON ARM

ARM BASE WELD DETAILS

GENERAL NOTES:

Clamp-on details are used for the second arm on dual mast arm assemblies. A Maximum 1 1/2" wide vertical slotted hole may be cut in the front clamp plate to facilitate drainage during galvanizing. The slot shall be centered behind the arm and shall be no longer than the arm diameter minus 1"

Fixed mount details are used for single mast arm assemblies and for the first arm on dual mast arm assemblies.

Where duplicate parts occur on a detail, welds shown for one part shall apply to all similar parts on the detail.

Pin bolts are required to prevent rotation of clamp-on arms under design wind forces.

NOTE:

Pin bolts shall be A325 with threads excluded from the shear plane. Pin bolt and 3/4" dia pipe shall have 3/8" dia holes for a 1/2" dia galvanized copper pin. Back clamp plate shall be furnished with a 3/4" dia hole for each pin bolt. An 1/2" dia hole for each pin bolt shall be field drilled through the pole after arm orientations have been approved by the Engineer.

Texas Department of Transportation
Traffic Operations Division

**STANDARD ASSEMBLY
FOR TRAFFIC SIGNAL
SUPPORT STRUCTURES
MAST ARM CONNECTIONS**


MA-C-09

REVISIONS	DATE	BY	CHKD	APP'D
5-96				
5-09 Connection & Thk E				


DISCLAIMER: The use of this standard is governed by the "Texas Engineering Practice Act". No warranty of any kind is made by TxDOT for any purpose, and no liability is assumed for any results or damages resulting from its use.

DATE: FILE:


TABLE OF DIMENSIONS for ILSN Support Arm Clamp-on Details 1, 2 and 3					
ILSN ARM SIZE	A	F	CONN. BOLTS		PIN BOLTS
	in.	in.	No.	Dia	No. Dia
3 in. dia Schedule 40 Pipe	10	8	4		2 $\frac{5}{8}$

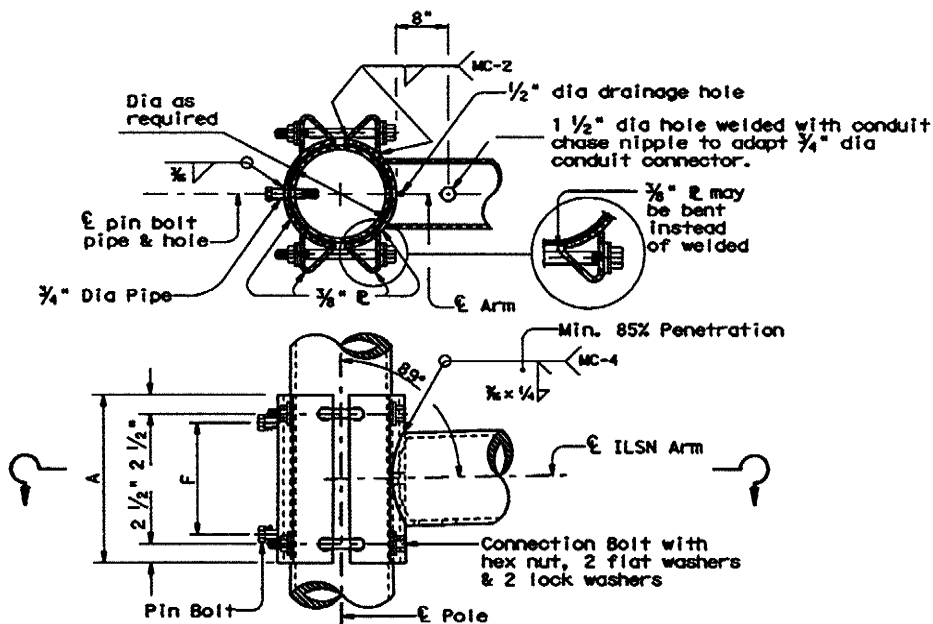

ILSN CLAMP-ON DETAIL 1

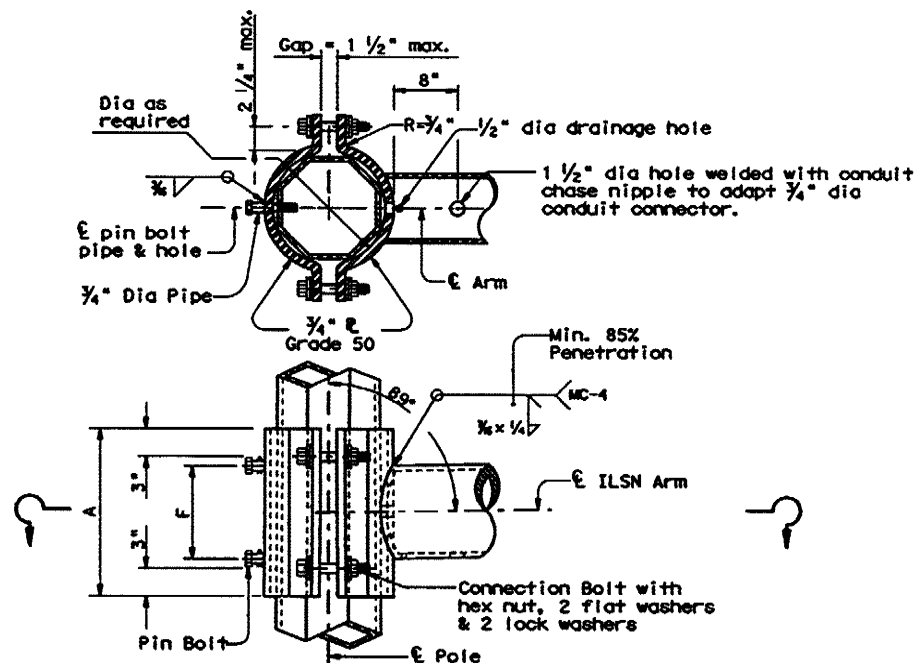

ILSN CLAMP-ON DETAIL 2

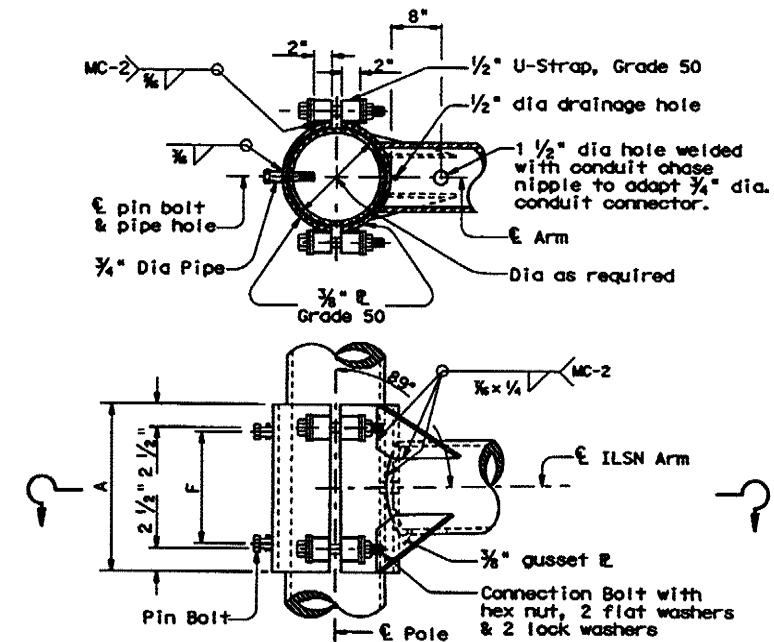

ILSN CLAMP-ON DETAIL 3

GENERAL NOTES:


Clamp-on details shall be used for ILSN support arm assemblies. A 1 1/2 inch diameter hole shall be cut in the front clamp plate for wiring access. A matched hole shall be field drilled through the pole to provide wire access after arm is oriented. Deburr both holes.

Where duplicate parts occur on a detail, welds shown for one part shall apply to all similar parts on the details.


Pin bolts are required to prevent rotation of clamp-on arms under design wind forces.

NOTE:

Pin bolts shall be A325 with threads excluded from the shear plane. Pin bolt and 3/4 inch dia pipe shall have 3/8 inch dia holes for a 1/4 inch dia galvanized cotter pin. Back clamp plate shall be furnished with a 3/4 inch dia hole for each pin bolt. An 1/8 inch dia hole for each pin bolt shall be field drilled through the pole after arm orientations have been approved by the Engineer.

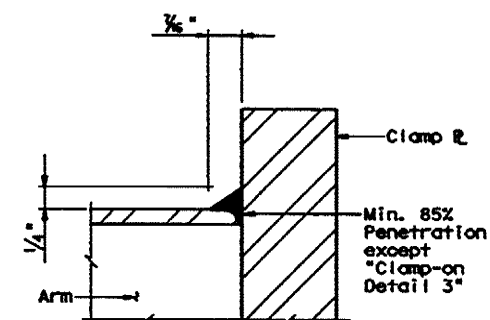


CLAMP-ON ARM
ARM BASE WELD DETAILS


 Texas Department of Transportation
 Traffic Operations Division
**STANDARD ASSEMBLY
 FOR TRAFFIC SIGNAL
 SUPPORT STRUCTURES**
 MAST-ARM CONNECTIONS
MA-C (ILSN) -96

REVISONS	DATE	BY	CHKD	APP'D
	5-96			

DISCLAIMER: The use of this standard is governed by the "Texas Engineering Practice Act". No warranty of any kind is made by TxDOT for any purpose whatsoever. TxDOT assumes no responsibility for the conversion of this standard to other formats or for incorrect results or damages resulting from its use.

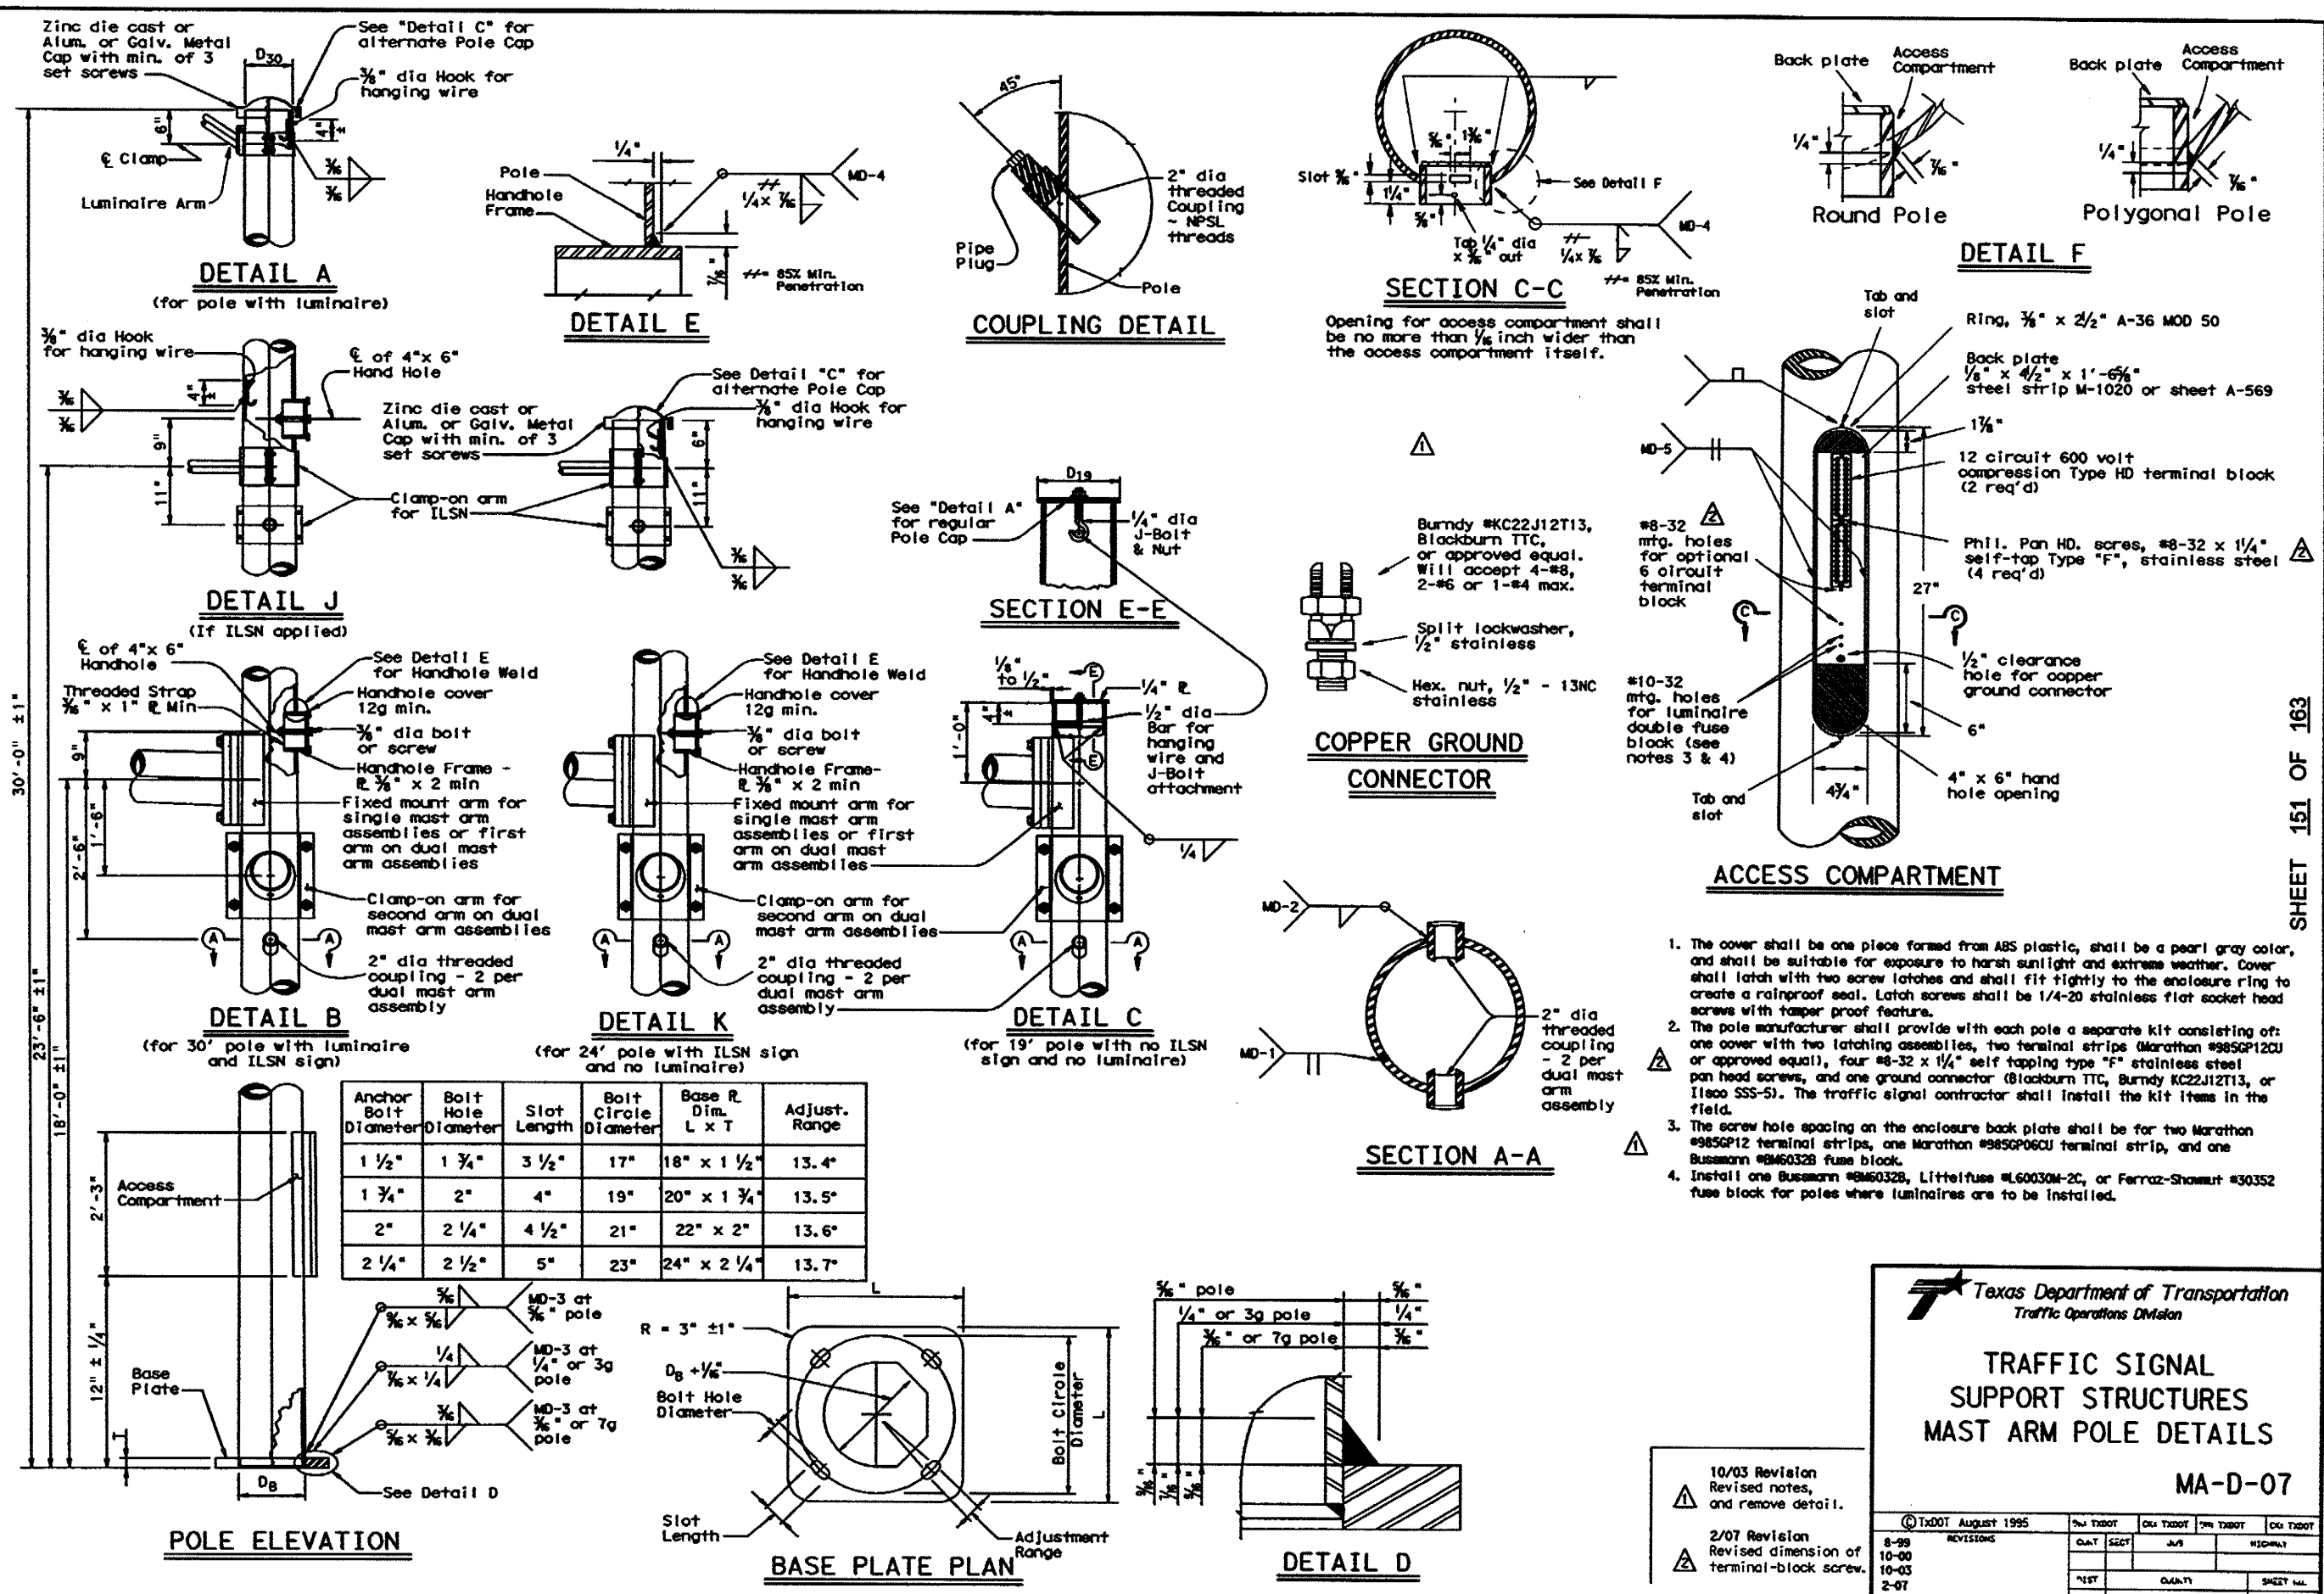

Anchor Bolt Diameter	Bolt Hole Diameter	Slot Length	Bolt Circle Diameter	Base R. Dim. L x T	Adjust. Range
1 1/2"	1 3/4"	3 1/2"	17"	18" x 1 1/2"	13.4"
1 3/4"	2"	4"	19"	20" x 1 3/4"	13.5"
2"	2 1/4"	4 1/2"	21"	22" x 2"	13.6"
2 1/4"	2 1/2"	5"	23"	24" x 2 1/4"	13.7"

- The cover shall be one piece formed from ABS plastic, shall be a pearl gray color, and shall be suitable for exposure to harsh sunlight and extreme weather. Cover shall latch with two screw latches and shall fit tightly to the enclosure ring to create a rainproof seal. Latch screws shall be 1/4-20 stainless flat socket head screws with tamper proof feature.
- The pole manufacturer shall provide with each pole a separate kit consisting of: one cover with two latching assemblies, two terminal strips (Marathon #985GP12CU or approved equal), four #8-32 x 1/4" self tapping type "F" stainless steel pan head screws, and one ground connector (Blackburn TTC, Burndy KC22J12T13, or ILSco SSS-5). The traffic signal contractor shall install the kit items in the field.
- The screw hole spacing on the enclosure back plate shall be for two Marathon #985GP12 terminal strips, one Marathon #985GP06CU terminal strip, and one Busmann #BM6032B fuse block.
- Install one Busmann #BM6032B, Littelfuse #L60030M-2C, or Ferraz-Shawmut #30352 fuse block for poles where luminaires are to be installed.

Texas Department of Transportation
Traffic Operations Division

**TRAFFIC SIGNAL
SUPPORT STRUCTURES
MAST ARM POLE DETAILS**

MA-D-07

10/03 Revision Revised notes, and remove detail.
2/07 Revision Revised dimension of terminal-block screw.


© TxDOT AUGUST 1995

8-99	10-00	10-03	2-07
REVISED	REVISED	REVISED	REVISED
DATE	BY	CHKD	APP'D


127

DISCLAIMER: The use of this standard is governed by the "Texas Engineering Practice Act". No warranty of any kind is made by TxDOT for any purpose whatsoever. TxDOT assumes no responsibility for the conversion of this standard to other formats or for incorrect results or damages resulting from its use.


TOP VIEW
(Slab & Base)

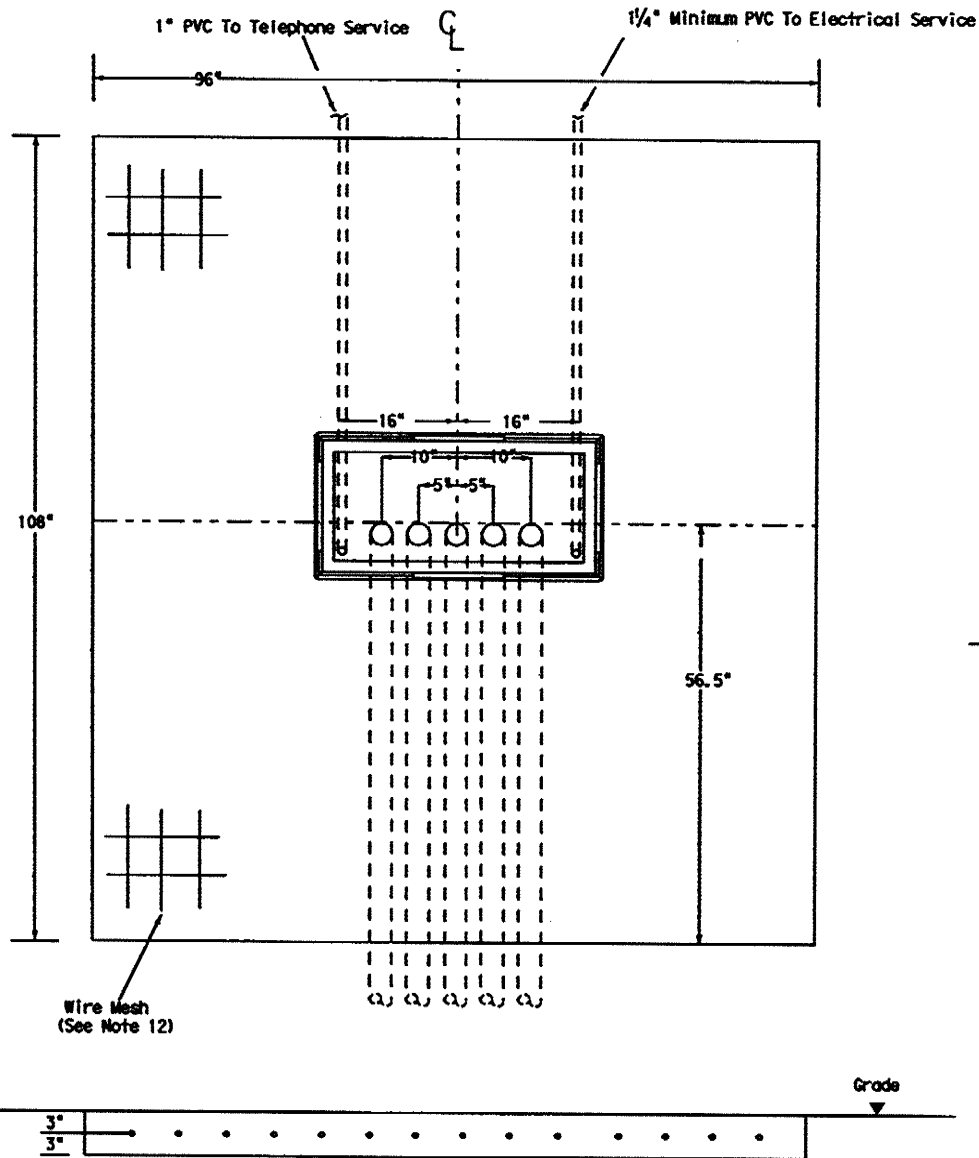

SIDE VIEW
(Slab & Base)

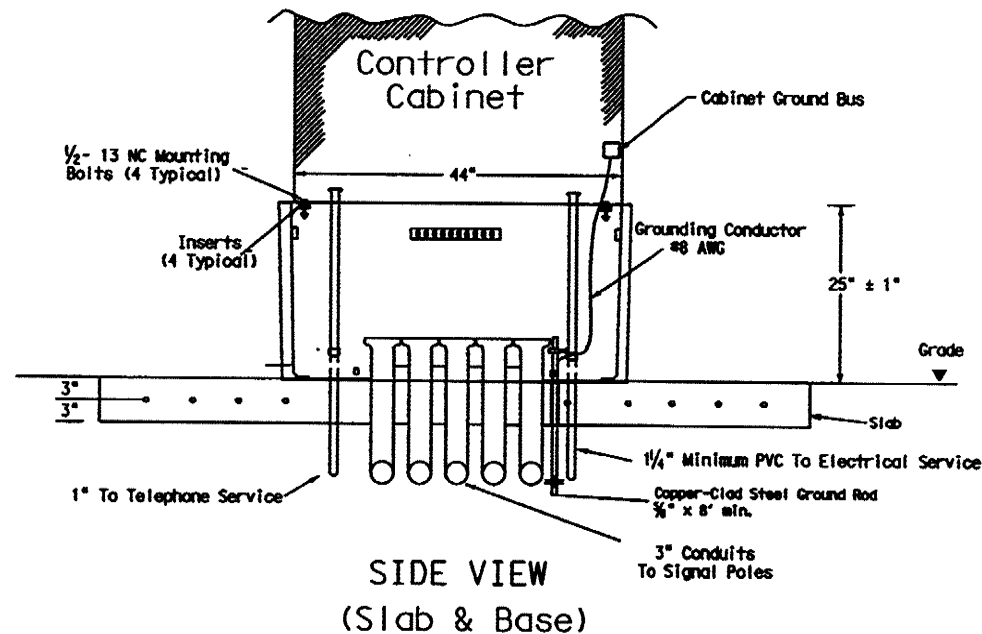

CABINET BASE

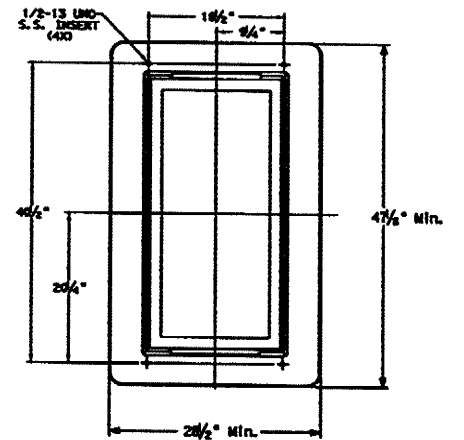

TRAFFIC SIGNAL CONTROLLER BASE:

1. Provide a traffic signal controller base (cabinet base) manufactured of polymer concrete material consisting of calcareous and siliceous stone; glass fibers and thermoplastic polyester resin. The polymer concrete cabinet base must be reinforced on the inside of the cabinet base with fiberglass matting. Provide one of the following bases: Armurocast Part # A6001848224, Quartzite Model # P630482709, or other as approved by TxDOT Traffic Operation Division.
 2. The polymer concrete material must have a minimum compressive strength of 10,300 pounds per square inch (psi), minimum flexural strength of 3600 psi, and minimum shear strength of 3600 psi.
 3. The polymer concrete cabinet base must conform to the dimensions shown and must accommodate a standard TxDOT base-mount cabinet.
 4. Supply the cabinet base with four 1/2"-13 UNC stainless steel inserts for attachment of the cabinet to the base. Inserts must withstand a minimum torque of 50 ft-lb and a minimum straight pull out strength of 750 lbs.
 5. Provide the cabinet base with 4 cable racks mounted one on each side of the base 2" to 7" from the top edge of the base. Unless approved otherwise, cable racks must be 1-1/2 x 3/8 x 3/8 inch steel channel with eight T-slots spaced at 1-1/2 inches. The cable racks must easily accommodate the insertion of tie wraps to attach field wiring to the racks to serve as strain relief. Secure cable racks to the base using 1/2"-13 UNC stainless steel screws and inserts.
 6. The cabinet base, when secured to the concrete slab with controller cabinet attached, must withstand a minimum wind load of 125 mph or a 850 lb force applied at 45° above the bottom of the base without causing the base or cabinet to come out of their anchored position or cause any permanent deformation. The manufacturer must supply certification by an independent testing laboratory or sealed by a Texas Licensed Professional Engineer. Provide the cabinet base with hardware for attachment to a concrete slab.
 7. The traffic signal base must be permanently marked either by impress or by permanent ink with the manufacturer's model number and name or logo.
 8. Seal the base to the concrete with a silicone caulk bead and fastened to the slab per manufacturer's instructions.
- CONCRETE SLAB:**
9. Traffic signal controller pad must be a portland cement concrete slab poured in place, must conform to the dimensions shown, and must be level.

10. Bond a #8 AWG copper ground wire and an 8 ft ground rod bonded to the reinforcing mesh by a suitable UL Listed clamp and terminated to the cabinet grounding bus for the purpose of providing a local ground for the electrical grounding conductor. The electrical grounding conductor specified in Item 680-3.A.4 is required and must be terminated to the cabinet ground bus.
11. Install a PVC sleeve to prevent the ground rod from direct embedment in the slab.
12. Provide welded wire mesh 6X6-W2.9 X W2.9 for reinforcement. Provide joints and splices in the mesh with a minimum 6-inch overlap. Center the mesh between top and bottom and provide a minimum 3 inch cover on the edges.
13. Provide Class B concrete minimum for the slab in accordance with Item 421. Construct the slab in accordance with Item 531.

CONDUITS:

14. Stub up and run 3-inch conduits through the slab to the various traffic signal poles and ground bases as shown on the layouts. Install the number of conduits as shown on layouts plus two additional 3 inch conduits for future use. Terminate the conduits with a bushing between 2 and 4-inches above the slab.
15. Extend conduits for future use at least 18-inches from the edge of the slab, terminate underground with a coupling, and cap and seal so that the seal can be removed without damaging the coupling. This must also apply to unused telephone conduit.
16. Stub up two separate conduits through the slab from the electrical and telephone services. Run the conduit for the electrical feed directly to the electrical service enclosure. Run the conduit for the telephone line directly to the telephone service, usually located on the same pole as the electrical service. Telephone must not under any circumstance share a conduit with any other function.
17. Terminate electric and telephone conduits above the slab with a coupling. After the base is installed, extend the conduits above the top of the base and secure to the base using a steel one-hole strap or similar suitable substitute.

CONTROLLER CABINET:

18. Anchor the controller cabinet to the base using four stainless steel 1/2"-13 NC bolts.
19. The silicone caulk bead specified in Item 680.3.B must be RTV 133.

PAYMENT:

20. Bid TS-CF as subsidiary to Item 680.





DATE: FILE:




**TRAFFIC SIGNAL
CONTROLLER CABINET
BASE AND PAD**

TS-CF-04


© TxDOT October 2000	DATE	BY	CHKD	APP'D
12-04	REVISIONS	DATE	BY	APP'D
	REV	DATE	BY	APP'D
	REV	DATE	BY	APP'D

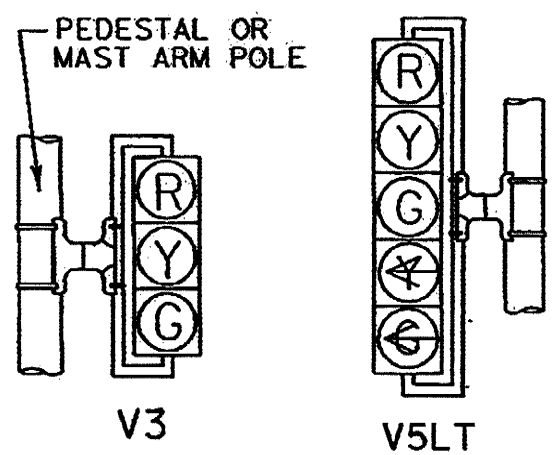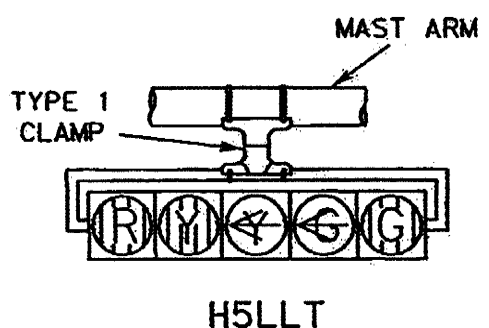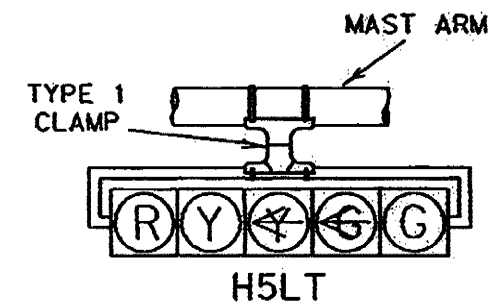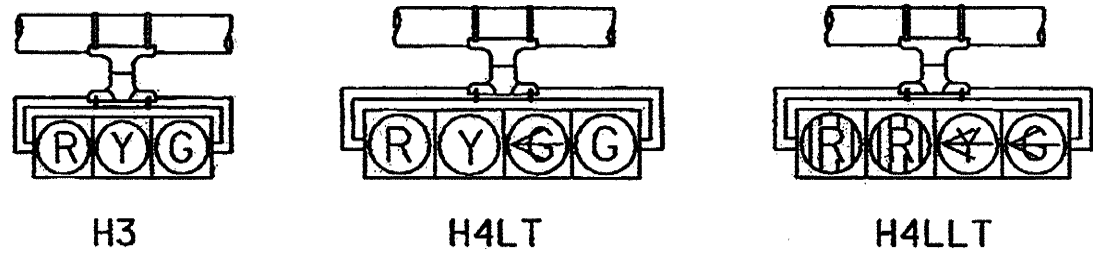


NOTE: VERTICAL LOUVERS SHALL BE INSTALLED ON HORIZONTAL MOUNTED SIGNALS, HORIZONTAL LOUVERS SHALL BE INSTALLED ON VERTICAL MOUNTED SIGNAL WHEN NEEDED.

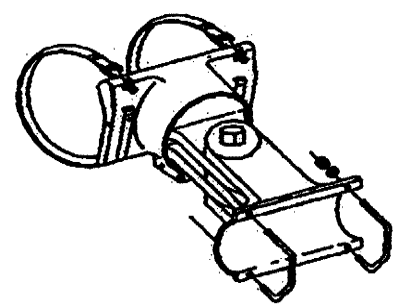


TYPE 2 CLAMP KIT
SHALL BE INSTALLED WHEN ROTATION ABOUT THE HORIZONTAL AND VERTICAL AXES ARE NEEDED.

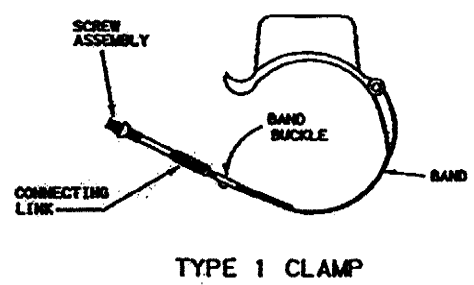


NOTE:
CLAM SHELL MOUNTING HARDWARE MAY BE USED INSTEAD OF MOUNTING HARDWARE SHOWN ABOVE, AS APPROVED BY THE ENGINEER. ICC P/N 4805 OR OR MCCAIN QUICKMOUNT OR APPROVED EQUAL.

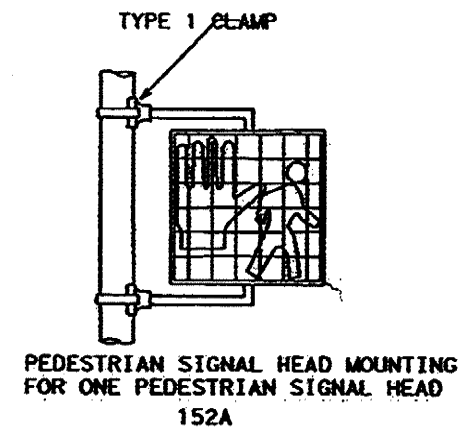





NOTE:
THE POLE ON THIS DRAWING IS SHOWN AS AN EXAMPLE ONLY. POLES OF SIMILAR DESIGN FOR ANY CROSS SECTION WHICH MEET THE SPECIFICATIONS AND REQUIREMENTS SHOWN ON THESE DRAWINGS AND ARE APPROVED BY THE ENGINEER WILL BE DEEMED ACCEPTABLE.

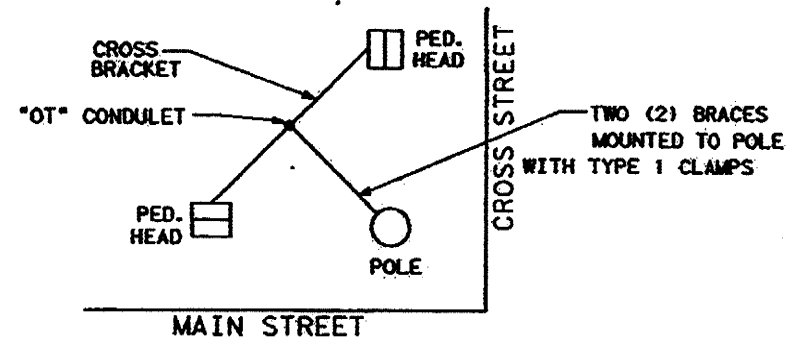

PEDESTRIAN SIGNAL HEAD MOUNTING FOR TWO PEDESTRIAN SIGNAL HEADS 143C

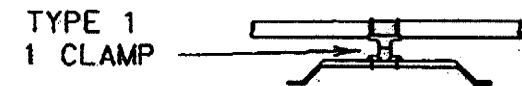

- * ONE (1) CLAMP SHALL BE USED ON SIGNS LESS THAN OR EQUAL TO 10 FT IN LENGTH.
- * TWO (2) CLAMPS SHALL BE USED ON SIGNS GREATER THAN 10 FT IN LENGTH.

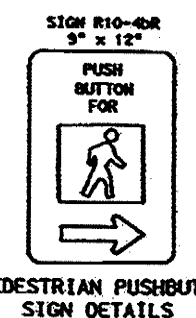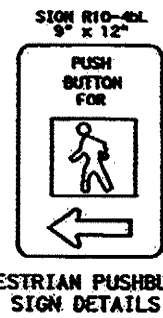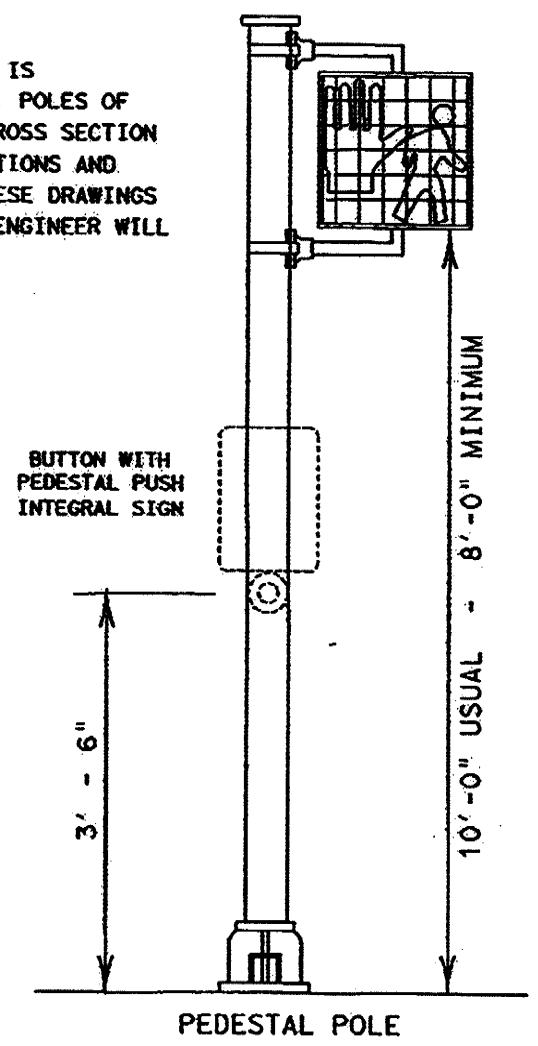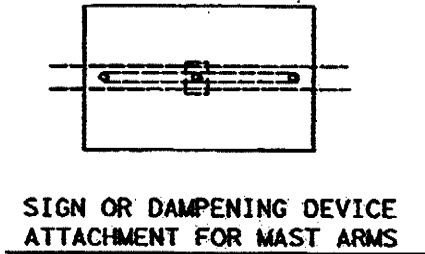

PEDESTRIAN PUSHBUTTON SIGN DETAILS


- NOTES:
1. VEHICLE AND PEDESTRIAN SIGNAL HEADS SHALL BE MOUNTED WITH TYPE 1 CLAMP AND APPROPRIATE TUBING.
 2. ALL POLE MOUNTED VEHICLE AND PEDESTRIAN HEADS SHALL BE INSTALLED ON THE AWAY-FROM-TRAFFIC SIDE OF THE PEDESTAL OR MAST ARM POLE.
 3. ALL DAMPING DEVICES SHALL BE 18" TO 24" WIDE BY 4 FT IN LENGTH.
 4. ALL WIRING FOR PEDESTRIAN SIGNALS SHALL BE TOTALLY ENCLOSED WITHIN THE SIGNAL MOUNTING HAREWARE.
 5. ALL PEDESTRIAN SIGNAL HEADS AND PUSH BUTTON SIGNS SHALL DISPLAY THE SYMBOLIZED MESSAGES SHOWN ABOVE.

ALTERNATIVE MOUNTING METHOD revised 12-92
* REVISED 3-7-97

TRAFFIC SIGNAL AND PEDESTRIAN HEAD IDENTIFICATION

© TXDOT
DALLAS DISTRICT STANDARD

NO.	DATE	BY	CHKD.
6			
STATE	COUNTY	CITY	
TEXAS	DALLAS	DALLAS	
DATE	BY	CHKD.	APPROVED BY

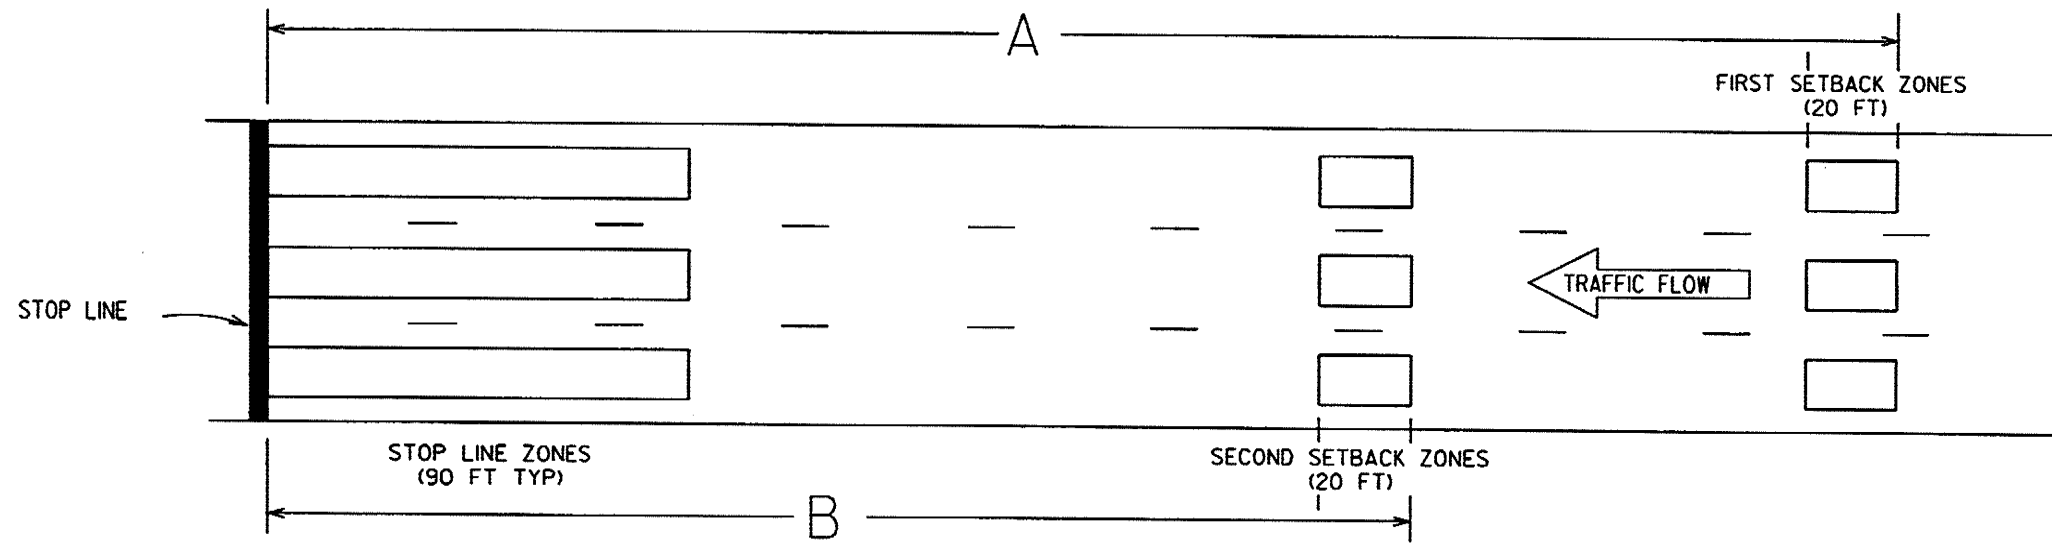


ADVANCE DETECTION ZONE LAYOUT

APPROACH SPEED LIMIT (MPH)	DISTANCE A (FT) ¹	DISTANCE BETWEEN CAMERA AND STOP LINE (FT) ²	CAMERA HEIGHT (FT)									
			24	28	32	36	40	24	28	32	36	40
			DISTANCE B (FT)					EXTENSION ON 2ND DET. ZONE (SEC.)				
60	470	80	280	295	305	310	315	0.0	0.0	0.0	0.5	0.5
		150	270	285	295	300	310	0.0	0.0	0.0	0.0	0.5
55	430	80	255	265	275	280	285	0.0	0.0	0.0	0.5	0.5
		150	245	255	265	275	280	0.0	0.0	0.0	0.0	0.5
50	390	50	235	245	250	255	260	0.0	0.0	0.5	0.5	0.5
		150	220	230	240	245	250	0.0	0.0	0.0	0.0	0.5
45	350	50	210	215	220	225	230	0.0	0.0	0.5	0.5	0.5
		150	190	200	210	215	220	0.0	0.0	0.0	0.0	0.5

NOTES:

- Distances shown are based on a 20' detection zone and a 1.0 second passage time setting.
- Distance between the camera and the stop line, as measured parallel to the direction of travel.



Texas Department of Transportation
 © 2004 Dallas District

VIDEO DETECTION ZONE PLACEMENT


VDZ-04 (DAL)

© TxDOT September 2004	THI	CDB	BES	TRF-AUS.
REVISIONS	FED. RD. DIV. NO.	PROJECT NUMBER		HIGHWAY NO.
04/06/05	6	VITRU		VITRU
	STATE	DISTRICT	COUNTY	SHEET NO.
	TEXAS	DALLAS		
	CONTROL	SECTION	JOB	

DISCLAIMER: The use of this standard is governed by the "Texas Engineering Practice Act". No warranty of any kind is made by TxDOT for any purpose whatsoever. TxDOT assumes no responsibility for the performance of this standard to other formats or for inaccuracy or for inaccuracy resulting from its use.

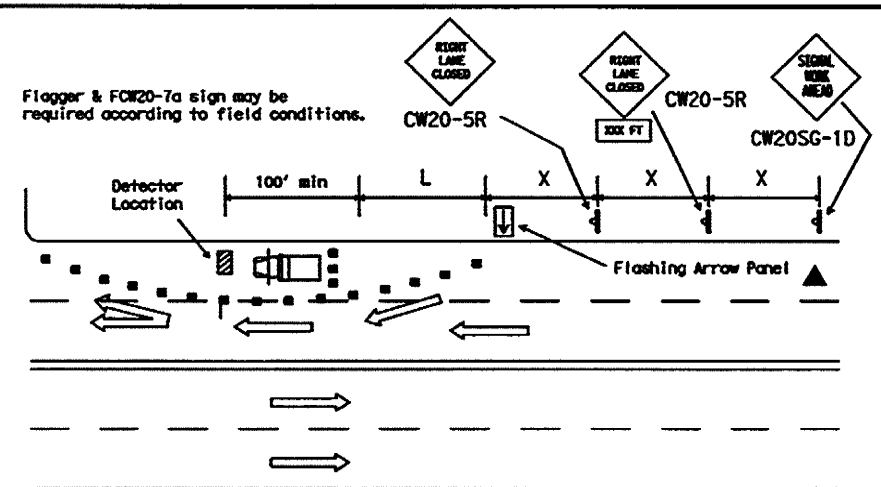


Daytime - Four Lane Roadway

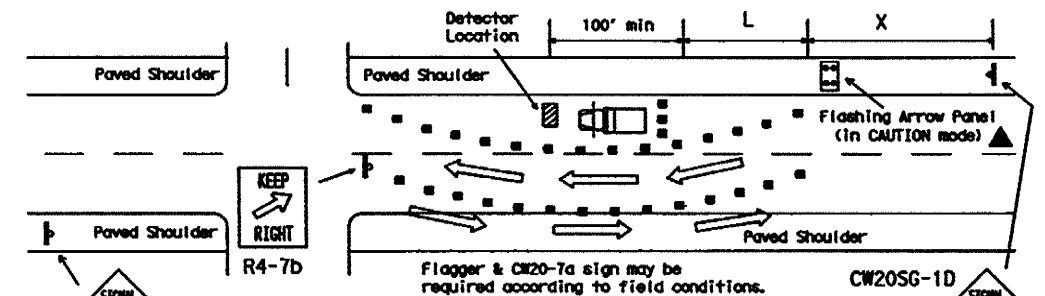

Daytime - Two Lane Roadway

TYPICAL DETECTOR INSTALLATION OR OTHER WORK OPERATIONS THAT ARE SHORT TERM OR SHORT DURATION

Nighttime Channelizing Devices shall be reflectorized.

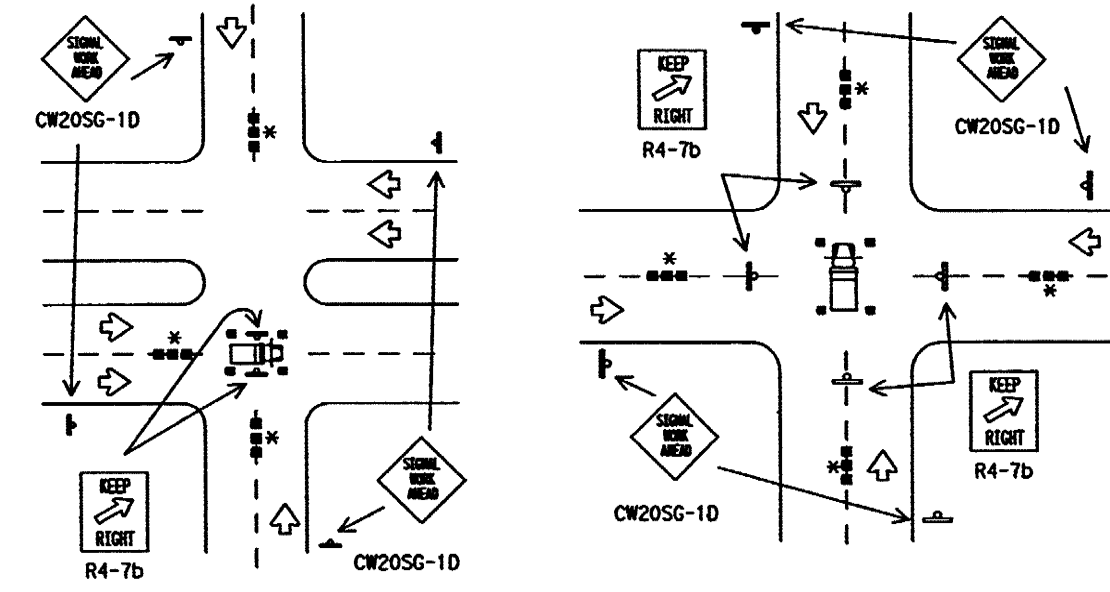


TYPICAL HANGING SIGNAL INSTALLATIONS OR OTHER WORK OPERATIONS THAT ARE SHORT TERM OR SHORT DURATION

* Advance warning channelizing devices are optional.

Posted Speed	Formula	Minimum Desirable Taper Lengths $\frac{1}{2}L$			Suggested Maximum Spacing of Device			Minimum Sign Spacing $\frac{1}{2}L$
		10' Offset	11' Offset	12' Offset	On a Taper	On a Tangent	X Distance	
30	$L = \frac{WS^2}{60}$	150'	165'	180'	30'	60'-75'	120'	
35		205'	225'	245'	35'	70'-90'	160'	
40		265'	295'	320'	40'	80'-100'	240'	
45	$L = WS$	450'	495'	540'	45'	90'-110'	320'	
50		500'	550'	600'	50'	100'-125'	400'	
55		550'	605'	660'	55'	110'-140'	500'	
60		600'	660'	720'	60'	120'-150'	600'	
65		650'	715'	780'	65'	130'-165'	700'	
70	700'	770'	840'	70'	140'-175'	800'		
75	750'	825'	900'	75'	150'-185'	900'		


**Taper lengths have been rounded off.
L-Length of Taper (FT.) 1'-Sixth of Offset (FT.) 5-Posted Speed MPH

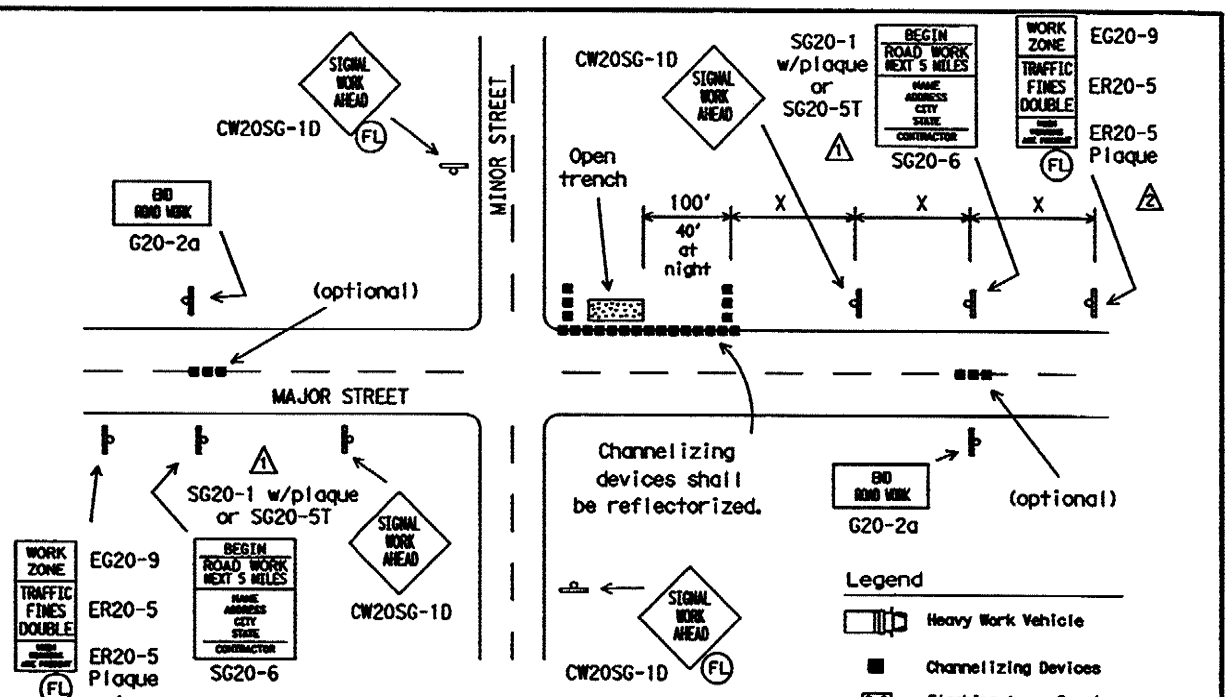

TYPICAL ADVANCE SIGNING FOR LONG TERM and INTERMEDIATE-TERM STATIONARY WORK OPERATIONS

Observe Warning Signs State Law (R20-3) shall be required. See BC(2). Location will be as directed by the Engineer.

- Legend
- Heavy Work Vehicle
 - Channelizing Devices
 - Flashing Arrow Panel
 - Flashing Warning Light

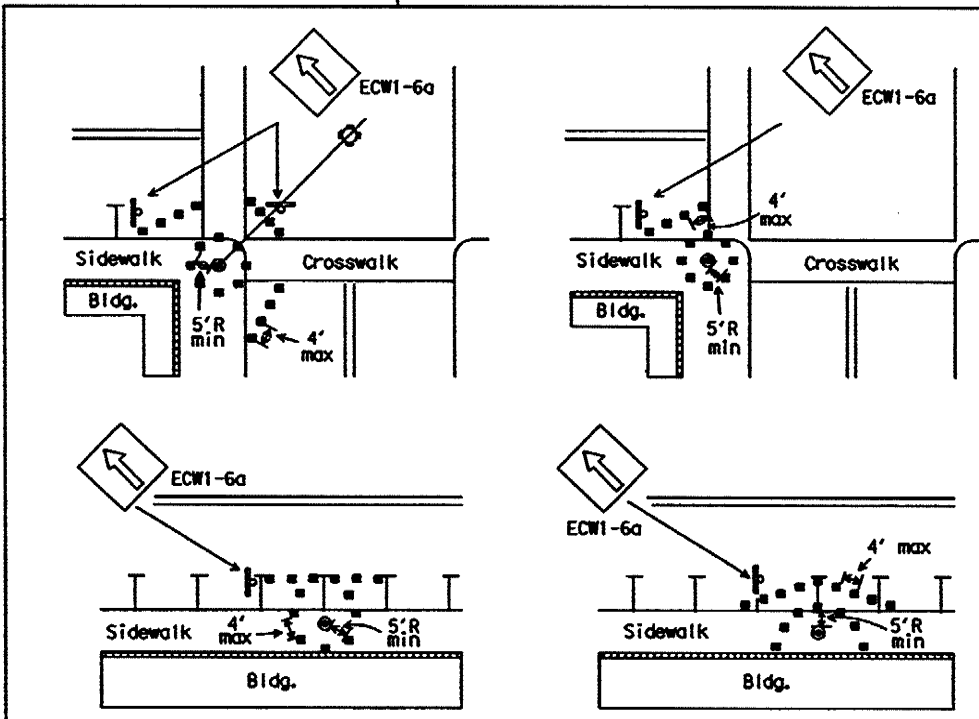

Channelizing devices should not be placed closer than 5 foot radius (minimum) to signal poles. Parking may be eliminated by placing channelizing devices in spaces. If pedestrian walkways are blocked, refer to the Texas Manual on Uniform Traffic Control Devices (TMUTCD) Part 6.

TYPICAL RESTRICTED PEDESTRIAN MOVEMENTS FOR ALL WORK OPERATIONS REGARDLESS OF WORK DURATION

- The arrow panel may be omitted when stated elsewhere in the plans.
- Typical channelizing device is the 28" cone.
- Plastic drums or vertical panels may be used if approved by the Engineer.
- For several closely adjoining projects, advance signing may not be required in advance of each intersection, but only in advance of the intersections at the project limits.
- See details elsewhere in the plans for advance signing requirements.
- Advance signs shall be in place when signal construction operations are in progress.
- The contractor shall remove advance signs when no construction operations are underway.
- Obstructions or hazards at the work area shall be clearly marked and delineated at all times.
- All holes, trenches or other hazardous areas shall be adequately protected by lights or other protective devices.
- Trenches shall be covered or surrounded with orange plastic construction fence as directed by the Engineer.
- Flagger and FCW20-7a sign may be required according to field conditions.
- Vehicles parked in roadway shall be equipped with two strobes.
- High level flags at corners of vehicle may also be used.
- Work operations that require work vehicle in traveled way 20 minutes or less may use cones, high level flags and strobes as advance warning devices.
- Cones should only be placed around vehicle.
- Flaggers may be used on high speed rural intersections.

Texas Department of Transportation Traffic Operations Division



TRAFFIC SIGNAL INSTALLATION TYPICAL DETAILS

SHEET 1 OF 2 WZ(BTS-1)-03

DATE	REVISIONS	BY	CHKD	DATE	BY	CHKD
2-98						
4-98						
10-99						
3-03						


DISCLAIMER: The use of this standard is governed by the "Texas Engineering Practice Act". No warranty of any kind is made by TxDOT for any purpose whatsoever. TxDOT assumes no responsibility for the conversion or modification of this standard to other formats or for incorrect results or damages resulting from its use.

"ABOVE LANE" WORK PERFORMED BY BUCKET TRUCK

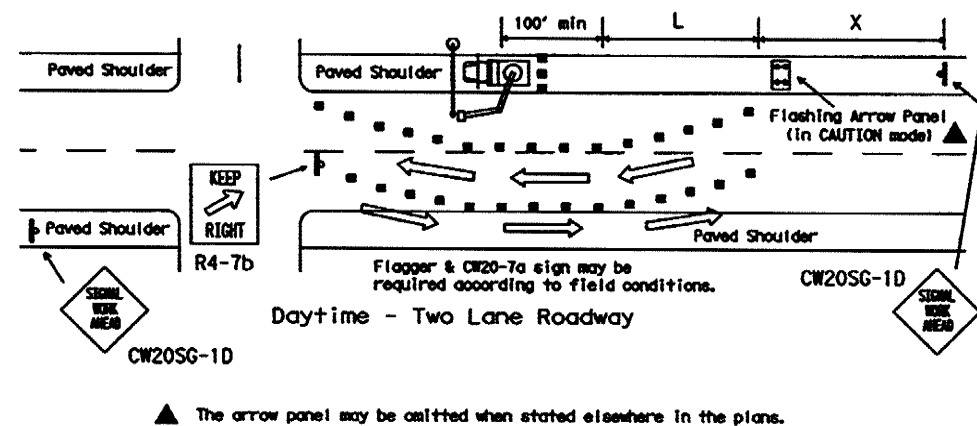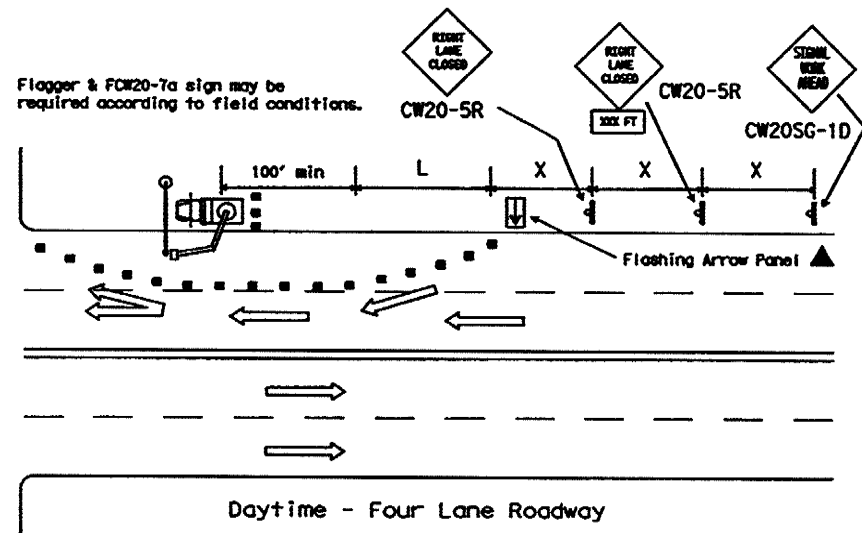

▲ The arrow panel may be omitted when stated elsewhere in the plans.

"ABOVE TRUCK" WORK PERFORMED BY BUCKET TRUCK

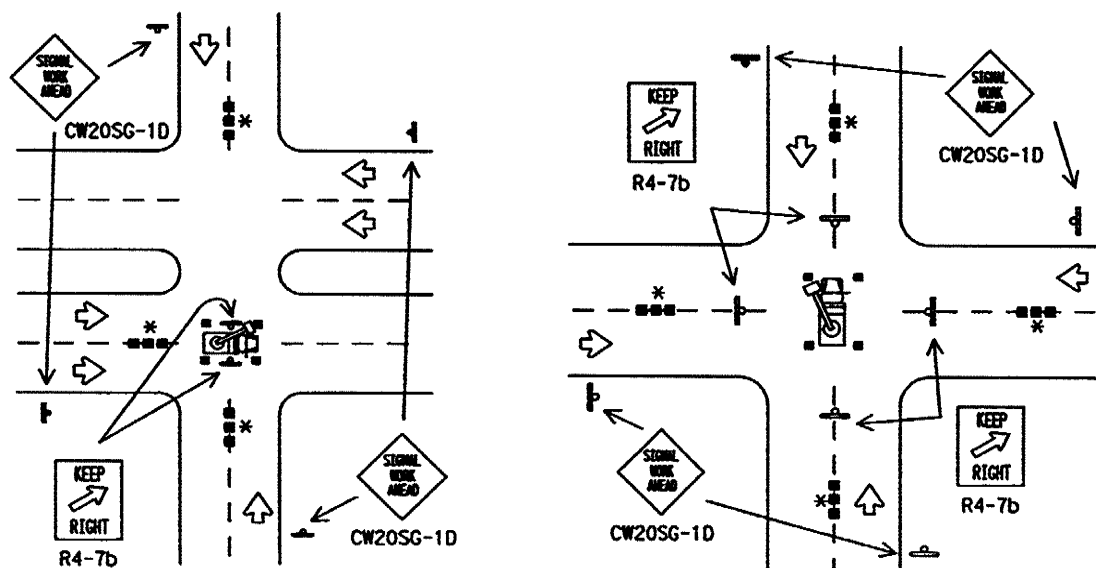

DATE: FILE:

GENERAL NOTES FOR WORK ZONE SIGNS

- Contractor shall install and maintain signs in a straight and plumb condition and/or as directed by the Engineer.
- Wooden sign posts shall be painted white.
- Barricades shall NOT be used as sign supports.
- Nails shall NOT be used to attach signs to any support.
- All signs shall be installed in accordance with the plans or as directed by the Engineer. Signs shall be used to regulate, warn, and guide the traveling public safely through the work zone.
- The Contractor may furnish either the sign design shown in the plans or in the "Standard Highway Sign Designs for Texas" (SHSD). The Engineer/Inspector may require the Contractor to furnish other work zone signs that are shown in the "Texas Manual on Uniform Traffic Control Devices" (TMUTCD) but may have been omitted from the plans. Any variation in the plans shall be documented by written agreement between the Engineer and the Contractor's Responsible Person. All changes must be documented in writing before being implemented. This can include documenting the changes in the Inspector's TxDOT diary and having both the Inspector and Contractor initial and date the agreed upon changes. The additional signs requested by the Engineer/Inspector shall not be subsidiary.
- The Contractor shall furnish sign supports listed in the "Compliant Work Zone Traffic Control Device List" (CWZTCD). The Contractor shall install the sign support in accordance with the manufacturer's recommendations. If there is a question regarding installation procedures, the Contractor shall furnish the Engineer a copy of the manufacturer's installation recommendations so that the Engineer can verify the correct procedures are being followed.
- The contractor is responsible for sign installations and replacing signs with damaged or cracked substrates and/or damaged or marred reflective sheeting as directed by the Engineer/Inspector.
- Identification markings may be shown only on the back of the sign substrate. The maximum height of letters and/or company logos used for identification shall be 1".
- The Contractor shall replace damaged wood posts. New or damaged wood sign posts shall not be spliced.

Duration of Work (as defined by the TMUTCD Part 6)

The types of sign supports, the size of signs, and the type of sign substrates can vary based on the type of work being performed. The Engineer is responsible for selecting the appropriate size sign for the type of work being performed. The Contractor is responsible for ensuring that the sign support and substrate meets crashworthiness and length of work requirements.

- Long-term stationary is work that occupies a location more than 3 days.
- Intermediate-term stationary is work that occupies a location more than one daylight period up to 3 days, or nighttime work lasting more than 1 hour.
- Short-term stationary is daytime work that occupies a location for more than 1 hour, but less than 12 hours.
- Short duration is work that occupies a location up to 1 hour.
- Mobile is work that moves intermittently or continuously.

SIGN MOUNTING HEIGHT

- The bottom of Long-term/Intermediate-term signs shall be at least 7 feet, but not more than 9 feet, above the paved surface.
- The bottom of Short-term/Short Duration signs shall be a minimum of 1 foot above the pavement surface but no more than 2 feet above the ground.
- Long-term/Intermediate-term Signs may be used in lieu of Short-term/Short Duration signing.
- Short-term/Short Duration signs shall be used only during daylight and shall be removed at the end of the workday.
- Regulatory signs shall be mounted at least 7 feet, but not more than 9 feet, above the paved surface regardless of work duration.

REMOVING OR COVERING

- When sign messages may be confusing or do not apply, the signs shall be removed or completely covered.
- Long-term stationary or intermediate stationary signs installed on square metal tubing may be turned away from traffic 90 degrees when the sign message is not applicable. This type of sign support meets the crashworthiness standards regardless of the direction of impact. This technique may not be used for signs installed in the median of divided highways or near any intersections where the sign may be seen from approaching traffic.
- Signs installed on skids shall not be turned at 90 degree angles to the roadway. These signs should be removed or completely covered when not required.
- When signs are covered, the material used shall be opaque, such as heavy mil black plastic.
- Burlap shall NOT be used to cover signs.
- Duct tape or other adhesive material shall NOT be affixed to a sign face. These materials can damage the retroreflectivity of sign sheeting.
- Signs shall be removed upon completion of the work.

SIGN SUPPORT WEIGHTS

- Where sign supports require the use of weights to keep from turning over, the use of sandbags with dry, cohesionless sand is recommended.
- The sandbags will be tied shut to keep the sand from spilling and to maintain a constant weight.
- Rock, concrete, iron, steel or other solid objects will not be permitted for use as sign support weights.
- Sandbags should weigh a minimum of 35 lbs and a maximum of 50 lbs.
- Sandbags shall be made of a durable material that tears upon vehicular impact.
- Rubber (such as tire inner tubes) shall NOT be used for sandbags.
- Rubber ballasts (such as those used with cones or edgeline channelizers) shall NOT be used as sign support weights.
- Sandbags shall only be placed along or laid over the base supports of the traffic control device and shall not be suspended above ground level or hung with rope, wire, chains or other fasteners. Sandbags shall be placed along the length of the skids to weigh down the sign support.
- Sandbags shall NOT be placed under the skid and shall not be used to level sign supports placed on slopes.

Only pre-qualified products shall be used. A copy of the "Compliant Work Zone Traffic Control Device List" (CWZTCD) describes pre-qualified products and their sources and may be obtained by contacting:

Standards Engineer
Traffic Operations Division - TE
Texas Department of Transportation
125 East 11th Street
Austin, Texas 78701-2483
Phone (512) 416-3120
Fax (512) 416-3299

Instructions to locate the "CWZTCD" on TxDOT website are:

Start at website - www.dot.state.tx.us
Click on "About TxDOT",
Click on "Organizational Chart",
Click on Traffic Operations Box,
Click on "Compliant Work Zone Traffic Control Devices",
Click on "View PDF".
This site is printable.

DEPARTMENTAL MATERIAL SPECIFICATIONS		
PLYWOOD SIGN BLANKS		DMS-7100
ALUMINUM SIGN BLANKS		DMS-7110
FLAT SURFACE REFLECTIVE SHEETING		DMS-8300
FLEXIBLE ROLL-UP REFLECTIVE SIGNS		DMS-8310
VINYL NON-REFLECTIVE SHEETING		DMS-8320
COLOR	USAGE	SHEETING MATERIAL
ORANGE	BACKGROUND	TYPE E (FLUORESCENT PRISMATIC)
WHITE	BACKGROUND	TYPE C (HIGH SPECIFIC INTENSITY)
WHITE	LEGEND & BORDERS	TYPE C (HIGH SPECIFIC INTENSITY)
BLACK	LEGEND & BORDERS	VINYL NON-REFLECTIVE SHEETING


Texas Department of Transportation
Traffic Operations Division

TRAFFIC SIGNAL INSTALLATION BARRICADES AND SIGNS

SHEET 2 OF 2 WZ(BTS-2)-03



REV	DATE	BY	CHKD	APP	DESCRIPTION
2-98					REVISIONS
4-98					
10-99					
3-03					

DISCLAIMER: The use of this standard is governed by the "Texas Engineering Practice Act". No warranty of any kind is made by TxDOT for any purpose whatsoever. TxDOT assumes no responsibility for the conversion of this standard to other formats or for inaccuracies or damages resulting from its use.

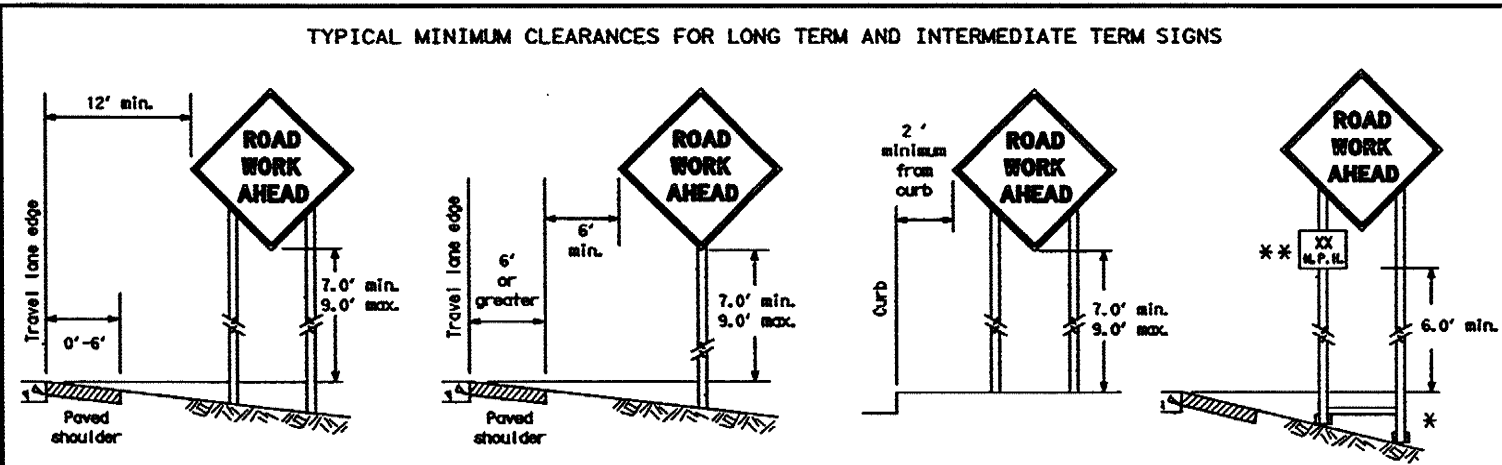

* When placing skid supports on uneven ground, the leg post lengths must be adjusted so the sign appears straight and plumb. Objects shall NOT be placed under skids as a means of leveling.

** When plaques are placed on dual-leg supports, they should be attached to the upright nearest the travel lane. Supplemental plaques (advisory or distance) should not cover the surface of the parent sign.

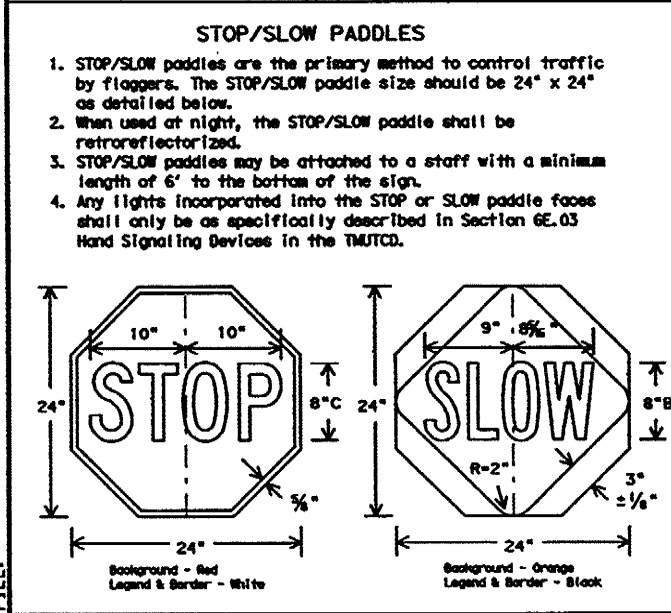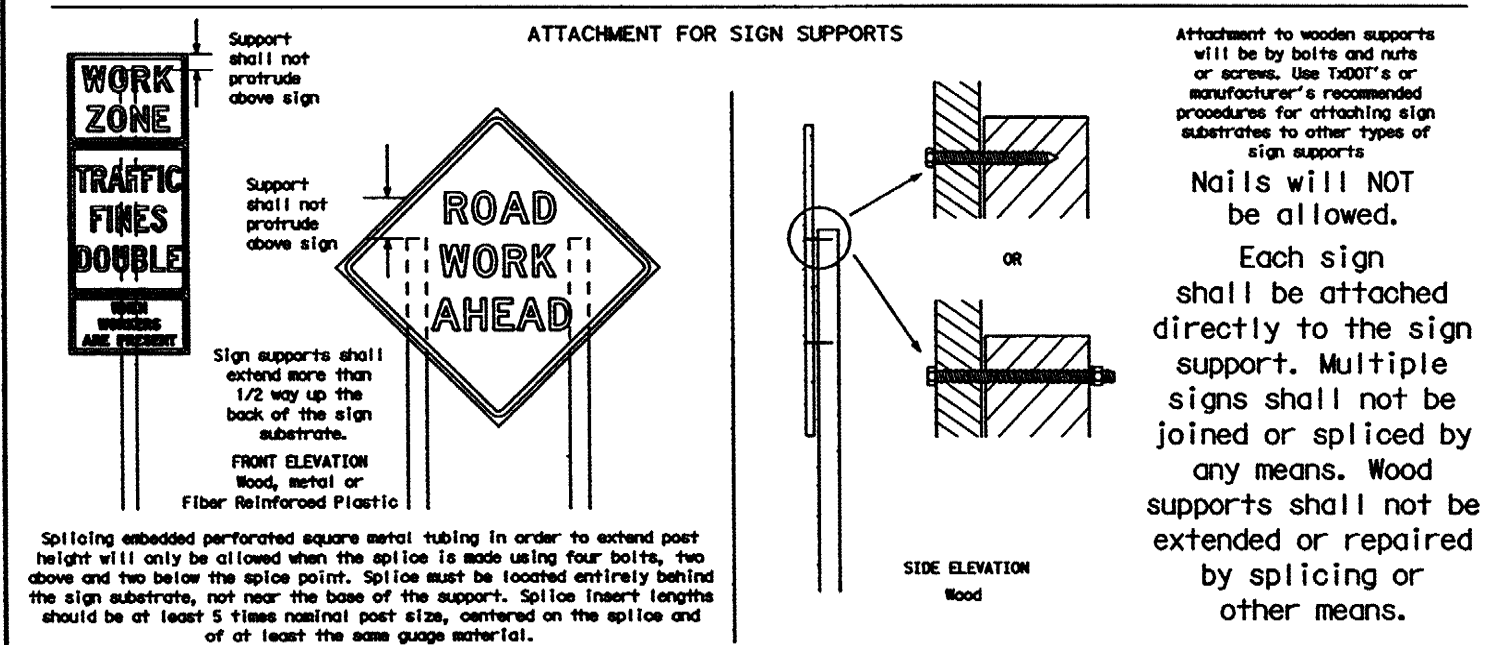

CONTRACTOR REQUIREMENTS FOR MAINTAINING PERMANENT SIGNS WITHIN THE PROJECT LIMITS

- Permanent signs are used to give notice of traffic laws or regulations, call attention to conditions that are potentially hazardous to traffic operations, show route designations, destinations, directions, distances, services, points of interest, and other geographical, recreational, or cultural information. Drivers proceeding through a work zone need the same, if not better route guidance as normally installed on a roadway without construction.
- When permanent regulatory or warning signs conflict with work zone conditions, remove or cover the permanent signs until the permanent sign message matches the roadway condition.
- When existing permanent signs are moved and relocated due to construction purposes, they shall be visible to motorists at all times.
- If existing signs are to be relocated on their original supports, they shall be installed on crashworthy bases as shown on the SMD Standard sheets. The signs shall meet the required mounting heights shown on the BC Sheets or the SMD Standards. This work should be paid for under the appropriate pay item for relocating existing signs.
- If permanent signs are to be removed and relocated using temporary supports, the Contractor shall use crashworthy supports as shown on the BC sheets or the CRZTCD. The signs shall meet the required mounting heights shown on the BC Sheets or the SMD Standards during construction. This work should be paid for under the appropriate pay item for relocating existing signs.
- Any sign or traffic control device that is struck or damaged by the Contractor or his/her construction equipment shall be replaced as soon as possible by the Contractor to ensure proper guidance for the motorists. This will be subsidiary to Item 502.

GENERAL NOTES FOR WORK ZONE SIGNS

- Contractor shall install and maintain signs in a straight and plumb condition and/or as directed by the Engineer.
- Wooden sign posts shall be painted white.
- Barricades shall NOT be used as sign supports.
- Nails shall NOT be used to attach signs to any support.
- All signs shall be installed in accordance with the plans or as directed by the Engineer. Signs shall be used to regulate, warn, and guide the traveling public safely through the work zone.
- The Contractor may furnish either the sign design shown in the plans or in the "Standard Highway Sign Designs for Texas" (SHSD). The Engineer/Inspector may require the Contractor to furnish other work zone signs that are shown in the TMUTCD but may have been omitted from the plans. Any variation in the plans shall be documented by written agreement between the Engineer and the Contractor's Responsible Person. All changes must be documented in writing before being implemented. This can include documenting the changes in the Inspector's TxDOT diary and having both the Inspector and Contractor initial and date the agreed upon changes.
- The Contractor shall furnish sign supports listed in the "Compliant Work Zone Traffic Control Device List" (CWZTCD). The Contractor shall install the sign support in accordance with the manufacturer's recommendations. If there is a question regarding installation procedures, the Contractor shall furnish the Engineer a copy of the manufacturer's installation recommendations so the Engineer can verify the correct procedures are being followed.
- The Contractor is responsible for installing signs on approved supports and replacing signs with damaged or cracked substrates and/or damaged or marred reflective sheeting as directed by the Engineer/Inspector.
- Identification markings may be shown only on the back of the sign substrate. The maximum height of letters and/or company logos used for identification shall be 1 inch.
- The Contractor shall replace damaged wood posts. New or damaged wood sign posts shall not be spliced.

DURATION OF WORK (as defined by the "Texas Manual on Uniform Traffic Control Devices" Part 6)

- The types of sign supports, sign mounting height, the size of signs, and the type of sign substrates can vary based on the type of work being performed. The Engineer is responsible for selecting the appropriate size sign for the type of work being performed. The Contractor is responsible for ensuring the sign support, sign mounting height and substrate meets manufacturer's recommendations in regard to crashworthiness and duration of work requirements.
 - Long-term stationary - work that occupies a location more than 3 days.
 - Intermediate-term stationary - work that occupies a location more than one daylight period up to 3 days, or nighttime work lasting more than one hour.
 - Short-term stationary - daytime work that occupies a location for more than 1 hour in a single daylight period.
 - Short, duration - work that occupies a location up to 1 hour.
 - Mobile - work that moves continuously or intermittently (stopping for up to approximately 15 minutes.)

SIGN MOUNTING HEIGHT

- The bottom of Long-term/Intermediate-term signs shall be at least 7 feet, but not more than 9 feet, above the paved surface, except as shown for supplemental plaques mounted below other signs.
- The bottom of Short-term/Short Duration signs shall be a minimum of 1 foot above the pavement surface but no more than 2 feet above the ground.
- Long-term/Intermediate-term Signs may be used in lieu of Short-term/Short Duration signing.
- Short-term/Short Duration signs shall be used only during daylight and shall be removed at the end of the workday, or raised to appropriate Long-term/Intermediate-term sign height.
- Regulatory signs shall be mounted at least 7 feet, but not more than 9 feet, above the paved surface regardless of work duration.

SIZE OF SIGNS

- The Engineer may allow the use of smaller size construction warning signs on secondary roads or city streets where speeds are low if the sign size is listed as an option on the "Typical Construction Warning Sign Size and Spacing" chart shown on BC(2).
- The Contractor shall furnish the sign sizes shown in plans, the BC Sheets, the TCP sheets or as directed by the Engineer.

SIGN SUBSTRATES

- The Contractor shall ensure the sign substrate is installed in accordance with the manufacturer's recommendations for the type of sign support that is being used. The CWZTCD lists each substrate that can be used on the different types and models of sign supports.
- "Mesh" type materials are NOT an approved sign substrate, regardless of the tightness of the weave.
- All wooden individual sign panels fabricated from 2 or more pieces shall have one or more plywood cleat, 1/2" thick by 6" wide, fastened to the back of the sign and extending fully across the sign. The cleat shall be attached to the back of the sign using wood screws that do not penetrate the face of the sign panel. The screws shall be placed on both sides of the splice and spaced at 6" centers. The Engineer may approve other methods of splicing the sign face.

REFLECTIVE SHEETING

- All signs shall be retroreflective and constructed of sheeting meeting the color and retro-reflectivity requirements of DMS-8300 for rigid signs or DMS-8310 for roll-up signs. The web address for DMS specifications is shown on BC(1).
- White sheeting, meeting the requirements of DMS-8300 Type C (High Specific Intensity), shall be used for signs with a white background.
- Orange sheeting, meeting the requirements of DMS-8300 Type E (Fluorescent Prismatic), shall be used for rigid signs with orange backgrounds.

SIGN LETTERS

- All sign letters and numbers shall be clear, and open rounded type uppercase alphabet letters as approved by the Federal Highway Administration (FHWA) and as published in the "Standard Highway Sign Design for Texas" manual. Signs, letters and numbers shall be of first class workmanship in accordance with Department Standards and Specifications.

REMOVING OR COVERING

- When sign messages may be confusing or do not apply, the signs shall be removed or completely covered.
- Long-term stationary or Intermediate-term stationary signs installed on square metal tubing may be turned away from traffic 90 degrees when the sign message is not applicable. This type of sign support meets the crashworthiness standards regardless of the direction of impact. This technique may not be used for signs installed in the median of divided highways or near any intersections where the sign may be seen from approaching traffic.
- Signs installed on wooden skids shall not be turned at 90 degree angles to the roadway. These signs should be removed or completely covered when not required.
- When signs are covered, the material used shall be opaque, such as heavy mil black plastic, or other materials which will cover the entire sign face and maintain their opaque properties under automobile headlights at night, without damaging the sign sheeting.
- Burlap shall NOT be used to cover signs.
- Duct tape or other adhesive material shall NOT be affixed to a sign face. These materials can damage the retroreflectivity of sheeting.
- Signs and anchor stubs shall be removed and holes backfilled upon completion of work.

SIGN SUPPORT WEIGHTS

- Where sign supports require the use of weights to keep from turning over, the use of sandbags with dry, cohesionless sand is recommended.
- The sandbags will be tied shut to keep the sand from spilling and to maintain a constant weight.
- Rock, concrete, iron, steel or other solid objects shall not be permitted for use as sign support weights.
- Sandbags should weigh a minimum of 35 lbs and a maximum of 50 lbs.
- Sandbags shall be made of a durable material that tears upon vehicular impact.
- Rubber (such as tire inner tubes) shall NOT be used for sandbags.
- Rubber ballasts designed for channelizing devices should not be used for ballast on portable sign supports. Sign supports designed and manufactured with rubber bases may be used when shown on the CWZTCD list.
- Sandbags shall only be placed along or laid over the base supports of the traffic control device and shall not be suspended above ground level or hung with rope, wire, chains or other fasteners. Sandbags shall be placed along the length of the skids to weigh down the sign support.
- Sandbags shall NOT be placed under the skid and shall not be used to level sign supports placed on slopes.

Texas Department of Transportation
Traffic Operations Division

**BARRICADE AND CONSTRUCTION
TEMPORARY SIGN NOTES
STANDARD**

4 of 12 BC(4)-07


© TxDOT 11-4-02	7th TxDOT	10th TxDOT	13th TxDOT	16th TxDOT
9-07	DATE	REVISED	DATE	REVISED
	TEST	QUANTITY		SHEET NO.

104


DISCLAIMER: The use of this standard is covered by the "Texas Engineering Practice Act". No warranty of any kind is made by TxDOT for any purpose whatsoever. TxDOT assumes no responsibility for the conversion of this standard to other formats or for incorrect results or damages resulting from its use.

SKID MOUNTED WOOD SIGN SUPPORTS

LONG/INTERMEDIATE TERM STATIONARY - PORTABLE SKID MOUNTED SIGN SUPPORTS □

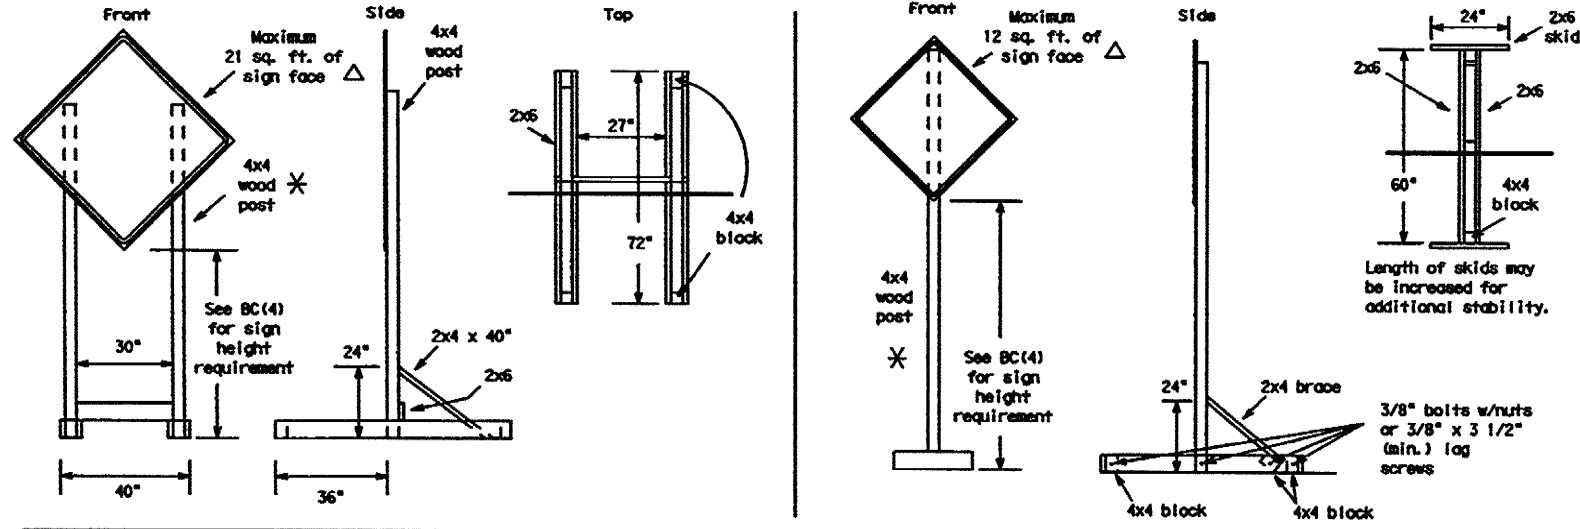


SKID MOUNTED PERFORATED SQUARE STEEL TUBING SIGN SUPPORTS

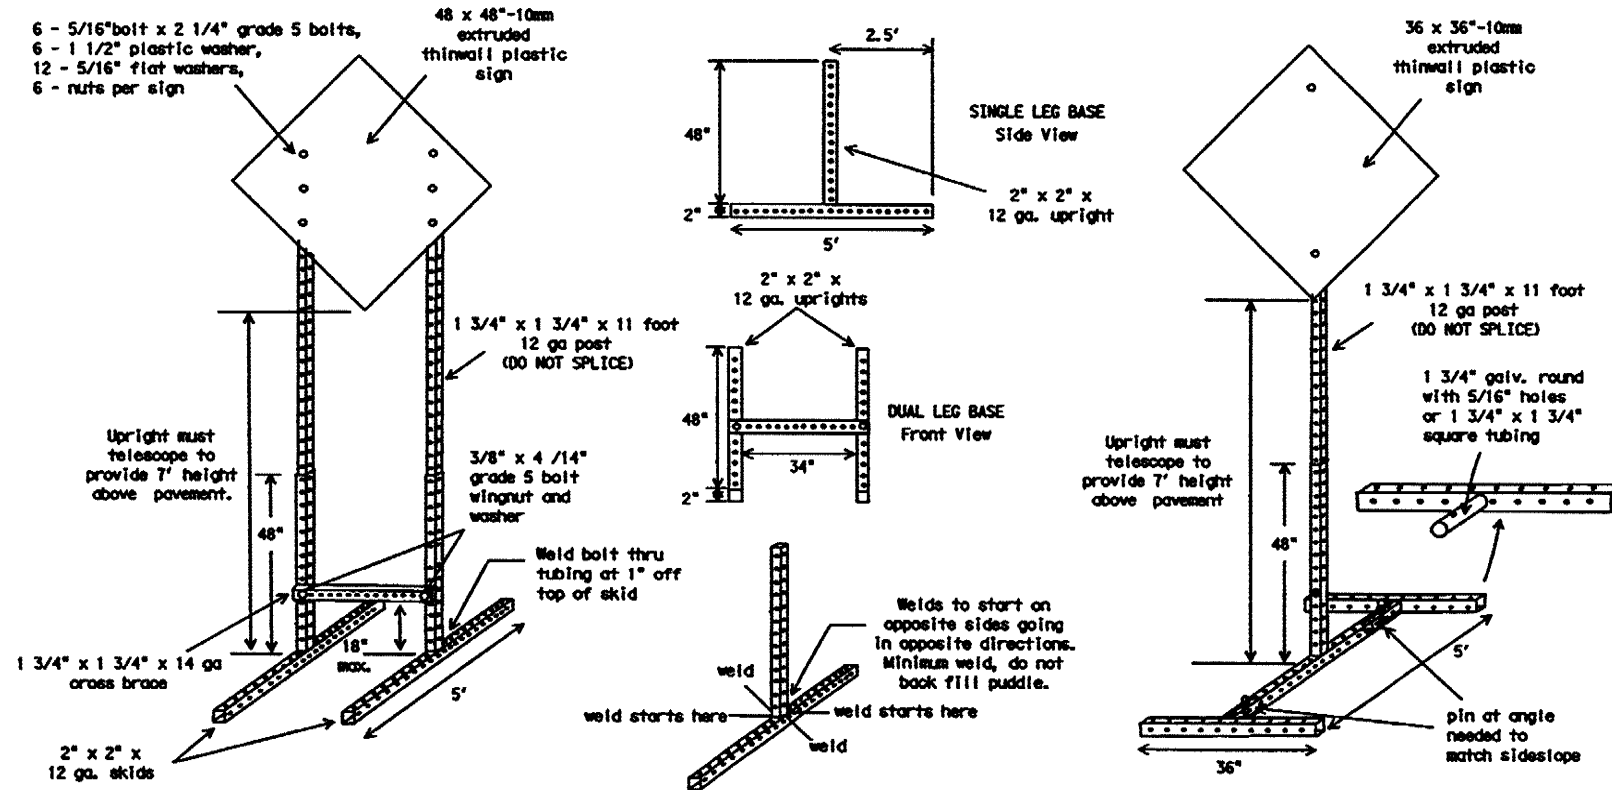

WEDGE ANCHORS

Both steel and plastic Wedge Anchor Systems as shown on the SMD Standard Sheets may be used as temporary sign supports for signs up to 10 square feet of sign face. They may be set in concrete or in sturdy soils if approved by the Engineer. (See web address for "Traffic Engineering Standard Sheets" on BC(1)).

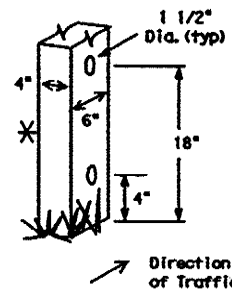


WOOD POST SYSTEM FOR GROUND MOUNTED SIGN SUPPORTS

Nominal Post Size	No. of Posts	Maximum Sq. feet of Sign Face	Minimum Soil Embedment	Drilled Hole(s) Required
4 x 4	1	12	36"	NO
4 x 4	2	21	36"	NO
4 x 6	1	21	36"	YES
4 x 6	2	36	36"	YES

GROUND MOUNTED SIGN SUPPORTS

Refer to the CRZTCO and the manufacturer's installation procedure for each type sign support. The maximum sign square footage shall adhere to the manufacturer's recommendation. Two post installations can be used for larger signs.

PERFORATED SQUARE METAL TUBING

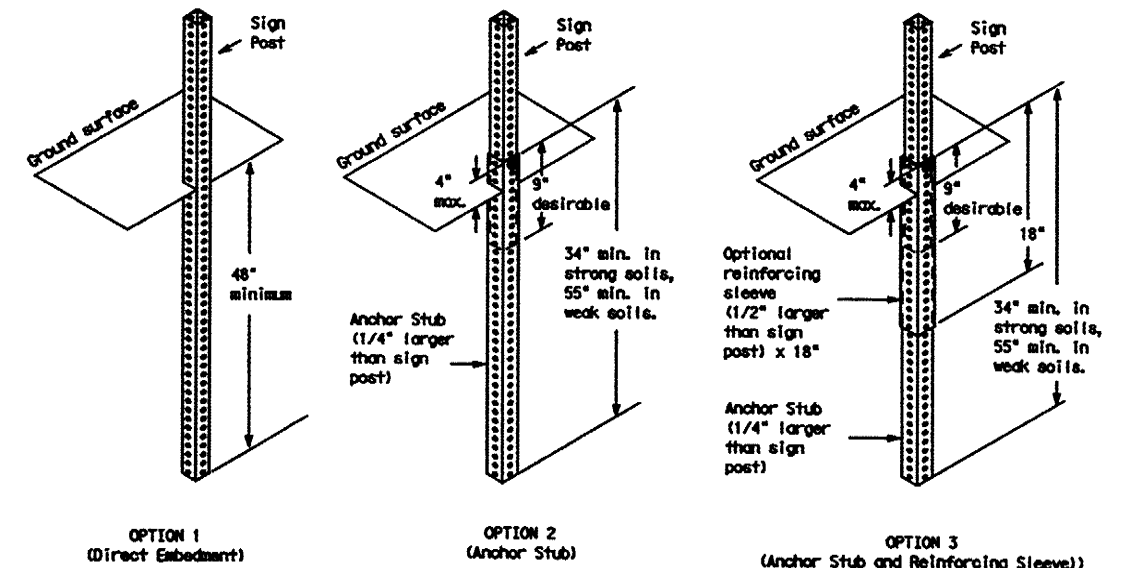

GENERAL NOTES

- Nails may be used in the assembly of wooden sign supports, but 3/8" bolts with nuts or 3/8" x 3 1/2" lag screws must be used on every joint for final connection.
- More details of approved Long/Intermediate and Short Term supports can be found on the CRZTCO list. See BC(1) for website location.
- No more than 2 sign posts shall be placed within a 7 ft. circle, except for specific materials noted on the CRZTCO List.
- When project is completed, all sign supports and foundations shall be removed from the project site. This will be considered subsidiary to Item 502.

□ See BC(4) for definition of "Work Duration."

* Wood sign posts MUST be one piece. Splicing will NOT be allowed. Posts shall be painted white.

△ See the CRZTCO for the type of sign substrate that can be used for each approved sign support.

Texas Department of Transportation
Traffic Operations Division

BARRICADE AND CONSTRUCTION TYPICAL SIGN SUPPORT STANDARD



5 of 12

BC(5)-07


DATE	REVISIONS	BY	CHKD	APP'D	REASON
9-07					

DISCLAIMER: The use of this standard is governed by the "Texas Engineering Practice Act". No warranty of any kind is made by TxDOT for any purpose whatsoever. TxDOT assumes no responsibility for the performance of this standard or for incorrect results or damages resulting from its use.

CHANNELIZING DEVICES

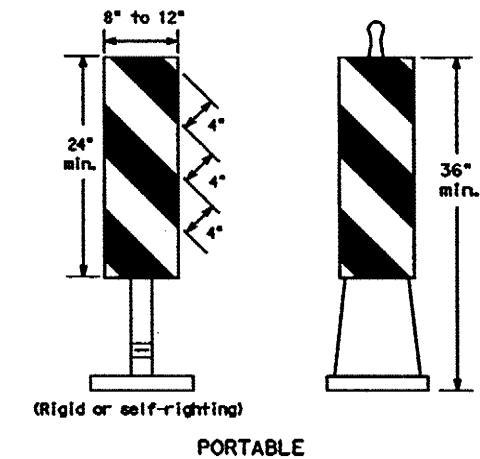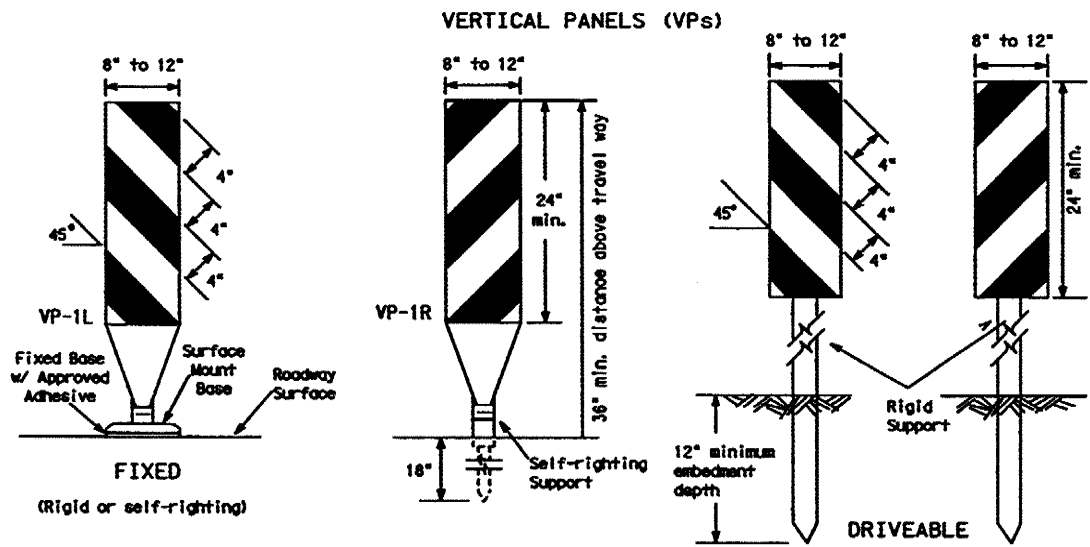


- Vertical Panels (VP's) are normally used to channelize traffic or divide opposing lanes of traffic.
- VP's may be used in daytime or nighttime situations. They may be used at the edge of shoulder drop-offs and other areas such as lane transitions where positive daytime and nighttime delineation is required. The Engineer/Inspector shall refer to the Roadway Design Manual Appendix B "Treatment of Pavement Drop-offs in Work Zones" for additional guidelines on the use of VP's for drop-offs.
- VP's should be mounted back to back if used at the edge of cuts adjacent to two-way two lane roadways. Stripes are to be reflective orange and reflective white and should always slope downward toward the travel lanes.
- VP's used on expressways and freeways or other high speed roadways, shall have a minimum of 270 square inches of retroreflective area facing traffic.
- Self-righting supports are available with portable base. See "Compliant Work Zone Traffic Control Devices List" (CWZTCD).
- Sheeting for the VP's shall be retroreflective Type C (High Specific Intensity) conforming to Departmental Material Specification DMS-8300, unless noted otherwise.
- Where the height of reflective material on the vertical panel is greater than 36 inches, a panel stripe of 6 inches shall be used.

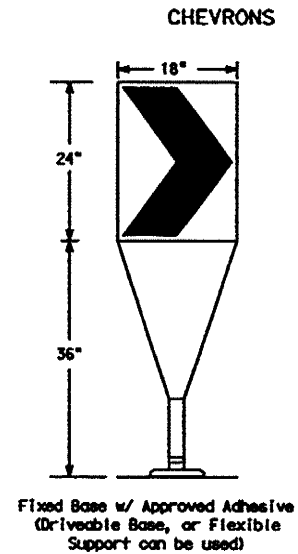

- The chevron shall be a vertical rectangle with a minimum size of 12 by 18 inches.
- Chevrons are intended to give notice of a sharp change of alignment with the direction of travel and provide additional emphasis and guidance for vehicle operators with regard to changes in horizontal alignment of the roadway.
- Chevrons, when used, shall be erected on the outside of a sharp curve or turn, or on the far side of an intersection. They shall be in line with and at right angles to approaching traffic. Spacing should be such that the marker always has three in view, until the change in alignment eliminates its need.
- To be effective, the chevron should be visible for at least 500 feet.
- Chevrons shall be orange with a black nonreflective legend. Sheeting for the chevron shall be retroreflective Type E (Fluorescent Prismatic) conforming to Departmental Material Specification DMS-8300, unless noted otherwise. The legend shall be black vinyl non-reflective dual sheeting meeting the requirements of DMS-8300.
- For Long Term Stationary use on freeways and divided highways self-righting chevrons may be used to supplement plastic drums but not to replace plastic drums.

OPPOSING TRAFFIC LANE DIVIDERS (OTLD)

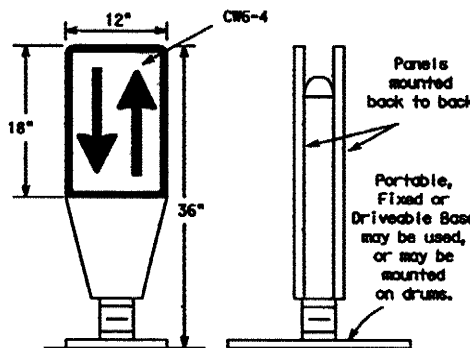

- Opposing Traffic Lane Dividers (OTLD) are delineation devices designed to convert a normal one-way roadway section to two-way operation. OTLD's are used on temporary centerlines. The upward and downward arrows on the sign's face indicate the direction of traffic on either side of the divider. The base is secured to the pavement with an adhesive or rubber weight to minimize movement caused by a vehicle impact or wind gust.
- The OTLD may be used in combination with simple tubular markers or VP's.
- Spacing between the OTLD shall not exceed 500 feet. Tubular markers or VP's placed between the OTLD's should not exceed 100 foot spacing.
- The OTLD shall be orange with a black non-reflective legend. Sheeting for the OTLD shall be retroreflective Type E (Fluorescent Prismatic) conforming to Departmental Material Specification DMS-8300, unless noted otherwise. The legend shall be black vinyl non-reflective dual sheeting meeting the requirements of DMS-8300.


GENERAL NOTES:

- Work zone channelizing devices illustrated on this sheet may be installed in close proximity to traffic and are suitable for use on high or low speed roadways. The Engineer/Inspector shall ensure that spacing and placement is uniform and in accordance with the "Texas Manual on Uniform Traffic Control Devices" (TMUTCD).
- Channelizing devices shown on this sheet may have a driveable, fixed or portable base. The requirement for self-righting channelizing devices must be specified in the General Notes or other plan sheets.
- Channelizing devices on self-righting supports should be used in work zone areas where channelizing devices are frequently impacted by errant vehicles or vehicle related wind gusts making alignment of the channelizing devices difficult to maintain. Locations of these devices shall be detailed elsewhere in the plans. These devices shall conform to the TMUTCD and the "Compliant Work Zone Traffic Control Devices List" (CWZTCD).
- The Contractor shall maintain devices in a clean condition and replace damaged, nonreflective, faded, or broken devices and bases as required by the Engineer/Inspector. The Contractor shall be required to maintain proper device spacing and alignment.
- Portable bases shall be fabricated from virgin and/or recycled rubber. The portable bases shall weigh approximately 35 lbs.
- Pavement surfaces shall be prepared in a manner that ensures proper bonding between the adhesives, the fixed mount bases and the pavement surface. Adhesives shall be prepared and applied according to the manufacturer's recommendations.
- The installation and removal of channelizing devices shall not cause detrimental effects to the final pavement surfaces, including pavement surface discoloration or surface integrity. Driveable bases shall not be permitted on final pavement surfaces. The Engineer/Inspector shall approve all application and removal procedures of fixed bases.
- Examples on this sheet are commonly used channelizing devices in work zones. For other devices, refer to the CWZTCD.

Posted Speed	Formula	Minimum Desirable Taper Lengths X X			Suggested Maximum Spacing of Channelizing Devices	
		10' Offset	11' Offset	12' Offset	On a Taper	On a Tangent
30	L = WS ² / 60	150'	165'	180'	30'	60'-75'
35		205'	225'	245'	35'	70'-90'
40		265'	295'	320'	40'	80'-100'
45	L = WS	450'	495'	540'	45'	90'-110'
50		500'	550'	600'	50'	100'-125'
55		550'	605'	660'	55'	110'-140'
60	L = WS	600'	660'	720'	60'	120'-150'
65		650'	715'	780'	65'	130'-165'
70		700'	770'	840'	70'	140'-175'
75	L = WS	750'	825'	900'	75'	150'-185'
80		800'	880'	960'	80'	160'-195'

X X Taper lengths have been rounded off.
L-Length of Taper (FT.) W-Width of Offset (FT.)
S-Posted Speed (MPH)

HOLLOW OR WATER BALLASTED SYSTEMS USED AS LONGITUDINAL CHANNELIZING DEVICES OR BARRIERS

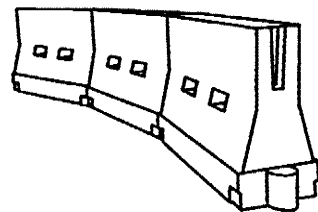

LONGITUDINAL CHANNELIZING DEVICES


- Longitudinal channelizing devices are crashworthy, lightweight, deformable devices that are highly visible, have good target value and can be connected together. They are not designed to contain or redirect a vehicle on impact.
- Longitudinal channelizing devices may be used instead of a line of cones or drums.
- Longitudinal channelizing devices shall be placed in accordance to application and installation requirements specific to the device, and used only when shown on the CWZTCD list.
- Longitudinal channelizing devices should not be used to provide positive protection for obstacles, pedestrians or workers.
- Longitudinal channelizing devices shall be retroreflective, or supplemented with retroreflective delineation as required for temporary barriers on BC(7)-07.

WATER BALLASTED SYSTEMS USED AS BARRIERS

- Water ballasted systems used as barriers shall not be used solely to channelize road users, but also to protect the work space per the appropriate MCHRP 350 crashworthiness requirements based on roadway speed and barrier application.
- Water ballasted systems used to channelize vehicular traffic shall be supplemented with retroreflective delineation or channelizing devices to improve daytime/nighttime visibility. They may also be supplemented with pavement markings.
- Water ballasted systems used as barriers shall be placed in accordance to application and installation requirements specific to the device, and used only when shown on the CWZTCD list.
- Water ballasted systems used as barriers should not be used for a merging taper except in low speed (less than 45 MPH) urban areas. When used on a taper in a low speed urban area, the taper shall be delineated and the taper length should be designed to optimize road user operations considering the available geometric conditions.
- When water ballasted systems used as barriers have blunt ends exposed to traffic, they should be attenuated as per manufacturer recommendations or flared to point outside the clear zone.

If used to channelize pedestrians, longitudinal channelizing devices or water ballasted systems must have a continuous detectable bottom for users of long cones and the top of the unit shall be not less than 32 inches in height.

VERTICAL PANELS & OPPOSING TRAFFIC LANE DIVIDERS SEPARATING TWO-WAY TRAFFIC (Typical application)

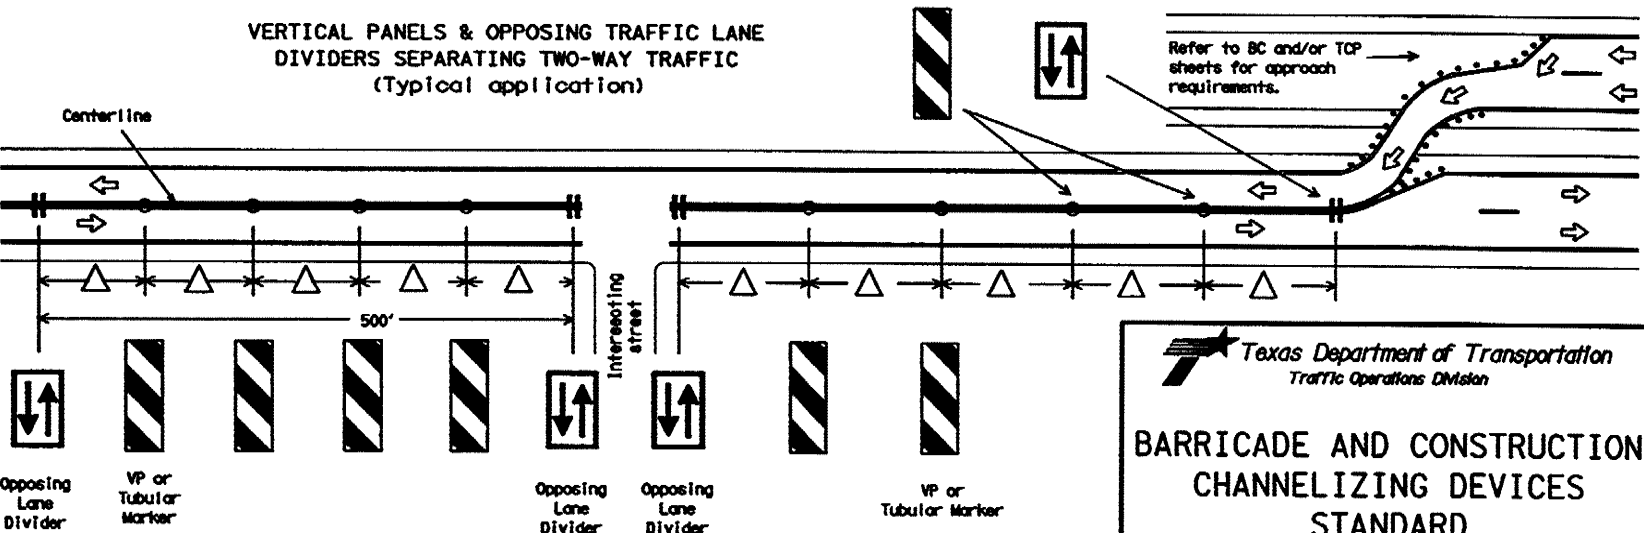

△ Spacing between the VP's or tubular markers shall not exceed 100 feet. On roadways with speeds less than 45 MPH, spacing between the tubular markers or VP's shall be as shown on the channelizing spacing table shown on this page. If the table shows spacing greater than 100 feet based on the roadway speed, then use a maximum of 100 feet spacing between the tubular markers or VP's. Every fifth channelizing device shall be an OTLD, except when the OTLD must be spaced closer to accommodate an intersection. Spacing between the OTLD shall not exceed 500 feet.

Texas Department of Transportation
Traffic Operations Division

BARRICADE AND CONSTRUCTION CHANNELIZING DEVICES STANDARD

9 of 12 BC(9)-07

© TxDOT 11-4-02		REV	DATE	BY	CHKD	APPD
9-07	REVISIONS	DATE	BY	CHKD	APPD	

DISCLAIMER: The use of this standard is governed by the Texas Engineering Practice Act. No warranty of any kind is made by TxDOT for any purpose whatsoever. TxDOT assumes no responsibility for the conversion of this standard to other formats or for incorrect results or damages resulting from its use.

TYPE III BARRICADES


1. Refer to the Compliant Work Zone Traffic Control Devices List (CMZTCD) for details of the Type III Barricades and a list of all materials used in the construction of Type III Barricades.
2. Type III Barricades shall be used at each end of construction projects closed to all traffic.
3. Barricades extending across a roadway should have stripes that slope downward in the direction toward which traffic must turn in detouring. When both right and left turns are provided, the chevron striping may slope downward in both directions from the center of the barricade. Where no turns are provided at a closed road striping should slope downward in both directions toward the center of roadway.
4. Striping of rails, for the right side of the roadway, should slope downward to the left. For the left side of the roadway, striping should slope downward to the right.
5. Identification markings may be shown only on the back of the barricade rails. The maximum height of letters and/or company logos used for identification shall be 1".
6. Barricades shall not be placed parallel to traffic unless an adequate clear zone is provided.
7. Warning lights shall NOT be installed on barricades.
8. Where barricades require the use of weights to keep from turning over, the use of sandbags with dry, cohesionless sand is recommended. The sandbags will be tied shut to keep the sand from spilling and to maintain a constant weight. Sand bags shall not be stacked in a manner that covers any portion of a barricade rails reflective sheeting. Rock, concrete, iron, steel or other solid objects will NOT be permitted. Sandbags should weigh a minimum of 35 lbs and a maximum of 50 lbs. Sandbags shall be made of a durable material that tears upon vehicular impact. Rubber (such as tire inner tubes) shall not be used for sandbags. Sandbags shall only be placed along or upon the base supports of the device and shall not be suspended above ground level or hung with rope, wire, chains or other fasteners.
9. Sheeting for barricades shall be retroreflective Type C (High Specific Intensity) conforming to Departmental Material Specification DMS-8300 unless otherwise noted.

Barricades shall NOT be used as a sign support.

TYPICAL STRIPING DETAIL FOR BARRICADE RAIL




TYPICAL PANEL DETAIL FOR SKID OR POST TYPE BARRICADES

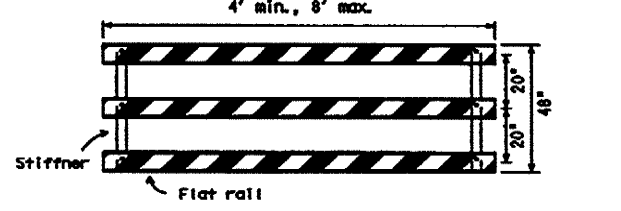

Stiffener may be inside or outside of support, but no more than 2 stiffeners shall be allowed on one barricade.


TYPE III BARRICADE (POST AND SKID) TYPICAL APPLICATION

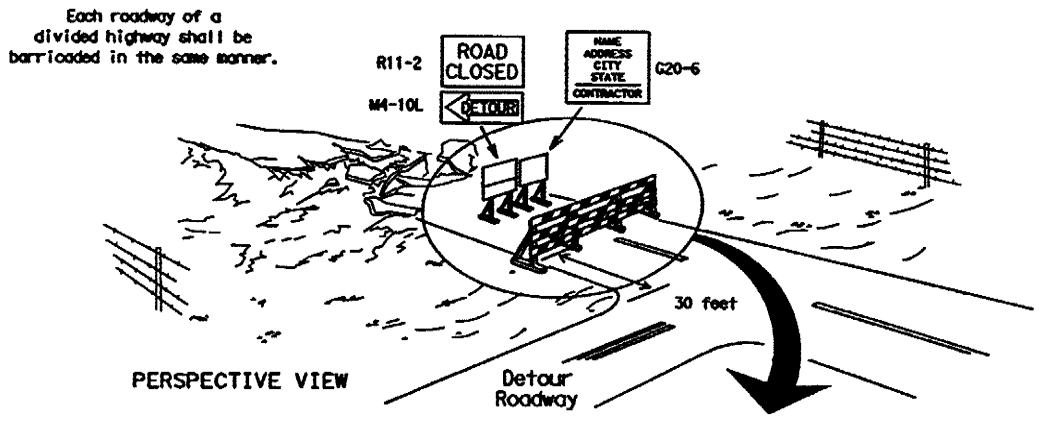

PERSPECTIVE VIEW


The three rails on Type III barricades shall be reflectorized orange and reflective white stripes on one side facing one-way traffic and both sides for two-way traffic. Barricade striping should slant downward in the direction of detour.

1. Signs should be mounted on independent supports at a 7 foot mounting height in center of roadway. The signs should be a minimum of 10 feet behind Type III Barricades.
2. Advance signing shall be as specified elsewhere in the plans.

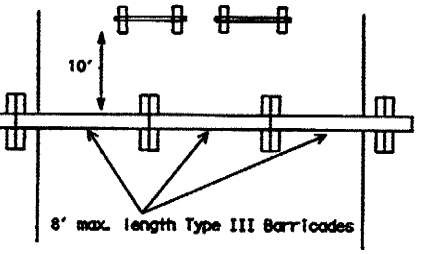


PLAN VIEW

CULVERT WIDENING OR OTHER ISOLATED WORK WITHIN THE PROJECT LIMITS

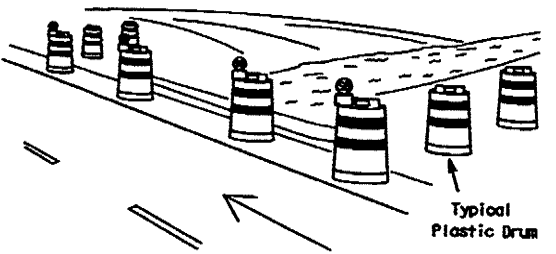

PERSPECTIVE VIEW

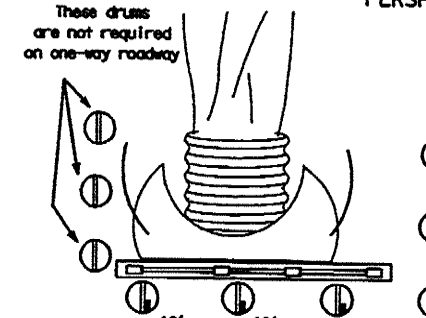



PLAN VIEW

1. Where positive redirection capability is provided, drums may be omitted.
2. Plastic construction fencing may be used with drums for safety as required in the plans.
3. Vertical Panels on flexible support may be substituted for drums when the shoulder width is less than 4 feet.
4. When the shoulder width is greater than 12 feet, steady-burn lights may be omitted if drums are used.
5. Drums must extend the length of the culvert widening.


Increase number of plastic drums on the side of approaching traffic if the crown width makes it necessary. (minimum of 2 and maximum of 4 drums)

- Legend
- Plastic drum
 - Plastic drum with steady burn light or yellow warning reflector
 - SB Steady burn warning light or yellow warning reflector

CONES

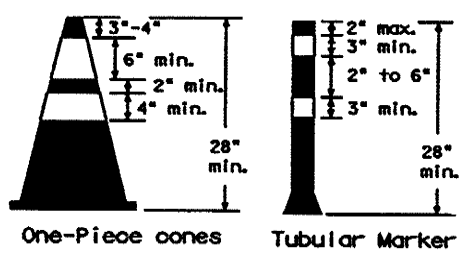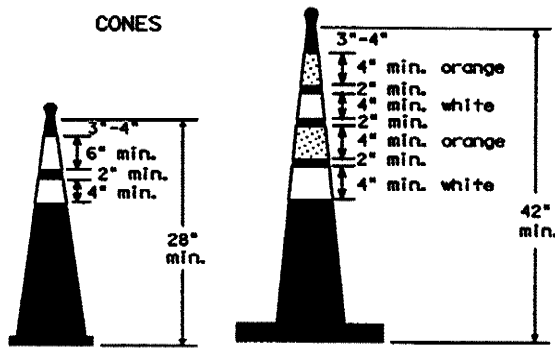


28" Cones shall have a minimum weight of 9 1/2 lbs.
42" 2-piece cones shall have a minimum weight of 30 lbs. including base.

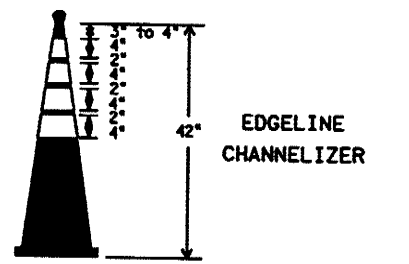

EDGE LINE CHANNELIZER

1. This device is intended only for use in place of a vertical panel to channelize traffic by indicating the edge of the travel lane. It is not intended to be used in transitions or tapers.
2. This device shall not be used to separate lanes of traffic (opposing or otherwise) or warn of objects.
3. This device is based on a 42 inch, two-piece cone with an alternate striping pattern: four 4 inch retroreflective bands, with an approximate 2 inch gap between bands. The color of the band should correspond to the color of the edgeline (yellow for left edgeline, white for right edgeline) for which the device is substituted or for which it supplements. The reflectorized bands shall be retroreflective Type C encapsulated bead (High Specific Intensity) conforming to Departmental Material Specification DMS-8300, unless otherwise noted.
4. The base must weigh a minimum of 30 lbs.

TRAFFIC CONTROL FOR MATERIAL STOCKPILES

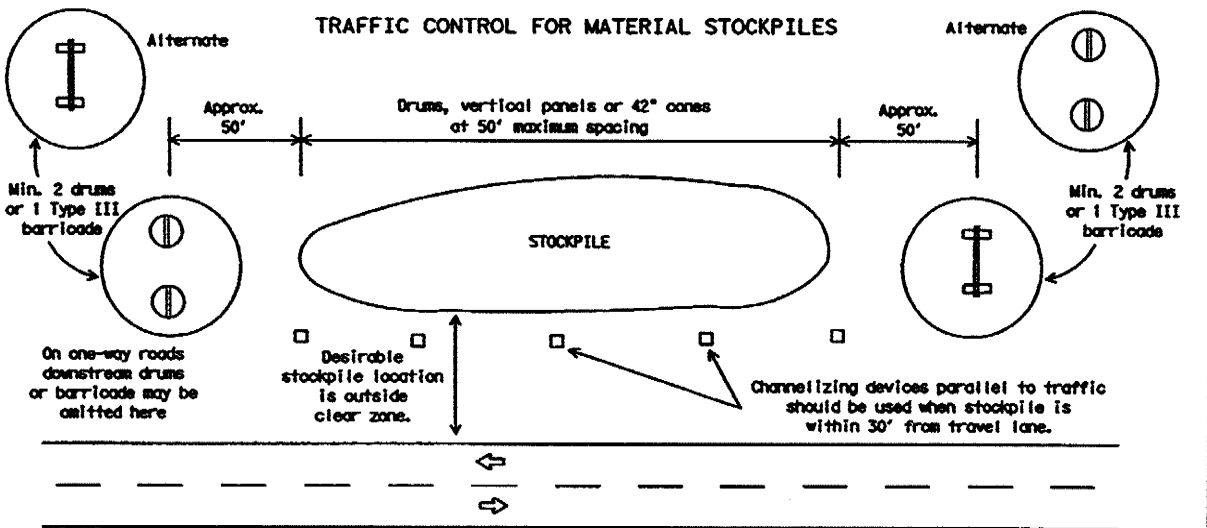

1. Traffic cones and tubular markers shall be a minimum of 28 inches in height when used either on freeways or at nighttime.
2. Cones or tubular markers shall be predominantly orange, fluorescent red-orange, or fluorescent yellow-orange. They should be kept clean and bright for maximum visibility.
3. Cones used only for daytime operations do not require the reflectorized bands.
4. Cones and tubular markers used for nighttime operations shall be reflectorized. Reflectorized material shall have a smooth, sealed outer surface that displays the same approximate color during the day and night. The reflectorized bands shall be retroreflective Type C (High Specific Intensity) conforming to Departmental Material Specification DMS-8300, unless otherwise noted.
5. When used at night, appropriate personnel shall ensure that cones and tubular markers remain in their proper location and in an upright position.
6. Reflectorization of 28" cones shall consist of a minimum 6 inch band placed at least 3 inches but not more than 4 inches from the top, supplemented by a minimum 4 inch band spaced a minimum of 2 inches below the 6 inch band.
7. Reflectorization of 42" cones shall be provided by alternating 4 to 6" orange and white stripes with orange on top.
8. Reflectorization of tubular markers shall be a minimum of two 3 inch bands placed a maximum of 2 inches from the top with a maximum of 6 inches between bands.
9. One-piece cones or tubular markers are generally suitable for temporary usage (up to 8 hours) with other channelization devices such as vertical panels, drums or two-piece cones for long term usage. Care should be taken to ensure they remain in their proper location and in an upright position.
10. Cones or tubular markers used on each project shall be of the same size and shape.
11. The handle may be designed as a hook or other shape, fabricated from non-rigid materials similar to the cone material, and may extend up to a maximum of 8 inches above the top of cone. Length of the handle shall not be considered with regard to the overall height of the cone.

Texas Department of Transportation
Traffic Operations Division

BARRICADE AND CONSTRUCTION CHANNELIZING DEVICES STANDARD

10 of 12 BC(10)-07

© TxDOT 11-4-02		REVISED	DATE	BY	REVISIONS
9-07	REVISIONS	DATE	BY	REVISIONS	DATE
		DATE	BY	REVISIONS	DATE

The use of this standard is governed by the "Texas Engineering Practices Act". No warranty of any kind is made by TxDOT for any purpose whatsoever. TxDOT assumes no responsibility for the content or use of this standard to other formats or for incorrect results or damages resulting from its use.

WORK ZONE PAVEMENT MARKINGS

GENERAL

- The Contractor shall be responsible for maintaining work zone and existing pavement markings, in accordance with the standard specifications and special provisions, on all roadways open to traffic within the CSJ limits unless otherwise stated in the plans.
- Color, patterns and dimensions shall be in conformance with the "Texas Manual on Uniform Traffic Control Devices" (TMUTCD).
- Additional supplemental pavement marking details may be found in the plans or specifications.
- Pavement markings shall be installed in accordance with the TMUTCD and as shown on the plans.
- When short term markings are required on the plans, short term markings shall conform with the TMUTCD, the plans and details as shown on the Standard Plan Sheet WZ (STPM).
- When standard pavement markings are not in place and the roadway is opened to traffic, DO NOT PASS signs shall be erected to mark the beginning of the sections where passing is prohibited and PASS WITH CARE signs at the beginning of sections where passing is permitted.
- All work zone pavement markings shall be installed in accordance with Item 662, "Work Zone Pavement Markings."

RAISED PAVEMENT MARKERS

- Raised pavement markers are to be placed according to the patterns on BC(12).
- All raised pavement markers used for work zone markings shall meet the requirements of Item 672, "RAISED PAVEMENT MARKERS" and Departmental Material Specification DMS-4200 or DMS-4300.

PREFABRICATED PAVEMENT MARKINGS

- Removable prefabricated pavement markings shall meet the requirements of DMS-8241.
- Non-removable prefabricated pavement markings (foil back) shall meet the requirements of DMS-8240.


MAINTAINING WORK ZONE PAVEMENT MARKINGS

- The Contractor will be responsible for maintaining work zone pavement markings within the work limits.
- Work zone pavement markings shall be inspected in accordance with the frequency and reporting requirements of work zone traffic control device inspections as required by Form 599.
- The markings should provide a visible reference for a minimum distance of 300 feet during normal daylight hours and 160 feet when illuminated by automobile low-beam headlights at night, unless sight distance is restricted by roadway geometrics.
- Markings failing to meet this criteria within the first 30 days after placement shall be replaced at the expense of the Contractor as per Specification Item 662.

REMOVAL OF PAVEMENT MARKINGS

- Pavement markings that are no longer applicable, could create confusion or direct a motorist toward or into the closed portion of the roadway, shall be removed or obliterated before the roadway is opened to traffic.
- The above shall not apply to detours in place for less than two weeks, where flaggers and/or sufficient channelizing devices are used in lieu of markings to outline the detour route.
- Pavement markings shall be removed to the fullest extent possible, so as not to leave a discernible marking. This shall be by any method approved by TxDOT Specification Item 677 for "Eliminating Existing Pavement Markings and Markers".
- The removal of pavement markings may require resurfacing or seal coating portions of the roadway.
- Subject to the approval of the Engineer, any method that proves to be successful on a particular type pavement may be used.
- Blast cleaning may be used but will not be required unless specifically shown in the plans.
- Over-painting of the markings SHALL NOT BE permitted.
- Removal of raised pavement markers shall be as directed by the Engineer.
- Removal of existing pavement markings and markers will be paid for directly in accordance with Item 677, "ELIMINATING EXISTING PAVEMENT MARKINGS AND MARKERS," unless otherwise stated in the plans.
- Black-out marking tape may be used to cover conflicting existing markings for periods less than two weeks when approved by the Engineer.

Temporary Flexible-Reflective Roadway Marker Tabs

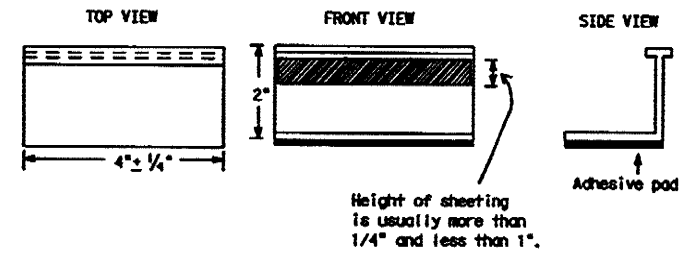

**STAPLES OR NAILS SHALL NOT BE USED TO SECURE
TEMPORARY FLEXIBLE-REFLECTIVE ROADWAY MARKER
TABS TO THE PAVEMENT SURFACE**

- Temporary flexible-reflective roadway marker tabs used as guidemarks shall meet the requirements of DMS-8242.
- Tabs detailed on this sheet are to be inspected and accepted by the Engineer or designated representative. Sampling and testing is not normally required, however at the option of the Engineer, either "A" or "B" below may be imposed to assure quality before placement on the roadway.
 - Select five (5) or more tabs at random from each lot or shipment and submit to the Construction Division, Materials and Pavement Section to determine specification compliance.
 - Select five (5) tabs and perform the following test. Affix five (5) tabs at 24 inch intervals on an asphaltic pavement in a straight line. Using a medium size passenger vehicle or pickup, run over the markers with the front and rear tires at a speed of 35 to 40 miles per hour, four (4) times in each direction. No more than one (1) out of the five (5) reflective surfaces shall be lost or displaced as a result of this test.
- Small design variances may be noted between tab manufacturers.
- See Standard Sheet WZ (STPM) for tab placement on new pavements. See Standard Sheet TCP(7-1) for tab placement on seal coat work.

Raised Pavement Markers used as Guidemarks

- Raised pavement markers used as guidemarks shall be from the approved product list, and meet the requirements of DMS-4200.
- All temporary construction raised pavement markers provided on a project shall be of the same manufacturer.
- Adhesive for guidemarks shall be bituminous material hot applied or butyl rubber pad for all surfaces, or thermoplastic for concrete surfaces.

Guidemarks shall be designated as:
 YELLOW - (two amber reflective surfaces with yellow body).
 WHITE - (one silver reflective surface with white body).

DEPARTMENTAL MATERIAL SPECIFICATIONS

PAVEMENT MARKERS (REFLECTORIZED)	DMS-4200
TRAFFIC BUTTONS	DMS-4300
EPOXY AND ADHESIVES	DMS-6100
BITUMINOUS ADHESIVE FOR PAVEMENT MARKERS	DMS-6130
PREFABRICATED PAVEMENT MARKINGS-PERMANENT	DMS-8240
PREFABRICATED PAVEMENT MARKINGS-REMOVABLE	DMS-8241
TEMPORARY FLEXIBLE-REFLECTIVE ROADWAY MARKER TABS	DMS-8242

A list of prequalified reflective raised pavement markers, non-reflective traffic buttons, roadway marker tabs and other pavement markings can be found at the Material Producer List web address shown on BC(1).



BARRICADE AND CONSTRUCTION PAVEMENT MARKINGS STANDARD

11 of 12





BC(11)-07

© TxDOT February 1998	REVISED	DATE	BY	REVISION
2-98	1-02	11-02	9-07	

DISCLAIMER: The use of this standard is governed by the "Texas Engineering Practice Act". No warranty of any kind is made by TxDOT for any purpose whatsoever. TxDOT assumes no responsibility for the conversion of this standard to other formats or for incorrect results or damages resulting from its use.



PAVEMENT MARKING PATTERNS

CENTER LINE & NO-PASSING ZONE BARRIER LINES FOR TWO-LANE, TWO-WAY HIGHWAYS

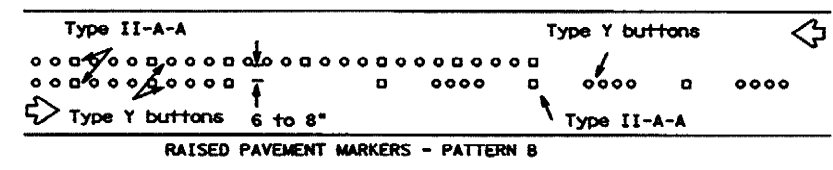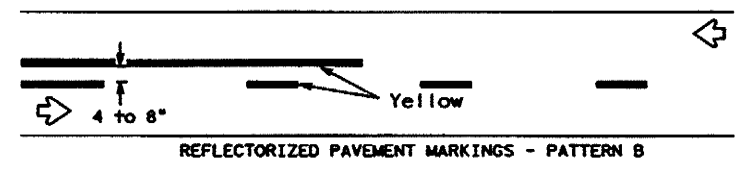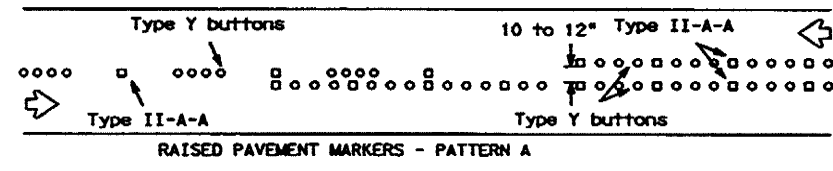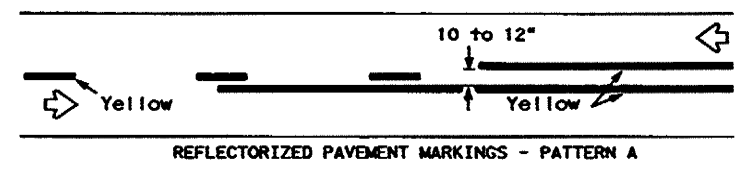



Pattern A is the TxDOT Standard, however Pattern B may be used if approved by the Engineer. Prefabricated markings may be substituted for reflectorized pavement markings.

EDGE & LANE LINES FOR DIVIDED HIGHWAY

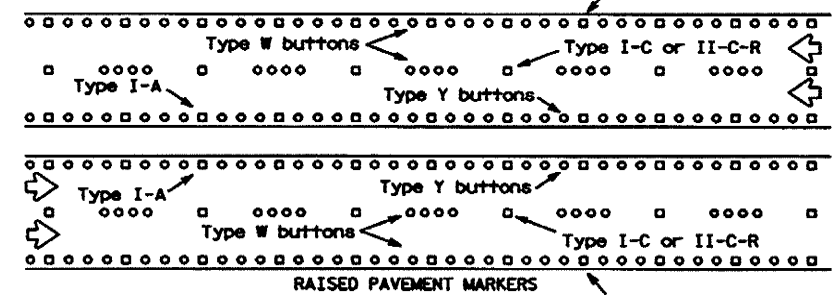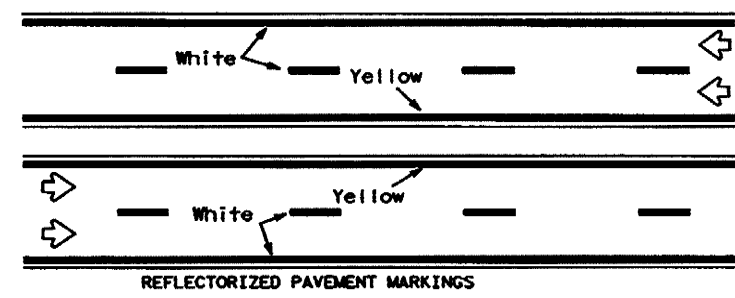



Prefabricated markings may be substituted for reflectorized pavement markings.

LANE & CENTER LINES FOR MULTILANE UNDIVIDED HIGHWAYS

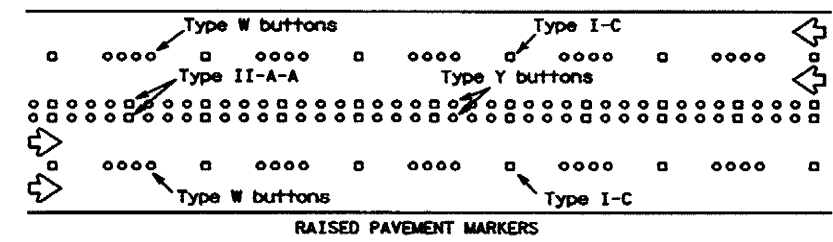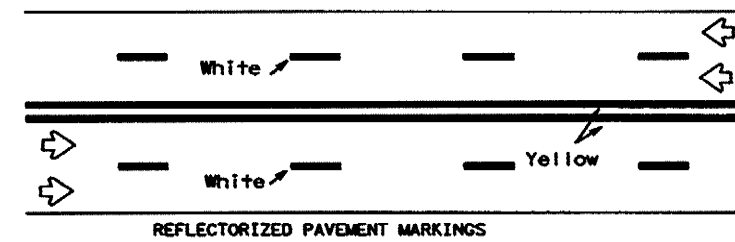






Prefabricated markings may be substituted for reflectorized pavement markings.

TWO-WAY LEFT TURN LANE

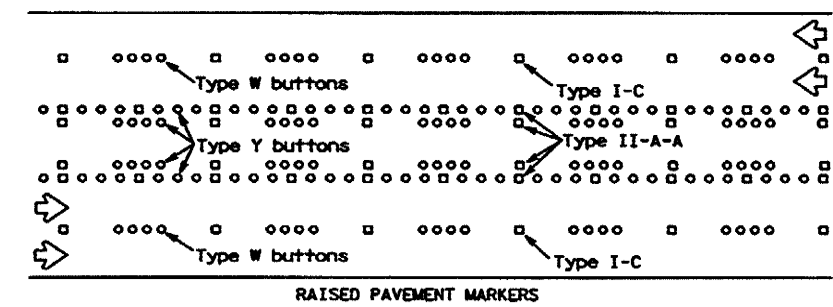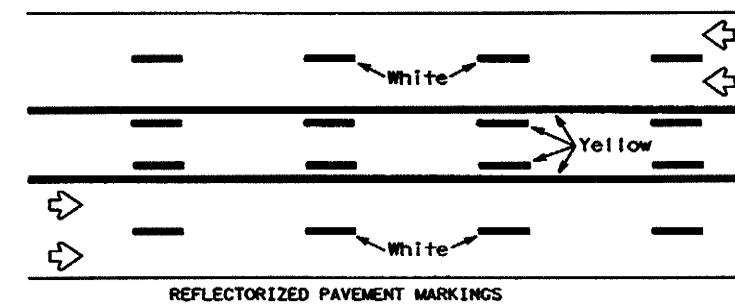

Prefabricated markings may be substituted for reflectorized pavement markings.

STANDARD WORK ZONE PAVEMENT MARKINGS DETAILS

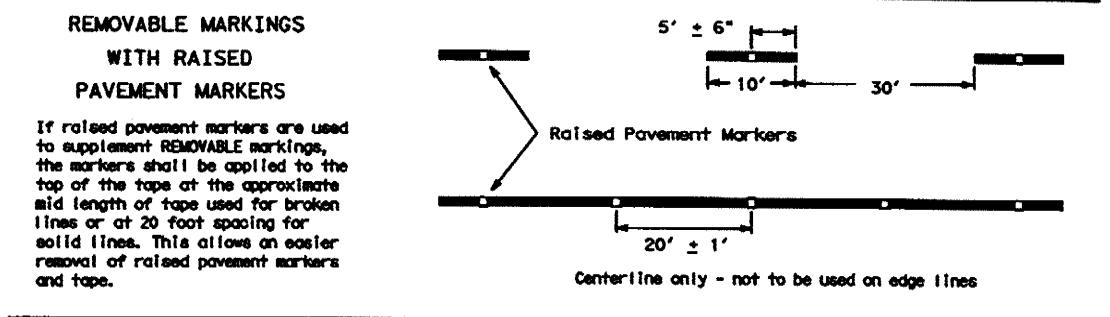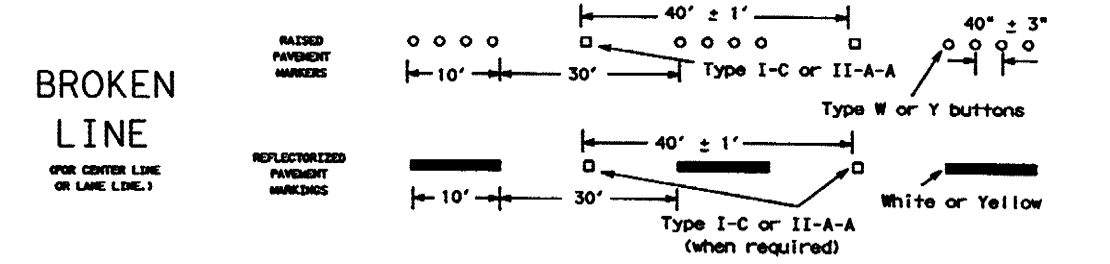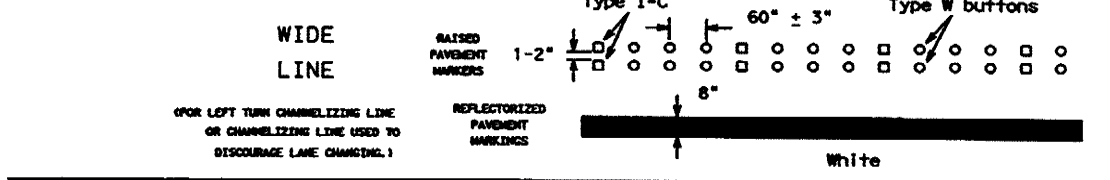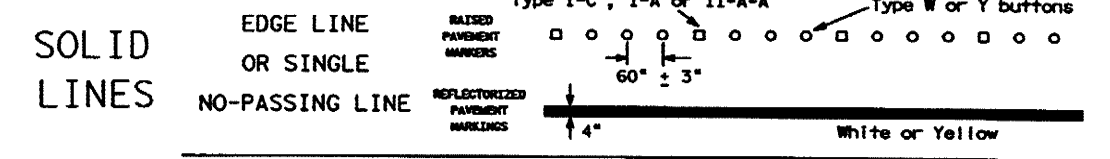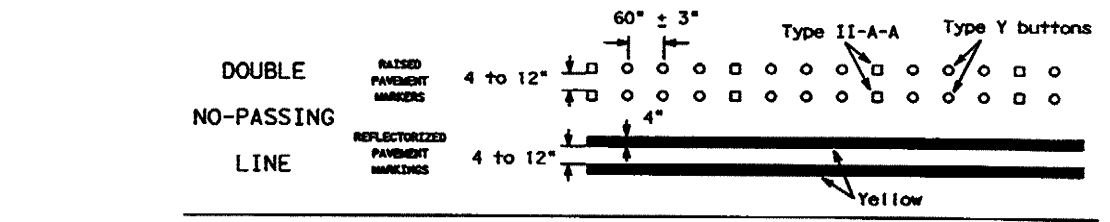

Raised pavement markers used as standard pavement markings shall be from the approved products list and meet the requirements of Item 672 "RAISED PAVEMENT MARKERS."

Texas Department of Transportation
Traffic Operations Division

BARRICADE AND CONSTRUCTION PAVEMENT MARKING PATTERNS STANDARD

12 of 12 BC(12)-07

© TxDOT February 1998		Rev. TxDOT	Rev. TxDOT	Rev. TxDOT	Rev. TxDOT
1-97	REVISIONS	DATE	SECT	BY	REASON
2-98					
11-02					
9-07					
		TITLE	QUANTITY	SHEET No.	

DATE: FILE:

SHEET 163 OF 163