
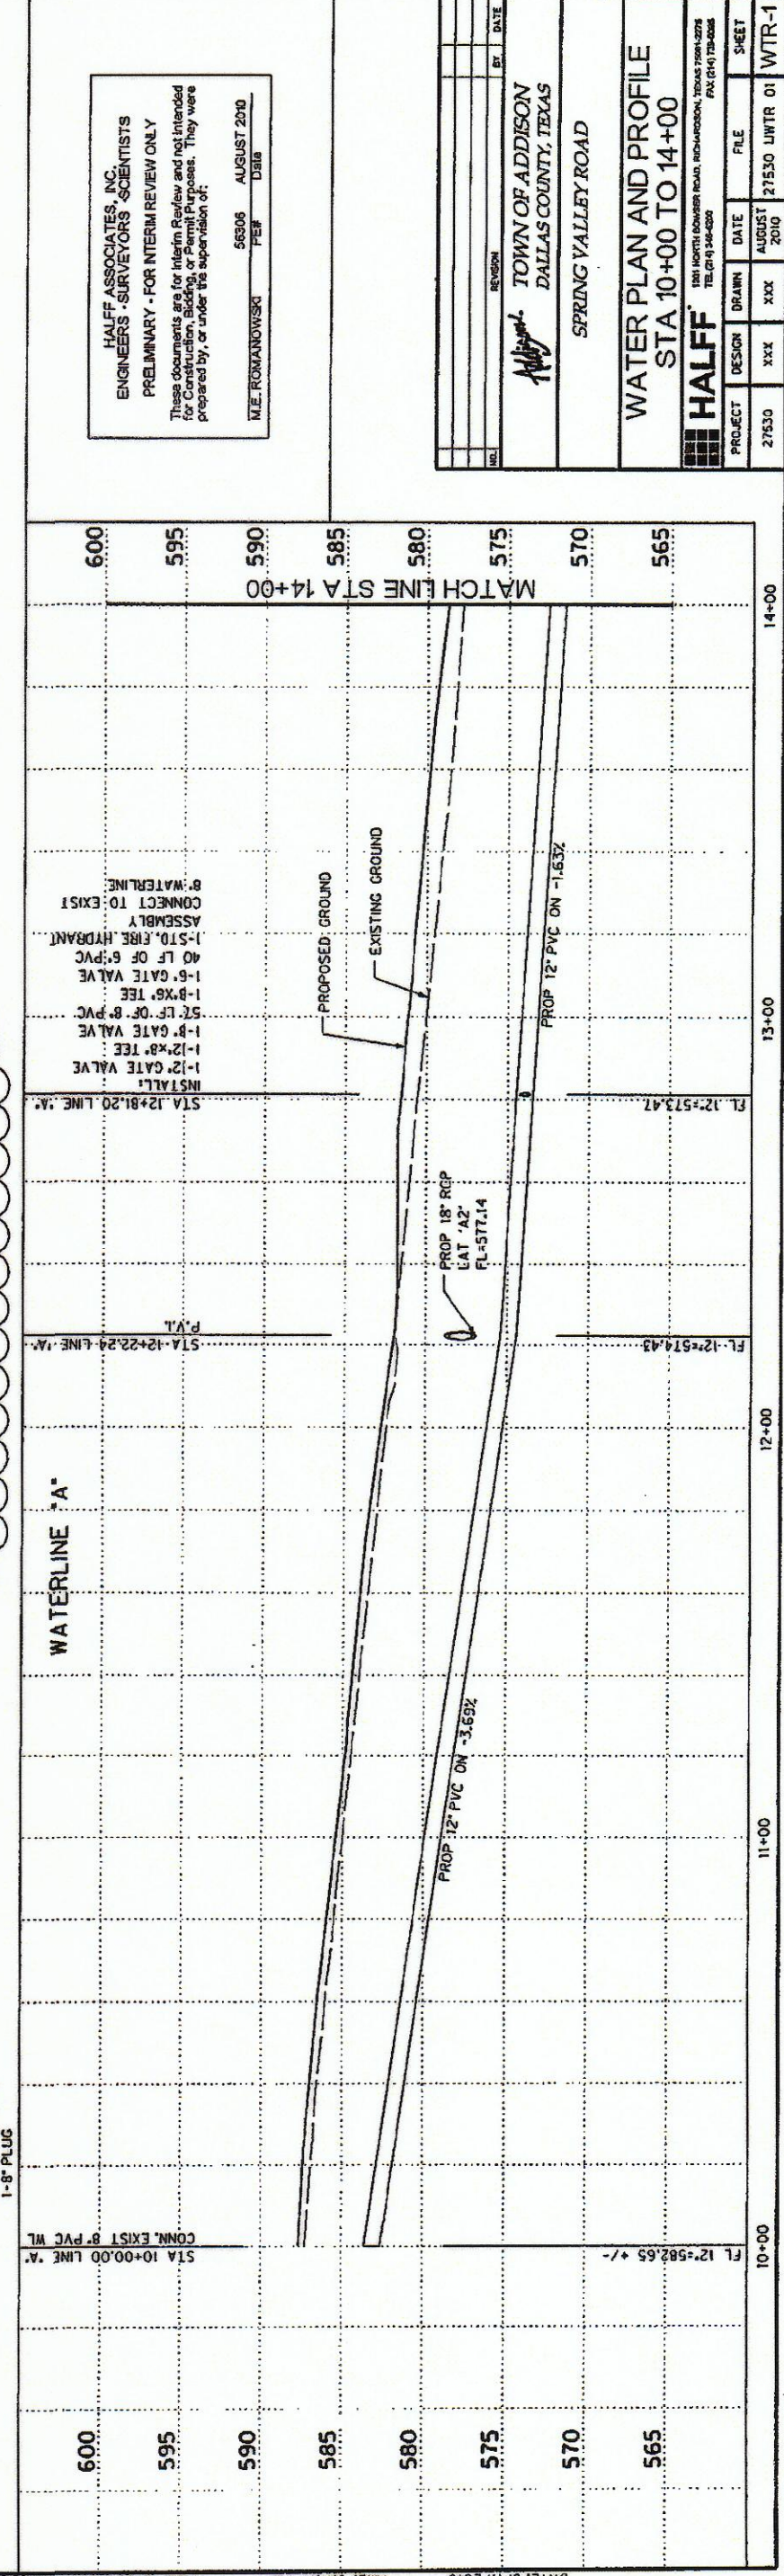


1175.580
321.474
41' R/W
581.502
1200.751
331.474
41' R/W
579.142
1297.697
341.474
41' R/W
575.224
1370.482
341.474
41' R/W

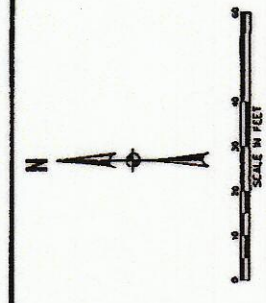

HALFF ASSOCIATES, INC.
ENGINEERS - SURVEYORS - SCIENTISTS
PRELIMINARY - FOR INTERIM REVIEW ONLY
These documents are for Interim Review and not intended for Construction, Bidding, or Permit Purposes. They were prepared by, or under the supervision of:

M.E. ROMANOWSKI P.E. 56306 AUGUST 2010
D.B.B.

REVISION	BY	DATE
TOWN OF ADDISON DALLAS COUNTY, TEXAS SPRING VALLEY ROAD		
WATER PLAN AND PROFILE STA 10+00 TO 14+00		
1511 NORTH DOWNS ROAD, RICHLAND, TEXAS 76878 TEL: (817) 246-0200 FAX: (817) 273-0206		
PROJECT	DESIGN	DRAWN
21530	XXX	XXX
DATE	AUGUST	2010
FILE	21530 UNTR 01	WTR-1
SHEET		