


Handwritten notes in pink boxes:

- 1200 394 4\"/>

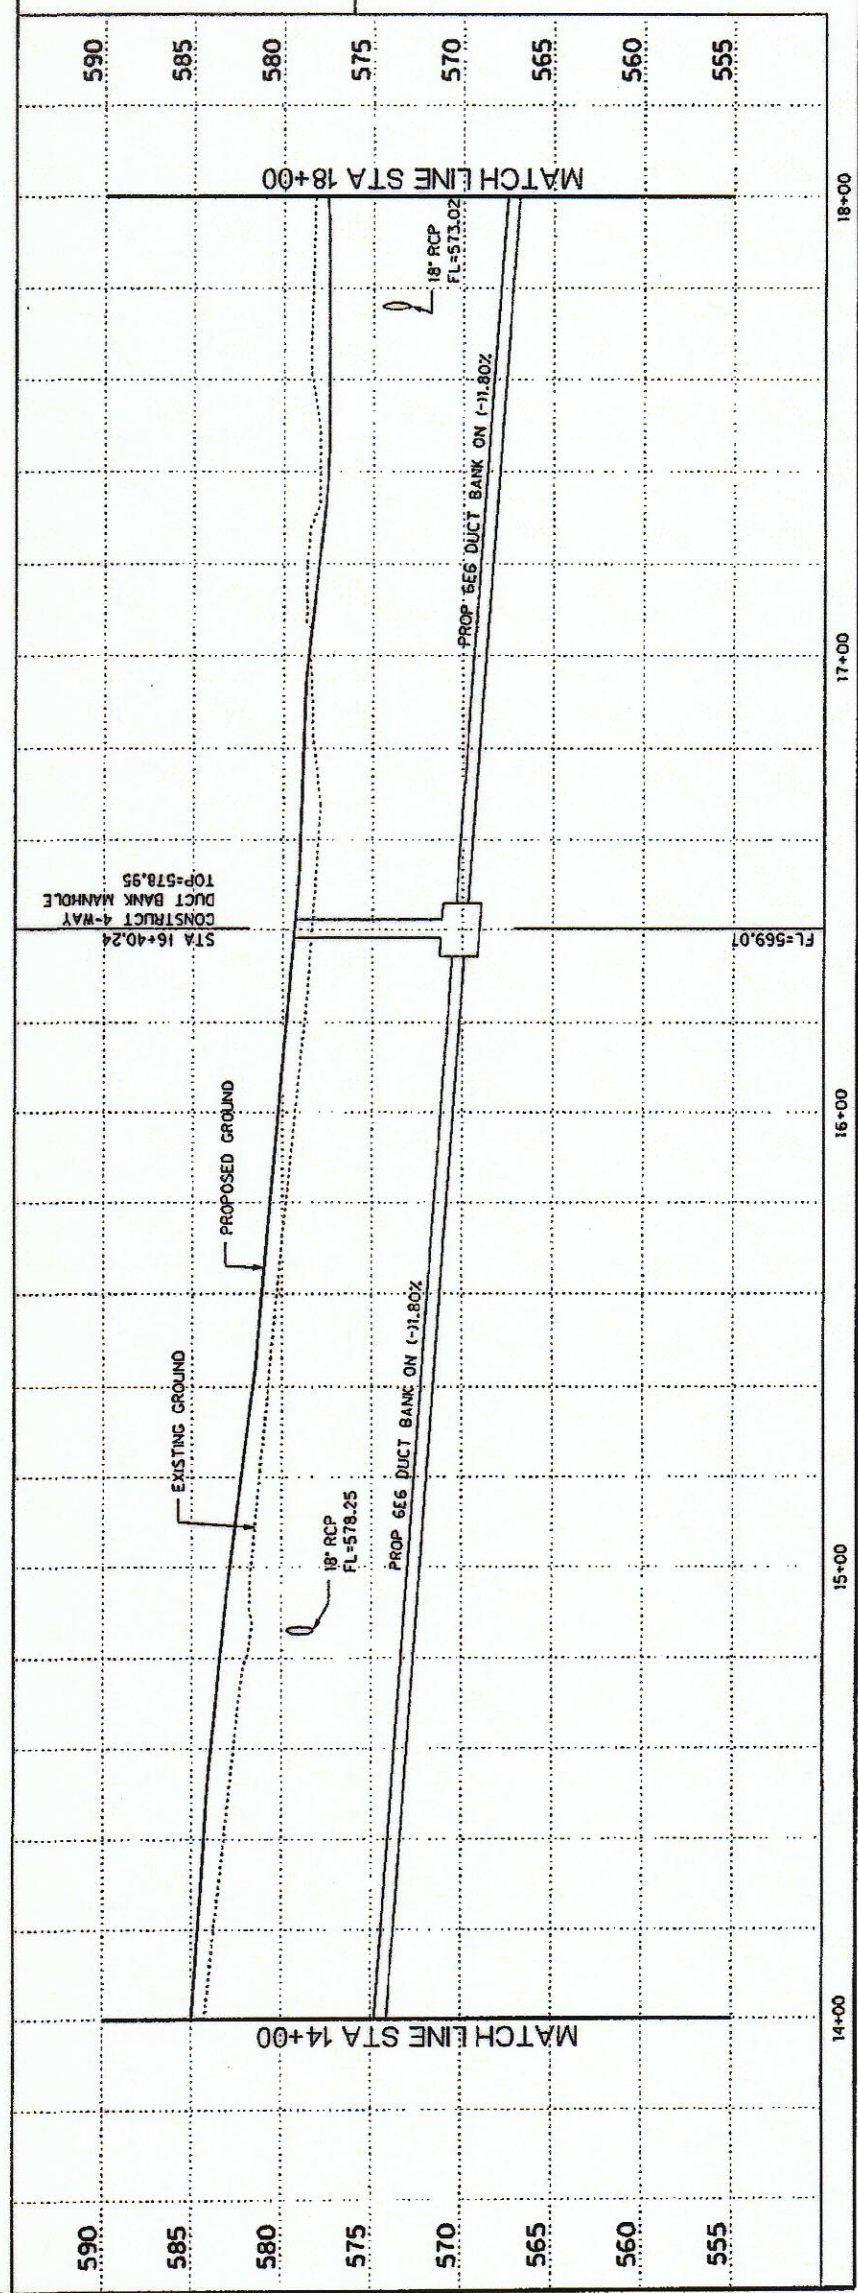

HALFF ASSOCIATES, INC.
 ENGINEERS - SURVEYORS - SCIENTISTS
 PRELIMINARY - FOR INTERIM REVIEW ONLY
 These documents are for Interim Review and not intended for Construction, Bidding, or Permit Purposes. They were prepared by, or under the supervision of:
 M.E. ROMANOWSKI P.E. 56306 AUGUST 2010
 P.E. 0318

NO.	REVISION	BY	DATE

TOWN OF ADDISON
 DALLAS COUNTY, TEXAS
 SPRING VALLEY ROAD

DUCT BANK PLAN AND PROFILE
 STA 14+00 TO 18+00

HALFF
 1201 NORTH BOWSER ROAD, RICHARDSON, TEXAS 75081-2028
 TEL: (972) 344-2000 FAX: (972) 344-2008

PROJECT	DESIGN	DRAWN	DATE	FILE	SHEET
27530	XXX	XXX	AUGUST 2010	27530 UELE 02	ELE-2