
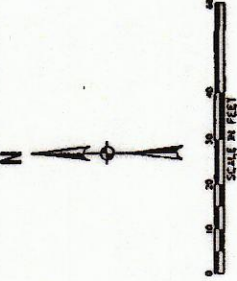
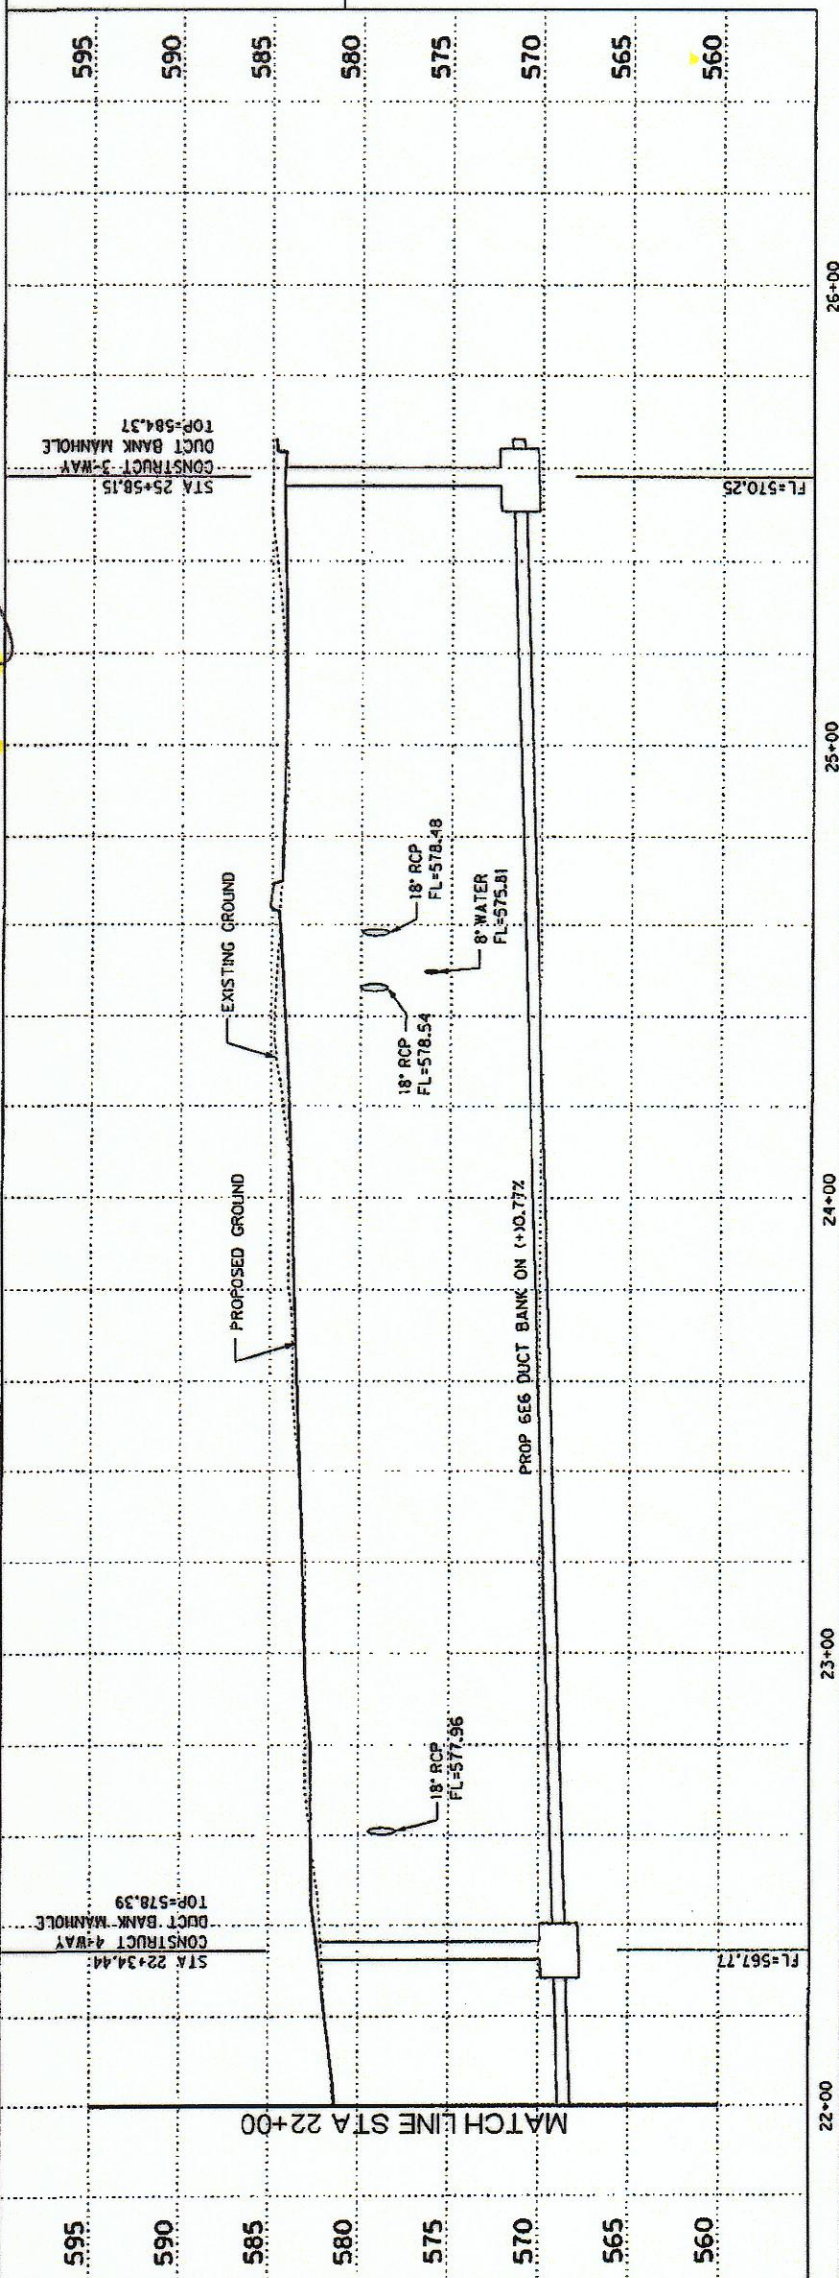


MATCH LINE STA 22+00

MATCH LINE STA 22+00

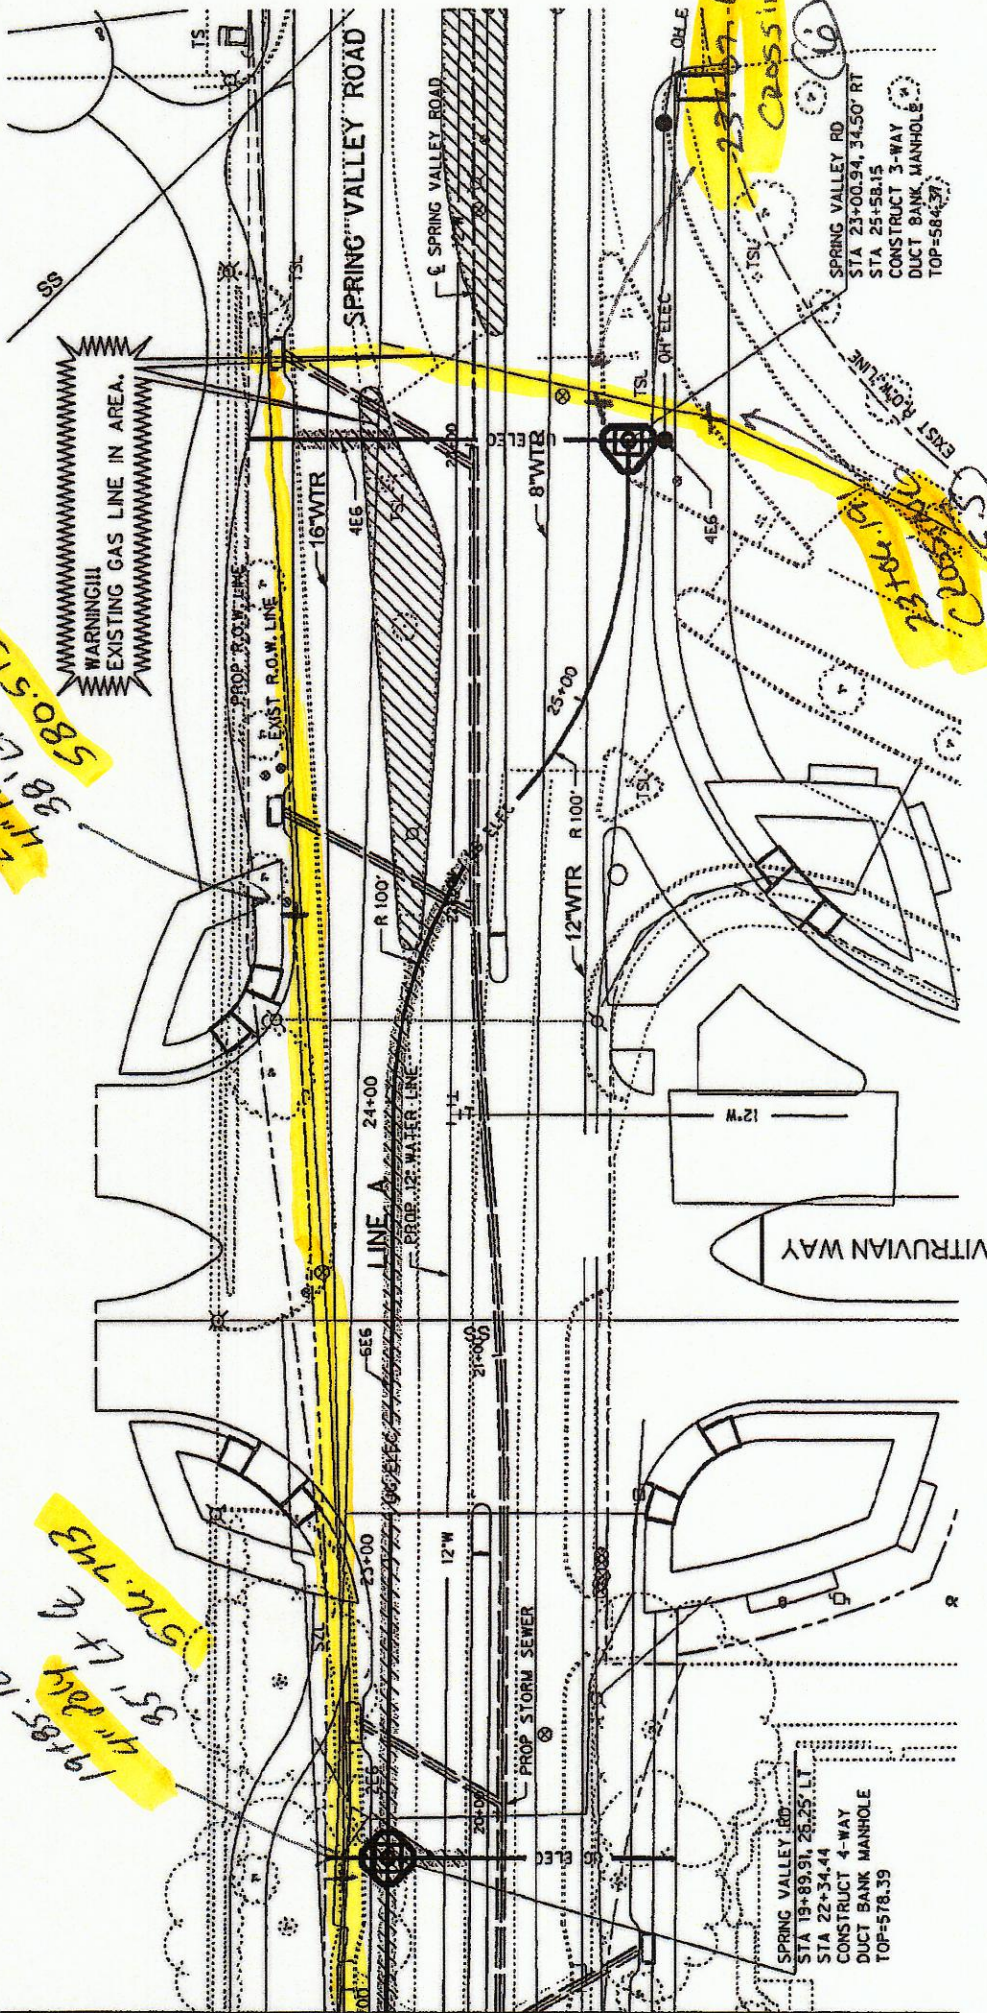

HALFF ASSOCIATES, INC.
 ENGINEERS - SURVEYORS - SCIENTISTS
 PRELIMINARY - FOR INTERIM REVIEW ONLY
 These documents are for Interim Review and not intended for Construction, Bidding, or Permit Purposes. They were prepared by, or under the supervision of:

M.E. ROMANOWSKI PEIF DATE AUGUST 2010
 56303

NO.	REVISION	BY	DATE

TOWN OF ADDISON
 DALLAS COUNTY, TEXAS
 SPRING VALLEY ROAD

PROJECT: 27530
 DESIGN: XXX
 DRAWN: XXX
 DATE: AUGUST 2010
 FILE: 27530 UELE 04
 SHEET: ELE-4

DUCT BANK PLAN AND PROFILE
 STA 22+00 TO 25+58.15

HALFF
 1201 NORTH BOWSER ROAD, RICHARDSON, TEXAS 75081-2278
 TEL: (972) 348-4300 FAX: (972) 348-4305

21787-206
 98.17 d
 580.513

19785-180
 95.17 d
 578.713

23767-DBS
 CROSSING

23767-DBS
 CROSSING