


LEGEND	
— T —	EX WATERLINE W/ VALVE
-O- P P	EXISTING POWER POLE
— E —	EXISTING OVERHEAD ELECTRIC
XXXXXX	EXISTING STORM LINE

RECORD DOCUMENTS  
 THESE RECORD DOCUMENTS HAVE BEEN PREPARED BASED ON INFORMATION PROVIDED BY OTHERS. JBI PARTNERS, INC HAS NOT VERIFIED THE ACCURACY AND/OR COMPLETENESS OF THIS INFORMATION, UNLESS OTHERWISE NOTED ON THESE DOCUMENTS. JBI PARTNERS, INC SHALL NOT BE RESPONSIBLE FOR ANY ERRORS OR OMISSIONS THAT MAY BE INCORPORATED AS A RESULT OF ERRONEOUS INFORMATION PROVIDED BY OTHERS.

JBI PARTNERS, INC  
 BY: *Steven S. Crauford*  
 DATE: 3/2/09

BENCHMARKS  
 BM #1 - CITY OF DALLAS WATER DEPARTMENT BENCHMARK, NORTHEAST CORNER OF CELESTIAL ROAD AND MONTFORT DRIVE, SQUARE CUT ON CONCRETE BASE OF 6 FOOT BRICK WALL. ELEVATION = 626.81'  
 BM #2 - SOUTHEAST CORNER OF CELESTIAL ROAD AND MONTFORT DRIVE, "X" CUT IN CONCRETE SIDEWALK, APPROXIMATELY 22 FEET NORTH OF THE CURB RETURN ON MONTFORT DRIVE. ELEVATION = 624.51'

NO.	REVISIONS DURING CONSTRUCTION	BY	DATE	NO.	REVISIONS DURING PLAN REVIEW	BY	DATE
				2.	REVSED SIDEWALK REMOVAL	JAL	8/10/06
				1.	REVSED PER CITY COMMENTS	LJG	7/28/06

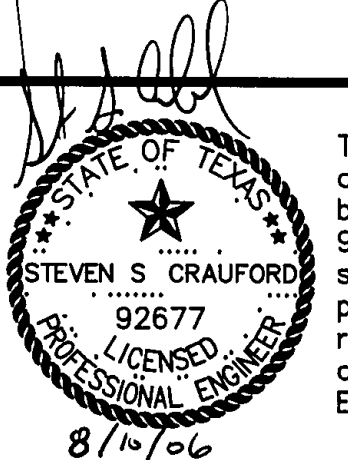

The seal appearing on this document was authorized by Steven S. Crauford, P.E. 92677. Alteration of a sealed document without proper notification to the responsible engineer is an offense under the Texas Engineering Practice Act.

**JBI Jones & Boyd, Inc.**  
 17090 Dallas Parkway, Suite 200  
 Dallas, Texas 75248  
 972 248 7676 office  
 972 248 1414 fax  
 www.jones-boyd.com

- Engineering
- Surveying
- Planning
- Landscape Architecture
- Construction Management

<b>DEMOLITION PLAN</b>		PROJECT NO
<b>STANFORD COURT VILLAS</b>		CDC004
Town of Addison, Dallas County, Texas		SHEET NO
		<b>2</b>