

CIVIL CONSTRUCTION PLANS FOR 4301 SUNBELT SANITARY SEWER EXTENSION ADDISON, TX




TOWN OF ADDISON PROJECT #: 14-06
 TOWN OF ADDISON BID #: 15-09

ENGINEER/SURVEYOR:

CobbFendley
 TBPE Firm Registration No. 274
 TBPLS Firm Registration No. 100467
 6801 Gaylord Parkway, Suite 302
 Frisco, Texas 75034
 972.335.3214 | fax 972.335.3202 | www.cobbfendley.com
 Contact: Jenny Prazak, P.E.

TOWN OF ADDISON CITY COUNCIL:

TODD MEIER	MAYOR
BLAKE CLEMENS	MAYOR PRO TEMPORE
JANELLE MOORE	DEPUTY MAYOR PRO TEMPORE
CHRIS DeFRANCISCO	COUNCIL MEMBER
MARY CARPENTER	COUNCIL MEMBER
BRUCE ARFSTEN	COUNCIL MEMBER
DAVID HEAPE	COUNCIL MEMBER
LEA DUNN	CITY MANAGER
LISA PYLES	DIRECTOR OF INFRASTRUCTURE & DEVELOPMENT SERVICES
JASON SHROYER	ASSISTANT DIRECTOR OF INFRASTRUCTURE & DEVELOPMENT SERVICES

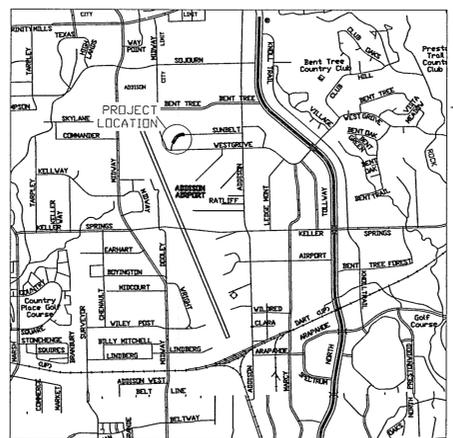

LOCATION MAP
 N.T.S.

SHEET INDEX	
Sheet Number	Sheet Title
C0.0	COVER SHEET
C1.0	GENERAL NOTES
C2.0	SANITARY SEWER LINE 'A'
C3.0	SEWER DETAILS
C4.0	SWPPP PLAN + DETAILS

SUBMITTAL LOG

NO.	DATE	DESCRIPTION
1	10.11.2014	CONSTRUCTION SET REVIEW
2	10.27.2014	CONSTRUCTION SET REVIEW RESUBMITTAL
3	11.11.2014	ISSUED FOR BID
4	11.18.2014	ADDENDUM NO. 1 ISSUED

RECORD DRAWINGS


THESE RECORD DRAWINGS HAVE BEEN PREPARED BASED ON INFORMATION PROVIDED BY OTHERS. THE ENGINEER HAS NOT VERIFIED THE ACCURACY OF THIS INFORMATION AND SHALL NOT BE RESPONSIBLE FOR ANY ERRORS OR OMISSIONS WHICH MAY BE INCORPORATED HEREIN AS A RESULT.

COBB, FENDLEY & ASSOCIATES, INC.
 By: *Jenny Prazak* Date: 4/7/15

RECORD DRAWING
 Date 04/07/15

Construction Inspector Town of Addison
 Contractor Wilson Contractor Services

This drawing reflects the construction work of this project according to available information furnished to the Engineer during the progress of the construction.

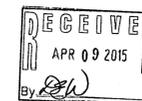

THE LOCATION OF EXISTING UNDERGROUND UTILITIES ARE APPROXIMATE. THE CONTRACTOR IS RESPONSIBLE FOR VERIFYING THE LOCATION OF UNDERGROUND UTILITIES PRIOR TO CONSTRUCTION. THE CONTRACTOR IS TOTALLY RESPONSIBLE FOR COORDINATING THE LOCATION, AND PRESERVATION OF EXISTING DRY UTILITIES (ELECTRIC, TELEPHONE, CABLE, ETC.).