



CORDELL & ASSOCIATES, INC.
 consulting engineers
 Dallas Texas


SEPT. 1970 70-3-8

Revised 11-9-70
 4-19-71 As built


WILEY POST ROAD

STA. 12+00
 MATCH LINE

MATCH LINE
 STA. 24+00

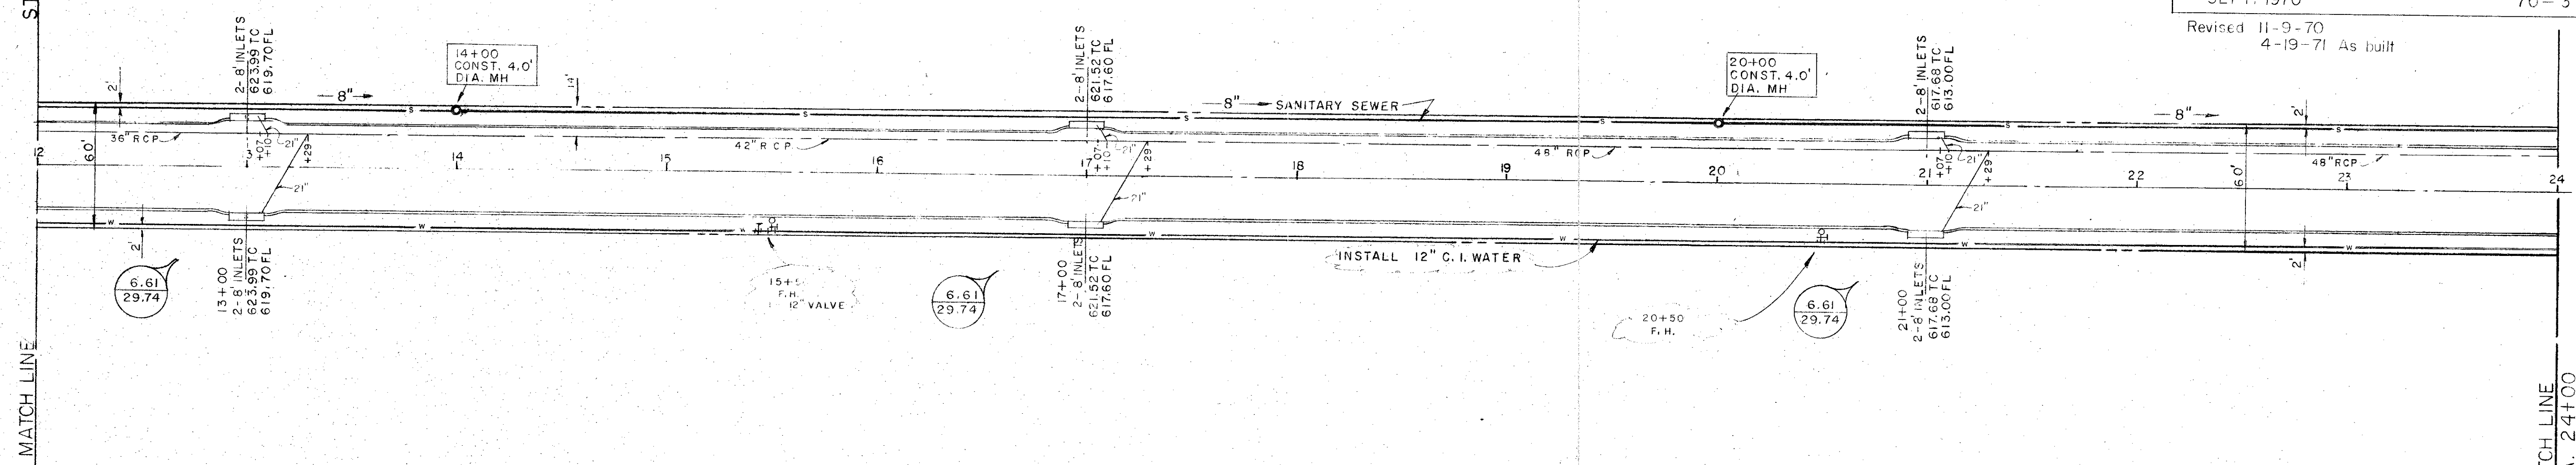

B.M. HILT NAIL IN T.R. & L. TRANS. TWR. FOOTING, NE. COR., 3RD TWR. HO. OF RR. ELEV. 605.00
 B.M. 60" NAIL SET IN 2" POWER POLE NO. OF WILEY POST RD., WEST SIDE OF DOOLEY RD. ELEV. 633.30

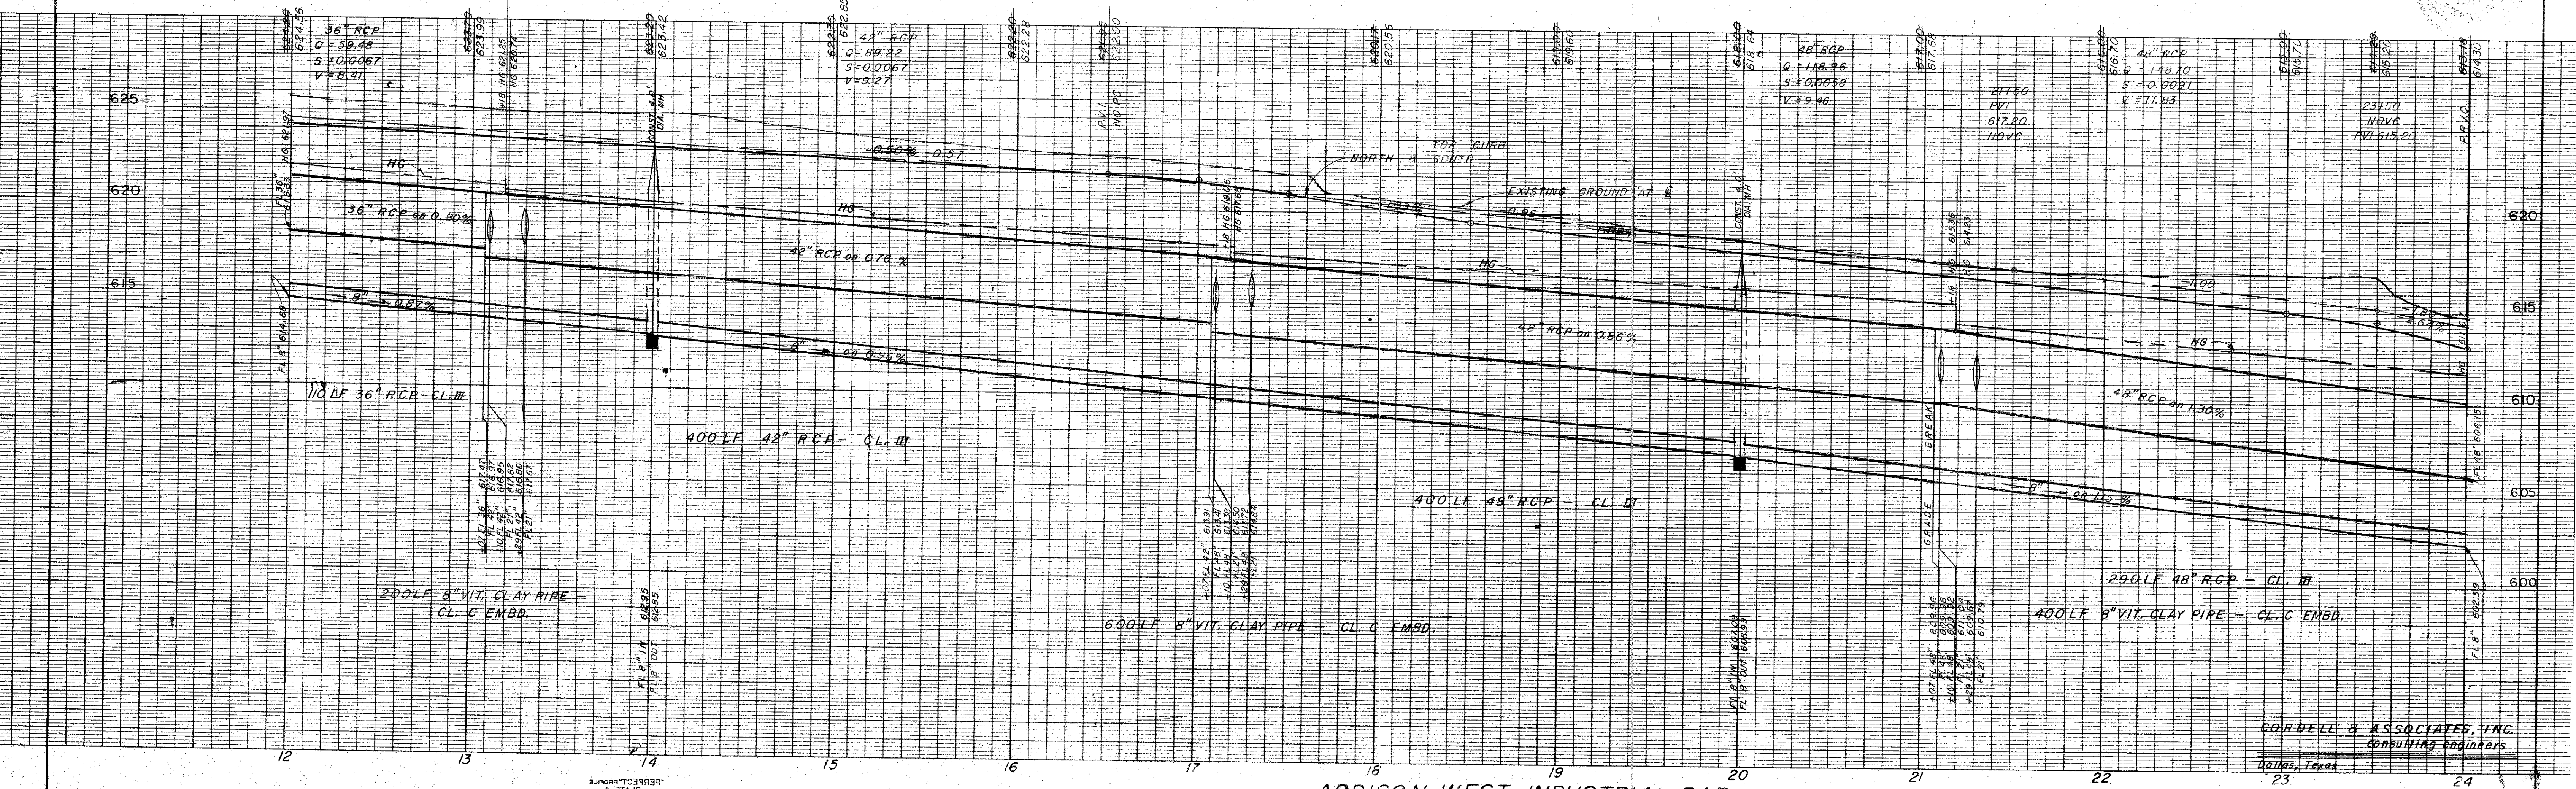

CORDELL & ASSOCIATES, INC.
 consulting engineers
 Dallas, Texas

— ADDISON WEST INDUSTRIAL PARK — WILEY POST RD. —