


LEGEND

- PH FIRE HYDRANT
- PP POWER POLE
- LS LIGHT STANDARD
- WM WATER METER
- WV WATER VALVE
- WC CLEANOUT
- MH MANHOLE
- GM GAS METER
- PROPERTY LINE
- INDICATES 6" CONCRETE CURB
- INDICATES 18" CONCRETE CURB

0 20 40 80 120
GRAPHIC SCALE IN FEET

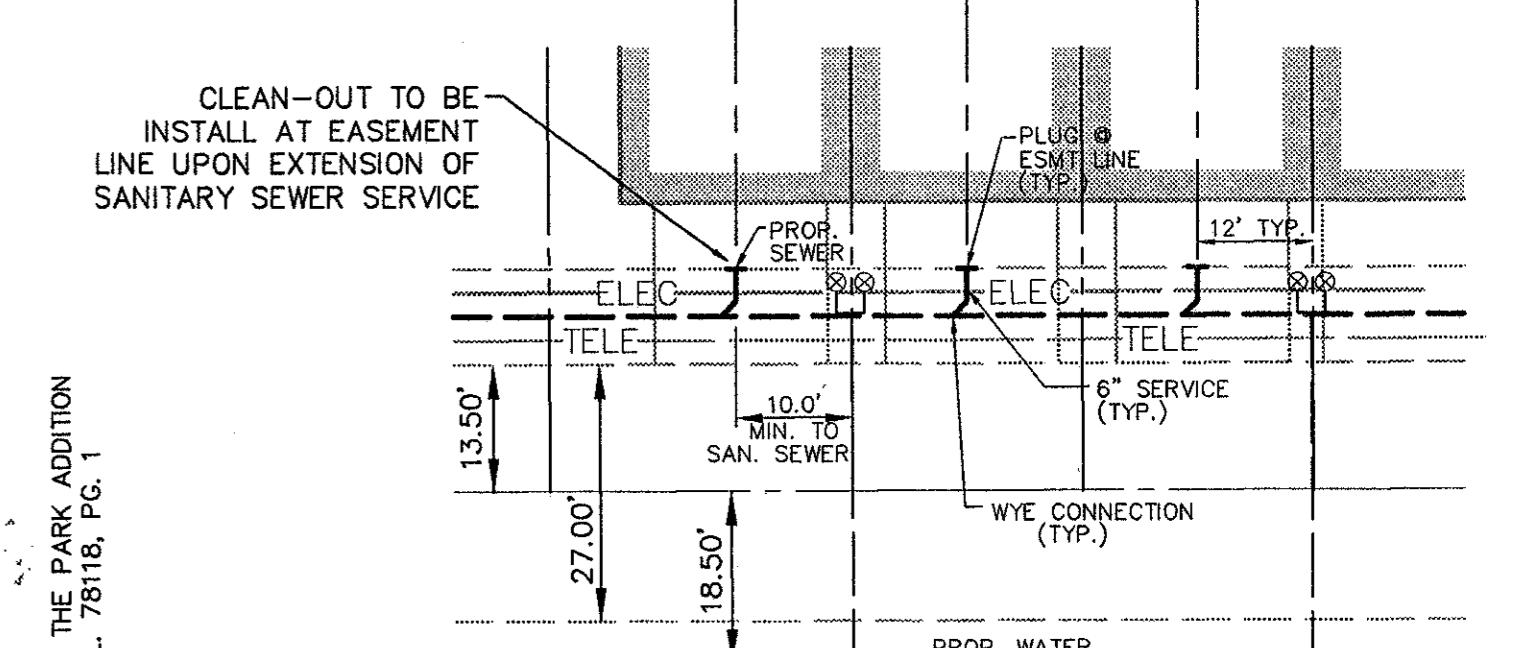

CAUTION!
GAS LINE IN AREA - CONTACT LONE STAR GAS 48 HOURS PRIOR TO CONSTRUCTION PHONE: 283-3444

CAUTION!
MR. ED KEAH, OPERATING SUPPORT SECTION DISTRIBUTION DEPARTMENT, 2 WORKING DAYS PRIOR TO EXCAVATING T.U. ELECTRIC FACILITIES PHONE: 698-7239 OR 698-7207

CAUTION!
UNDERGROUND TELEPHONE IN AREA - CONTACT S.W.B.T. 48 HOURS PRIOR TO CONSTRUCTION PHONE: 698-7239 (UNDERGROUND) PHONE: 698-7240 (OVER-HEAD)



- BENCHMARK LIST**
- "□" CUT ON TOP OF CURB IN FRONT OF FIRE HYDRANT ON NORTH SIDE OF BELTWAY DRIVE, 160± FEET EAST OF CENTERLINE OF LA GRANDE DRIVE EL = 629.57
 - "□" CUT ON TOP OF CURB ON NORTH WEST CORNER OF PARKING LOT AT 14833 MIDWAY ROAD. EL = 630.53
 - "□" CUT ON TOP OF CURB OF SOUTHWEST CORNER OF PARKING LOT AT 14833 MIDWAY ROAD. EL = 628.75

RECORD DRAWING

THIS DRAWING HAS BEEN REVISED TO REFLECT CONSTRUCTION RECORDS MAINTAINED AND PROVIDED BY THE CONTRACTOR FOR THIS PROJECT.

CONTRACTOR: THE HUBBLE GROUP

DATE REVISED: 11/10/99

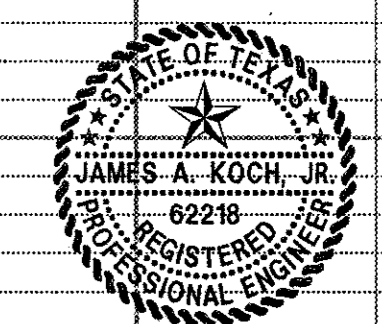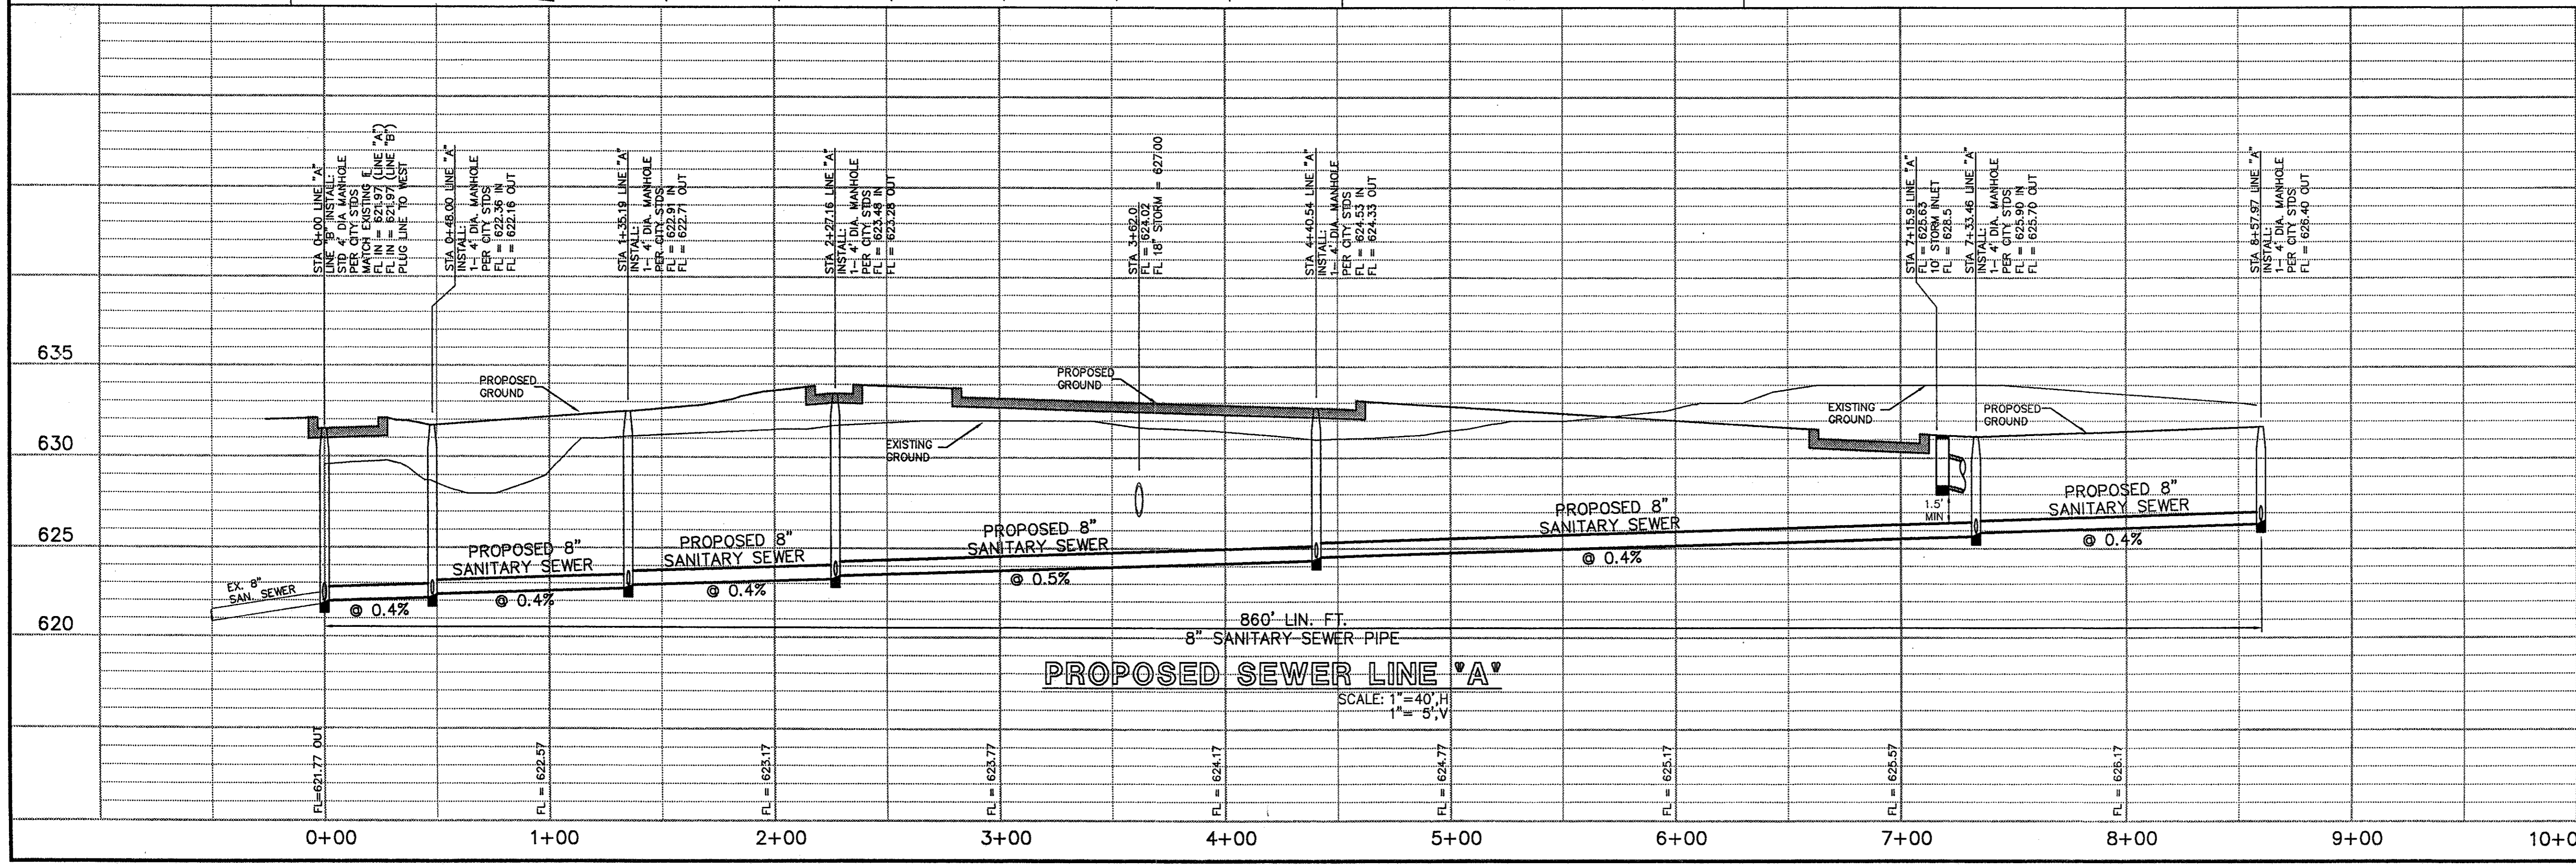

THIS DOCUMENT IS RELEASED FOR THE PURPOSE OF INTERIM REVIEW UNDER THE AUTHORITY OF JAMES A. KOCH JR., P.E. 62218 ON 12/16/96. IT IS NOT TO BE USED FOR CONSTRUCTION, BIDDING OR PERMIT PURPOSES.

PACHECO KOCH 9401 I.B.J. Freeway, Suite 300
Consulting Engineers, Inc. Dallas, Texas 75243
Civil Engineering • Land Surveying (972) 235-3031

SANITARY SEWER LINE 'A'
TOWNE LAKE ADDITION
STA 0+00 TO STA 8+57.97
TOWNES OF ADDISON
TOWN OF ADDISON, TEXAS

DESIGN	DRAWN	DATE	SCALE	NOTES	FILE	NO.
JAK	JSN	12/16/96	1" = 40' H 1" = 5' V			C-4.2