


Good Fulton & Farrell Architects
 214.303.1500/Tel
 214.303.1512/Fax
 www.gff.com
 2808 Fairmount Street
 Dallas, Texas 75201
 © Good Fulton & Farrell 2009

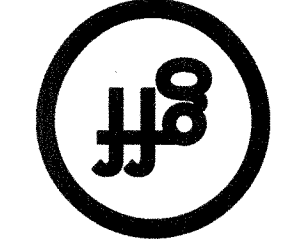


McInnish Engineering,
 10501 FM 2222, Suite R-128
 Addison, Texas 75240
 Dallas: 214.613.0901

VILLAGE ON THE PARKWAY
 5100 BELT LINE ROAD
 Addison, Texas 75254

No.	Date	Item	REVISIONS
7	12.07.12	ASI #6	
8	06.14.12	Addendum #2	

BBM
 Designer
 BBM
 Checker
 BBM
 Approver

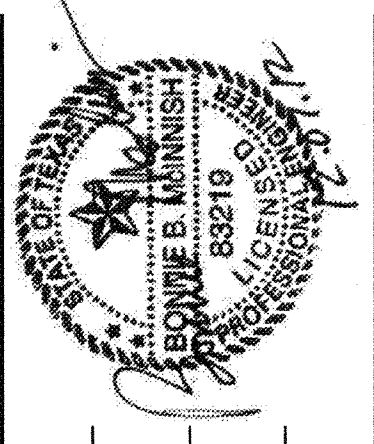

FLOOR PLAN - SOUTH
 PLUMBING

Project No. 11013.03
 Date 05.25.12
 Last Revision MWJ/BBM
P2.02

AS-BUILT DRAWINGS
 7-19-13

1 FLOOR PLAN - SOUTH - PLUMBING
 SCALE: 1/8"=1'-0"

