#### 1.1 SCOPE

- Provide complete sprinkler installation as detailed and specified herein, includes furnishing all labor, materials, and equipment for the proper installation. Work includes but is not limited to:
  - Trenching and backfill 2. Automatic controlled system. 3. Upon completion of installation, supply drawings showing details of construction including location of mainline piping, manual and automatic valves, electrical supply to
- All sleeves as shown on plans will be furnished by General Contractor. Meter and power source to be provided by General Contractor.

valves, and specifically exact location of automatic valves.

- 1.2 RELATED WORK SPECIFIED ELSEWHERE
  - A. See Irrigation Plans. See plans for controller, heads, and valves.
  - B. Section 02900-Landscape
  - C. Section 02811-Underground Irrigation Sleeve and Utility Conduits
- 1.3 APPLICABLE STANDARDS
- A. America Standard for Testing and Materials (ASTM) Latest edition.
- 1. D2241 Poly (Vinyl Chloride) (PVC) Plastic Pipe (SDR-PR) 2. D2464 Poly (Vinyl Chloride) (PVC) Plastic Pipe Fittings, Thread, Schedule 80 3. D2455 Poly (Vinyl Chloride) (PVC) Plastic Pipe Fittings, Schedule 40
- 4. D2467 Poly (Vinyl Chloride) (PVC) Plastic Pipe Fittings, Socket Type, Schedule 80 5. D2564 Solvent Cements for Poly (Vinyl Chloride) (PVC) Plastic Pipe and Fittings
- 6. D2287 Flexible Poly Vinyl Chloride (PVC) Plastic Pipe 7. F656 Poly Vinyl Chloride (PVC) Solvent Weld Primer 8. D2855 Making Solvent – Cemented Joints with Poly (Vinyl Chloride) (PVC) Pipe and
- 1.4 MAINTENANCE AND GUARANTEE

ROTARY HEAD

- Materials and workmanship shall be fully guaranteed for one (1) year after final
- Provide maintenance of system, including raising and lowering of heads to compensate for lawn growth, cleaning and adjustment of heads, raising and lowering of shrub heads to compensate for shrub growth, for one (1) year after completion of installation.
- Guarantee is limited to repair and replacement of defective materials or workmanship, including repair of backfill settlement.

ROTARY HEAD

CONTROLLER AS SPECIFIED MOUNT @ 4'-4" HT.=/-

- STEEL MALE CONNECTOR

— 1 1/4" RIGID STEEL CONDUIT

HARD WIRE 117 VOLT A.C. POWER TO

TO FLUSH OUTLET BEHIND CONTROLLER

STEEL SPLICE BOX WITH FRONT ACCESS PANEL

RIGID STEEL CONDUIT (SAME SIZE AS

STEEL COUPLING (AS REQUIRED)

— ← FINISH FLOOR

10 TechLine CV END FEED LAYOUT

STEEL SWEEP ELL

RIGID STEEL CONDUIT BELOW

FLOOR OR GRADE

- CONDUIT BELOW GRADE) CONDUIT SHALL

—— SWING JOINT

LATERAL PIPING

NOT TO SCALE

NOT TO SCALE

REMOTE CONTROL VALVE WITH DISC FILTER AND PRV

Techline START

CONNECTION MALE ADAPTER

———— Techline® CV TUBING

— PVC OR POLY SUPPLY HEADER

PVC OR POLY EXHAUST HEADER

- MANUAL LINE FLUSHING VALVE PLUMBED TO PVC OR POLY

PERIMETER LATERALS 2" TO 4" FROM EDGE

NOT TO SCALE

SIDEWALK OR CURB

#### 1.5 SUBMITTALS

- Procedure: Comply with Division I requirements.
- Product Data: Submit (5) copies of equipment manufacturer's specifications and literature for approval by Landscape Architect prior to installation.
- Project Record Documents
- 1. Comply with Division I requirements. 2. Locate by written dimension, routing of mainline piping, remote control valves and quick coupling valves. Locate mainlines by single dimensions from permanent site features provided they run parallel to these elements. Locate valves, intermediate
- electrical connections, and quick couplers by two dimensions from a permanent site feature at approximately 70 degrees to each other. 3. When dimensioning is complete, transpose work to mylar reproducible tracings. 4. Submit completed tracings prior to final acceptance. Mark tracings "Record Prints
- Showing Significant Changes". Date and sign drawings. 5. Provide three complete operation manuals and equipment brochures neatly bound in a hard back three-ring binder. Include product data on all installed materials. Include warranties and guarantees extended to the Owner by the manufacturer of all
- D. Quick Coupler Keys: Provide 3 coupler keys with boiler drains attached using brass
- Controller Keys: Provide three sets of keys to controller enclosure(s).
- Use of materials differing in quality, size, or performance from those specified will only be allowed upon written approval of the Landscape Architect. The decision will be based on
- comparative ability of material or article to perform fully all purposes of mechanics and general design considered to be possessed by item specified.
- G. Bidders desiring to make a substitution for specified sprinklers shall submit manufacturer's catalog sheet showing full specification of each type sprinkler proposed as a substitute, including discharge in GPM maximum allowable operating pressure at
- Approval of substitute sprinkler shall not relieve Irrigation Contractor of his responsibility
- to demonstrate that final installed sprinkler system will operate according to intent of originally designed and specified system. I. It is the responsibility of the Irrigation Contractor to demonstrate that final installed sprinkler system will operate according to intent of originally designed and specified

system. If Irrigation Contractor notes any problems in head spacing or potential

coverage, it is his responsibility to notify the Landscape Architect in writing, before proceeding with work. Irrigation Contractor guarantees 100% coverage of all areas to be

Perform testing required with other trades, including earthwork, paving, plumbing, electrical, etc. to avoid unnecessary cutting, patching and boring. B. Wire Connectors: Waterproof splice kit connectors. Type DBY by 3M.

#### 2.6 SCHEDULE 80 PVC NIPPLES

- A. Composed of Standard Schedule 40 PVC Fittings and PVC meeting noted standards. No clamps or wires may be used. Nipples for heads and shrub risers to be nominal one-half inch diameter by eight inches long, where applicable.
- B. Polyethylene nipples six (6") inches long to be used on all pop-up spray heads.
- 2.7 MATERIALS See Irrigation Plan
- Sprinkler heads in lawn area as specified on plan.
- PVC Pipe: Class 200, SPR 21 Copper Tubing (City Connection): Type "M" 24V Wire: Size 14, Type U.F.
- C. Electric valves to be all plastic construction as indicated on plans. Refer to drawing for backflow prevention requirements and flow valve.

#### PART 3 - EXECUTION

#### 3.1 INSTALLATION - GENERAL

- Staking: Before installation is started, place a stake where each sprinkler is to be located, in accordance with drawing. Staking shall be approved by Landscape Architect before proceeding.
- Excavations: Excavations are unclassified and include earth, loose rock, rock or any combination thereof, in wet or dry state. Backfill trenches with material that is suitable for compaction and contains no lumps, clods rock, debris, etc. Special backfill specifications, if furnished take preference over this general specification.
- Backfill: Flood or hand-tamp to prevent after settling. Hand rake trenches and adjoining area to leave grade in as good or better condition than before installation.
- Piping Layout: Piping layout is diagrammatic. Route piping around trees and shrubs in such a manner as to avoid damage to plantings. Do not dig within ball of newly planted trees or shrubs.

# 3.2 PIPE INSTALLATION

- Sprinkler Mains: Install a four (4") inch minimum trench with a minimum of eighteen (18") inches of cover.
- Lateral Piping: Install a four (4") inch wide minimum trench deep enough to allow for installation of sprinkler heads and valves, but in no case, with less than twelve (12") of
- Trenching: Remove lumber, rubbish, and large rocks from trenches. Provide firm, uniform bearing for entire length of each pipe line to prevent uneven settlement. Wedging or blocking of pipe will not be permitted. Remove foreign matter or dirt from inside of pipe before welding, and keep piping clean by approved means during and after laying of pipe.

# 3.3 PVC PIPE AND FITTING ASSEMBLY

- Solvent: Use only solvent recommended by manufacturer to make solvent-welded joints. Thoroughly clean pipe and fittings of dirt, dust and moisture before applying solvent.
- PVC to metal connection: Work metal connections first. Use a non-hardening pipe dope such as Permatex No. 2 on threaded PVC adapters into which pipe may be welded.

#### 3.4 COPPER TUBING AND FITTING ASSEMBLY

Clean pipe and fitting thoroughly and lightly sand pipe connections to remove residue from pipe. Attach fittings to tubing in an approved manner using 50-50 soft solid core solder.

# 3.5 POP-UP SPRAY HEADS

Supply pop-up spray heads in accordance with materials list and plan. Attach sprinkler to lateral piping with a semi-flexible polyethylene nipple not less than three (3") inches or more than six (6")

#### 3.6 VALVES

Supply valves in accordance with materials list and sized according to drawings. Install valves in a level position in accordance with Manufacturer's Specifications. See plan for typical installation of electric valve, valve box.

# WIRING

VALVE BOX AND LID

- Supply wire from the automatic sprinkler controls to the valves. No conduit will be required for U.F. wire unless otherwise noted on the plan. Wire shall be tucked under the
- A separate wire is required from the control to each electric valve. A common neutral wire is also required from each control to each of the valves served by each particular
- Bundle multiple wires and tape them together at ten (10') foot intervals. Install ten (10") inch expansion coil at not more than one hundred (100') foot intervals. Make splices
- 3.8 AUTOMATIC SPRINKLER CONTROLS

NOT TO SCALE

# Supply in accordance with Irrigation Plan. Install according to manufacturer's recommendations.

# 3.9 TESTING

A. Sprinkler Mains: Test sprinkler main only for a period of twelve (12) to fourteen (14) hours under normal pressure. If leaks occur, replace joint or joints and repeat test. B. Complete tests prior to backfilling. Sufficient backfill material may be placed in trenches between fittings to insure stability of line under pressure. In each case, leave fittings and couplings open to visual inspection for full period of test.

HT-T FINISH GRADE

ADAPT INLET AND OUTLET

PVC LINE PER SPECIFICATIONS TO IRRIGATION SYSTEMS

UTILITY GRAVEL (1/2" - 3/4" DIA.), 10" DEPTH for Testing and Repair

MAINLINE

NOT TO SCALE

TAPE & BUNDLE WIRING AT 10'-0" INTERVALS.

. MAIN FROM SOURCE PER CITY REQUIREMENT

(AS REQUIRED)

MASTER VALVE

(09) TRENCH DETAIL

## 3.10 FINAL ADJUSTMENT

After installation has been completed, make final adjustment of sprinkler system in preparation for Landscape Architect's final inspection. Completely flush system to remove debris from lines and turning on system. Check sprinklers for proper operation and proper alignment for direction of flow. Check each section of spray heads for operating pressure and balance to other sections by use of flow adjustment and top of each valve. Check nozzling for proper coverage. Prevailing wind conditions may indicate that arch of angle of spray should be other than shown on drawings. In this case, change nozzles to provide correct coverage.

## END OF SECTION




landscape architects, inc. 1708 N. Griffin Street Dallas, Texas 75202 Tel 214,871,0083

Fax 214.871.0545 Ema**il** smr@smr-la.com

# ARKWAY 0




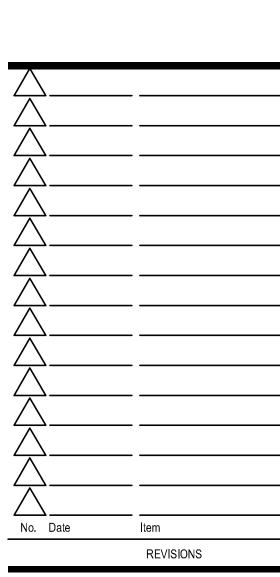


**IRRIGATION SPECIFICATIONS** 


05.25.12 Last Revision L2.02


RECORD DRAWINGS (October 2013) Information Provided By **BOB MOORE** 

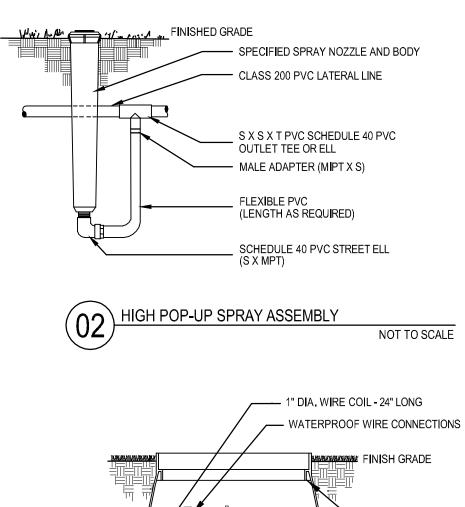


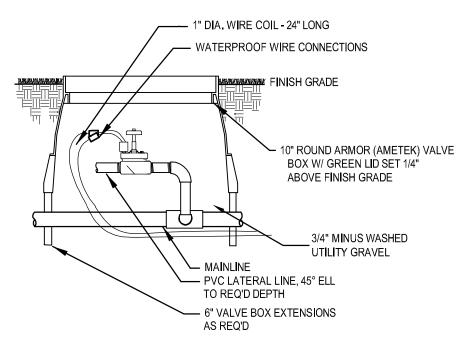



NOT TO SCALE

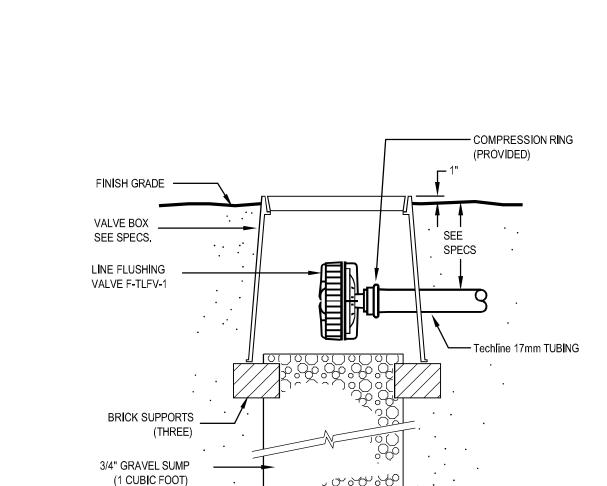

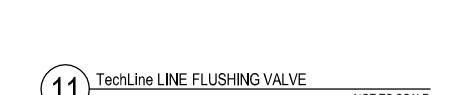

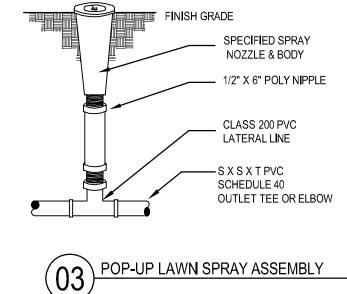

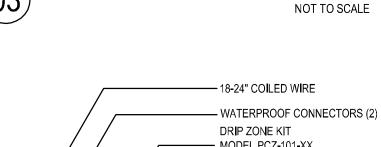

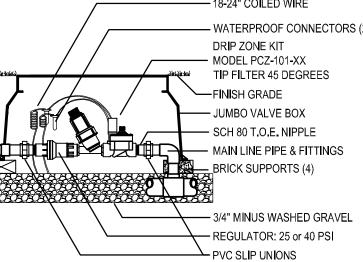



AIR / VACUUM REL**I**EF VALVE

BUSHING


(THREE)

Techline 180 2-WAY

ADAPTER TEE


3/4" CRUSHED GRAVEL SUMP


Techline TUBING

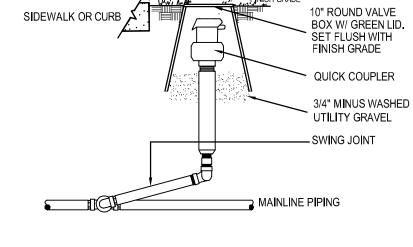



BACKFLOW PREVENTER




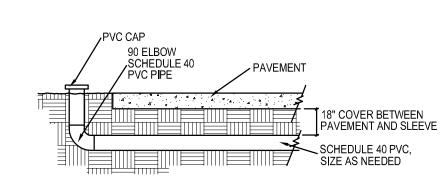


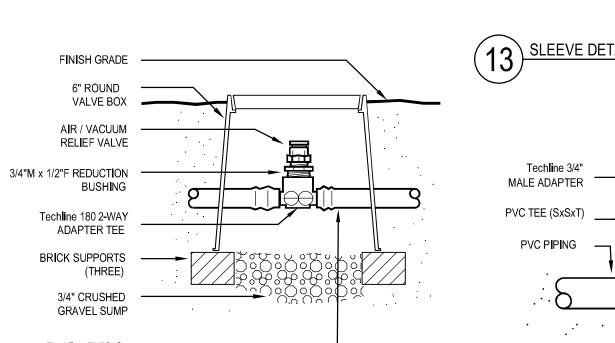

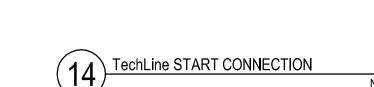

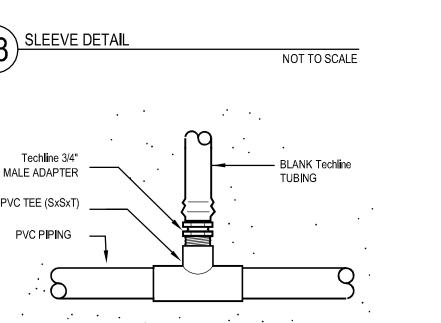

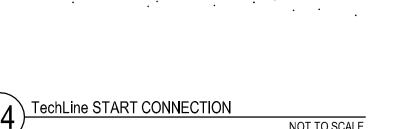

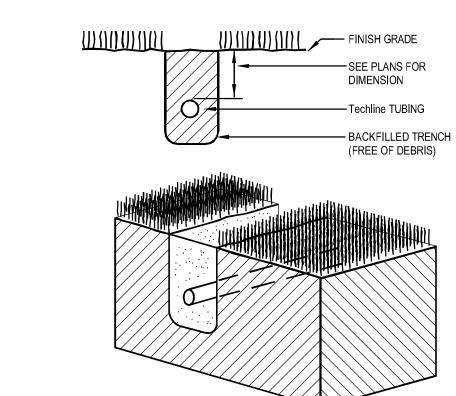

(15) TechLine TRENCHING NOT TO SCALE