


LOT CORNER COORDINATES

#	Y	X
49	1416.196	2697.371
50	1416.196	2899.684
54	1416.196	2272.186
56	1416.196	2008.351
59	1543.196	2309.684
60	1747.419	2309.684
61	1543.196	2583.245
62	1385.925	2724.605

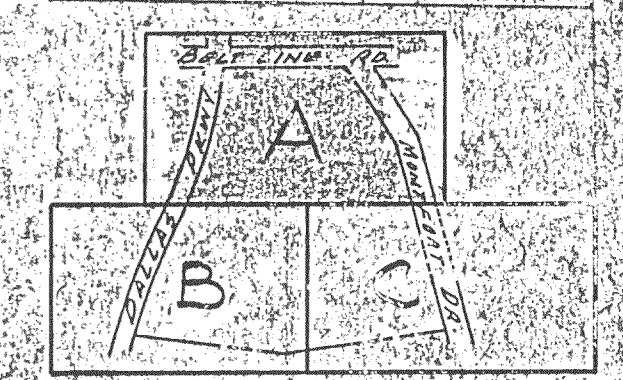

KEY MAP

A-4 CONSTRUCT STD 10 CURB INLET W/ 12" SLOPE  
 TOP: 622.8 E. 618.00 G. 118.3  
 12" x 12" 12" x 12" 12" x 12"  
 R.P.F. DRAINAGE TO HERE  
 A-4 CONSTRUCT STD 10 CURB INLET  
 TOP: 623.8 E. 618.00 G. 118.4  
 12" x 12" 12" x 12" 12" x 12"

REMOVE EXIST. INLET BOTTOM  
 PLUG 21" R.C.P.

21" R.C.P.  
 2' 00"  
 2' 00"  
 2' 00"  
 2' 00"

11" 52.5" 12" INLET  
 CONSTRUCT STD 10 CURB INLET  
 TOP: 615.50 E. 619.95 G. 116.0  
 12" x 12" 12" x 12" 12" x 12"  
 CONSTRUCT STD 10 CURB INLET  
 TOP: 616.50 E. 619.95 G. 116.0  
 12" x 12" 12" x 12" 12" x 12"  
 11" 52.5" 12" INLET  
 CONSTRUCT STD 10 CURB INLET  
 TOP: 617.00 E. 619.95 G. 116.0  
 12" x 12" 12" x 12" 12" x 12"

3" x 33" 30" PIPE CANN.  
 3" x 33" 30" PIPE CANN.

BENCH MARK: STANDARD WATER DEPT.  
 BENCH MARK CENTER INLET,  
 NORTHWEST CORNER BELTLINE  
 ROAD AND DALLAS PARKWAY  
 ELEV. 632.08

NOTE: REFER TO HORIZONTAL LAYOUT  
 & PAVING PLANS FOR EXACT  
 LOCATION OF CURB INLETS

1/4/79 REVISED TO CONFORM WITH  
 A-C GRADING PLAN

**STORM SEWER PLAN**  
**VILLAGE ON THE PARWAY**  
**VILLAGE PARKWAY VENTURE**  
 ALBERT H. H. ZEE ASSOCIATES, INC., ENGINEERS  
 CITY OF ADDISON, TEXAS

DESIGN	DRAWN	DATE	SCALE	NO. OF SHEETS	SHEET NO.
A.H.H. ASSOC.	T.P.	MAY 1978	1" = 40'	6163	