


NOTE:
THE SANITARY SEWERS ON LOT E ARE ASSOCIATED WITH A.H. HALFF ASSOCIATES, INC. AS SUCH IS AVAILABLE. SEE OUT SHEETS PROVIDED BY A.H. HALFF.

FOR WATER/SEWER RELOCATION'S SEE LOT E 411Q-1909A SH. 14, 15 LINES 'A' & 'D' F.B.K. 560 P. 41, 42

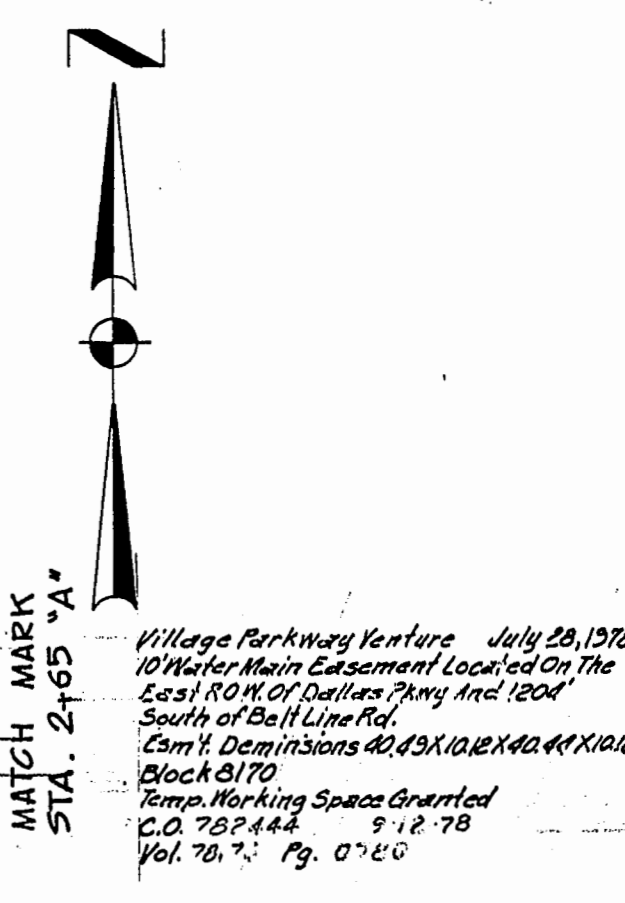



Lot Corner Coordinates

#	Y	X
31	599.786	2448.291
32	716.143	2448.293
33	663.938	1632.055
34	779.394	1644.281
35	873.083	2072.684
36	1074.196	2072.684
37	1074.196	2199.684
38	863.092	2199.684
39	843.534	2448.286
40	845.835	2477.684
41	1074.196	2477.684
42	1074.196	1803.553
43	899.359	1738.696
44	1074.196	2604.684
45	858.771	2604.684
51	1201.196	2399.684
53	1201.196	2272.684
57	1201.196	1873.316
70	740.099	2143.765
71	624.456	2134.647
72	621.240	2175.541
73	736.883	2184.639
77	724.789	2558.702
78	609.142	2567.755
80	727.989	2599.577
81	729.165	2614.596
504	593.400	2610.113
505	733.150	2614.285

KEY MAP

MATCH LINE SHEET 35

#	Y	X
31	599.786	2448.291
32	716.143	2448.293
33	663.938	1632.055
34	779.394	1644.281
35	873.083	2072.684
36	1074.196	2072.684
37	1074.196	2199.684
38	863.092	2199.684
39	843.534	2448.286
40	845.835	2477.684
41	1074.196	2477.684
42	1074.196	1803.553
43	899.359	1738.696
44	1074.196	2604.684
45	858.771	2604.684
51	1201.196	2399.684
53	1201.196	2272.684
57	1201.196	1873.316
70	740.099	2143.765
71	624.456	2134.647
72	621.240	2175.541
73	736.883	2184.639
77	724.789	2558.702
78	609.142	2567.755
80	727.989	2599.577
81	729.165	2614.596
504	593.400	2610.113
505	733.150	2614.285

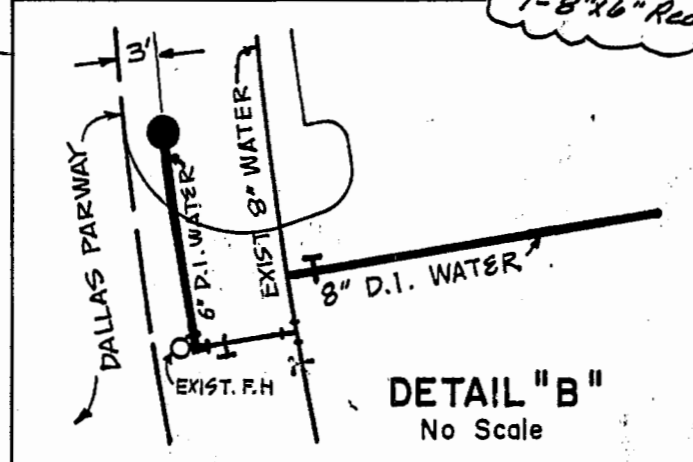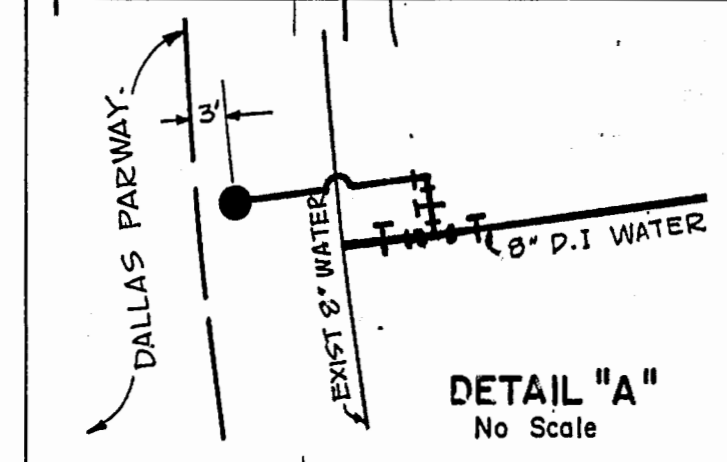

VERDE VALLEY PARKWAY PLACE ADDITION No. 1 VOL. 10202 P. 1934 BLOCK A 870
BENCHMARK: STANDARD WATER DEPT. BENCHMARK CENTER MUST NOW CORRECT B.C.T. LINE RA AND DALLAS PARKWAY ELEV. 652.00
LOCATION: VILLAGE ON THE PARKWAY SECOND INSTALLMENT DESIGNED BY A.H. HALFF ASSOCIATES, INC. 3/15/78
R.A.V. APPROVED: DATE: 4-25-78
ENGINEER: MICHAEL R. HALFF, P.E. DATE: 4-25-78
Contract No. 79-239 P879-240 P - 58 Mason Creek - April, 1979

DESIGNED: A.H. HALFF ASSOCIATES, INC. - ENGINEERS
R.A.V. APPROVED: DATE: 4-25-78
ENGINEER OF DESIGN: DALLAS WATER UTILITIES DEPT.
CONTRACT NO. 78-2614, 78-2622 - 51/1000 Sept 25, 1978

WATER & SANITARY SEWER PLANS

VILLAGE ON THE PARKWAY
VILLAGE PARKWAY VENTURE
ALBERT H. HALFF ASSOCIATES, INC. - ENGINEERS
CITY OF ADDISON, TEXAS

DESIGN	DRAWN	DATE	SCALE	NOTES	FILE	NO.
ALH	TP	MAY 1978	1"=40'	6148	411Q	1960