


Temp 6" on exist.
 for work on plus 5 & 6

Stand laying not to line
 to 45
 2' out road between pipes
 Rem has on exist set to delete
 values sta 10+00
 + 10+00
 10-14 running side exist

DAVE I TALKED TO MARK
 THE REMOVE & REPLACE GATE
 VALVE WAS TO BE REMOVED
 AND REPLACED W/ NEW VALVE.
 THE TEMP 6" GATE VALVE
 WAS A TEMPORARY 6" ON
 THE EXISTING 6" LINE FOR
 WORK ON PHASE 5 & 6.

LISTING OF PROPOSED SERVICES/METERS AND VALVES


STATION	LINE DESIGNATION	NORTHING	EASTING	MATERIALS
6+03.06	WL 'C'	5507.75	5129.39	2" TAPPING SADDLE & 35 LF 2" TYPE 'K' COPPER SERVICE
6+05.06	WL 'C'	5507.76	5131.39	2" TAPPING SADDLE & 36 LF 2" TYPE 'K' COPPER SERVICE
6+11.74	WL 'C'	5507.81	5138.04	8" GATE VALVE
6+18.34	WL 'C'	5507.87	5143.65	8" GATE VALVE
6+22.85	WL 'C'	5507.80	5271.14	8" GATE VALVE
10+05.33	WL 'C'	5248.32	5271.14	8" GATE VALVE
10+09.86	WL 'C'	5243.79	5271.14	2" TAPPING SADDLE & 39 LF 2" TYPE 'K' COPPER SERVICE
10+14.44	WL 'C'	5239.21	5271.14	8" GATE VALVE
10+21.85	WL 'C'	5231.80	5271.14	2" TAPPING SADDLE & 35 LF 2" TYPE 'K' COPPER SERVICE
10+24	WL 'C'	5229.65	5271.14	2" TAPPING SADDLE & 34 LF 2" TYPE 'K' COPPER SERVICE
10+34.28	WL 'C'	5219.37	5271.14	8" GATE VALVE
10+41.71	WL 'C'	5211.94	5271.14	TEMPORARY 6" GATE VALVE
10+43.45	WL 'C'	5192.24	5265.58	8" GATE VALVE & TEMPORARY 8"x6" REDUCER
10+70.91	WL 'C'	5186.57	5260.74	8" GATE VALVE
13+11.58	WL 'C'	5003.42	5104.61	2" TAPPING SADDLE & 34 LF 2" TYPE 'K' COPPER SERVICE
13+97.26	WL 'C'	4938.21	5048.03	8" GATE VALVE

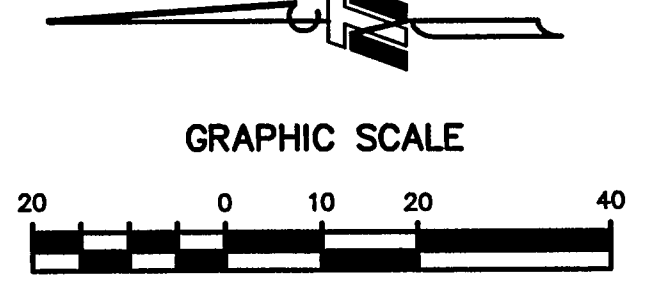

BENCHMARK
 BM:
 CUT CROSS SET IN THE TOP AT THE SOUTHEAST SIDEWALK
 INTERSECTION ON THE EAST SIDE OF THE FIRE LANE OPPOSITE
 APARTMENT BUILDING #24
 COORDINATES: N 5259.29 E 4562.25 ELEVATION: 570.84

CAUTION!!
 EXISTING UTILITIES
 LOCATIONS OF EXISTING UTILITIES SHOWN ON THESE PLANS ARE APPROXIMATE
 BASED ON INFORMATION PROVIDED BY THE OWNERS OF THE UTILITIES AND FIELD
 SURVEYS. THERE MAY ALSO BE EXISTING UTILITIES THAT ARE NOT SHOWN. THE
 OWNER AND ENGINEER SHALL NOT BE RESPONSIBLE FOR THE ACCURACY OF THIS
 INFORMATION. CONTRACTOR SHALL LOCATE ALL UTILITIES PRIOR TO BEGINNING
 CONSTRUCTION. IF A CONFLICT IS DISCOVERED BETWEEN EXISTING UTILITIES AND
 PROPOSED IMPROVEMENTS, CONTRACTOR SHALL NOTIFY ENGINEER IMMEDIATELY.
 IT SHALL BE CONTRACTOR'S SOLE RESPONSIBILITY TO COORDINATE WITH UTILITY
 COMPANY FOR ANY NECESSARY RELOCATION OF FACILITIES AND NO SEPARATE
 PAYMENT SHALL BE MADE. ADDITIONALLY, CONTRACTOR SHALL NOT BE
 COMPENSATED FOR DELAYS OR REMOVALIZATION DUE TO UTILITY COORDINATION.
 ANY DAMAGE TO EXISTING UTILITIES CAUSED BY CONTRACTOR'S OPERATIONS SHALL
 BE REPAIRED AT CONTRACTOR'S SOLE EXPENSE. CONTRACT TIME SHALL
 NOT BE EXTENDED DUE TO DELAYS CAUSED BY UTILITY COORDINATION.

NO.	REVISION	BY	DATE

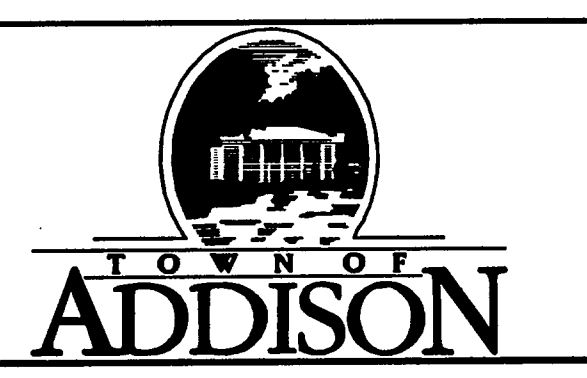


SCALE
 HORIZ
 1" = 20'
 VERT
 N/A
 DATE
 FEB 2004



TEAGUE NALL AND PERKINS
 ENGINEERS • SURVEYORS • CONSULTANTS

1100 Macon Street Fort Worth, Texas 76102 (817) 336-5773
 235 W. Hickory Street #100 Denton, Texas 76201 (940) 383-4177
 12160 N. Abrams Road #608 Dallas, Texas 75243 (214) 461-9867

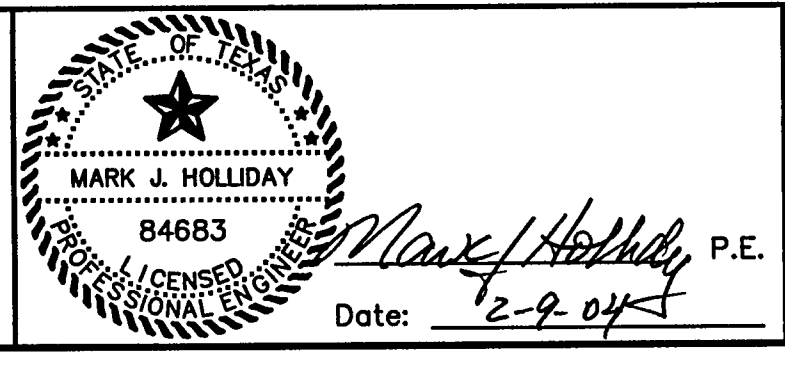

TOWN OF ADDISON, TEXAS
 TALISKER APARTMENTS
 WATER LINE IMPROVEMENTS

WATER LINE 'C' STA 5+00 TO 14+01.04

TNP PROJECT ADD03169
 SHEET 8 OF 11