


TOWN OF ADDISON, TEXAS

CONSTRUCTION PLANS FOR

TALISKER APARTMENTS WATER LINE IMPROVEMENTS

ADDISON, TEXAS

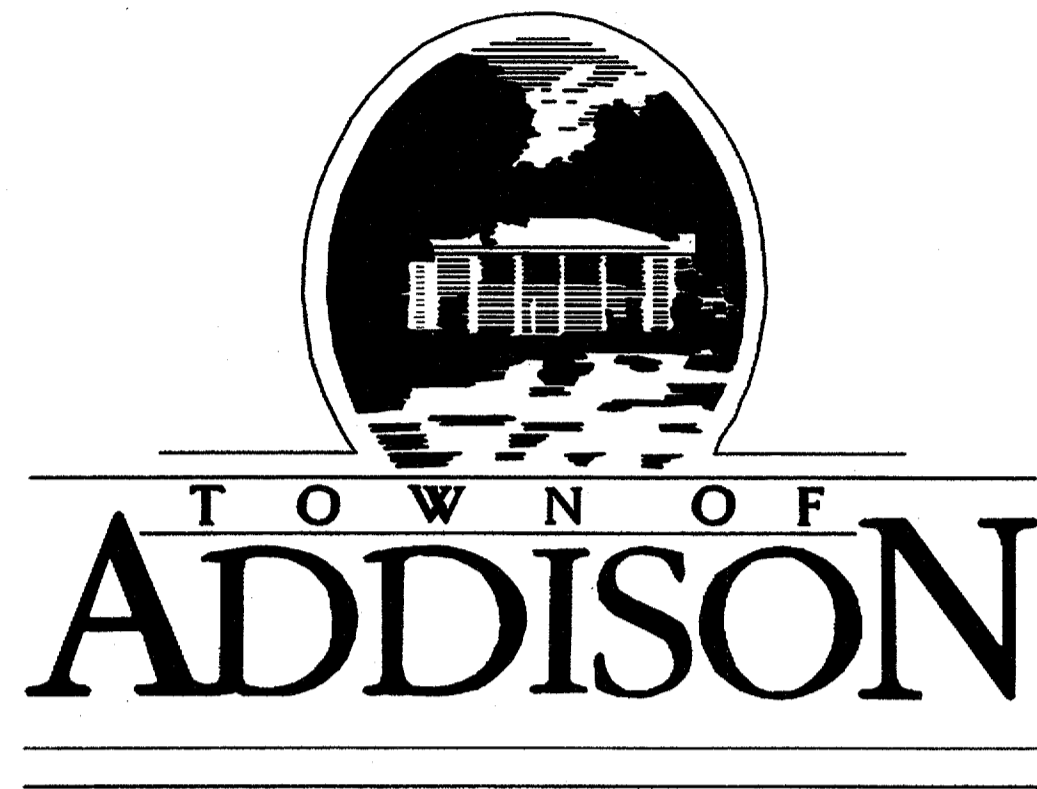

MAYOR
R. SCOTT WHEELER


MAYOR PRO-TEM
FREDRIC M. SILVER

DEPUTY MAYOR PRO-TEM
JOE CHOW

COUNCIL MEMBERS
DIANE MALLORY
GLYNDA TURNER
JIMMY NIEMANN
GREGORY S. HIRSCH

CITY MANAGER
RON WHITEHEAD


PUBLIC WORKS DIRECTOR
MICHAEL MURPHY, P.E.

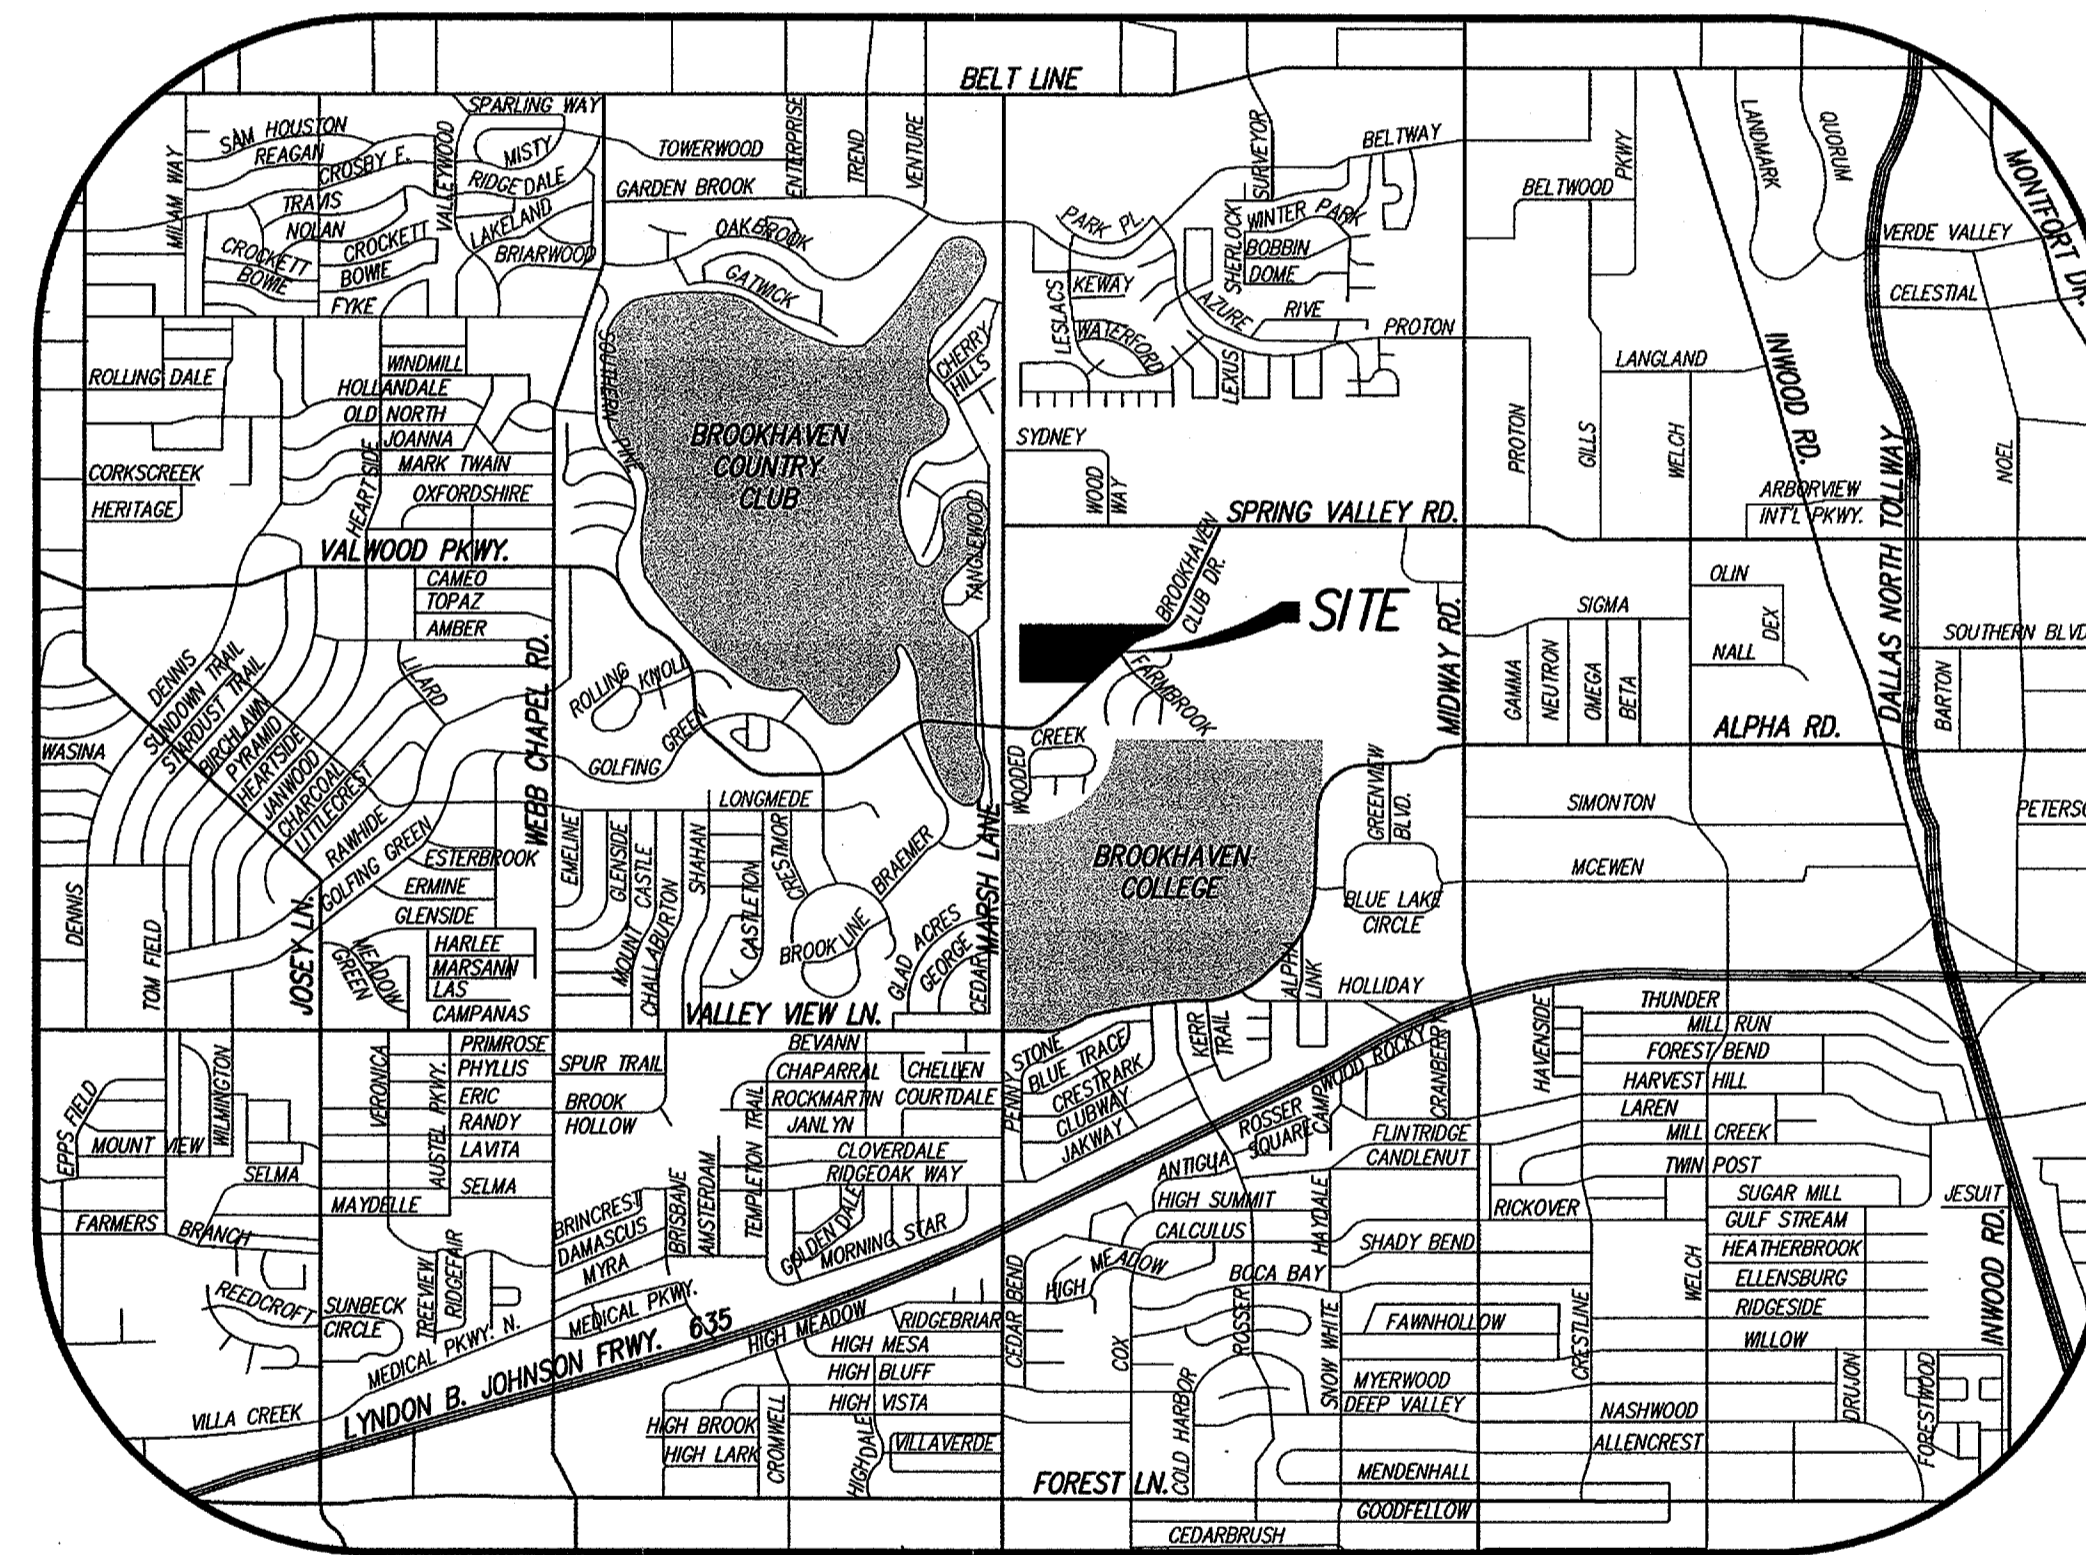

LOCATION MAP

FEBRUARY 2004

TTP INC.
TEAGUE NALL AND PERKINS
ENGINEERS • SURVEYORS • CONSULTANTS
WWW.TNP-ONLINE.COM

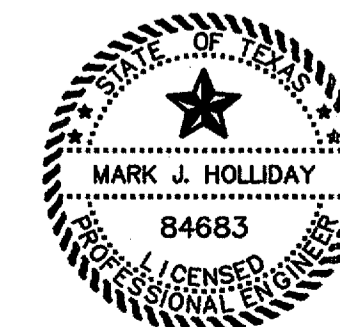

Date: 2-9-04

SHEET INDEX

SHEET NO.	DESCRIPTION
1	COVER SHEET
2	GENERAL NOTES & LEGEND
3	PROJECT LAYOUT SHEET
4	PROJECT CONSTRUCTION SEQUENCING
5	WATER LINE 'A' PLAN & PROFILE - STA 0+00 TO STA 1+78.64
6	WATER LINE 'B' PLAN - STA 0+00 TO STA 8+00
7	WATER LINE 'B' PLAN - STA 8+00 TO STA 10+79.34 WATER LINE 'C' PLAN - STA 0+00 TO STA 5+00
8	WATER LINE 'C' PLAN - STA 5+00 TO STA 14+01.04
9	WATER LINE 'D' PLAN - STA 0+00 TO STA 3+12.64 WATER LINE 'E' PLAN - STA 0+00 TO STA 4+14.64
10	MISCELLANEOUS DETAILS 1
11	MISCELLANEOUS DETAILS 2

RECORD DOCUMENTS

These Record Documents have been prepared based on information provided by others. The Design Professional has not verified the accuracy and/or completeness of this information and shall not be responsible for any errors or omissions which may be incorporated herein as a result.

ENGINEER

TEAGUE NALL AND PERKINS, INC.
12160 NORTH ABRAMS ROAD #508
DALLAS, TEXAS 75243
(214) 461-9867
CONTACT: MARK J. HOLLIDAY, P.E.

AI-3
Plan: A1.3
Region: Cont. Set.

Record Document (2 copies)

TNP PROJ #: ADD-03169

TALISKER APARTMENTS WATER LINE IMPROVEMENTS

TNP PROJ #: ADD-03169

AI-3

GENERAL NOTES

- TRAFFIC CONTROL & TRAFFIC CONTROL DEVICES USED DURING CONSTRUCTION SHALL BE IN ACCORDANCE WITH THE MOST RECENT VERSION OF THE TEXAS MANUAL ON UNIFORM TRAFFIC CONTROL DEVICES PUBLISHED BY THE TEXAS DEPARTMENT OF TRANSPORTATION. THE CONTRACTOR SHALL PROVIDE A TRAFFIC CONTROL PLAN TO THE CITY PRIOR TO CONSTRUCTION.
- CONTRACTOR SHALL USE EXTREME CAUTION IN LOCATING AND PROTECTING ALL UTILITY SERVICE LINES. WHERE A PROPOSED WATER LINE IS BEING CONSTRUCTED IN A LOCATION DIFFERENT FROM THE EXISTING MAIN, THE CONTRACTOR IS RESPONSIBLE FOR PERFORMING AN INSPECTION OF THE MAIN, TO BE REPLACED FOR THE PURPOSE OF IDENTIFYING AND LOCATING ALL ACTIVE SERVICE TAPS. THE CONTRACTOR SHOULD NOT ASSUME THAT ALL SERVICES TO BE RECONNECTED ARE SHOWN IN THE PLANS, OR SHOWN IN THE CORRECT LOCATION. THE COST FOR THE PRECONSTRUCTION INSPECTION IS SUBSIDIARY TO THE COST BID FOR THE INSTALLATION OF THE MAIN.
- THE CONTRACTOR SHALL MAINTAIN EXISTING WATER SERVICE THROUGHOUT CONSTRUCTION, USING TEMPORARY LINES AS NECESSARY. AFTER THE PROPOSED WATER MAIN HAS BEEN TESTED AND APPROVED BY THE ENGINEER, THE CONTRACTOR SHALL TRANSFER ALL EXISTING METERED SERVICES. NO SERVICE SHALL BE DISRUPTED FOR A PERIOD LONGER THAN SIX (6) HOURS. ALL SERVICES SHALL BE 2" UNLESS OTHERWISE NOTED ON THE PLANS.
- THE ENGINEER WILL PROVIDE ON THE PLANS HORIZONTAL CONTROL IN THE FORM OF GRID REFERENCE POINTS AND/OR BEARINGS AND DISTANCES AND VERTICAL CONTROL IN THE FORM OF BENCHMARKS. FROM THE CONTROLS PROVIDED ON THE PLANS, THE CONTRACTOR SHALL BE RESPONSIBLE FOR THE COMPLETE LAYOUT OF THE WORK AND FOR ESTABLISHING LINES AND ELEVATIONS AS NEEDED DURING CONSTRUCTION. THE CONTRACTOR SHALL FURNISH AT HIS OWN EXPENSE LABOR, INCLUDING THE SERVICES OF COMPETENT PERSONNEL, EQUIPMENT, INCLUDING ACCURATE SURVEYING INSTRUMENTS, STAKES, TEMPLATES, PLATFORMS, TOOLS, AND MATERIALS AS MAY BE REQUIRED FOR LAYING OUT ANY AND ALL PARTS OF THE WORK. ALL WORK ASSOCIATED WITH CONSTRUCTION LAYOUT SHALL BE SUBSIDIARY TO THE VARIOUS CONSTRUCTION PAY ITEMS IN THE CONTRACT.
- THE CONTRACTOR SHALL PROTECT AND SUPPORT ALL EXISTING UTILITY POLES, LIGHT POLES, SIGNALS, AND GUY WIRES. (NO SEPARATE PAY ITEM)
- THE CONTRACTOR SHALL PRESERVE ALL TREES, SHRUBS, SPRINKLER SYSTEMS, FENCES, MAIL BOXES AND OTHER PROPERTY OWNER IMPROVEMENTS NOT NOTED FOR REMOVAL. THE REMOVAL AND/OR REPLACEMENT OF THE SAID PROPERTY OWNER IMPROVEMENTS BY THE CONTRACTOR DEEMED NECESSARY FOR THE COMPLETION OF SAID PROJECT, INCLUDING BUT NOT LIMITED TO ASPHALT PAVEMENT, CONCRETE SIDEWALKS, CONCRETE CURB/GUTTER, SPEED BUMPS, LANDSCAPING, FENCES, STEPS, PARKING/FIRE LANE STRIPING SHALL BE REPLACED TO EQUAL OR BETTER CONDITION AS A NON-PAY ITEM UNLESS A PAY ITEM EXISTS FOR THE SPECIFIC IMPROVEMENT.
- THE CONTRACTOR SHALL GIVE THE TOWN, APARTMENT MANAGEMENT, AND BUSINESSES AFFECTED BY ANTICIPATED WATER OR SEWER SERVICE DISRUPTIONS AT LEAST FORTY-EIGHT (48) HOURS PRIOR NOTICE.
- DUCTILE IRON FITTINGS REQUIRED TO PROPERLY INSTALL THE PROPOSED WATER LINES ON THIS PROJECT SHALL BE MEASURED SEPARATELY, AND SHALL BE PAID FOR UNDER A SEPARATE PAY ITEM PER TON.
- ALL EXISTING FIRE HYDRANTS WITHIN THE LIMITS OF THE PROJECT, SHALL BE SALVAGED AND DELIVERED TO THE TOWN OF ADDISON PUBLIC WORKS YARD AT 16801 WESTGROVE BY THE CONTRACTOR. (NO SEPARATE PAY ITEM)
- ALL EXISTING WATER VALVES SHALL BE ABANDONED ON ALL KILLED WATER MAINS PER VALVE ABANDONMENT DETAIL. VALVE COVERS AND CAPS SHALL BE SALVAGED AND DELIVERED TO THE TOWN OF ADDISON PUBLIC WORKS YARD. WATER MAINS TO BE ABANDONED SHALL BE CUT, CAPPED, AND BLOCKED WITH CONCRETE AT ALL ENDS AND/OR FITTINGS.
- THE PROPOSED WATER MAIN SHALL HAVE A MINIMUM COVER OF FOUR (4') FEET MEASURED FROM THE TOP OF THE EXISTING CURB OR FROM THE TOP OF THE EXISTING GROUND TO THE TOP OF THE PROPOSED PIPE, WHICHEVER IS GREATER, OR AS DIRECTED BY THE ENGINEER.
- THE CONTRACTOR SHALL CENTER A FULL 20-FOOT LONG JOINT OF THE PROPOSED PIPE AT A STORM SEWER CROSSING IF THE PROPOSED PIPE MUST PASS UNDER THE STORM SEWER.
- WHERE PROPOSED OR EXISTING WATER LINES CROSS PROPOSED OR EXISTING SANITARY SEWER LINES: 1) THE SANITARY SEWER MAIN SHOULD BE EITHER CONCRETE ENCASED (20' CENTERED ON CROSSING); OR 2) A FULL 20-FOOT LONG JOINT OF PIPE SHALL BE CENTERED AT THE CROSSING AND A 2-FOOT VERTICAL CLEARANCE BE MAINTAINED. PAYMENT IS SUBSIDIARY TO COST OF PIPE.
- ALL DUCTILE IRON FITTINGS SHALL BE POLYWRAPPED.
- THE CONTRACTOR SHALL MAINTAIN FIRE EMERGENCY VEHICLE ACCESS TO FIRE HYDRANTS THROUGHOUT CONSTRUCTION.
- THE CONTRACTOR SHALL MAINTAIN AT LEAST ONE DRIVING LANE OPEN FOR INGRESS/EGRESS OF VEHICULAR TRAFFIC THROUGHOUT CONSTRUCTION. THE CONTRACTOR SHALL NOTIFY APARTMENT MANAGEMENT IF PARKING AREAS WILL BE INACCESSIBLE 48 HOURS PRIOR TO CONSTRUCTION.

- IRRIGATION AND SPRINKLER SYSTEM NOTES (SEE TOWN OF ADDISON SPECIFICATIONS):
 - THE CONTRACTOR SHALL HIRE A LICENSED IRRIGATOR AS A SUBCONTRACTOR TO OVERSEE ALL ACTIVITIES THAT IMPACT EXISTING, OR PROPOSED IRRIGATION SYSTEMS.
 - PRIOR TO DEMOLITION OR CONSTRUCTION ACTIVITIES, EXISTING IRRIGATION SYSTEMS SHALL BE TURNED ON. THE LOCATION OF THE HEADS, VALVES, AND PIPE SHALL BE MARKED WHERE DEMOLITION OR CONSTRUCTION WILL IMPACT THE SYSTEM. DEFICIENCIES IN THE SYSTEM SHALL BE NOTED AND REPORTED TO THE SYSTEM OWNER. A PHOTOGRAPHIC OR VIDEO RECORD SHALL BE MADE IF APPROPRIATE.
 - PIPING SHALL BE CUT, CAPPED, AND MARKED AT THE LIMITS OF CONSTRUCTION.
 - AT THE COMPLETION OF CONSTRUCTION, THE LICENSED IRRIGATOR SHALL RESTORE AND TEST THE IRRIGATION SYSTEMS FOR PROPER FUNCTION. THE TESTS SHALL BE CONDUCTED IN THE PRESENCE OF THE TOWN OF ADDISON'S PUBLIC WORKS INSPECTOR, AND THE SYSTEM OWNERS. (NO SEPARATE PAY)
- CONTRACTOR SHALL CONFORM WITH THE "NORTH CENTRAL TEXAS STANDARD SPECIFICATIONS FOR PUBLIC WORKS CONSTRUCTION" (NCTSSPWC) AND ALL TOWN OF ADDISON STANDARD CONSTRUCTION DETAILS.
- ALL BENDS AND FIRE HYDRANTS SHALL INCLUDE RESTRAINED TYPE FITTINGS WITH RETAINER GLANDS IN ADDITION TO CONCRETE THRUST BLOCKING. ALL FIRE HYDRANTS SHALL BE INSTALLED PER STANDARD DETAILS. CONCRETE THRUST BLOCKING MAY BE ELIMINATED AT THE OWNER'S DISCRETION.
- WATER MAINS SHALL BE AWWA C-909, CL 150.
- ALL STREET AND DRIVEWAY PAVEMENT SHALL BE 8-INCH, 4000 PSI CONCRETE WITH #3 BARS ON 18-INCH (18") CENTERS BOTH WAYS. ALL CONSTRUCTION TO BE PER TOWN STANDARDS.
- ALL PORTIONS OF EXISTING PAVEMENT THAT ARE TO REMAIN SHALL BE PROTECTED BY THE CONTRACTOR. REMOVAL OF ANY PAVEMENT THAT IS NOT SHOWN TO BE REMOVED SHALL BE REPLACED BY THE CONTRACTOR AT NO ADDITIONAL COST TO THE TOWN OF ADDISON.
- ALL WATER SERVICE LINES THAT EXTEND ACROSS PUBLIC STREETS SHALL BE BORED UNDERNEATH THE EXISTING PAVEMENT UNLESS OTHERWISE NOTED.
- THE CONTRACTOR SHALL CONNECT ALL NEW SERVICE LINES TO THE NEW WATER METERS. (NO SEPARATE PAY ITEM)
- THE CONTRACTOR SHALL INSTALL NEW WATER METERS AND BOXES ACCORDING TO THE TOWN OF ADDISON SPECIFICATIONS. ALL METERS SHALL BE EQUIPPED WITH ELECTRONIC ENCODER REGISTERS, PROGRAMMED TO READ IN THOUSAND GALLON INCREMENTS, FOR CONNECTION TO TOUCH PAD. WATER METERS SHALL BE 5/8", 1", 1.5", OR 2". ALL EXISTING WATER METERS SHALL BE SALVAGED AND DELIVERED TO THE TOWN OF ADDISON PUBLIC WORKS YARD. COORDINATE METER CHANGE-OUT WITH THE TOWN OF ADDISON PUBLIC WORKS DEPARTMENT.
- AN APPROVED BACKFLOW PREVENTION ASSEMBLY SHALL BE INSTALLED, BY A LICENSED PLUMBER WITH ALL WATER SERVICES AFTER THE METER, WITH A BRASS OR COPPER NIPPLE BETWEEN THE METER AND THE ASSEMBLY OF SUFFICIENT LENGTH TO ALLOW PLACEMENT IN SEPARATE BOXES. IT SHALL BE THE RESPONSIBILITY OF THE CONTRACTOR TO HAVE THE ASSEMBLY TESTED UPON INSTALLATION BY A CERTIFIED TESTER, REGISTERED WITH THE TOWN OF ADDISON. THE ORIGINAL TEST RESULTS SHALL BE PROVIDED TO THE TOWN OF ADDISON UTILITY DIVISION PRIOR TO FINAL CONTINUOUS CONNECTION TO THE TOWN'S WATER SUPPLY. ALL BACKFLOW PREVENTION ASSEMBLIES SHALL BE USC CERTIFIED. INSTALLATION OF THE BPA SHALL BE SUBSIDIARY TO THE METER. THE APPROPRIATE BPA WILL BE DETERMINED BY THE TOWN OF ADDISON UTILITY DIVISION USING THE MOST CURRENT EDITION OF THE MANUAL OF CROSS-CONNECTION CONTROL AS PUBLISHED BY USFPCOCHR AS A GUIDELINE. FINAL DETERMINATION RESTS WITH THE TOWN OF ADDISON. ALL BPAs SHALL BE INSTALLED ACCORDING TO THE MOST RECENT EDITION OF THE TOWN OF ADDISON'S STANDARD OPERATING PROCEDURES MANUAL.
- ALL PAVEMENT FOR REMOVAL WITHIN THE PROJECT LIMITS SHALL BE SAWCUT. ALL SAWCUTS SHALL BE FULL DEPTH. (NO SEPARATE PAY ITEM)
- BEFORE THE NEWLY CONSTRUCTED WATER MAIN IS PERMITTED TO BE PLACED INTO SERVICE, IT SHALL BE PRESSURE TESTED, DISINFECTED AND TESTED FOR BACTERIA AT THE CONTRACTOR'S EXPENSE. TESTING IS TO BE ACCOMPLISHED BY A TOWN OF ADDISON APPROVED LAB. NO ADDITIONAL COMPENSATION WILL BE ALLOWED FOR DESINFECTATION AND TESTING.
- STAGING AND STORAGE FOR THIS PROJECT SHALL BE APPROVED BY THE TOWN OF ADDISON PRIOR TO ANY CONSTRUCTION ACTIVITY.
- ALL NEW DUMMY AND EXPANSION JOINTS SHALL MATCH EXISTING JOINT LOCATIONS, WHICH SHALL BE RECORDED BY VIDEO, SKETCH, PHOTO ETC. PRIOR TO DEMOLITION.
- CONTRACTOR SHALL SUPPLY RECORD DRAWINGS TO THE TOWN OF ADDISON, BASED UPON MARKUP PLANS PROVIDED BY THE TOWN INSPECTOR AND CONTRACTOR.

- LOCATIONS OF EXISTING UTILITIES SHOWN ON THESE PLANS ARE APPROXIMATE BASED ON INFORMATION PROVIDED BY THE OWNERS OF THE UTILITIES AND FIELD SURVEYS. THERE MAY ALSO BE EXISTING UTILITIES THAT ARE NOT SHOWN. THE OWNER AND ENGINEER SHALL NOT BE RESPONSIBLE FOR THE ACCURACY OF THIS INFORMATION. CONTRACTOR SHALL LOCATE ALL UTILITIES PRIOR TO BEGINNING CONSTRUCTION. IF A CONFLICT IS DISCOVERED BETWEEN EXISTING UTILITIES AND PROPOSED IMPROVEMENTS, CONTRACTOR SHALL NOTIFY ENGINEER IMMEDIATELY. IT SHALL BE CONTRACTOR'S SOLE RESPONSIBILITY TO COORDINATE WITH UTILITY COMPANY FOR ANY NECESSARY RELOCATION OF FACILITIES AND NO SEPARATE PAYMENT SHALL BE MADE. ADDITIONALLY, CONTRACTOR SHALL NOT BE COMPENSATED FOR DELAYS OR REMOBILIZATION DUE TO UTILITY COORDINATION. ANY DAMAGE TO EXISTING UTILITIES CAUSED BY CONTRACTOR'S OPERATIONS SHALL BE REPAIRED AT CONTRACTOR'S SOLE EXPENSE. CONTRACT TIME SHALL NOT BE EXTENDED DUE TO DELAYS CAUSED BY UTILITY COORDINATION. RESPONSIBILITY TO NOTIFY THE OWNERS TO ARRANGE FOR EXACT LOCATIONS AT LEAST 48 HOURS PRIOR TO BEGINNING CONSTRUCTION.

UTILITY	TELEPHONE
ONCOR	(214) 875-2256
WORLDCOM/MCI	(972) 656-5519
TELE-CABLE	(214) 578-7573
DIG-TESS	1-800-344-8377
SBC	(214) 920-0189
AT&T	(972) 907-4073
TOWN OF ADDISON (DAVE WILDE)	(972) 450-2871
- ANY CONSTRUCTION ITEM OR REQUIRED WORK SHOWN ON THESE PLANS FOR WHICH THERE IS NO SPECIFIC BID ITEM IN THE PROPOSAL SHALL BE CONSIDERED SUBSIDIARY TO THE OTHER BID ITEMS AND NO SEPARATE PAYMENT SHALL BE MADE.
- CONTRACTOR SHALL PREPARE PHOTOGRAPHS AND A VIDEO OF THE PROJECT SITE DOCUMENTING SITE CONDITIONS PRIOR TO COMMENCEMENT OF CONSTRUCTION. VIDEO SHALL CLEARLY SHOW ALL PUBLIC AND PRIVATE IMPROVEMENTS WITHIN AND ADJACENT TO THE PROJECT LIMITS INCLUDING, BUT NOT LIMITED TO, DRIVEWAYS, FENCES, STRUCTURES, LANDSCAPING, POOLS, ABOVE GROUND UTILITIES, RETAINING WALLS, ETC. NO SEPARATE PAYMENT SHALL BE MADE FOR PREPARATION OF PHOTOGRAPHS AND VIDEO. VIDEO TO BE APPROVED BY TOWN.
- THE CONTRACTOR SHALL BE REQUIRED TO SUBMIT A DETAILED CONSTRUCTION SCHEDULE AT THE PRECONSTRUCTION CONFERENCE FOR EACH PHASE OF THE PROJECT.
- ALL PEDESTRIAN FACILITIES SHALL CONFORM TO CURRENT AMERICAN'S WITH DISABILITIES ACT (ADA) REQUIREMENTS.
- SUBGRADE SHALL BE COMPACTED TO 95% STD PROCTOR DENSITY AND APPROVED BY TOWN'S INDEPENDENT LAB BEFORE PROCEEDING WITH CONSTRUCTION. (PROVIDED BY CONTRACTOR AT NO SEPARATE PAY)
- ALL CONCRETE FORMS SHALL BE APPROVED BY TOWN INSPECTOR PRIOR TO POURING.
- WORKING HOURS SHALL BE DETERMINED BY THE TOWN OF ADDISON AND PROPERTY OWNER MANAGEMENT.
- SPRINKLING FOR DUST CONTROL SHALL CONSIST OF THE AUTHORIZED APPLICATION OF WATER AS DIRECTED BY THE TOWN OF ADDISON. WATER SHALL BE FURNISHED BY THE CONTRACTOR AND SHALL BE CLEAN, FREE FROM INDUSTRIAL WASTE AND OTHER OBJECTIONABLE MATTER. THE CONTRACTOR SHALL FURNISH AND OPERATE A SPRINKLER EQUIPPED WITH POSITIVE AND RAPIDLY WORKING CUTOFF VALVES AND APPROVED SPRAY BARS, WHICH SHALL INSURE THE DISTRIBUTION OF WATER IN A UNIFORM AND CONTROLLABLE RATE OF APPLICATION. IT SHALL BE THE CONTRACTOR'S CONTINUOUS RESPONSIBILITY AT ALL TIMES INCLUDING NIGHTS, HOLIDAYS, WEEKENDS, ETC., UNTIL ACCEPTANCE OF THE PROJECT BY THE OWNER, TO MAINTAIN THE PROJECT FREE OF DUST IN A MANNER WHICH SHALL CAUSE THE LEAST INCONVENIENCE TO THE PUBLIC. (NO SEPARATE PAY)

SYMBOL LEGEND

EXISTING	PROPOSED

T/C = TOP OF CURB ELEV.
 F/L = FLOW LINE ELEV.
 MH = MANHOLE
 CO = CLEANOUT

RECORD DOCUMENTS
 These Record Documents have been prepared based on information provided by others. The Design Professional has not verified the accuracy and/or completeness of this information and shall not be responsible for any errors or omissions which may be incorporated herein as a result.

NO.	REVISION	BY	DATE		SCALE HORIZ N/A VERT N/A DATE FEB 2004		TEAGUE NALL AND PERKINS ENGINEERS • SURVEYORS • CONSULTANTS 1100 Macon Street Fort Worth, Texas 76102 (817) 336-5773 235 W. Hickory Street #100 Denton, Texas 76201 (940) 383-4177 12160 N. Abrams Road #508 Dallas, Texas 75243 (214) 461-9867		TOWN OF ADDISON, TEXAS TALISKER APARTMENTS WATER LINE IMPROVEMENTS GENERAL NOTES	TNP PROJECT ADD03169
										SHEET 2 OF 11

END 8" WL 'B' - STA 10+79.34
 BEGIN 8" WL 'C' - STA 0+00
 N 5228.44 E 4536.94

END 8" WL 'D' - STA 3+12.64
 CONNECT TO EXIST 8" WL
 N 5724.32 E 4808.63

END 8" WL 'E' - STA 4+14.64
 8" WL 'D' - STA 1+78.65
 N 5711.03 E 4930.53

BEGIN 8" WL 'D' - STA 0+00
 8" WL 'C' - STA 3+93.45
 N 5632.38 E 4830.38

PROP 8" C909 CL150
 WATER LINE 'E'

PROP 8" C909 CL150
 WATER LINE 'B'

BEGIN 8" WL 'E' - STA 0+00
 8" WL 'C' - STA 6+15.49
 N 5507.84 E 5141.79

PROP 8" C909 CL150
 WATER LINE 'C'

PROPOSED 20"
 UTILITY ESMT

PROP 8" C909 CL150
 WATER LINE 'B'

PROP 8" C909 CL150
 WATER LINE 'C'

14110 Marsh
 Brookhaven Village Shopping Center
 Mustang Brookhaven S/C, Ltd.
 Volume 94129 Page 111

20' U.E. (Plat. 88225/4789)

3925 Brookhaven Club
 A-520 Pg. 822 Tr. 45
 Devdos Limited Partnership
 Volume 2002185 Page 4334

Access & Utility Easement (75245/651)

Access & Utility Easement (75245/651)

PROP 8" C909 CL150
 WATER LINE 'C'



PROP 8" C909 CL150
 WATER LINE 'B'

END WL 'A' - STA 1+78.64
 BEGIN WL 'B' - STA 0+00
 END WL 'C' - STA 14+01.04
 N 4935.34 E 5046.58

PROP 12" C909 CL150
 WITH 24" CASING
 WATER LINE 'A'

BEGIN 12" WL 'A' - STA 0+00
 CONNECT TO EXIST 8" WL
 N 4818.96 E 5182.11

45' Water Easmt. (Plat. 77233/443)

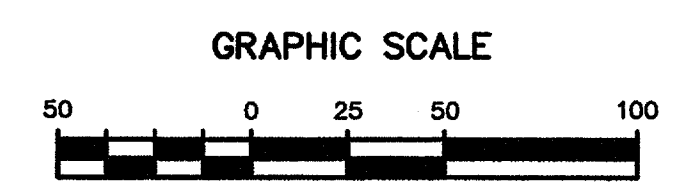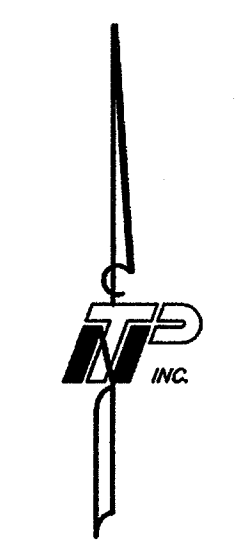


BENCHMARK
 BM :
 CUT CROSS SET IN THE TOP AT THE SOUTHEAST SIDEWALK
 INTERSECTION ON THE EAST SIDE OF THE FIRE LANE OPPOSITE
 APARTMENT BUILDING #24
 COORDINATES: N 5259.29 E 4562.25 ELEVATION: 570.84

4015 Brookhaven Club
 The Pier
 75 Pier No. 2, L.P.
 Volume 94147 Page 195

CAUTION!!
 EXISTING UTILITIES
 LOCATIONS OF EXISTING UTILITIES SHOWN ON THESE PLANS ARE APPROXIMATE
 BASED ON INFORMATION PROVIDED BY THE OWNERS OF THE UTILITIES AND FIELD
 SURVEYS. THERE MAY ALSO BE EXISTING UTILITIES THAT ARE NOT SHOWN. THE
 OWNER AND ENGINEER SHALL NOT BE RESPONSIBLE FOR THE ACCURACY OF THIS
 INFORMATION. CONTRACTOR SHALL LOCATE ALL UTILITIES PRIOR TO BEGINNING
 CONSTRUCTION. IF A CONFLICT IS DISCOVERED BETWEEN EXISTING UTILITIES AND
 PROPOSED IMPROVEMENTS, CONTRACTOR SHALL NOTIFY ENGINEER IMMEDIATELY.
 IT SHALL BE CONTRACTOR'S SOLE RESPONSIBILITY TO COORDINATE WITH UTILITY
 COMPANY FOR ANY NECESSARY RELOCATION OF FACILITIES AND NO SEPARATE
 PAYMENT SHALL BE MADE. ADDITIONALLY, CONTRACTOR SHALL NOT BE
 COMPENSATED FOR DELAYS OR REMOVALIZATION DUE TO UTILITY COORDINATION.
 ANY DAMAGE TO EXISTING UTILITIES CAUSED BY CONTRACTOR'S OPERATIONS SHALL
 BE REPAIRED AT CONTRACTOR'S SOLE EXPENSE. CONTRACT TIME SHALL
 NOT BE EXTENDED DUE TO DELAYS CAUSED BY UTILITY COORDINATION.

RECORD DOCUMENT
 These Record Documents have been prepared
 on information provided by others. The
 Professional has not verified the accuracy and
 completeness of this information and shall not be
 responsible for any errors or omissions which may be
 incorporated herein as a result.


NO.	REVISION	BY	DATE

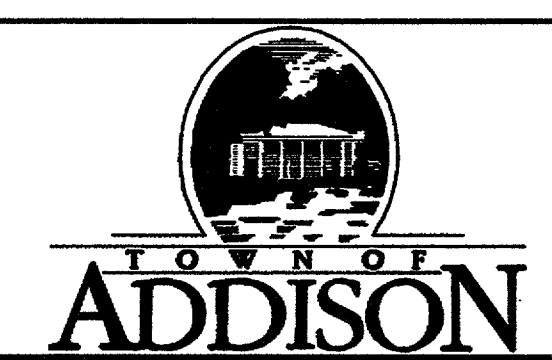

SCALE
 HORIZ
 1" = 50'
 VERT
 N/A
 DATE
 FEB 2004




TEAGUE NALL AND PERKINS
 ENGINEERS • SURVEYORS • CONSULTANTS
 1100 Macon Street Fort Worth, Texas 76102 (817) 336-5773
 235 W. Hickory Street #100 Denton, Texas 76201 (940) 383-4177
 12160 N. Abrams Road #508 Dallas, Texas 75243 (214) 461-9867

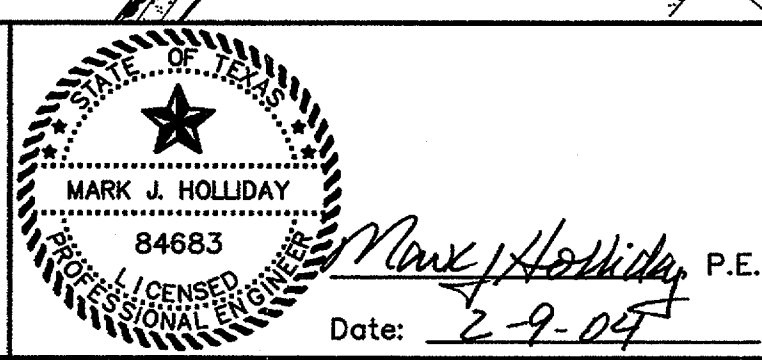


TOWN OF ADDISON, TEXAS
 TALISKER APARTMENTS
WATER LINE IMPROVEMENTS
 PROJECT LAYOUT

TNP PROJECT
 ADD03169
 SHEET
3
 OF
 11

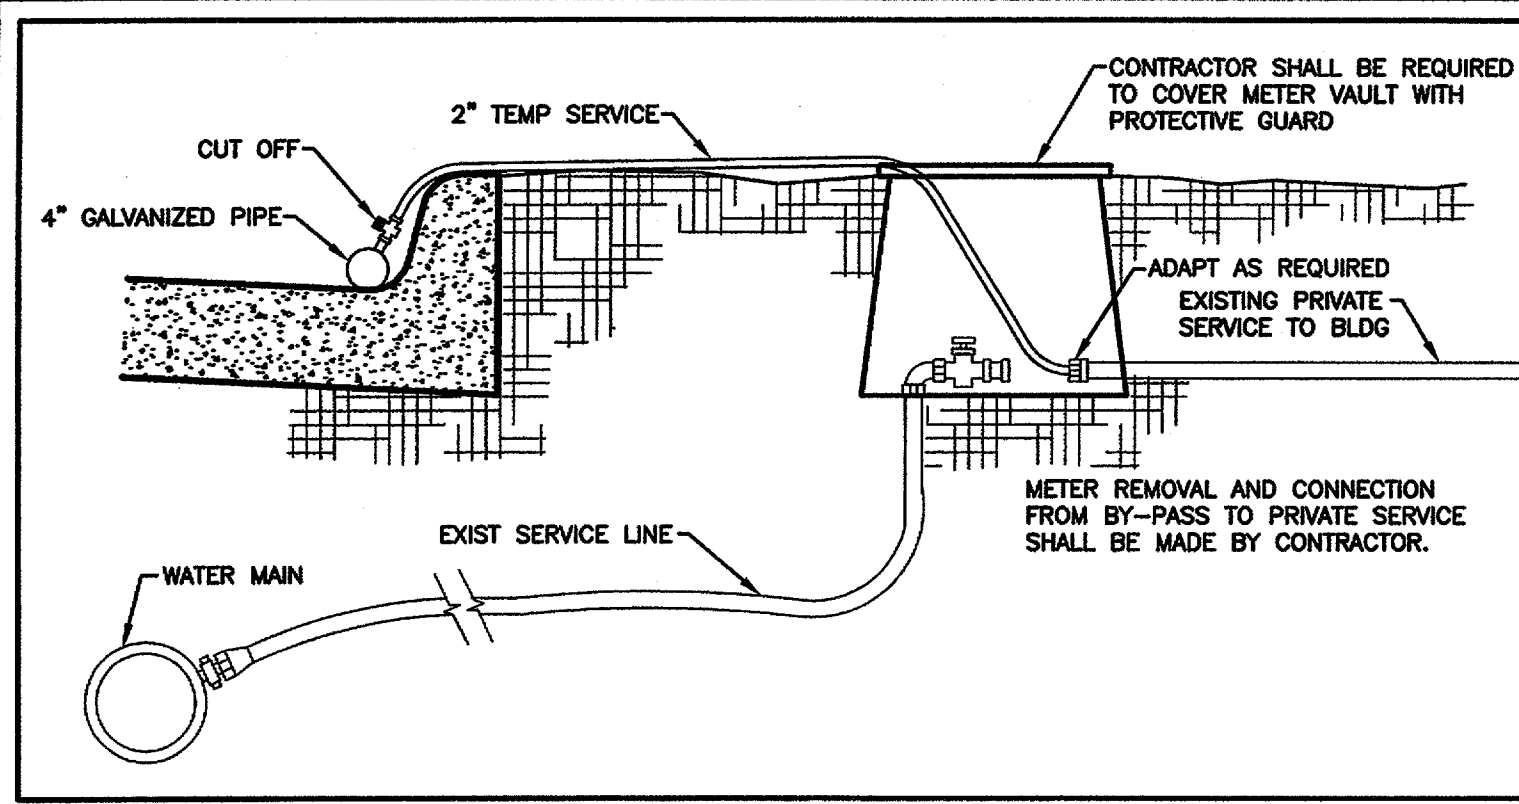


TEMPORARY SERVICE CONNECTION DETAIL
N.T.S.

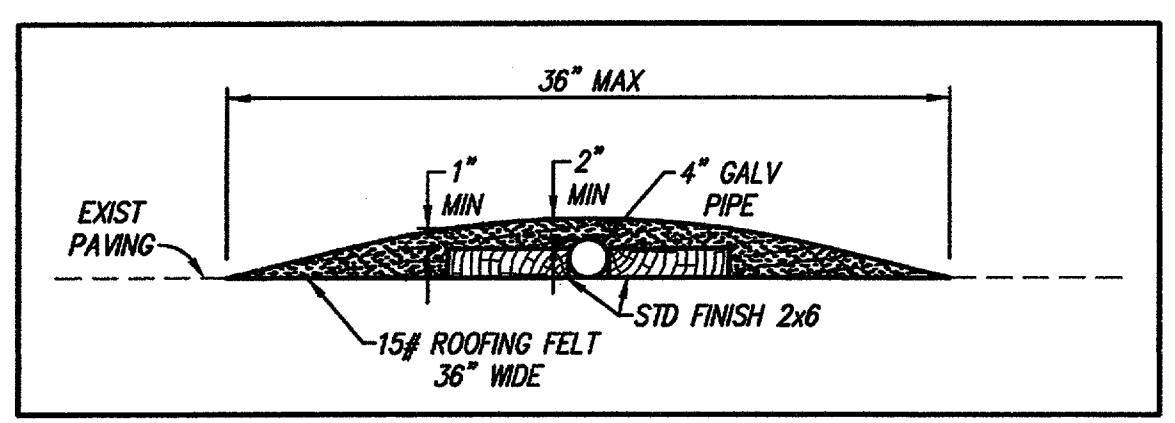

TEMPORARY WATER SERVICE DETAIL
(FOR TRAFFIC CROSSING LOCATIONS)
N.T.S.

GENERAL NOTES

1. TRAFFIC CONTROL & TRAFFIC CONTROL DEVICES USED DURING CONSTRUCTION SHALL BE IN ACCORDANCE WITH THE MOST RECENT VERSION OF THE TEXAS MANUAL ON UNIFORM TRAFFIC CONTROL DEVICES PUBLISHED BY THE TEXAS DEPARTMENT OF TRANSPORTATION. THE CONTRACTOR SHALL PROVIDE A TRAFFIC CONTROL PLAN TO THE CITY PRIOR TO CONSTRUCTION.
2. THE CONTRACTOR SHALL MAINTAIN AT LEAST ONE DRIVING LANE OPEN FOR INGRESS/EGRESS OF VEHICULAR TRAFFIC THROUGHOUT CONSTRUCTION. THE CONTRACTOR SHALL NOTIFY APARTMENT MANAGEMENT IF PARKING AREAS WILL BE INACCESSIBLE 48 HOURS PRIOR TO CONSTRUCTION.
3. CONTRACTOR SHALL USE EXTREME CAUTION IN LOCATING AND PROTECTING ALL UTILITY SERVICE LINES. WHERE A PROPOSED WATER LINE IS BEING CONSTRUCTED IN A LOCATION DIFFERENT FROM THE EXISTING MAIN. THE CONTRACTOR IS RESPONSIBLE FOR PERFORMING AN INSPECTION OF THE MAIN, TO BE REPLACED FOR THE PURPOSE OF IDENTIFYING AND LOCATING ALL ACTIVE SERVICE TAPS. THE CONTRACTOR SHOULD NOT ASSUME THAT ALL SERVICES TO BE RECONNECTED ARE SHOWN IN THE PLANS, OR SHOWN IN THE CORRECT LOCATION. THE COST FOR THE PRECONSTRUCTION INSPECTION IS SUBSIDIARY TO THE COST BID FOR THE INSTALLATION OF THE MAIN.
4. THE CONTRACTOR SHALL MAINTAIN EXISTING WATER SERVICE THROUGHOUT CONSTRUCTION, USING TEMPORARY LINES AS NECESSARY. AFTER THE PROPOSED WATER MAIN HAS BEEN TESTED AND APPROVED BY THE ENGINEER, THE CONTRACTOR SHALL TRANSFER ALL EXISTING METERED SERVICES. NO SERVICE SHALL BE DISRUPTED FOR A PERIOD LONGER THAN SIX (6) HOURS. ALL SERVICES SHALL BE 2" UNLESS OTHERWISE NOTED ON THE PLANS.
5. THE CONTRACTOR SHALL GIVE THE TOWN, APARTMENT MANAGEMENT, AND BUSINESSES AFFECTED BY ANTICIPATED WATER OR SEWER SERVICE DISRUPTIONS AT LEAST FORTY-EIGHT (48) HOURS PRIOR NOTICE.

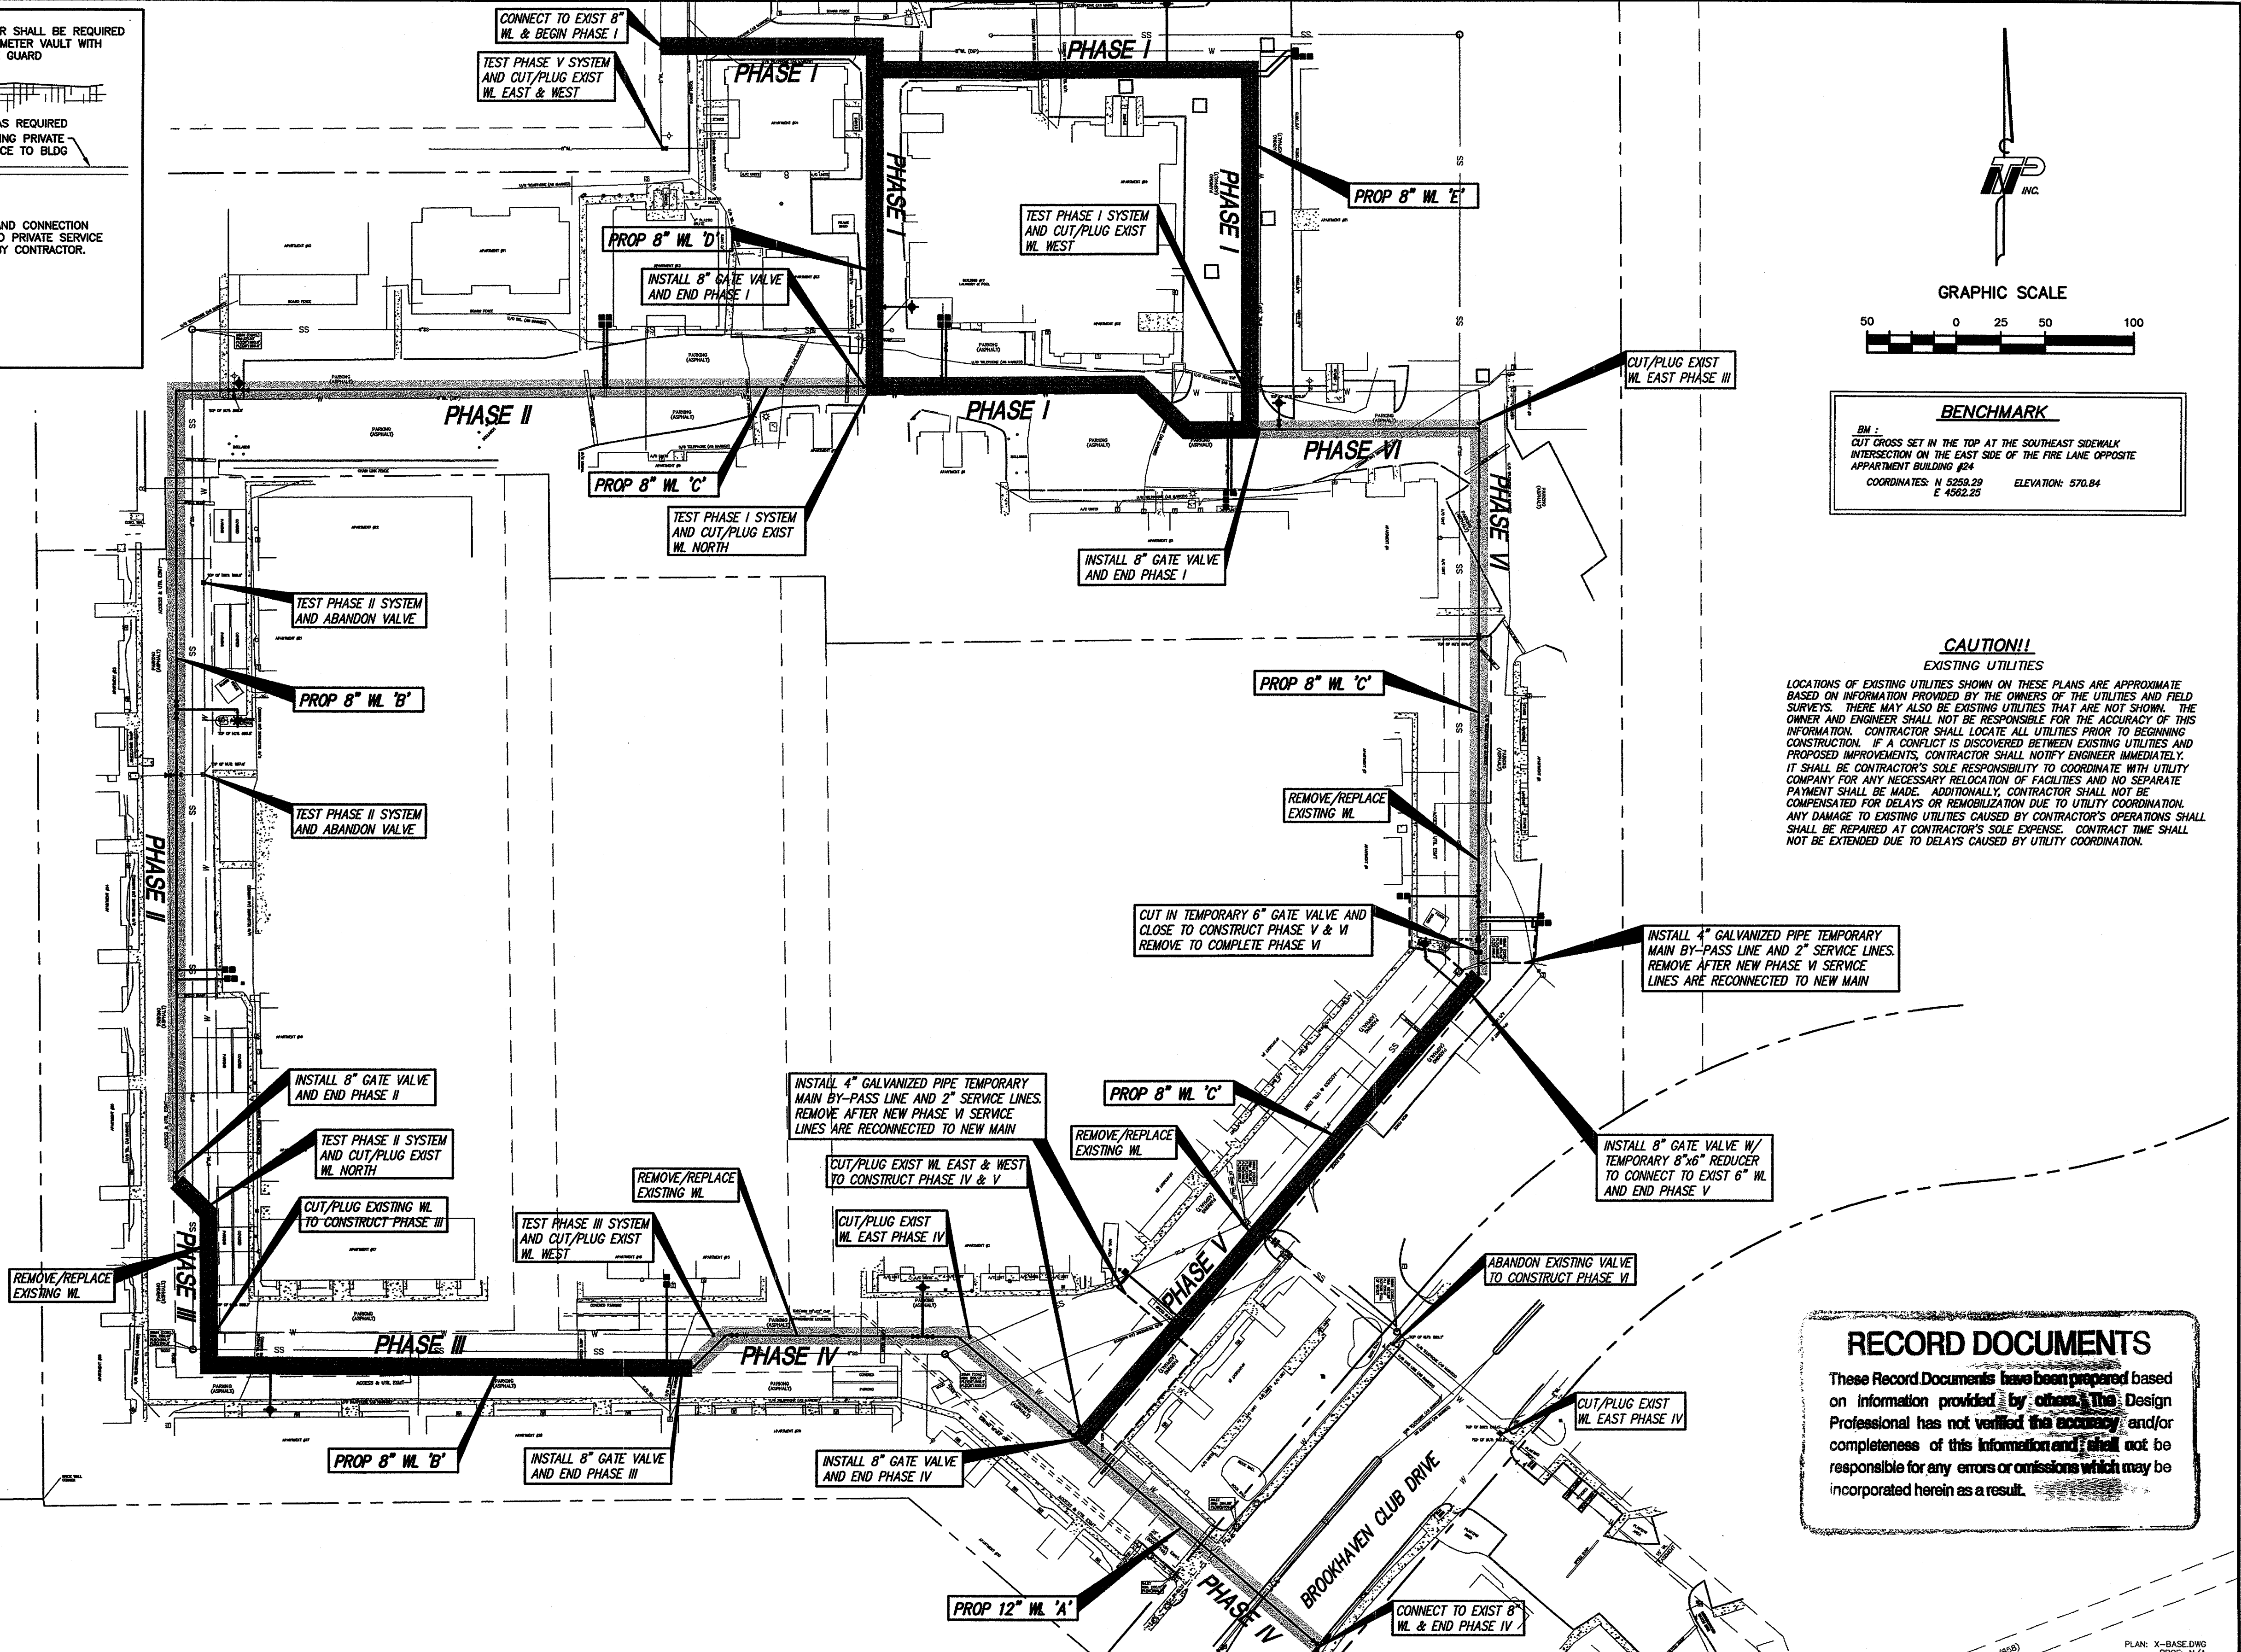

INC.

GRAPHIC SCALE
50 0 25 50 100

BENCHMARK

BM 1:
CUT CROSS SET IN THE TOP AT THE SOUTHEAST SIDEWALK INTERSECTION ON THE EAST SIDE OF THE FIRE LANE OPPOSITE APARTMENT BUILDING #24
COORDINATES: N 5259.29 E 4582.25 ELEVATION: 570.84


CAUTION!!
EXISTING UTILITIES

LOCATIONS OF EXISTING UTILITIES SHOWN ON THESE PLANS ARE APPROXIMATE BASED ON INFORMATION PROVIDED BY THE OWNERS OF THE UTILITIES AND FIELD SURVEYS. THERE MAY ALSO BE EXISTING UTILITIES THAT ARE NOT SHOWN. THE OWNER AND ENGINEER SHALL NOT BE RESPONSIBLE FOR THE ACCURACY OF THIS INFORMATION. CONTRACTOR SHALL LOCATE ALL UTILITIES PRIOR TO BEGINNING CONSTRUCTION. IF A CONFLICT IS DISCOVERED BETWEEN EXISTING UTILITIES AND PROPOSED IMPROVEMENTS, CONTRACTOR SHALL NOTIFY ENGINEER IMMEDIATELY. IT SHALL BE CONTRACTOR'S SOLE RESPONSIBILITY TO COORDINATE WITH UTILITY COMPANY FOR ANY NECESSARY RELOCATION OF FACILITIES AND NO SEPARATE PAYMENT SHALL BE MADE. ADDITIONALLY, CONTRACTOR SHALL NOT BE COMPENSATED FOR DELAYS OR REWORK DUE TO UTILITY COORDINATION. ANY DAMAGE TO EXISTING UTILITIES CAUSED BY CONTRACTOR'S OPERATIONS SHALL BE REPAIRED AT CONTRACTOR'S SOLE EXPENSE. CONTRACT TIME SHALL NOT BE EXTENDED DUE TO DELAYS CAUSED BY UTILITY COORDINATION.

RECORD DOCUMENTS

These Record Documents have been prepared based on information provided by others. The Design Professional has not verified the accuracy and/or completeness of this information and shall not be responsible for any errors or omissions which may be incorporated herein as a result.

NO.	REVISION	BY	DATE

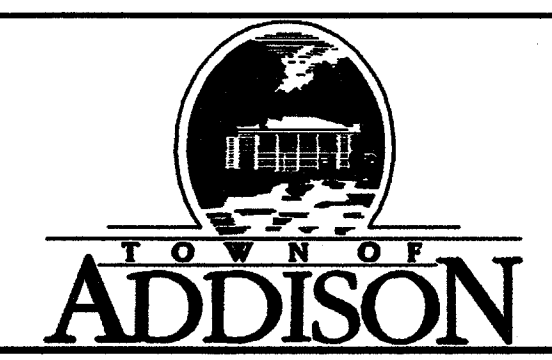


SCALE
HORIZ
1" = 50'
VERT
N/A
DATE
FEB 2004





TEAGUE NALL AND PERKINS
ENGINEERS • SURVEYORS • CONSULTANTS

1100 Macon Street Fort Worth, Texas 76102 (817) 336-5773
235 W. Hickory Street #100 Denton, Texas 76201 (940) 383-4177
10012 N. Abrams Road #508 Dallas, Texas 75243 (214) 461-9867

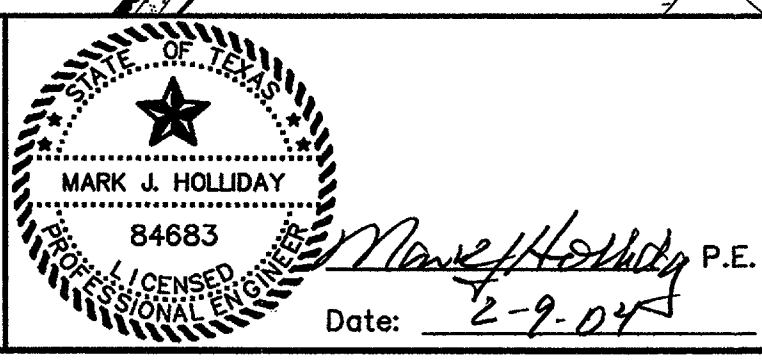

TOWN OF ADDISON, TEXAS
TALISKER APARTMENTS
WATER LINE IMPROVEMENTS
PROJECT CONSTRUCTION SEQUENCING

TNP PROJECT
ADD03169
SHEET
4
OF
11

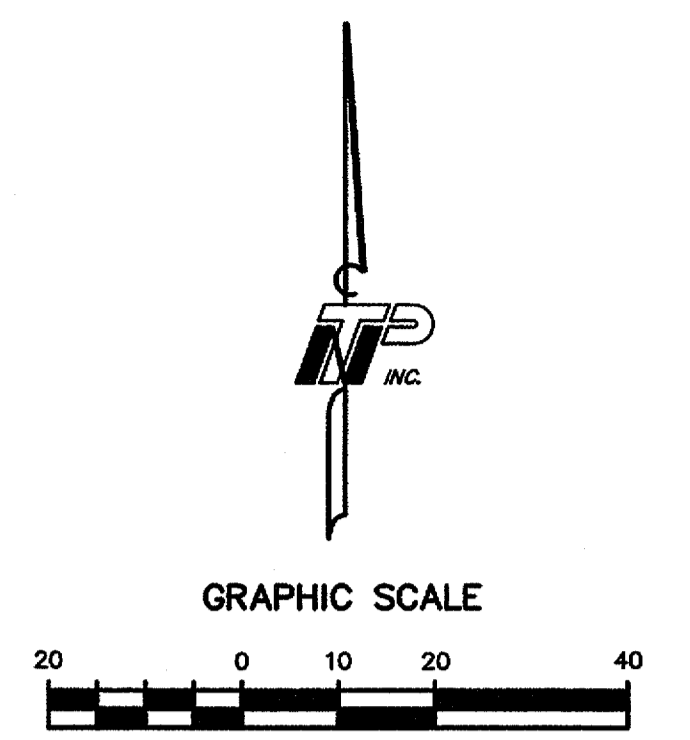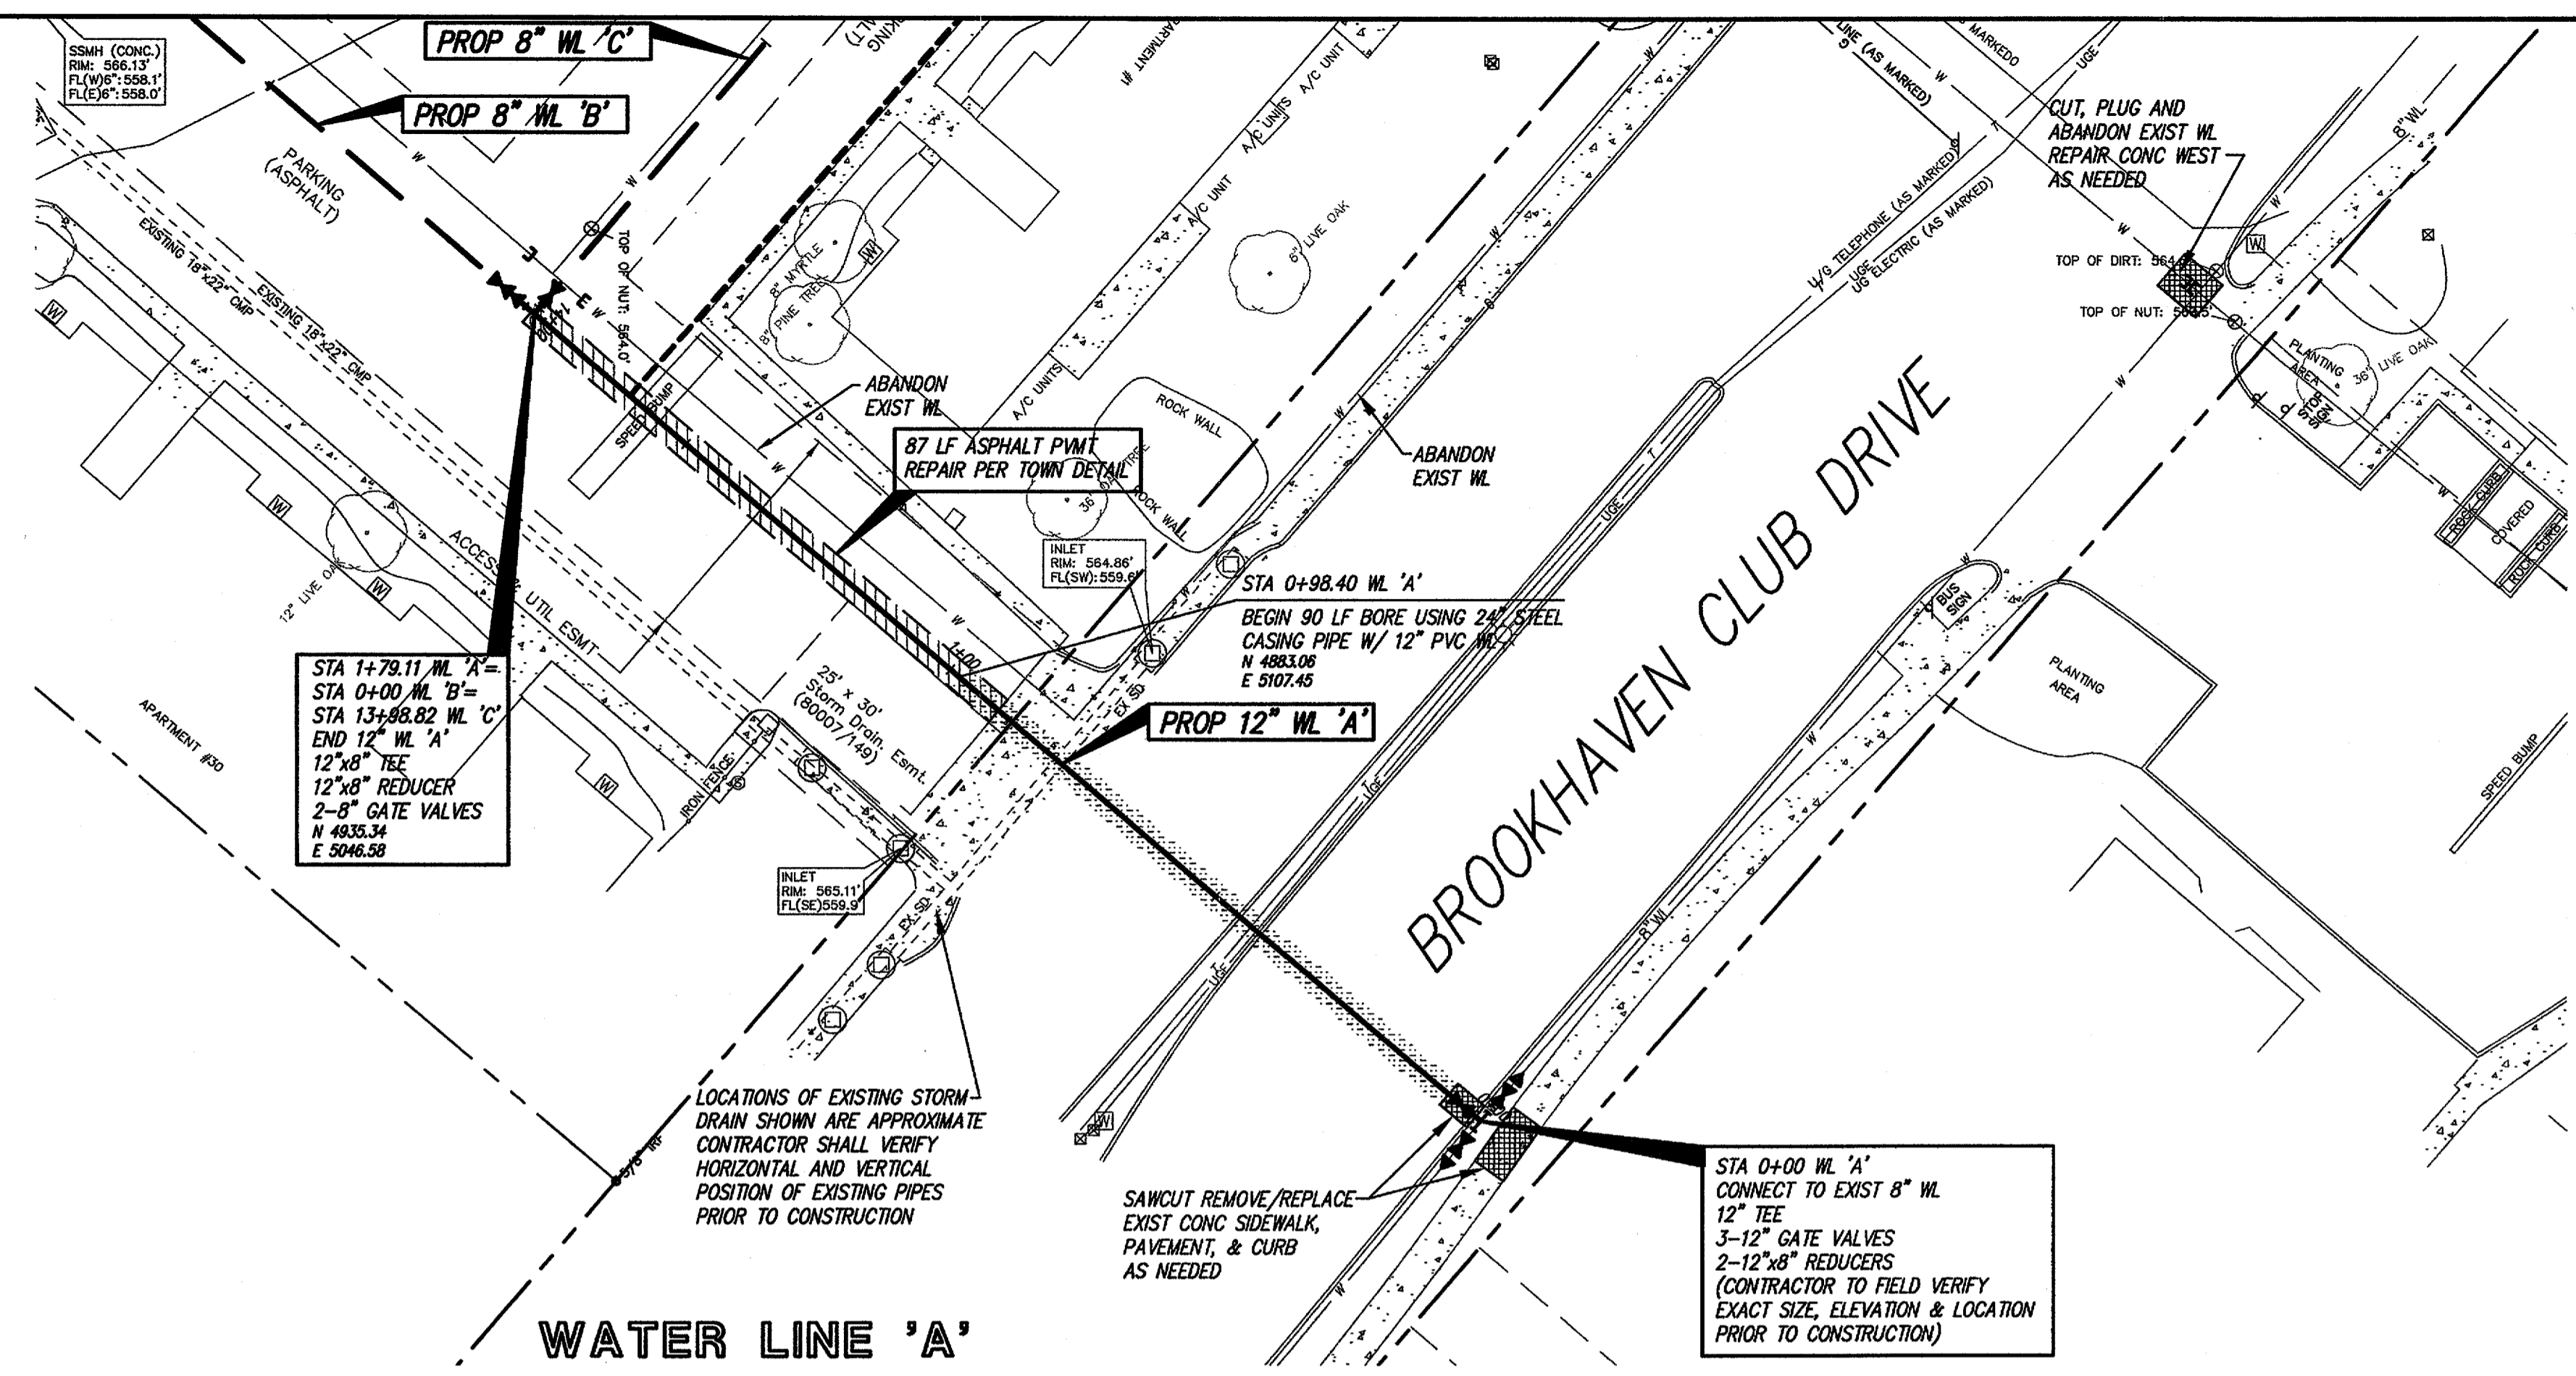

BENCHMARK
 BM 1
 CUT CROSS SET IN THE TOP AT THE SOUTHEAST SIDEWALK INTERSECTION ON THE EAST SIDE OF THE FIRE LANE OPPOSITE APARTMENT BUILDING #24
 COORDINATES: N 5259.29 E 4562.25
 ELEVATION: 570.84


CAUTION!!
 EXISTING UTILITIES
 LOCATIONS OF EXISTING UTILITIES SHOWN ON THESE PLANS ARE APPROXIMATE BASED ON INFORMATION PROVIDED BY THE OWNERS OF THE UTILITIES AND FIELD SURVEYS. THERE MAY ALSO BE EXISTING UTILITIES THAT ARE NOT SHOWN. THE OWNER AND ENGINEER SHALL NOT BE RESPONSIBLE FOR THE ACCURACY OF THIS INFORMATION. CONTRACTOR SHALL LOCATE ALL UTILITIES PRIOR TO BEGINNING CONSTRUCTION. IF A CONFLICT IS DISCOVERED BETWEEN EXISTING UTILITIES AND PROPOSED IMPROVEMENTS, CONTRACTOR SHALL NOTIFY ENGINEER IMMEDIATELY. IT SHALL BE CONTRACTOR'S SOLE RESPONSIBILITY TO COORDINATE WITH UTILITY COMPANY FOR ANY NECESSARY RELOCATION OF FACILITIES AND NO SEPARATE PAYMENT SHALL BE MADE. ADDITIONALLY, CONTRACTOR SHALL NOT BE COMPENSATED FOR DELAYS OR REMOBILIZATION DUE TO UTILITY COORDINATION. ANY DAMAGE TO EXISTING UTILITIES CAUSED BY CONTRACTOR'S OPERATIONS SHALL BE REPAIRED AT CONTRACTOR'S SOLE EXPENSE. CONTRACT TIME SHALL NOT BE EXTENDED DUE TO DELAYS CAUSED BY UTILITY COORDINATION.

STA 1+78.11 WL 'A' =
 STA 0+00 WL 'B' =
 STA 13+98.82 WL 'C' =
 END 12" WL 'A'
 12"x8" TEE
 12"x8" REDUCER
 2-8" GATE VALVES
 N 4833.34
 E 5046.58

PROP 12" WL 'A'


STA 0+00 WL 'A'
 CONNECT TO EXIST 8" WL
 12" TEE
 3-12" GATE VALVES
 2-12"x8" REDUCERS
 (CONTRACTOR TO FIELD VERIFY EXACT SIZE, ELEVATION & LOCATION PRIOR TO CONSTRUCTION)

WATER LINE 'A'

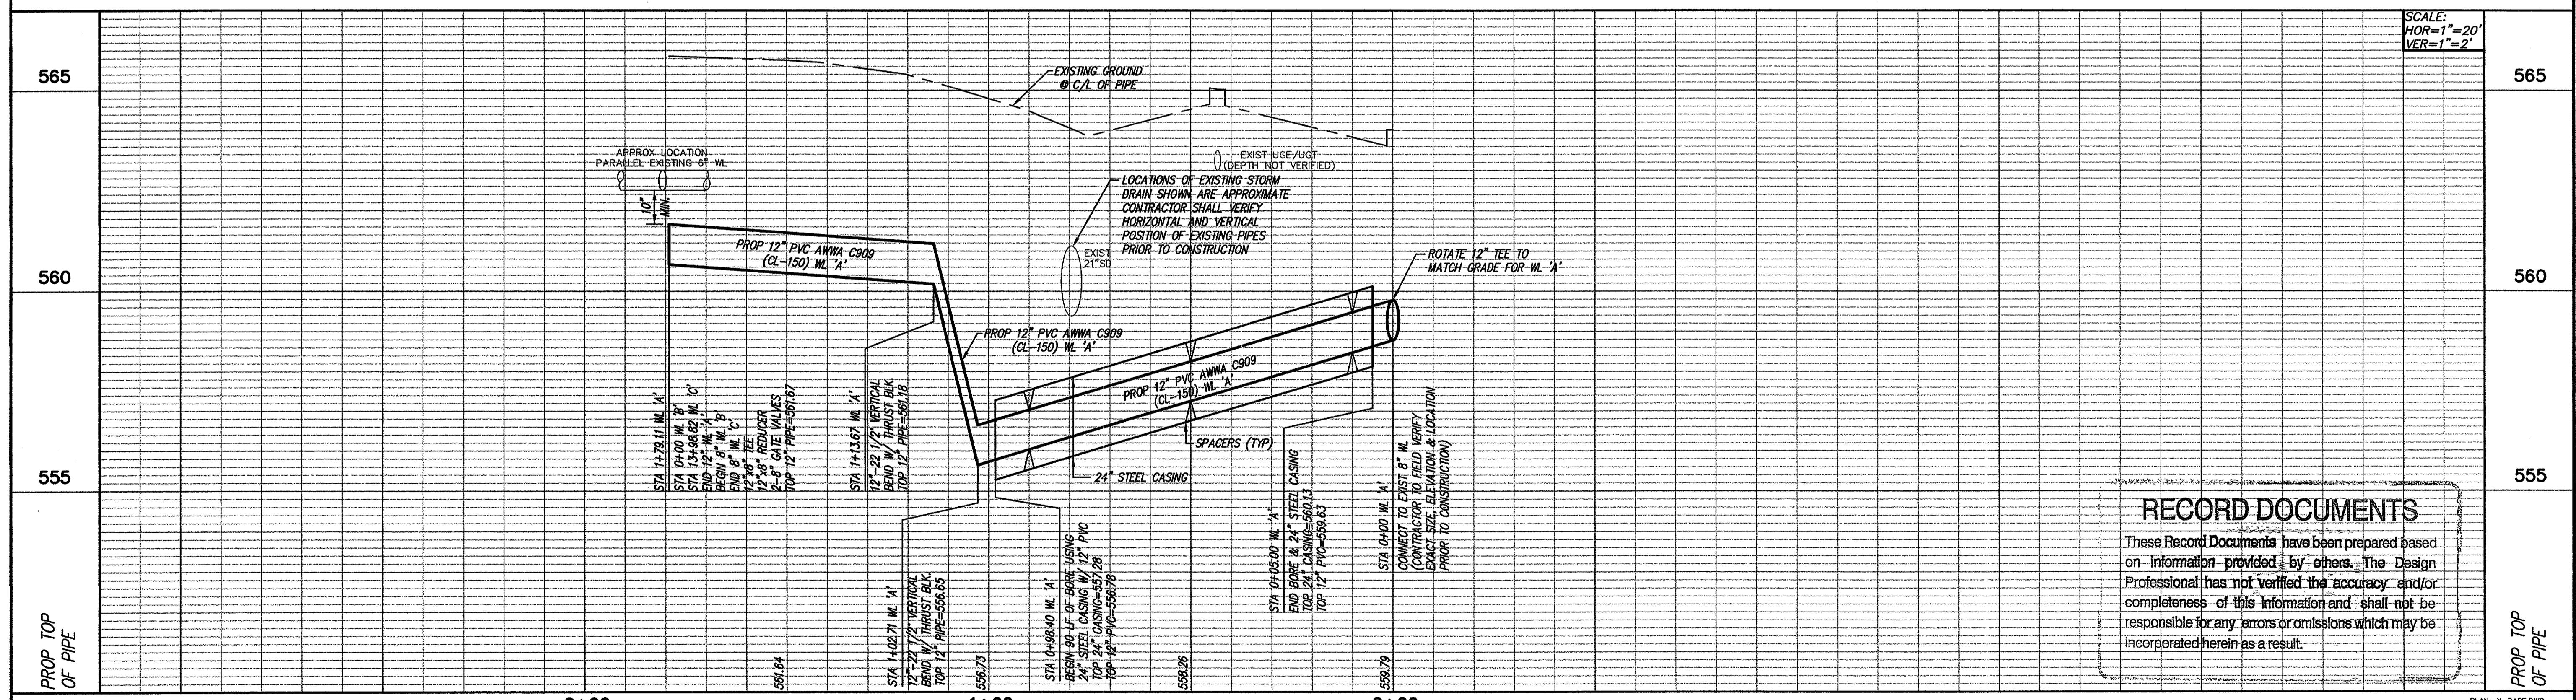

RECORD DOCUMENTS
 These Record Documents have been prepared based on information provided by others. The Design Professional has not verified the accuracy and/or completeness of this information and shall not be responsible for any errors or omissions which may be incorporated herein as a result.


NO.	REVISION	BY	DATE

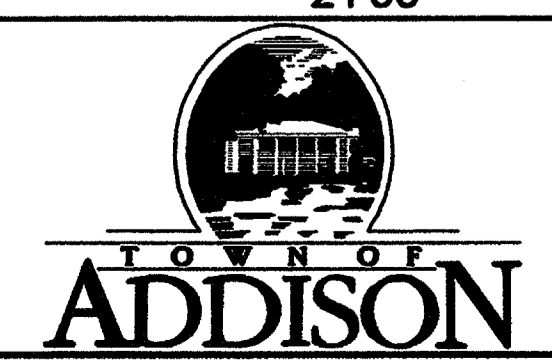

SCALE
 HORIZ
 1" = 20'
 VERT
 1" = 2'
 DATE
 FEB 2004



TEAGUE NALL AND PERKINS
 ENGINEERS • SURVEYORS • CONSULTANTS
 1100 Macon Street Fort Worth, Texas 76102 (817) 336-5773
 235 W. Hickory Street #100 Denton, Texas 76201 (940) 383-4177
 12160 N. Abrams Road #508 Dallas, Texas 75243 (214) 461-9867

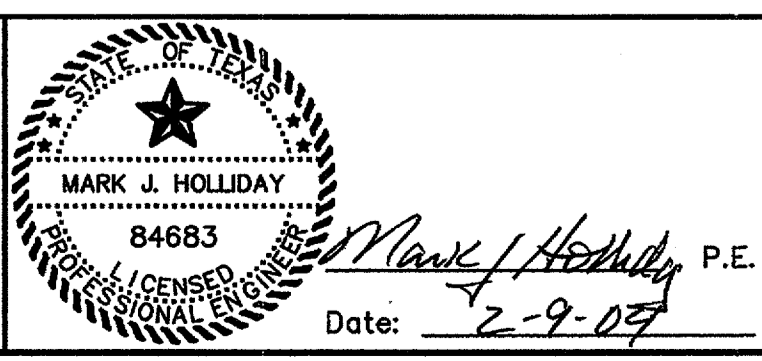



TOWN OF ADDISON, TEXAS
 TALISKER APARTMENTS
 WATER LINE IMPROVEMENTS
 WATER LINE 'A' PLAN & PROFILE
 STA 0+00 TO STA 1+78.64

TNP PROJECT
 ADD03169
 SHEET
5
 OF
 11

MATCHLINE STA 8+00

LISTING OF PROPOSED SERVICES/METERS AND VALVES


STATION	LINE DESIGNATION	NORTHING	EASTING	MATERIALS
0+08.24	WL 'B'	4936.90	5041.84	12" 20# REDUCER & 8" GATE VALVE
2+16.22	WL 'B'	4955.00	4955.10	8" GATE VALVE
2+51.83	WL 'B'	4976.16	4924.35	8" GATE VALVE
2+62.04	WL 'B'	4976.22	4914.13	2" TAPPING SADDLE & 28 LF 2" TYPE 'K' COPPER SERVICE
6+01.47	WL 'B'	5059.06	4555.91	8" GATE VALVE
6+35.53	WL 'B'	5085.63	4537.86	8" GATE VALVE
7+46.14	WL 'B'	5196.24	4537.63	2" TAPPING SADDLE & 28 LF 2" TYPE 'K' COPPER SERVICE
7+51.43	WL 'B'	5201.53	4537.62	2" TAPPING SADDLE & 28 LF 2" TYPE 'K' COPPER SERVICE

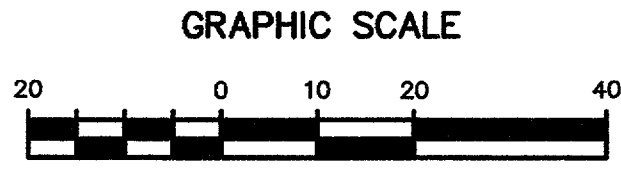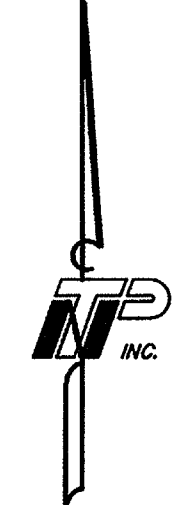

BENCHMARK
 BM:
 CUT CROSS SET IN THE TOP AT THE SOUTHEAST SIDEWALK
 INTERSECTION ON THE EAST SIDE OF THE FIRE LANE OPPOSITE
 APARTMENT BUILDING #24
 COORDINATES: N 5259.29 ELEVATION: 570.84
 E 4562.25


CAUTION!!
 EXISTING UTILITIES

LOCATIONS OF EXISTING UTILITIES SHOWN ON THESE PLANS ARE APPROXIMATE BASED ON INFORMATION PROVIDED BY THE OWNERS OF THE UTILITIES AND FIELD SURVEYS. THERE MAY ALSO BE EXISTING UTILITIES THAT ARE NOT SHOWN. THE OWNER AND ENGINEER SHALL NOT BE RESPONSIBLE FOR THE ACCURACY OF THIS INFORMATION. CONTRACTOR SHALL LOCATE ALL UTILITIES PRIOR TO BEGINNING CONSTRUCTION. IF A CONFLICT IS DISCOVERED BETWEEN EXISTING UTILITIES AND PROPOSED IMPROVEMENTS, CONTRACTOR SHALL NOTIFY ENGINEER IMMEDIATELY. IT SHALL BE CONTRACTOR'S SOLE RESPONSIBILITY TO COORDINATE WITH UTILITY COMPANY FOR ANY NECESSARY RELOCATION OF FACILITIES AND NO SEPARATE PAYMENT SHALL BE MADE. ADDITIONALLY, CONTRACTOR SHALL NOT BE COMPENSATED FOR DELAYS OR REINSTATEMENT DUE TO UTILITY COORDINATION. ANY DAMAGE TO EXISTING UTILITIES CAUSED BY CONTRACTOR'S OPERATIONS SHALL BE REPAIRED AT CONTRACTOR'S SOLE EXPENSE. CONTRACT TIME SHALL NOT BE EXTENDED DUE TO DELAYS CAUSED BY UTILITY COORDINATION.

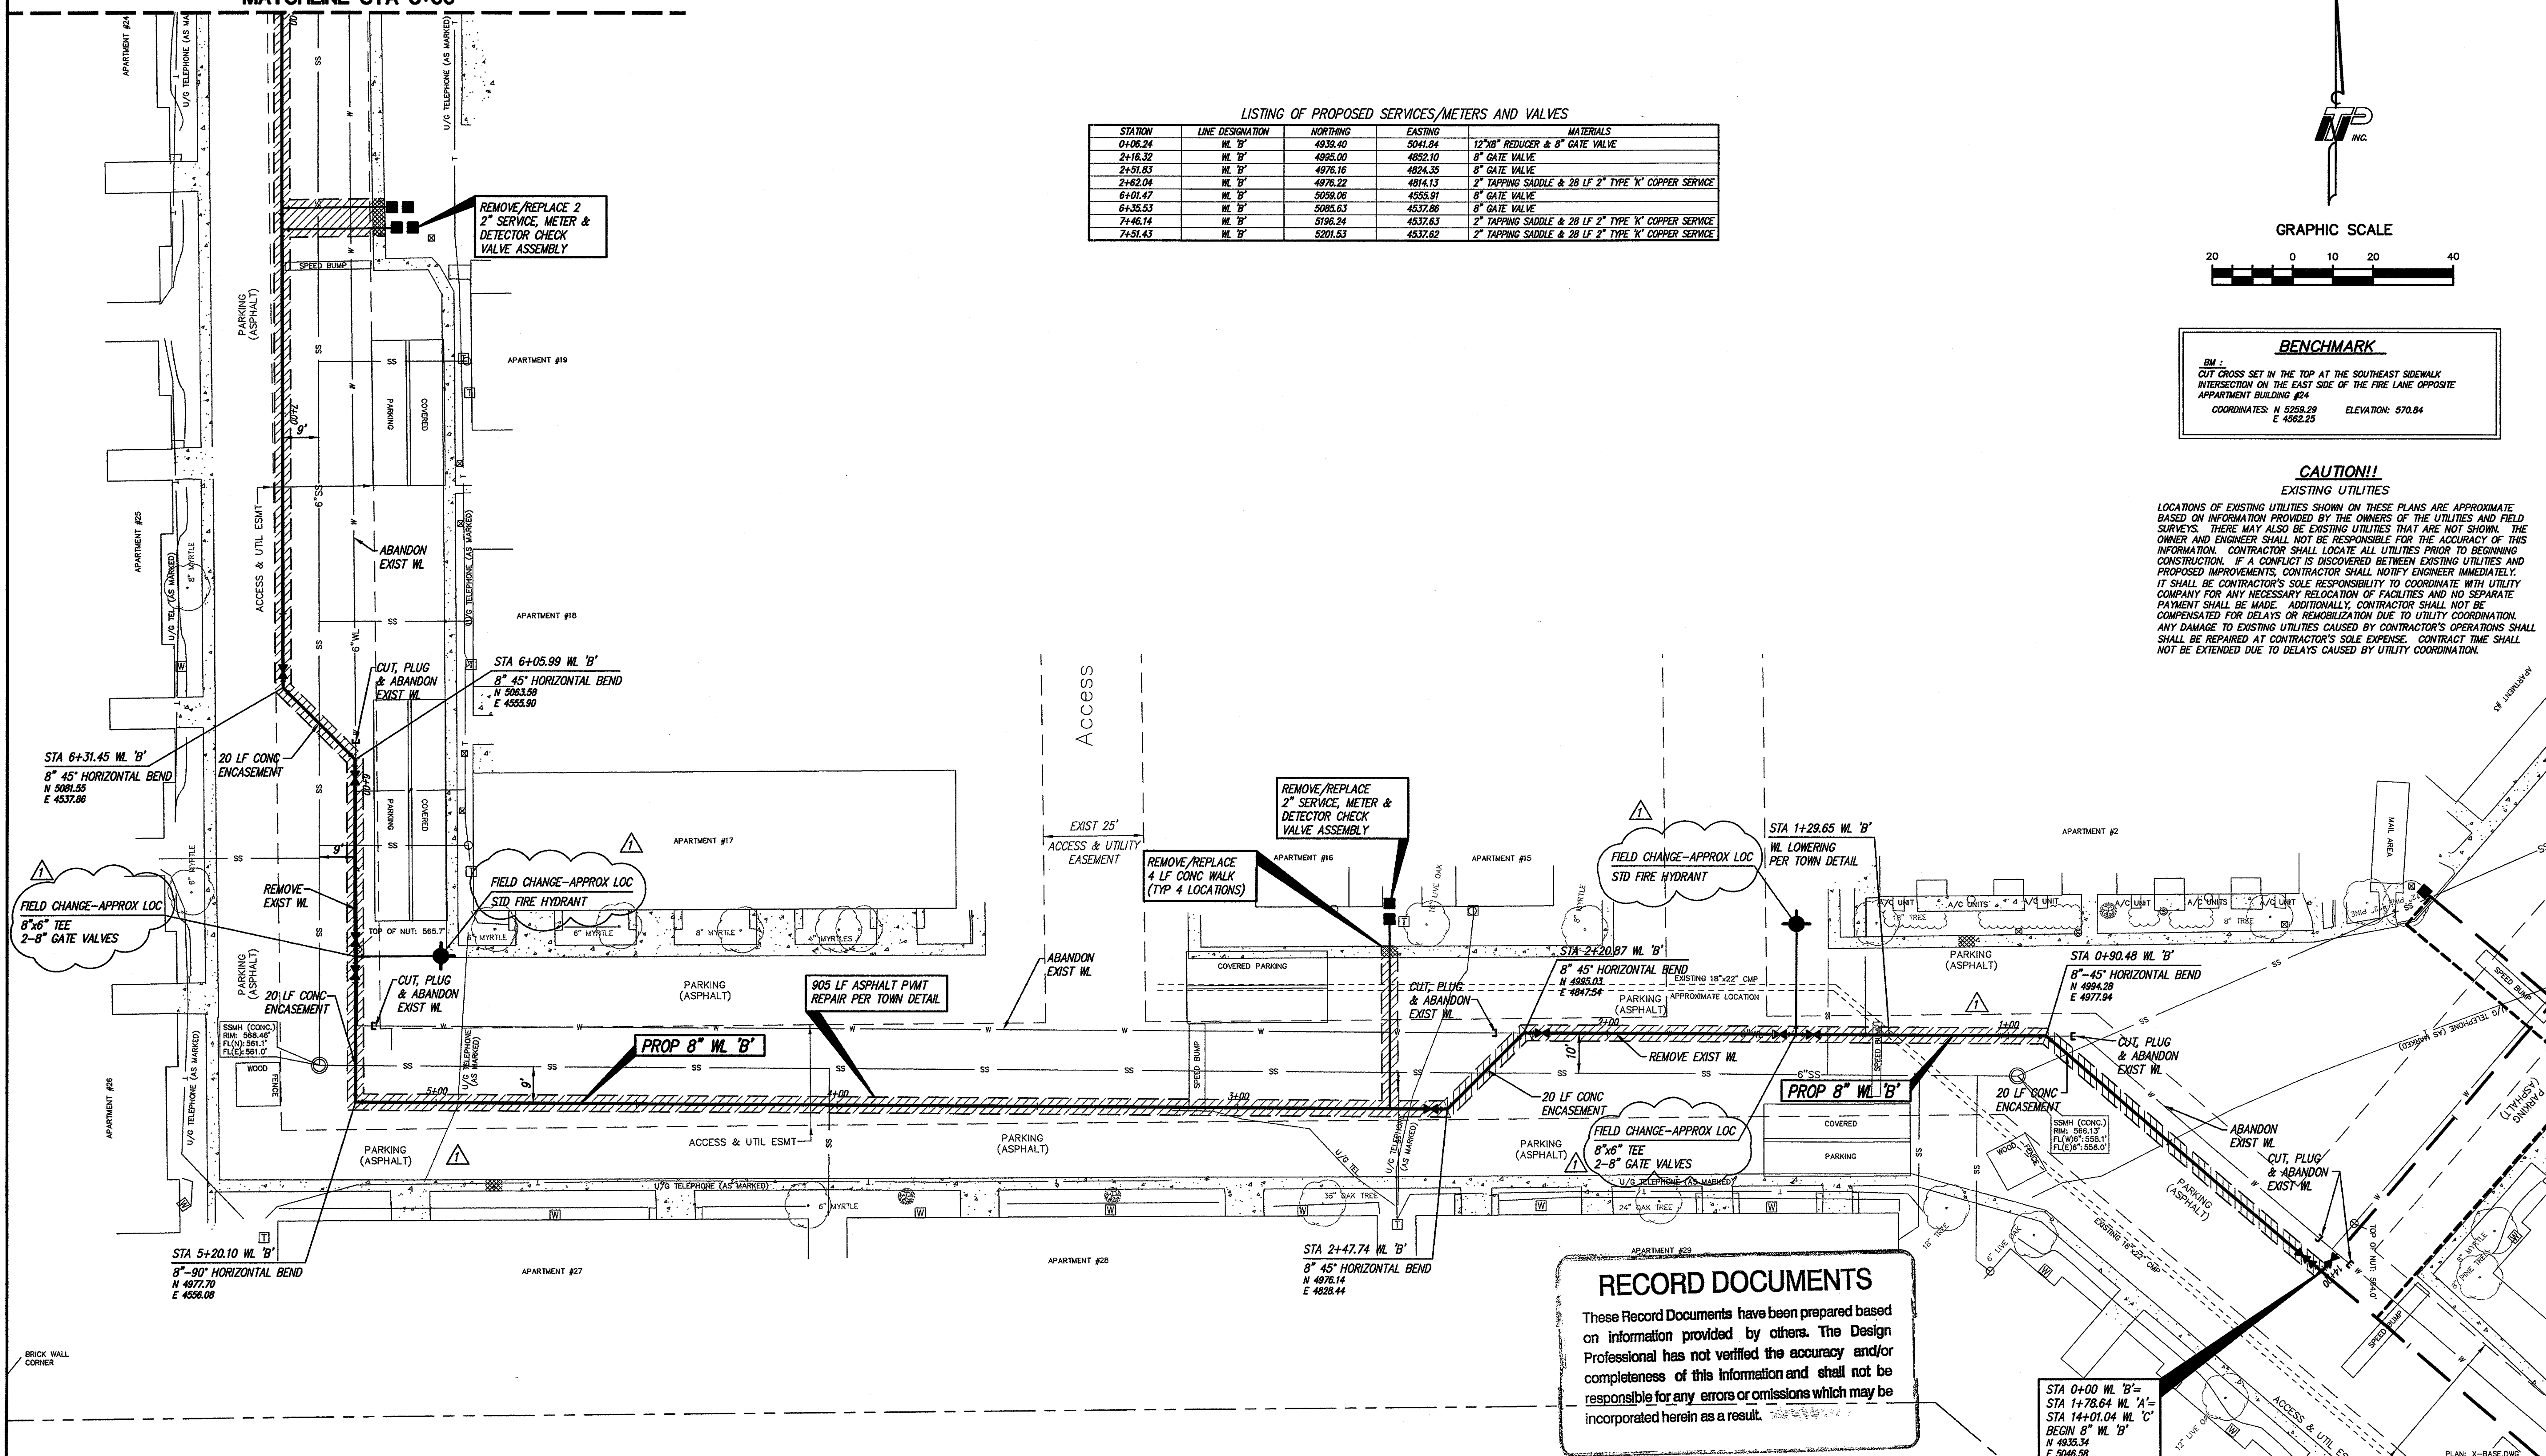

RECORD DOCUMENTS
 These Record Documents have been prepared based on information provided by others. The Design Professional has not verified the accuracy and/or completeness of this information and shall not be responsible for any errors or omissions which may be incorporated herein as a result.


RECORD DRAWING MODIFICATION:	TNP	1/05
RELOCATED PROP. FH/WV PER		
FIELD CHANGE MARKUP.		
NO.	REVISION	BY DATE

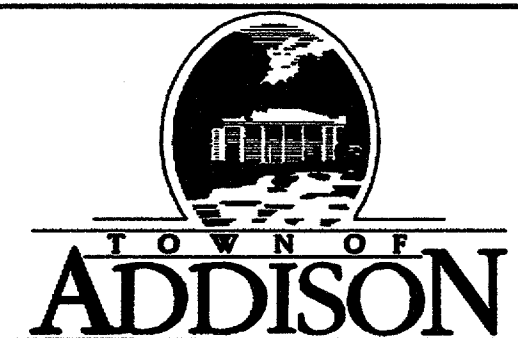

SCALE
 HORIZ
 1" = 20'
 VERT
 N/A
 DATE
 FEB 2004




TEAGUE NALL AND PERKINS
 ENGINEERS • SURVEYORS • CONSULTANTS
 1100 Macon Street Fort Worth, Texas 76102 (817) 336-5773
 235 W. Hickory Street Denton, Texas 76201 (940) 383-4177
 #100 12160 N. Abrams Road #508 Dallas, Texas 75243 (214) 461-9867

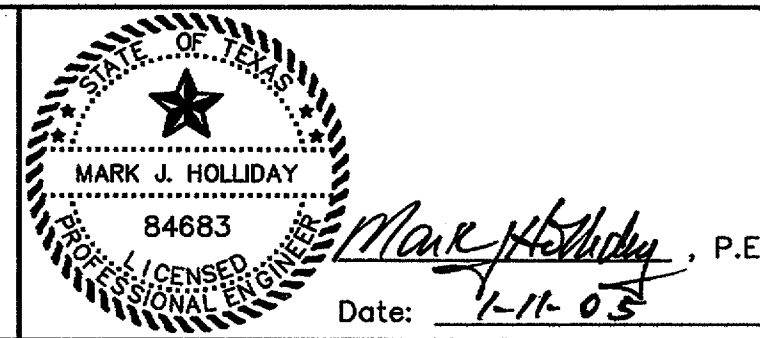



TOWN OF ADDISON, TEXAS
 TALISKER APARTMENTS
WATER LINE IMPROVEMENTS
 WATER LINE 'B' STA 0+00 TO 8+00

TNP PROJECT
 ADD03169
 SHEET
6
 OF
 11

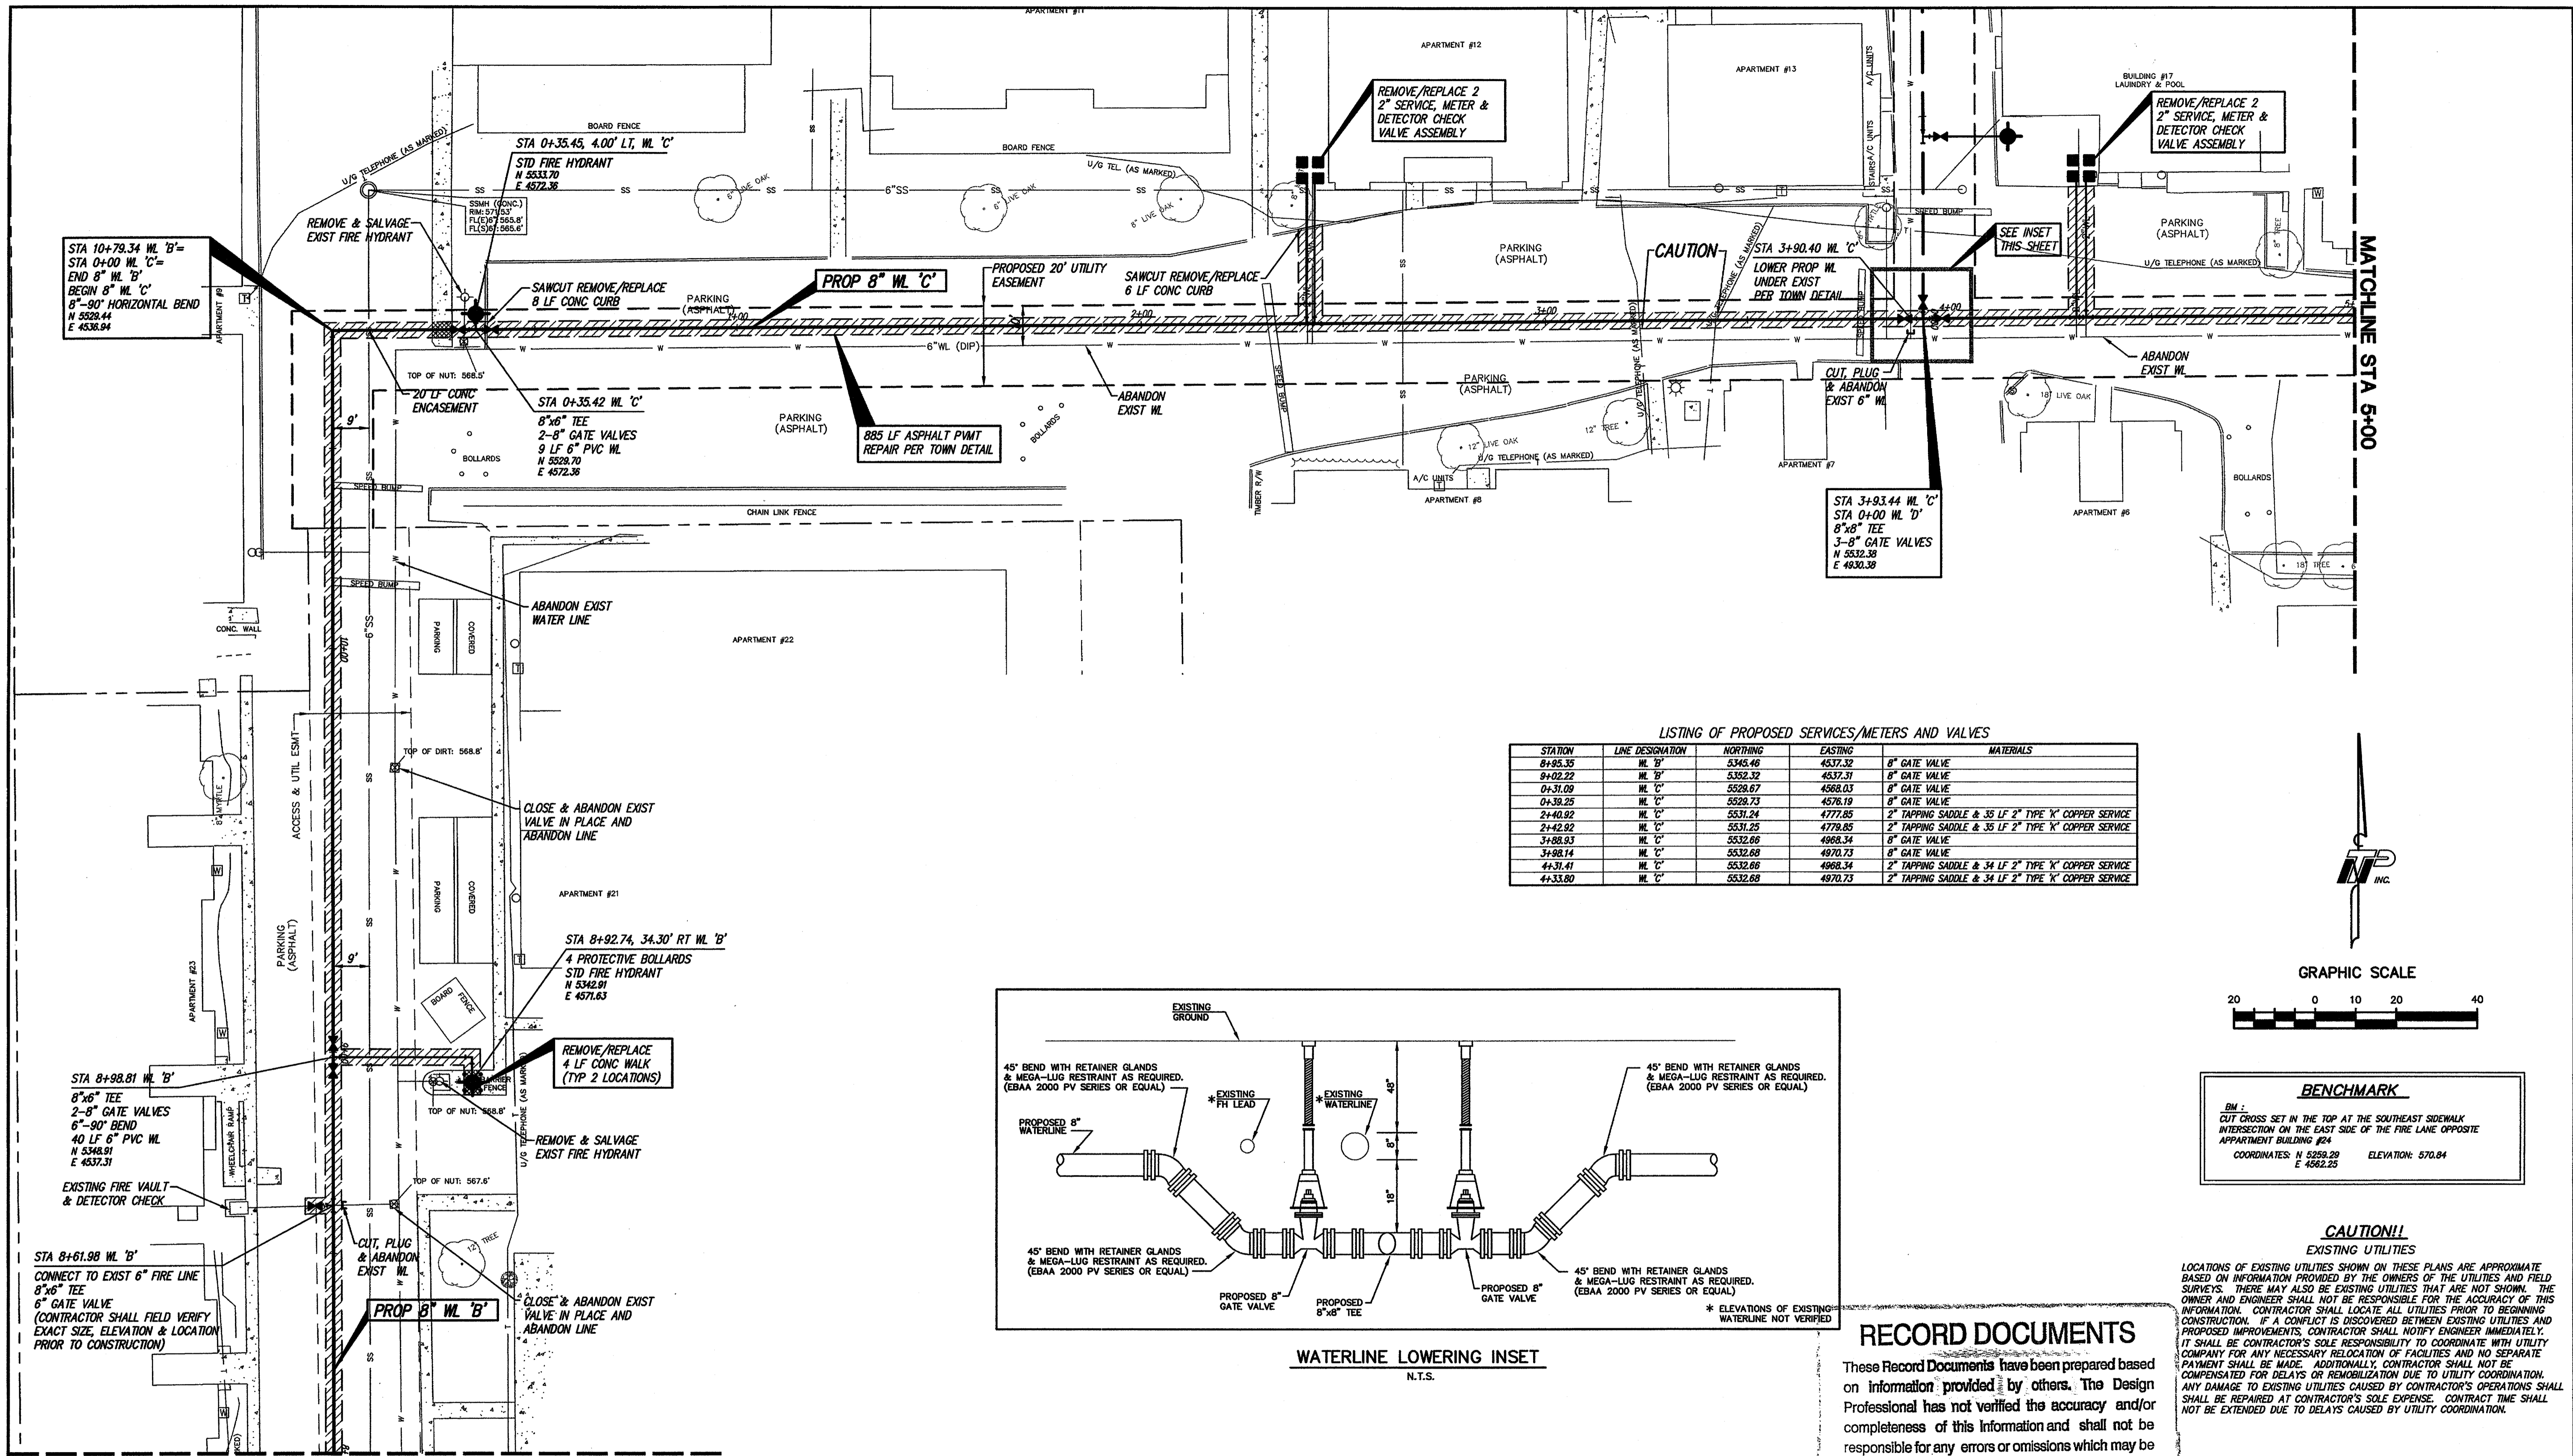

LISTING OF PROPOSED SERVICES/METERS AND VALVES

STATION	LINE DESIGNATION	NORTHING	EASTING	MATERIALS
8+95.35	WL 'B'	5345.46	4537.32	8" GATE VALVE
9+02.22	WL 'B'	5352.32	4537.31	8" GATE VALVE
0+31.09	WL 'C'	5529.67	4568.03	8" GATE VALVE
0+38.25	WL 'C'	5529.73	4576.19	8" GATE VALVE
2+40.92	WL 'C'	5531.24	4777.85	2" TAPPING SADDLE & 35 LF 2" TYPE 'K' COPPER SERVICE
2+42.92	WL 'C'	5531.25	4779.85	2" TAPPING SADDLE & 35 LF 2" TYPE 'K' COPPER SERVICE
3+98.93	WL 'C'	5532.68	4968.34	8" GATE VALVE
3+98.14	WL 'C'	5532.68	4970.73	8" GATE VALVE
4+31.41	WL 'C'	5532.68	4968.34	2" TAPPING SADDLE & 34 LF 2" TYPE 'K' COPPER SERVICE
4+33.80	WL 'C'	5532.68	4970.73	2" TAPPING SADDLE & 34 LF 2" TYPE 'K' COPPER SERVICE

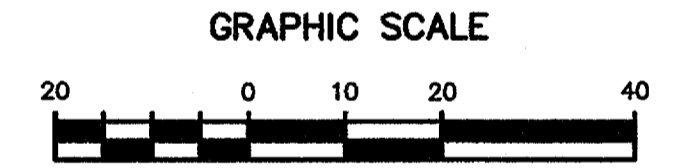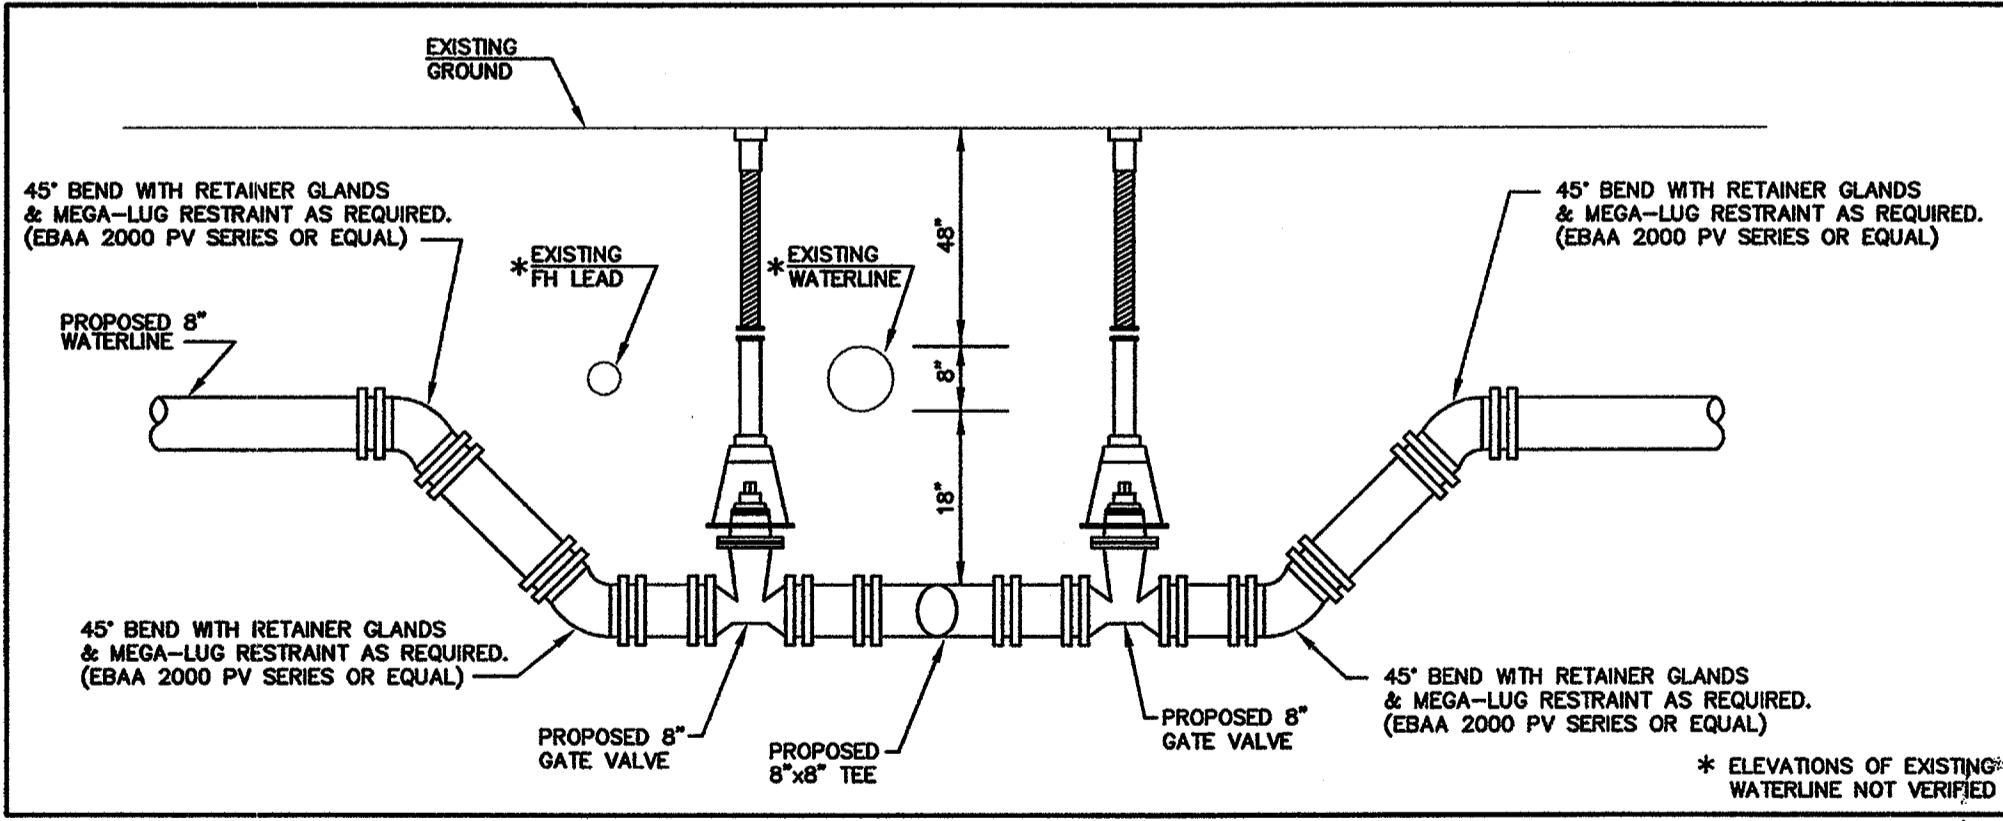


BENCHMARK
 BM : CUT CROSS SET IN THE TOP AT THE SOUTHEAST SIDEWALK INTERSECTION ON THE EAST SIDE OF THE FIRE LANE OPPOSITE APARTMENT BUILDING #24
 COORDINATES: N 5259.29 E 4562.25 ELEVATION: 570.84

RECORD DOCUMENTS
 These Record Documents have been prepared based on information provided by others. The Design Professional has not verified the accuracy and/or completeness of this information and shall not be responsible for any errors or omissions which may be incorporated herein as a result.

CAUTION!!
 EXISTING UTILITIES
 LOCATIONS OF EXISTING UTILITIES SHOWN ON THESE PLANS ARE APPROXIMATE BASED ON INFORMATION PROVIDED BY THE OWNERS OF THE UTILITIES AND FIELD SURVEYS. THERE MAY ALSO BE EXISTING UTILITIES THAT ARE NOT SHOWN. THE OWNER AND ENGINEER SHALL NOT BE RESPONSIBLE FOR THE ACCURACY OF THIS INFORMATION. CONTRACTOR SHALL LOCATE ALL UTILITIES PRIOR TO BEGINNING CONSTRUCTION. IF A CONFLICT IS DISCOVERED BETWEEN EXISTING UTILITIES AND PROPOSED IMPROVEMENTS, CONTRACTOR SHALL NOTIFY ENGINEER IMMEDIATELY. IT SHALL BE CONTRACTOR'S SOLE RESPONSIBILITY TO COORDINATE WITH UTILITY COMPANY FOR ANY NECESSARY RELOCATION OF FACILITIES AND NO SEPARATE PAYMENT SHALL BE MADE. ADDITIONALLY, CONTRACTOR SHALL NOT BE COMPENSATED FOR DELAYS OR REMEDIATION DUE TO UTILITY COORDINATION. ANY DAMAGE TO EXISTING UTILITIES CAUSED BY CONTRACTOR'S OPERATIONS SHALL BE REPAIRED AT CONTRACTOR'S SOLE EXPENSE. CONTRACT TIME SHALL NOT BE EXTENDED DUE TO DELAYS CAUSED BY UTILITY COORDINATION.


NO.	REVISION	BY	DATE

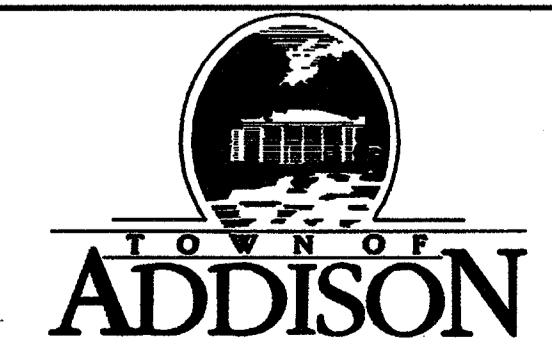


SCALE
 HORIZ 1" = 20'
 VERT N/A
 DATE FEB 2004



TEAGUE NALL AND PERKINS
 ENGINEERS • SURVEYORS • CONSULTANTS
 1100 Macon Street Fort Worth, Texas 76102 (817) 336-5773
 235 W. Hickory Street #100 Denton, Texas 76201 (940) 383-4177
 12160 N. Abrams Road #508 Dallas, Texas 75243 (214) 461-9867

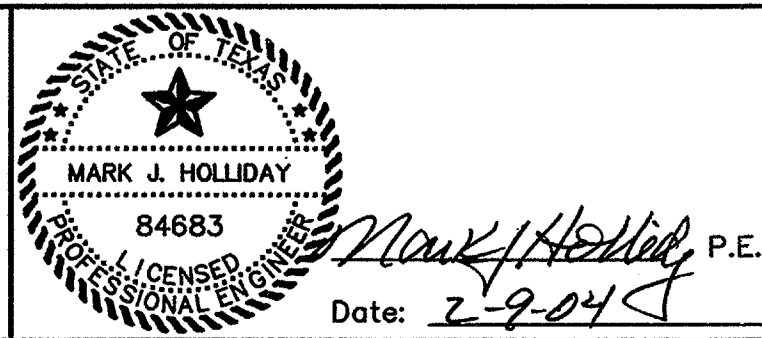


TOWN OF ADDISON, TEXAS
 TALISKER APARTMENTS
WATER LINE IMPROVEMENTS
 WATER LINE 'B' STA 8+00 TO 10+79.34
 WATER LINE 'C' STA 0+00 TO 5+00
 TNP PROJECT ADD03169
 SHEET **7** OF 11

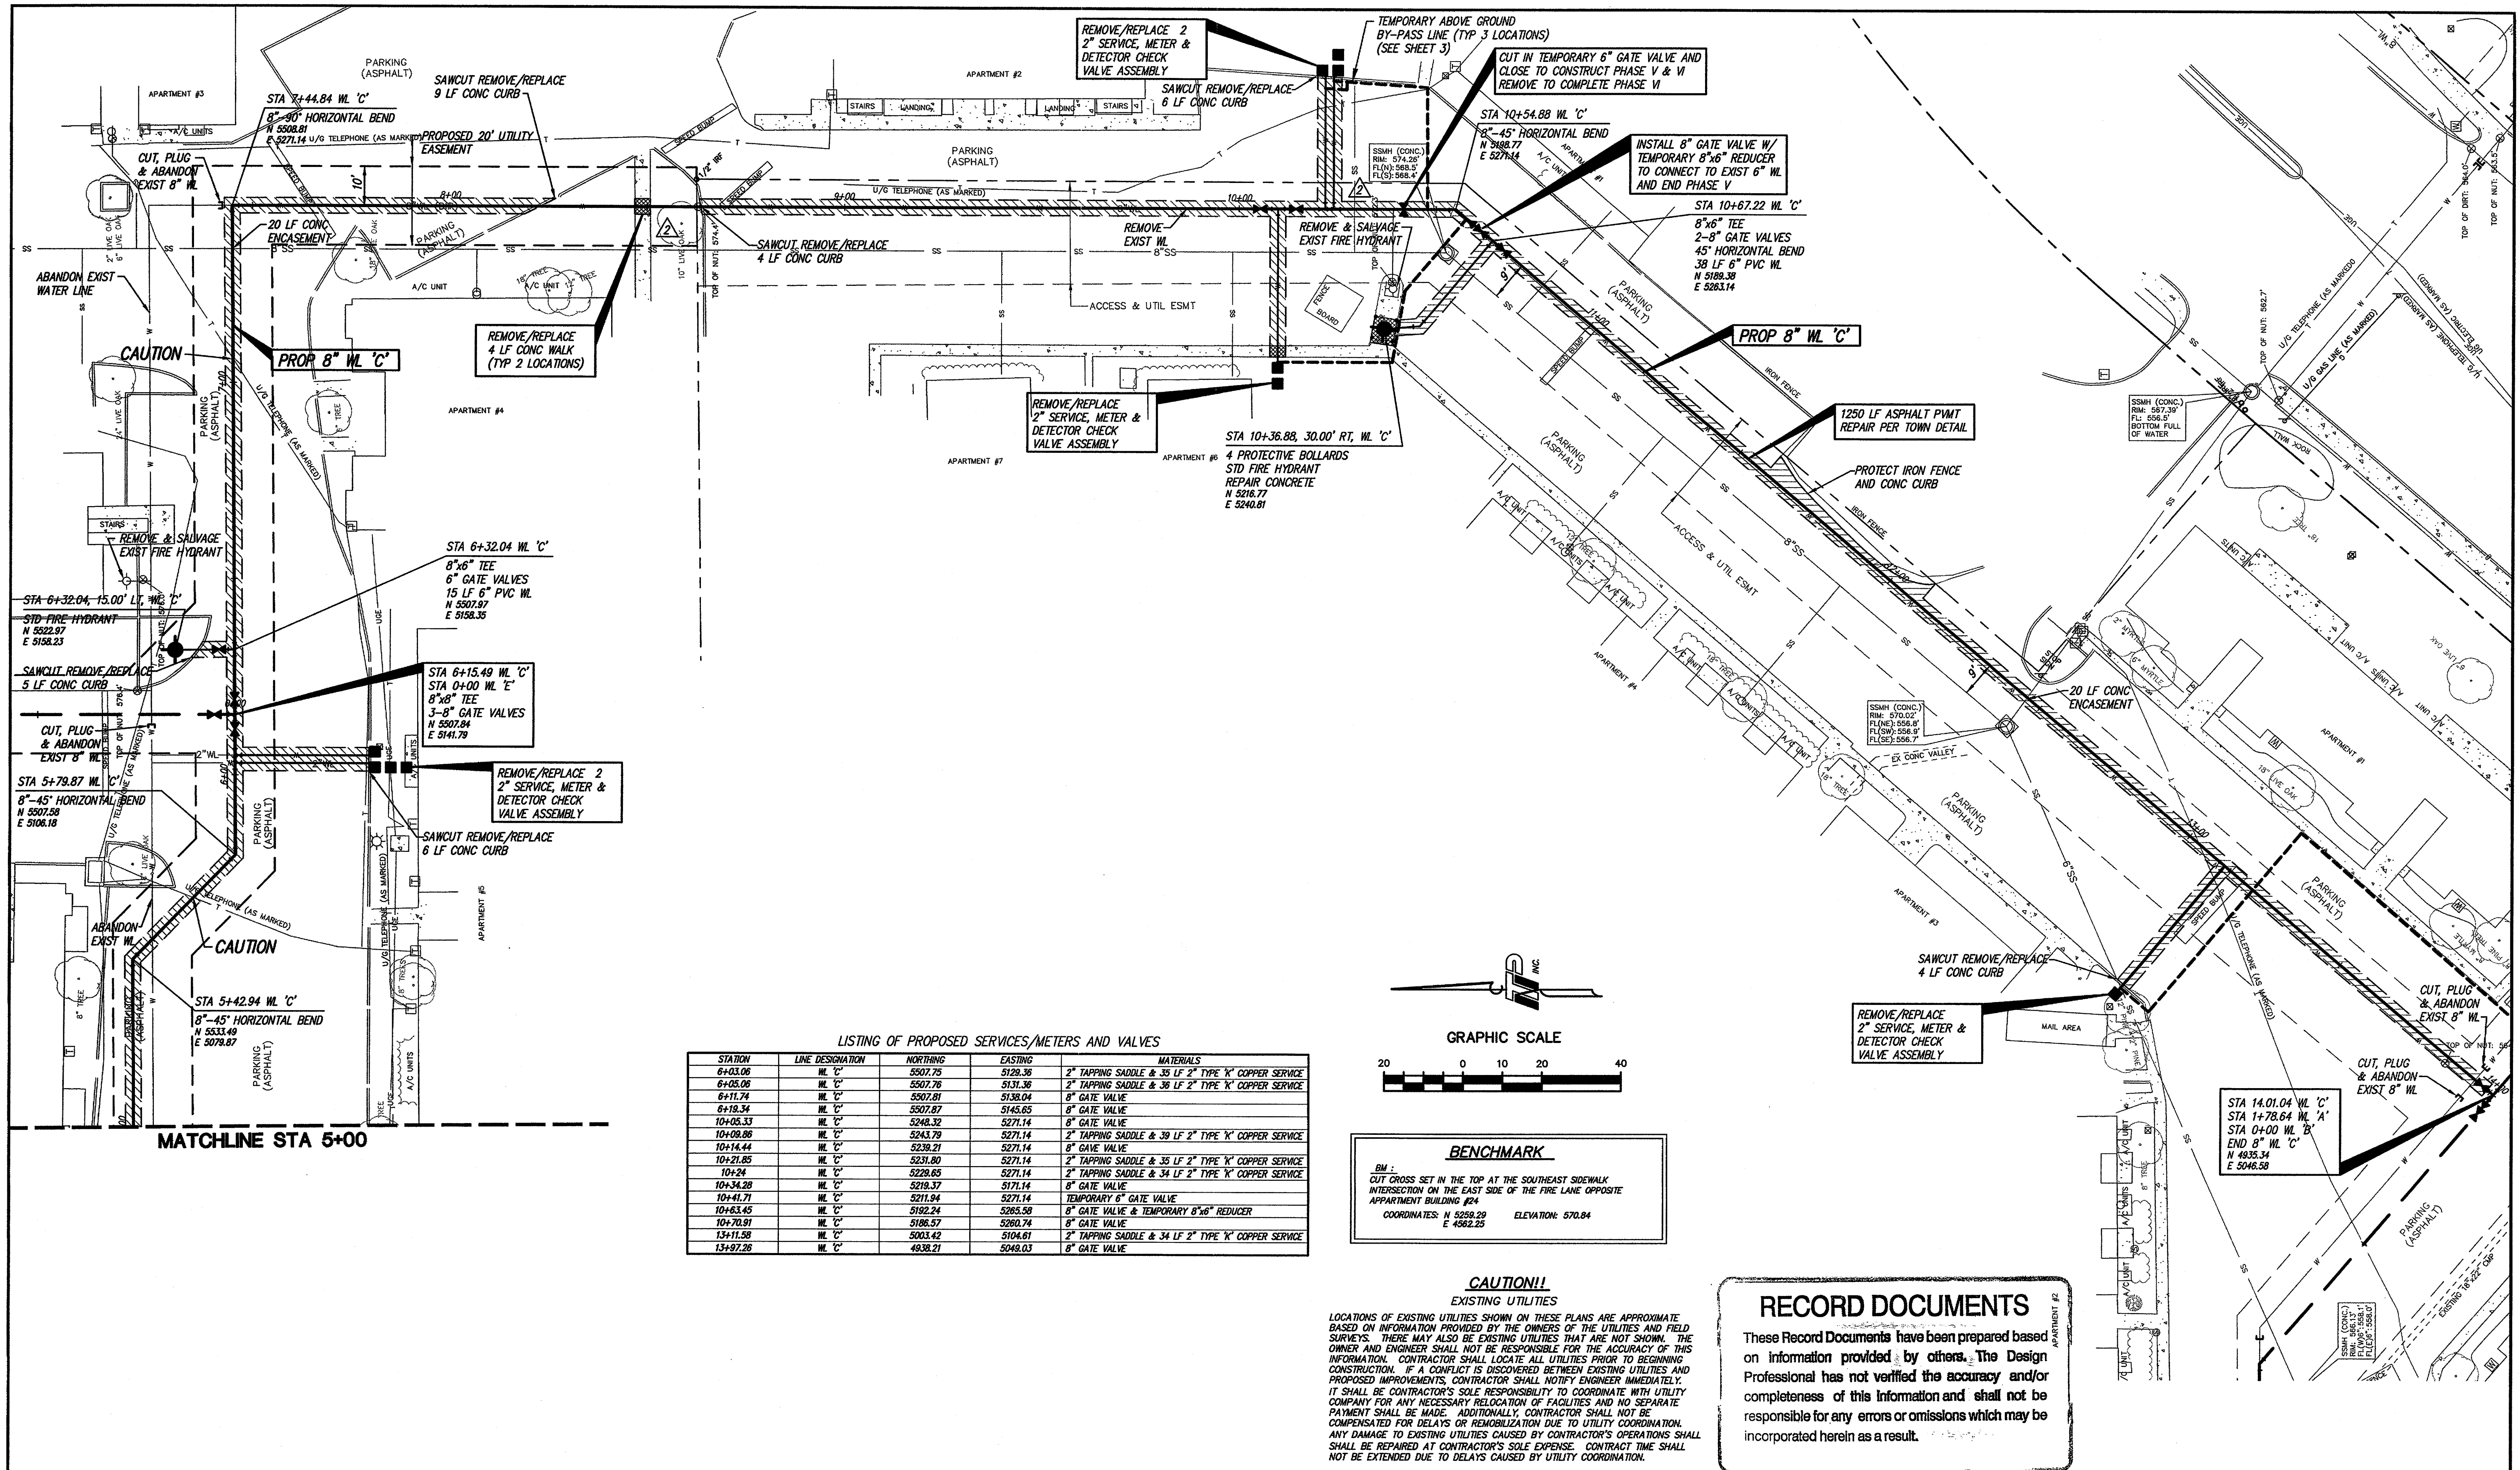

LISTING OF PROPOSED SERVICES/METERS AND VALVES

STATION	LINE DESIGNATION	NORTHING	EASTING	MATERIALS
6+03.06	WL 'C'	5507.75	5129.36	2" TAPPING SADDLE & 35 LF 2" TYPE 'K' COPPER SERVICE
6+05.06	WL 'C'	5507.76	5131.36	2" TAPPING SADDLE & 36 LF 2" TYPE 'K' COPPER SERVICE
6+11.74	WL 'C'	5507.81	5138.04	8" GATE VALVE
6+19.34	WL 'C'	5507.87	5145.65	8" GATE VALVE
10+05.33	WL 'C'	5248.32	5271.14	8" GATE VALVE
10+08.89	WL 'C'	5243.79	5271.14	2" TAPPING SADDLE & 39 LF 2" TYPE 'K' COPPER SERVICE
10+14.44	WL 'C'	5239.21	5271.14	8" GATE VALVE
10+21.85	WL 'C'	5231.80	5271.14	2" TAPPING SADDLE & 35 LF 2" TYPE 'K' COPPER SERVICE
10+24	WL 'C'	5228.65	5271.14	2" TAPPING SADDLE & 34 LF 2" TYPE 'K' COPPER SERVICE
10+34.28	WL 'C'	5219.37	5171.14	8" GATE VALVE
10+41.71	WL 'C'	5211.94	5271.14	TEMPORARY 6" GATE VALVE
10+63.45	WL 'C'	5192.24	5265.58	8" GATE VALVE & TEMPORARY 8"x6" REDUCER
10+70.91	WL 'C'	5186.57	5260.74	8" GATE VALVE
13+11.59	WL 'C'	5003.42	5104.61	2" TAPPING SADDLE & 34 LF 2" TYPE 'K' COPPER SERVICE
13+19.28	WL 'C'	4938.21	5049.03	8" GATE VALVE

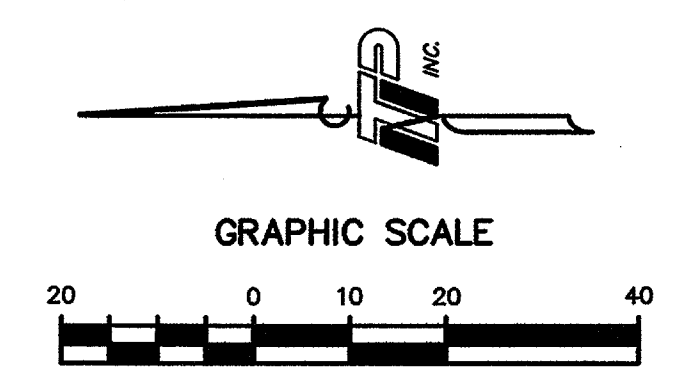


BENCHMARK
 BM :
 CUT CROSS SET IN THE TOP AT THE SOUTHEAST SIDEWALK INTERSECTION ON THE EAST SIDE OF THE FIRE LANE OPPOSITE APARTMENT BUILDING #24
 COORDINATES: N 5258.29 E 4562.25 ELEVATION: 570.84

CAUTION!!
 EXISTING UTILITIES
 LOCATIONS OF EXISTING UTILITIES SHOWN ON THESE PLANS ARE APPROXIMATE BASED ON INFORMATION PROVIDED BY THE OWNERS OF THE UTILITIES AND FIELD SURVEYS. THERE MAY ALSO BE EXISTING UTILITIES THAT ARE NOT SHOWN. THE OWNER AND ENGINEER SHALL NOT BE RESPONSIBLE FOR THE ACCURACY OF THIS INFORMATION. CONTRACTOR SHALL LOCATE ALL UTILITIES PRIOR TO BEGINNING CONSTRUCTION. IF A CONFLICT IS DISCOVERED BETWEEN EXISTING UTILITIES AND PROPOSED IMPROVEMENTS, CONTRACTOR SHALL NOTIFY ENGINEER IMMEDIATELY. IT SHALL BE CONTRACTOR'S SOLE RESPONSIBILITY TO COORDINATE WITH UTILITY COMPANY FOR ANY NECESSARY RELOCATION OF FACILITIES AND NO SEPARATE PAYMENT SHALL BE MADE. ADDITIONALLY, CONTRACTOR SHALL NOT BE COMPENSATED FOR DELAYS OR REMOBILIZATION DUE TO UTILITY COORDINATION. ANY DAMAGE TO EXISTING UTILITIES CAUSED BY CONTRACTOR'S OPERATIONS SHALL BE REPAIRED AT CONTRACTOR'S SOLE EXPENSE. CONTRACT TIME SHALL NOT BE EXTENDED DUE TO DELAYS CAUSED BY UTILITY COORDINATION.

RECORD DOCUMENTS
 These Record Documents have been prepared based on information provided by others. The Design Professional has not verified the accuracy and/or completeness of this information and shall not be responsible for any errors or omissions which may be incorporated herein as a result.


RECORD DRAWING MODIFICATION:	TNP	1/05
DELETED PROP. WV PER		
FIELD CHANGE MARKUP.		
NO.	REVISION	BY DATE

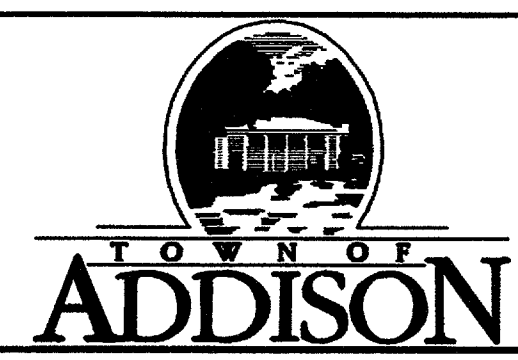

SCALE
 HORIZ
 1" = 20'
 VERT
 N/A
 DATE
 FEB 2004



TEAGUE NALL AND PERKINS
 ENGINEERS • SURVEYORS • CONSULTANTS
 1100 Macon Street Fort Worth, Texas 76102 (817) 336-5773
 235 W. Hickory Street Denton, Texas 76201 (940) 383-4177
 #100 12160 N. Abrams Road #508 Dallas, Texas 75243 (214) 461-9867

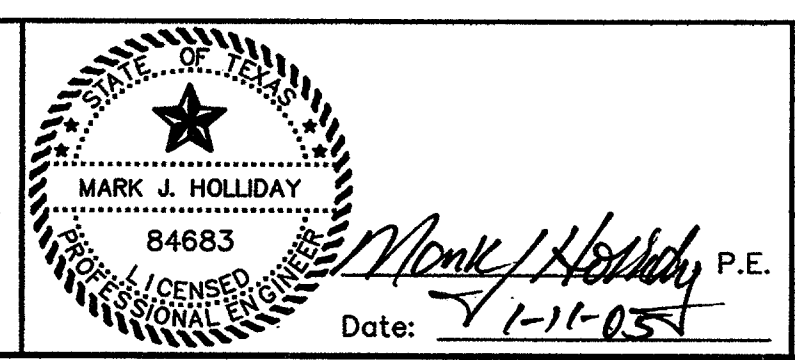


TOWN OF ADDISON, TEXAS
 TALISKER APARTMENTS
 WATER LINE IMPROVEMENTS
 WATER LINE 'C' STA 5+00 TO 14+01.04

TNP PROJECT
 ADD03169
 SHEET
8
 OF
 11

LIST OF PROPOSED SERVICES/METERS AND VALVES					
STATION	LINE DESIGNATION	NORTHINGS	EASTINGS		MATERIALS
0+04.07	WL 'D'	5536.45	4930.39		8" GATE VALVE
1+74.33	WL 'D'	5706.70	4930.34		8" GATE VALVE
3+08.41	WL 'D'	5724.32	4813.87		8" GATE VALVE
0+05.18	WL 'E'	5513.02	5141.79		8" GATE VALVE
1+89.19	WL 'E'	5707.03	5141.79		2" TAPPING SADDLE & 30 LF 2" TYPE 'K' COPPER SERVICE
2+02.19	WL 'E'	5710.03	5141.79		2" TAPPING SADDLE & 30 LF 2" TYPE 'K' COPPER SERVICE
4+10.35	WL 'E'	5711.03	4934.62		8" GATE VALVE



GRAPHIC SCALE

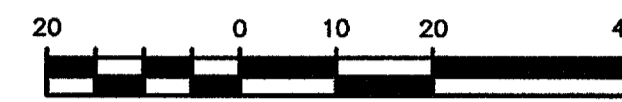

BENCHMARK


BM :
CUT CROSS SET IN THE TOP AT THE SOUTHEAST SIDEWALK INTERSECTION ON THE EAST SIDE OF THE FIRE LANE OPPOSITE APARTMENT BUILDING #24
COORDINATES: N 5259.29 E 4562.25
ELEVATION: 570.84

CAUTION!!


EXISTING UTILITIES
LOCATIONS OF EXISTING UTILITIES SHOWN ON THESE PLANS ARE APPROXIMATE BASED ON INFORMATION PROVIDED BY THE OWNERS OF THE UTILITIES AND FIELD SURVEYS. THERE MAY ALSO BE EXISTING UTILITIES THAT ARE NOT SHOWN. THE OWNER AND ENGINEER SHALL NOT BE RESPONSIBLE FOR THE ACCURACY OF THIS INFORMATION. CONTRACTOR SHALL LOCATE ALL UTILITIES PRIOR TO BEGINNING CONSTRUCTION. IF A CONFLICT IS DISCOVERED BETWEEN EXISTING UTILITIES AND PROPOSED IMPROVEMENTS, CONTRACTOR SHALL NOTIFY ENGINEER IMMEDIATELY. IT SHALL BE CONTRACTOR'S SOLE RESPONSIBILITY TO COORDINATE WITH UTILITY COMPANY FOR ANY NECESSARY RELOCATION OF FACILITIES AND NO SEPARATE PAYMENT SHALL BE MADE. ADDITIONALLY CONTRACTOR SHALL NOT BE COMPENSATED FOR DELAYS OR REMOBILIZATION DUE TO UTILITY COORDINATION. ANY DAMAGE TO EXISTING UTILITIES CAUSED BY CONTRACTOR'S OPERATIONS SHALL BE REPAIRED AT CONTRACTOR'S SOLE EXPENSE. CONTRACT TIME SHALL NOT BE EXTENDED DUE TO DELAYS CAUSED BY UTILITY COORDINATION.

RECORD DOCUMENTS

These Record Documents have been prepared based on information provided by others. The Design Professional has not verified the accuracy and/or completeness of this information and shall not be responsible for any errors or omissions which may be incorporated herein as a result.

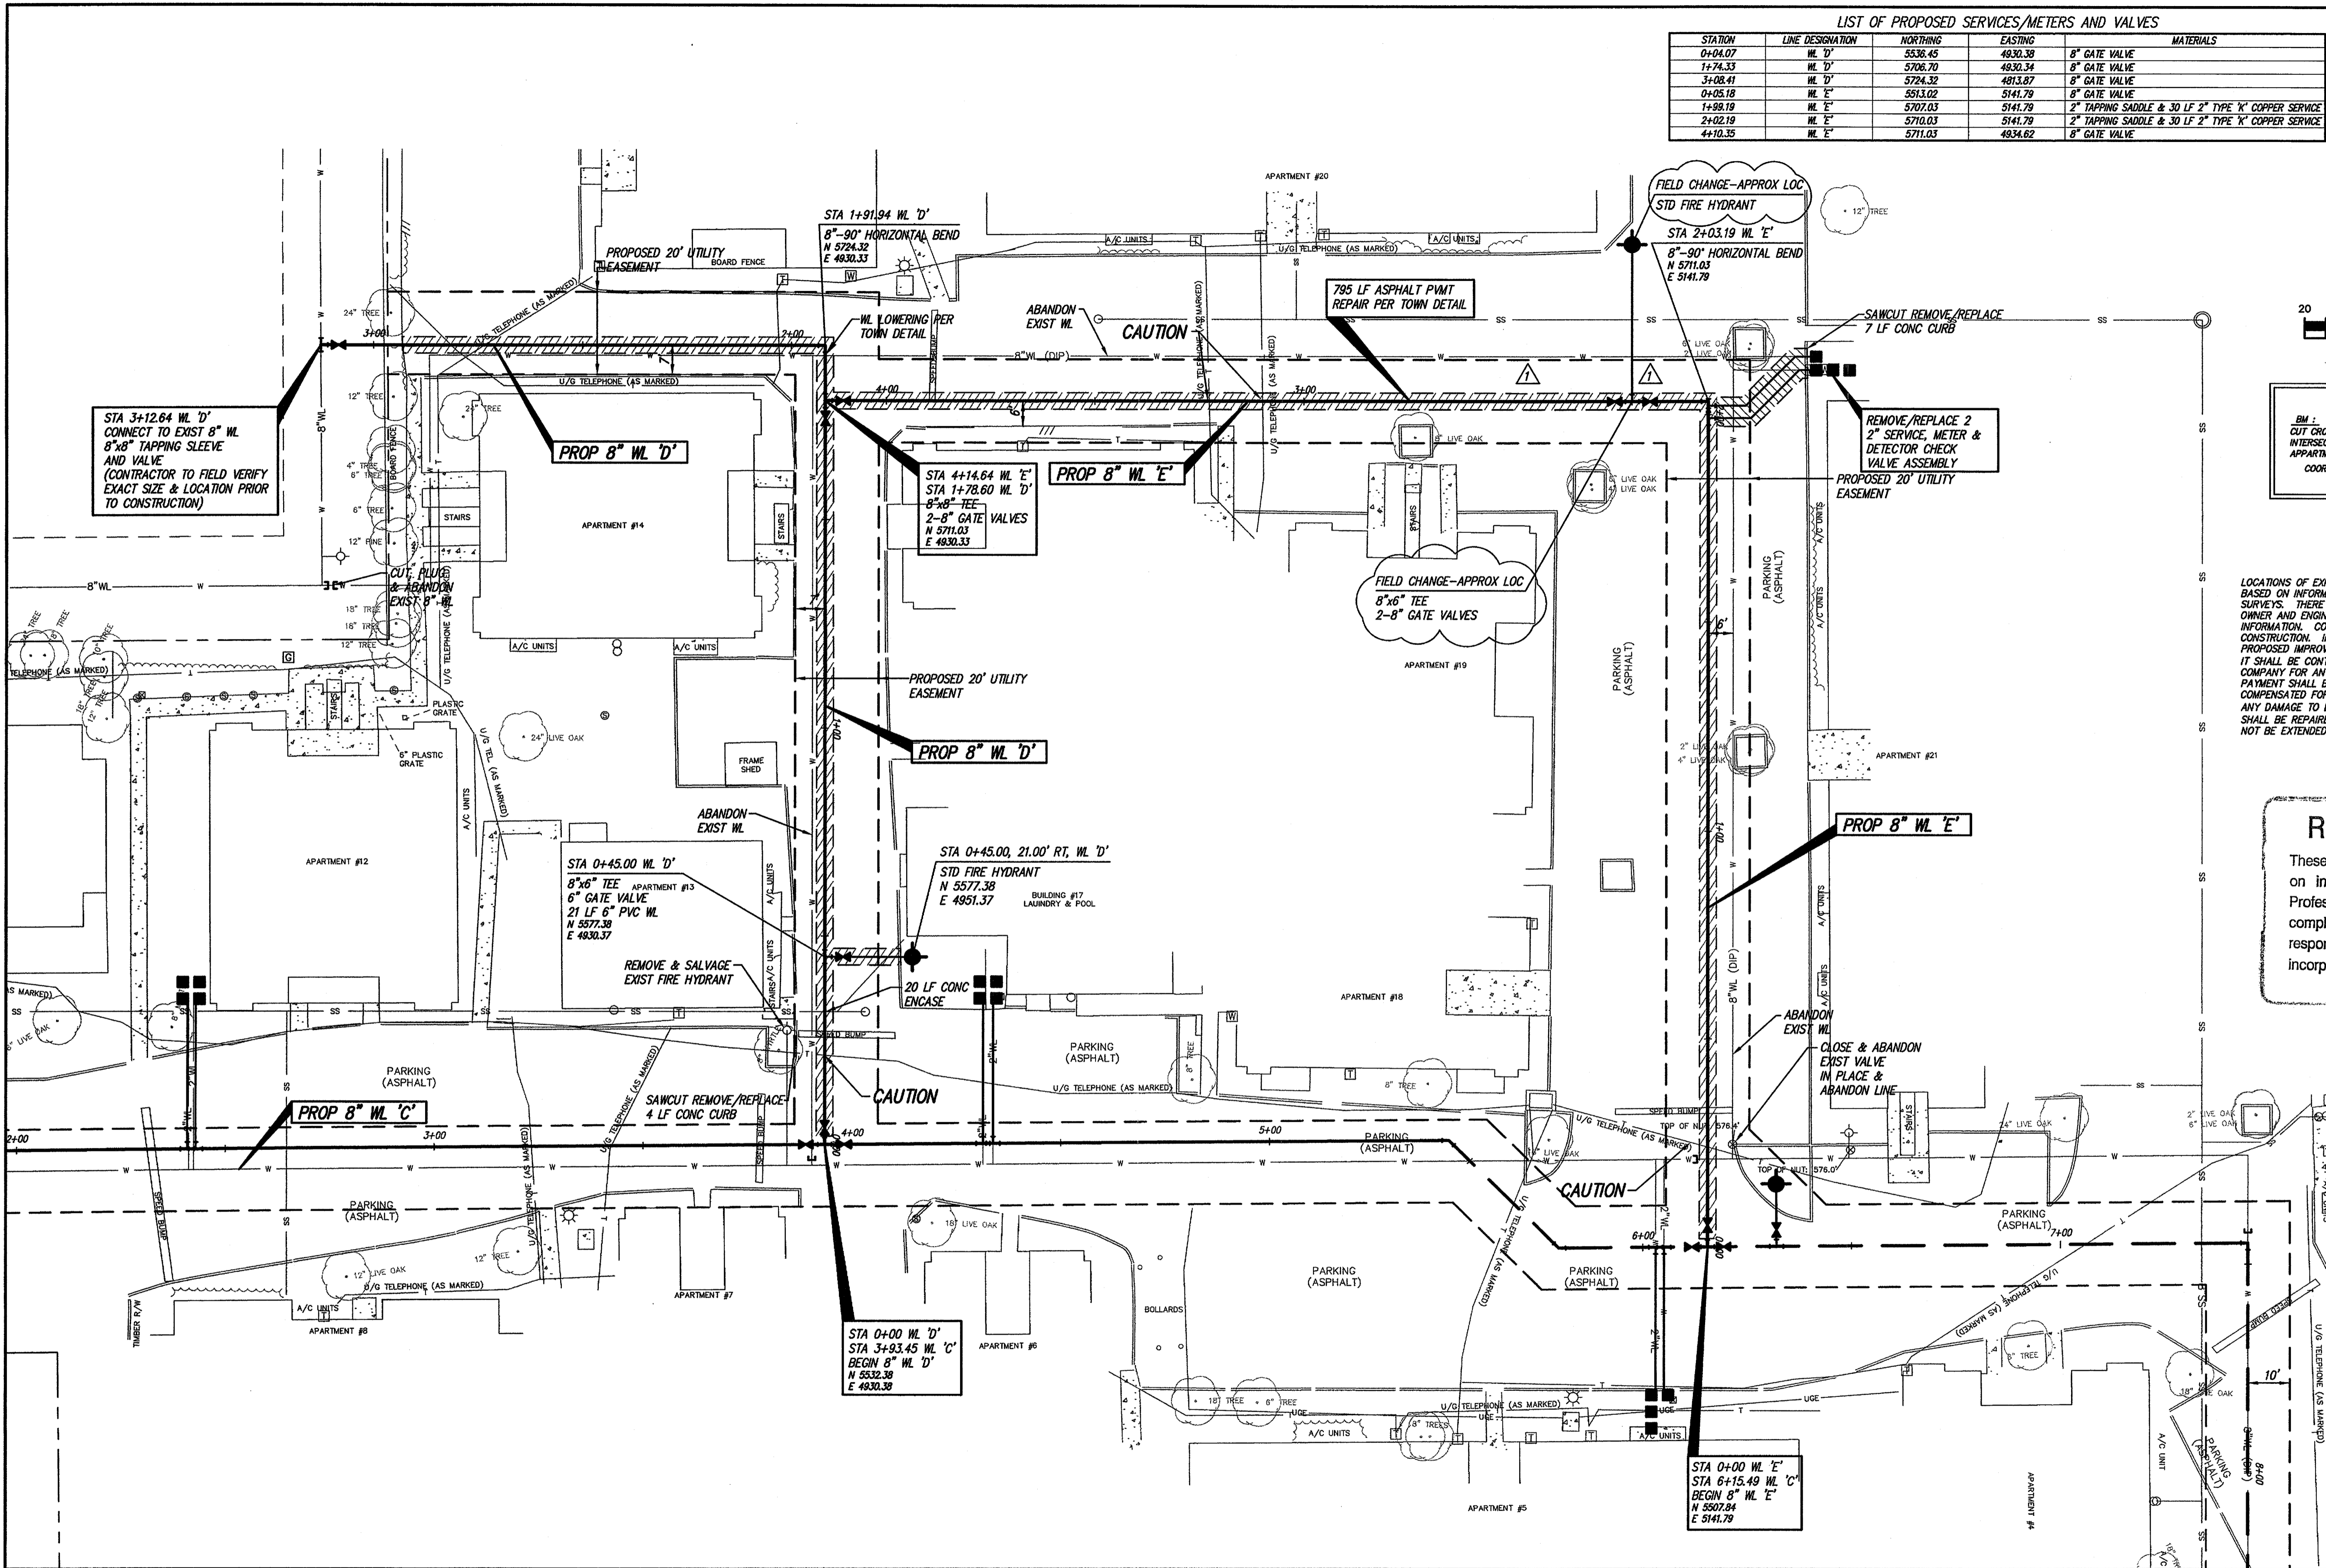


RECORD DRAWING MODIFICATION:	TNP	1/05
RELOCATED PROP. FH/WV PER		
FIELD CHANGE MARKUP.		
NO.	REVISION	BY DATE

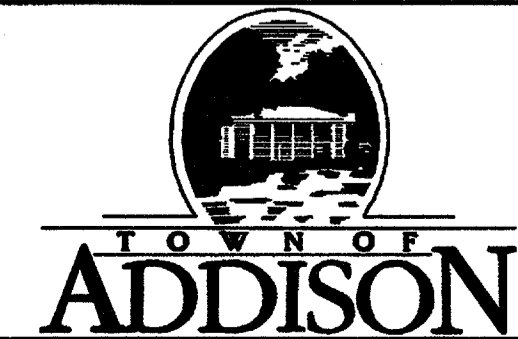

SCALE
HORIZ
1" = 20'
VERT
N/A
DATE
FEB 2004




TEAGUE NALL AND PERKINS
ENGINEERS • SURVEYORS • CONSULTANTS
1100 Macon Street Fort Worth, Texas 76102 (817) 336-5773
235 W. Hickory Street #100 Denton, Texas 76201 (940) 383-4177
12160 N. Abrams Road #508 Dallas, Texas 75243 (214) 461-9967

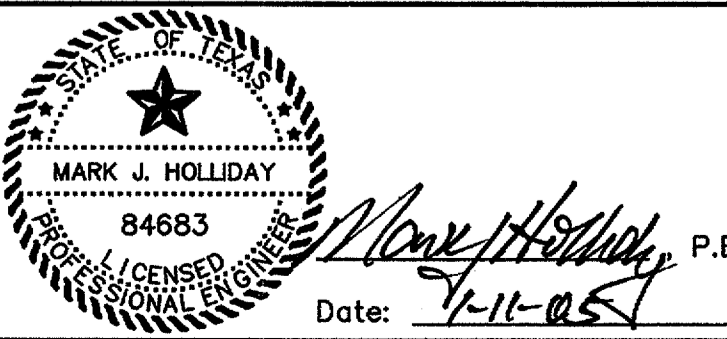


TOWN OF ADDISON, TEXAS
TALISKER APARTMENTS
WATER LINE IMPROVEMENTS
WATER LINE 'D' STA 0+00 TO 3+12.64
WATER LINE 'E' STA 0+00 TO 4+14.64

TNP PROJECT
ADD03169
SHEET
9
OF
11

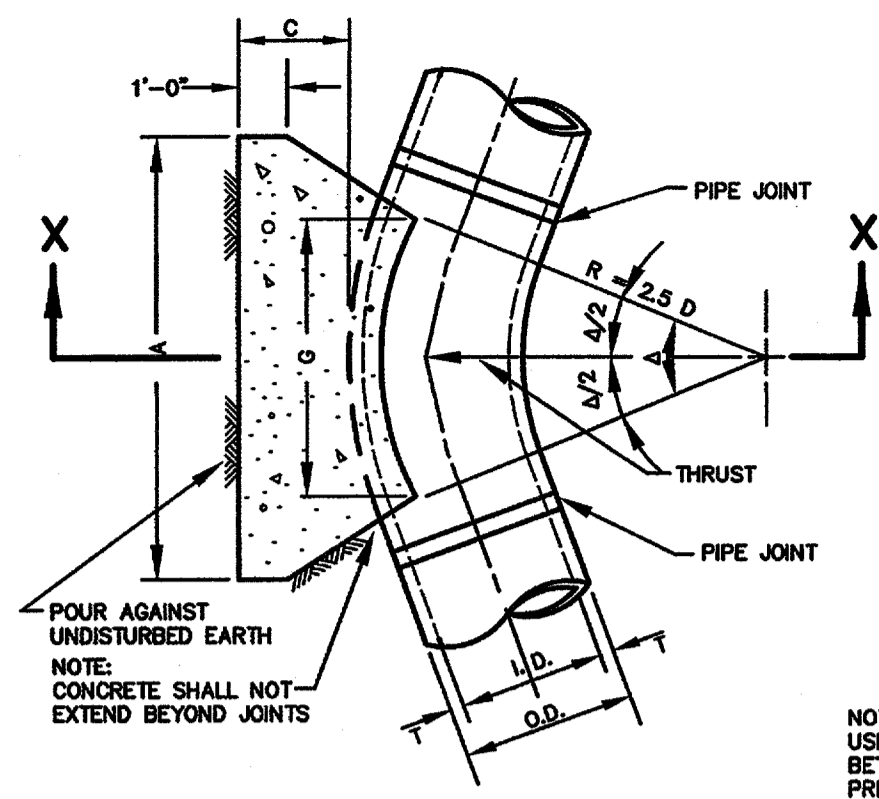


HORIZONTAL THRUST BLOCK
N.T.S.

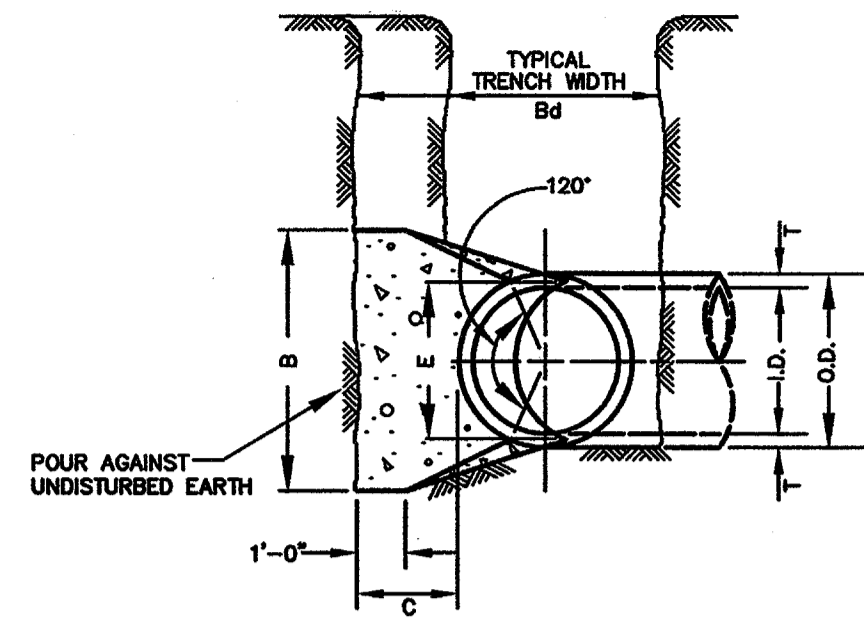


SECTION X-X
N.T.S.

I.D. (N)	Δ=11.25°				Δ=22.50°				Δ=45°				Δ=90°			
	C FT.	E FT.	G FT.	VOL. C.Y.	C FT.	E FT.	G FT.	VOL. C.Y.	C FT.	E FT.	G FT.	VOL. C.Y.	C FT.	E FT.	G FT.	VOL. C.Y.
6/8	1.5	0.9	0.4	0.1	0.8	1.5	1.5	0.1	1.5	2.0	2.0	0.2	2.7	5.0	1.5	0.4

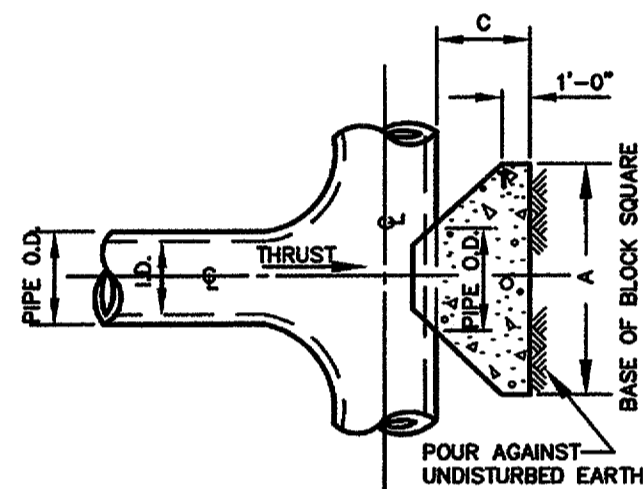

PLUG & TEE THRUST BLOCK


I.D. (N)	C FT.	A FT.	VOL. C.Y.
6/8	1.5	2.5	0.3
10/12	1.5	3.5	0.6
16/18	2.0	5.5	1.6
20	2.0	6.0	1.9
24	2.5	7.0	3.1
30	3.0	7.5	4.1

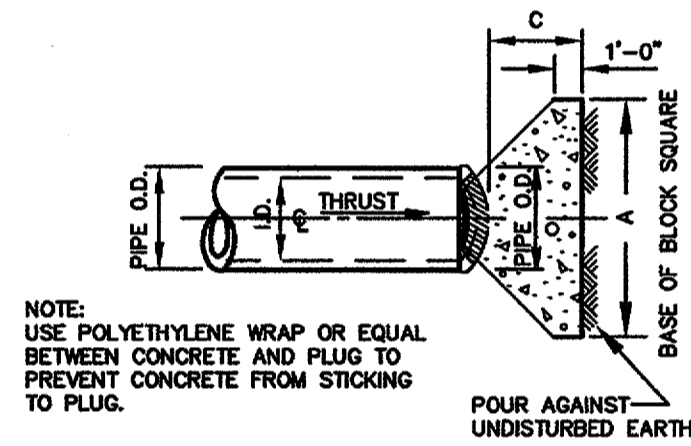


- GENERAL NOTES FOR ALL THRUST BLOCKS:**
1. ALL CALCULATIONS ARE BASED ON INTERNAL PRESSURE OF 200 P.S.I. (EXCEPT 30" I.D. - 150 P.S.I.).
 2. CONCRETE FOR BLOCKING SHALL BE CLASS B, 2000 P.S.I. CONCRETE.
 3. DIMENSIONS MAY BE VARIED AS REQUIRED BY FIELD CONDITIONS WHERE AND AS DIRECTED BY THE C.M. THE NET VOLUME OF CONCRETE BLOCKING SHALL NOT BE LESS THAN SHOWN IN TABLES.

PLAN OF TEE THRUST BLOCK
N.T.S.


PLAN OF PLUG THRUST BLOCK
N.T.S.

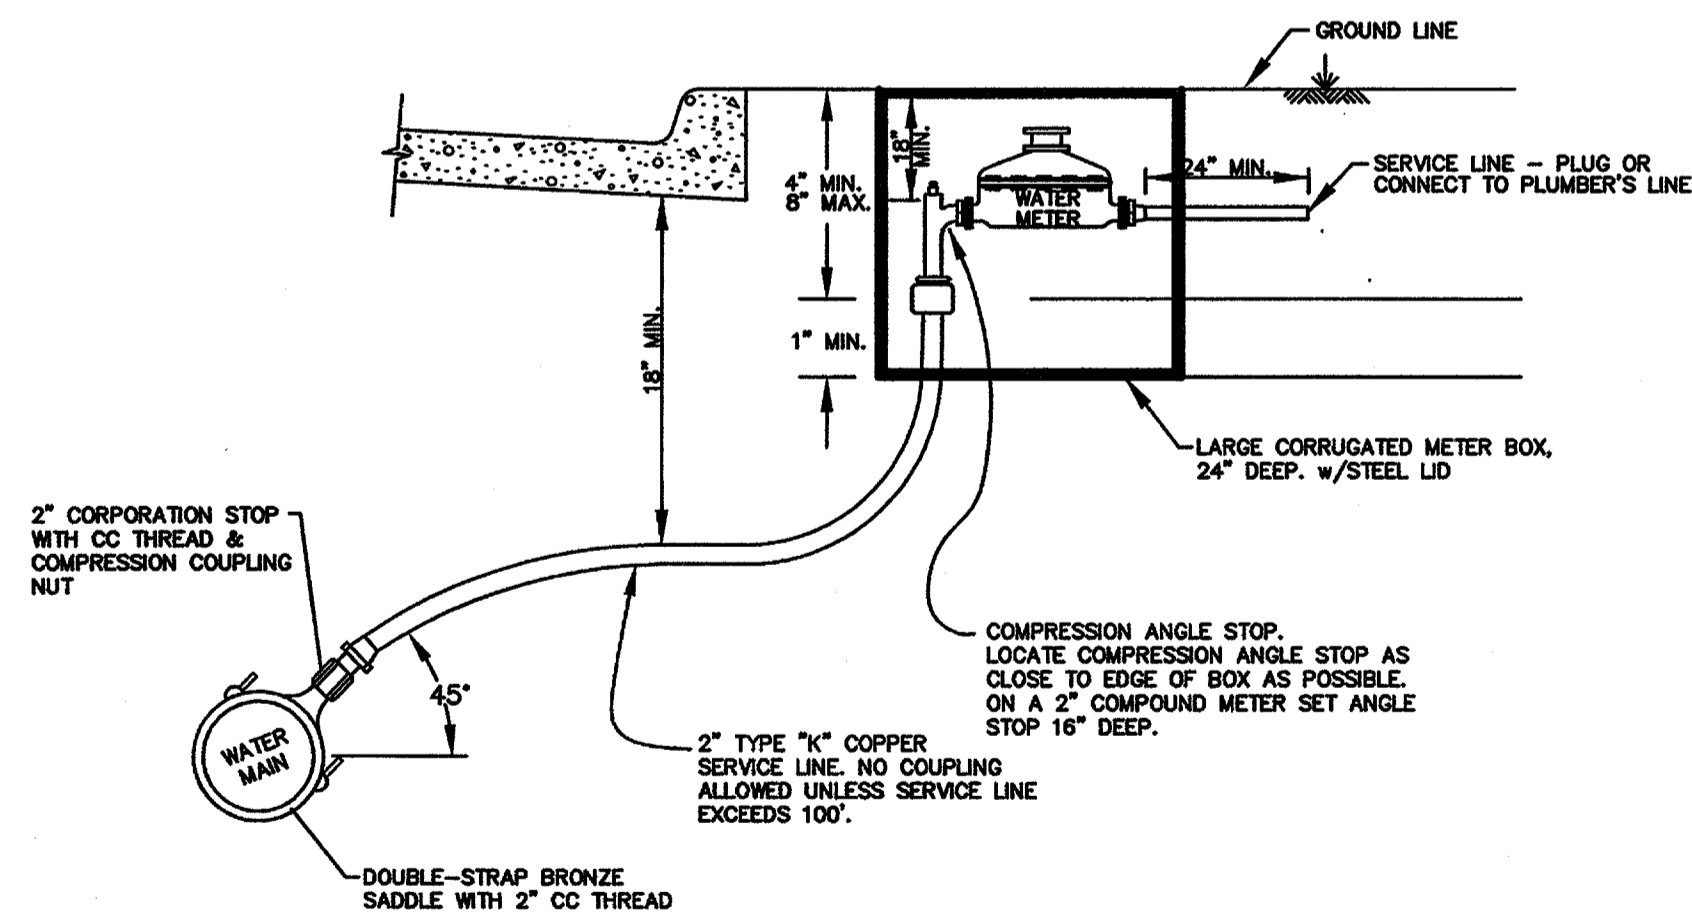

TYPICAL SERVICE CONNECTION WITH METER BOX
N.T.S.

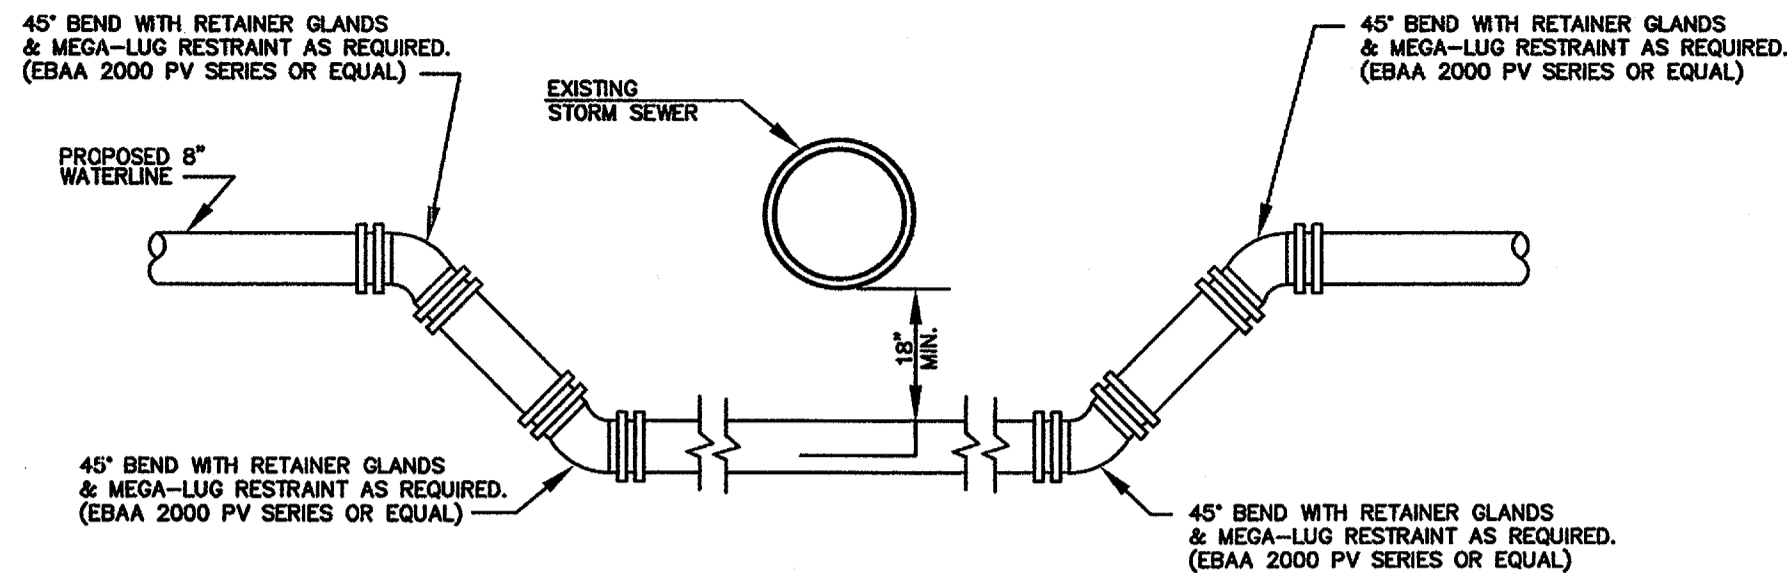


WATER LINE RELOCATION AT STORM SEWER CROSSING
TYPICAL SECTION
N.T.S.

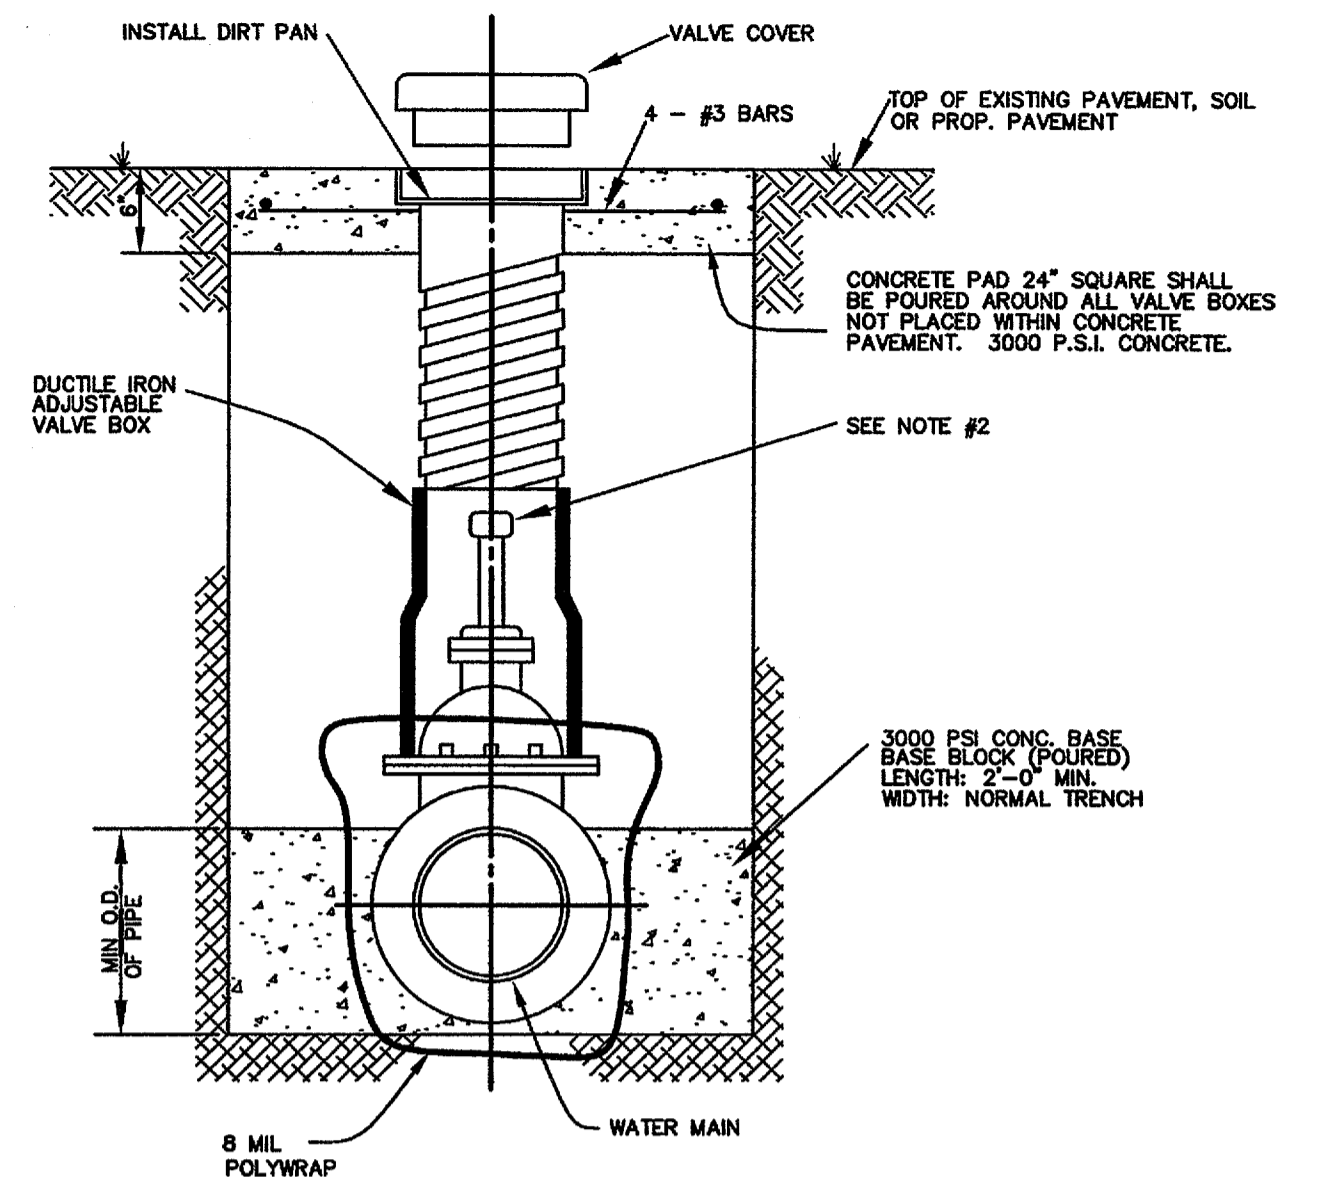

- NOTE:**
1. GATE VALVES SHALL BE IN ACCORDANCE WITH AWWA STANDARD C-509-80 OR LATEST THEREOF. ALL VALVES SHALL BE "MUELLER" OR EQUAL.
 2. A PERMANENTLY ATTACHED VALVE EXTENSION STEM SHALL BE REQUIRED FOR ANY VALVE WHOSE OPERATING NUT IS LOCATED IN EXCESS OF 4 FEET BELOW THE VALVE BOX. THIS EXTENSION SHALL BE OF SUFFICIENT LENGTH TO INSURE THAT ITS TOP IS WITHIN 4 FEET OF VALVE BOX LID. MANUFACTURED VALVE STACK DUCTILE IRON PIPE TO BE USED FOR EXTENSION GREATER THAN 4". BELL END OF STACK TO BE FITTED OVER VALVE, AND VALVE STACK IS TO BE POLYWRAPPED.
 3. VALVES SHALL BE OF DUCTILE IRON W/RUBBER ENCAPSULATED DISK. BOLTS SHALL BE STAINLESS STEEL OF SAME SIZE ON EACH VALVE.
 4. VALVE COVERS SHALL BE MARKED "WATER".

TYPICAL VALVE SETTING & BOX
N.T.S.

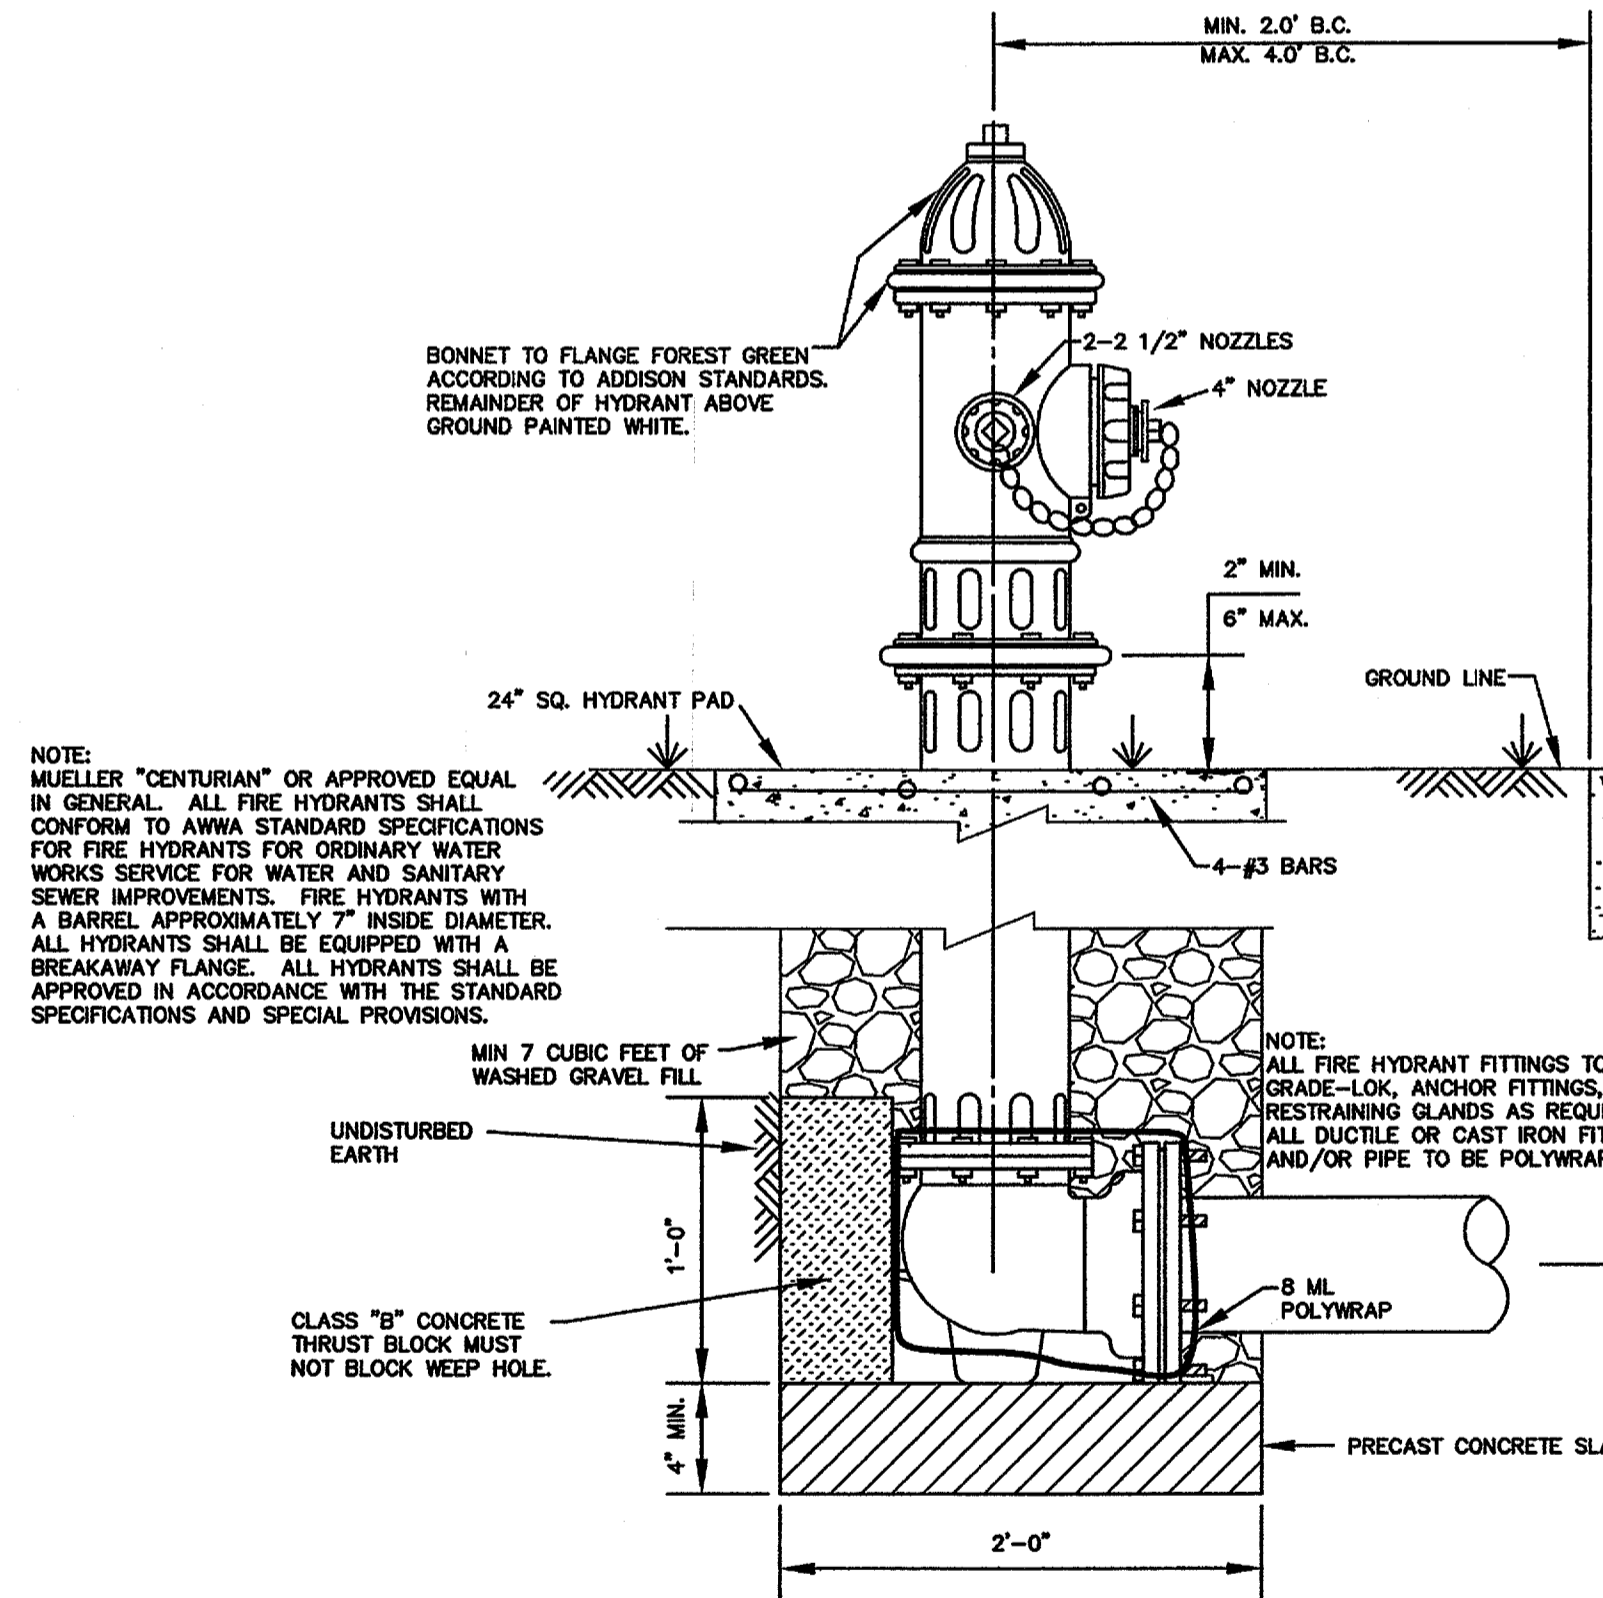

- NOTE:** MUELLER "CENTURIAN" OR APPROVED EQUAL IN GENERAL. ALL FIRE HYDRANTS SHALL CONFORM TO AWWA STANDARD SPECIFICATIONS FOR FIRE HYDRANTS FOR ORDINARY WATER WORKS SERVICE FOR WATER AND SANITARY SEWER IMPROVEMENTS. FIRE HYDRANTS WITH A BARREL APPROXIMATELY 7" INSIDE DIAMETER. ALL HYDRANTS SHALL BE EQUIPPED WITH A BREAKAWAY FLANGE. ALL HYDRANTS SHALL BE APPROVED IN ACCORDANCE WITH THE STANDARD SPECIFICATIONS AND SPECIAL PROVISIONS.

- NOTE:** ALL FIRE HYDRANT FITTINGS TO BE GRADE-LOK, ANCHOR FITTINGS, OR RESTRAINING GLANDS AS REQUIRED. ALL DUCTILE OR CAST IRON FITTINGS AND/OR PIPE TO BE POLYWRAPPED.

TYPICAL FIRE HYDRANT INSTALLATION
N.T.S.

RECORD DOCUMENTS

These Record Documents have been prepared based on information provided by others. The Design Professional has not verified the accuracy and/or completeness of this information and shall not be responsible for any errors or omissions which may be incorporated herein as a result.

NO.	REVISION	BY	DATE




SCALE
HORIZ N/A
VERT N/A
DATE
FEB 2004



TEAGUE NALL AND PERKINS
ENGINEERS • SURVEYORS • CONSULTANTS


1100 Macon Street Fort Worth, Texas 76102 (817) 336-5773
235 W. Hickory Street #100 Denton, Texas 76201 (940) 383-4177
12160 N. Abrams Road #508 Dallas, Texas 75243 (214) 461-9867

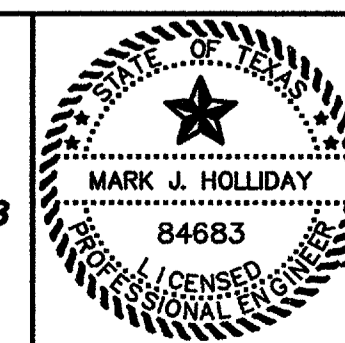


DATE: 2-9-04

TOWN OF ADDISON, TEXAS
TALISKER APARTMENTS
WATER LINE IMPROVEMENTS
MISCELLANEOUS DETAILS 1


TNP PROJECT
ADD03169
SHEET
10
OF
11

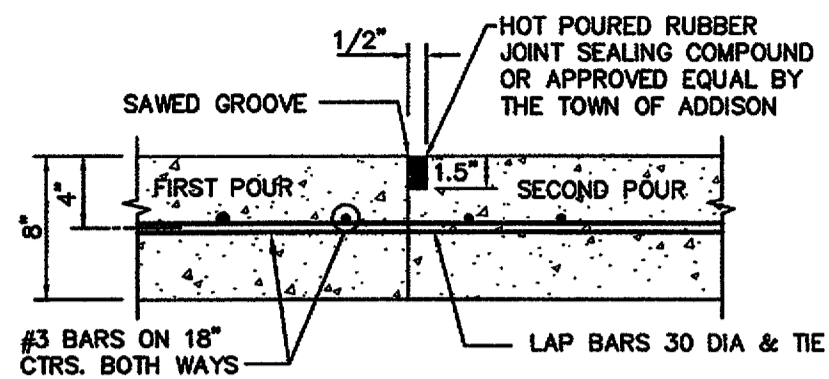


CONSTRUCTION JOINT
N.T.S.

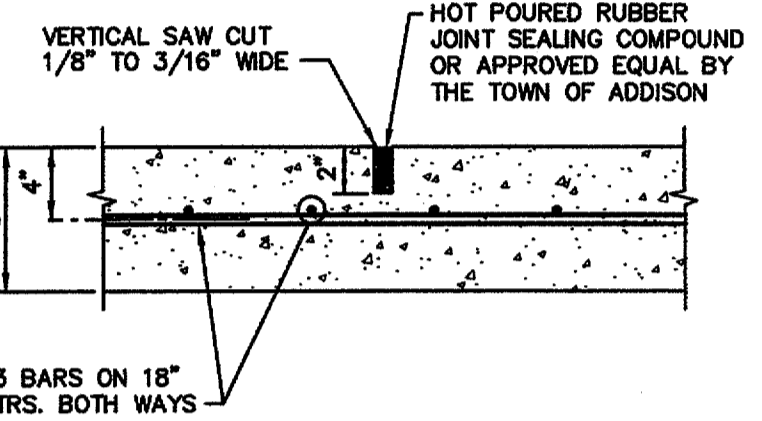

SAWED DUMMY JOINT
N.T.S.

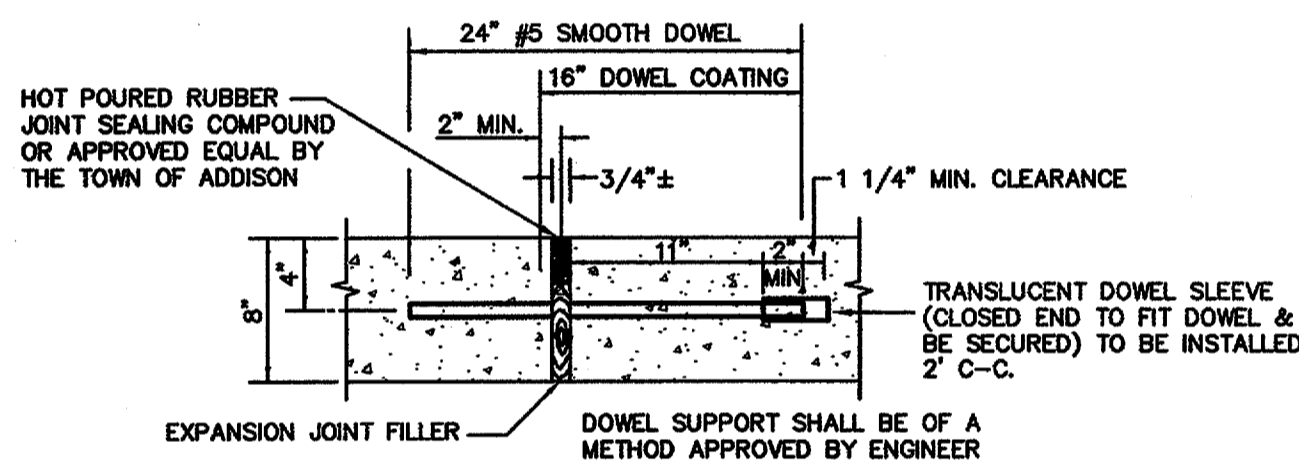


EXPANSION JOINT
N.T.S.

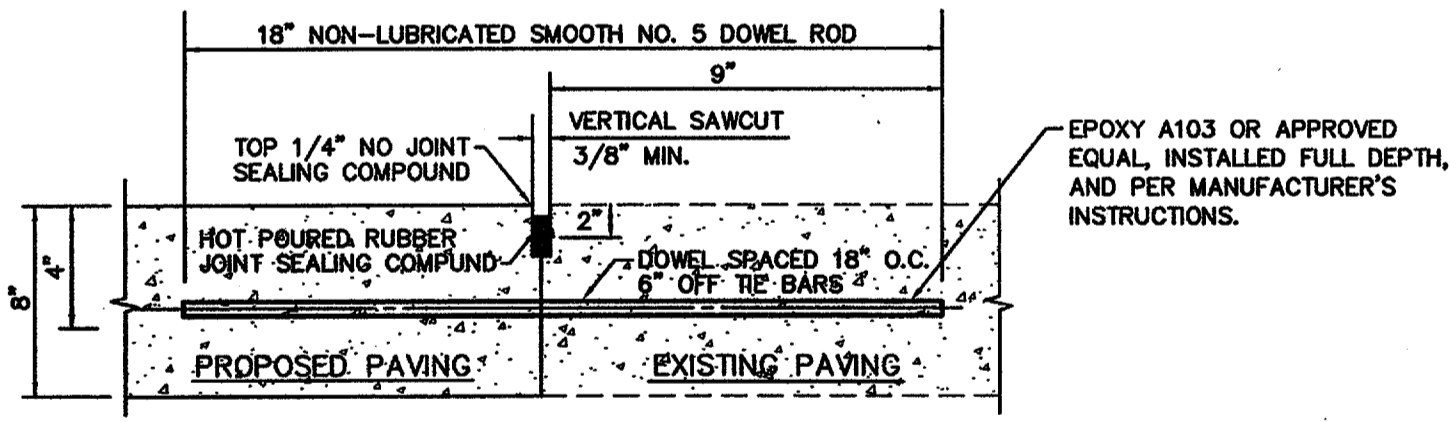


CONNECTION TO EXISTING PAVEMENT
N.T.S.


PAVEMENT/JOINT DETAILS

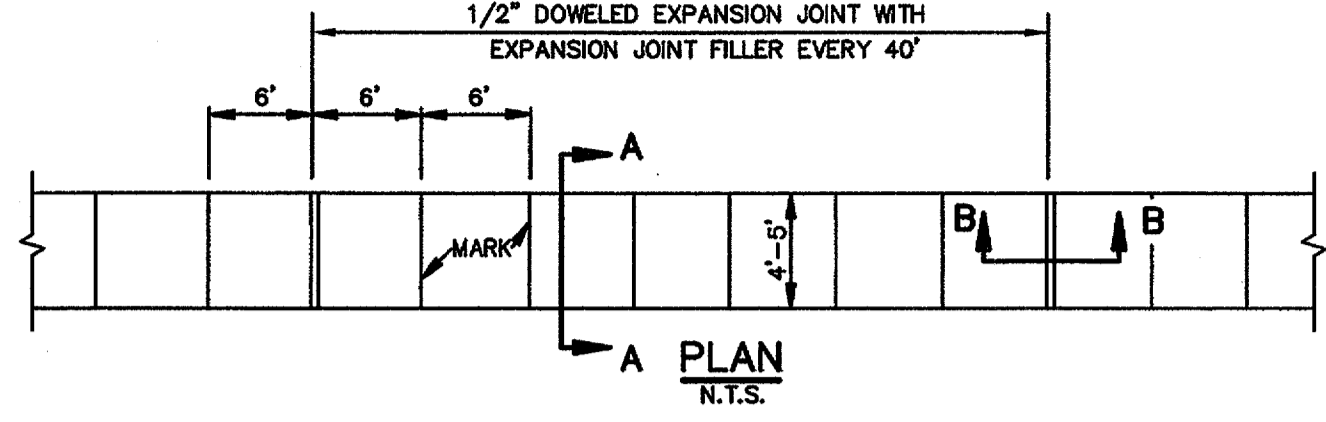

PLAN
N.T.S.

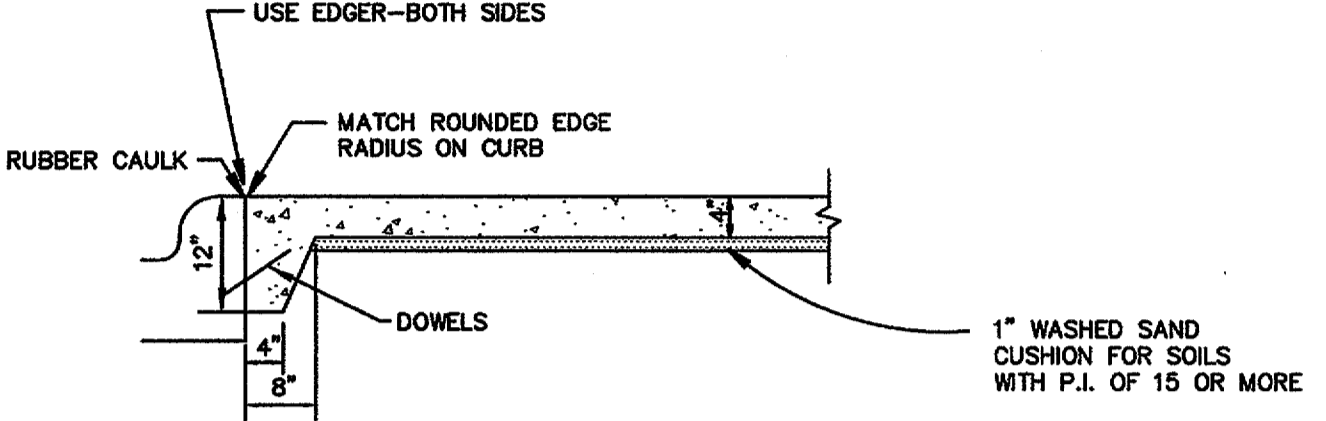

JOINT LUG DETAIL FOR MEDIAN PAVEMENT OR SIDEWALK ADJACENT TO CURB
N.T.S.

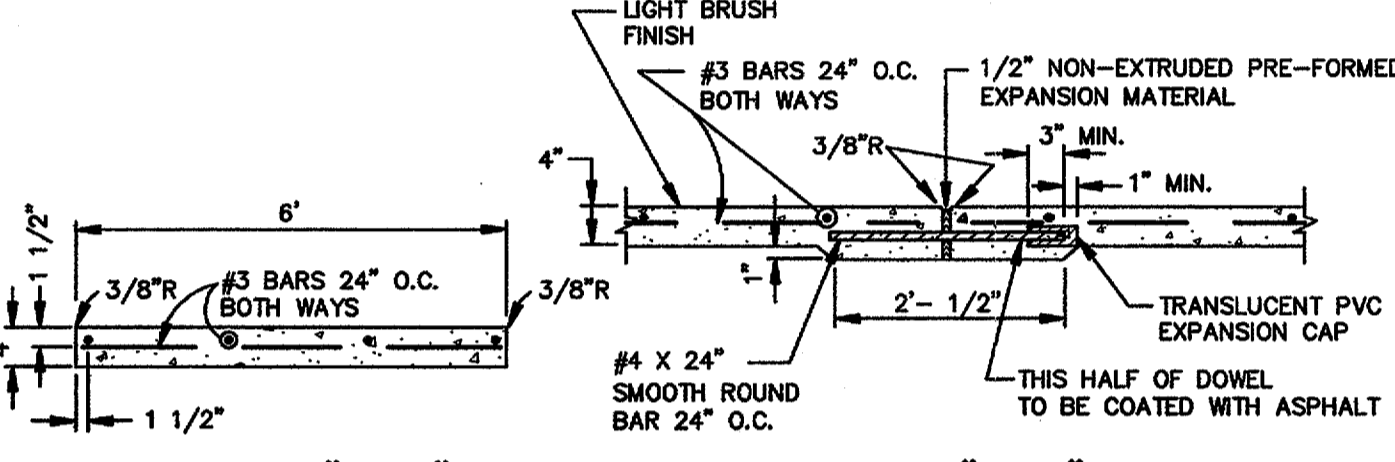


SECTION "A-A"
N.T.S.


SECTION "B-B"
N.T.S.

- NOTE:**
- CROSS SLOPE OF SIDEWALK SHALL BE $\pm 1/4$ " PER FT. MIN. TO $\pm 3/8$ " PER FT. MAX.
 - OTHER THAN 6'-0" SIDEWALK WIDTH MAY BE SPECIFIED BY OWNER.
 - SIDEWALK SHALL BE CLASS "A" CONCRETE UNLESS OTHERWISE SPECIFIED BY OWNER.

SIDEWALK DETAILS
N.T.S.

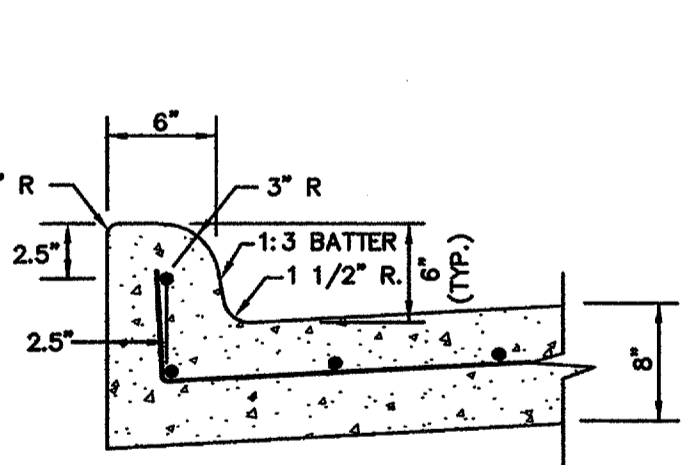


INTEGRAL CURB
N.T.S.

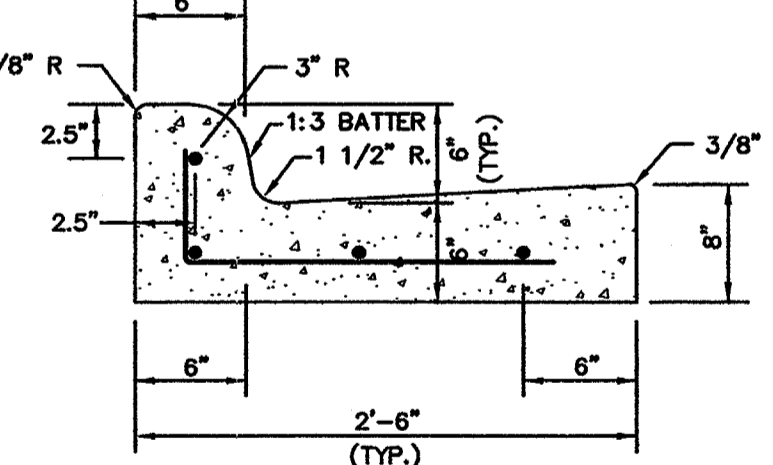


SEPARATE CURB & GUTTER
N.T.S.

- NOTES:**
- REINFORCEMENT SHALL BE NO. 4 BARS.
 - CONCRETE SHALL BE CLASS "C".
 - "CF" IS 6" UNLESS OTHERWISE SPECIFIED.
 - ALL CURBS ARE CONSTRUCTED OF PORTLAND CEMENT CONCRETE UNLESS OTHERWISE SHOWN.
 - GRADE SHALL BE MEASURED AT BACK OF CURB.

CURB DETAILS
N.T.S.

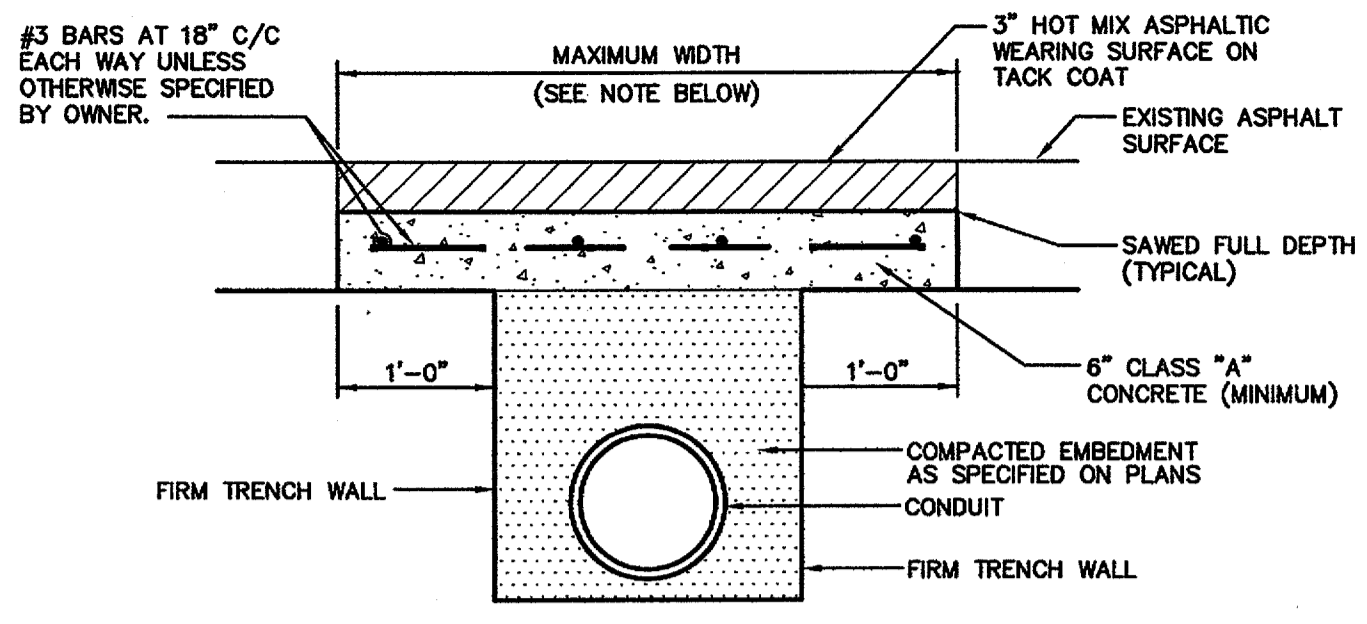


ASPHALT PAVEMENT
N.T.S.

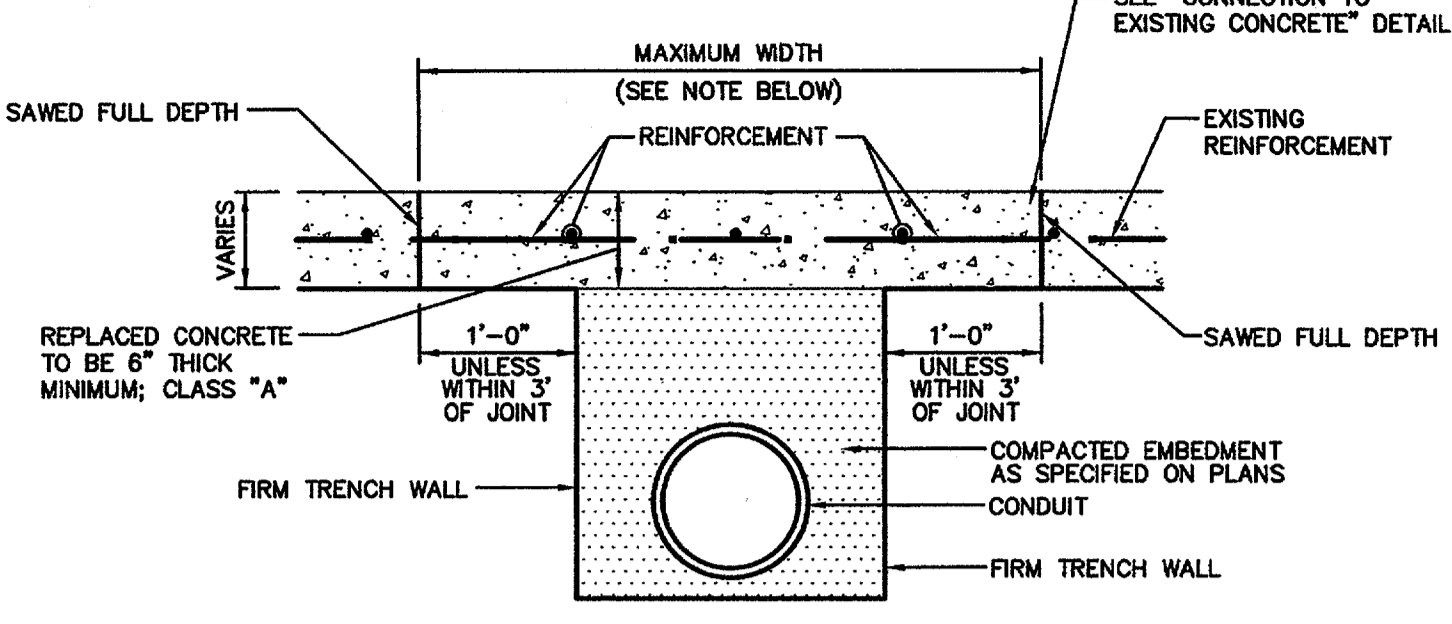

CONCRETE PAVEMENT
N.T.S.

- NOTES:**
- PAYMENT TO THE CONTRACTOR FOR REPLACEMENT OF PAVEMENT AND/OR DRIVEWAYS WILL BE BASED ON ACTUAL MEASUREMENTS UP TO A MAXIMUM WIDTH EQUAL TO THE SPECIFIED MAXIMUM TRENCH WIDTH (PER STD. SPEC. ITEM 6.2.) PLUS 2 FEET. ANY EXISTING PAVEMENT DAMAGED OR REMOVED IN EXCESS OF THE MAXIMUM LIMITS SHALL BE AT THE EXPENSE OF THE CONTRACTOR.
 - ALL SAW CUTS SHALL BE FULL DEPTH. CONTRACTOR SHALL DRILL AND EPOXY GROUT 18" x #4 SMOOTH DOWEL 9" INTO EXISTING CONCRETE. REINFORCEMENT SHALL BE #3 BARS AT 18" C/C EACH WAY UNLESS OTHERWISE SPECIFIED BY THE OWNER.


PAVEMENT/DRIVEWAY REPAIR DETAILS
N.T.S.

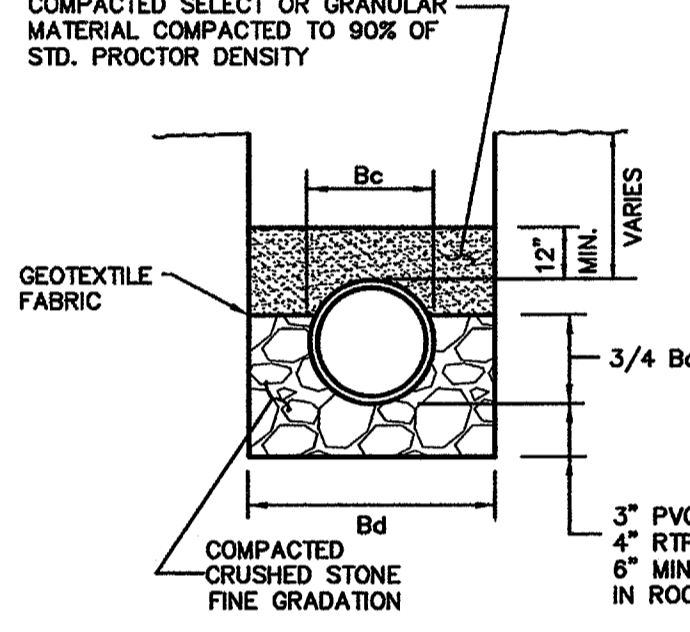

CLASS "B-2"
N.T.S.

- NOTES:**
- Bc = OUTSIDE DIAMETER OF PIPE
 - Bd = TRENCH WIDTH

EMBEDMENT/ENCASEMENT DETAILS
N.T.S.

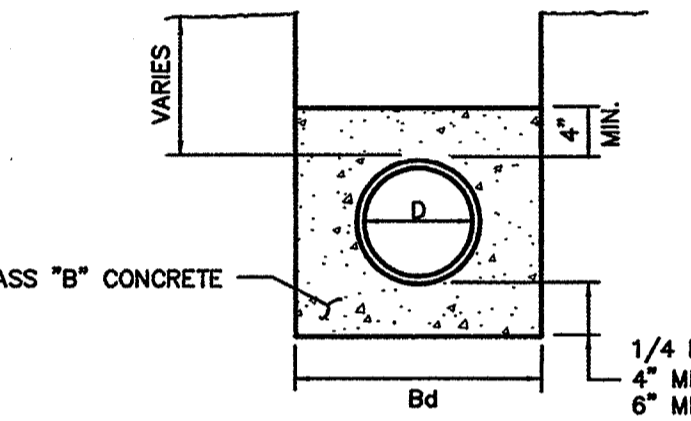


CONCRETE ENCASEMENT
N.T.S.


- NOTES:**
- D = INSIDE DIAMETER OF PIPE
 - Bd = TRENCH WIDTH

RECORD DOCUMENTS


These Record Documents have been prepared based on information provided by others. The Design Professional has not verified the accuracy and/or completeness of this information and shall not be responsible for any errors or omissions which may be incorporated herein as a result.

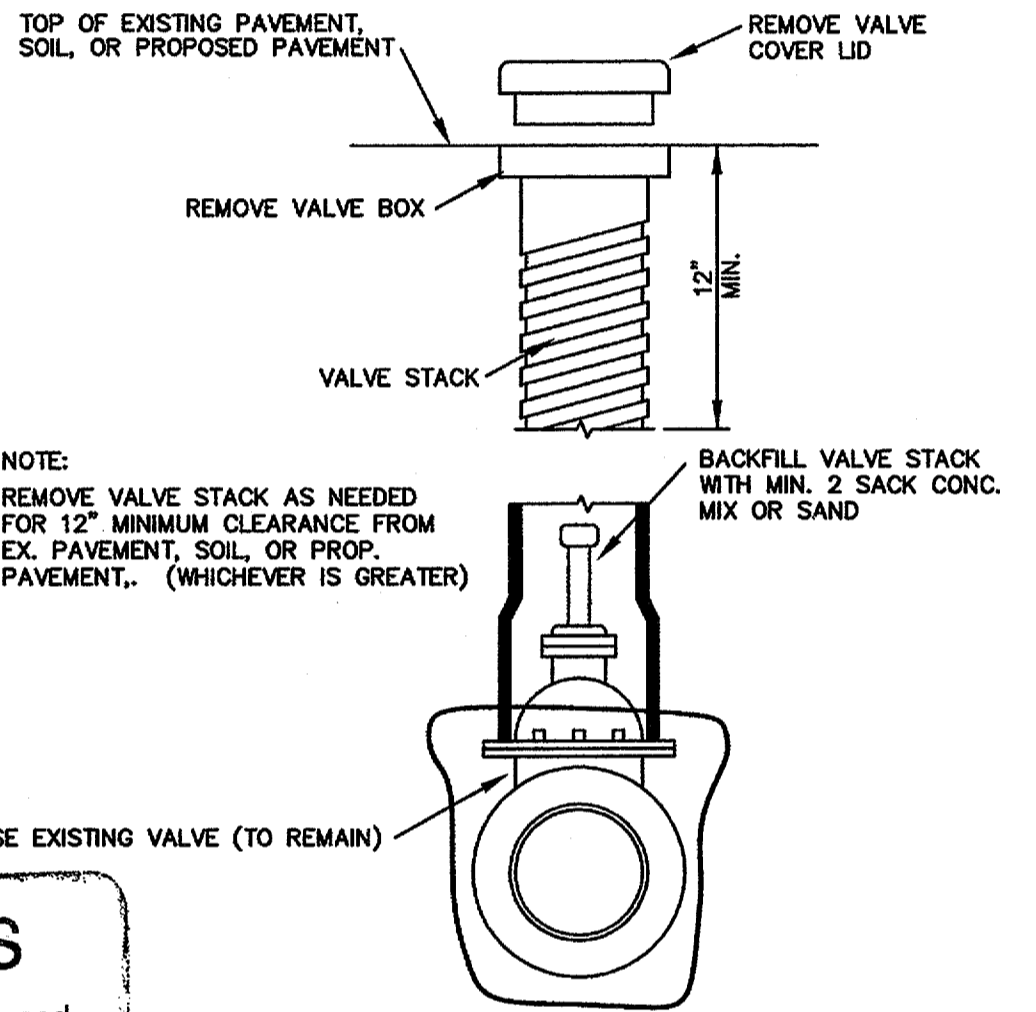

WATER VALVE ABANDONMENT DETAIL
N.T.S.

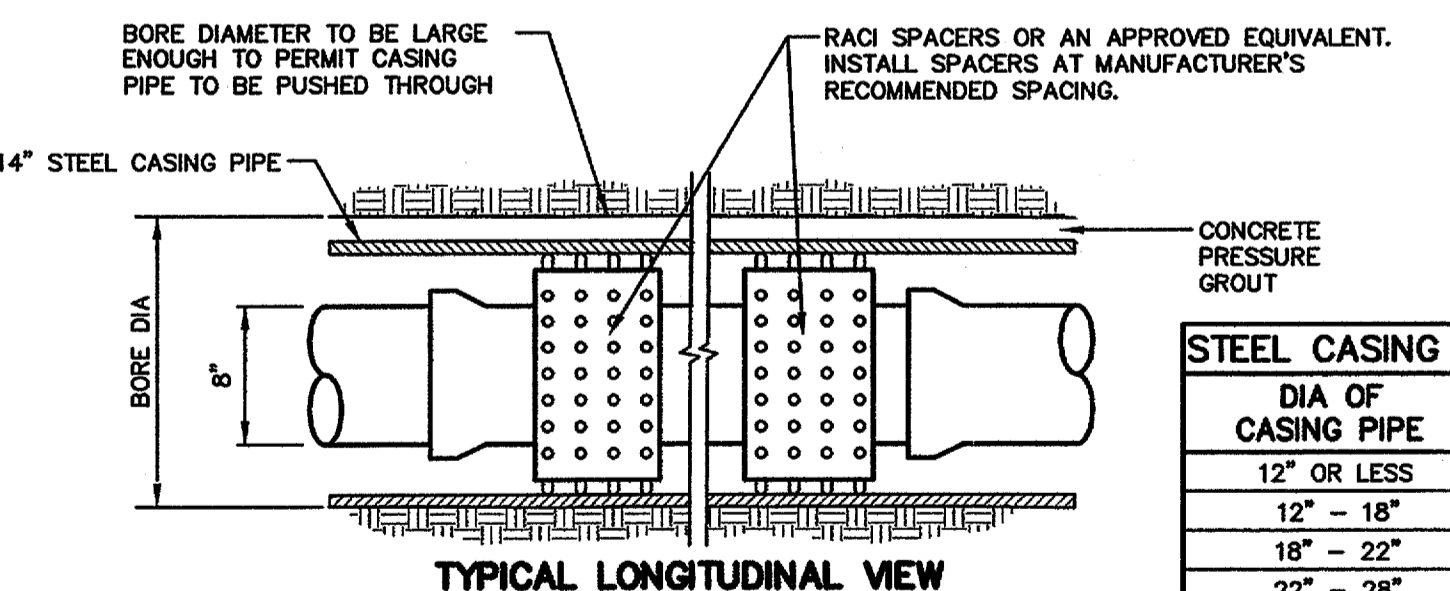

TYPICAL LONGITUDINAL VIEW

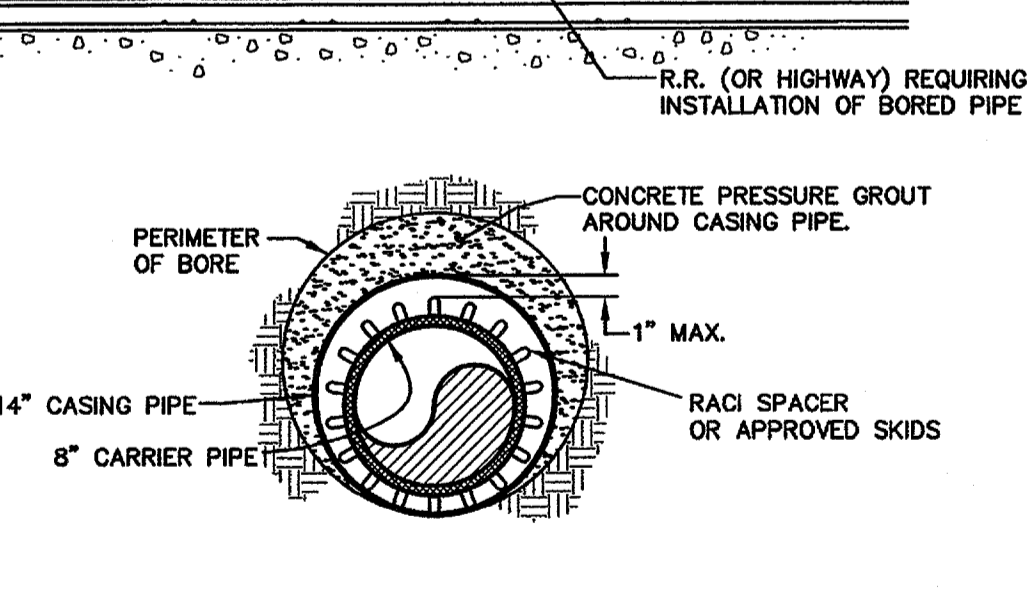


TYPICAL END VIEW

BORE AND CASING ROADWAY CROSSING DETAIL
N.T.S.

STEEL CASING WALL THICKNESS	
DIA OF CASING PIPE	MIN THICKNESS
12" OR LESS	0.25"
12" - 18"	0.3125"
18" - 22"	0.4375"
22" - 28"	0.4375"

CASING PIPES SHALL BE SMOOTH STEEL PIPES WITH A MIN YIELD STRENGTH OF 35,000psi

NO.	REVISION	BY	DATE

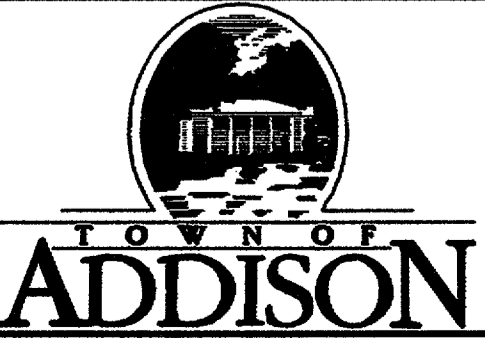

SCALE	N/A
HORIZ	N/A
VERT	N/A
DATE	FEB 2004




TEAGUE NALL AND PERKINS
ENGINEERS • SURVEYORS • CONSULTANTS

1100 Macon Street Fort Worth, Texas 76102 (817) 338-5773

235 W. Hickory Street #100 Denton, Texas 76201 (940) 383-4177

12180 N. Abrams Road #508 Dallas, Texas 75243 (214) 461-9867

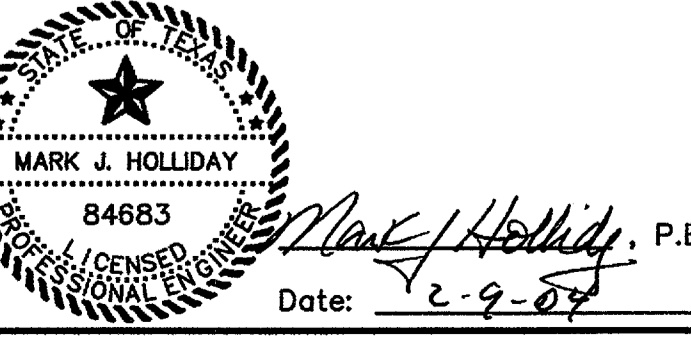

TOWN OF ADDISON, TEXAS
TALISKER APARTMENTS
WATER LINE IMPROVEMENTS
MISCELLANEOUS DETAILS 2

TNP PROJECT ADD03169
SHEET 11 OF 11