


TOWN OF ADDISON, TEXAS

CONSTRUCTION PLANS FOR

TALISKER APARTMENTS WATER LINE IMPROVEMENTS

ADDISON, TEXAS

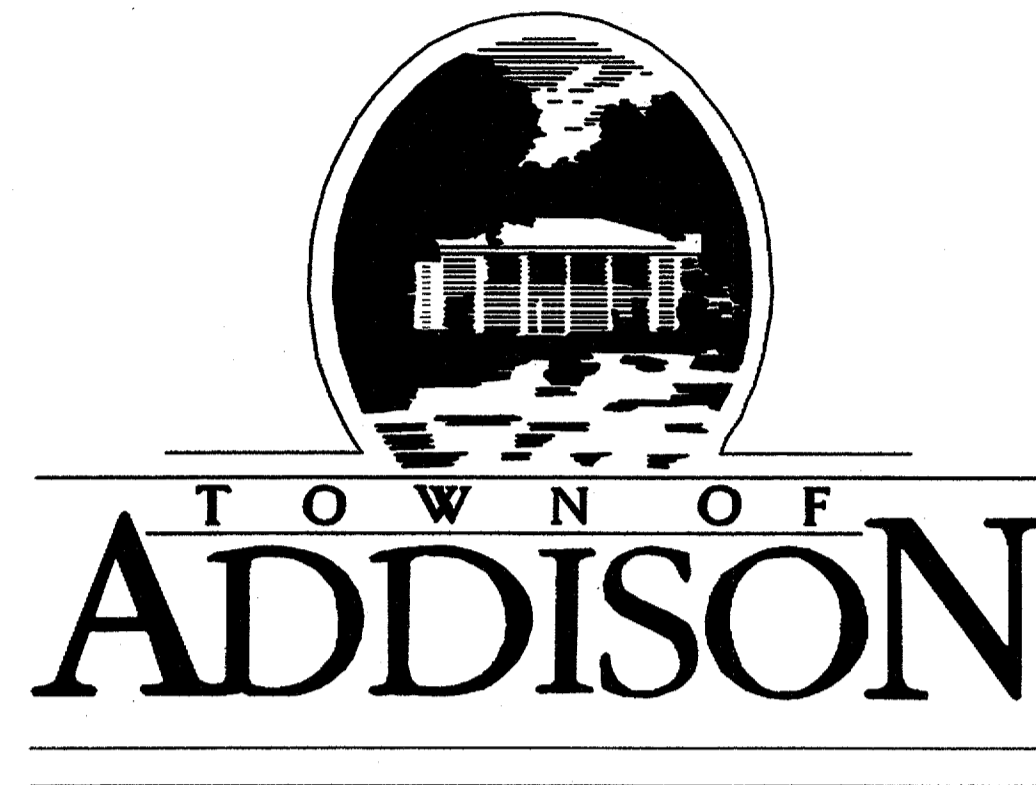

MAYOR
R. SCOTT WHEELER


MAYOR PRO-TEM
FREDRIC M. SILVER

DEPUTY MAYOR PRO-TEM
JOE CHOW

COUNCIL MEMBERS
DIANE MALLORY
GLYNDA TURNER
JIMMY NIEMANN
GREGORY S. HIRSCH

CITY MANAGER
RON WHITEHEAD


PUBLIC WORKS DIRECTOR
MICHAEL MURPHY, P.E.

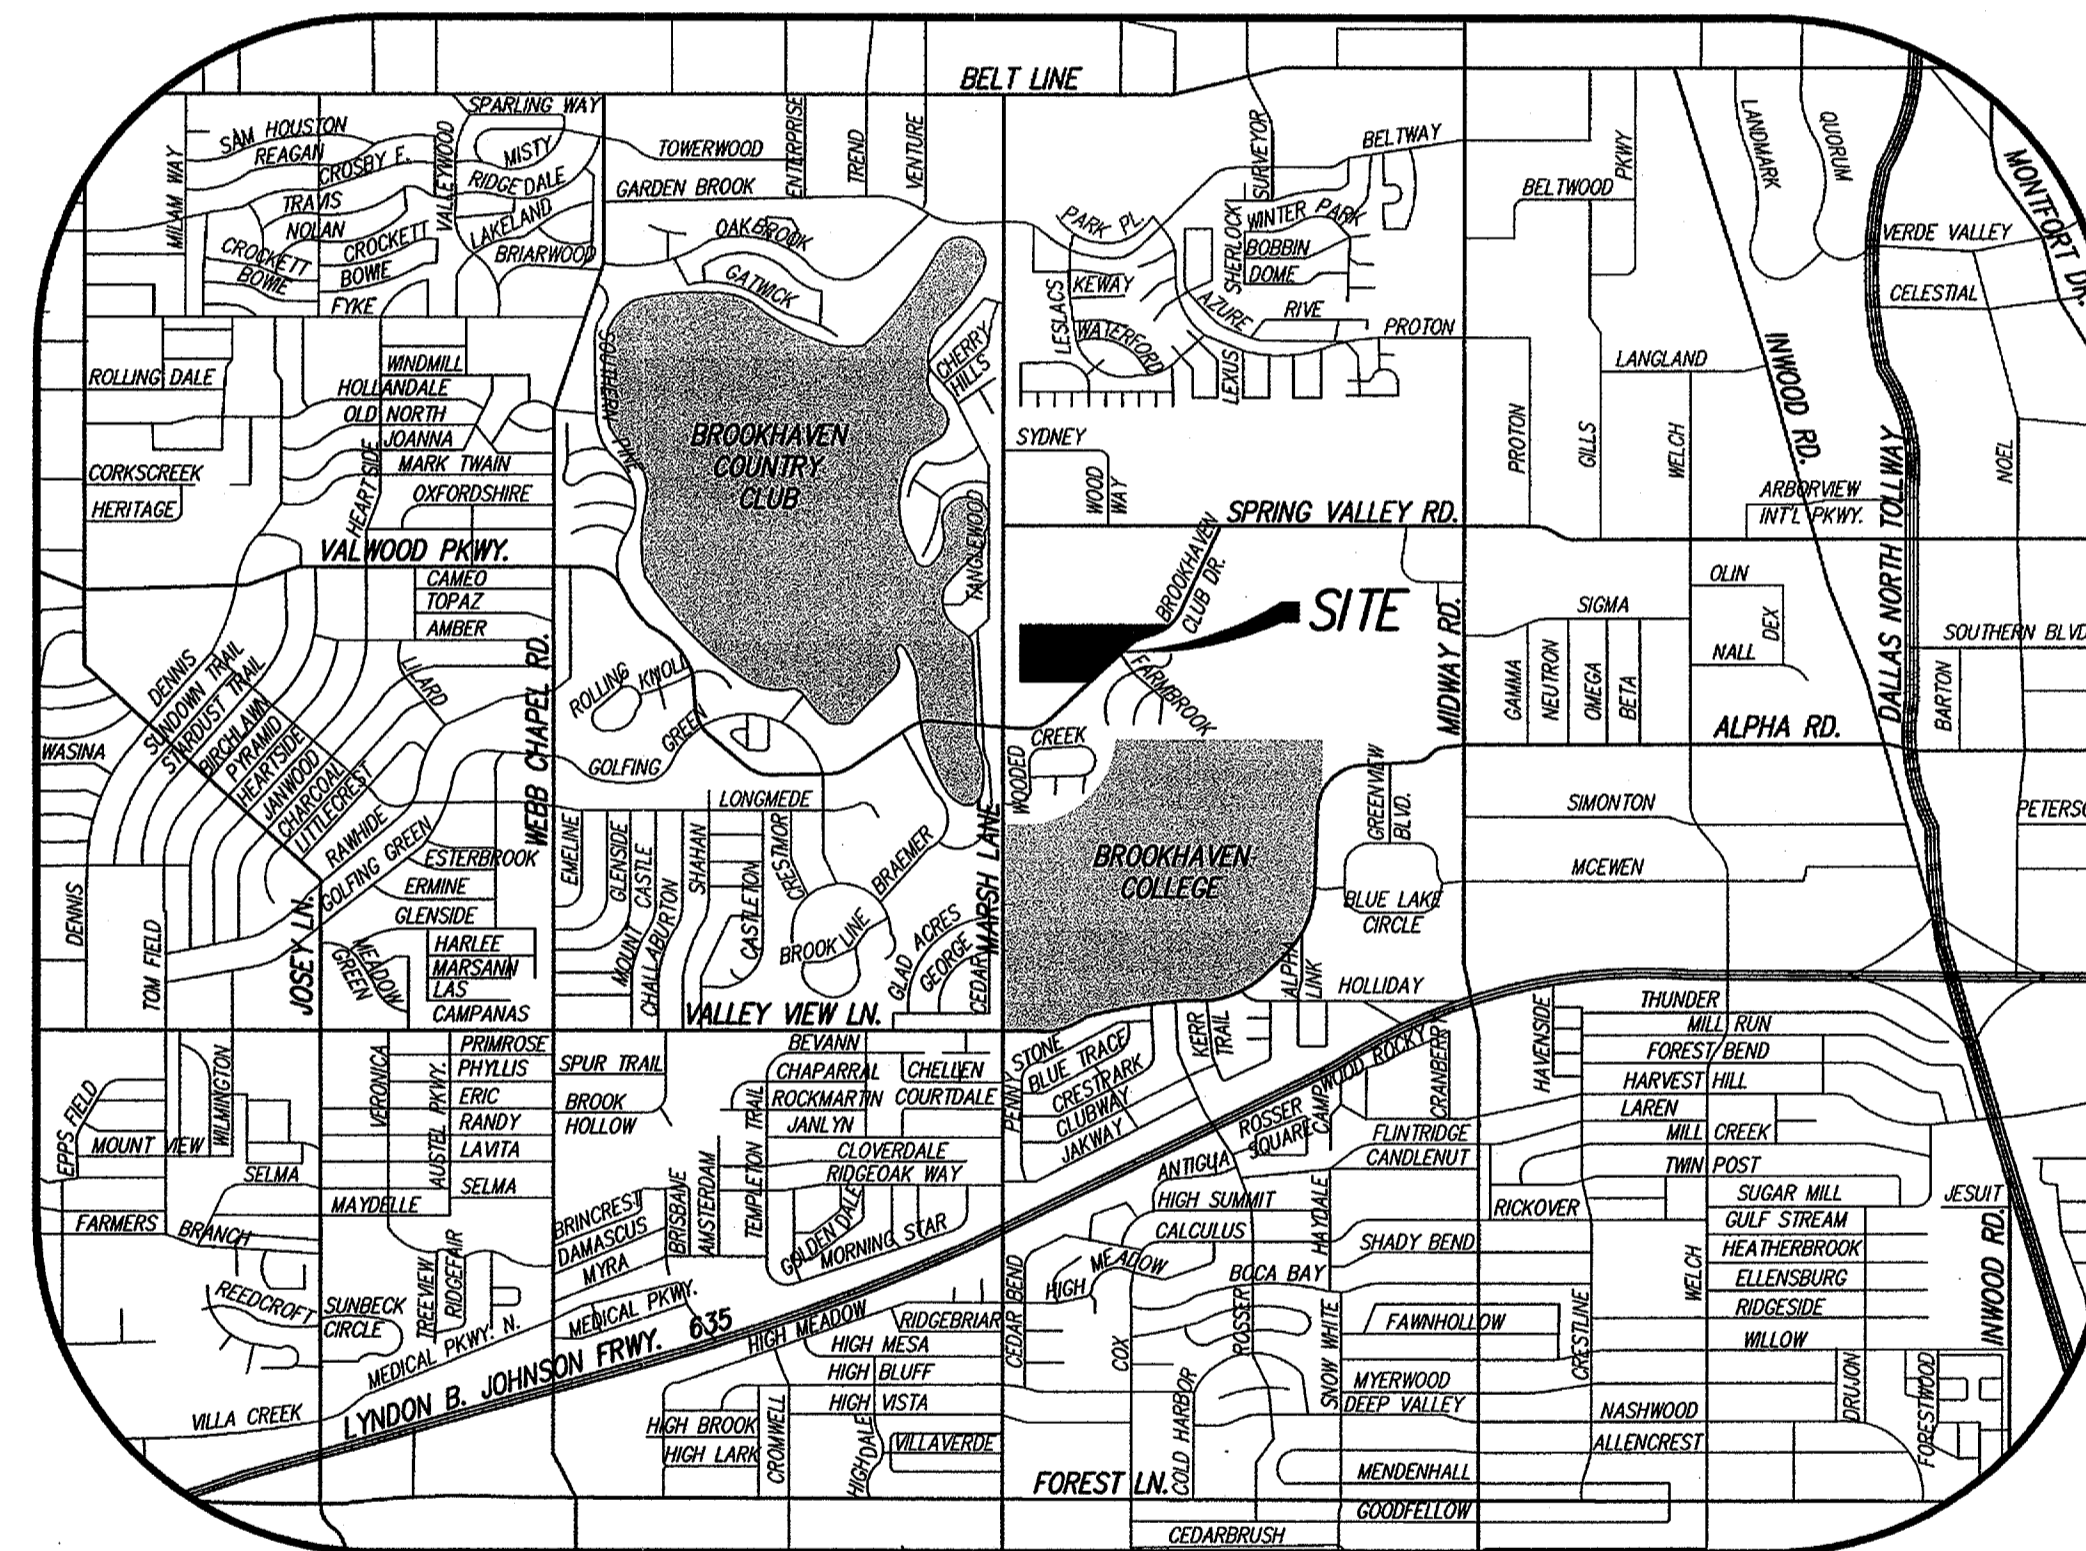

LOCATION MAP

FEBRUARY 2004

TTP INC.
TEAGUE NALL AND PERKINS
ENGINEERS • SURVEYORS • CONSULTANTS
WWW.TNP-ONLINE.COM

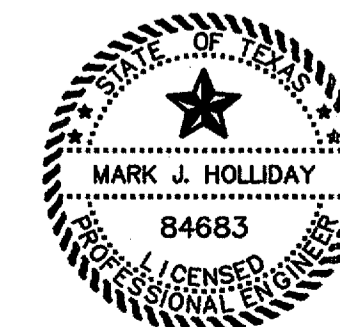

Date: 2-9-04

SHEET INDEX

SHEET NO.	DESCRIPTION
1	COVER SHEET
2	GENERAL NOTES & LEGEND
3	PROJECT LAYOUT SHEET
4	PROJECT CONSTRUCTION SEQUENCING
5	WATER LINE 'A' PLAN & PROFILE - STA 0+00 TO STA 1+78.64
6	WATER LINE 'B' PLAN - STA 0+00 TO STA 8+00
7	WATER LINE 'B' PLAN - STA 8+00 TO STA 10+79.34 WATER LINE 'C' PLAN - STA 0+00 TO STA 5+00
8	WATER LINE 'C' PLAN - STA 5+00 TO STA 14+01.04
9	WATER LINE 'D' PLAN - STA 0+00 TO STA 3+12.64 WATER LINE 'E' PLAN - STA 0+00 TO STA 4+14.64
10	MISCELLANEOUS DETAILS 1
11	MISCELLANEOUS DETAILS 2

RECORD DOCUMENTS

These Record Documents have been prepared based on information provided by others. The Design Professional has not verified the accuracy and/or completeness of this information and shall not be responsible for any errors or omissions which may be incorporated herein as a result.

ENGINEER

TEAGUE NALL AND PERKINS, INC.
12160 NORTH ABRAMS ROAD #508
DALLAS, TEXAS 75243
(214) 461-9867
CONTACT: MARK J. HOLLIDAY, P.E.

AI-3
Plan: AI-3
Region: Cont. Set.

Record Document (2 copies)

TNP PROJ #: ADD-03169

TALISKER APARTMENTS WATER LINE IMPROVEMENTS

TNP PROJ #: ADD-03169

AI-3