

END 8" WL 'B' - STA 10+79.34
 BEGIN 8" WL 'C' - STA 0+00
 N 5228.44 E 4536.94

END 8" WL 'D' - STA 3+12.64
 CONNECT TO EXIST 8" WL
 N 5724.32 E 4808.63

END 8" WL 'E' - STA 4+14.64
 8" WL 'D' - STA 1+78.65
 N 5711.03 E 4930.53

BEGIN 8" WL 'D' - STA 0+00
 8" WL 'C' - STA 3+93.45
 N 5632.38 E 4830.38

PROP 8" C909 CL150
 WATER LINE 'E'

PROP 8" C909 CL150
 WATER LINE 'B'

BEGIN 8" WL 'E' - STA 0+00
 8" WL 'C' - STA 6+15.49
 N 5507.84 E 5141.79

PROP 8" C909 CL150
 WATER LINE 'C'

PROPOSED 20"
 UTILITY ESMT

PROP 8" C909 CL150
 WATER LINE 'B'

PROP 8" C909 CL150
 WATER LINE 'C'

PROP 8" C909 CL150
 WATER LINE 'C'

3925 Brookhaven Club
 A-520 Pg. 822 Tr. 45
 Devdos Limited Partnership
 Volume 2002185 Page 4334

PROP 8" C909 CL150
 WATER LINE 'B'

END WL 'A' - STA 1+78.64
 BEGIN WL 'B' - STA 0+00
 END WL 'C' - STA 14+01.04
 N 4933.34 E 5046.58

PROP 12" C909 CL150
 WITH 24" CASING
 WATER LINE 'A'

BEGIN 12" WL 'A' - STA 0+00
 CONNECT TO EXIST 8" WL
 N 4818.96 E 5182.11



14110 Marsh
 Brookhaven Village Shopping Center
 Mustang Brookhaven S/C, Ltd.
 Volume 94129 Page 111

20' U.E. (Plat. 88225/4789)

Access & Utility Easement (75245/651)

Access & Utility Easement (75245/651)

45' Water Easmt. (Plat. 77233/443)

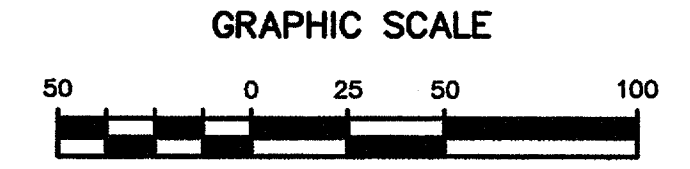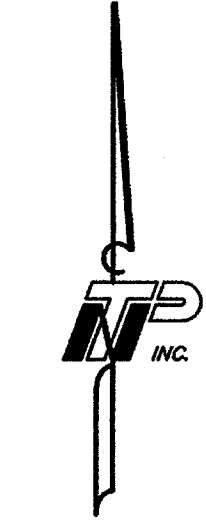


BENCHMARK
 BM :
 CUT CROSS SET IN THE TOP AT THE SOUTHEAST SIDEWALK
 INTERSECTION ON THE EAST SIDE OF THE FIRE LANE OPPOSITE
 APARTMENT BUILDING #24
 COORDINATES: N 5258.29 E 4562.25 ELEVATION: 570.84

4015 Brookhaven Club
 The Pier
 75 Pier No. 2, L.P.
 Volume 94147 Page 195

CAUTION!!
 EXISTING UTILITIES
 LOCATIONS OF EXISTING UTILITIES SHOWN ON THESE PLANS ARE APPROXIMATE
 BASED ON INFORMATION PROVIDED BY THE OWNERS OF THE UTILITIES AND FIELD
 SURVEYS. THERE MAY ALSO BE EXISTING UTILITIES THAT ARE NOT SHOWN. THE
 OWNER AND ENGINEER SHALL NOT BE RESPONSIBLE FOR THE ACCURACY OF THIS
 INFORMATION. CONTRACTOR SHALL LOCATE ALL UTILITIES PRIOR TO BEGINNING
 CONSTRUCTION. IF A CONFLICT IS DISCOVERED BETWEEN EXISTING UTILITIES AND
 PROPOSED IMPROVEMENTS, CONTRACTOR SHALL NOTIFY ENGINEER IMMEDIATELY.
 IT SHALL BE CONTRACTOR'S SOLE RESPONSIBILITY TO COORDINATE WITH UTILITY
 COMPANY FOR ANY NECESSARY RELOCATION OF FACILITIES AND NO SEPARATE
 PAYMENT SHALL BE MADE. ADDITIONALLY, CONTRACTOR SHALL NOT BE
 COMPENSATED FOR DELAYS OR REMOVALIZATION DUE TO UTILITY COORDINATION.
 ANY DAMAGE TO EXISTING UTILITIES CAUSED BY CONTRACTOR'S OPERATIONS SHALL
 BE REPAIRED AT CONTRACTOR'S SOLE EXPENSE. CONTRACT TIME SHALL
 NOT BE EXTENDED DUE TO DELAYS CAUSED BY UTILITY COORDINATION.

RECORD DOCUMENT
 These Record Documents have been prepared
 on information provided by others. The
 Professional has not verified the accuracy and
 completeness of this information and shall not be
 responsible for any errors or omissions which may be
 incorporated herein as a result.


NO.	REVISION	BY	DATE

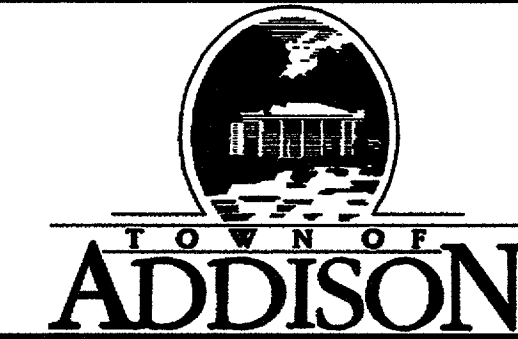

SCALE
 HORIZ
 1" = 50'
 VERT
 N/A
 DATE
 FEB 2004



TEAGUE NALL AND PERKINS
 ENGINEERS • SURVEYORS • CONSULTANTS
 1100 Macon Street Fort Worth, Texas 76102 (817) 336-5773
 235 W. Hickory Street #100 Denton, Texas 76201 (940) 383-4177
 12160 N. Abrams Road #508 Dallas, Texas 75243 (214) 461-9867

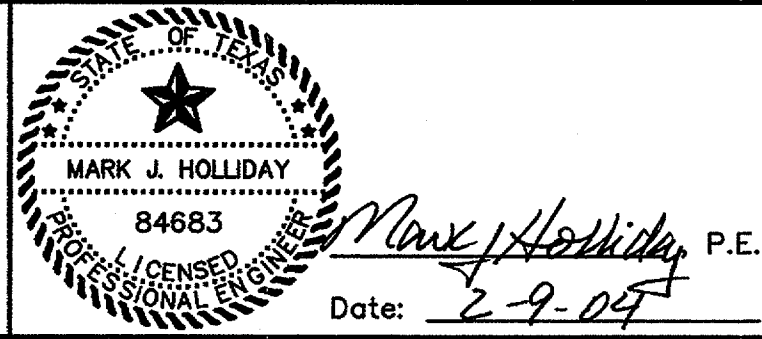

TOWN OF ADDISON, TEXAS
 TALISKER APARTMENTS
WATER LINE IMPROVEMENTS
 PROJECT LAYOUT

TNP PROJECT
 ADD03169
 SHEET
3
 OF
 11