
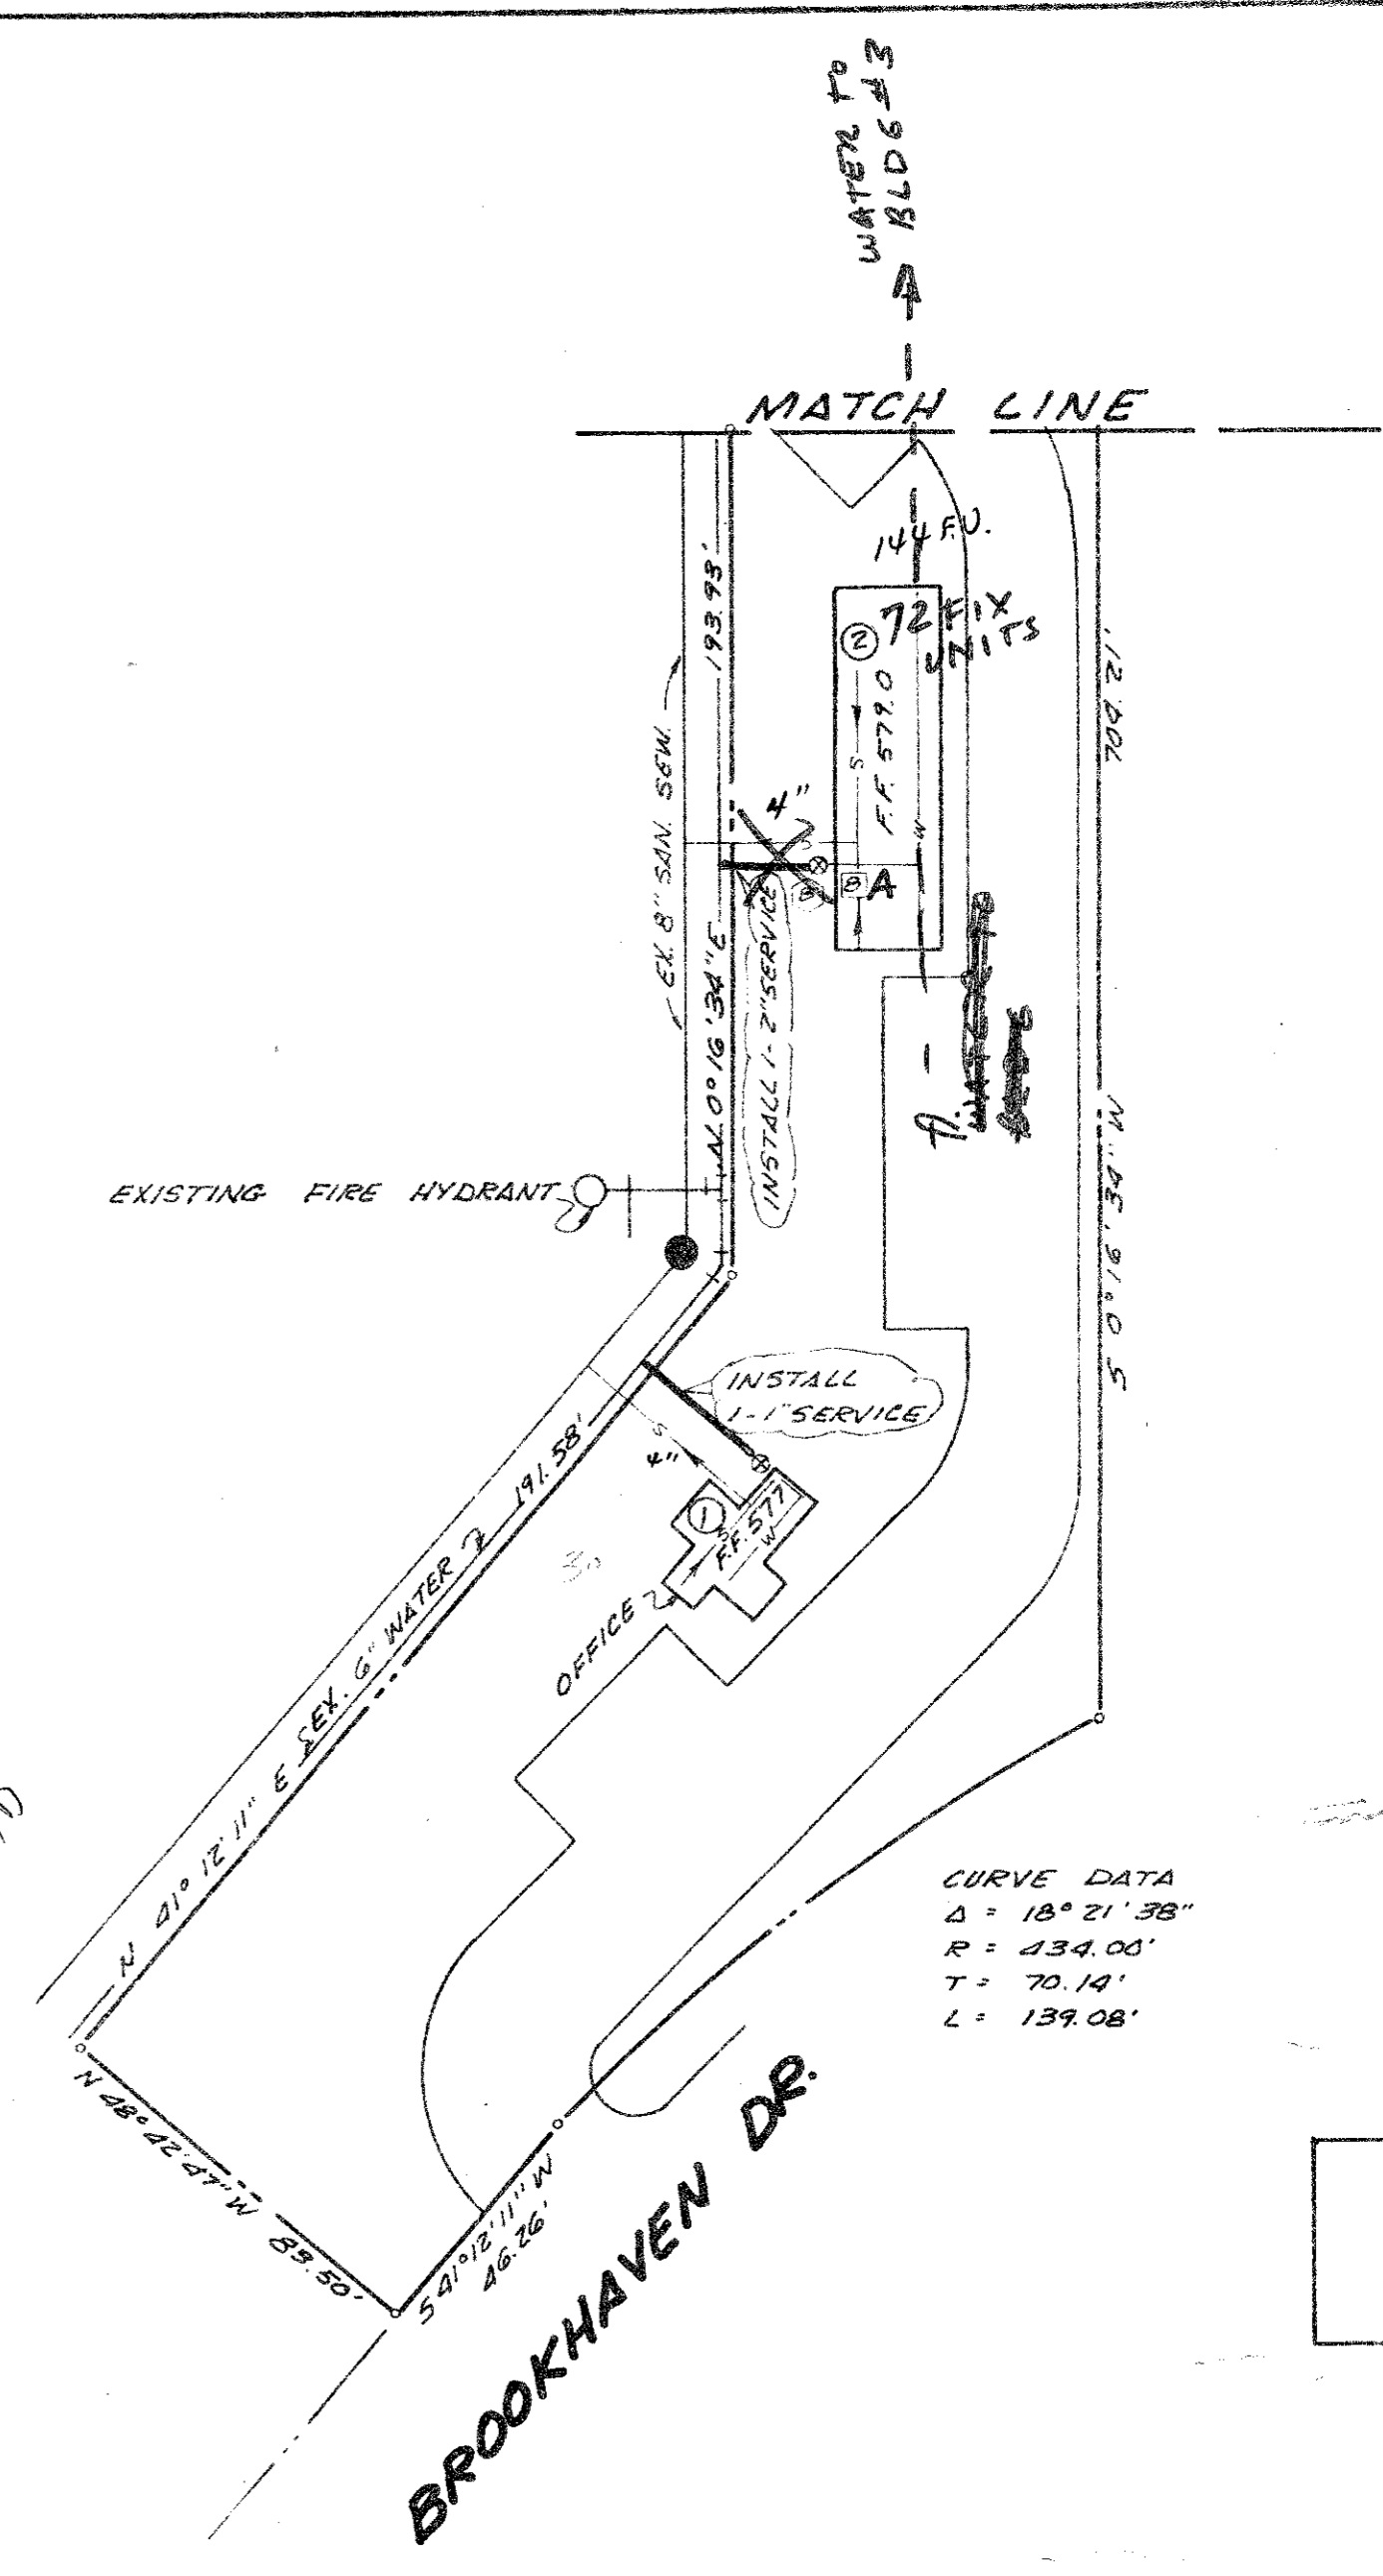


Bldg # 2-3-13 28 Type A - 1 BATH 174

40	-	B	1"	"	WITH WORK/OWNER 174
32	-	C	1"	"	"
24	-	D	1"	"	"
16	-	E	1 1/2"	"	STUDIO WITH WASHER DRYER 244
32	-	F	1"	"	BATH 184
8	-	G	2"	"	STUDIO WITH 174

NOTE: ALL WATER LINES TO BE P.V.C. WRAPPED

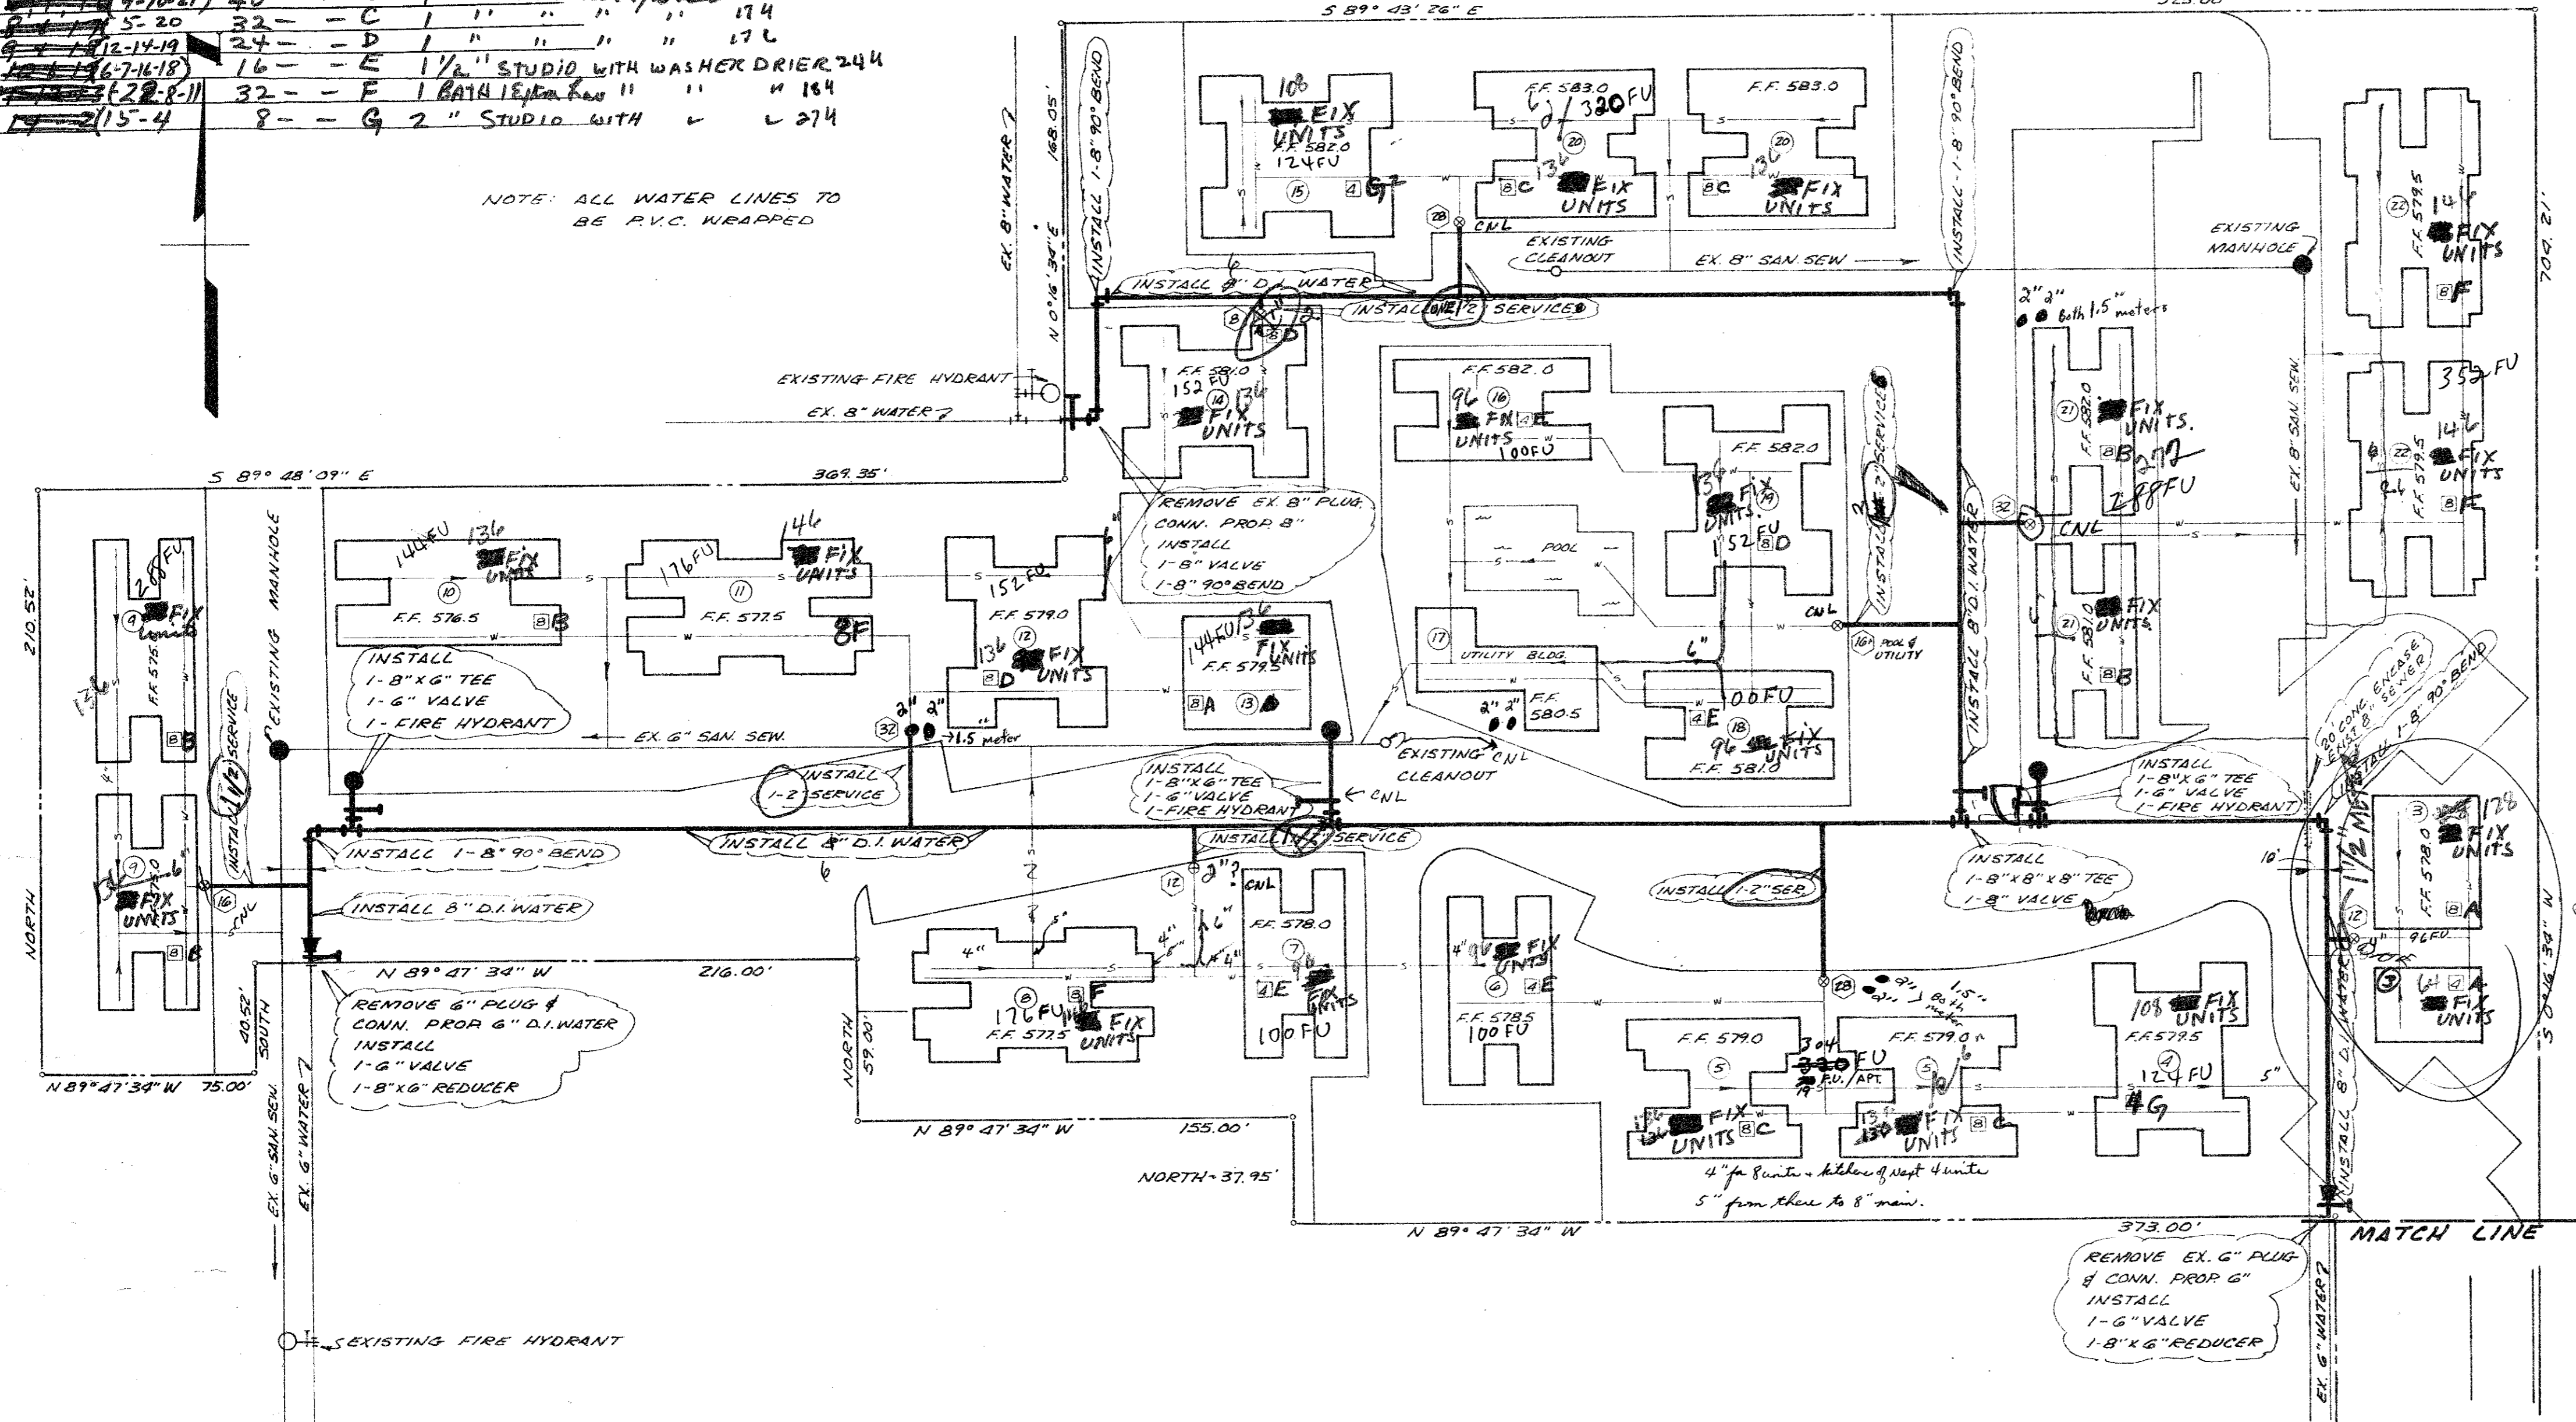


CURVE DATA
 Δ = 18° 21' 38"
 R = 434.00'
 T = 70.14'
 L = 139.08'

SITE SYMBOLS

⊙	- UNITS PER SERVICE
⊠	- UNITS PER BUILDING
①	- BUILDING NUMBER

A1-7

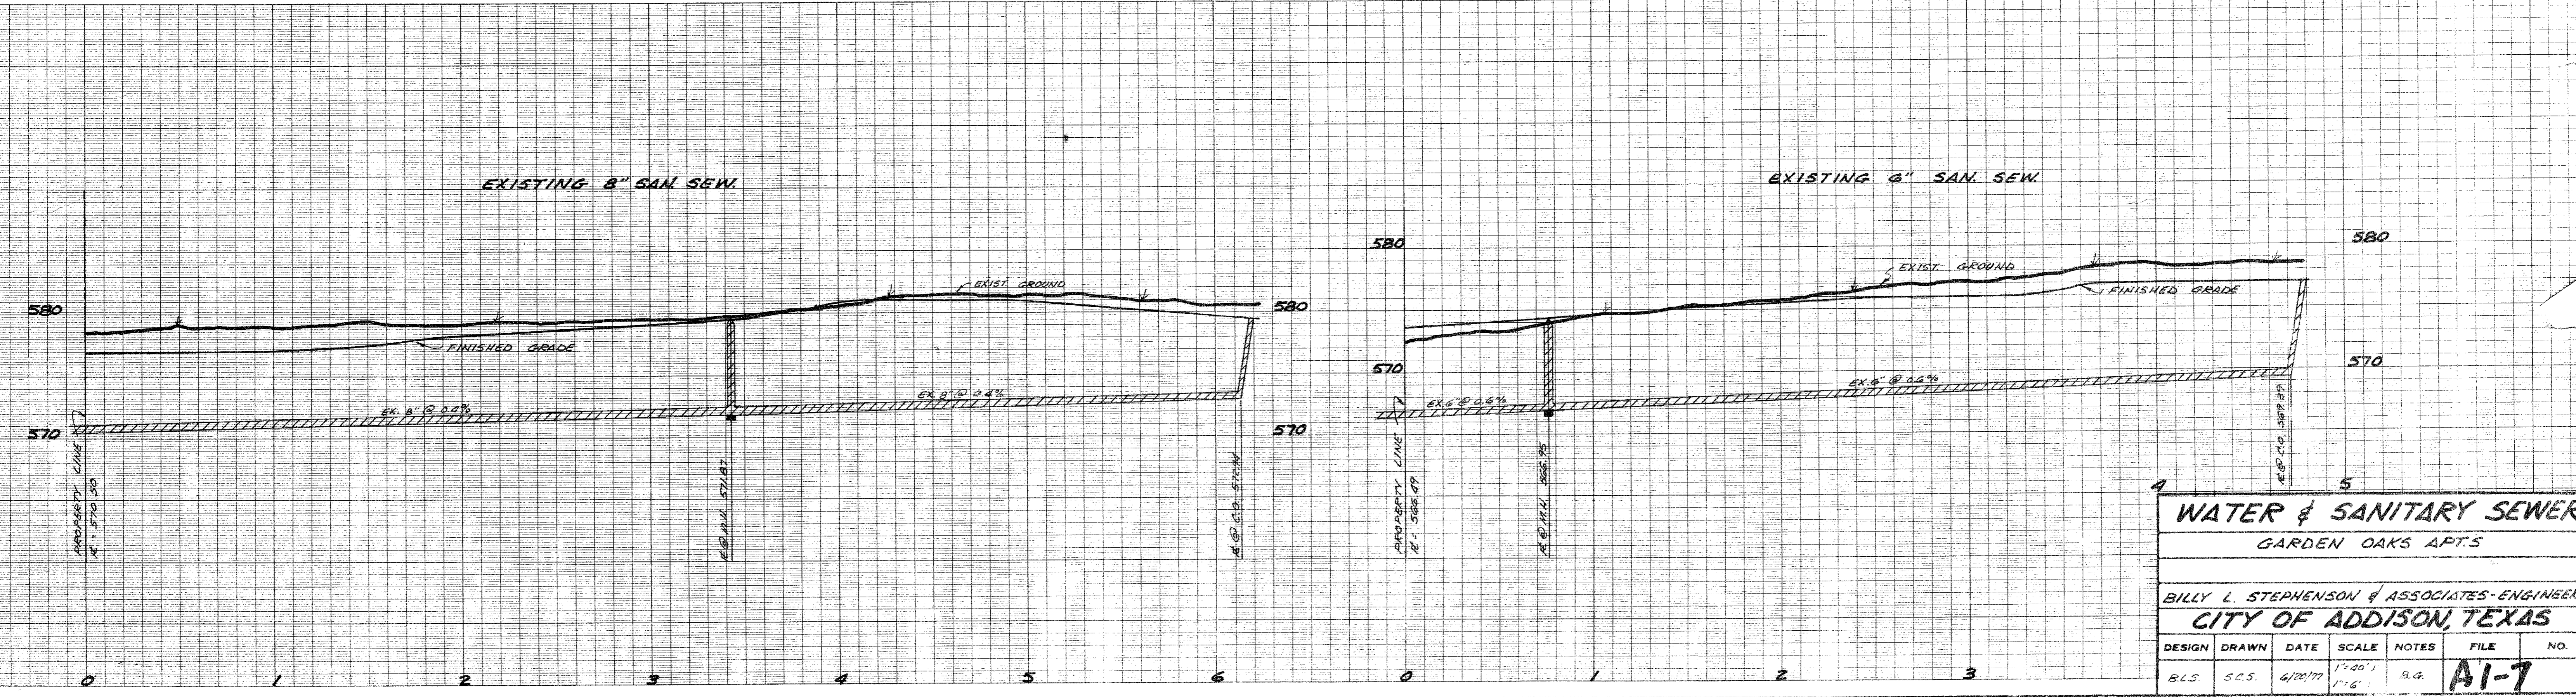

WATER & SANITARY SEWER						
GARDEN OAKS APTS						
BILLY L. STEPHENSON & ASSOCIATES-ENGINEER						
CITY OF ADDISON, TEXAS						
DESIGN	DRAWN	DATE	SCALE	NOTES	FILE	NO.
BLS	SCS	4/20/79	1"=20' 1"=6'	S.G.	A1-7	