

KEVIN SLOAN STUDIO

2400 EMPIRE CENTRAL, SUITE F  
DALLAS, TEXAS 75235 214.469.1784

03.07.2013 95% CONSTRUCTION SET

COPYRIGHT © 2012 KEVIN SLOAN STUDIO, LLC.

DRAWINGS, WRITTEN MATERIAL, AND DESIGN CONCEPTS SHALL NOT BE USED OR REPRODUCED IN WHOLE OR PART IN ANY FORM OR FORMAT WITHOUT PRIOR WRITTEN CONSENT OF KEVIN SLOAN STUDIO, LLC. DO NOT SCALE DRAWINGS. USE GIVEN DIMENSIONS ONLY. IF NOT SHOWN, VERIFY CORRECT DIMENSIONS WITH THE LANDSCAPE ARCHITECT. CONTRACTOR SHALL CHECK AND VERIFY ALL DIMENSIONS AND CONDITIONS AT JOB SITE.



TEXAS FIRM REG. # F-2658

### VITRUVIAN PARK AMPHITHEATRE

TOWN OF ADDISON

UDR  
3875 Ponte Avenue,  
Suite 400  
Addison, TX 75001

PROJECT - AMPHITHEATRE IMPROVEMENTS


ISSUED FOR: 100% CONSTRUCTION DOCUMENTS

DATE: MARCH 7, 2013

### PARTIAL PARK PLAN

SHEET

SP208

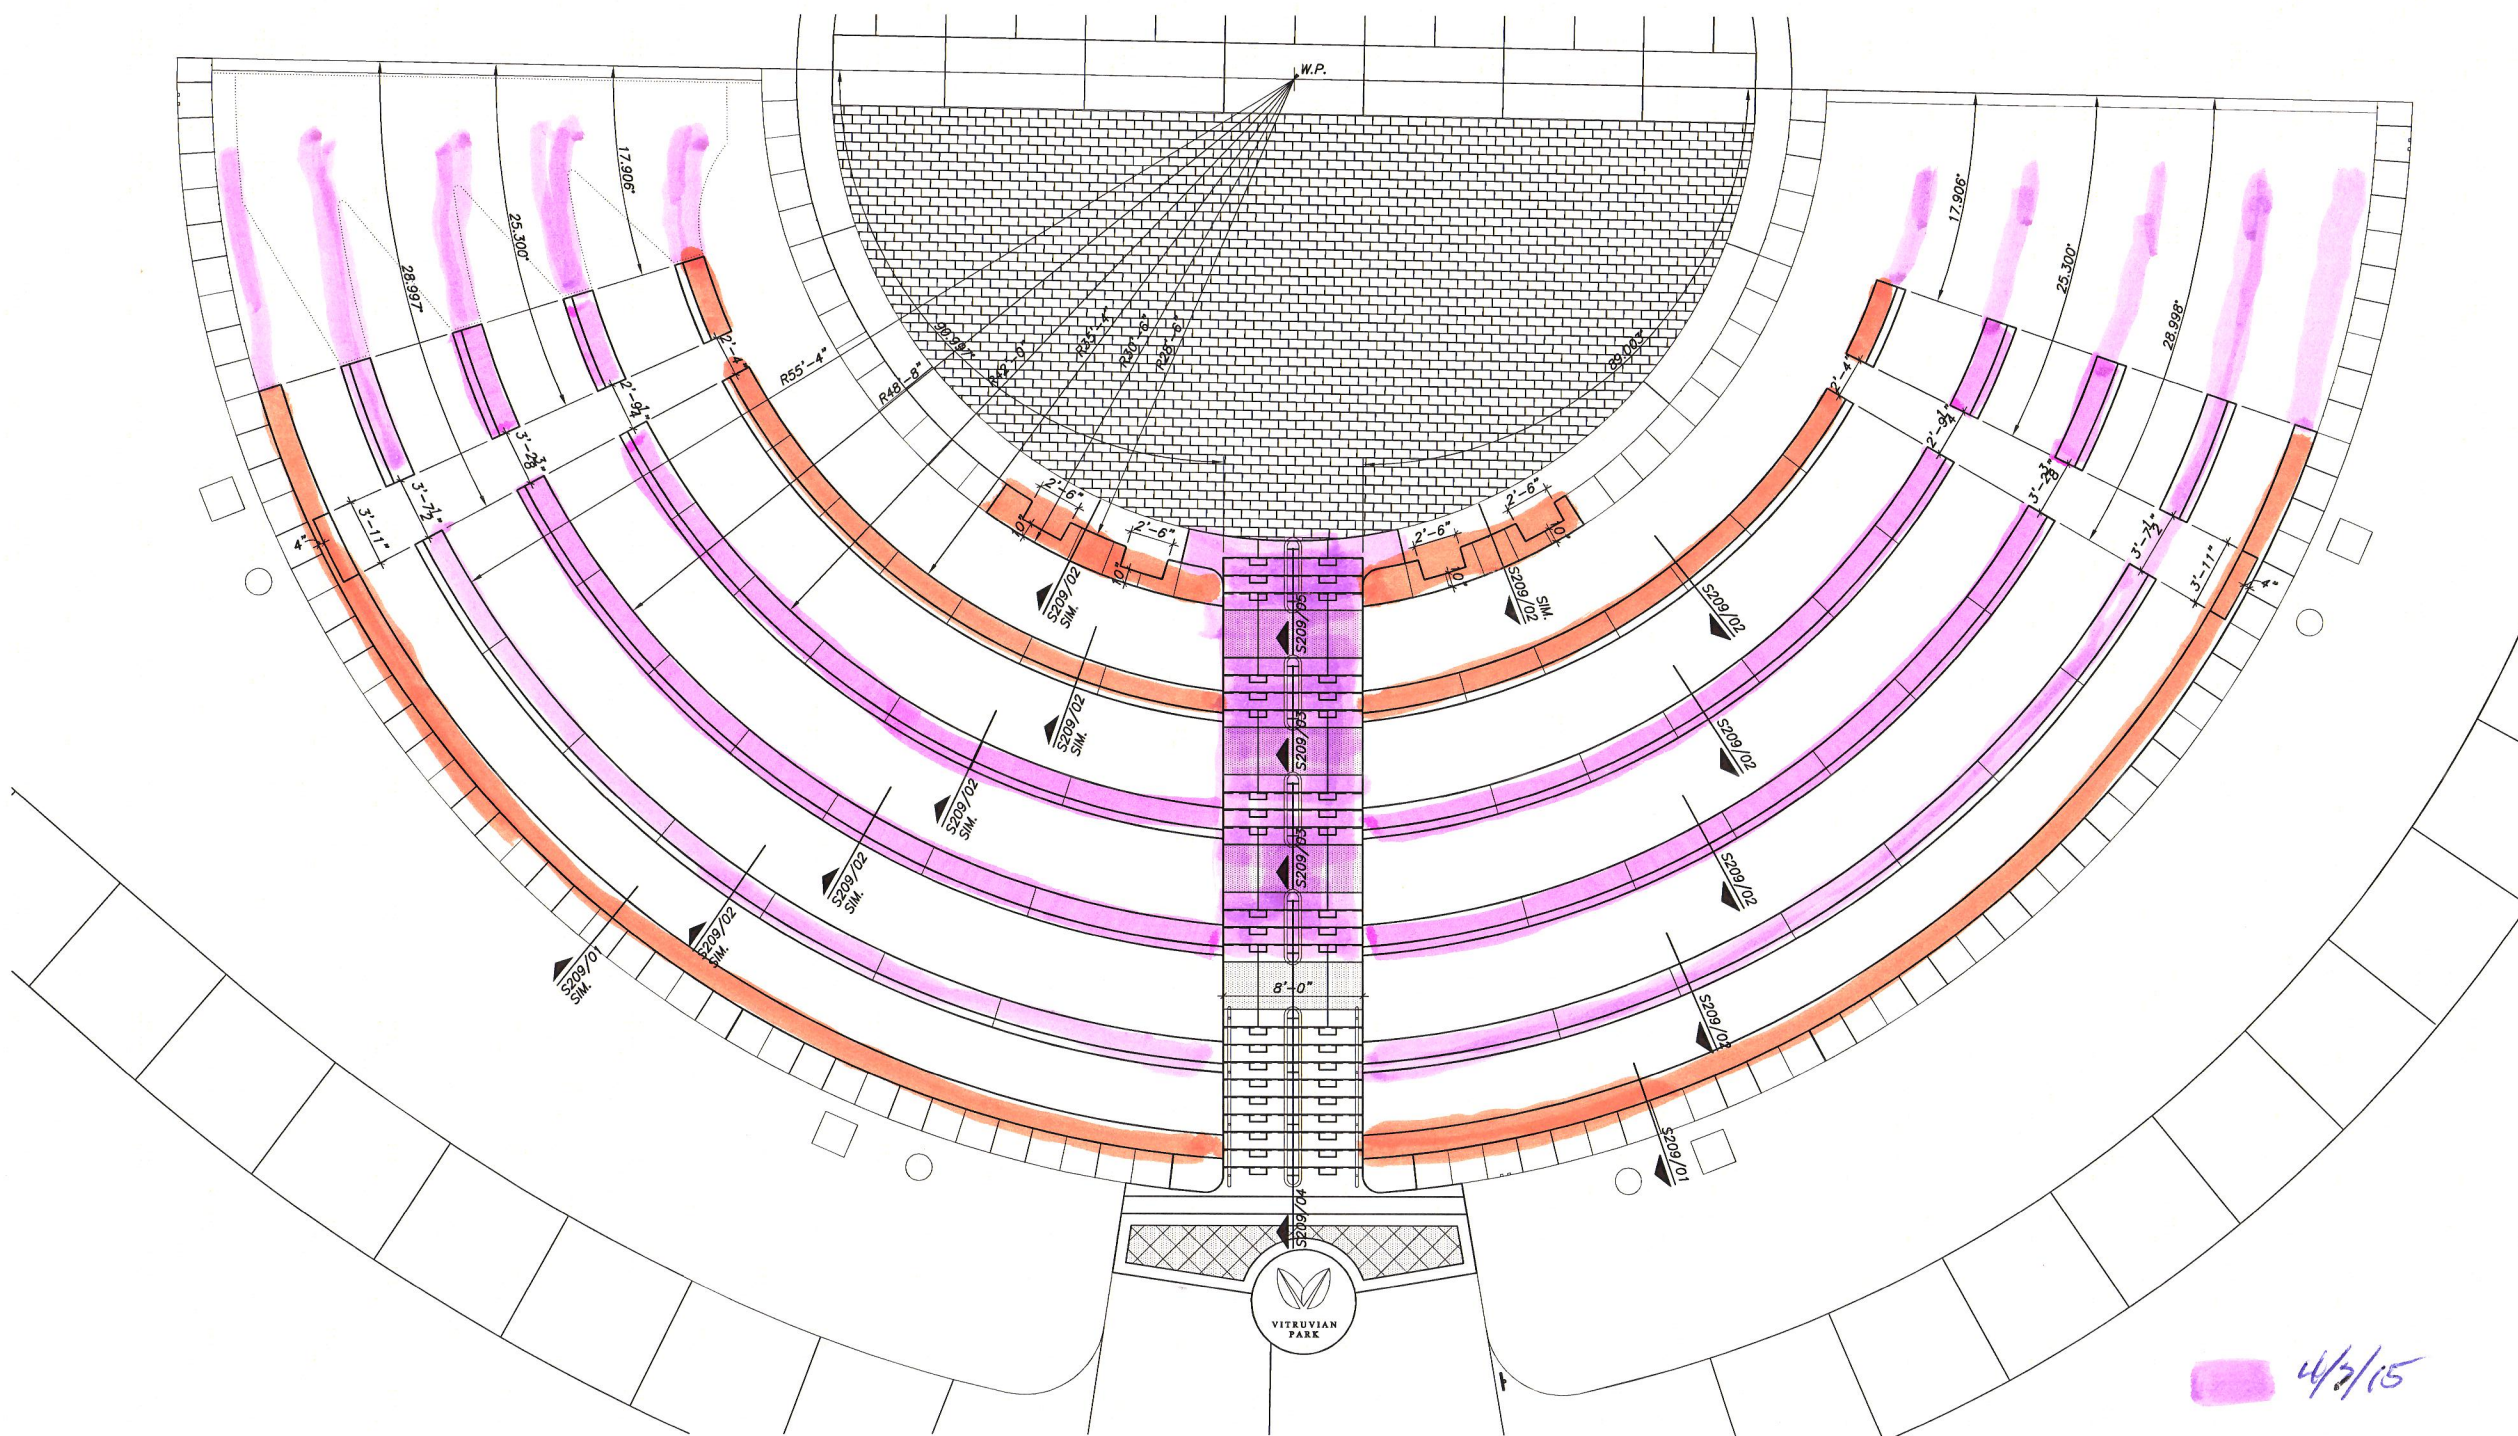

01 PARTIAL PARK PLAN  
3/16"=1'-0"

NOTE:  
RE: LANDSCAPE ARCHITECT FOR  
ALL RADII, CURVES, GRADES  
AND ELEVATIONS.

-2/16/15

-2/20/15

4/2/15

**VIEWTECH, INC.**  
4205 BELTWAY DR. ADDISON, TEXAS 75001  
(972) 661-8187 FAX(972) 661-8172