

PLANS FOR THE CONSTRUCTION OF
WATER, SANITARY SEWER & PAVING IMPROVEMENTS
FOR
VITRUVIAN PARK PUBLIC INFRASTRUCTURE - BLOCK 500 A
TOWN OF ADDISON, TEXAS
TOWN PROJECT # 17-07




JOE CHOW
MAYOR

IVAN HUGHES
JIM DUFFY
AL ANGELL
TOM BRAUN
PAUL WALDEN
LORI WARD
 COUNCIL MEMBERS

WES PIERSON
CITY MANAGER
LISA PYLES
DIRECTOR OF INFRASTRUCTURE
JASON SHROYER
ASST DIRECTOR OF INFRASTRUCTURE
LAURA BELL
CITY SECRETARY

CIVIL ENGINEER:
 ICON CONSULTING ENGINEERS, INC.
 2840 W. SOUTHLAKE BLVD., SUITE 110
 SOUTHLAKE, TEXAS 76092
 PH: (817) 552-6210
 FAX: (817) 778-4845
 CONTACT: BRUCE F. DUNNE, P.E.

SURVEYOR:
 KADLECK & ASSOCIATES,
 A DIVISION OF WESTWOOD
 2740 NORTH DALLAS PKWY., SUITE 280
 PLANO, TEXAS, 75093
 PH: (214) 473-4640
 CONTACT: LYNN KADLECK, R.P.L.S.

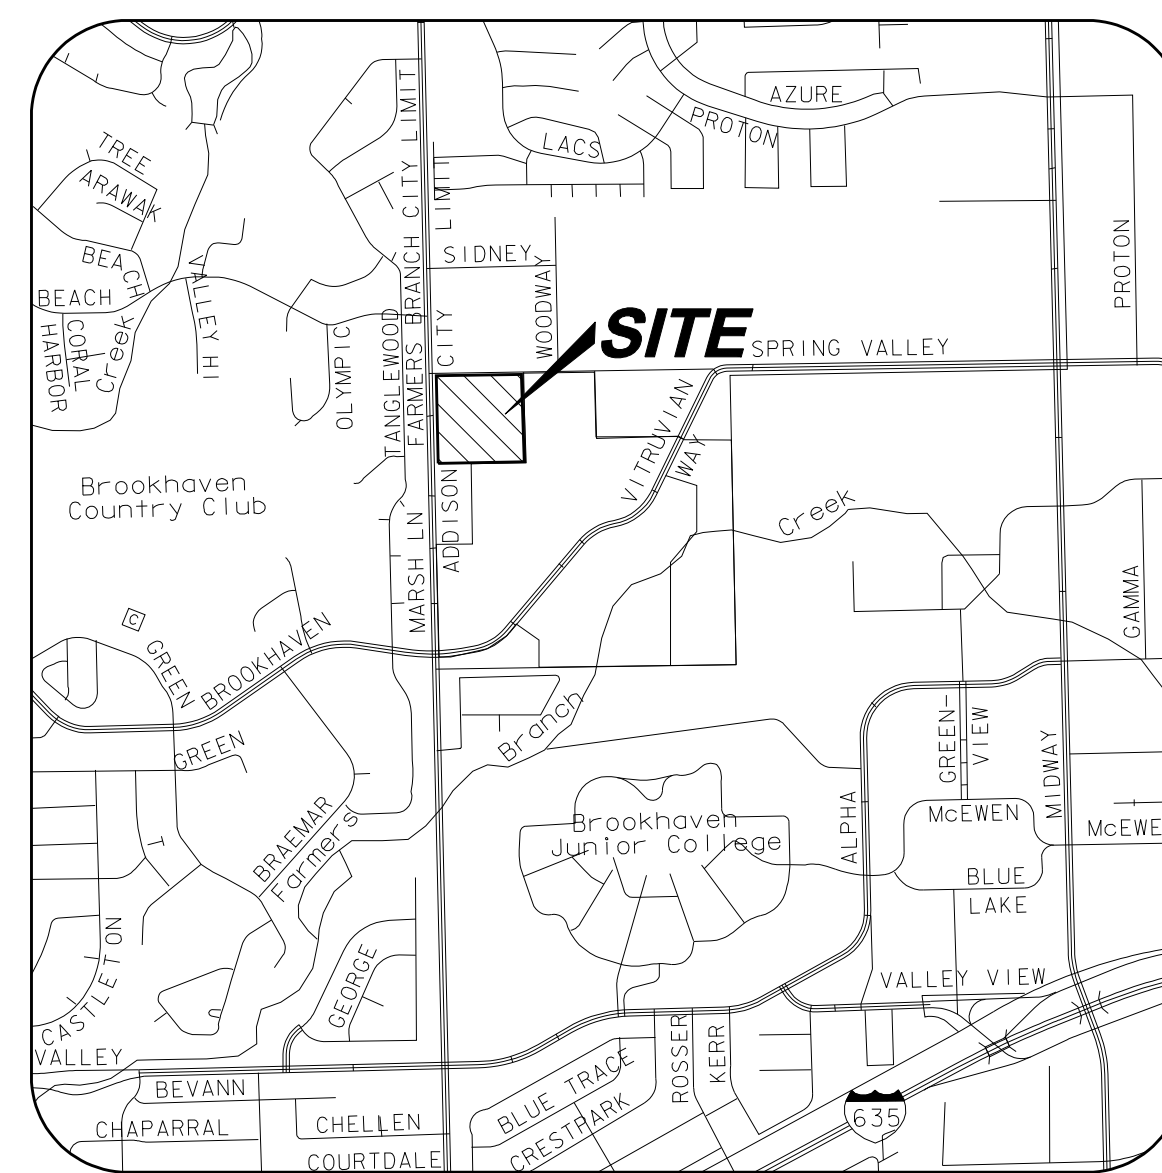

VICINITY MAP
 NOT TO SCALE
 (MAPSCO GRID 13 & 14)

SHEET INDEX

- 1 COVER SHEET
- 2 OVERALL LAYOUT & PROJECT CONTROL
- 3 GENERAL CONSTRUCTION NOTES, LEGEND & ABBREVIATIONS
- 4 OVERALL WATER LAYOUT - NORTH & SOUTH
- 5 OVERALL WATER & SANITARY SEWER LAYOUT - SHOPPING CENTER
- 6 WATER PLAN & PROFILE - LINE E STA 8+75.00 TO 12+00
- 7 WATER PLAN & PROFILE - LINE E STA 12+00 TO 15+50
- 8 WATER PLAN & PROFILE - LINE E STA 15+50 TO 19+50
- 9 WATER PLAN & PROFILE - LINE E STA 19+50 TO 23+50
- 10 WATER PLAN & PROFILE - LINE E STA 23+50 TO 28+00
- 11 WATER PLAN & PROFILE - LINE E STA 28+00 TO 32+14.29
- 12 WATER & SANITARY SEWER PLAN - SHOPPING CENTER - SOUTHWEST
- 13 WATER & SANITARY SEWER PLAN - SHOPPING CENTER - SOUTHEAST
- 14 WATER & SANITARY SEWER PLAN - SHOPPING CENTER - NORTHEAST
- 15 WATER & SANITARY SEWER PLAN - SHOPPING CENTER - NORTHWEST
- 16 SANITARY SEWER PROFILES - LINE A STA 0+00 TO 9+00
- 17 SANITARY SEWER PROFILES - LINE A STA 9+00 TO 14+20.64
- 18 SANITARY SEWER PROFILES - LINE B STA 0+00 TO 5+19.26
- 19 WATER DETAILS
- 20 WATER DETAILS
- 21 SANITARY SEWER DETAILS
- 22 PAVING PLAN - MARSH LANE - STA 73+50 TO 81+50
- 23 PAVING PLAN - MARSH LANE - STA 81+50 TO 90+50
- 24 PAVING PLAN - MARSH LANE - STA 90+50 TO 97+50
- 25 PAVING PLAN - SPRING VALLEY RD - STA 3+00 TO 8+50
- 26 PAVING PLAN - SHOPPING CENTER - SOUTH
- 27 PAVING PLAN - SHOPPING CENTER - EAST
- 28 PAVING NOTES & DETAILS
- 29 PAVING DETAILS
- 30 PAVING DETAILS - STREETScape
- 31 PEDESTRIAN FACILITIES - CURB RAMPS - PED-12A (1)
- 32 PEDESTRIAN FACILITIES - CURB RAMPS - PED-12A (2)
- 33 EROSION & SEDIMENT CONTROL PLAN - NORTH & SOUTH
- 34 EROSION & SEDIMENT CONTROL PLAN - SHOPPING CENTER
- 35 EROSION & SEDIMENT CONTROL DETAILS
- 36 CONSTRUCTION PHASING - PHASE 1 SHOPPING CENTER
- 37 CONSTRUCTION PHASING - PHASE 2 SHOPPING CENTER
- 38 CONSTRUCTION PHASING - PHASE 3 SHOPPING CENTER
- 39 CONSTRUCTION PHASING - PHASE 4 SHOPPING CENTER
- 40 TRAFFIC CONTROL PLAN - TCP(1-4)-12
- 41 TRAFFIC CONTROL PLAN - MARSH LANE STA 64+30 TO 83+50
- 42 TRAFFIC CONTROL PLAN - MARSH LANE STA 83+50 TO 98+00
- 43 TRAFFIC CONTROL PLAN - SPRING VALLEY RD & SHOPPING CENTER

icon Consulting Engineers, Inc.
 Civil Engineers- Designers- Planners
 ENGINEERING FIRM REGISTRATION NUMBER F-9007

JANUARY 22, 2020 - AS-BUILT / RECORD DRAWINGS

