


SIGNAL HEADS												
SIGNAL HEAD NO.	SIGNAL HEAD TYPE	12" SIGNAL INDICATION				LOUVER	VEHICLE SIGNAL SECTIONS					PED SIGNAL SECTIONS
		BACKPLATE			RED BALL		YELLOW BALL	GREEN BALL	YELLOW ARROW	GREEN ARROW		
		3 SEC (EA)	4 SEC (EA)	5 SEC (EA)								
23	V4LT		1			1	1	1		1		
2, 3, 8, 9, 13, 14, 19, 20	*V3											
1, 6, 7, 12, 17, 18	*V5LT											
4, 5, 10, 11, 15, 16, 21, 22	*COUNTDOWN											
	TOTAL		1			1	1	1		1		

*SIGNAL HEADS ARE EXISTING AND SHALL REMAIN IN PLACE
 SIGNAL HEADS 4, 5, 10, AND 22 SHALL BE COVERED DURING PHASE 3 OF CONSTRUCTION.

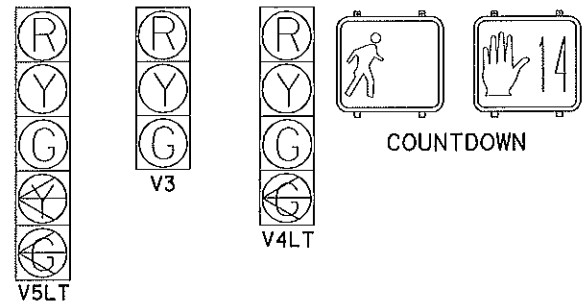


SIGNAL HEAD AND POLE PLACEMENT (FEET)											
POLE NUMBER	A	B	C	D	E	F	G	H	NO. OF HEADS	LUM-A	
P-1	7	13	11	12	---	36	20	---	3	---	
P-2	12.5	PEDESTAL POLE ASSEMBLY					10	---	---	---	---
P-3	10.5	12	11	11	14	48	20	---	4	---	
P-4	7	10	11	11	---	32	20	14	3+1	---	
P-5	9	19	10	9	10	48	20	---	4	---	

ALL SIGNAL POLES ARE EXISTING AND SHALL REMAIN IN PLACE.

WIRE INSIDE POLE (FEET)						
POLE NUMBER	5 CNDR CABLE (#14 AWG)	7 CNDR CABLE (#14 AWG)	VIVDS CABLE	LUMINAIRE CABLE 1C#8 XHHW	OPTICOM CABLE	SSR CABLE
P-4	14	---	---	---	---	---
TOTALS	14	---	---	---	---	---

ONLY NEW CABLE SHOWN IN THE TABLE ABOVE.

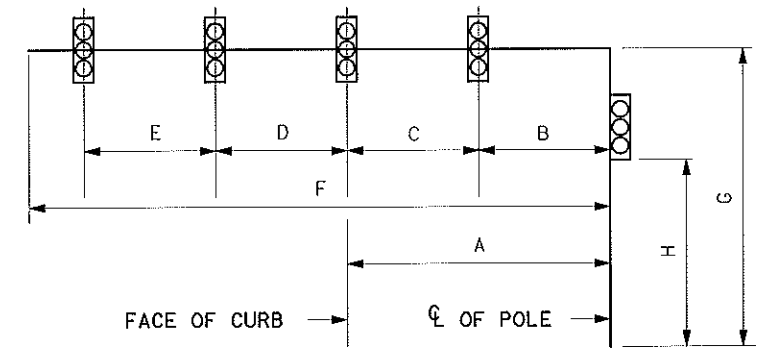

J. T. Short 4/28/09
 DATE
 JOSEPH T. SHORT, P.E.
 LEE ENGINEERING, L.L.C., REGISTRATION NO. F-450



NO.	REVISION	BY	DATE

TOWN OF ADDISON
 DALLAS COUNTY, TEXAS

PAVING, DRAINAGE & UTILITY IMPROVEMENTS
 VITRUVIAN WAY AND PONTE AVENUE

TEMPORARY TRAFFIC SIGNAL TABLES
 MARSH LN AT BROOKHAVEN CLUB DR - PHASE 3

PROJECT	DESIGN	DRAWN	DATE	FILE	SHEET
5028-01	CJP	CJP	APR 28, 2009	PW# 2009-01	TS11

PAVING, DRAINAGE & UTILITY IMPROVEMENTS - VITRUVIAN WAY & PONTE AVENUE