


ø1, ø3, ø5 and ø7 are protected/permissive left turns.

LEGEND OF SYMBOLS			
	EXISTING SIGNAL POLE/ MAST ARM ASSEMBLY		EXISTING MAST ARM MOUNTED SIGN
			EXISTING SIGN IDENTIFICATION
			EXISTING SIGNAL POLE/POST MOUNTED SIGN
	EXISTING CONTROLLER CABINET ASSEMBLY		RIGHT OF WAY LINES
	RELOCATED PEDESTAL POLE ASSEMBLY		EXISTING CONDUIT RUN & NUMBERS
	EXISTING SIGNAL HEAD NUMBERS		EXISTING VIVDS DETECTION CAMERA
	EXISTING SIGNAL POLE NUMBERS		EXISTING VIVDS DETECTOR IDENTIFICATION
	EXISTING GROUND BOX		EXISTING OPTICOM DETECTOR
	ø2		EXISTING ELECTRICAL SERVICE
	NEW MAST ARM MOUNTED SIGN		EXISTING SPREAD SPECTRUM RADIO ANTENNA
	NEW SIGN IDENTIFICATION		LANE USE ARROWS
	P-2		RELOCATED SIGNAL HEAD NUMBERS

BROOKHAVEN CLUB DRIVE

VITRUVIAN WAY

MARSH LANE

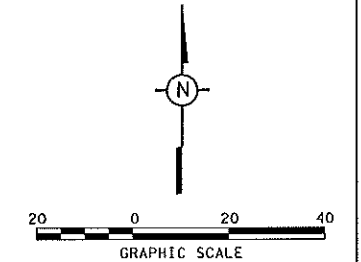


NOTES:

- FOR PAVEMENT MARKING DETAILS, SEE ROADWAY PLAN PAVEMENT MARKING SHEETS.
- LANE USE SIGN D ON MAST ARM P-3 AND POST MOUNTED SIGNS O AND P SHALL BE REMOVED BY THE CONTRACTOR. SIGNS C, M, AND N SHALL BE REINSTALLED/UNCOVERED IN THEIR PLACE. A NEW LANE CONFIGURATION SIGN J SHALL BE INSTALLED ON MAST ARM P-5.
- SIGNAL PHASING SHALL BE RETURNED TO PROTECTED/PERMISSIVE OPERATION.
- SIGNAL HEAD 23 (V4LT) WHICH WAS INSTALLED DURING PHASE 3 OF CONSTRUCTION SHALL BE REMOVED BY THE CONTRACTOR.
- SIGNS E AND K SHALL BE REINSTALLED/UNCOVERED BY THE CONTRACTOR.
- CONTRACTOR SHALL RELOCATE EXISTING PEDESTAL POLE P-2 FROM EXISTING LOCATION TO NEW LOCATION SHOWN ON THE PLANS. PAYMENT SHALL BE SUBSIDIARY TO "INSTALLATION OF HIGHWAY TRAFFIC SIGNALS."
- EXISTING SIGNAL CABLE SERVICING PEDESTAL POLE P-2 SHALL BE REMOVED FROM EXISTING CONDUIT #2 AND REROUTED THROUGH NEW CONDUIT #2 (10' SCHD 40 PVC) TO THE NEW LOCATION OF THE PEDESTAL POLE. THE EXISTING FOUNDATION SHALL BE JACKHAMMERED TO A DEPTH OF 2 FEET BELOW GRADE AND BACKFILLED.

JOSEPH T. SHORT, P.E.
LEE ENGINEERING, L.L.C., REGISTRATION NO. F-450

Joseph T. Short
DATE 4/28/09

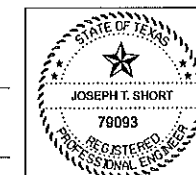

NO.	REVISION	BY	DATE
PAVING, DRAINAGE & UTILITY IMPROVEMENTS VITRUVIAN WAY AND PONTE AVENUE			
TRAFFIC SIGNAL LAYOUT MARSH LANE AT BROOKHAVEN CLUB DRIVE			
PROJECT	DESIGN	DRAWN	DATE
5020-01	C/P	C/P	APR 28, 2009
FILE	SHEET		
PW# 2009-01	TS12		

PAVING, DRAINAGE, & UTILITY IMPROVEMENTS - VITRUVIAN WAY & PONTE AVENUE