

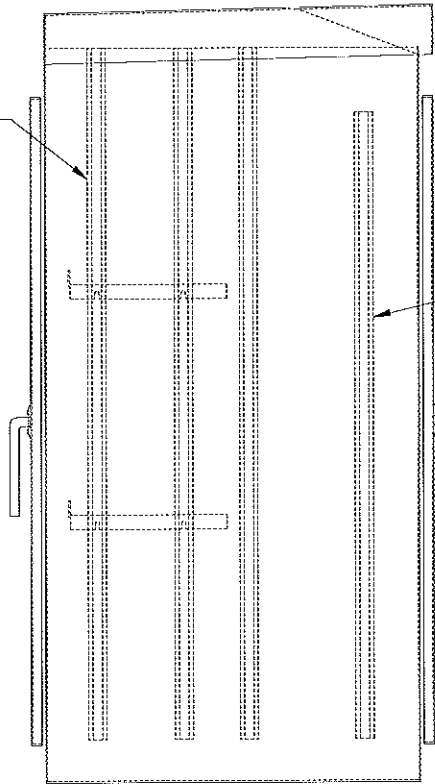
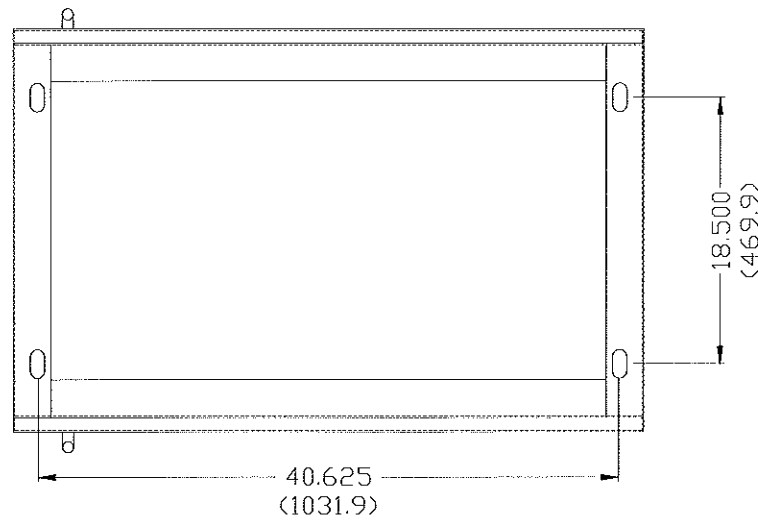


48.000" (1219.2)  
UNISTRUT

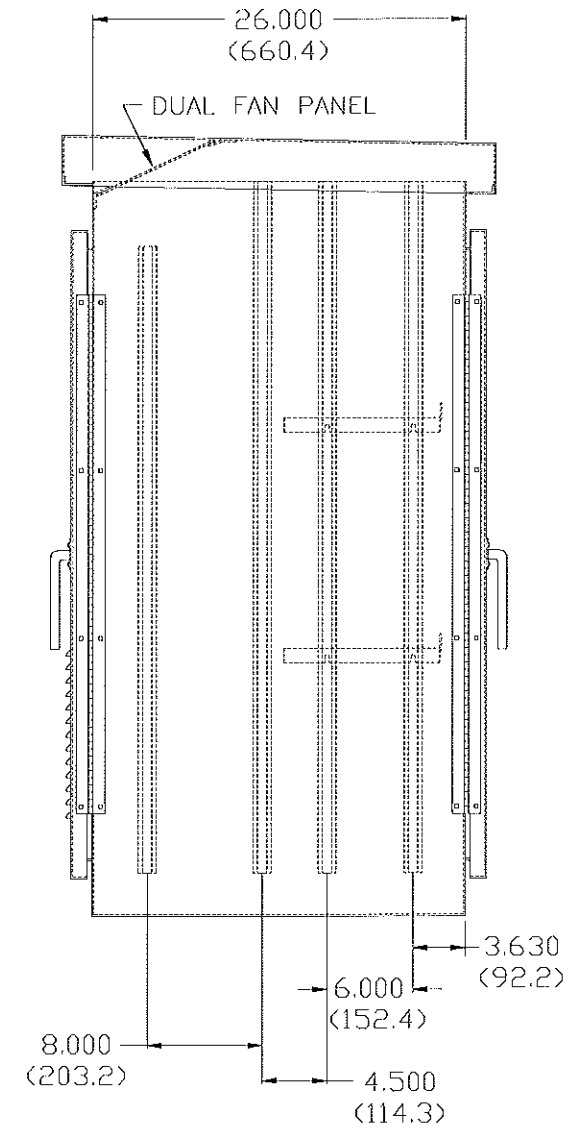

43.500" (1104.9)  
UNISTRUT

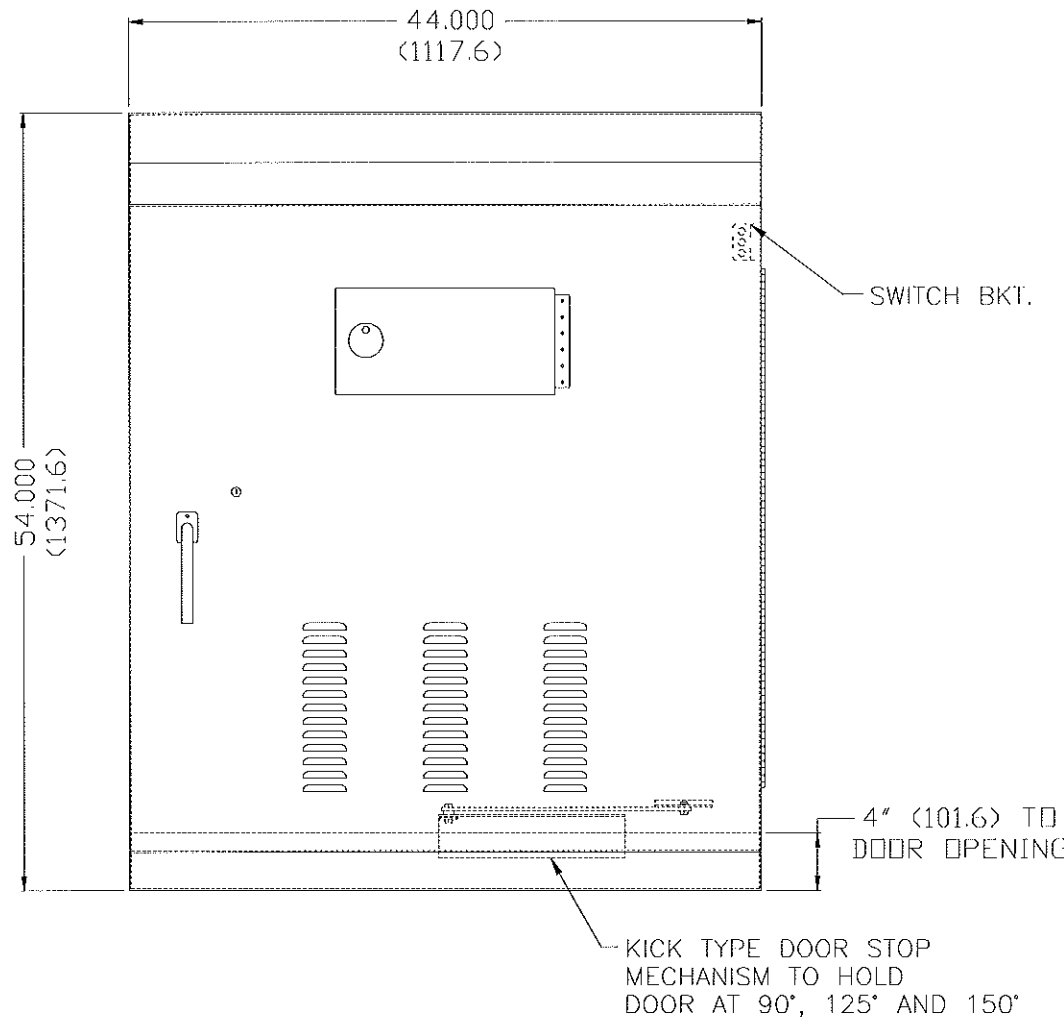


NOTES:

1. MATERIAL: 0.125 (3.18) THK. 5052 ALUMINUM.
2. FULL LENGTH SST HINGE.
3. FULL PERIMETER 1/2" X 2" (12.7 X 50.8) CLOSED CELL NEOPRENE GASKET.
4. TWO 11.000" (279.4) DEEP ADJUSTABLE SHELVES TO BE PROVIDED.
5. MAIN DOOR LOCK IS A #2 CORBIN LOCK
6. POLICE DOOR LOCK IS A #1 CORBIN LOCK
7. 3-POINT LATCHING SYSTEM WITH PADLOCKABLE SST HANDLE.
8. FILTER SIZE TO BE 14" X 25" (355.6 X 635.0)
9. CONTINUOUSLY WELDED EXTERNAL SEAMS.
10. SHIPPED ON A PLYWOOD PALLET WITH 4 X 4 RUNNERS.
11. FINISH: MILL IF REQUIRED.  
PAINT IF REQUIRED: REECE SUPPLY  
(313 DARK BRONZE AKZO METAFLEX) OUTSIDE, WHITE INSIDE.

JOSEPH T. SHORT, P.E.  
LEE ENGINEERING, L.L.C., REGISTRATION NO. F-450

*J.T. Short* 4/28/09  
DATE

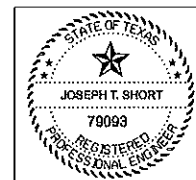

NO.	REVISION	BY	DATE
<b>TOWN OF ADDISON</b> DALLAS COUNTY, TEXAS			
<b>PAVING, DRAINAGE &amp; UTILITY IMPROVEMENTS</b> VITRUVIAN WAY AND PONTE AVENUE			
<b>CONTROLLER CABINET DETAIL</b> VITRUVIAN WAY AT PONTE AVENUE			
PROJECT	DESIGN	DRAWN	DATE
5029-01	CJP	CJP	APR 28, 2009
FILE	SHEET		
PW# 2009-01	TS31		

PAVING, DRAINAGE & UTILITY IMPROVEMENTS - VITRUVIAN WAY & PONTE AVENUE