


**WARNING**  
 CONTRACTOR IS TO CONTACT TEXAS ONE-CALL SYSTEM (1-800-245-4545) OR OTHER UTILITY LOCATING SERVICES AT LEAST 48 HOURS PRIOR TO CONSTRUCTION ACTIVITIES. ICON CONSULTING ENGINEERS, INC. IS NOT RESPONSIBLE FOR KNOWING ALL EXISTING UTILITIES IN THE PROJECT AREA NOR FOR DEPICTING THE EXACT LOCATIONS OF UTILITIES ON THESE DRAWINGS.

BM #1 REF. ELEVATION = 559.47  
 SQUARE CUT IN TOP OF CURB, SOUTH MEDIAN END NOSE, MARSH LANE 1127' NORTH OF VITRUVIAN WAY.

BM #2 REF. ELEVATION = 547.84  
 SQUARE CUT IN TOP OF CURB, NORTH MEDIAN END NOSE, AT INTERSECTION OF VITRUVIAN WAY AND MARSH LANE.

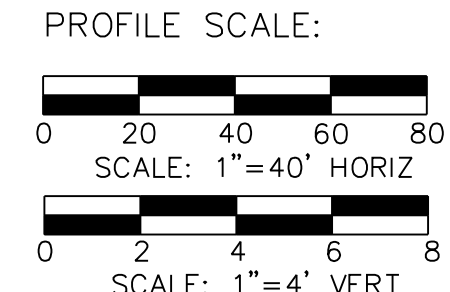

**BRUCE F. DUNNE**  
 62654  
 LICENSED PROFESSIONAL ENGINEER

**ADDISON**  
 TOWN OF ADDISON  
 DALLAS COUNTY, TEXAS

**PAVING, DRAINAGE & UTILITY IMPROVEMENTS**  
 VITRUVIAN WAY & PONTE AVENUE

**STORM DRAIN PLAN & PROFILE-VW**  
 LINES A2, A3, A4 & B2

**icon** Consulting Engineers, Inc.  
 Civil Engineers - Designers - Planners  
 250 W. Southlake Blvd., Suite 117  
 Southlake, Tx 76092 (817) 552-6210

PROJECT	DESIGN	DRAWN	DATE	FILE	SHEET
5029-01	ICE	ICE	MAY 7 2009	PW# 2009-01	35

RECORD DRAWINGS 08/25/10

PAVING, DRAINAGE, & UTILITY IMPROVEMENTS - VITRUVIAN WAY & PONTE AVENUE