


SUMMARY OF SMALL SIGNS (WITHOUT REMOVABLE COPY)							
SIGN	SIGN	SIGN	SIGN	REFLECTIVE	PLYWOOD	ALUMINUM	TYPE
NO.	TYPE	TEXT	DIMENSIONS	SHEETING	TYPE A	ΤΥΡΕ Α	
0			(INCHES)				

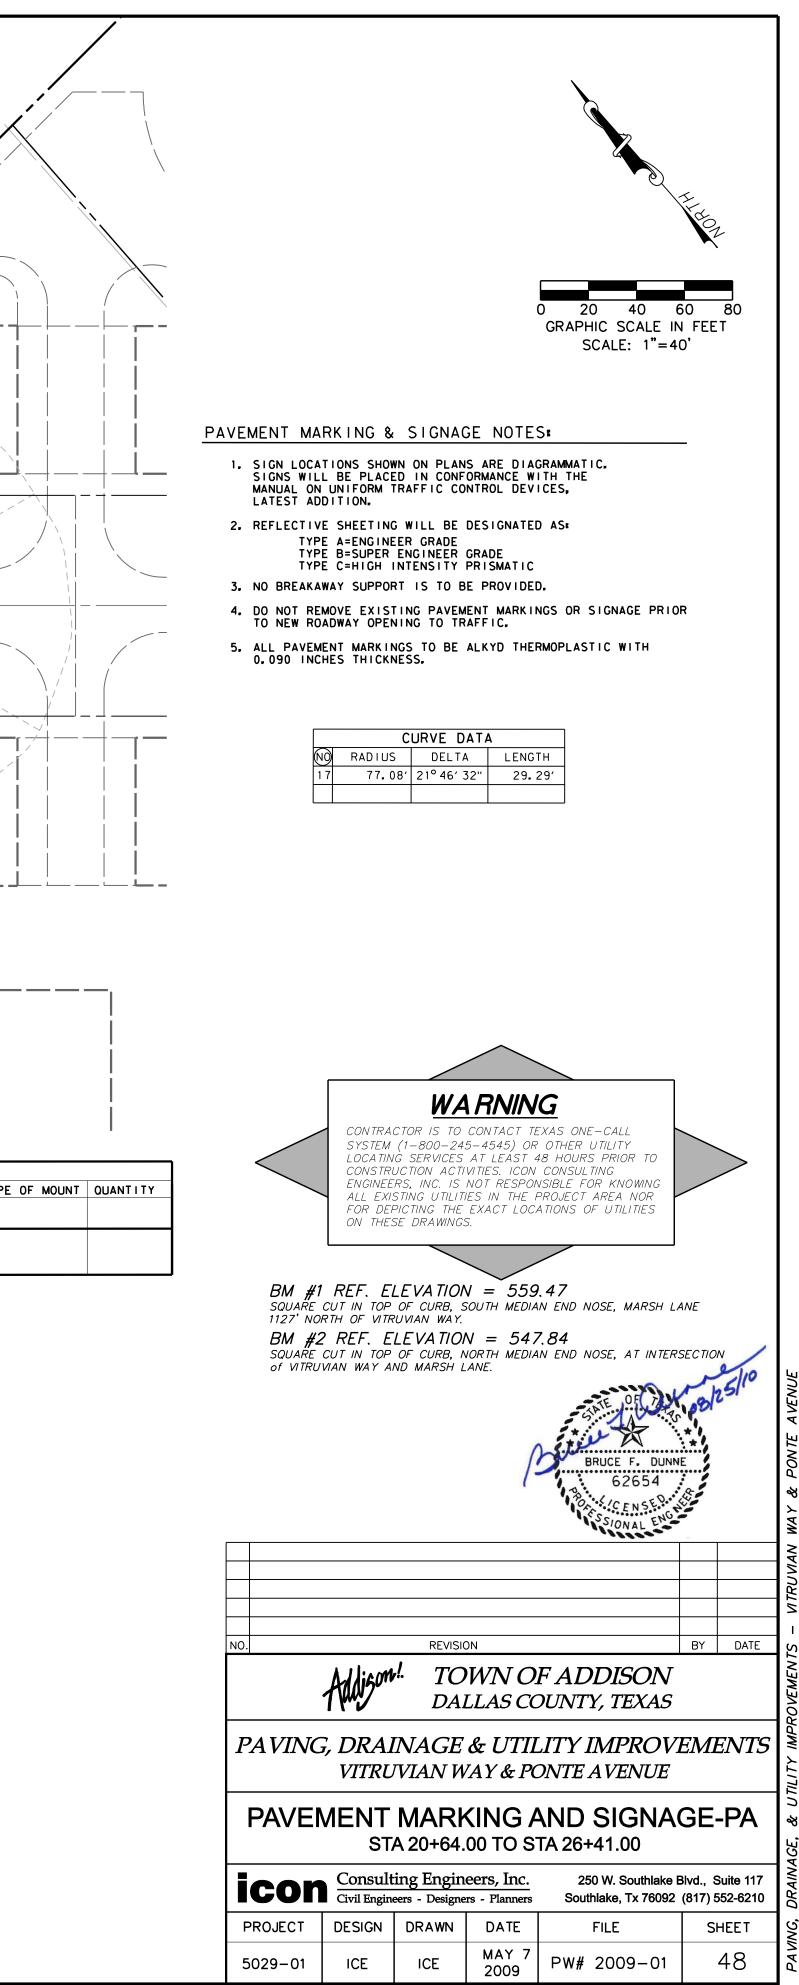

**RECORD DRAWINGS 08/25/10**