


ALL MANHOLES SHALL PASS VACUUM TEST AS PER NCTCOG SPECIFICATIONS

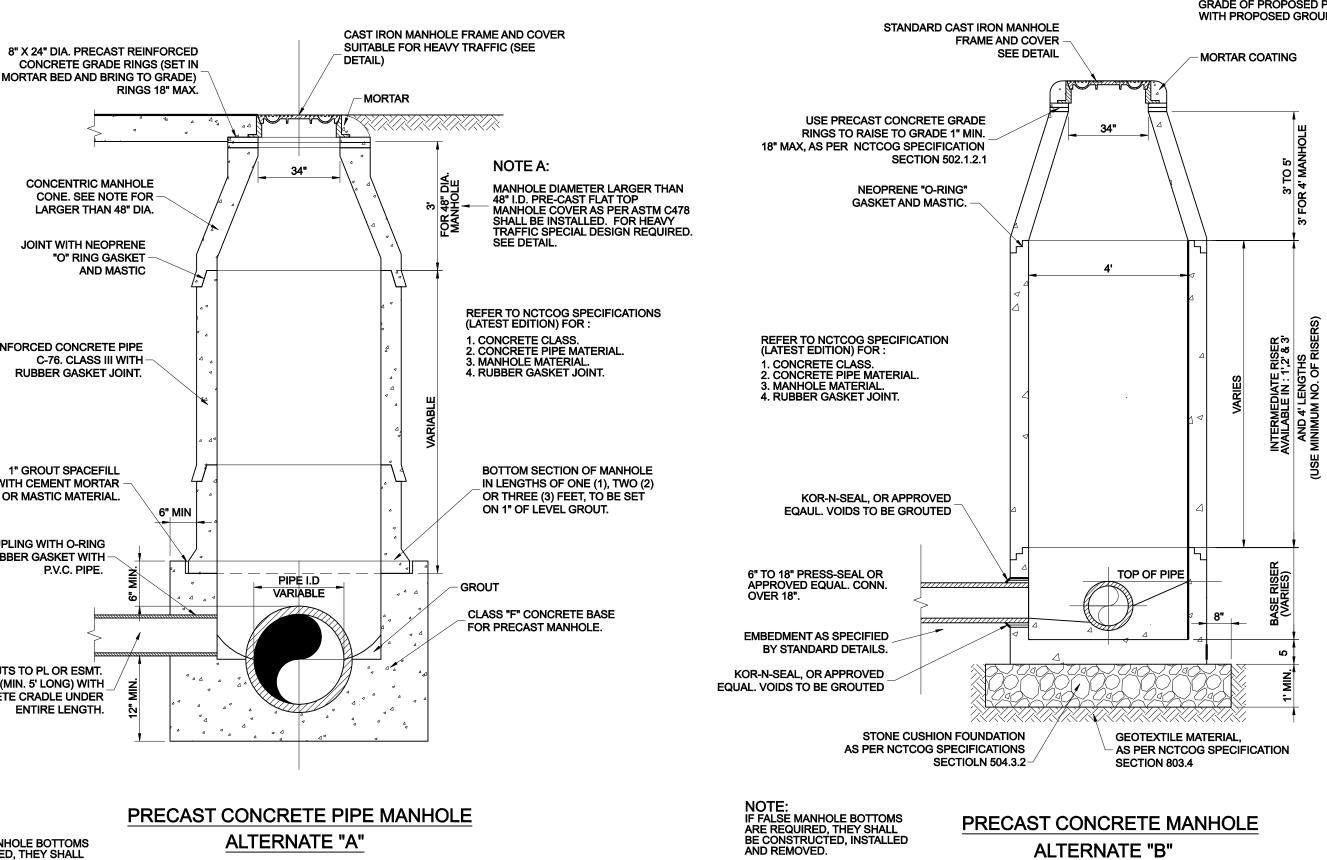


OF A OF A		4" RAISED LETTERING ECESSED FLUSH) SEE PICKBAR DETAIL 2" 4 SPECIAL LOGO - 3/4" LETTERING RECESSED (CHANGED ANNUALLY)	BH400-24 BH400-24 00002473 CIUN 20224A MODAYR X
Ň	1/2" RAISE	ECESSED FLUSH) ED LETTERING SED FLUSH)	BOTTOM VIEW OF COVER
24"		2 1/2" 1 2 1/2" 2 13/16"	3 3/4"= = 1 7/8"
24 1/4"		3/4"	3 1/16" 1 3/4" 2023 PICKBAR DETAIL
20 1/4"			DIA. –––– PICKBAR DETAIL PICKBAR
- 31"		5/16" DIA BUNA-I O-RING GASKET	
FRAME SECTION			
LOAD RATING HEAVY DUTY	COATING DIPPED	ESTIMATED WEIGHT COVER: 190 LBS 86 kg	MATERIAL SPECIFICATION COVER - GRAY IRON ASTM A48 CL35B
√ DESIGNATES	MACHINE S	URFACE	

CAST IRON FRAME AND COVER

MANHOLE RING AND COVER TO BE SET TO GRADE OF PROPOSED PAVEMENT, OR FLUSH WITH PROPOSED GROUND GRADE.

NOTE A: MOTE A. MANHOLE DIAMETER LARGER THAN 48" I.D. PRE-CAST FLAT TOP MANHOLE COVER AS PER ASTM C478 SHALL BE INSTALLED. FOR HEAVY TRAFFIC SPECIAL DESIGN REQUIRED. SEE DETAIL.

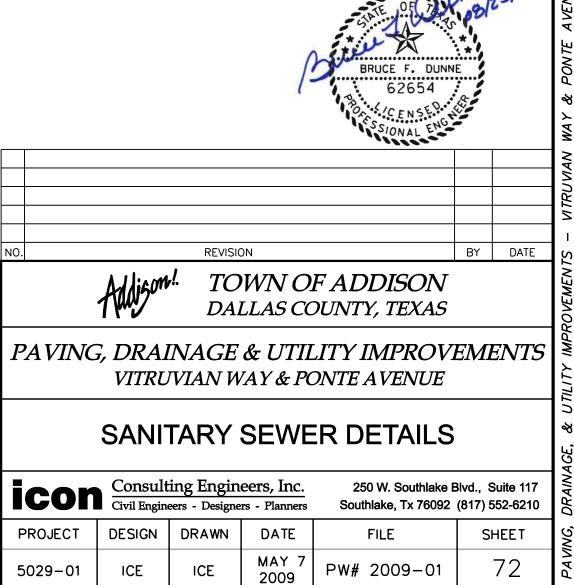

RECORD DRAWINGS 08/25/10