




2+00.00

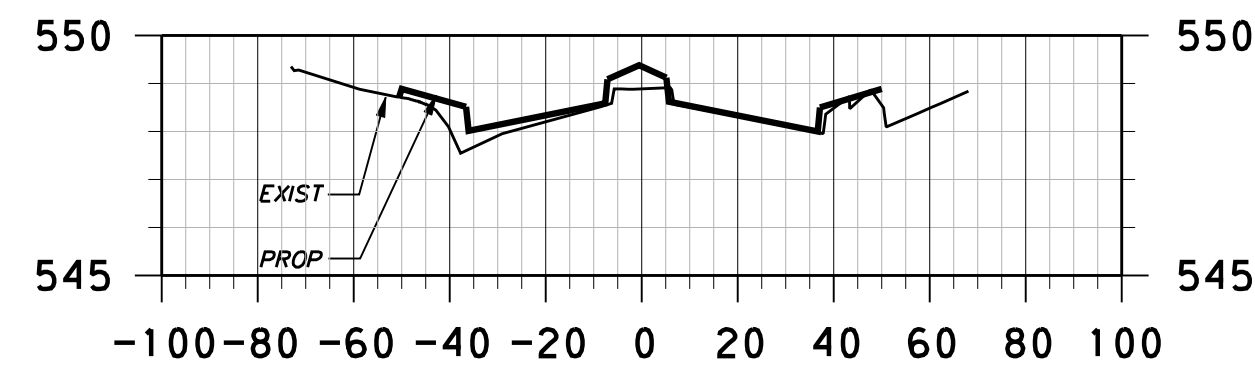


4+00.00

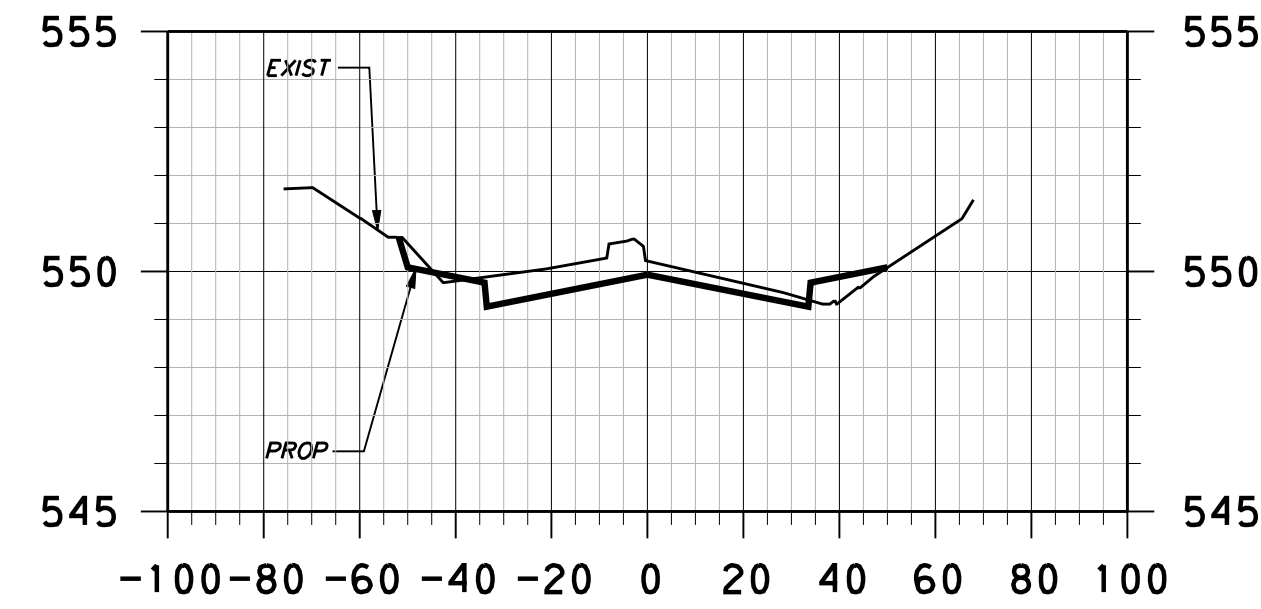


6+00.00

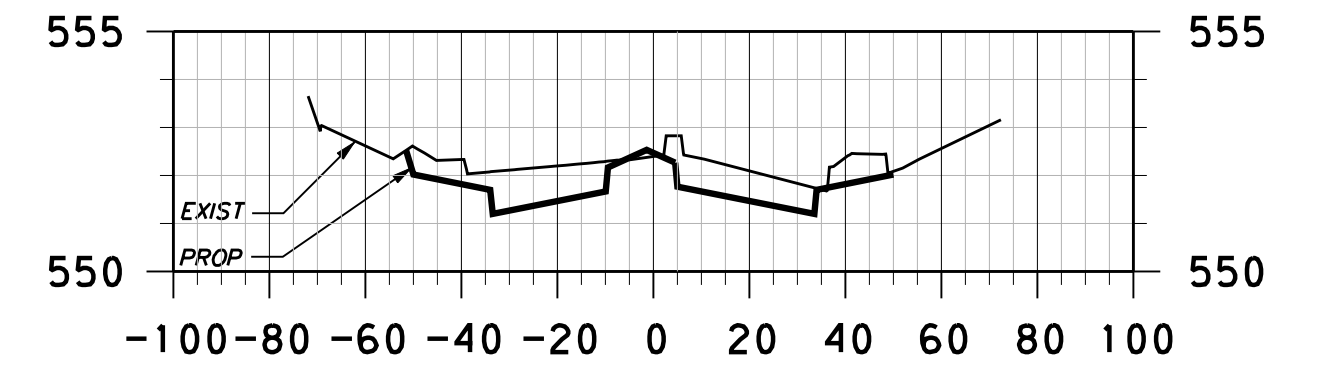


8+00.00

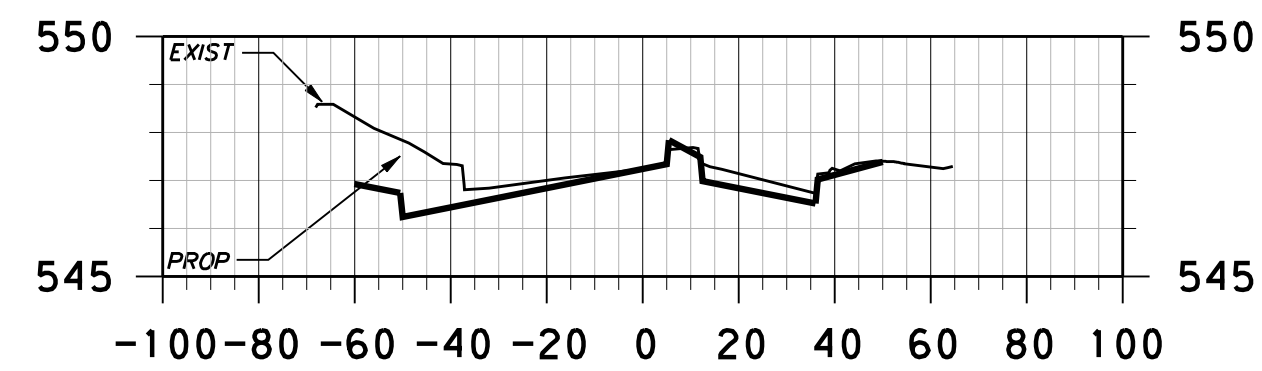


1+50.00

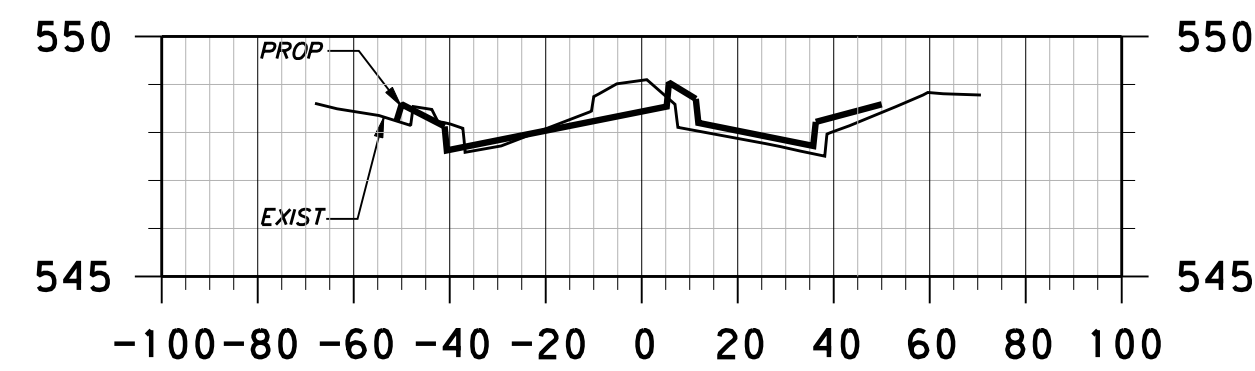


3+50.00

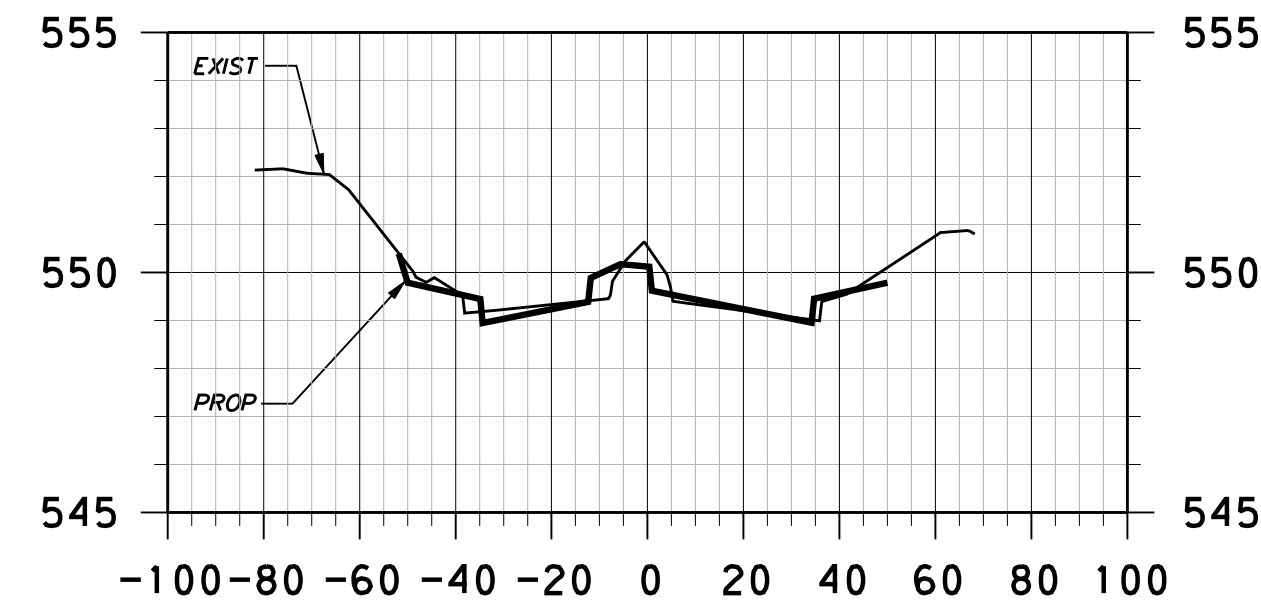


5+50.00

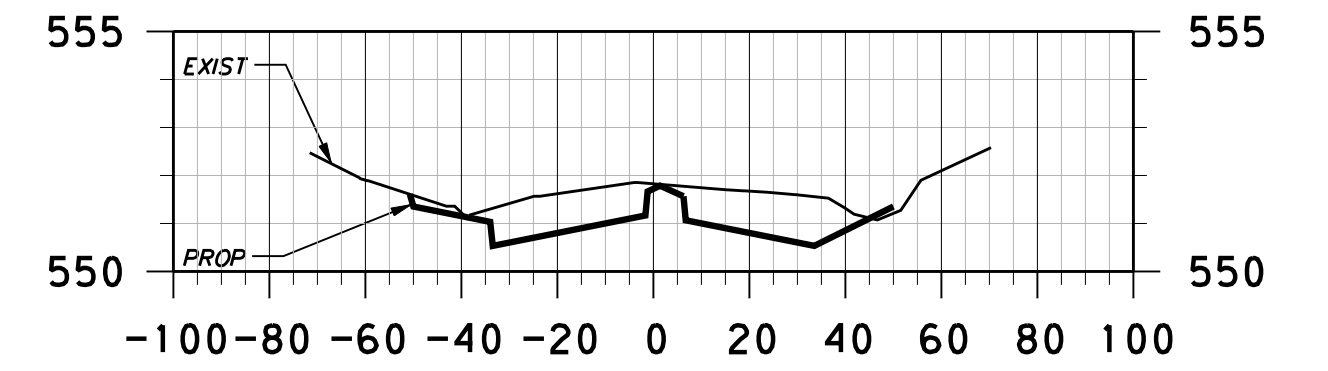


7+50.00

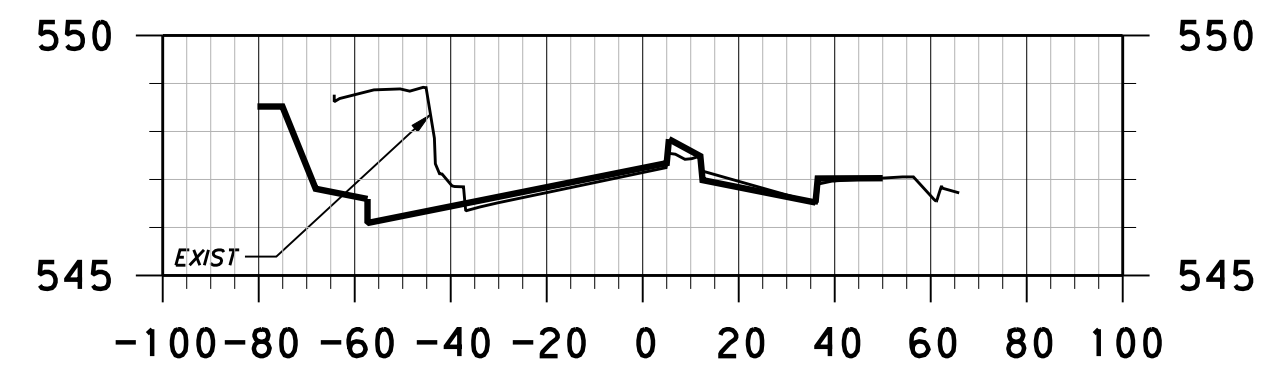


1+00.00

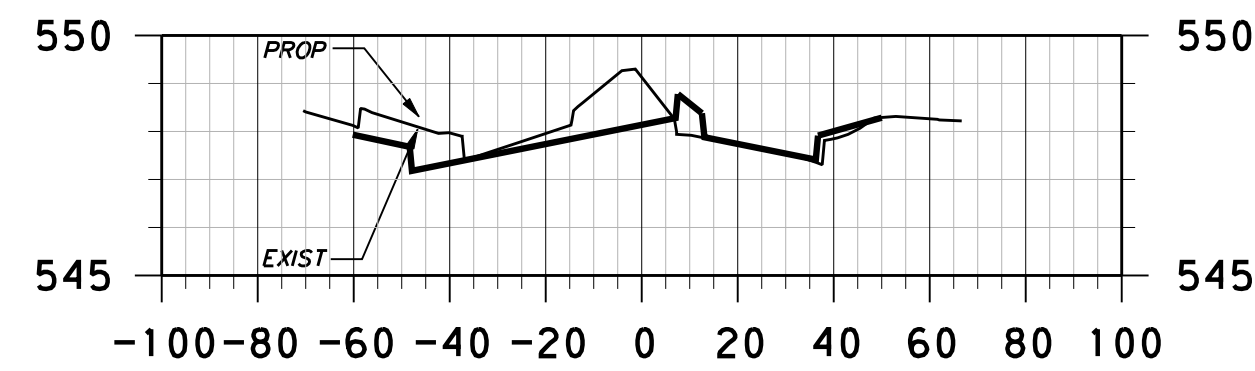


3+00.00

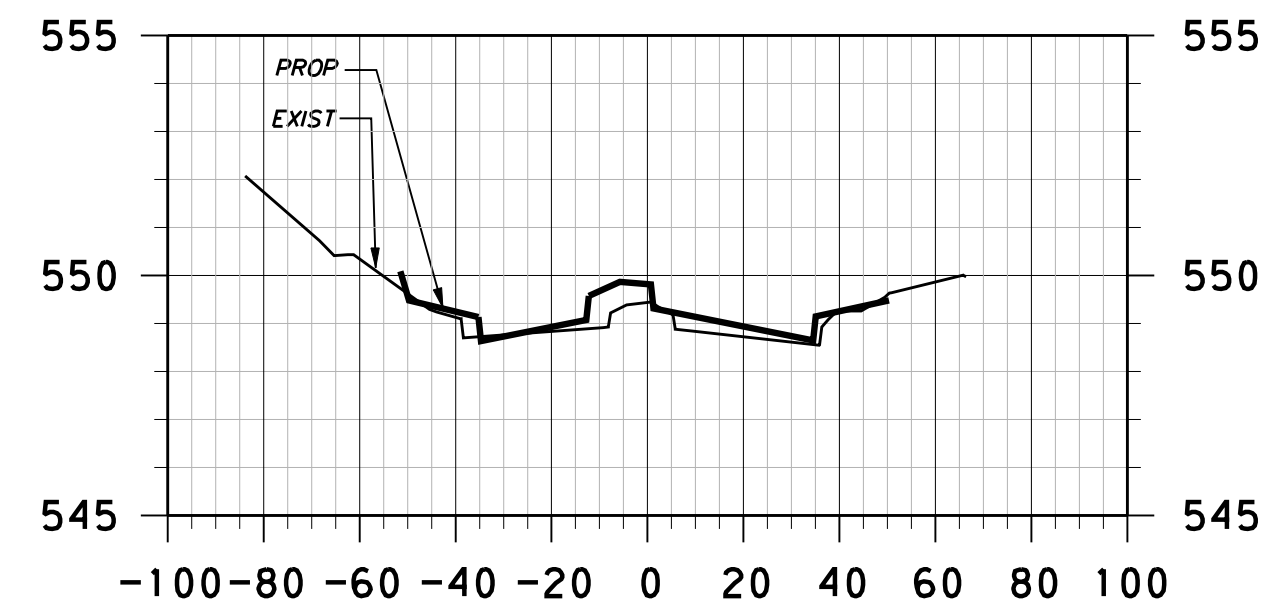


5+00.00

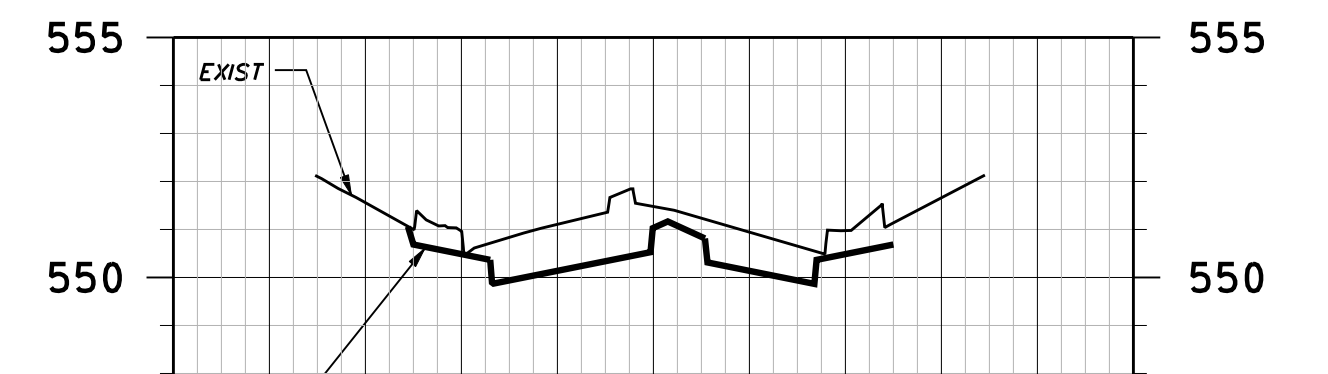


7+00.00

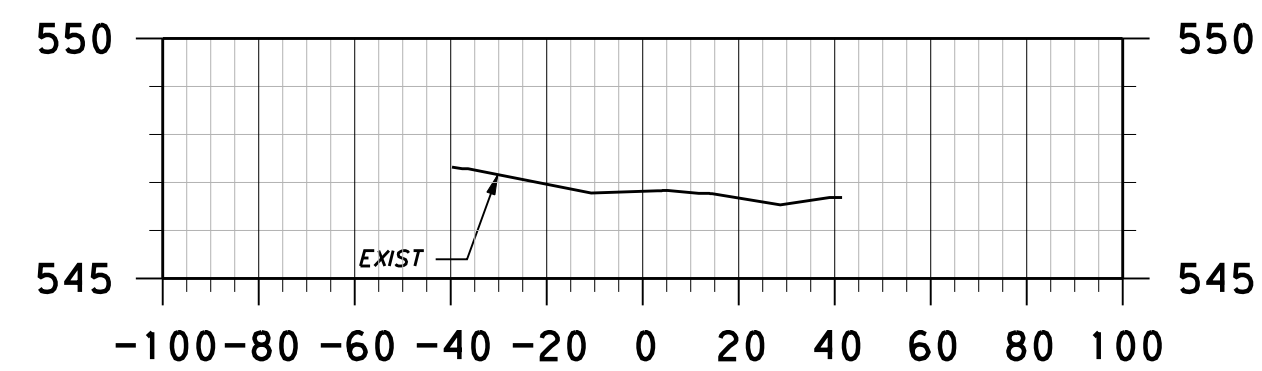


0+50.00

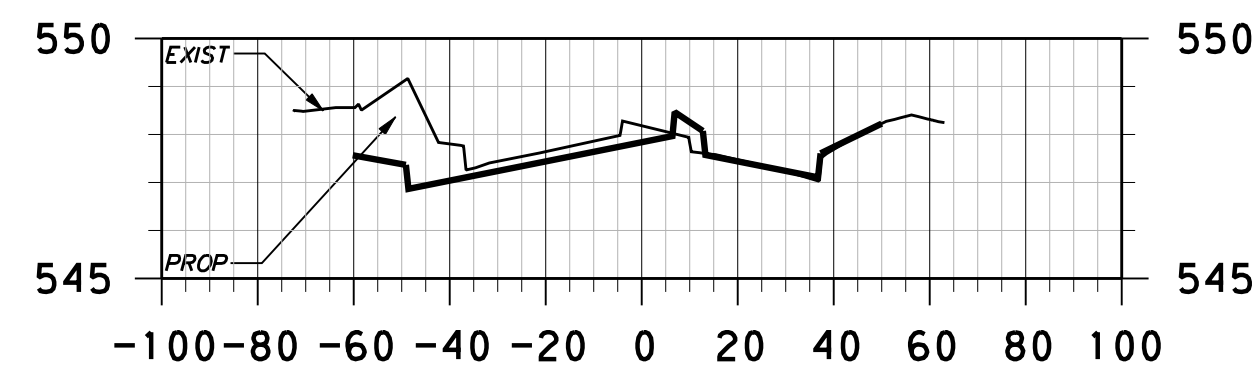



2+50.00

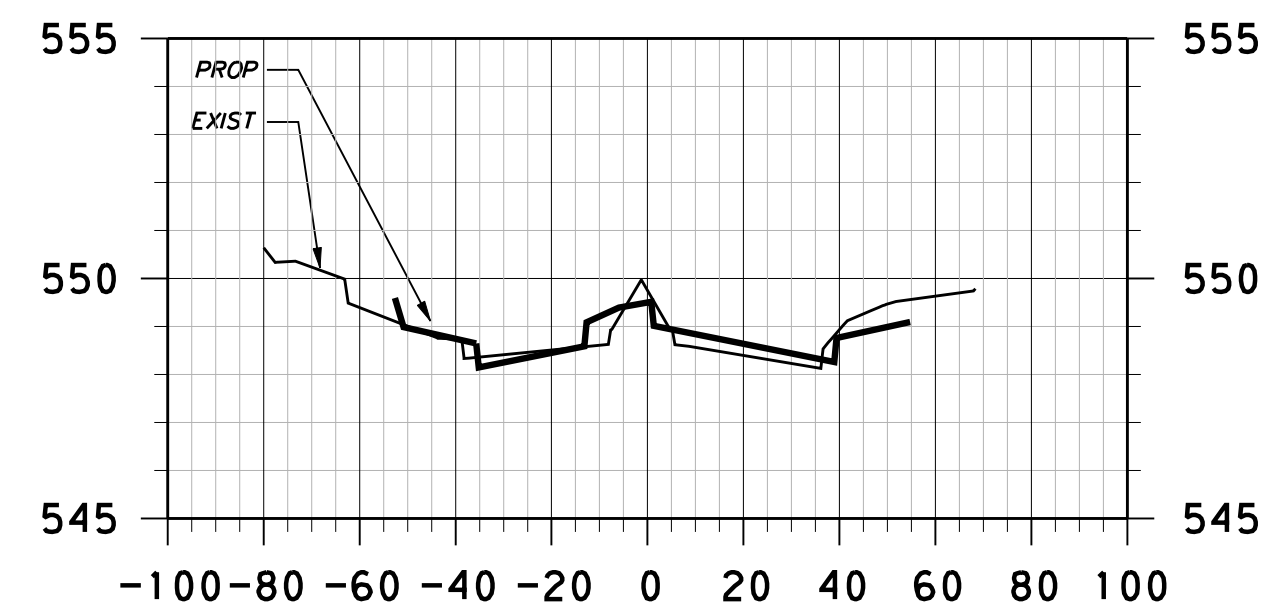

4+50.00

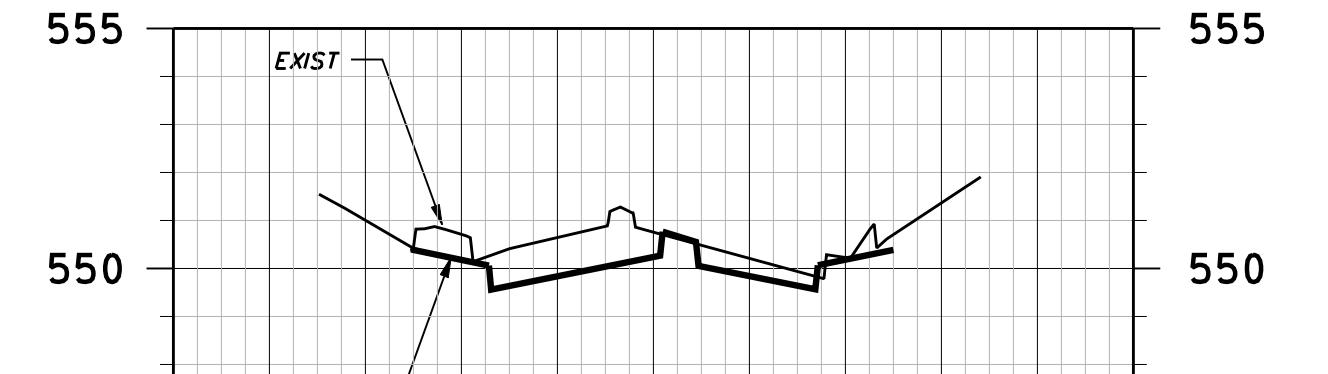

6+50.00

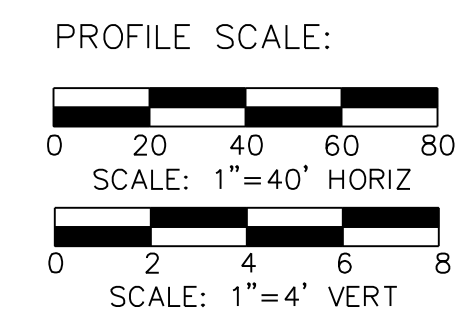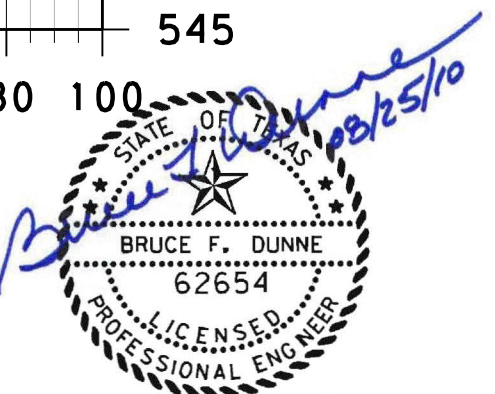

NO.	REVISION	BY	DATE

**Addison!** TOWN OF ADDISON  
DALLAS COUNTY, TEXAS  
PAVING, DRAINAGE & UTILITY IMPROVEMENTS  
VITRUVIAN WAY & PONTE AVENUE

**CROSS-SECTIONS-VW  
STA 0+00.00 TO STA 8+00.00**

<b>icon</b> Consulting Engineers, Inc. Civil Engineers - Designers - Planners		250 W. Southlake Blvd., Suite 117 Southlake, Tx 76092 (817) 552-6210			
PROJECT	DESIGN	DRAWN	DATE	FILE	SHEET
5029-01	ICE	ICE	MAY 7 2009	PW# 2009-01	91

PAVING, DRAINAGE, & UTILITY IMPROVEMENTS - VITRUVIAN WAY & PONTE AVENUE