



SPRING VALLEY ROAD

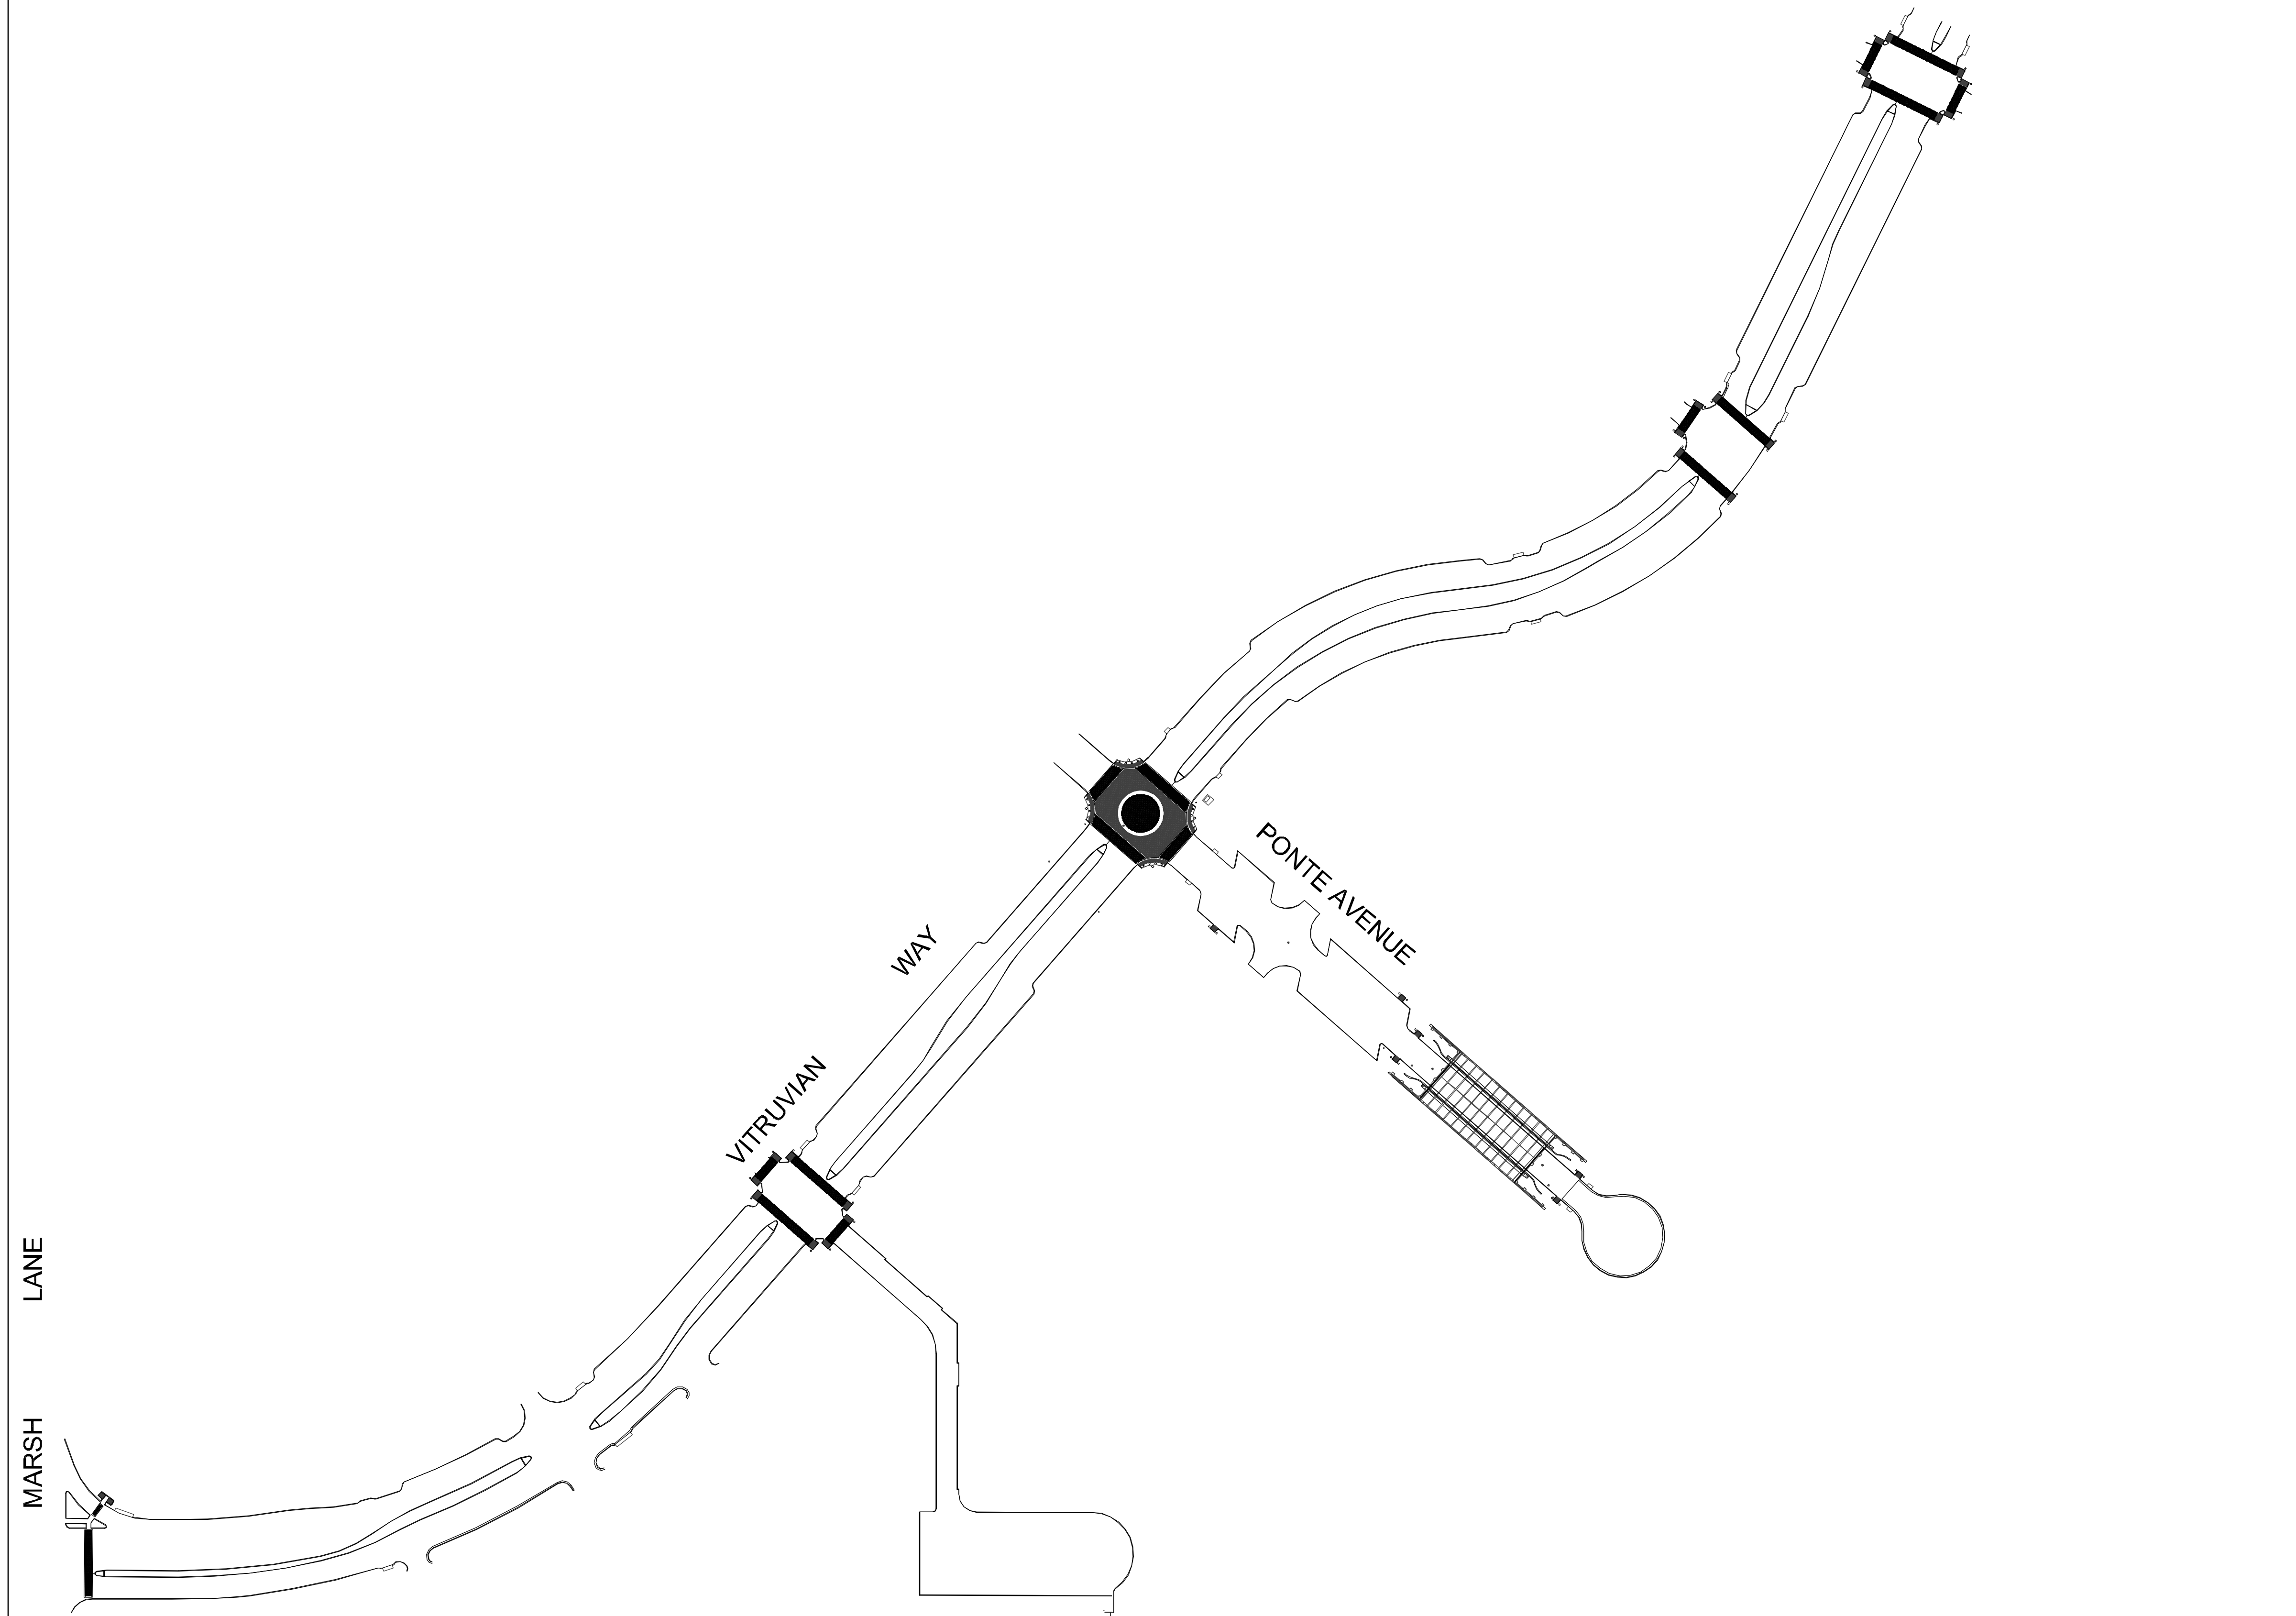

LANE  
MARSH


VITRUVIAN WAY  
PONTE AVENUE

1  
L1-00 Vitruvian Way and Ponte Avenue Overall Street Plan

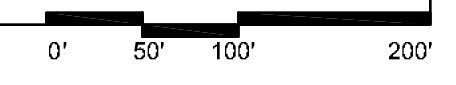

**SHEET INDEX**

- L1-00 Cover Sheet
  - L1-10 General Notes
- BASE BID CONDITION**
- L2-00 Hardscape Materials, Elements and Layout
  - L2-01 VW Hardscape - South Crosswalk Enlargement
  - L2-02 VW Hardscape - Central Crosswalk Enlargement
  - L2-03 VW Hardscape - North Crosswalk Enlargement
  - L2-04 VW Hardscape - North Crosswalk Enlargement
  - L2-05 VW + Ponte Ave - Intersection Enlargement
  - L2-06 Ponte Avenue - Enlargements

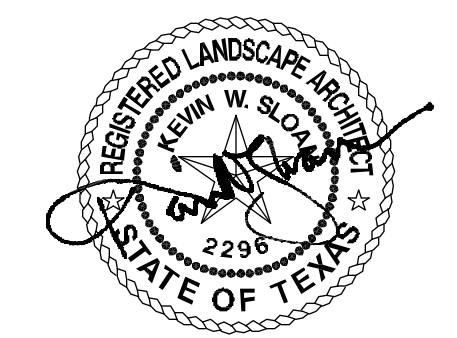

**ISSUED FOR CONSTRUCTION**  
 KEVIN SLOAN STUDIO  
 Landscape Architect KEVIN W. SLOAN  
 Lic. No. 2296 Date 4/28/09

NO.	REVISION	BY	DATE

*Addison!* TOWN OF ADDISON  
 DALLAS COUNTY, TEXAS

PAVING, DRAINAGE & UTILITY IMPROVEMENTS  
 VITRUVIAN WAY AND PONTE AVENUE

**COVER SHEET**

KEVIN SLOAN STUDIO 4145 Travis, Suite 105  
 Dallas, Texas 75204 (214) 379-1061

PROJECT	DESIGN	DRAWN	DATE	FILE	SHEET
5029-01	KWS	MM	APR 2009	PW # 2009-01	L1-00

PAVING, DRAINAGE, & UTILITY IMPROVEMENTS - VITRUVIAN WAY & PONTE AVENUE