

*PLANS FOR THE CONSTRUCTION OF
PARK AND STREETSCAPE IMPROVEMENTS*

VITRUVIAN PARK

FOR

VITRUVIAN PARK PUBLIC INFRASTRUCTURE-PHASE 1C

TOWN OF ADDISON, TEXAS

PUBLIC WORKS # 2009-04



JOE CHOW
MAYOR

ROGER MELLOW
MAYOR PRO TEMPORE


TOM BRAUN
BLAKE CLEMENS
DON DASEKE
KIMBERLY LAY
BIANCA NOBLE
COUNCIL MEMBERS

RON WHITEHEAD
CITY MANAGER

NANCY CLINE, P.E.
DIRECTOR OF PUBLIC WORKS

CLAY BARNETT, P.E.
TOWN ENGINEER

SLADE STRICKLAND
DIRECTOR OF PARKS

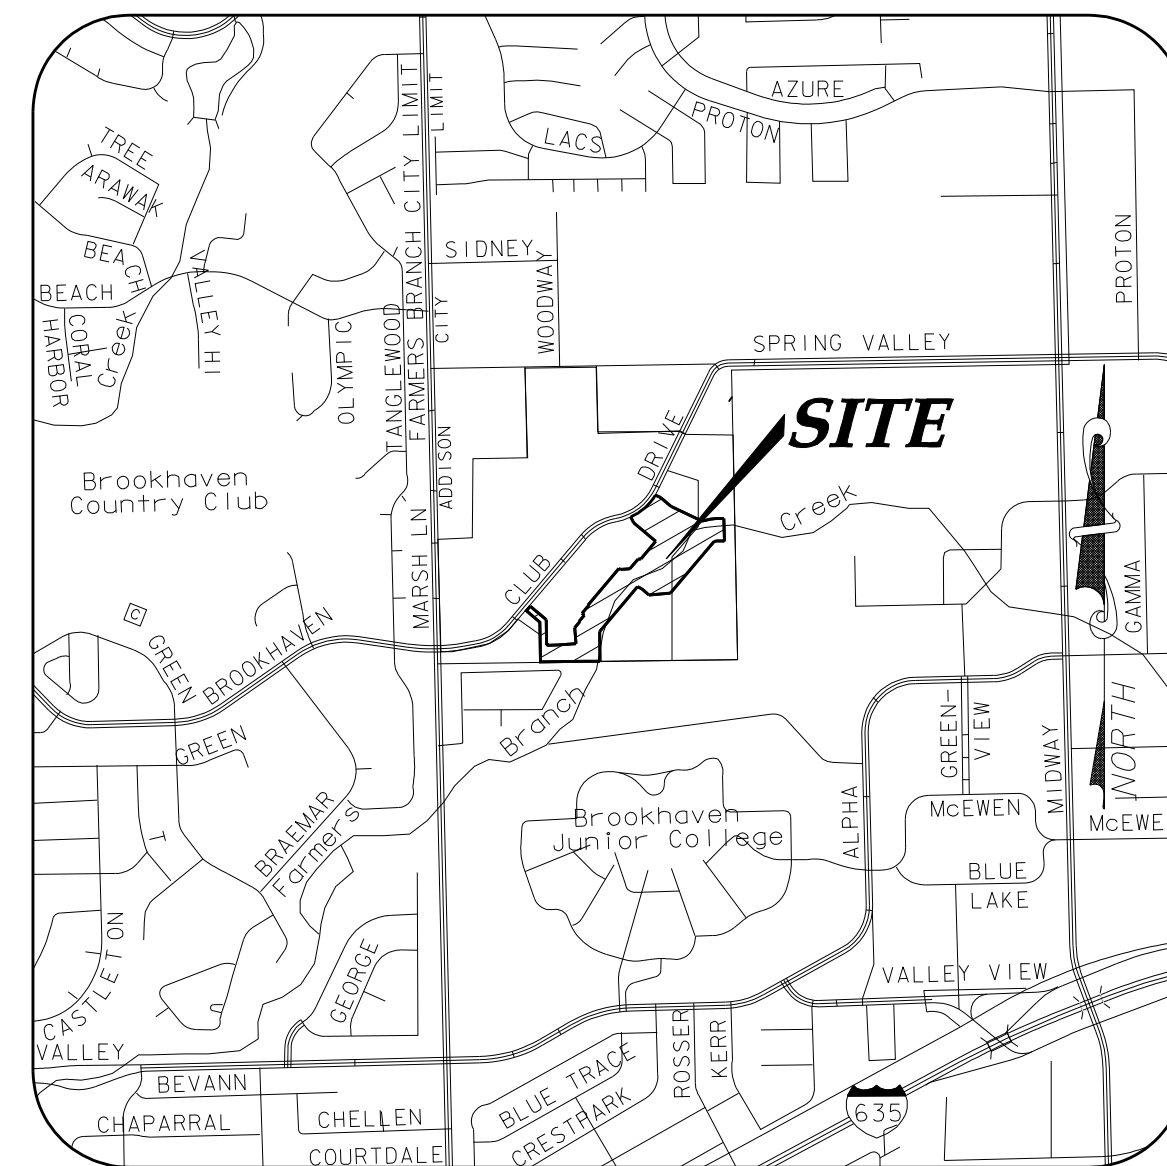

VICINITY MAP

NOT TO SCALE
(MAPSCO GRID 13 & 14)

CIVIL ENGINEER:

ICON CONSULTING ENGINEERS, INC.
250 W. SOUTHLAKE BLVD., SUITE 117
SOUTHLAKE, TEXAS 76092
PH: (817) 552-6210
FAX: (817) 552-3126
CONTACT: BRUCE F. DUNNE, P.E.

SURVEYOR:

LANE'S SOUTHWEST SURVEYING, INC.
2717 MOTLEY DRIVE, SUITE 'B'
MESQUITE, TEXAS 75150
PH: (972) 681-4442
FAX: (972) 681-4829
CONTACT: JIM LANE, R.P.L.S.

LANDSCAPE ARCHITECT:

KEVIN SLOAN STUDIO
4145 TRAVIS ST, SUITE 105
DALLAS, TEXAS 75204
PH: (214) 379-1061
FAX: (214) 528-6296
CONTACT: KEVIN SLOAN

STRUCTURAL ENGINEER:

VIEWTECH STRUCTURAL ENGINEERS, INC.
4205 BELTWAY DRIVE
ADDISON, TEXAS 75001
PH: (972) 661-8187
FAX: (972) 740-7002
CONTACT: VICTOR LISSIAK, JR, P.E.

SIGNAGE ARCHITECT:

LOONEY RICKS KISS ARCHITECTS, INC.
175 TOYOTA PLAZA, SUITE 600
MEMPHIS, TN 38103
PH: 901 521 1440
FAX: 901 525 2760
CONTACT: LIZA BEAULIER RAO, LEED AP

ELECTRICAL ENGINEER

SCARBOROUGH ENGINEERING, INC.
2400 SCOTT AVENUE
FORT WORTH, TEXAS 76103
PH: (817) 451-6687
FAX: (817) 451-0476
CONTACT: JON D. SCARBOROUGH, P.E.

FOUNTAIN DESIGN:

GREENSCAPE, INC.
1425 WHITLOCK LANE, SUITE 108
CARROLLTON, TEXAS 75006
PH: 972 446-0037
FAX: 972 446-0313
CONTACT: JAYSON BUSH

icon Consulting Engineers, Inc.
Civil Engineers- Designers- Planners
ENGINEERING FIRM REGISTRATION NUMBER F-9007

APRIL 26, 2010



ICON PROJECT #5029-01

RECORD DRAWINGS 06/18/12