


TRANSVERSE JO	INT SPACING			
PAVEMENT THICKNESS	SPACING			
T = 5"	10 FEET			
T = 6"	12 FEET			
T = 7"	14 FEET			
T = 8''	16 FEET			
TRANSVERSE EXPA	NSION JT SPACING			
VARIES (200' C-	C MAXIMUM)			

LONGITUDINAL JOINT SPACING					
STREET WIDTH	SPACING				
22' TO 30'	ON CL				
36′&40′	ON CL & 8' FROM BACK OF CURE				
38'	6′ LT & RT OFF CL				
44'	ON CL AND 11' OFF CL				
48′	ON CL AND 12' OFF CL				
60′	6' AND 18' OFF CL				
76'	8', 20' AND 32' OFF CL				

JOINT	DE
PAVEMENT THICKNESS	
T = 5"	
T = 6"	
T = 7"	
T = 8"	

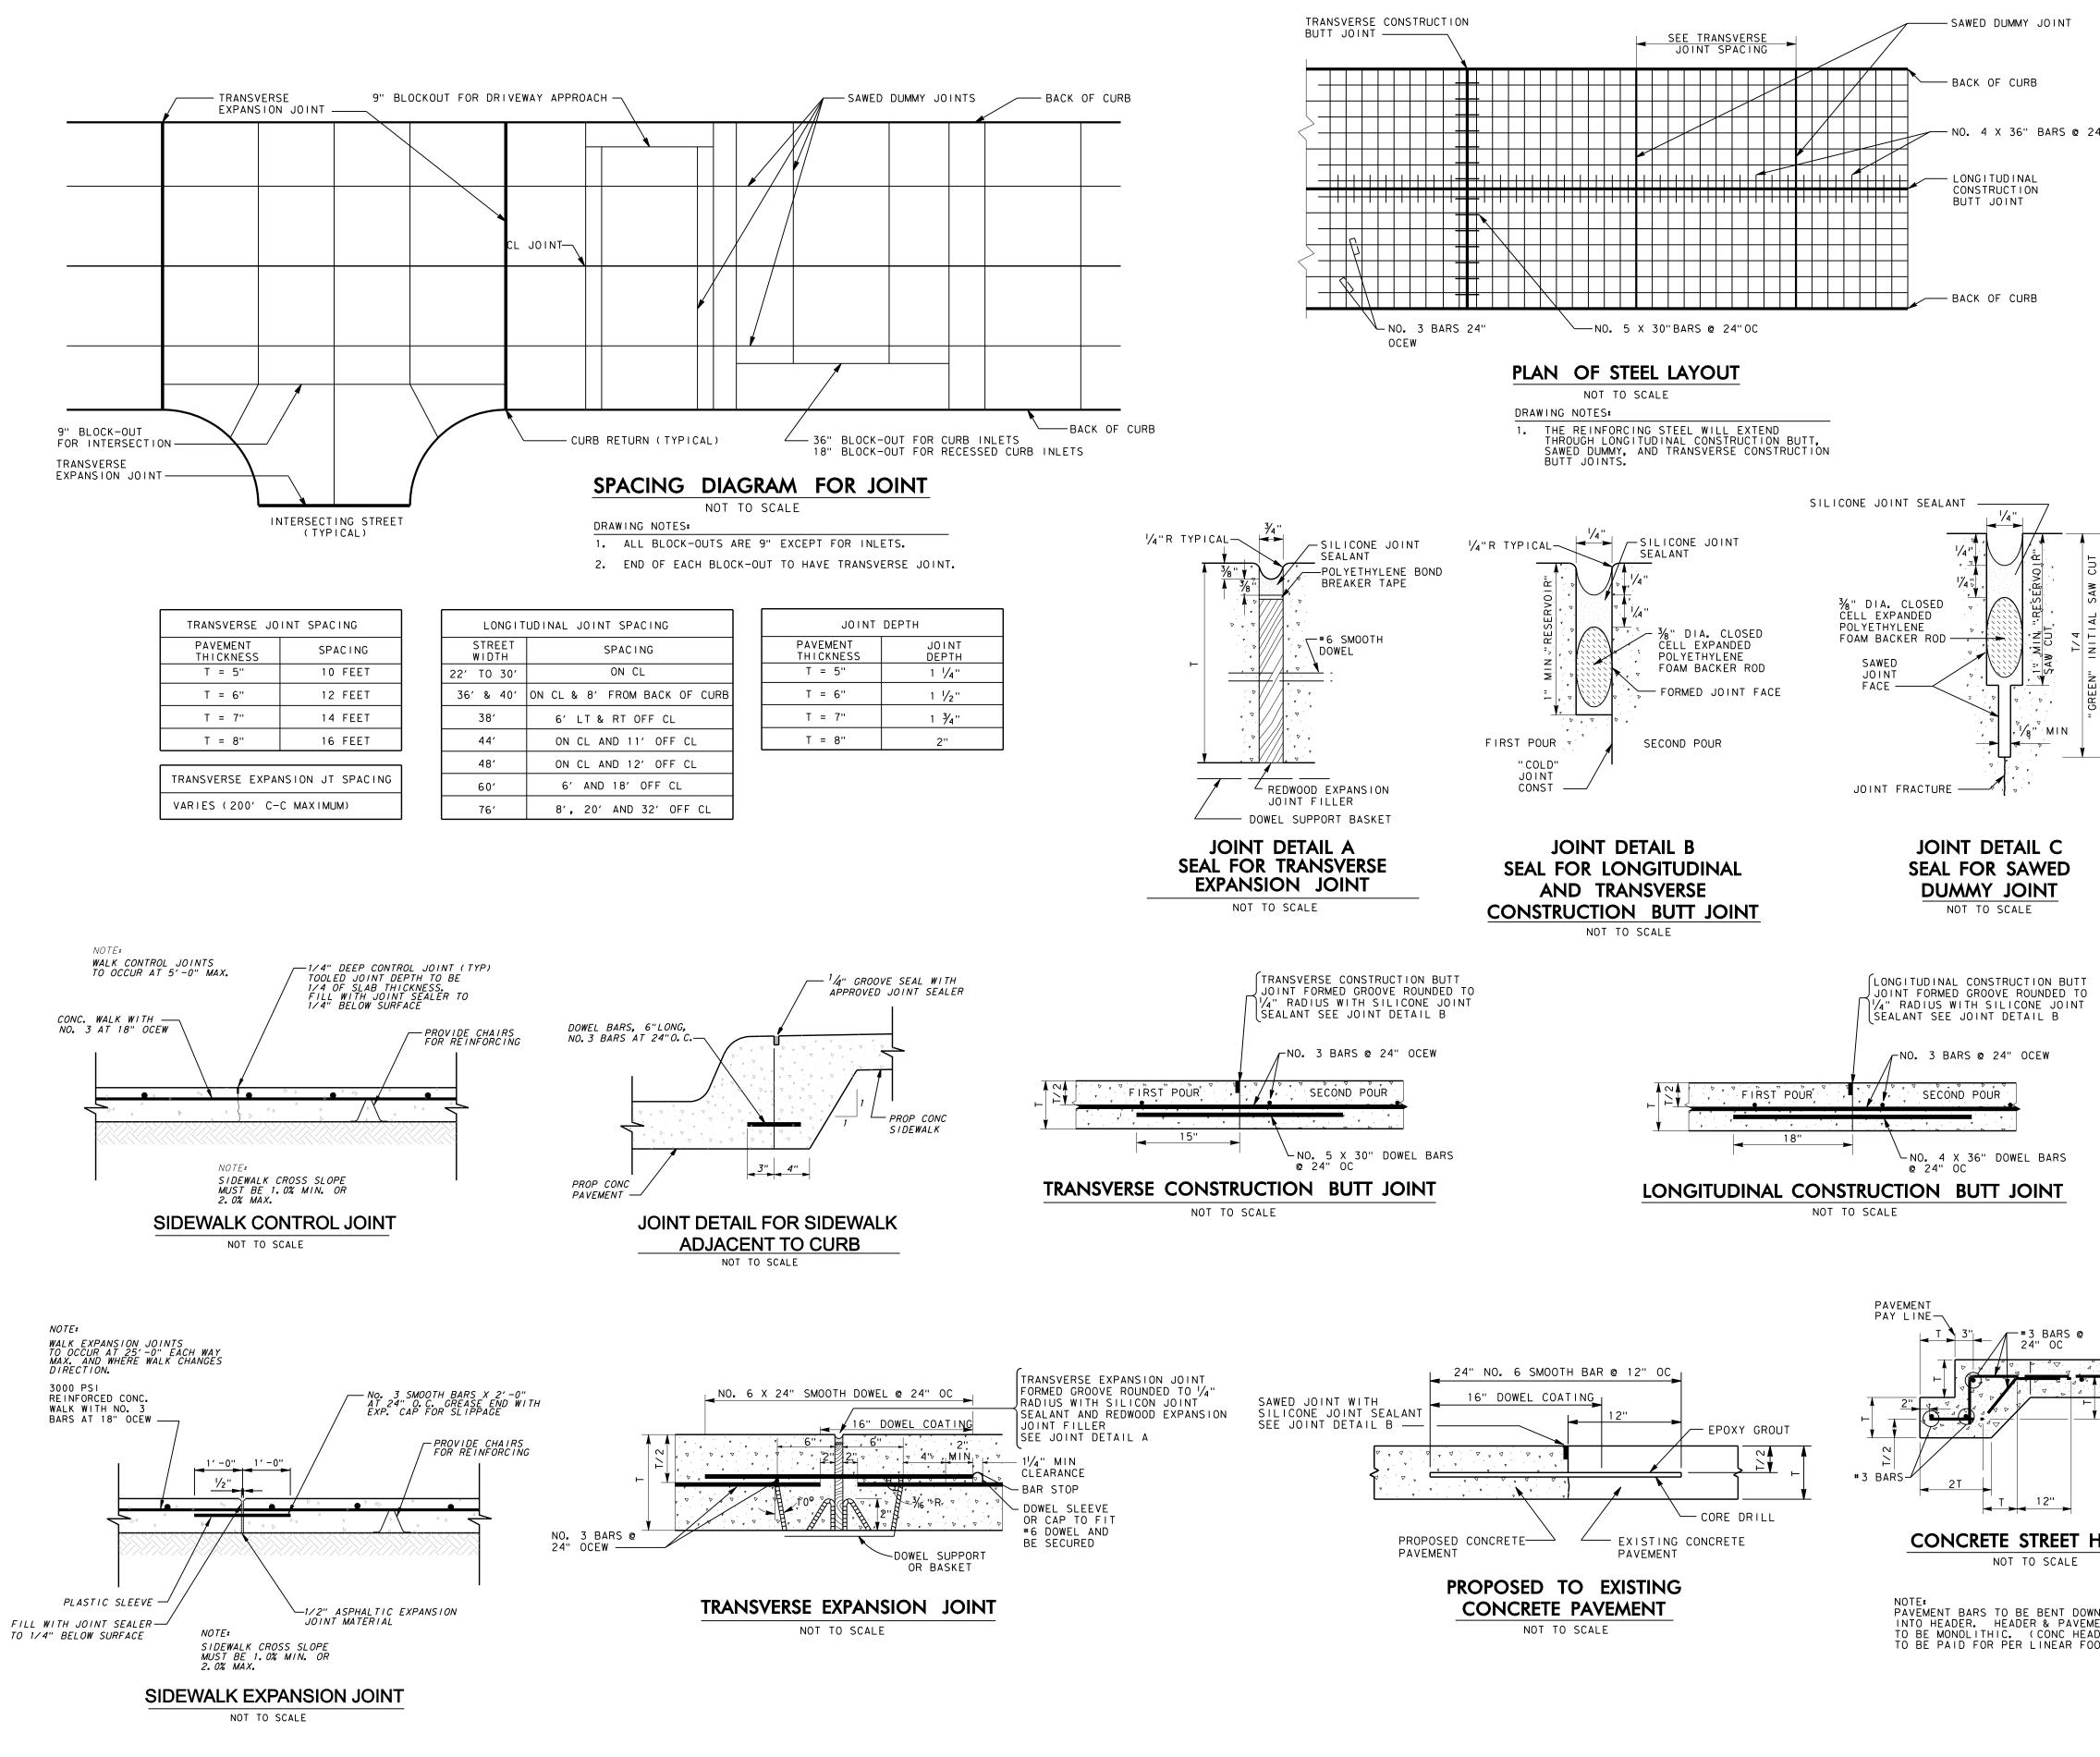

RECORD DRAWINGS 06/18/12

PAVING DETAILS								
	icon	Consulting Engineers, Inc. Civil Engineers - Designers - Planners			250 W. Southlake Blvd., Suite 117 Southlake, Tx 76092 (817) 552-6210			
	PROJECT	DESIGN	DRAWN	DATE	FILE	SHEET		
	5029-01	ICE	ICE	APR 26, 2010	PW# 2009-04	C607		

4" OCEW		/	≺sılıcoi	DUMMY JOIN NE JOINT S INT DETAIL	SEALANT		
	, , , , , , , , , , , , , , , , , , ,		NO. 3	BARS @ 24'	OCEW		
DOWEL BARS	TRANSVER SAWE		OL XWV		L -		
* 3 BARS @ 24" OC				ß	BRUCE F. DUNNE 62654	afoglur	PARK
	NO.		REVISIO	DN		BY DATE	NTRUVIAN PA
T 12"		Addison			F ADDISON DUNTY, TEXAS		HENTS -
E STREET HEADER	VITRUVIAN PARK					IMPROVEMENTS	
O BE BENT DOWN IEADER & PAVEMENT C. (CONC HEADER PER LINEAR FOOT)	ADER & PAVEMENT (CONC HEADER PAVING DETAILS					STREE TSCAPE	
	PROJECT	DESIGN	DRAWN	DATE	FILE	SHEET	AND
	5029-01	ICE	ICE	APR 26, 2010	PW# 2009-04	C607	PARK

6" 1<sup>3</sup>/<sub>4</sub>" OUTSIDE 1<sup>1</sup>/<sub>2</sub>" INSIDE

, V · · V , <

EXIST CONC PVMT

MONOLITHIC CURB

NOT TO SCALE

**--**2"

OCEW

6" 1 3/4"

4|≥

EPOXY GROUT

6" <sup>1</sup><sup>3</sup>/<sub>4</sub>"

ATTACHED CURB

NOT TO SCALE

2' -0"

₩3 BARS

6" CURB AND GUTTER

NOT TO SCALE

SAWED DUMMY JOINT WITH

1′ -4<sup>|</sup>/4''

— ASPHALT

PAVEMENT

#3 BARS @ 24",

