




SUMMARY OF SMALL SIGNS (WITHOUT REMOVABLE COPY)							
S I GN NO. O	SIGN TYPE	SIGN TEXT	SIGN DIMENSIONS (INCHES)	REFLECTIVE SHEETING			TYPE
1	R2-1	SPEED LIMIT	24X30	С		×	

Α



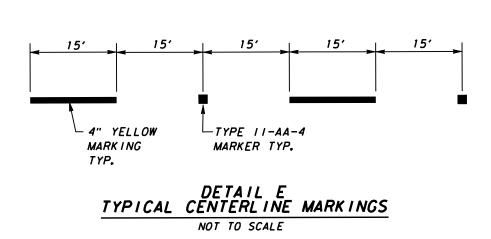

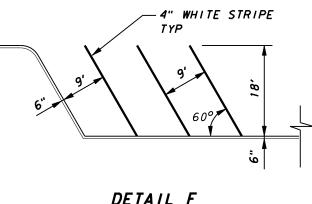

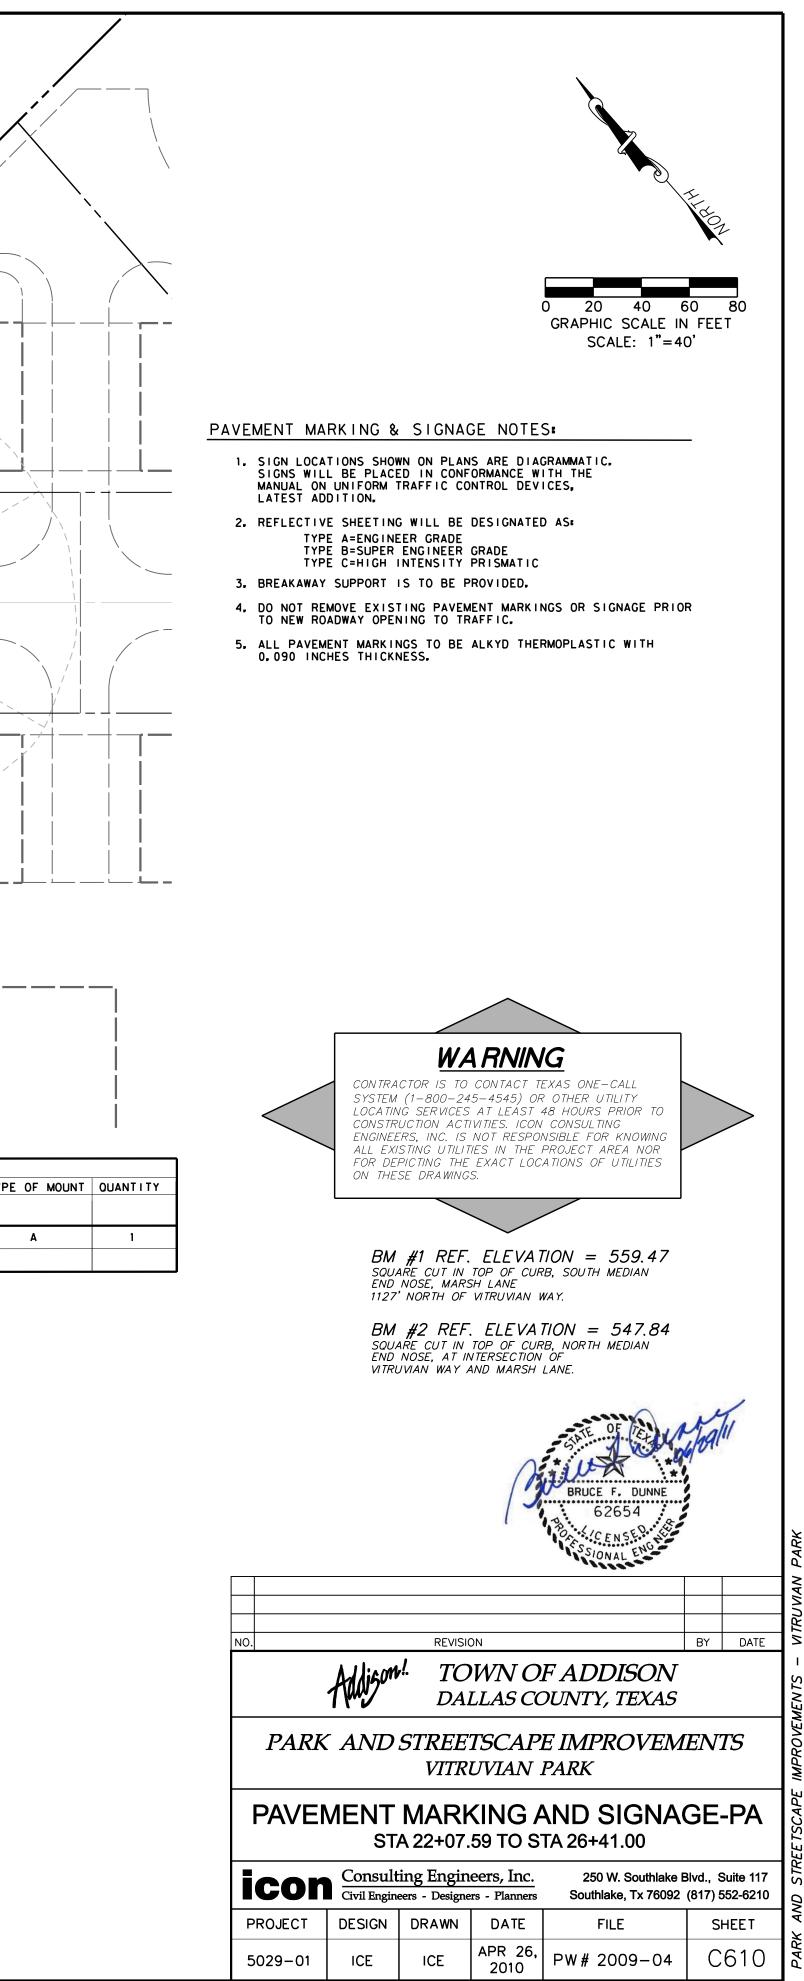

RUVIAN \geq

RECORD DRAWINGS 06/18/12