

- RUBBER END SEAL WITH STAINLESS STEEL BANDS

COVER——

CENTERING RING

LOWER NUTSOCKET

SPRING LOCK

—.075 THICK

47/64 WIDE

**SPRING LOCK** 

**VALVE EXTENSION** 

VALVE BOX

VALVE BOX WITH EXTENSION

ALL CAST IRON FITTINGS SHALL BE DOMESTIC.

—1" SOLID STEEL

3/16" X 1 3/4" X 2 " FB

3/16" X 2" X 2 " SQTBG

3/16" X 2 1/2" X 2 1/2" SQT X 2" LONG - 1

3/16" X 4 1/2"Ø 1-GUIDE

3/16" X 1" X 2"∠2 X 2" LONG. (SEE DETAIL)

1" SOLID STEEL

VARI. LENGTH

3/16" X 2 1/2" X 2 1/8" FB

X 1" LG. W.

TYPE - B

**VALVE EXTENSION** 


DOUBLE NUT

DEEPER THAN 5'-0".

NOTE: TO BE USED ON ALL VALVES

## WATER MAIN ENCASEMENT

**INSULATOR SPACING DETAIL** 

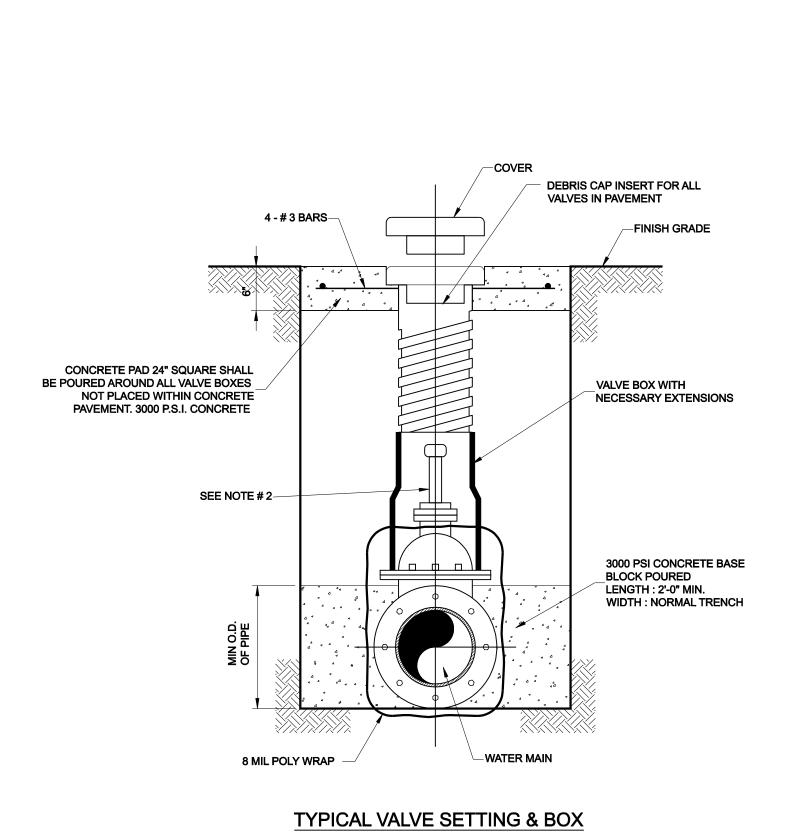


- CARRIER PIPE

1. 4"-12" R.S. GATE VALVES SHALL BE IN ACCORDANCE WITH TOWN OF ADDISON

WATER SYSTEM REQUIREMENTS AND AWWA STD C509. ALL VALVES SHALL BE MUELLER OR APPROVED EQUAL.

2. A PERMANENTLY ATTACHED VALVE EXTENSION STEM SHALL BE REQUIRED FOR ANY VALVE THATS OPERATING NUT IS LOCATED IN EXCESS OF 5 FEET BELOW THE TOP OF VALVE BOX. THIS EXTENSION SHALL BE OF SUFFICIENT LENGTH TO INSURE THAT ITS TOP IS WITHIN 5 FEET OF VALVE BOX LID.


3. BLUE DOT (3") ON NEAREST CURB FACE TO VALVE. 4. ALL IRON MATERIALS SHALL BE DOMESTIC.

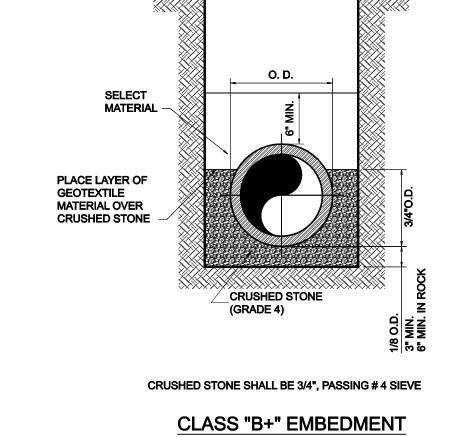

TYPICAL BACKFILL WATER MAIN P.V.C. WATER PIPE

TRENCH WIDTH
16" + O.D. MIN.

24" + O.D. MAX.

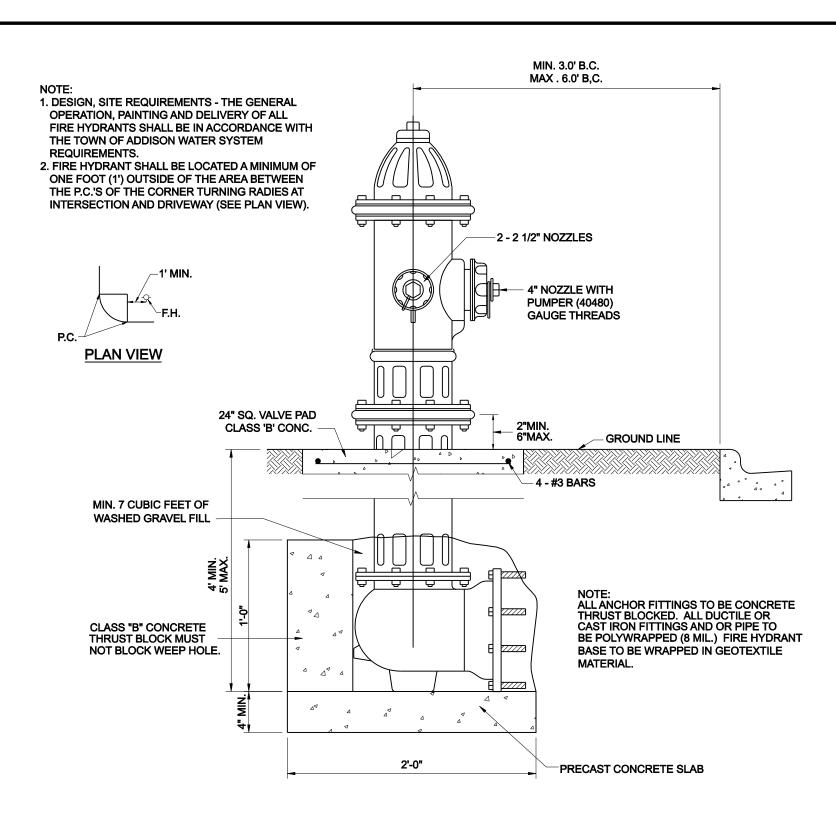

## TYPICAL FIRE HYDRANT INSTALLATION

5029-01

ICE

ICE



RECORD DRAWINGS 06/18/12

PW# 2009-04