


01 RAMP & STAIR PLAN
1/4" = 1'-0"

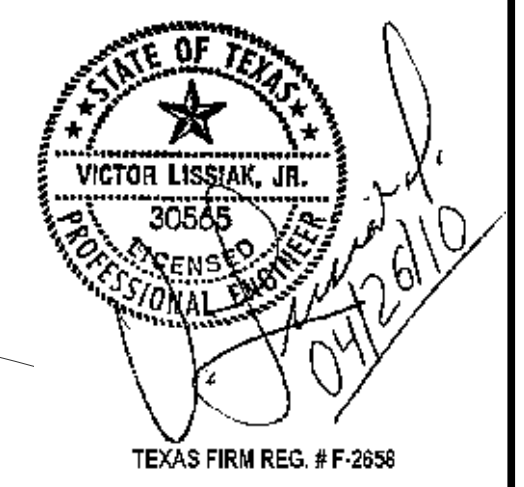

REVISED 04/28/10

NO.	REVISION	BY	DATE
1	MODIFY RAMP GRADES	VL	05-18-10
PARK AND STREETScape IMPROVEMENTS VITRUVIAN PARK			
PONTE AVE NORTH EAST RAMP & STAIR PLAN			
VIEWTECH INC. Structural Engineers		4205 Beltway Dr. - Addison, Texas 75001 (972) 661-8187 Fax (972) 661-8172	
PROJECT	DESIGN	DRAWN	DATE
5029-01	VL	NERF	APRIL 26 2010
FILE	SHEET		
PW#2009-04	SP315		