



USER: dn214  
 OFFICE: RCH  
 PROJECT # 27379  
 FILE: L201-SP-Bella-27379.dgn  
 TIME: 8:21:02 AM  
 DATE: 8/20/2010

**GENERAL NOTES**

1. REF. STRUCTURAL DRAWINGS FOR ALL BRIDGE DIMENSIONS AND COORDINATES.
2. ALL RAILING SHALL BE SPACED AT TYPICAL 10'-0" INCREMENTS AS SHOWN ON SHEET L3-01 UNLESS OTHERWISE NOTED.
3. ALL WALK DIMENSIONS ARE GIVEN FROM BACK OF CURB UNLESS OTHERWISE NOTED.
4. REF. ELECTRICAL DRAWINGS FOR ALL LIGHT FIXTURE TYPES.
5. ALL ITEMS AND APPURTANANCES N.I.C. TO BE COORDINATED BY THE CONTRACTOR PRIOR TO WORK COMMENCEMENT.
6. ALL DIMENSIONS AND ITEM LOCATIONS ARE TO BE MIRRORED ALONG THE BRIDGE CENTERLINE UNLESS OTHERWISE NOTED.

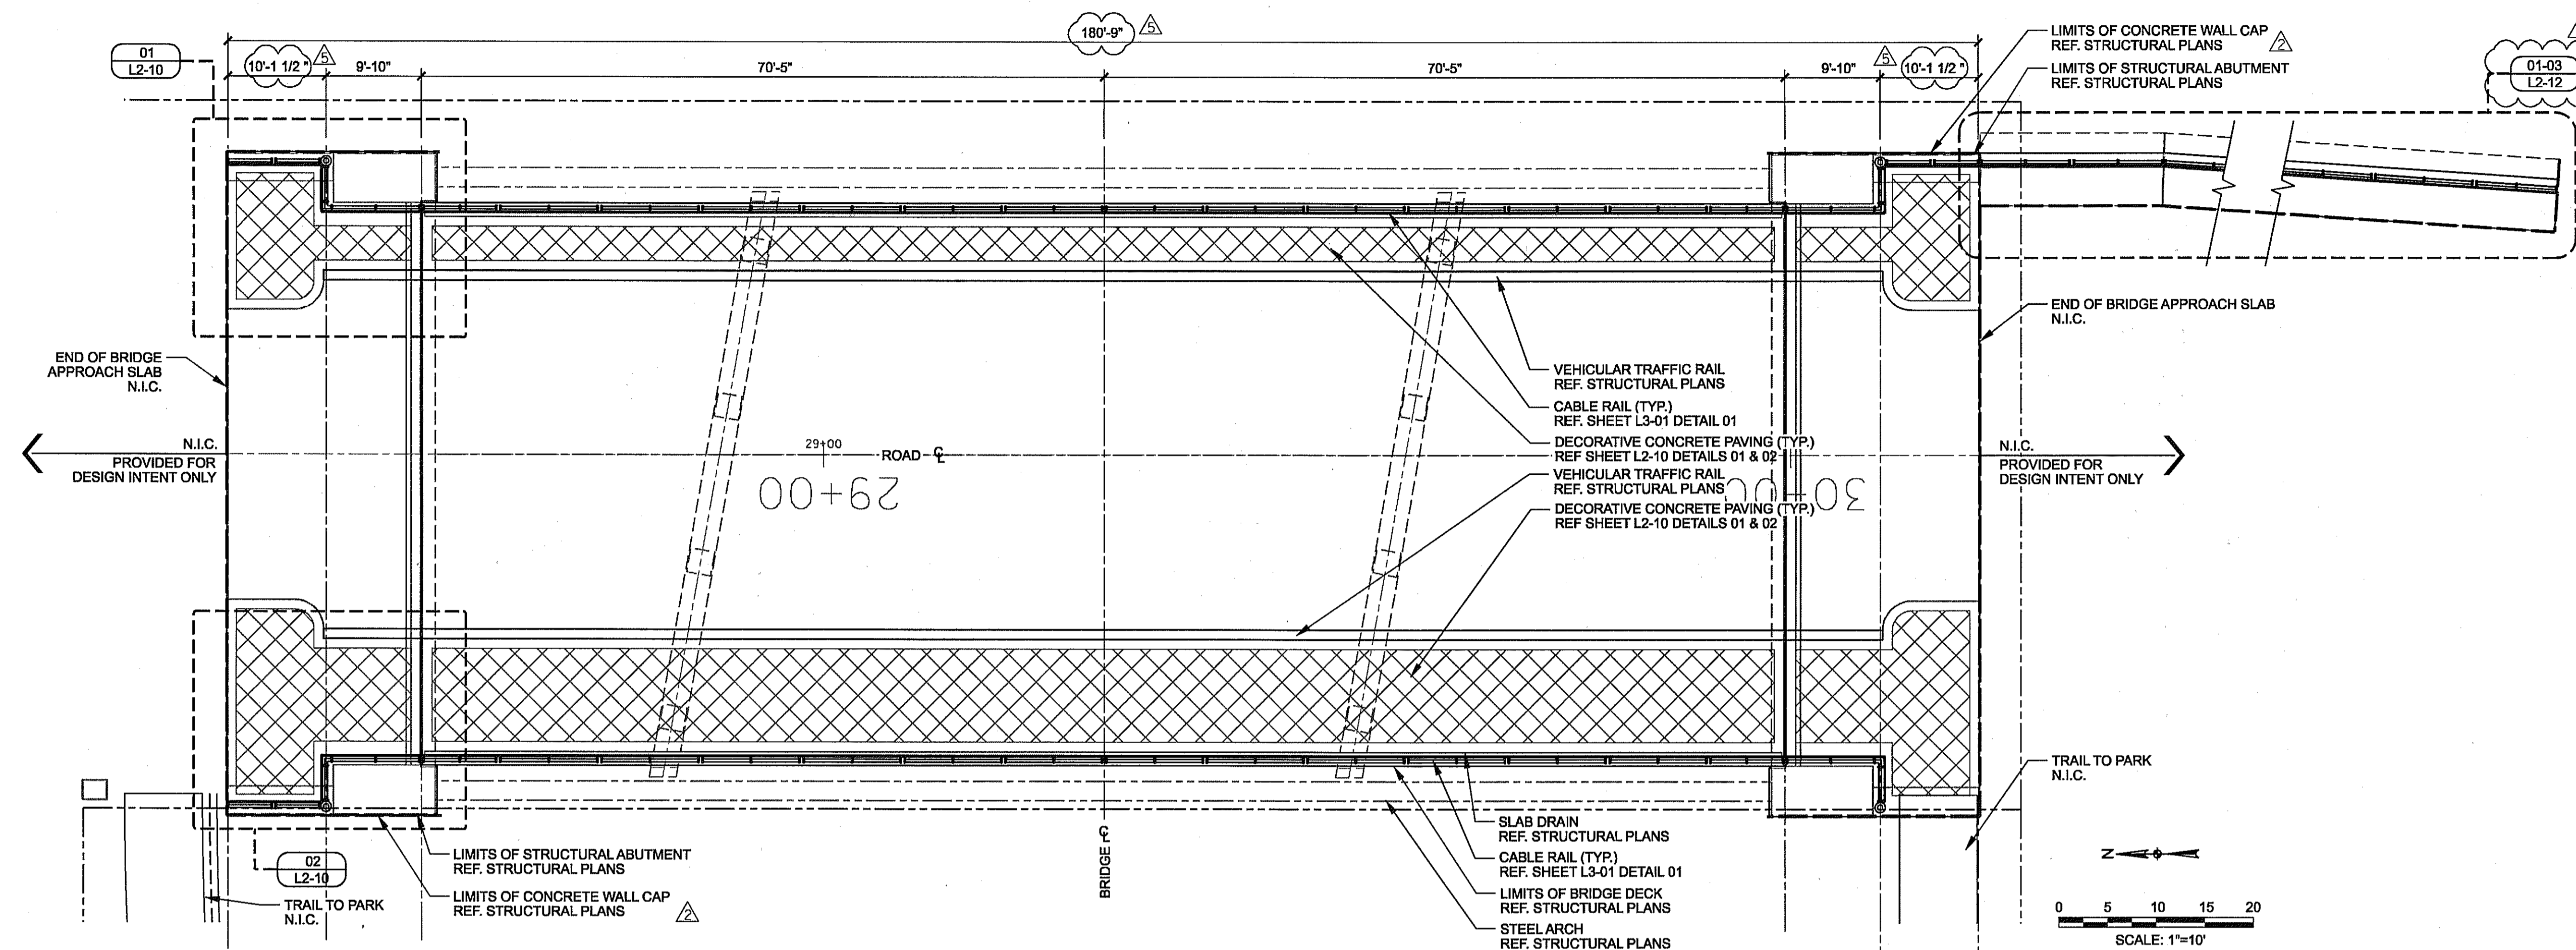

**01 CABLE RAIL AND PAVING LAYOUT**  
 SCALE: 10"= 1'-0"  
 PLAN

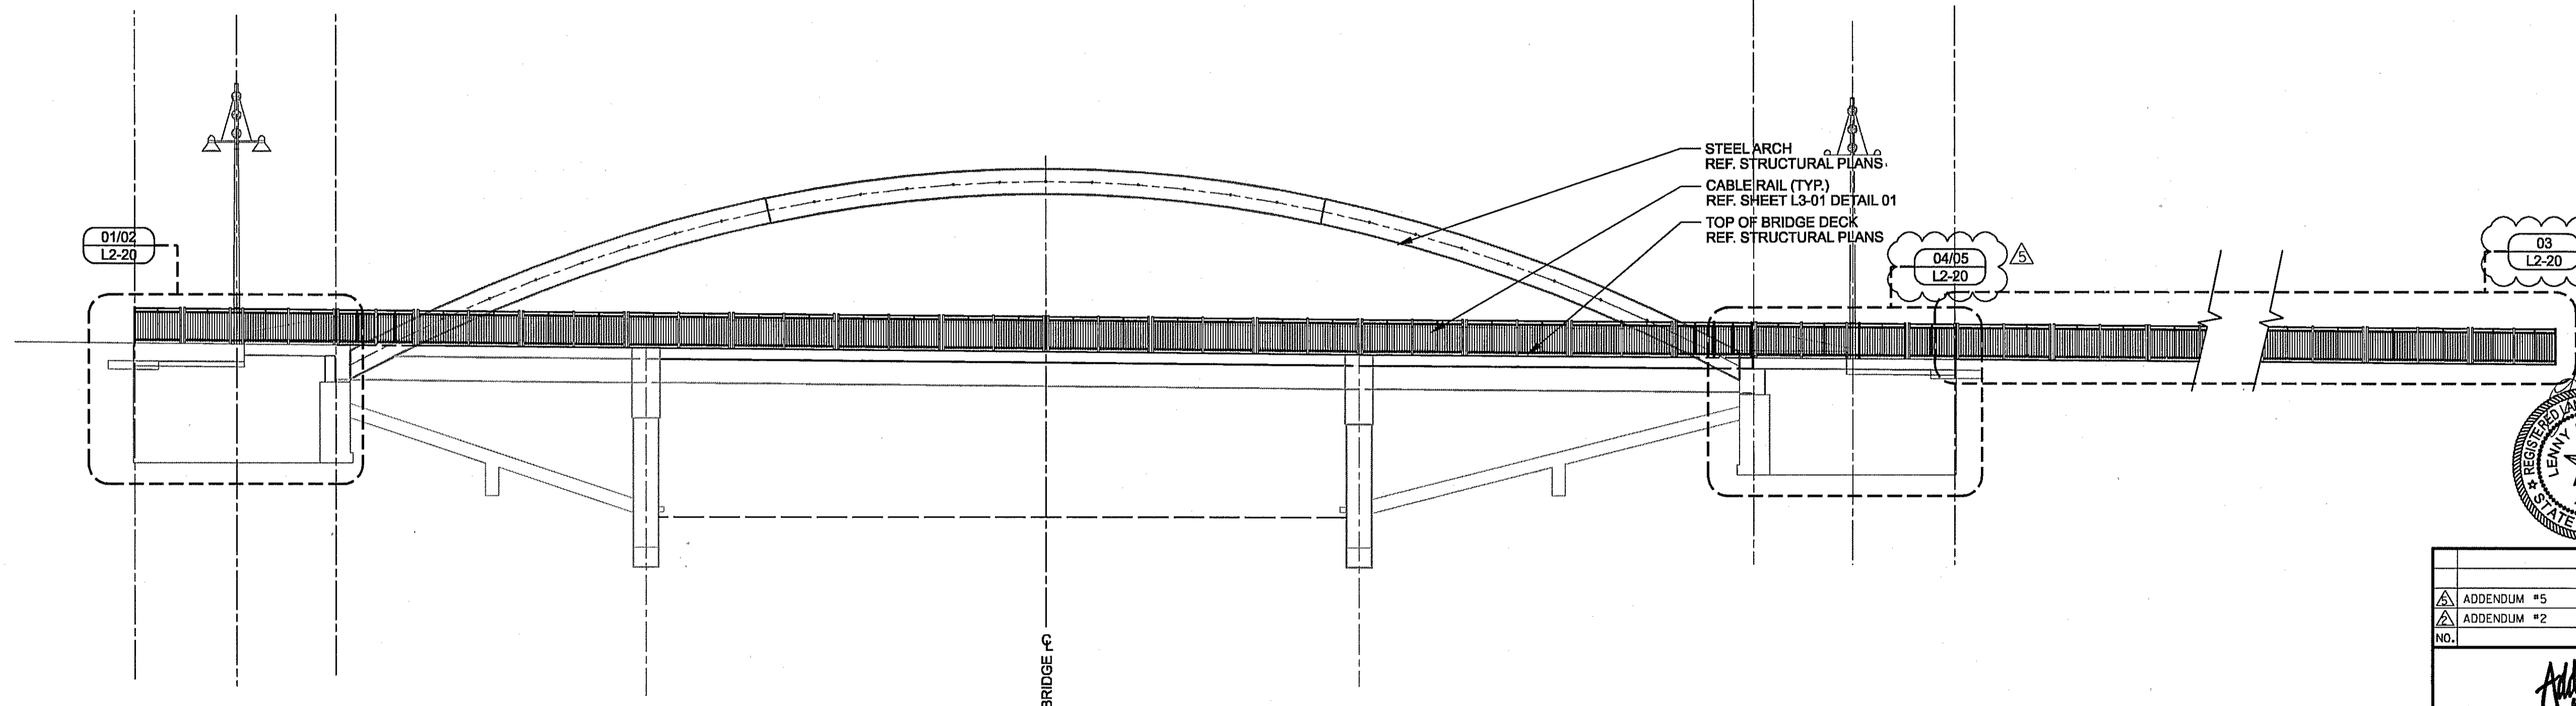

**02 CABLE RAIL AND WALL ABUTMENT LAYOUT**  
 SCALE: 10"= 1'-0"  
 ELEVATION



THE SEAL APPEARING ON THIS DOCUMENT WAS AUTHORIZED BY LENNY L. HUGHES, R.L.A., #2087 ON 08-18-2010. ALTERATION OF A SEALED DOCUMENT WITHOUT PROPER NOTIFICATION TO THE RESPONSIBLE LANDSCAPE ARCHITECT IS AN OFFENSE UNDER THE TEXAS ENGINEERING PRACTICE ACT. THE RECORD COPY OF THIS DRAWING IS ON FILE AT THE OFFICES OF HALFF ASSOCIATES, INC., 1201 NORTH BOWSER, RICHARDSON, TEXAS 75081. TBP# FIRM #F-312

ADDENDUM #5	JDB	08/18/10
ADDENDUM #2	JDB	05/19/10
NO.	REVISION	BY DATE

**Addison** TOWN OF ADDISON  
 DALLAS COUNTY, TEXAS

VITRUVIAN PARK BRIDGES  
 BELLA LANE

HANDRAIL LAYOUT  
 & PROFILE

**HALFF** 1201 NORTH BOWSER ROAD, RICHARDSON, TEXAS 75081-2275  
 TEL (214) 346-6200 FAX (214) 739-0095

PROJECT	DESIGN	DRAWN	DATE	FILE	SHEET
27379	JDB	AHH	APRIL 2010	-	L2-01